

SUMMARY OF QUANTITIES (TWO BRIDGES, EASTBOUND AND WESTBOUND BRIDGES)

ITEM NO.	DESCRIPTION	UNIT	SUPERSTRUCTURE	ABUTMENT 1	PIER 2	ABUTMENT 3	TOTAL
206	STRUCTURE EXCAVATION	CY	-	545	45	65	655
206	STRUCTURE BACKFILL (CLASS 1)	CY	-	1,595	25	1,275	2,895
206	MECHANICAL REINFORCEMENT OF SOIL	CY	-	1,595	-	1,275	2,870
502	STEEL PILING (HP 12x53)	LF	-	827	-	958	1,785
503	DRILLED CAISSON (42 INCH)	LF	-	-	182	-	182
506	RIPRAP	CY	-	1317	-	982	2,299
514	PIPE RAILING	LF	108	-	-	-	108
518	BRIDGE COMPRESSION SEAL	LF	85	-	-	-	85
518	BRIDGE EXPANSION DEVICE (0-4 INCH)	LF	170	-	-	-	170
601	CONCRETE CLASS D (BRIDGE)	CY	503	210	68	182	963
602	REINFORCING STEEL (EPOXY)	LB	77,965	23,725	16,885	20,815	139,390
628	BRIDGE GIRDER AND DECK UNIT (BY OTHERS)	EACH	1	-	-	-	1

1. RIPRAP QUANTITY PROVIDED FOR INFORMATION ONLY REFER TO CIVIL PLANS AND BRIDGE HYDRAULIC INFORMATION SHEET FOR RIPRAP LIMITS. QUANTITY ASSUMES 4" DEEP RIPRAP.
2. INCLUDES 371 CY OF CONCRETE WITHIN THE DECK, CURB AND SIDEWALK WHICH IS TO BE INCLUDED IN THE CONTECH PLANS. THE VALUE IS INCLUDED FOR OVERALL QUANTITY CALCULATIONS INFORMATION ONLY.
3. INCLUDES 59,465 LB OF REINFORCING STEEL WITHIN THE DECK, CURB AND SIDEWALK WHICH IS TO BE INCLUDED IN THE CONTECH PLANS. THE VALUE IS INCLUDED FOR OVERALL QUANTITY CALCULATIONS INFORMATION ONLY.


AS-BUILT/
CONSTRUCTED





07-12-22

THE SIGNING HARD COPY AND/OR ELECTRONIC FILE, INCLUDING THE PRINCIPLES OF DESIGN, IS THE PROPERTY OF THE ORIGINATOR OF THIS DOCUMENT AND IS SUBMITTED WITH THE AGREEMENT THAT IT IS NOT TO BE ALTERED, REPRODUCED, COPIED OR LOANED. IT IS NOT TO BE USED IN ANY MANNER THAT MAY BE A DETRIMENT TO ITS ORIGINATOR. USE THE ELECTRONIC FILE AT YOUR OWN RISK WITH NO WARRANTIES, INCLUDING WARRANTIES OF MERCHANTABILITY, FROM THE ORIGINATOR FOR ANY INACCURACIES OR INCOMPLETITUDES. SEE THE LATEST EDITION OF THE SIGNING HARD COPY AND/OR ELECTRONIC FILE.

DESIGNED BY: HMR		PROJECT TITLE FOREST LAKES BRIDGES		PROJECT LOCATION MONUMENT, CO	
DRAWN BY: AJM		SUMMARY OF QUANTITIES			
PROJECT MANAGER HMR					
DATE 7/12/22					
		STRUCTURE JOB:		SHEET NO. B02	



REVISIONS			DATE	BY
1	REVISED BEARING PAID DEPTH		05-19-21	HRK
2	REVISED QUANTITY		06-11-21	HRK
3	REVISED QUANTITY		07-09-21	HRK
4				
5				
6				
7				

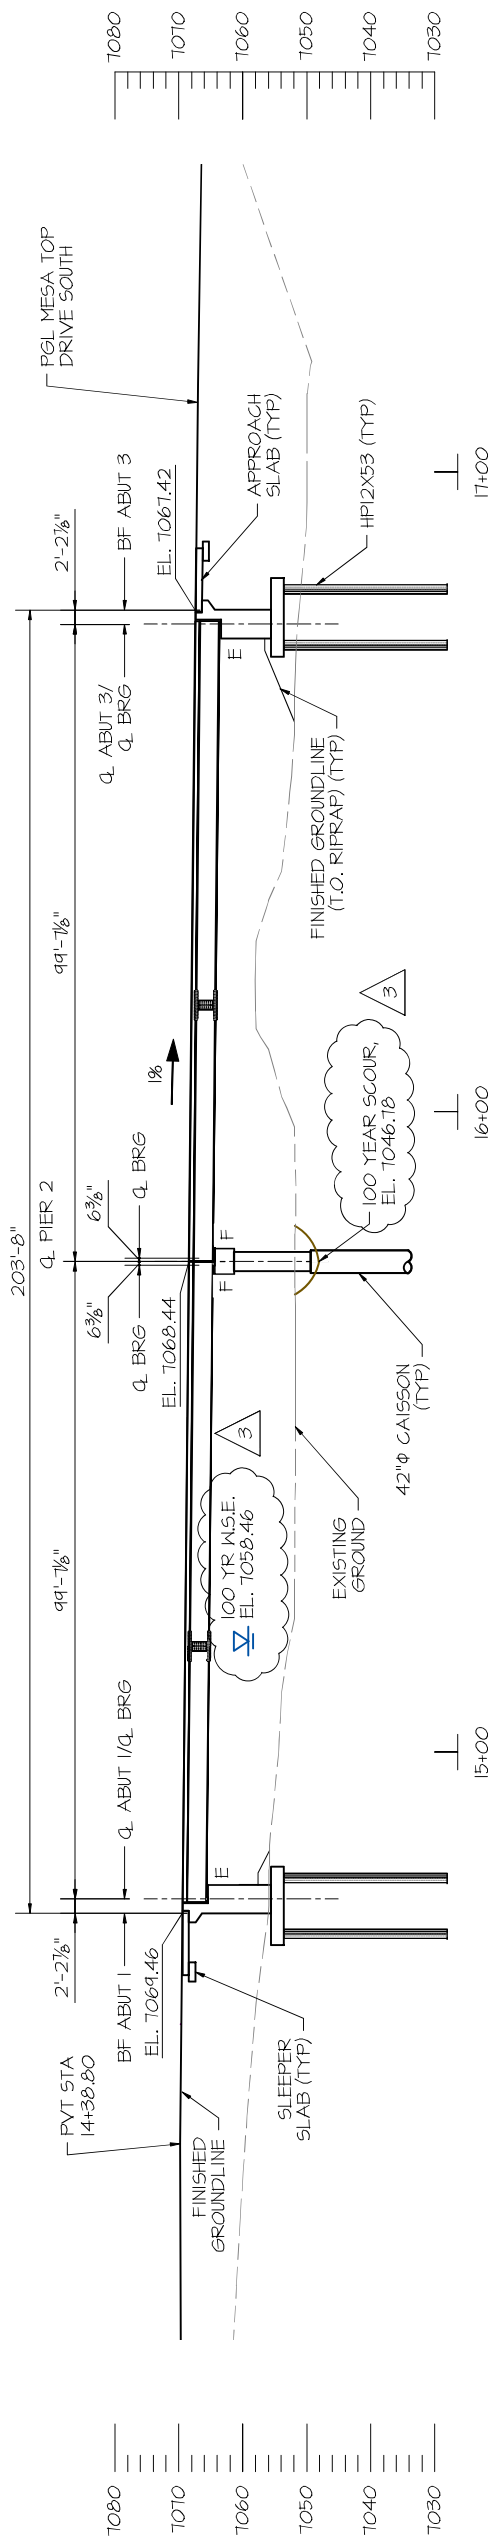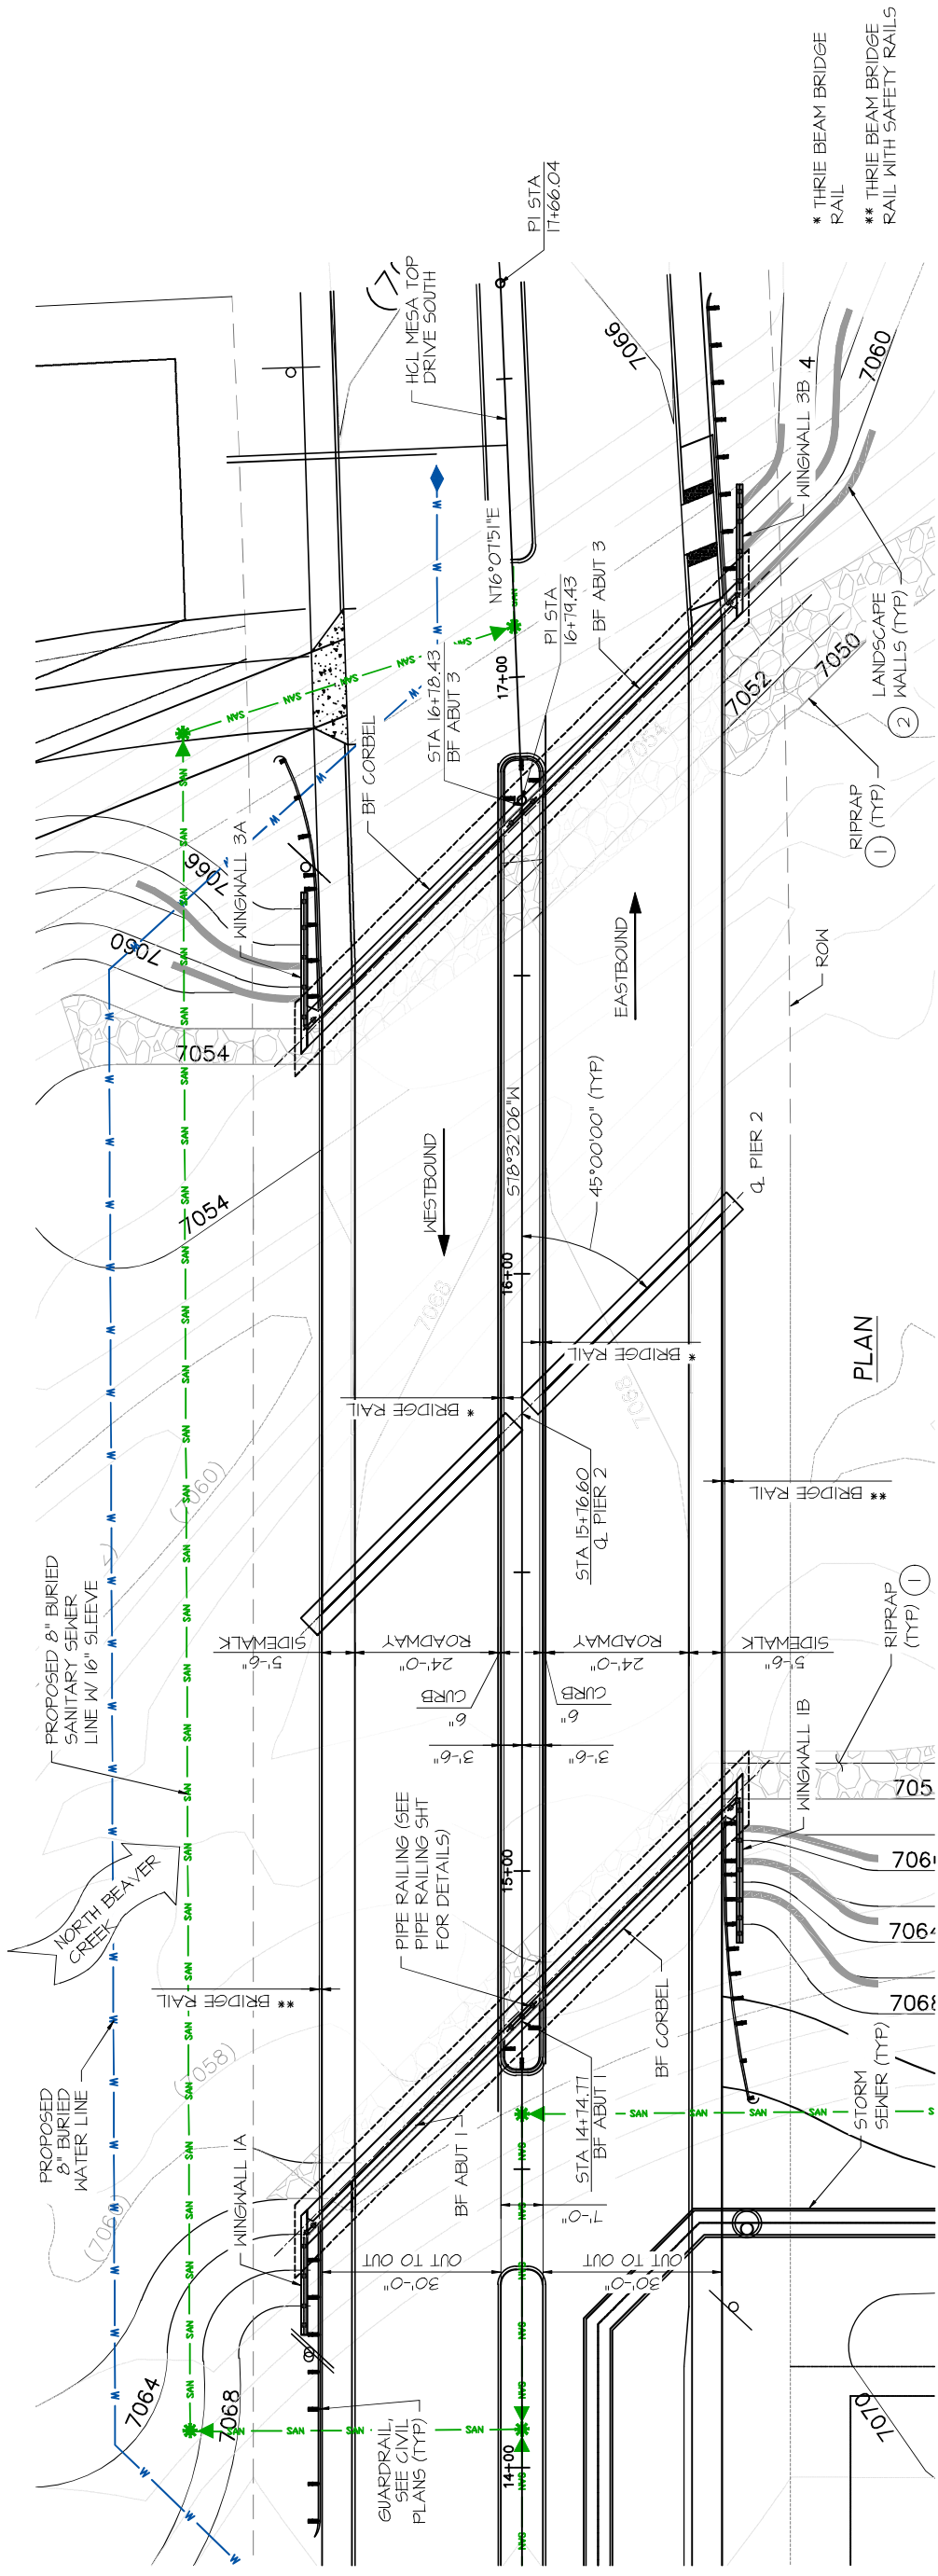








NOTES:

1. REFER TO CIVIL PLANS FOR RIPRAP LIMITS AND INFORMATION.
2. REFER TO CIVIL PLANS FOR LANDSCAPE WALL INFORMATION.
3. DIMENSIONS AND ELEVATIONS ARE BASED ON CIVIL STREET PLANS. CONTRACTOR TO VERIFY.
4. REFER TO CIVIL PLANS FOR GUARDRAIL AND MEDIAN GUARDRAIL LOCATION, LENGTHS AND DIMENSIONS.


ELEVATION

ELEVATIONS ARE AT FINISHED GRADE AT HCL
(WINGWALLS NOT SHOWN FOR CLARITY)




AS-BUILT/
CONSTRUCTED

	DESIGNED BY:		PROJECT TITLE		PROJECT LOCATION	
	DRAWN BY:		FOREST LAKES BRIDGES		MONUMENT, CO	
	PROJECT MANAGER:		GENERAL LAYOUT		STRUCT. JOB:	
	DATE:				SHEET NO.	
	7/12/22				B03	
<div><div></div><div></div></div>						
PREPARED FOR:		BY		DATE		
 		HMR		05-19-21		
		AJM		06-11-21		
		HMR		07-04-21		
REVISIONS						
1	REVISED BEARING PAID DEPTH	HMR		05-19-21		
2	REVISED LOOYR WATER	HMR		06-11-21		
3	REVISED HYDRAULIC DATA	HMR		07-04-21		
4						
5						
6						
7						

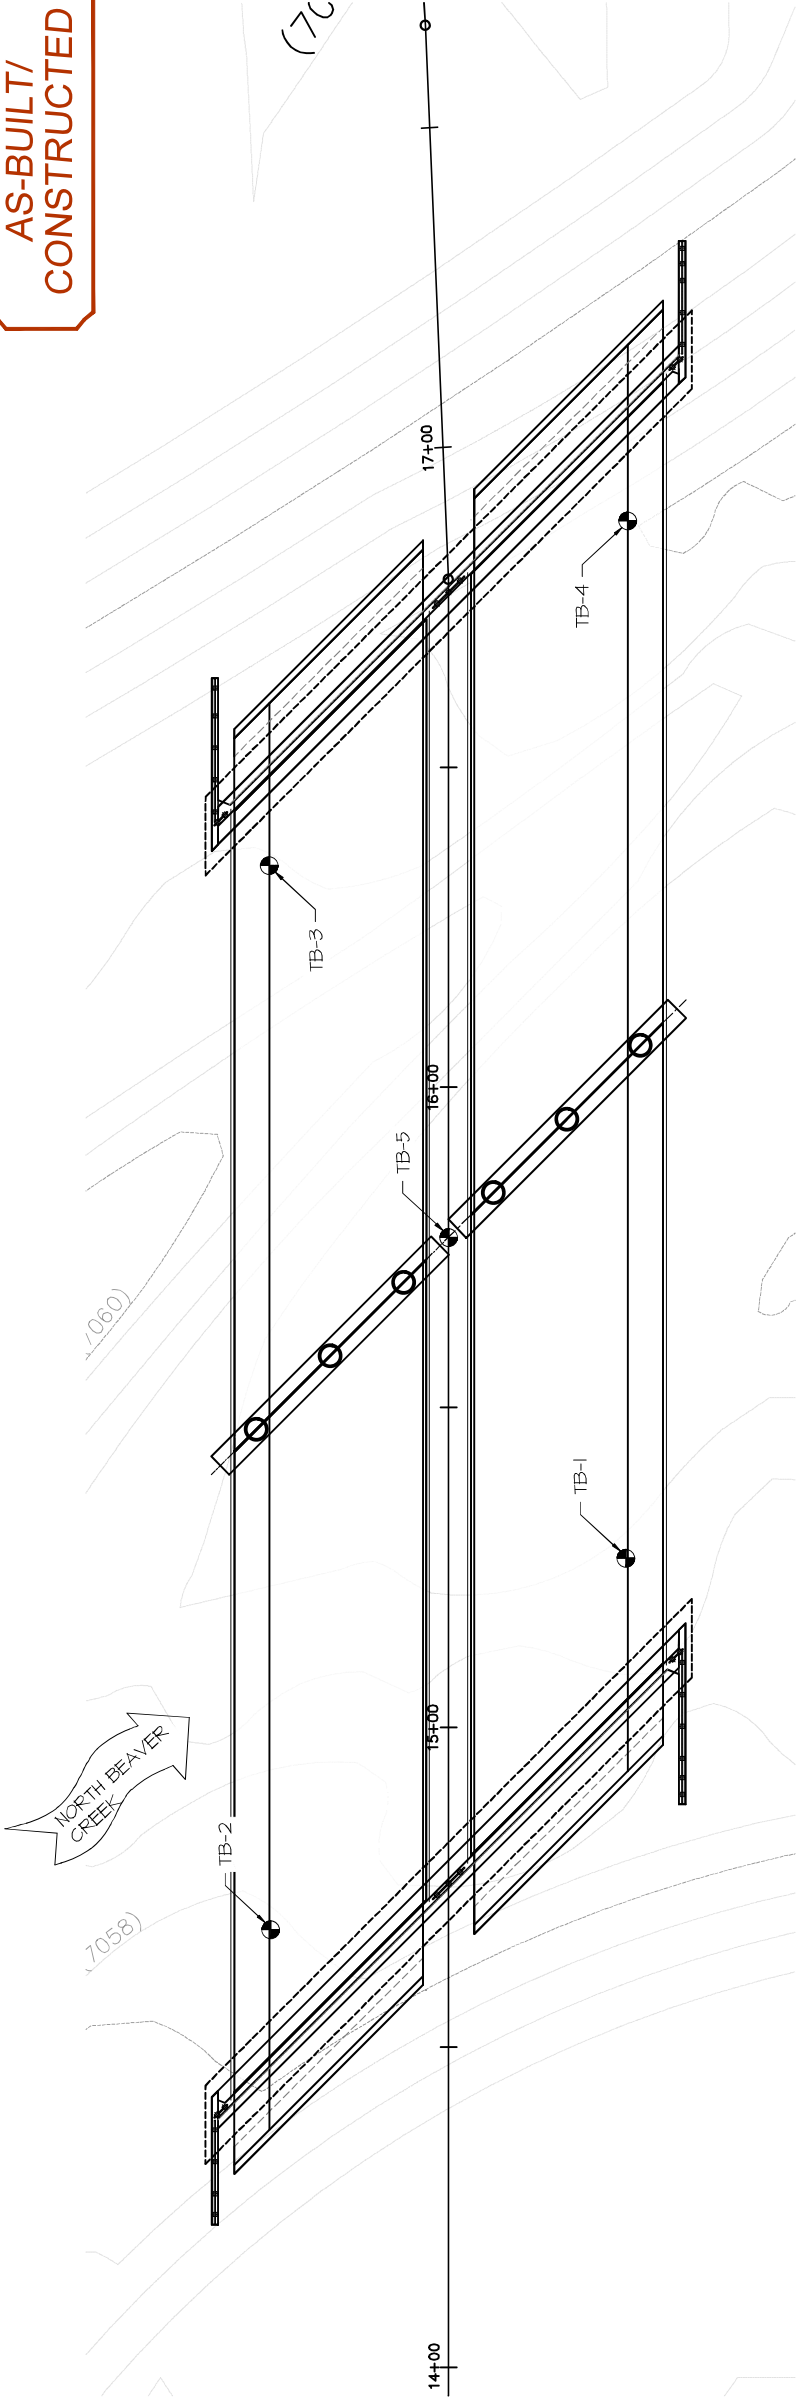


AS-BUILT/
CONSTRUCTED

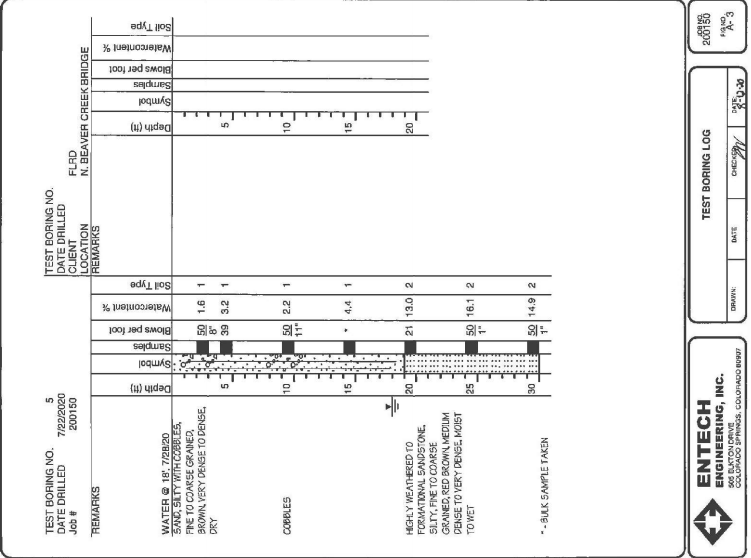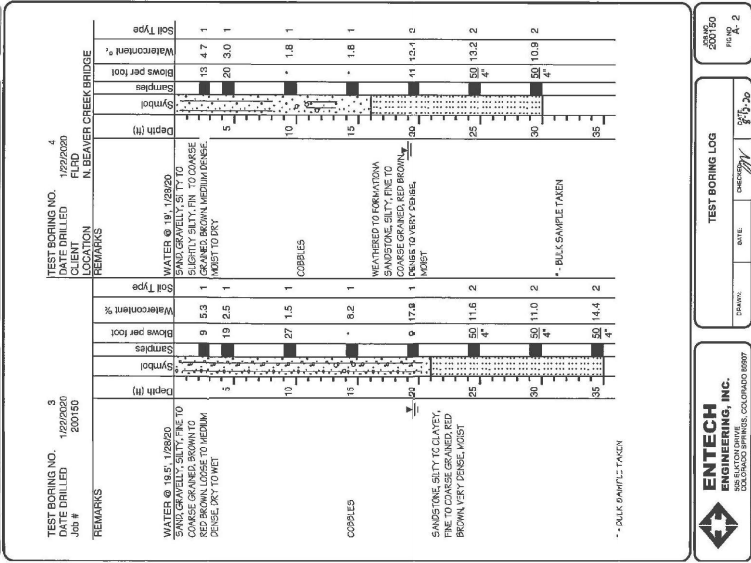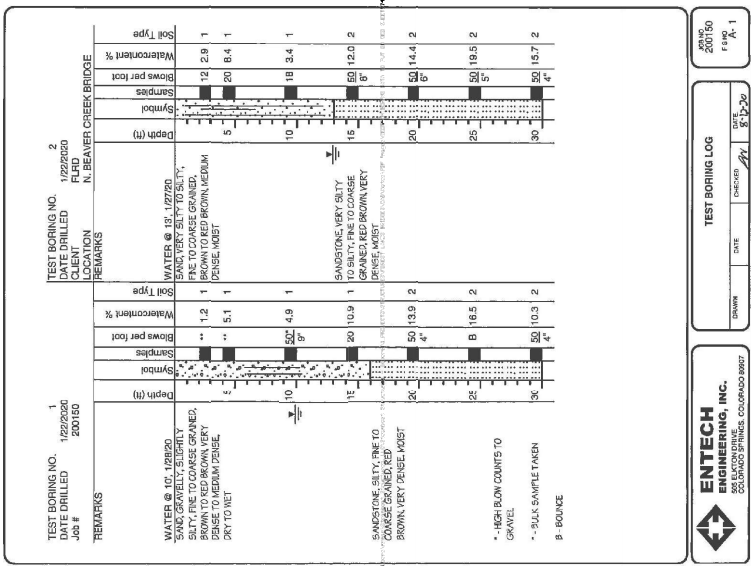

PLAN





THE GEOTECHNICAL DATA SHOWN IS PROVIDED FOR INFORMATION ONLY AND WAS PERFORMED BY ENTECH ENGINEERING, INC. ENTECH JOB NO. 200150. REFER TO THE FULL GEOTECHNICAL REPORT FOR ALL INFORMATION PERTAINING TO BRIDGE GEOTECHNICAL DATA.

<div><div>OT-12-22</div></div>	REVISIONS		PREPARED FOR:		<div></div>	DESIGNED BY: ENTECH	PROJECT TITLE FOREST LAKES BRIDGES	PROJECT LOCATION MONUMENT, CO	ENGINEERING GEOLOGY	STRUCTURE NO. B05
	1	DATE	BY	DRAWN BY: AJM						
	2			PROJECT MANAGER: HMR						
	3			DATE: 7/12/22						
	4									
	5									
	6									
	7									



07-12-22

THIS DRAWING AND/OR ANY ELECTRONIC FILE, INCLUDING THE PRINCIPLES OF DESIGN, IS THE PROPERTY OF THE ORIGINATOR OF THIS DOCUMENT AND IS LOANED TO YOU UNDER THE FOLLOWING CONDITIONS: THIS DOCUMENT AND/OR ANY ELECTRONIC FILE, INCLUDING THE PRINCIPLES OF DESIGN, IS NOT TO BE REPRODUCED, COPIED, OR LOANED IN WHOLE OR IN PART TO ANY OTHER PARTY WITHOUT THE WRITTEN PERMISSION OF THE ORIGINATOR. THE ORIGINATOR OF THIS DOCUMENT AND/OR ANY ELECTRONIC FILE, INCLUDING THE PRINCIPLES OF DESIGN, IS NOT RESPONSIBLE FOR ANY INACCURACIES OR INCOMPLETENESS. SEE THE LATEST EDITION OF THE ORIGINATOR'S DRAWING FOR THE LATEST REVISIONS.

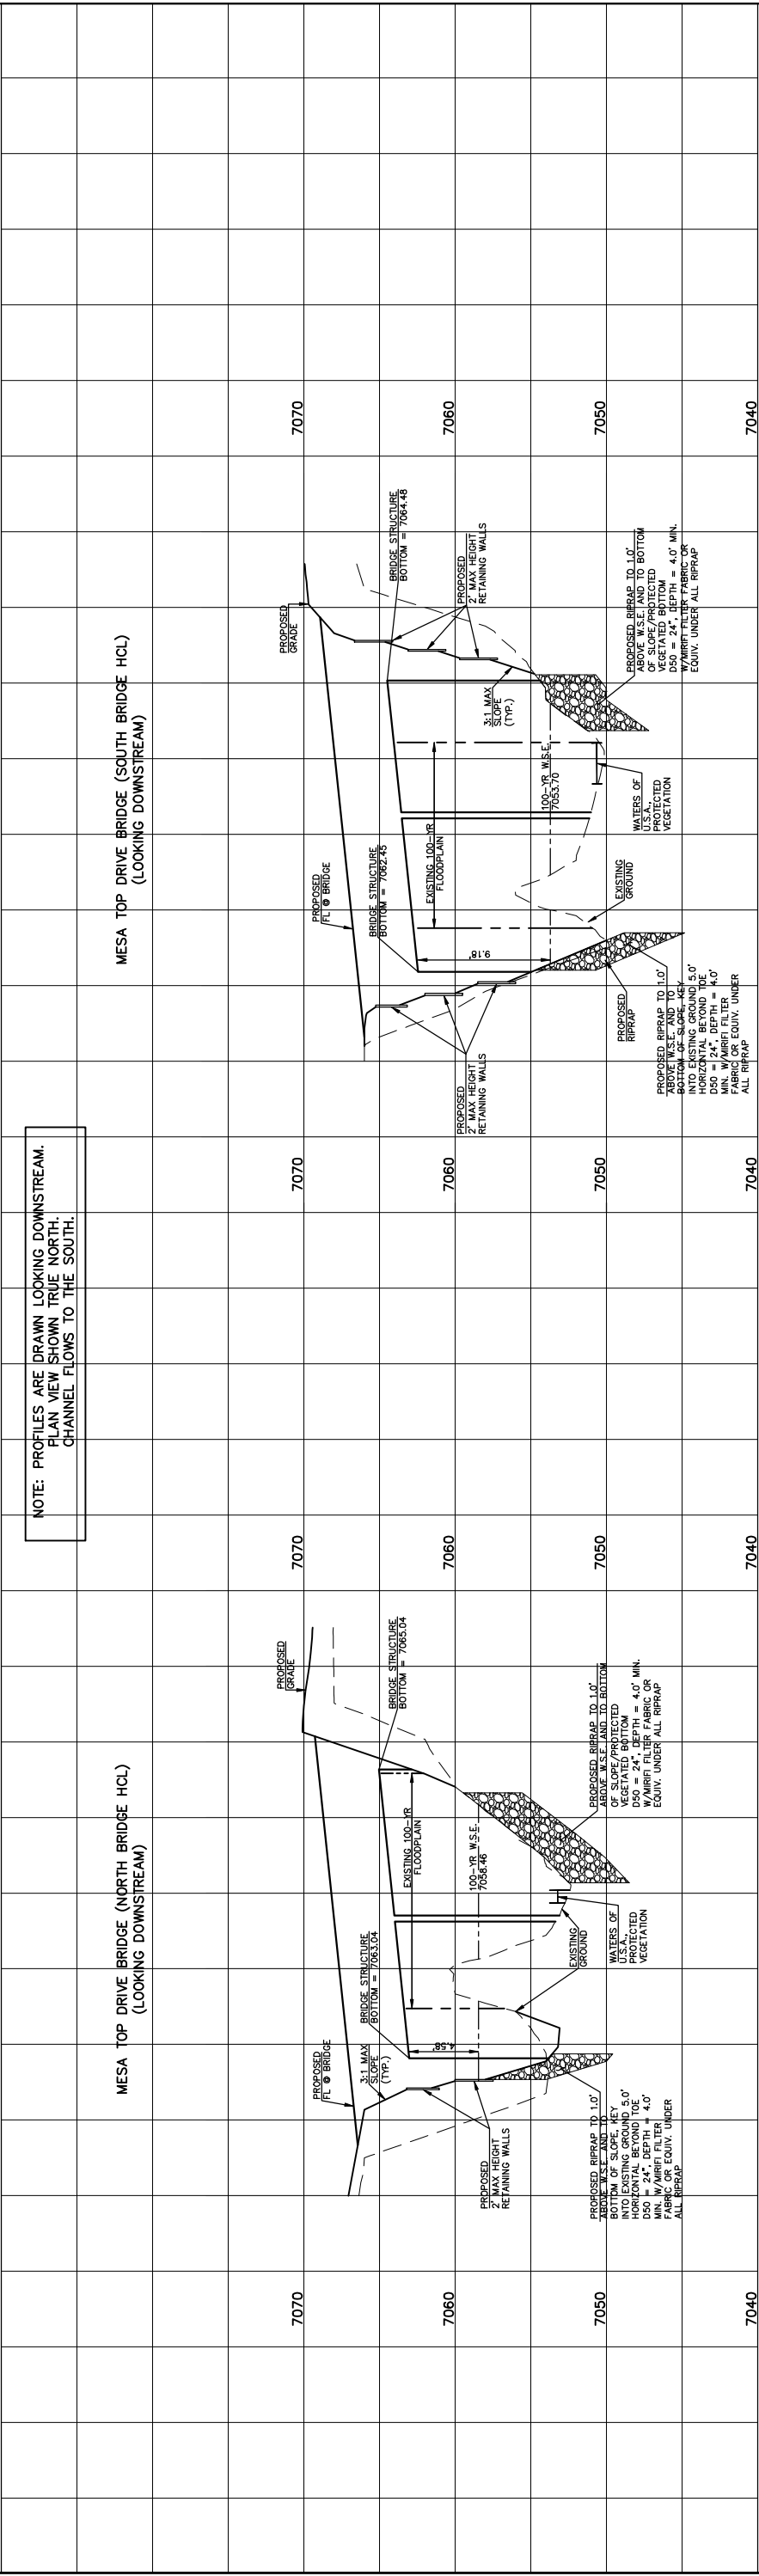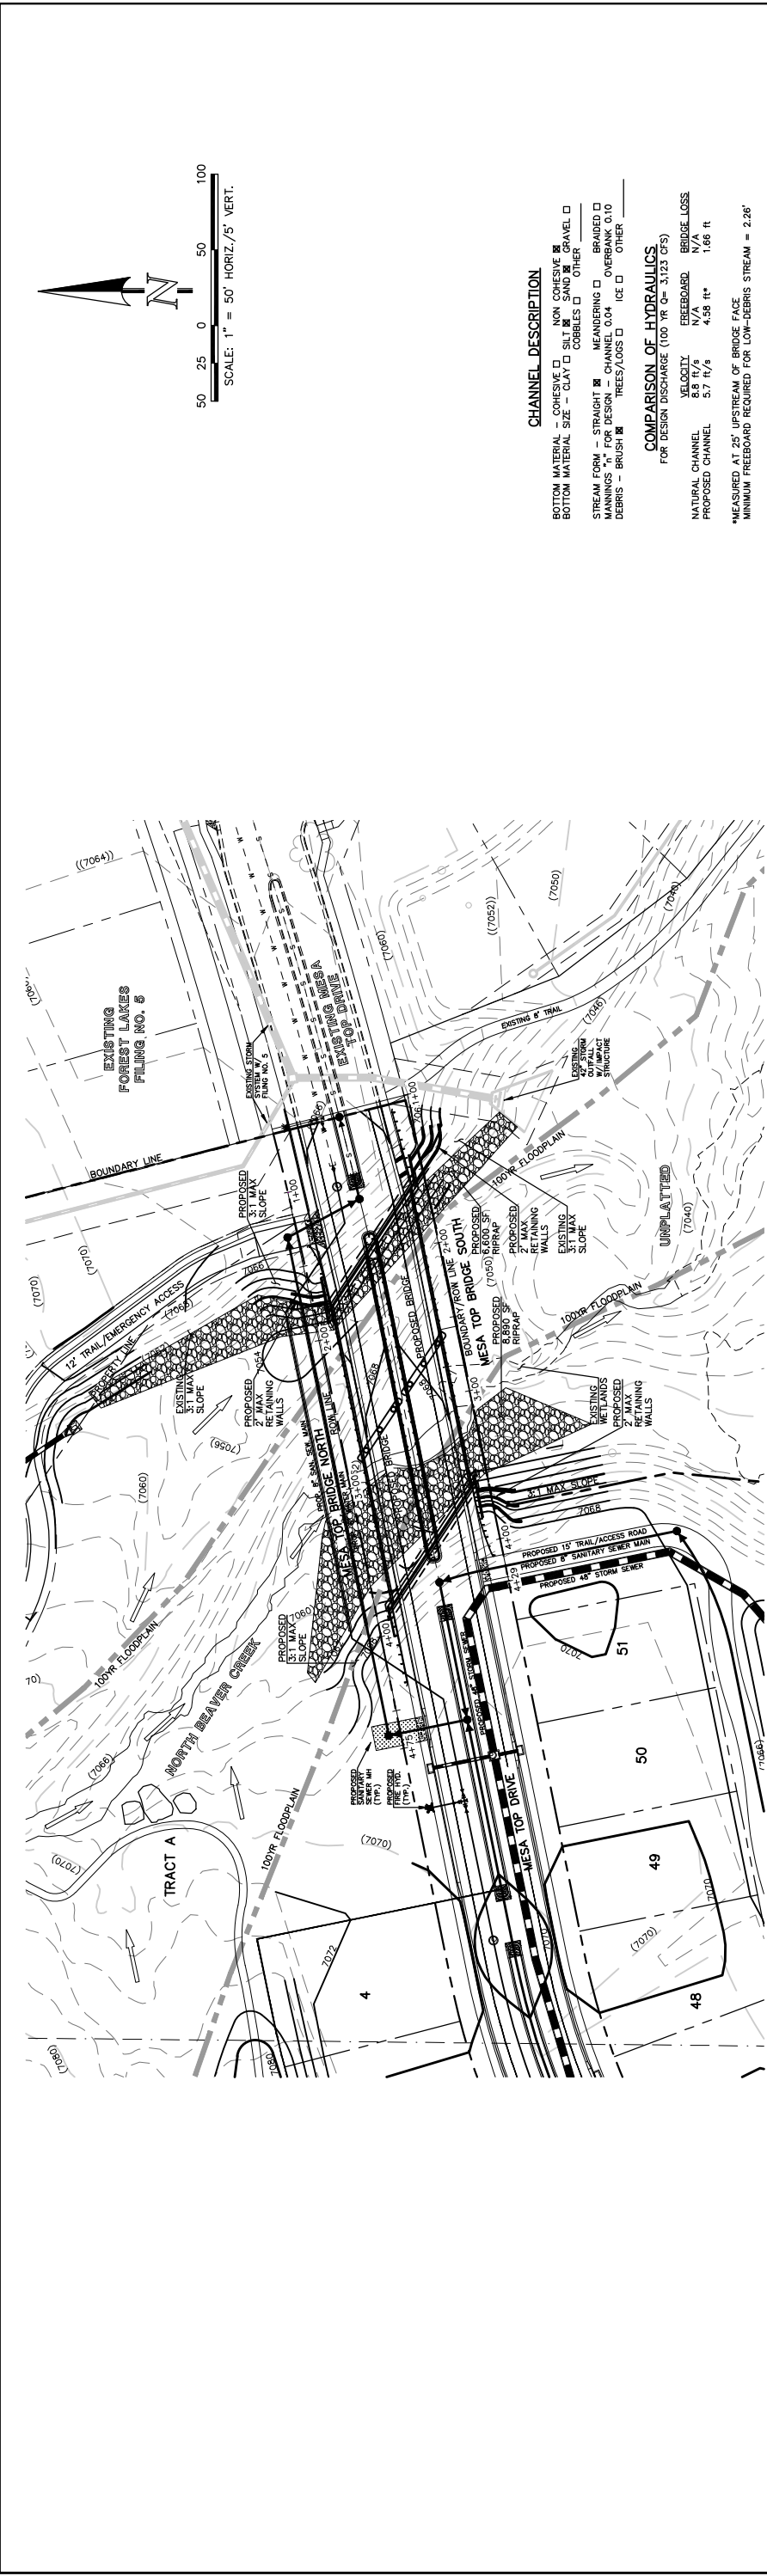

CLASSIC CONSULTING

FOREST LAKES FILING NO. 6

BRIDGE HYDRAULIC INFORMATION

MESA TOP DRIVE OVER NORTH BEAVER CREEK

DESIGNED BY

MAL

SCALE

(H) 1"= 50'

(V) 1"= 5'

DRAWN BY

MES

CHECKED BY

SHEET

1

OF

1

DATE

12/22/20

CLASSIC CONSULTING

619 N. Cascade Avenue, Suite 200

(719) 785-0790

Colorado Springs, Colorado 80903

(719) 785-0798 (fax)

REVIEW:

PREPARED UNDER MY DIRECT SUPERVISION FOR AND ON BEHALF OF

CLASSIC CONSULTING ENGINEERS AND SURVEYORS, LLC

KYLE R. CAMPBELL, COLORADO P.E. #29794

DATE

11/75.60

NO.

REVISION

DATE


48 HOURS BEFORE YOU DIG, CALL UTILITY LOCATORS

811


UTILITY NOTIFICATION CENTER OF COLORADO

IT'S THE LAW

THE LOCATIONS OF EXISTING UNDERGROUND UTILITIES ARE SHOWN IN AN APPROXIMATE WAY ONLY. THE CONTRACTOR SHALL DETERMINE THE EXACT LOCATION OF ALL EXISTING UTILITIES BEFORE COMMENCING WORK. THE CONTRACTOR SHALL PRESERVE ANY AND ALL UNDERGROUND UTILITIES. PRESERVE ANY AND ALL UNDERGROUND UTILITIES.

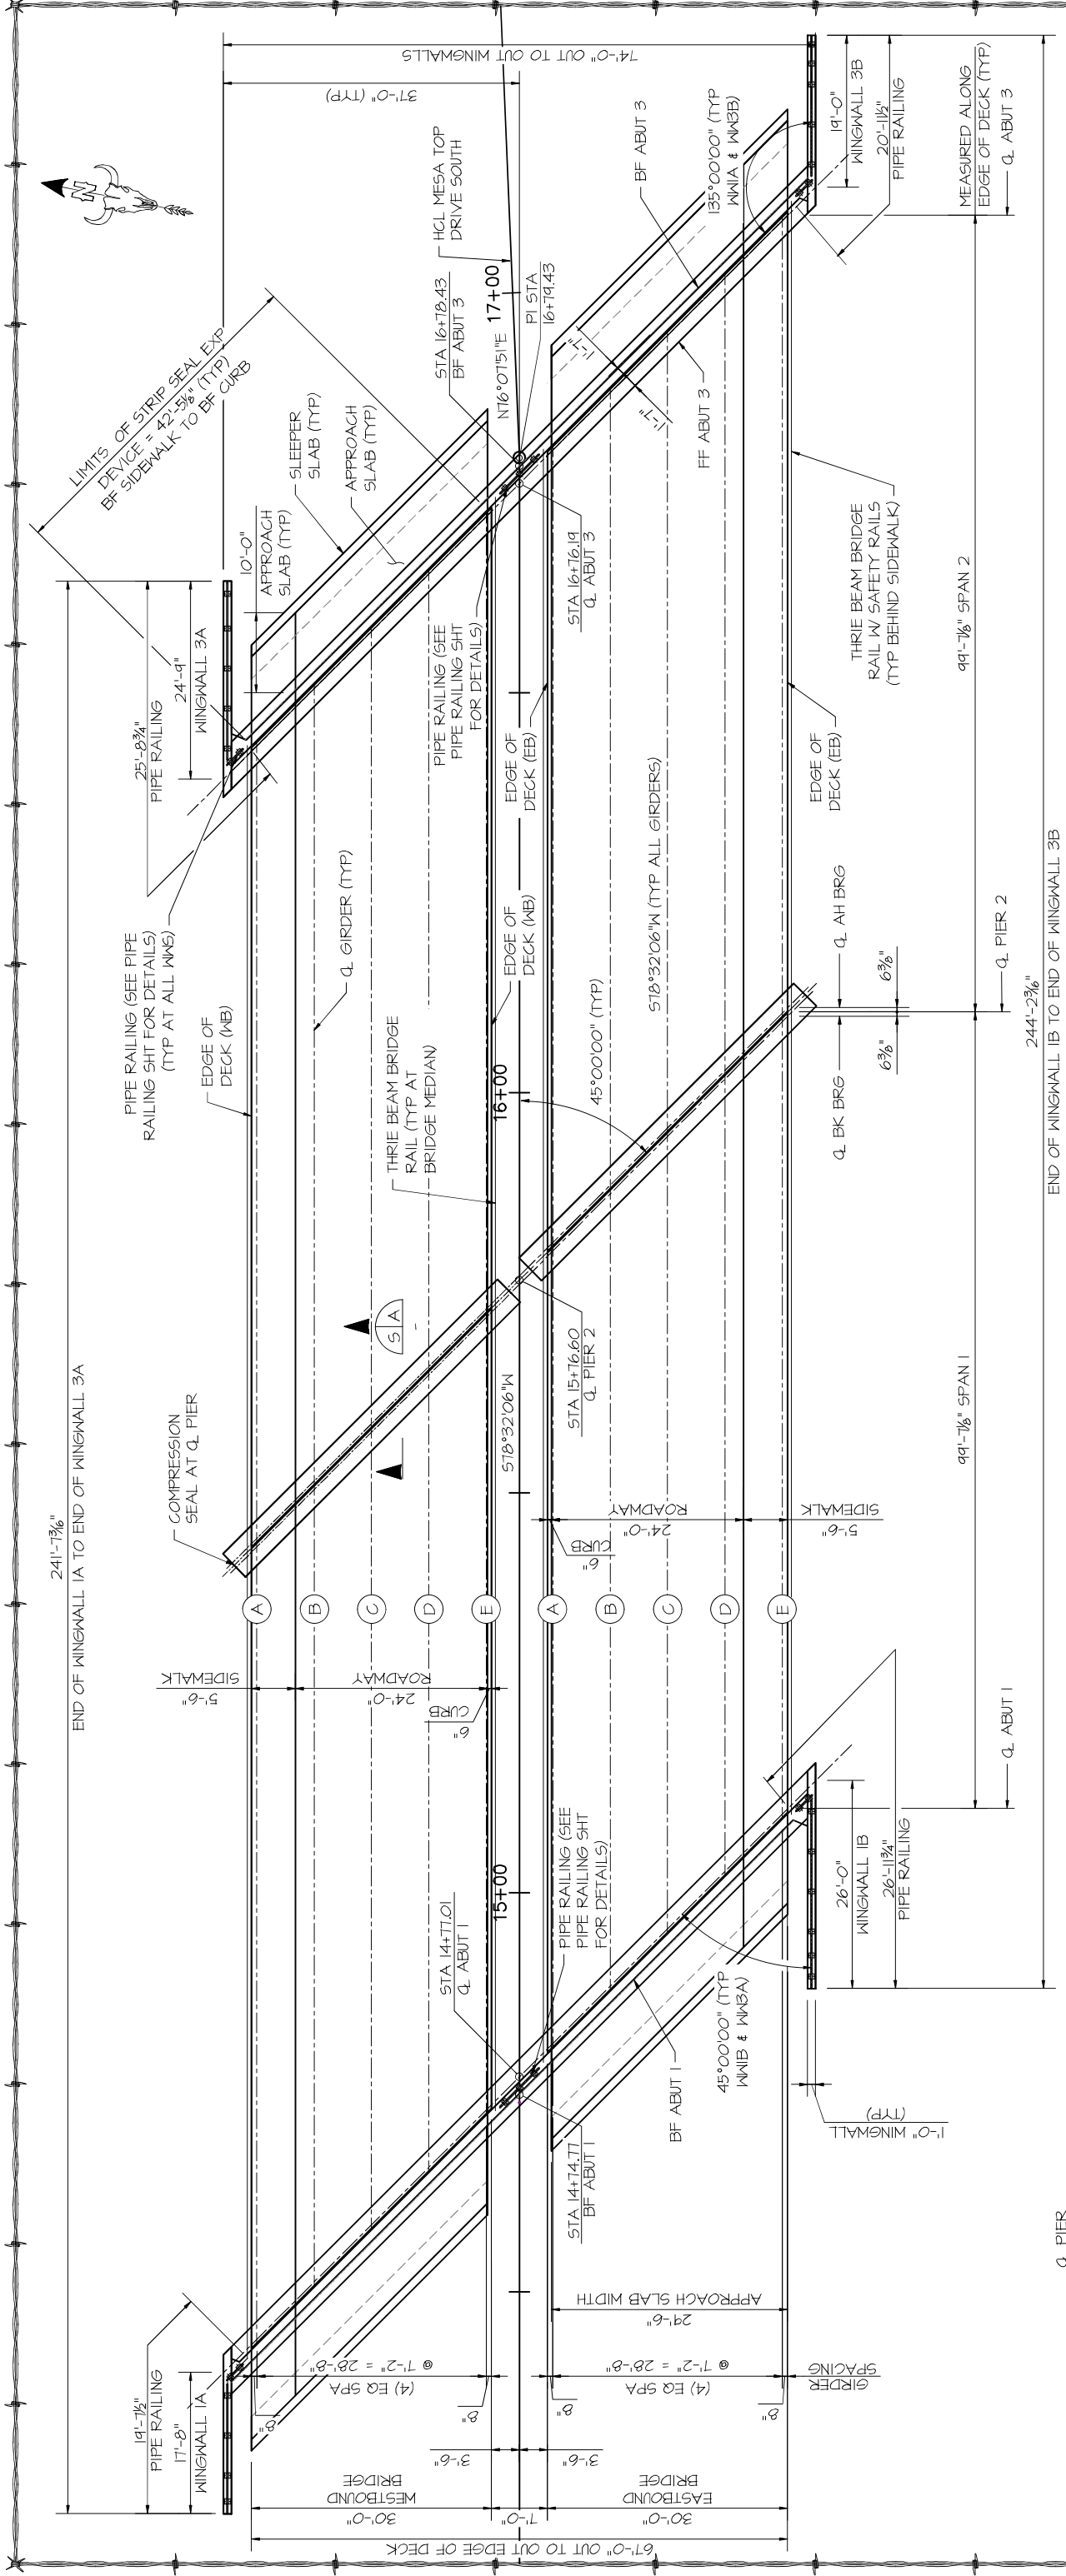

CONSTRUCTION LAYOUT

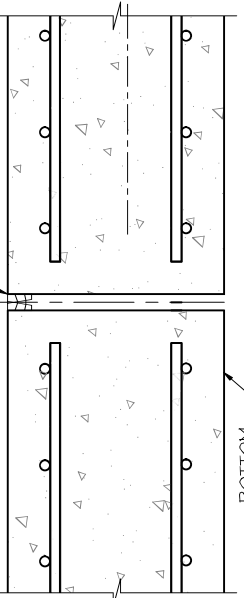

DECK JOINT SECTION (S/A)


NOTES:

- 1. REFER TO CONTECH PLANS FOR INFORMATION REGARDING ALL DIMENSIONS, BEARINGS, DIAPHRAGMS, ANCHOR BOLTS, AND BRIDGE RAIL DETAILS.
- 2. REFER TO CIVIL PLANS FOR GUARDRAIL INFORMATION AT ALL 4 OUTSIDE CORNERS & MEDIAN.

AS-BUILT/
CONSTRUCTED



07-12-22

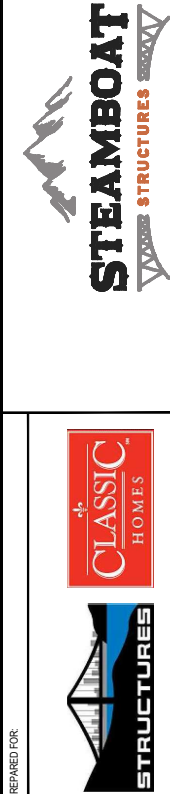

PREPARED FOR:

BY:

DATE:

REVISIONS

1 REVISED BEARING PAD DEPTH

2

3

4

5

6

7

DESIGNED BY:

HMR

DRAWN BY:

AJM

PROJECT MANAGER

HMR

DATE:

7/12/22

PROJECT TITLE

FOREST LAKES BRIDGES

PROJECT LOCATION


MONUMENT, CO

STRUCTURE:

CONSTRUCTION LAYOUT

SHEET NO.


B07

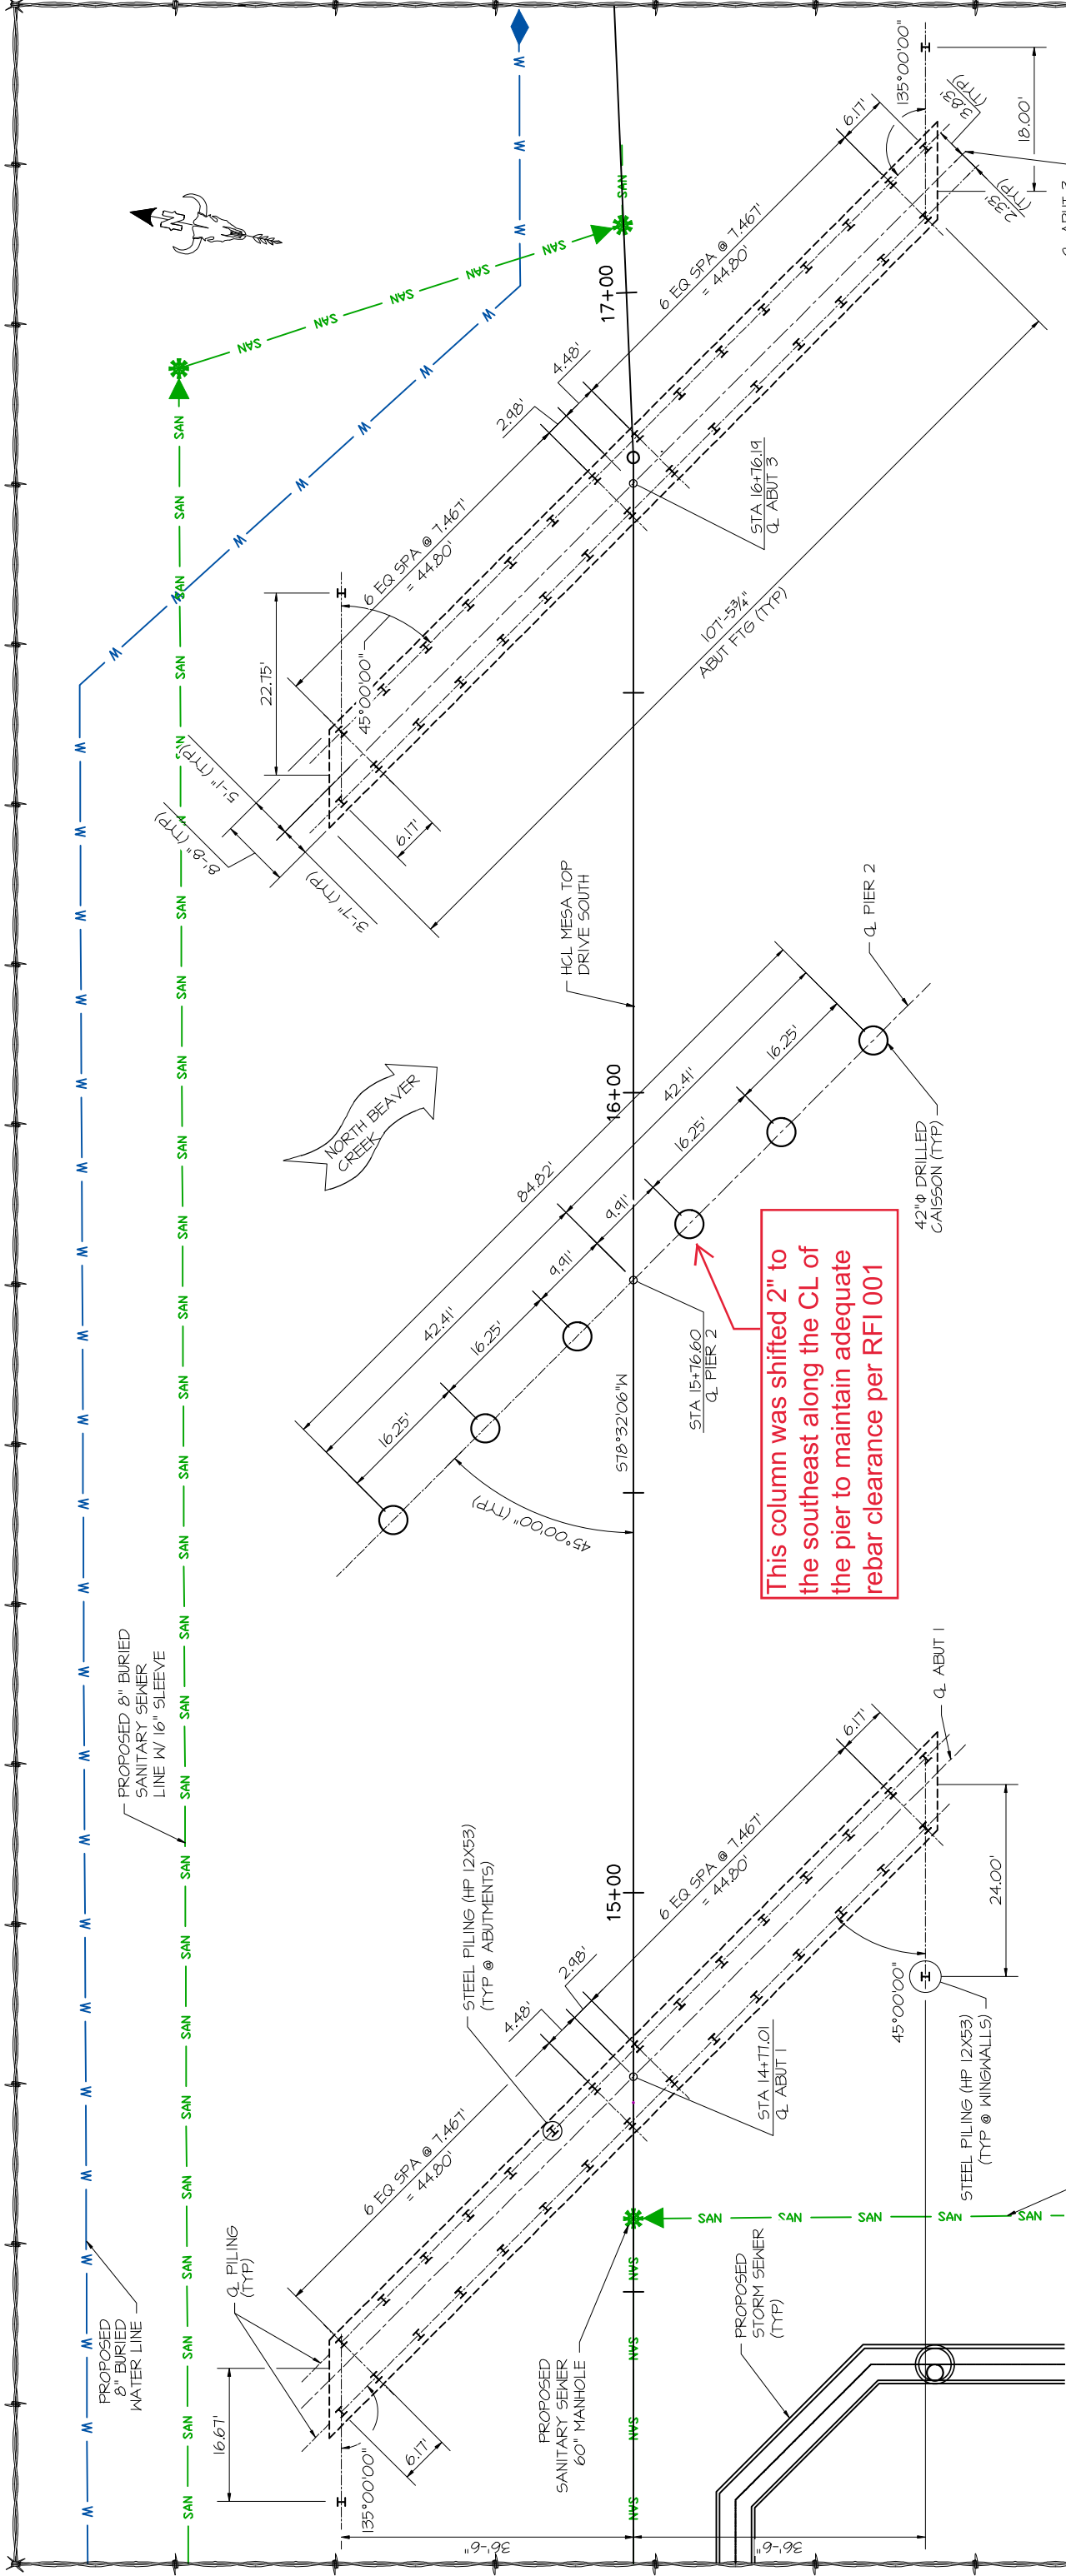

FOUNDATION LAYOUT

PILE NOTES:

- 1. PILES ARE ORIENTED SUCH THAT THE STRONG AXIS IS PARALLEL TO THE CENTERLINE OF THE ABUTMENT OR WINGWALL AS SHOWN.
- 2. PILE FIELD SPLICES, IF REQUIRED, SHALL BE MADE WITH COMPLETE JOINT PENETRATION (CJP) WELDS IN ACCORDANCE WITH CDOT STANDARD PROVISION OF SECTION 502 - EXTENSIONS AND SPLICES.
- 3. ONLY COMPLETE JOINT PENETRATION (CJP) WELDS SHALL BE USED FOR PILE SPLICES.
- 4. PILE TIP TO BE INCLUDED IN THE COST OF THE PILE.
- 5. ALL PILES ARE END BEARING AND SHALL BE DRIVEN VERTICAL.
- 6. PILE DRIVING ANALYZER (PDA) IS REQUIRED FOR THIS PROJECT. THE PDA MONITORING SHALL BE PERFORMED ON ONE PILE AT EACH ABUTMENT IN ACCORDANCE WITH SECTION 502 OF THE STANDARD SPECIFICATIONS.
- 7. ALL STEEL PILES SHALL BE AASHTO M270 GRADE 50 AND PROTECTED WITH AN APPROVED COMMERCIAL PILE TIP.
- 8. ELEVATIONS SHOWN SHALL BE VERIFIED AT TIME OF CONSTRUCTION BY THE GEOTECHNICAL ENGINEER.
- 9. AXIAL GEOTECHNICAL RESISTANCE FACTOR = 0.65.

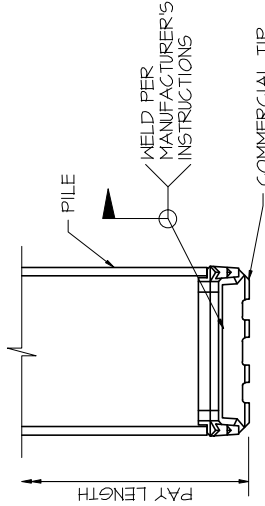


REINFORCING TIP LAYOUT

PILE SUMMARY									
	PILE SIZE	MAX LOAD (FACTORED) (KIPS)	MAX LOAD (SERVICE) (KIPS)	CUTOFF ELEVATION	ESTIMATED BEDROCK ELEV	ESTIMATED TIP ELEV	MINIMUM REQD TIP ELEV	AS-BUILT TIP ELEV*	
WINGWALL 1A	HP 12x53	28	22	7055	7045	7035	7035	7035.55	
WINGWALL 1B	HP 12x53	40	32	7055	7038	7028	7028	7032.53	
ABUTMENT 1	HP 12x53	215	158	7054	7038-7045	7028-7035	7028-7035	7031.94 - 7039.31	
WINGWALL 3A	HP 12x53	38	30	7055	7034	7024	7024	7029.29	
WINGWALL 3B	HP 12x53	29	23	7055	7038	7028	7028	7022.4	
ABUTMENT 3	HP 12x53	200	150	7054	7034-7038	7024-7028	7024-7028	7026.38 - 7030.92	

Per the pile driller, piles were embedded +/- 3' into bedrock. Piles were driven until the N count = 120 blows.

AS-BUILT/
CONSTRUCTED

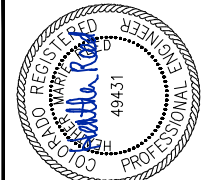

PROJECT LOCATION
MONUMENT, CO

STRUCTURE:
FOUNDATION LAYOUT

SHEET NO.
B08

DESIGNED BY:
HMR

DRAWN BY:
AJM

PROJECT MANAGER
HMR

DATE:
7/12/22

REVISIONS


NO.	DATE	BY	REVISIONS
1	05-19-21	HMR	REVISED BEARING PAD DEPTH
2			
3			
4			
5			
6			
7			

THIS DRAWING AND ANY ELECTRONIC FILES AND DATA ARE THE PROPERTY OF THE ORIGINAL DESIGNER AND SHALL BE SUBMITTED WITH THE AS-BUILT DRAWING. IT IS NOT TO BE USED IN ANY MANNER THAT MAY BE A DISRESPECT TO ITS ORIGINATOR. USE THE ELECTRONIC FILE AT YOUR OWN RISK WITH NO LIABILITY TO THE ORIGINATOR FOR ANY INACCURACIES OR INCOMPLETE FILES. USE THE AS-BUILT ORIGINAL. ALL DATA IS GRAPHICAL. UNLESS OTHERWISE NOTED, ALL DIMENSIONS ARE IN FEET AND INCHES. ACCEPTANCE OF THIS DRAWING IS AN AGREEMENT TO THE ABOVE.


CAISSON NOTES:

1. MINIMUM EMBEDMENT TO BE PROVIDED. BEDROCK ELEVATIONS MAY VARY.
2. 2" DIA CSL TUBES SHALL BE SCHEDULE 40 STEEL PIPE WITH TIGHT END CAPS. CSL TUBES SHALL BE SECURED TO REINFORCEMENT AND FILLED WITH WATER AND CAPPED PRIOR TO CONCRETE PLACEMENT.
3. CSL TESTING SHALL BE PERFORMED ON 100% OF PIER 2 CAISSONS.
4. CONTRACTOR SHALL VERIFY THAT FOUNDATION LOCATIONS DO NOT INTERFERE WITH ANY EXISTING OR PROPOSED UTILITIES.
5. ALL TIES AND VERTICAL REINFORCEMENT IN CAISSONS ARE NON-EPOXY COATED.
6. CAISSON REINFORCING SHAFT EXTEND TO FULL DEPTH OF DRILLED HOLE.
7. DRILLED CAISSON CONCRETE IS CLASS BZ.
8. MINIMUM LENGTH OF CAISSON SHALL BE 24'11" FOR EB BRIDGE, 30'56" FOR WB BRIDGE.
9. CONCRETE SHOULD BE PLACED IN THE CAISSON IMMEDIATELY AFTER DRILLING AND MUST BE PLACED THE SAME DAY THE HOLES ARE DRILLED.
10. THE MAXIMUM PERMISSIBLE VARIATION OF THE CENTER AXIS OF ANY DRILLED CAISSON AT THE TOP FROM IT'S PLANNED LOCATION SHALL BE 3 INCHES.
11. REFER TO THE GEOTECHNICAL REPORT FOR GROUND WATER AND POTENTIAL CAVING SOIL CONDITIONS. THE CONTRACTOR SHOULD BE PREPARED TO DE-WATER DRILLED CAISSONS AND TO CONSTRUCT CAISSONS WITH TEMPORARY CASINGS TO CONTROL GROUNDWATER AND MAINTAIN A STABLE OPEN EXCAVATION.
12. REFER TO THE GEOTECHNICAL REPORT FOR SHEAR RING INFORMATION AND REQUIREMENTS.
13. END BEARING & SIDE RESISTANCE FACTOR = 0.60

DRILLED CAISSON SUMMARY			
	WESTBOUND PIER CAISSONS	EASTBOUND PIER CAISSONS	
MAX FACTORED AXIAL	740	740	740
MAX SERVICE AXIAL	502	502	502
TOP OF CAISSON	7049.06	7048.41	7048.41
ESTIMATED BEDROCK ELEV	7032.50	7032.59	7032.59
MIN BEDROCK PENETRATION	14.0'	14.0'	14.0'
ESTIMATED TIP ELEV	7018.50	7018.50	7018.50
SCOUR ELEV	7047.76	7047.76	7047.76
AS-BUILT BEDROCK ELEV	7031.7-7032.4	7032.3-7032.8	7032.3-7032.8
AS-BUILT TIP ELEV	7017-7017.5	7018.1-7018.4	7018.1-7018.4

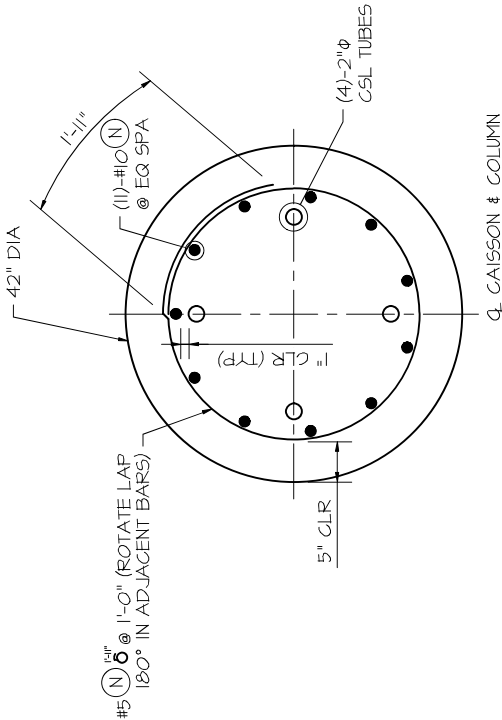

CAISSON SECTION S A

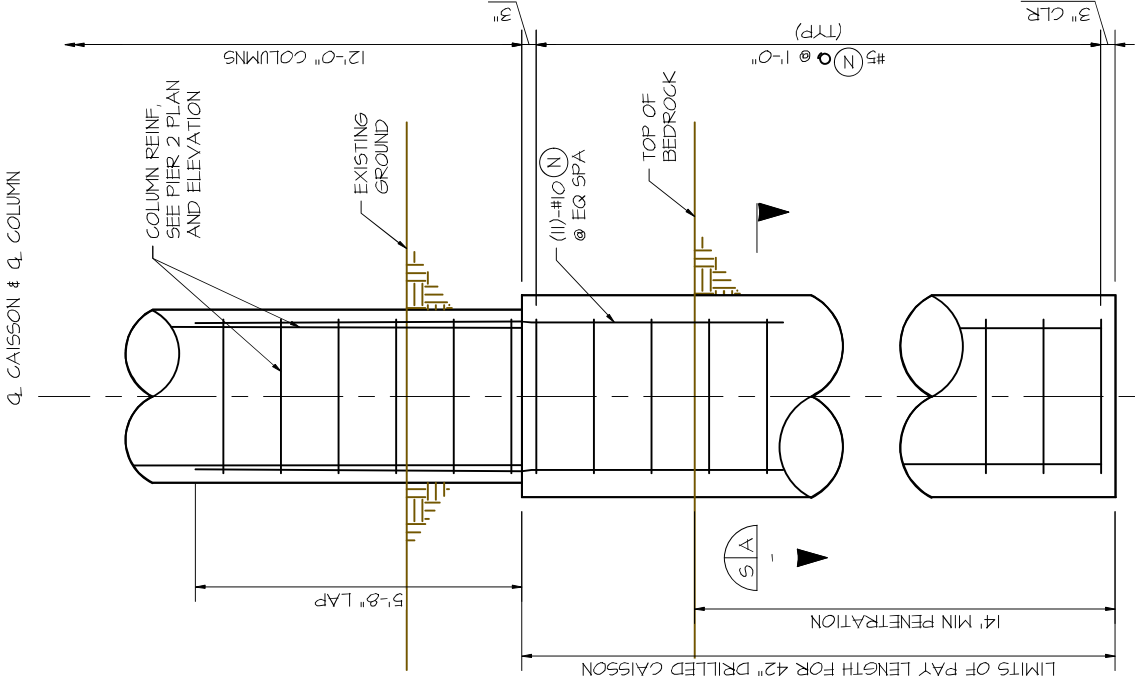


CAISSON ELEVATION

AS-BUILT/
CONSTRUCTED


DESIGNED BY: HMR		PROJECT TITLE FOREST LAKES BRIDGES		PROJECT LOCATION MONUMENT, CO	
DRAWN BY: AJM		CAISSON DETAILS			
PROJECT MANAGER: HMR					
DATE: 7/12/22					
				STRUCTURE: B09	



07-12-22

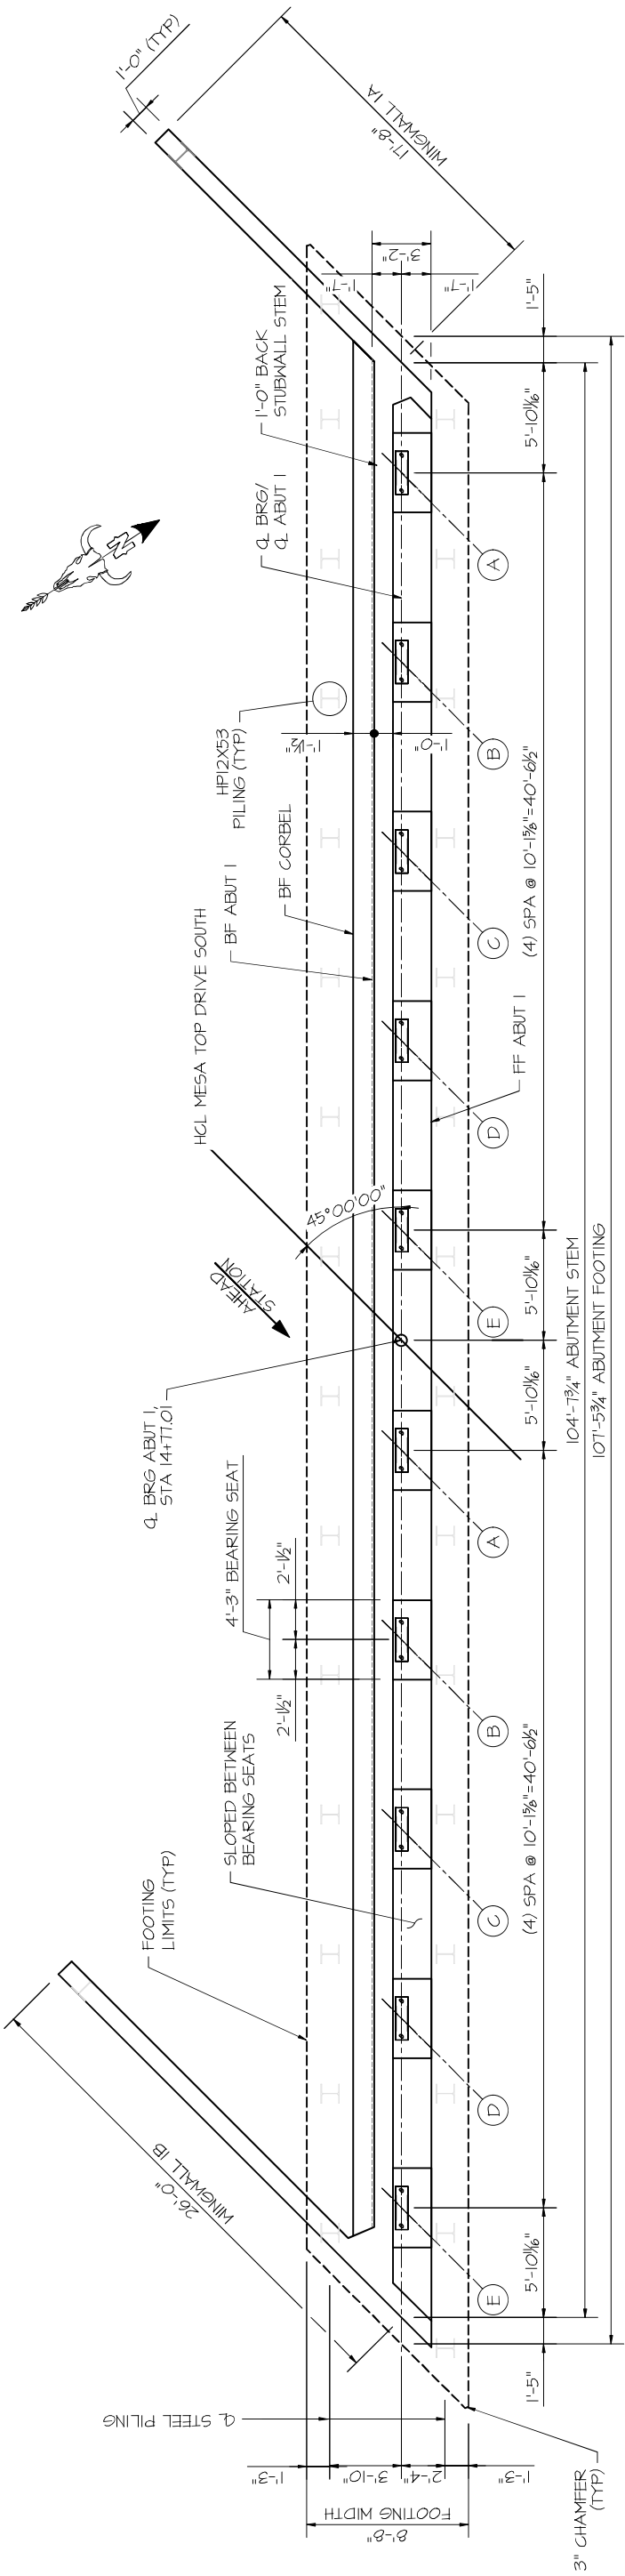

PLAN

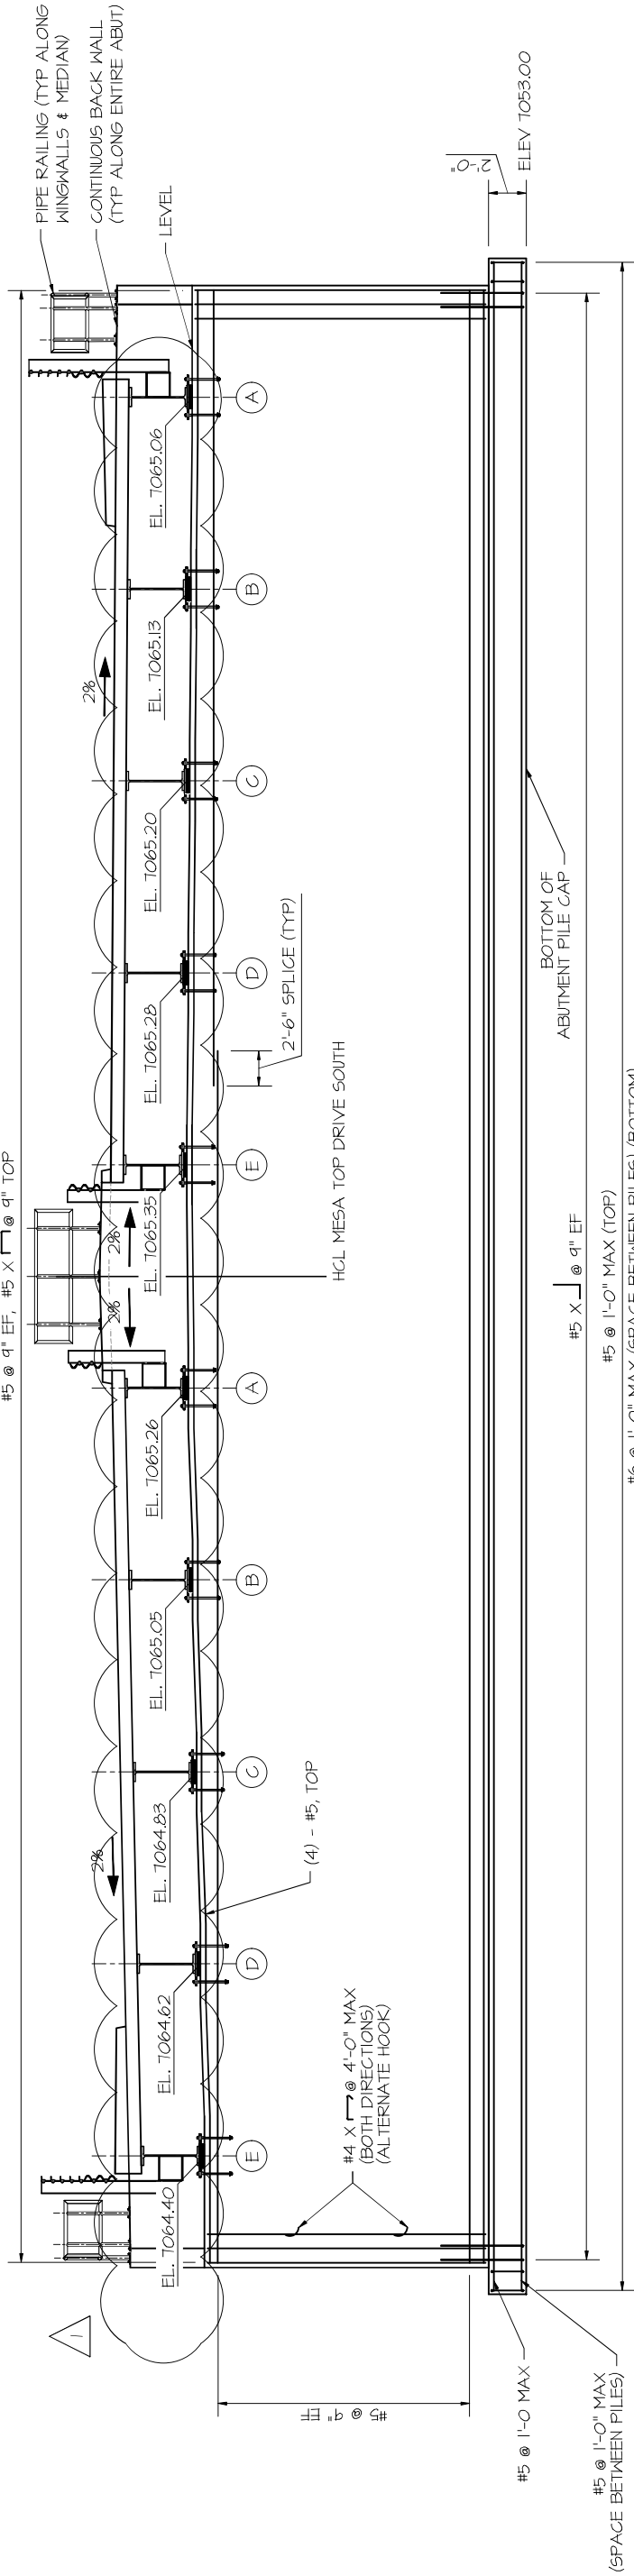

NOTES:

1. REFER TO CONTECH'S PLANS FOR SUPERSTRUCTURE DIMENSIONS AND DETAILS. SUPERSTRUCTURE SHOWN FOR INFORMATION ONLY.
2. ABUTMENT SHALL BE CONCRETE CLASS D (BRIDGE).
3. SEAT ELEVATIONS ARE PROVIDED ON THE CONTECH PLANS. SEAT ELEVATIONS ARE AT CENTERLINE OF BEARING AND CENTERLINE OF GIRDER AT TOP OF CONCRETE. THERE ARE 2 ANCHOR BOLTS PER GIRDER BEARING PLATE. TOTAL 20 ANCHOR BOLTS FOR ABUTMENT 1.

AS-BUILT/
CONSTRUCTED

ELEVATION
(H-PILES NOT SHOWN FOR CLARITY)
(LOOKING BACK STATION)



07-12-22

THIS DRAWING (AND ANY AND ALL ELECTRONIC FILES AND ANY AND ALL INFORMATION CONTAINED THEREIN) IS THE PROPERTY OF THE OPERATOR OF THIS DOCUMENT AND IS LOANED TO YOU BY THE OPERATOR. IT IS NOT TO BE USED IN ANY MANNER THAT MAY BE A VIOLATION OF ANY APPLICABLE LAW, RULE, OR REGULATION. IT IS NOT TO BE REPRODUCED, COPIED, OR LENT. IN PART OR WHOLE. IT IS NOT TO BE USED IN ANY MANNER THAT MAY BE A VIOLATION OF ANY APPLICABLE LAW, RULE, OR REGULATION. USE THE ELECTRONIC FILE AT YOUR OWN RISK WITH NO LIABILITY TO THE OPERATOR FOR ANY INACCURACIES OR INCOMPLETIONS. SEE THE LATEST ORIGINAL. ALL DATA IS GRAPHICAL IN NATURE AND IS FOR INFORMATION PURPOSES ONLY. ALL DIMENSIONS, SLOPES, ELEVATIONS WERE DERIVED FROM OTHER SOURCES. ACCEPTANCE OF THE DRAWING IS AN AGREEMENT TO THE ABOVE.



DESIGNED BY:	HMR
DRAWN BY:	AJM
PROJECT MANAGER:	HMR
DATE:	7/12/22



PROJECT TITLE
FOREST LAKES BRIDGES

PROJECT LOCATION
MONUMENT, CO

ABUTMENT 1 PLAN AND ELEVATION

SHEET NO.

B10

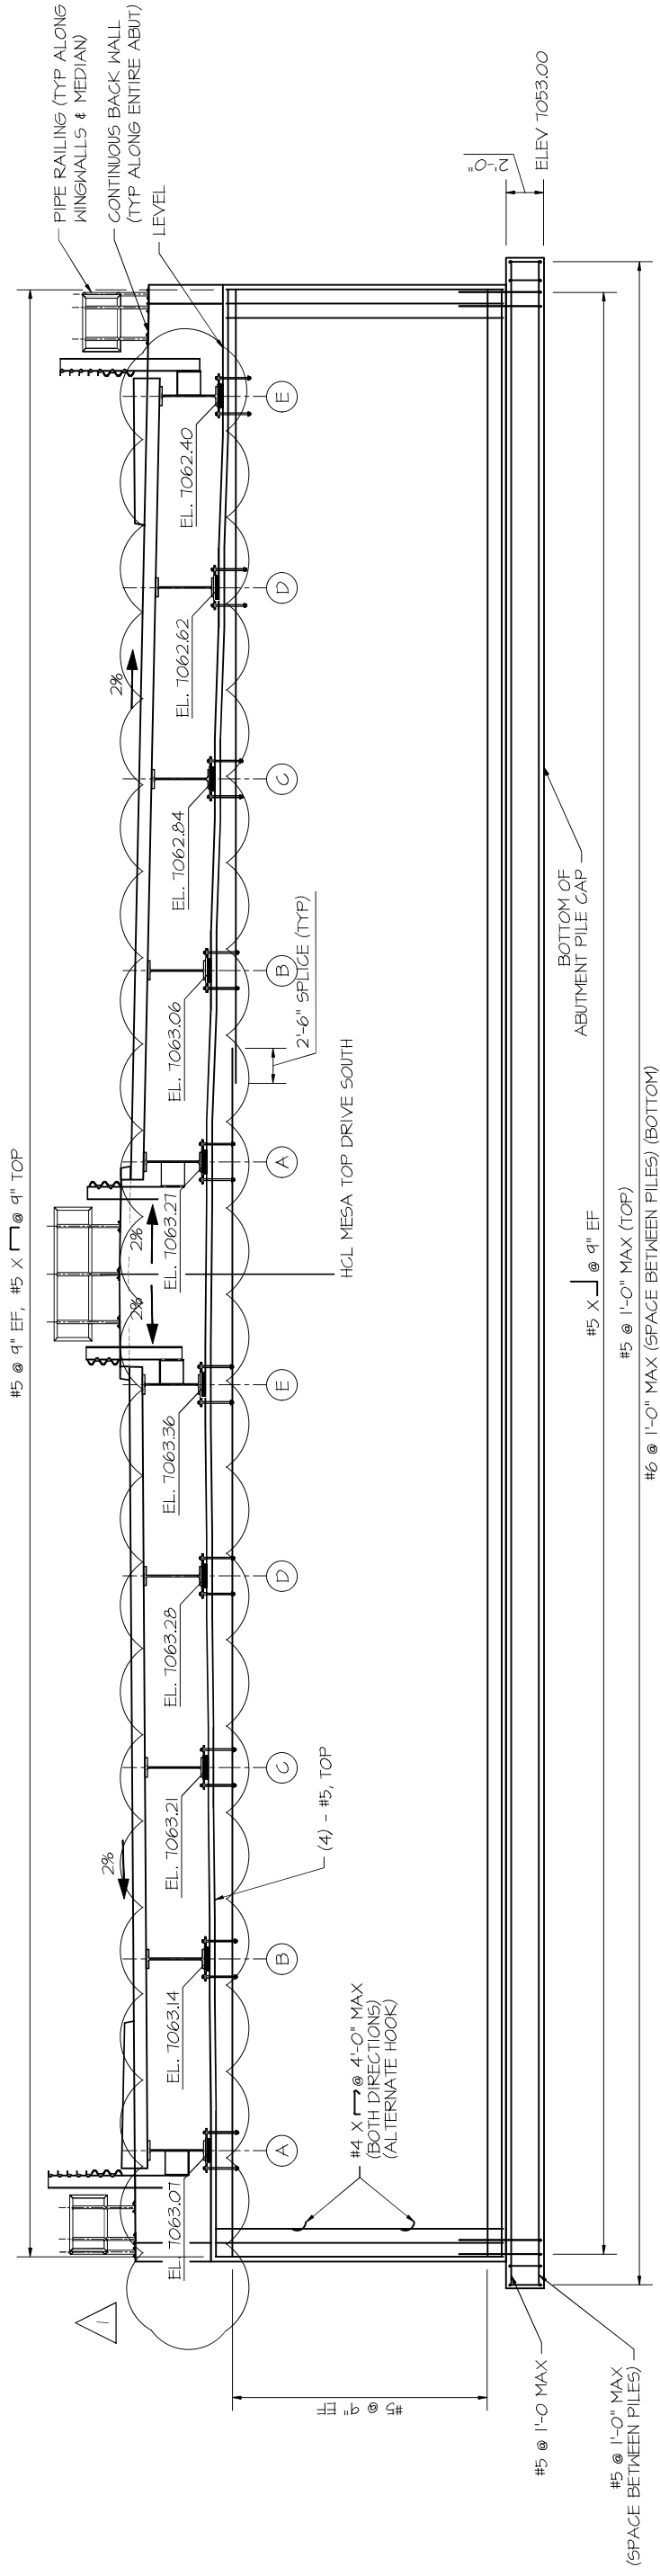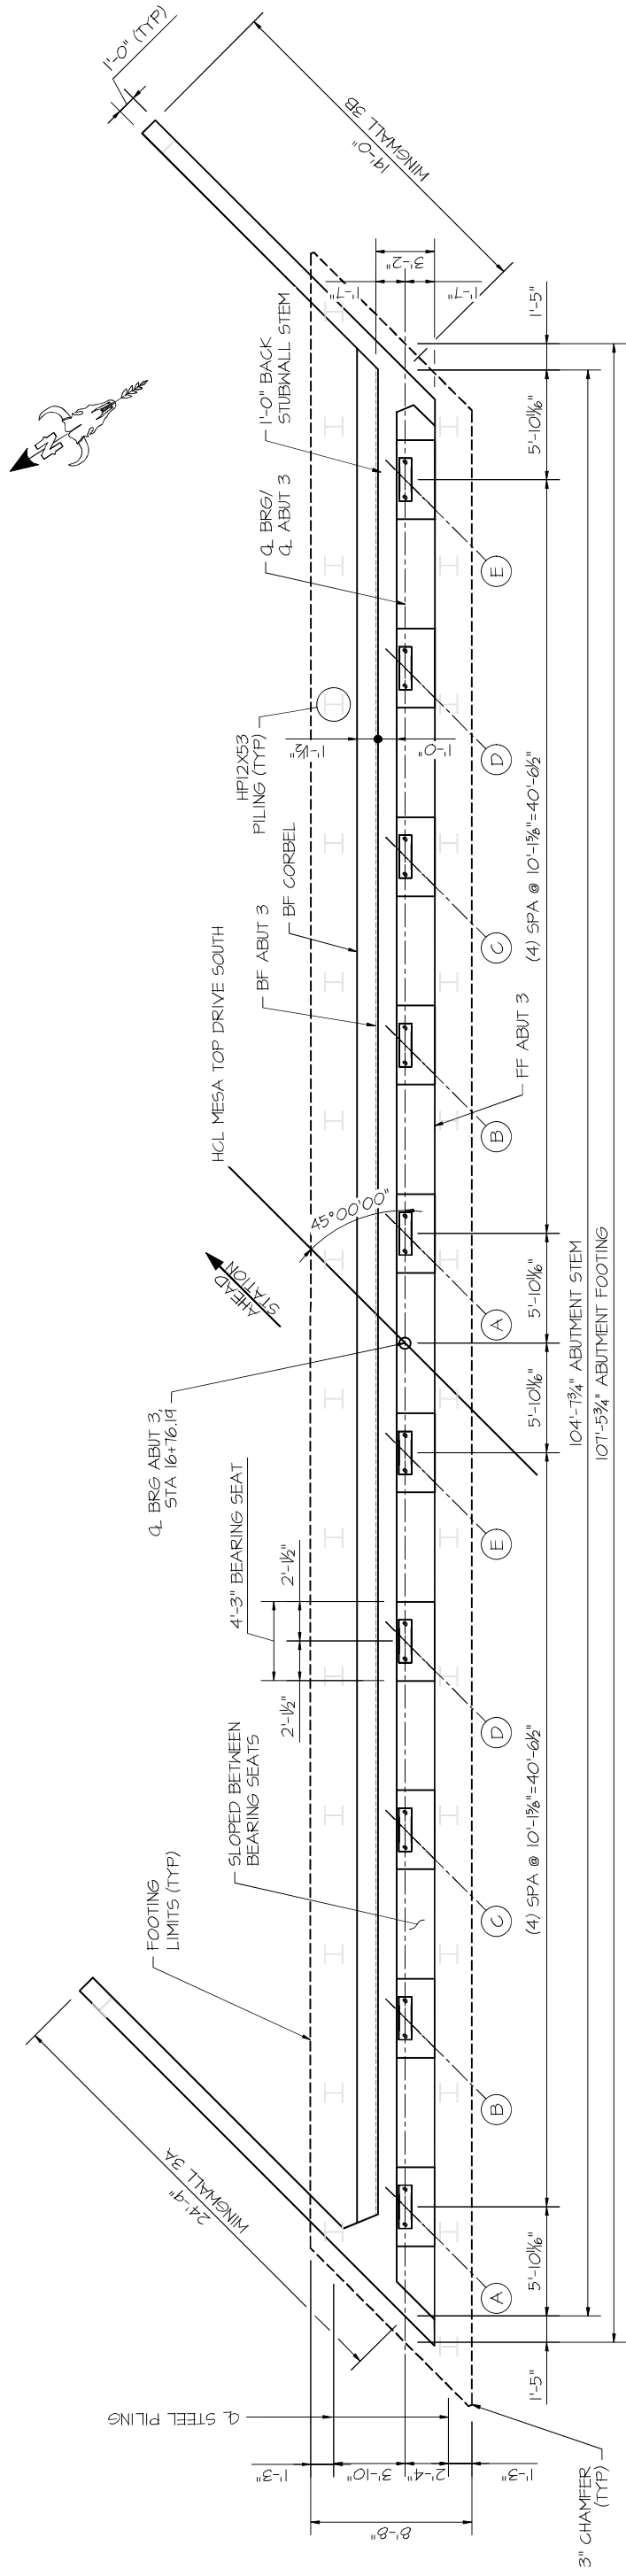


 






NOTES:

1. REFER TO CONTECH'S PLANS FOR SUPERSTRUCTURE DIMENSIONS AND DETAILS. SUPERSTRUCTURE SHOWN FOR INFORMATION ONLY.
2. ABUTMENT SHALL BE CONCRETE CLASS D (BRIDGE).
3. SEAT ELEVATIONS ARE PROVIDED ON THE CONTECH PLANS. SEAT ELEVATIONS ARE AT CENTERLINE OF BEARING AND CENTERLINE OF GIRDER AT TOP OF CONCRETE. THERE ARE 2 ANCHOR BOLTS PER GIRDER BEARING PLATE. TOTAL 20 ANCHOR BOLTS FOR ABUTMENT 3.
- 4.

ELEVATION

(H-PILES NOT SHOWN FOR CLARITY)
(LOOKING AHEAD STATION)

	REVISIONS		DATE	BY	PREPARED FOR	 STEAMBOAT STRUCTURES		 STEAMBOAT STRUCTURES
	1	REVISED BEARING PAD DEPTH	05-19-21	HMR				
	2							
	3							
	4							
5								
6								
7								
DESIGNED BY:		HMR	PROJECT TITLE			PROJECT LOCATION		
DRAWN BY:		AJM	FOREST LAKES BRIDGES			MONUMENT, CO		
PROJECT MANAGER:		HMR				STRUCTURE JOB:		
DATE:		7/12/22				SHEET NO.		
ABUTMENT 3 PLAN AND ELEVATION								
B11								

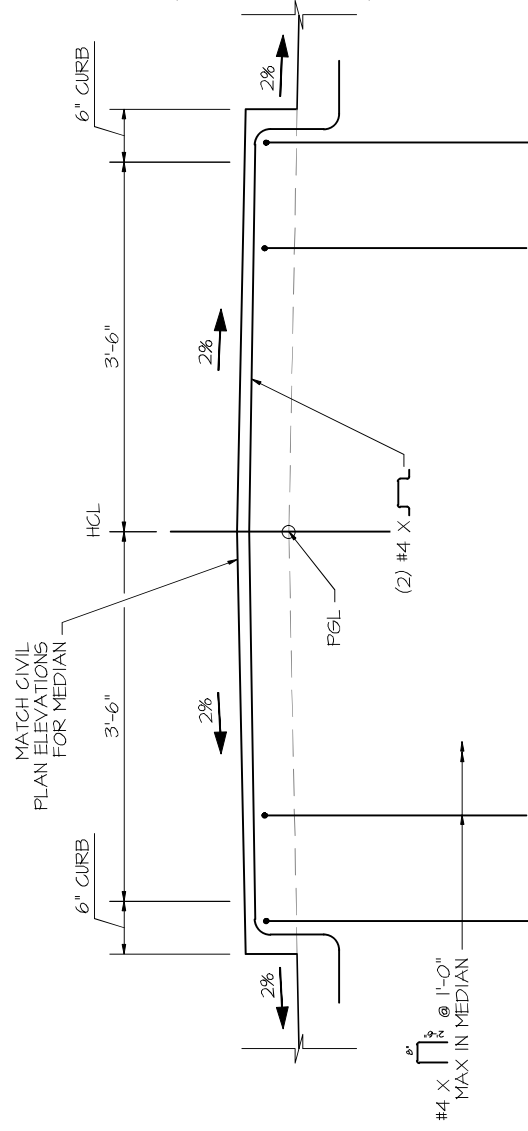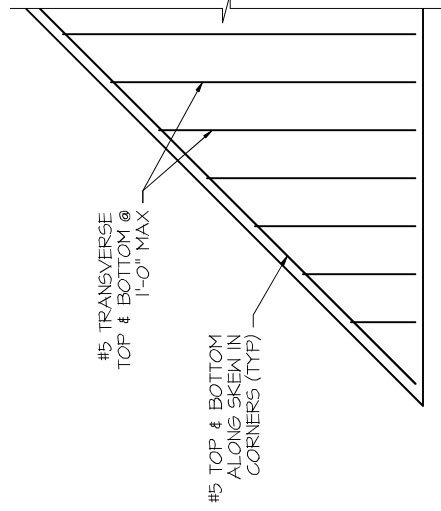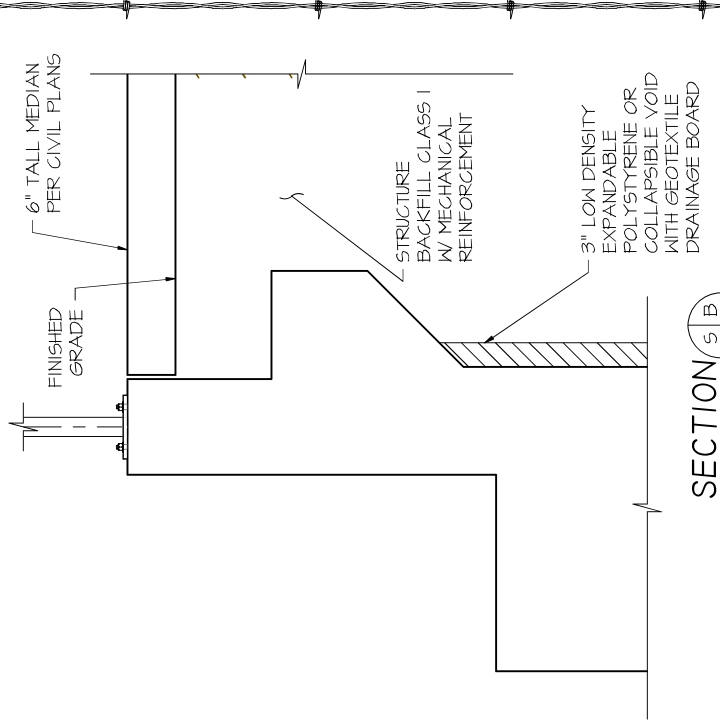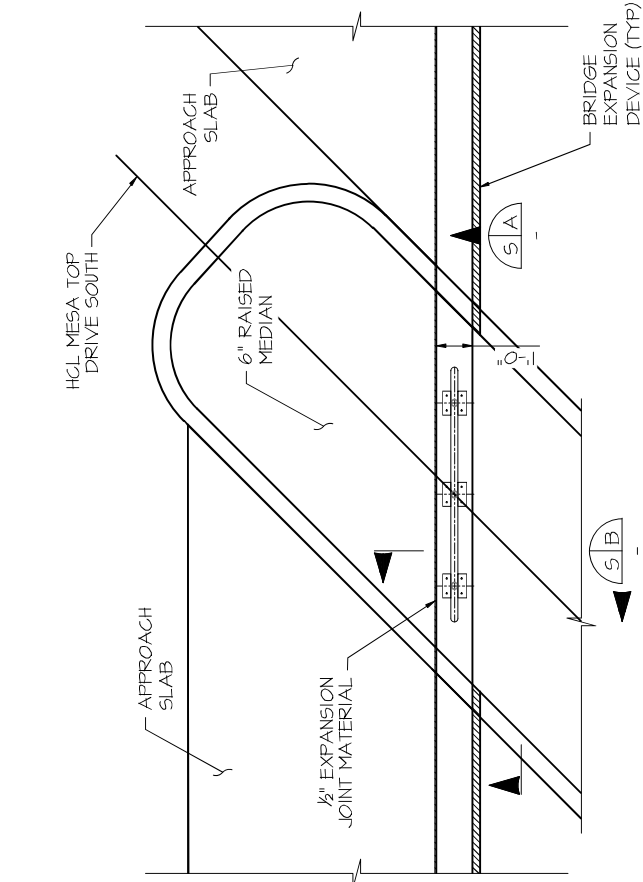


FOOTING ACUTE CORNER PLAN

MEDIAN BACK STUBWALL ELEVATION

TYPICAL ABUTMENT SECTION

NOTES:

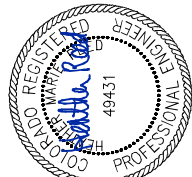

- I. SLOPE TOP OF BEARING SEAT TOWARDS FRONT FACE AT 2% BETWEEN BEARING SEATS.



07-12-22




REVISED		DATE	BY	PREPARED FOR
1	REVISED BEARING PAD DEPTH	05-19-21	JHR	
2				
3				
4				
5				
6				
7				

DESIGNED BY: HMR		PROJECT TITLE FOREST LAKES BRIDGES	PROJECT LOCATION MONUMENT, CO
DRAWN BY: AJM			
PROJECT MANAGER HMR		ABUTMENT DETAILS	STRUCT LOGS
DATE: 7/12/22			SHEET NO. B12

THIS DRAWING (AND COPY OR ELECTRONIC FILE), INCLUDING THE PRINCIPLES OF DESIGN, IS THE PROPERTY OF THE ORIGINATOR OF THIS DOCUMENT AND IS SUBMITTED WITH THE AGREEMENT THAT IT IS NOT TO BE ALTERED, REPRODUCED, COPIED OR LOANED, IN PART OR WHOLE. IT IS NOT TO BE USED IN ANY MANNER THAT MAY BE A DETRIMENT TO ITS ORIGINATOR. USE THIS ELECTRONIC FILE AT YOUR OWN RISK WITH NO LIABILITY TO THE ORIGINATOR FOR ANY INACCURACIES OR INCOMPLETIBILITIES. SEE THE LATEST EDITIONS OF THE DRAWING STANDARDS FOR ANY INACCURACIES OR INCOMPLETIBILITIES. SEE THE LATEST EDITIONS OF THE DRAWING STANDARDS FOR ANY INACCURACIES OR INCOMPLETIBILITIES.

AS-BUILT/
CONSTRUCTED

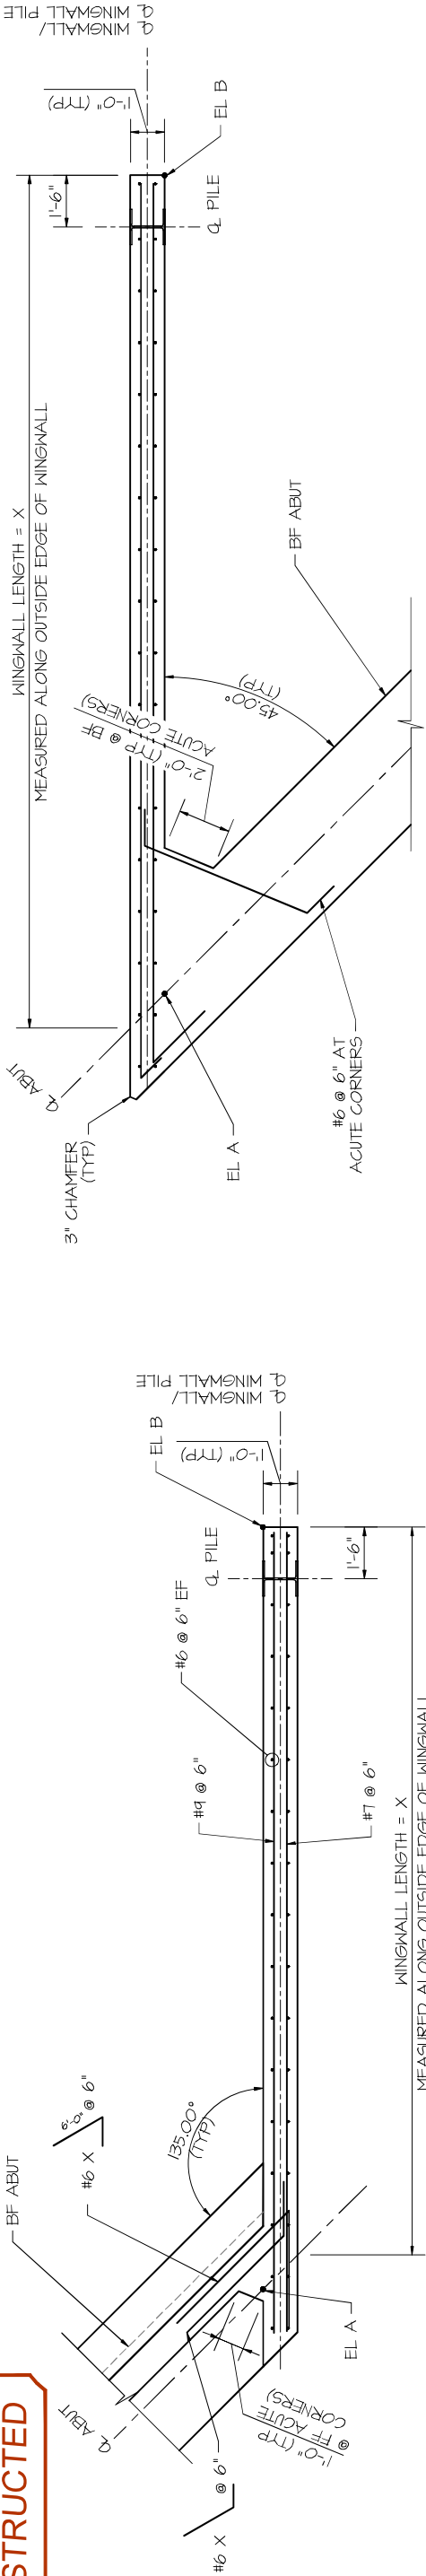


SECTION THRU BACK STUBWALL

WINGWALL 3B SHOWN
(WINGWALL 1A OPPOSITE HAND)

SECTION THRU ABUTMENT STEM

WINGWALL 3A SHOWN
(WINGWALL 1B OPPOSITE HAND)

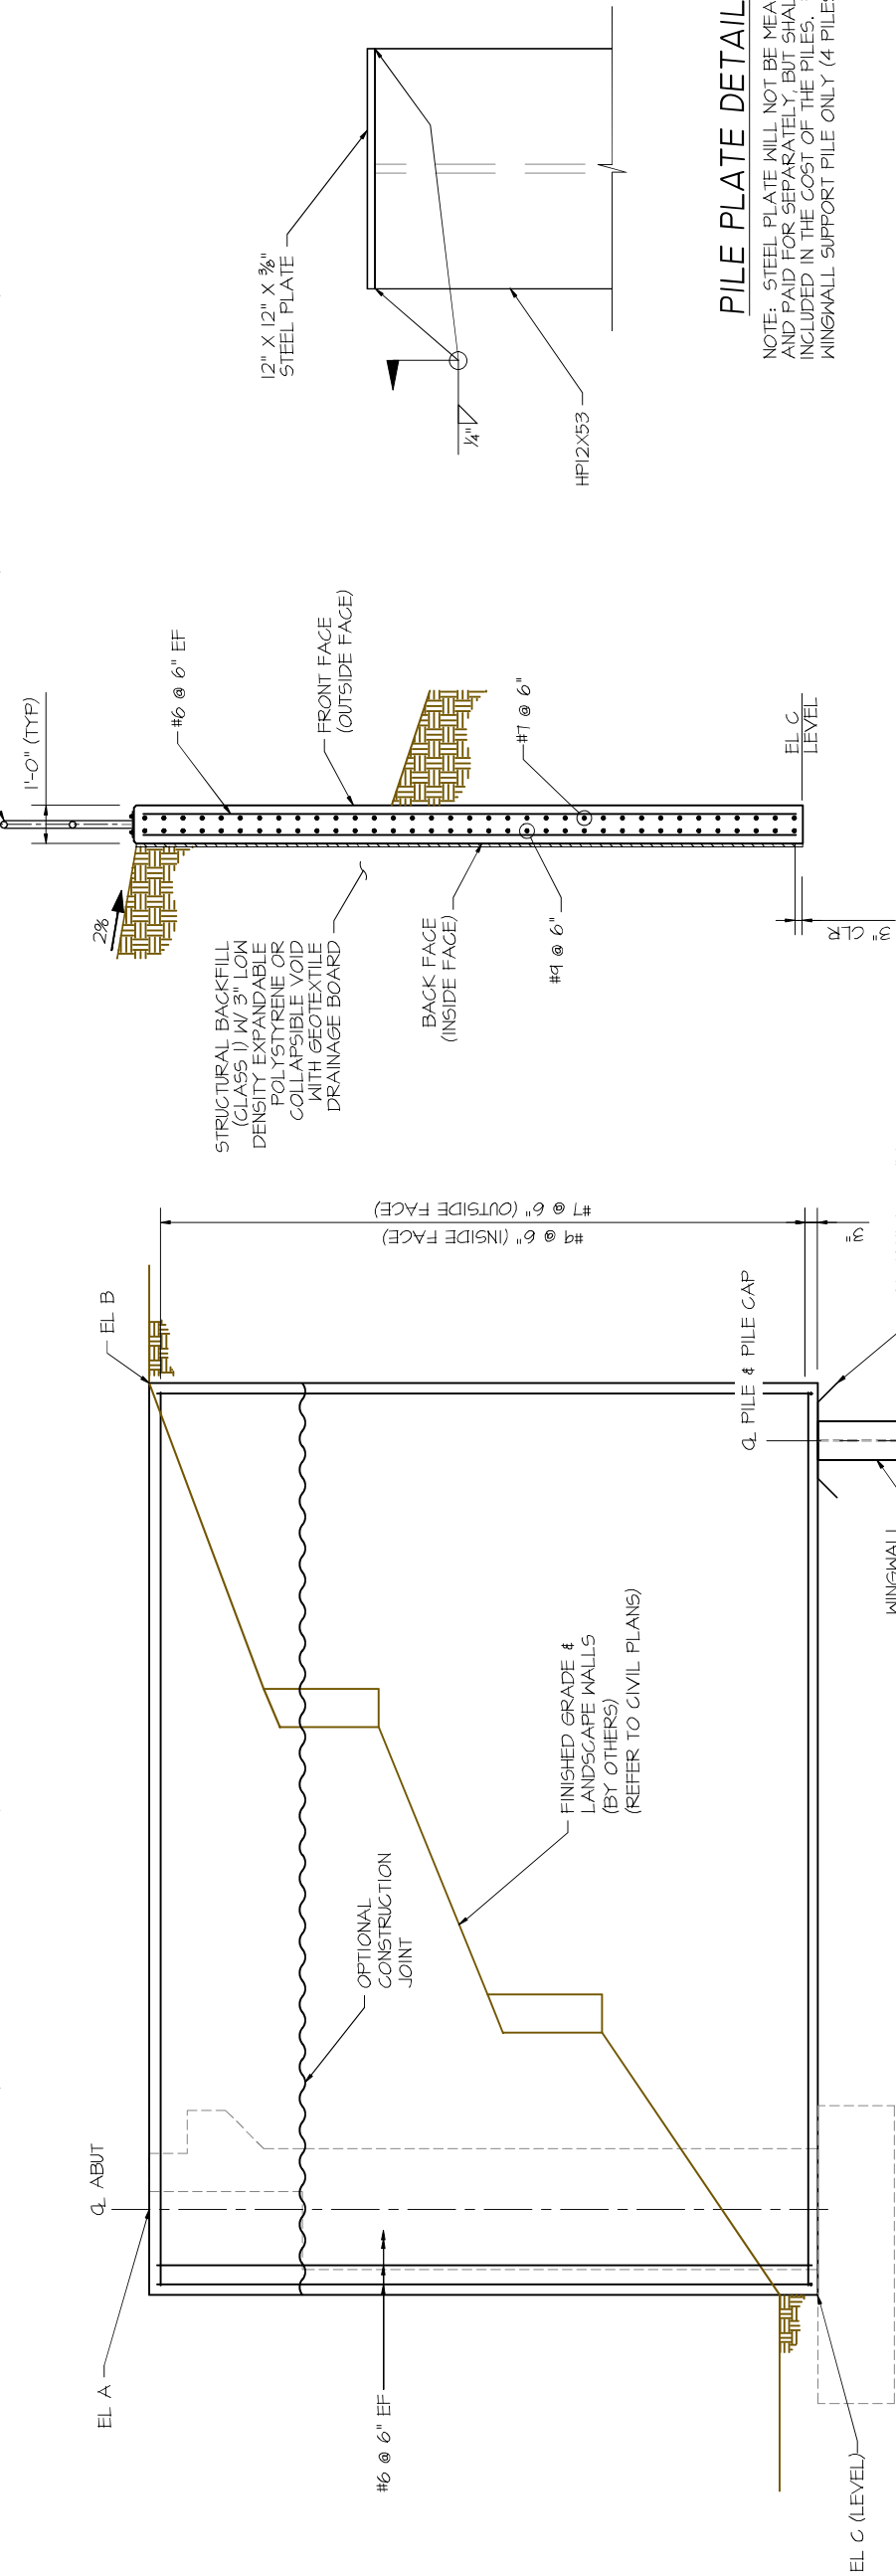

ELEVATION

WINGWALL	EL A	EL B	EL C	X
1A	7069.08	7069.20	7055.00	17'-8"
1B	7068.36	7068.61	7055.00	26'-0"
3A	7067.09	7066.85	7055.00	24'-9"
3B	7066.36	7066.05	7055.00	19'-0"

PILE PLATE DETAIL

NOTE: STEEL PLATE WILL NOT BE MEASURED AND PAID FOR SEPARATELY BUT SHALL BE INCLUDED IN THE COST OF THE PILES. FOR WINGWALL SUPPORT PILE ONLY (4 PILES TOTAL).

NOTES:

- CHAMFER 1'-0" AT FF OF ACUTE CORNERS. CHAMFER 2'-0" AT BF OF ACUTE CORNERS WITHIN STEM & STUBWALL. DO NOT CHAMFER CORBEL.

WINGWALL TYPICAL SECTION



07-12-22

PREPARED FOR:

BY:

DATE:

REVISIONS

1 REVISED BEARING PAD DEPTH

2

3

4

5

6

7



DESIGNED BY:

HMR

DRAWN BY:

AJM

PROJECT MANAGER

HMR

DATE:

7/1/22

PROJECT TITLE

FOREST LAKES BRIDGES

PROJECT LOCATION

MONUMENT, CO


WINGWALL DETAILS

STRUCTURE:

SHEET NO.


B13

THIS DRAWING IS THE PROPERTY OF STEAMBOAT STRUCTURES. IT IS NOT TO BE USED IN ANY MANNER THAT MAY BE A VIOLATION OF ANY APPLICABLE LAW OR REGULATION. USE OF THIS DRAWING FOR ANY PURPOSE OTHER THAN THAT FOR WHICH IT WAS PREPARED IS AT THE USER'S SOLE RISK. STEAMBOAT STRUCTURES ASSUMES NO LIABILITY FOR ANY INACCURACIES OR OMISSIONS IN THIS DRAWING. ALL DATA IS GRAPHICAL IN NATURE AND IS FOR INFORMATION PURPOSES ONLY. ALL DIMENSIONS, SLOPES, ELEVATIONS WERE DERIVED FROM OTHER SOURCES. ACCEPTANCE OF THE DRAWING IS AN AGREEMENT TO THE ABOVE.

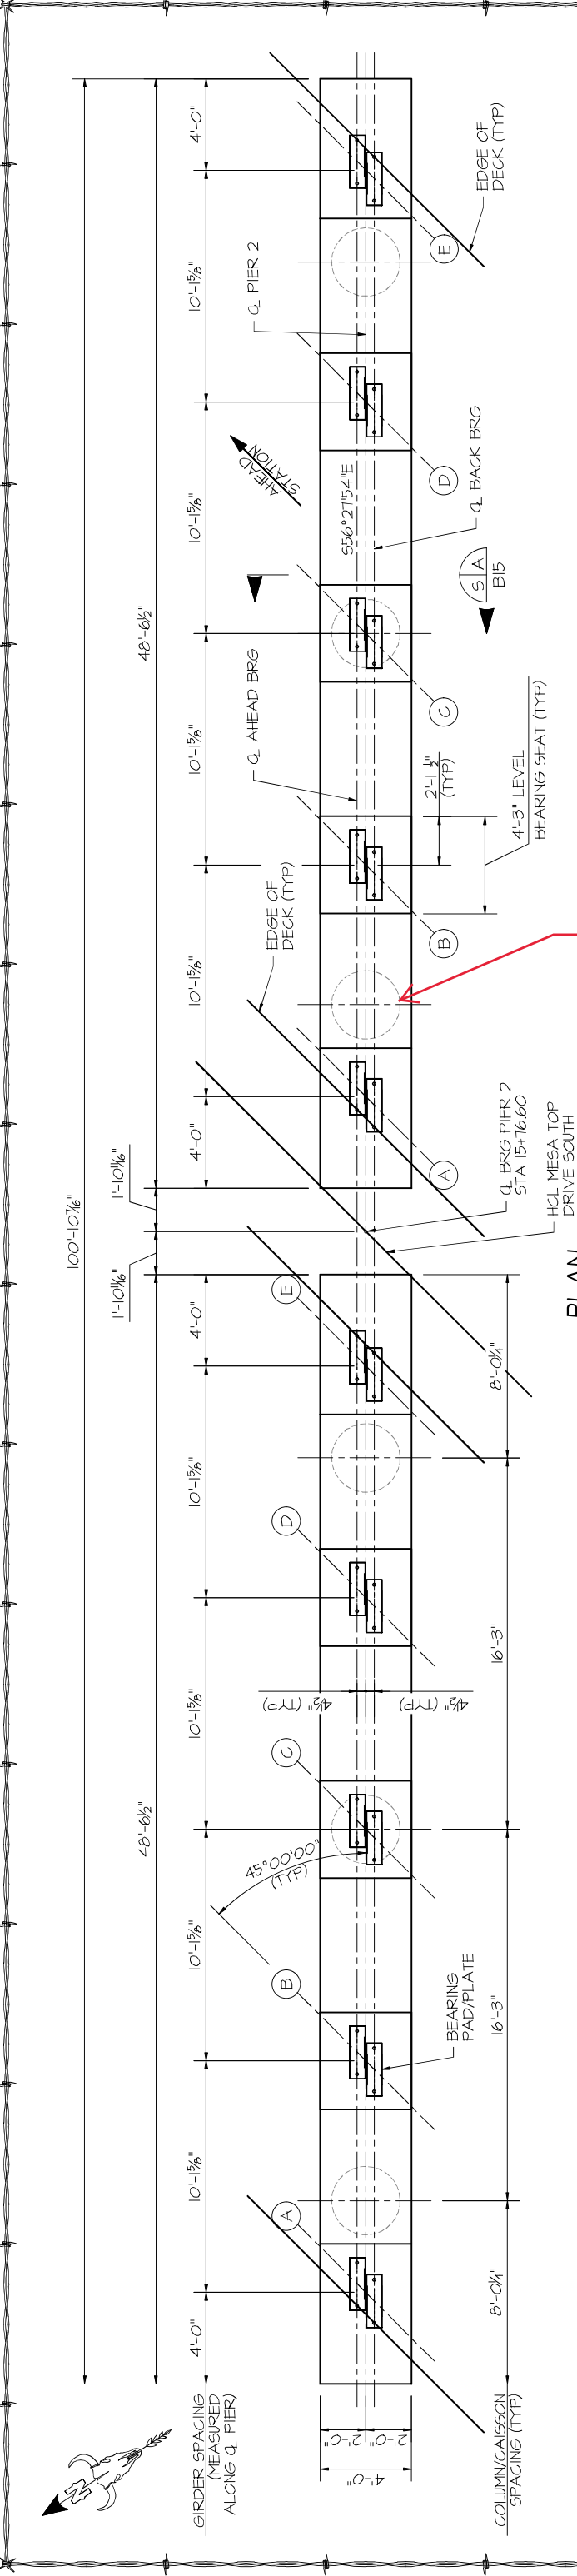

PLAN

This column was shifted 2" to the southeast along the CL of the pier to maintain adequate rebar clearance per RFI 001

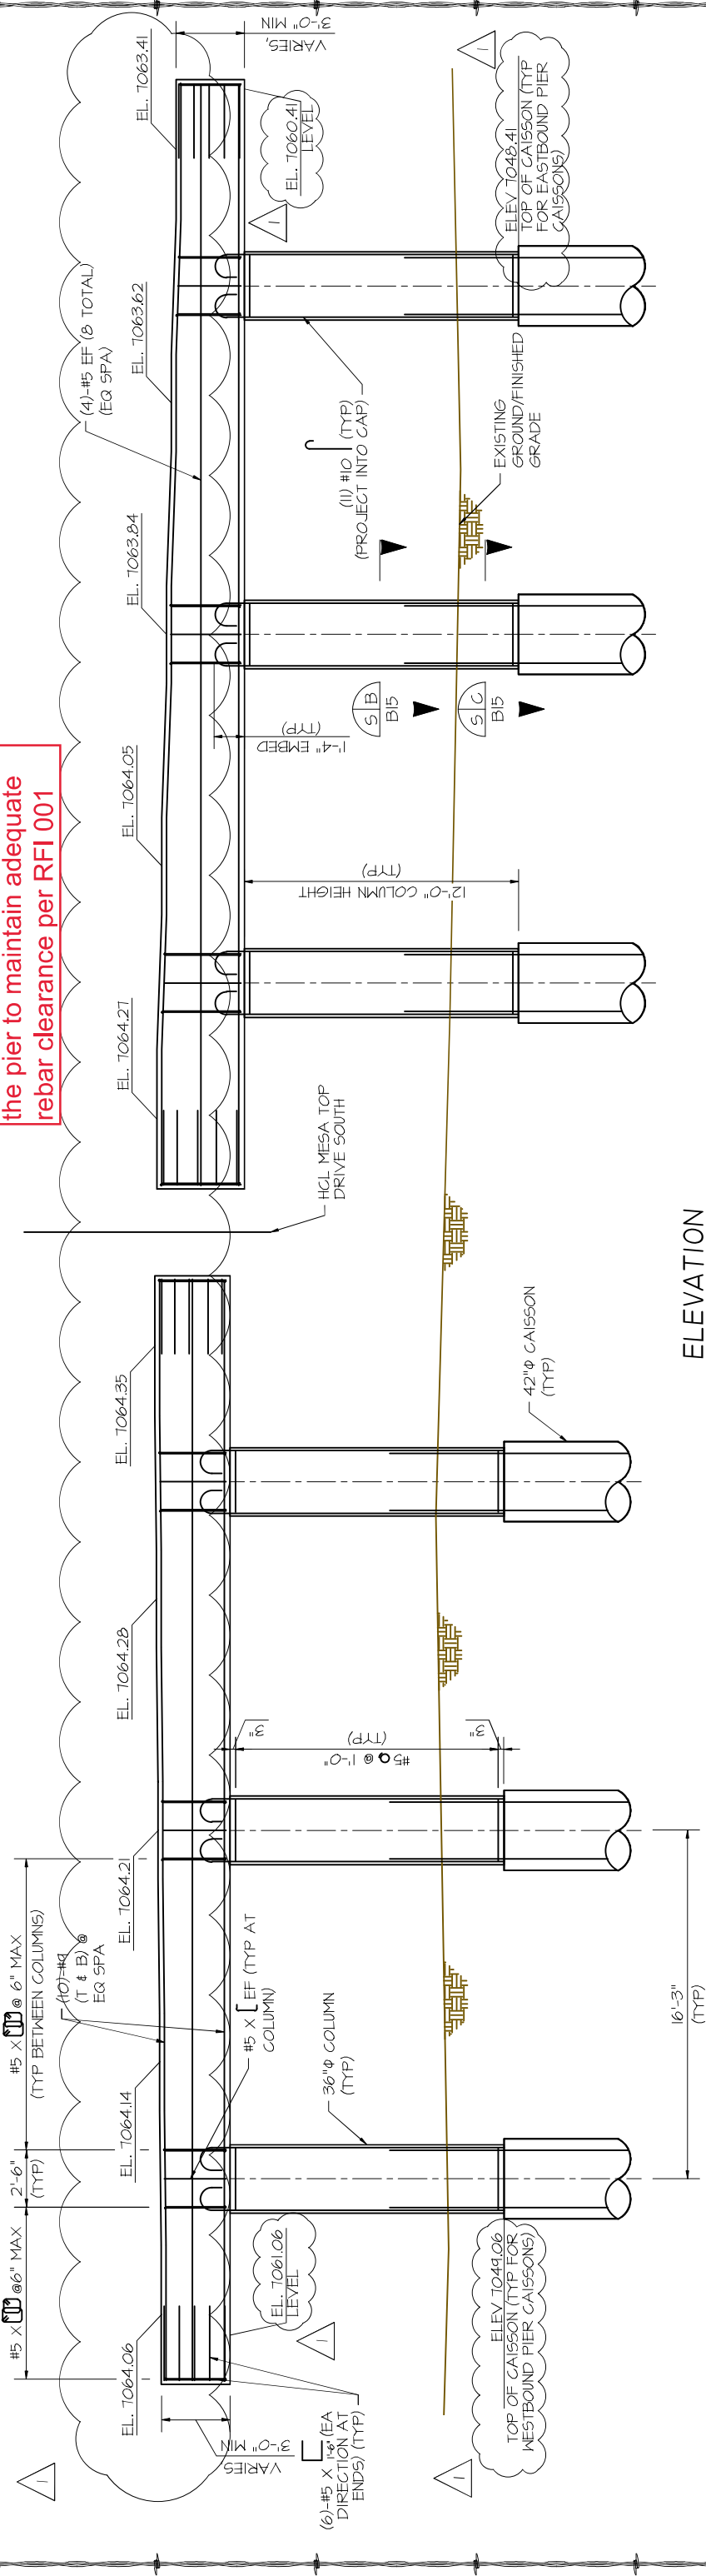

ELEVATION

(LOOKING AHEAD STATION)

NOTES:

- 1. REFER TO CONTECH'S PLANS FOR BEARING PLATE/PAD INFORMATION.
- 2. THERE ARE 2 ANCHOR BOLTS PER GIRDER BEARING PLATE. 20 ANCHOR BOLTS PER PIER, 40 TOTAL FOR PIER 2.

AS-BUILT/
CONSTRUCTED




SEATTLE
REGISTERED
PROFESSIONAL
ENGINEER

49431

07-12-22

CLASSIC
HOMES

STRUCTURES

<div>07-12-22</div>		<div></div>		REVISIONS		DATE		BY	PREPARED FOR		<div> STEAMBOAT STRUCTURES</div>		<div></div>		<div>DESIGNED BY: HMR</div> <div>DRAWN BY: AJM</div> <div>PROJECT MANAGER: HMR</div> <div>DATE: 7/12/22</div>		PROJECT TITLE FOREST LAKES BRIDGES		PROJECT LOCATION MONUMENT, CO																																																																																																																																																																																																																																																																																																																																																																																																																																																																																																																																																																																																																																																																																																																																																																																																																																																																																																																																																																																																																																																																																																																																																																																																						
				1	REVISED BEARING PAD DEPTH	05-19-21	HMR																																																																																																																																																																																																																																																																																																																																																																																																																																																																																																																																																																																																																																																																																																																																																																																																																																																																																																																																																																																																																																																																																																																																																																																																																		

THIS DRAWING IS THE PROPERTY OF CLASSIC HOMES. IT IS NOT TO BE USED IN ANY MANNER THAT MAY BE A VIOLATION OF ANY APPLICABLE LAW OR REGULATION. THE INFORMATION IS FOR INFORMATIONAL PURPOSES ONLY. ALL DIMENSIONS, SIZES, ELEVATIONS, AND MATERIALS ARE TO BE USED AS SHOWN UNLESS OTHERWISE NOTED. THE INFORMATION IS NOT TO BE USED FOR ANY PURPOSES OTHER THAN THAT FOR WHICH IT WAS PROVIDED. THE INFORMATION IS NOT TO BE USED FOR ANY PURPOSES OTHER THAN THAT FOR WHICH IT WAS PROVIDED. THE INFORMATION IS NOT TO BE USED FOR ANY PURPOSES OTHER THAN THAT FOR WHICH IT WAS PROVIDED.

NOTES:

THE EXPANSION DEVICE SHALL BE INSTALLED ON GRADE, PARALLEL TO THE SLOPE AND GRADE OF THE DECK.

THE EXPANSION DEVICE SHALL NOT BE SET BEFORE THE DECK ELEVATIONS HAVE BEEN APPROVED BY THE ENGINEER. THE CONTRACTOR SHALL TAKE SHOTS OF THE EXPANSION DEVICE TO ACHIEVE THE REQUIRED ELEVATIONS FOR SMOOTHER RIDEABILITY ON BRIDGE APPROACHES.

AFTER THE CONCRETE HAS ATTAINED INITIAL SET, THE ATTACHMENTS USED TO HOLD THE EXPANSION DEVICE ASSEMBLY IN ITS PROPER POSITION SHALL BE REMOVED.

"W" AND "E" DIMENSIONS ARE DEPENDENT UPON THE PARTICULAR EXPANSION DEVICE SUPPLIED, AND SHALL BE SHOWN ON THE WORKING DRAWINGS.

SEE TABLE FOR DIMENSIONS "A" AND "W". INTERPOLATE AS NEEDED. DO NOT INSTALL THE GLAND UNTIL DIMENSION "A" HAS OPENED UP TO AT LEAST 1/2" (21/2" FOR SILICOFLEX).

THE NEOPRENE GLAND SHALL BE INSTALLED IN ONE PIECE IN ACCORDANCE WITH SECTION 518 OF THE STANDARD SPECIFICATIONS.

SEE SECTION 518.04 IN THE STANDARD SPECIFICATIONS FOR WATER TIGHT INTEGRITY TESTING REQUIREMENTS.

SET ELEVATIONS AT TOP OF END OF DECK AND BACK STUBWALL WITH THE GRADE PROJECTION SCHEME.

ALL STEEL ELEMENTS (WHETHER GRADE A36 OR A588) OF THE BRIDGE EXPANSION DEVICE, INCLUDING COVER PLATES, SHALL BE HOT DIP GALVANIZED AFTER FABRICATION AS PER SECTION 504.11 OF THE STANDARD SPECIFICATIONS.

USE A RUN OF 1 FOR NEW CONSTRUCTION.

PROVIDE EXPANSION DEVICE SUPPORT AS SHOWN AT 6'-0" INTERVALS.

FOR REINFORCING NOT SHOWN HEREON, SEE ABUTMENT DETAILS AND CONTECH PLANS.

CUT THREADED ROD FLUSH TO CONCRETE FOR FINISHED JOINT.

CONCRETE SHALL BE PLACED AFTER EXPANSION DEVICE HAS BEEN ADJUSTED TO PROPER GRADE AND APPROVED BY THE ENGINEER.


ACCEPTABLE EXPANSION DEVICE ALTERNATES

D.S. BROWN A2R400-55A2MABO SE400 TYPE AEPOXY INDUSTRIES 5400-A
R. J. WATSON SILICOFLEX SF 400


AIR TEMP (°F)	"A"	"W"*
-30	2.75	5.25
0	2.55	5.05
30	2.35	4.85
60	2.15	4.65
90	1.95	4.45
120	1.75	4.25

* FOR E = 1/4" (MIN.)


AS-BUILT/
CONSTRUCTED

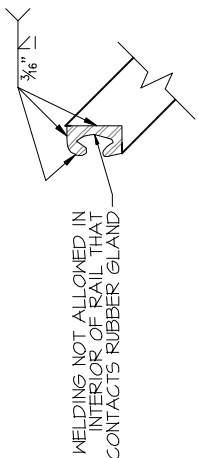


RAIL FIELD SPLICE DETAIL

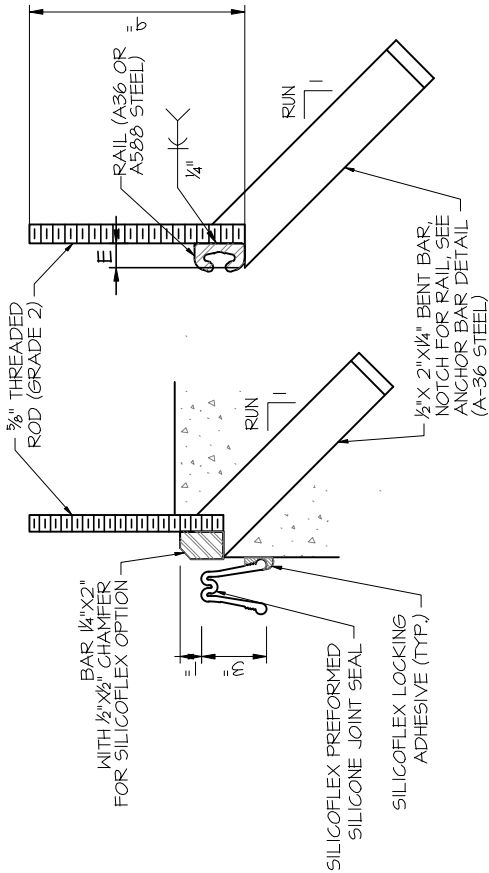


ANCHORAGE DETAIL

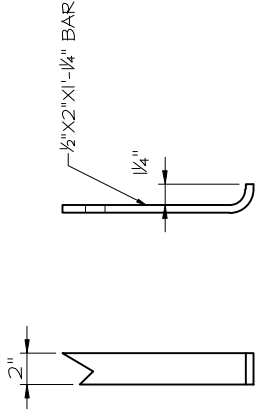

TYPICAL ANCHOR BAR DETAIL

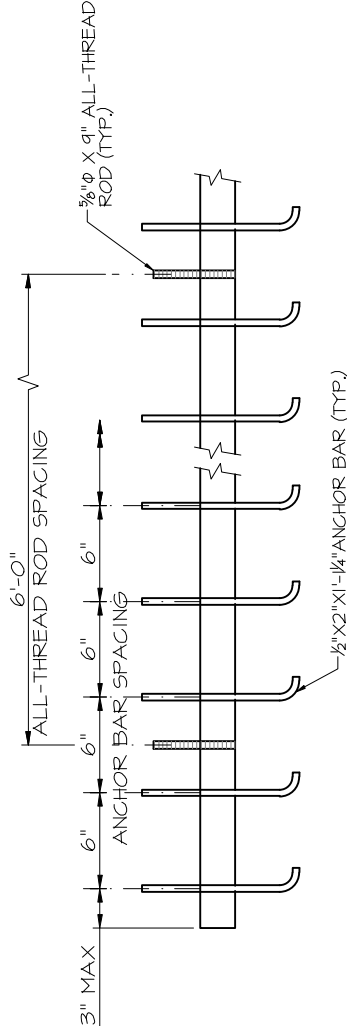


ANCHOR BAR SPACING

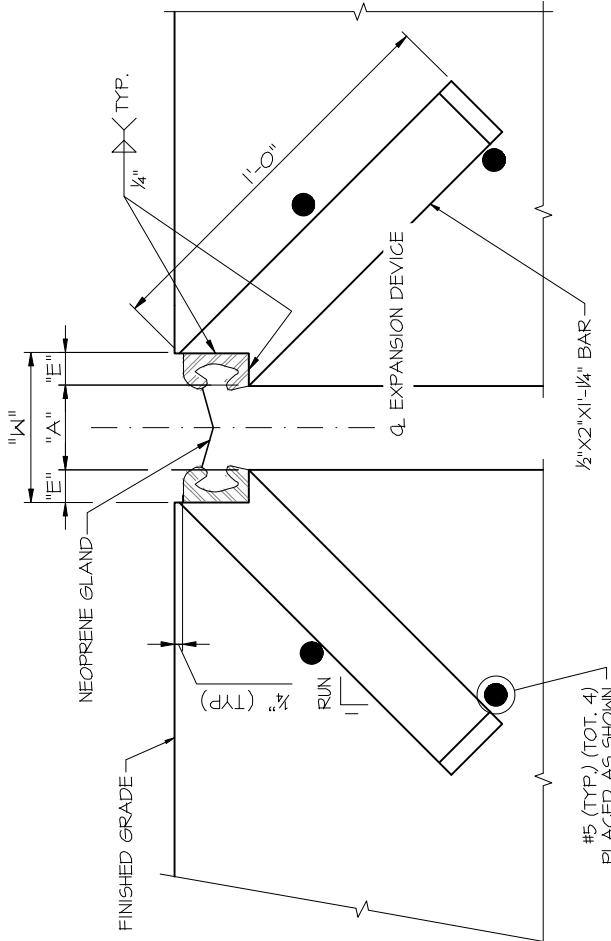


SECTION THRU STRIP SEAL BRIDGE EXPANSION

SECTION TAKEN PERPENDICULAR TO Q. EXPN DEVICE

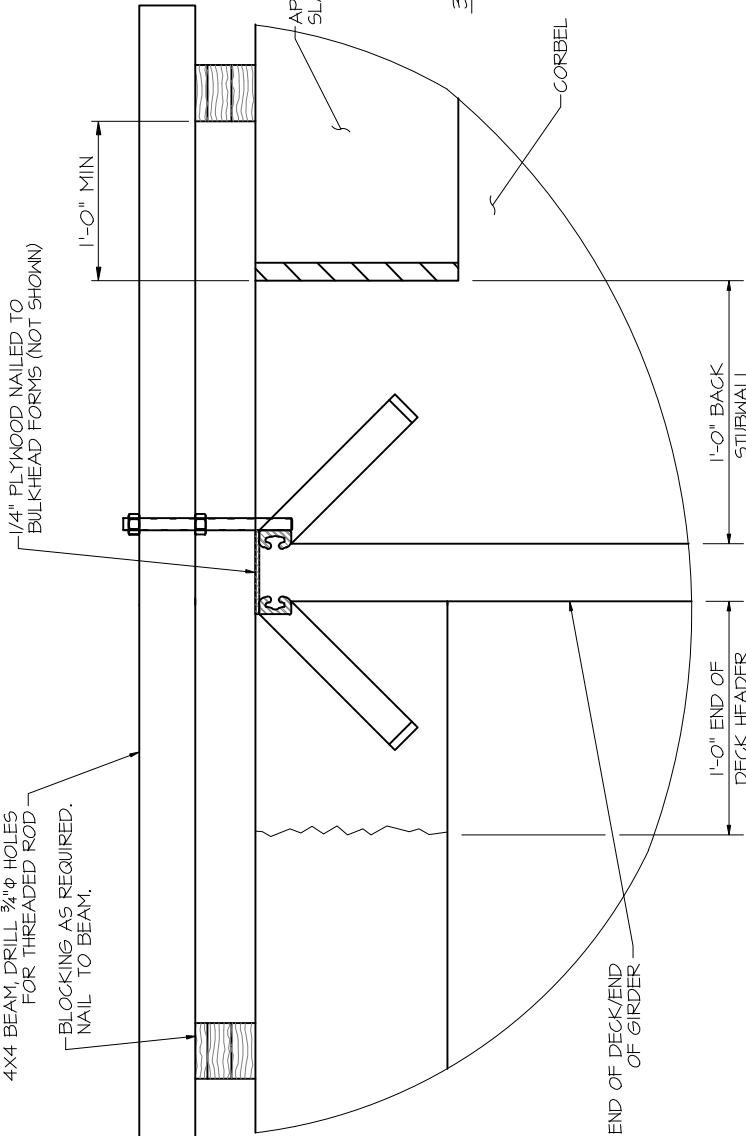

MINIMUM SUPPORT BRACKET REQUIREMENTS

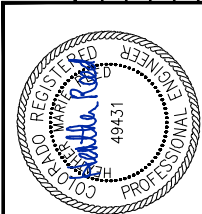

07-12-22

THIS DRAWING AND ANY ELECTRONIC FILES AND DATA ARE THE PROPERTY OF STEAMBOAT STRUCTURES. IT IS NOT TO BE USED IN ANY MANNER THAT MAY BE A DISRESPECT TO ITS ORIGINATOR. USE THE ELECTRONIC FILE AT YOUR OWN RISK WITH NO LIABILITY TO THE ORIGINATOR FOR ANY INACCURACIES OR INCOMPLETE FILES. USE THE LATEST ORIGINAL. ALL DATA IS GRAPHICAL. WHAT ARE AND IS FOR INFORMATION PURPOSES ONLY. ALL DIMENSIONS, SLOPES, ELEVATIONS WERE DERIVED FROM OTHER SOURCES. ACCEPTANCE OF THIS DRAWING IS AN AGREEMENT TO THE ABOVE.



DESIGNED BY:	HMR
DRAWN BY:	AJM
PROJECT MANAGER:	HMR
DATE:	7/1/22


PROJECT TITLE
FOREST LAKES BRIDGES

PROJECT LOCATION
MONUMENT, CO

BRIDGE EXPANSION DEVICE (1 OF 2)


SHEET NO.
B16

NOTE:
THREADED CONG INSERTS & FLAT HEAD
CAP SCREWS SHALL BE ASTM A307
STAINLESS STEEL OR EQUIVALENT.

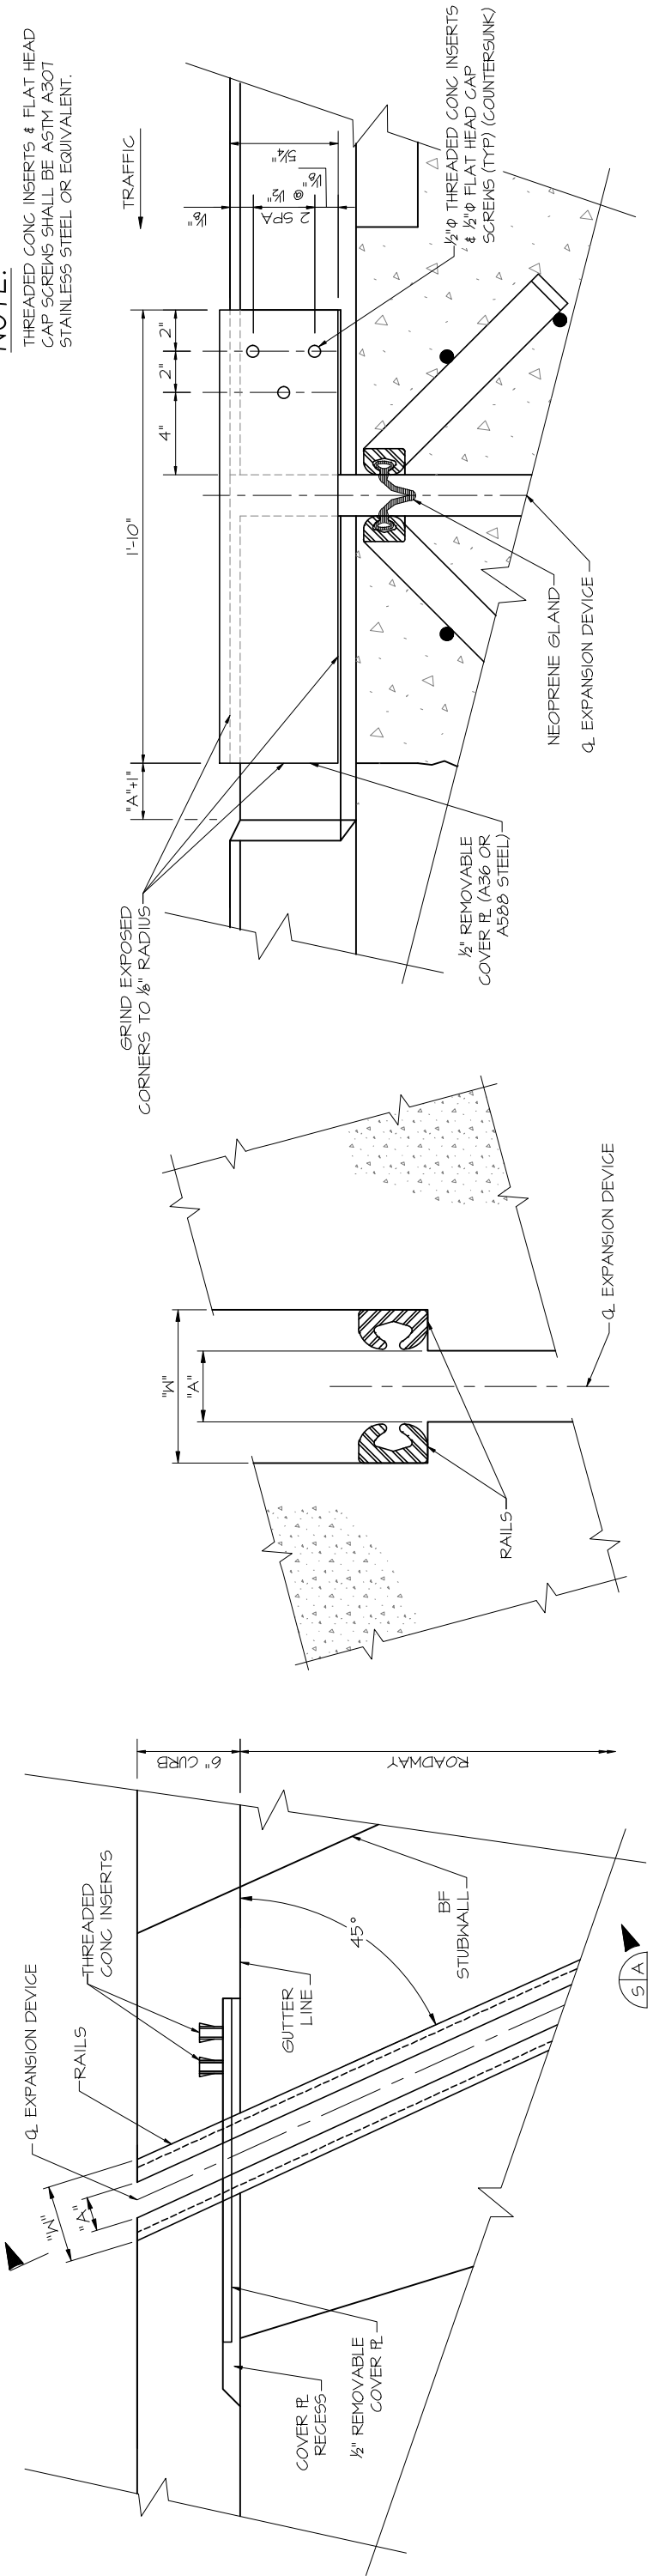

CURB - PLAN
SIMILAR AT SIDEWALK



SECTION S/B

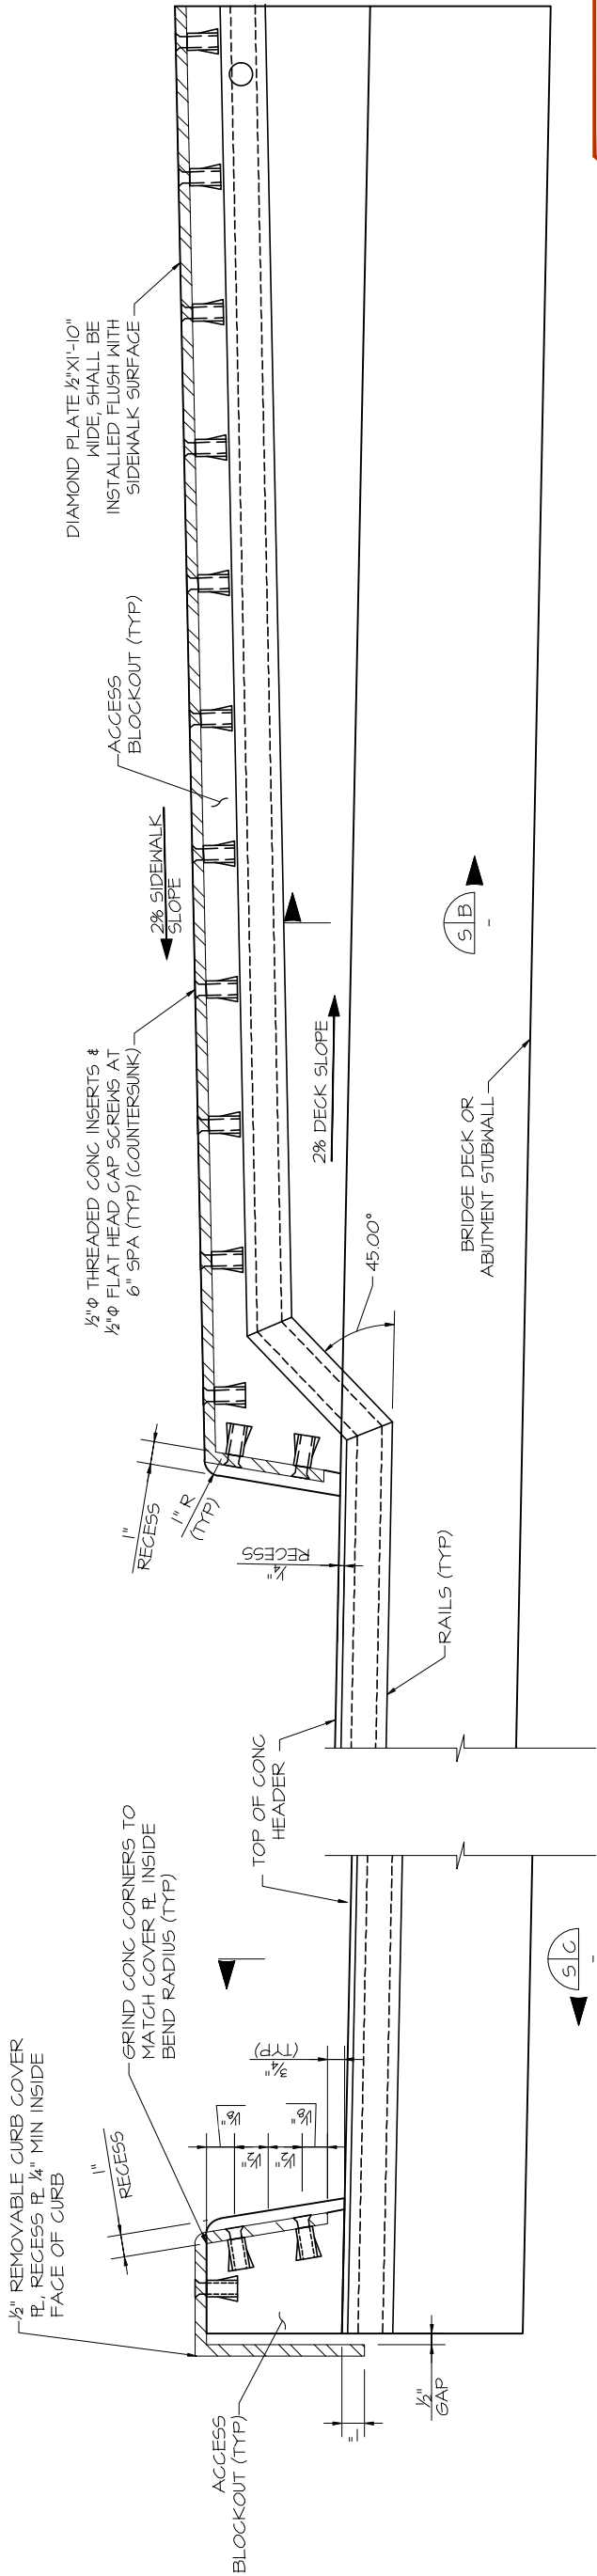

NOTE:
PROVIDE 2" MINIMUM COVER BETWEEN
ANCHORS AND ALL CONCRETE SURFACES.

SECTION S/A
AT SIDEWALK


AS-BUILT/
CONSTRUCTED

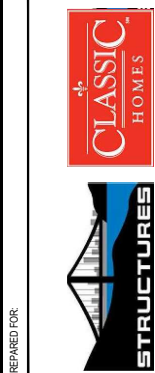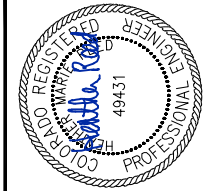


DESIGNED BY: HMR		PROJECT TITLE FOREST LAKES BRIDGES		PROJECT LOCATION MONUMENT, CO	
DRAWN BY: AJM		PROJECT MANAGER HMR		STRUCTURE: BRIDGE EXPANSION DEVICE (2 OF 2)	
DATE: 7/12/22				SHEET NO. B17	

NOTES:

- 1. CONCRETE CLASS D (BRIDGE) SHALL BE USED FOR APPROACH SLABS.
- 2. APPROACH SLAB CONCRETE SHALL BE CURED IN ACCORDANCE WITH THE SPECIFICATIONS FOR BRIDGE DECK CONCRETE IN SUBSECTION 601.
- 3. 1/2" EXPANSION JOINT MATERIAL SHALL MEET AASHTO SPEC M213.
- 4. FOR EXPANSION DEVICE DETAILS, SEE BRIDGE EXPANSION DEVICE SHEETS.
- 5. FOR CURB & SIDEWALK DETAILS, SEE CIVIL PLANS.

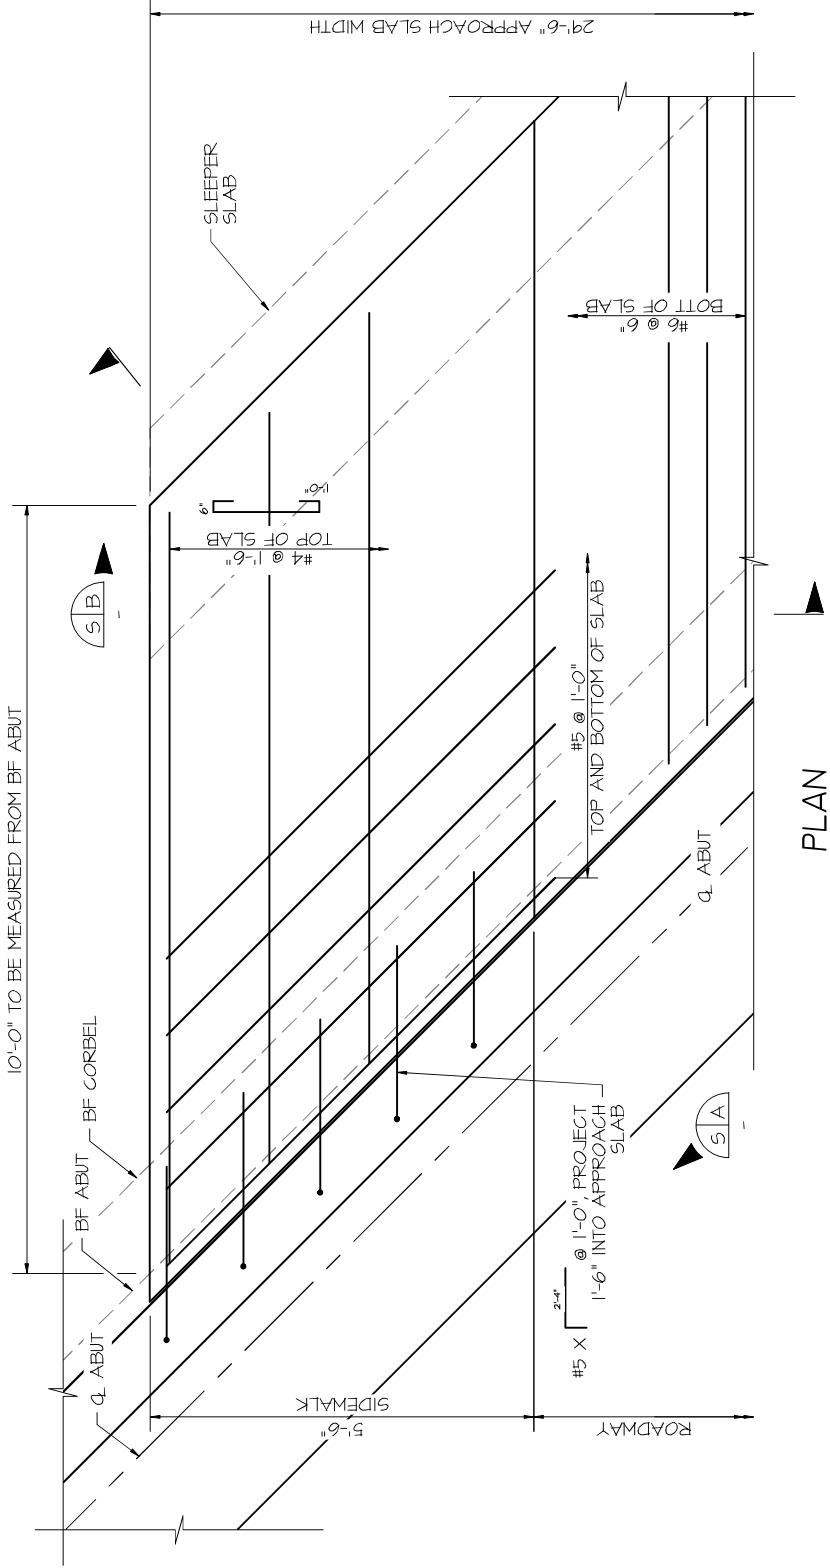


PLAN

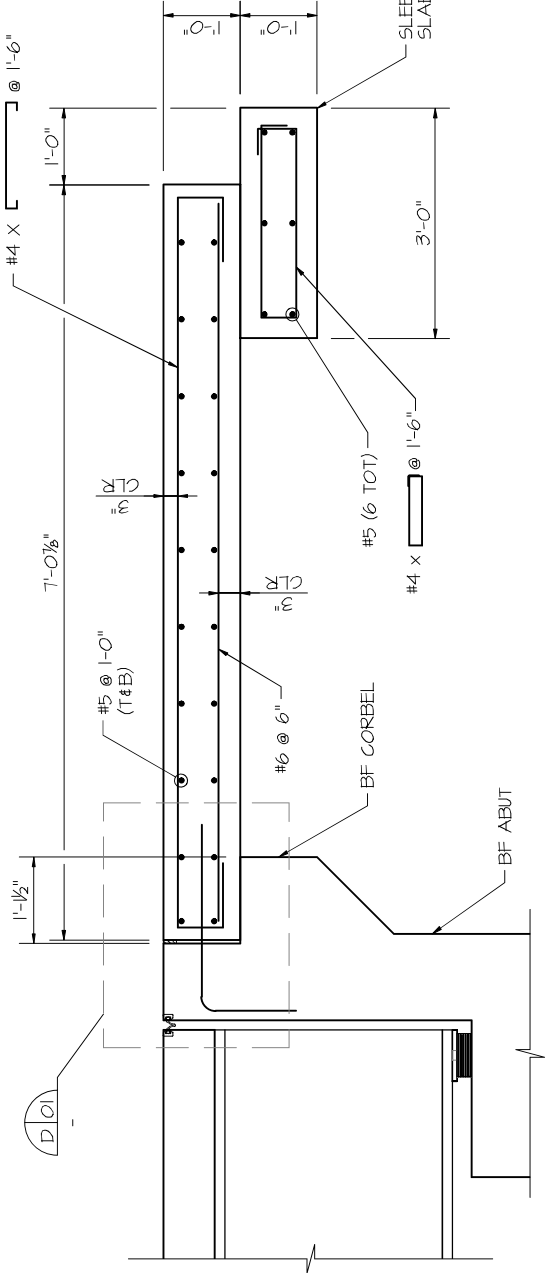

SECTION (S A)
(PERPENDICULAR TO Q ABUT)

DETAIL (D O)

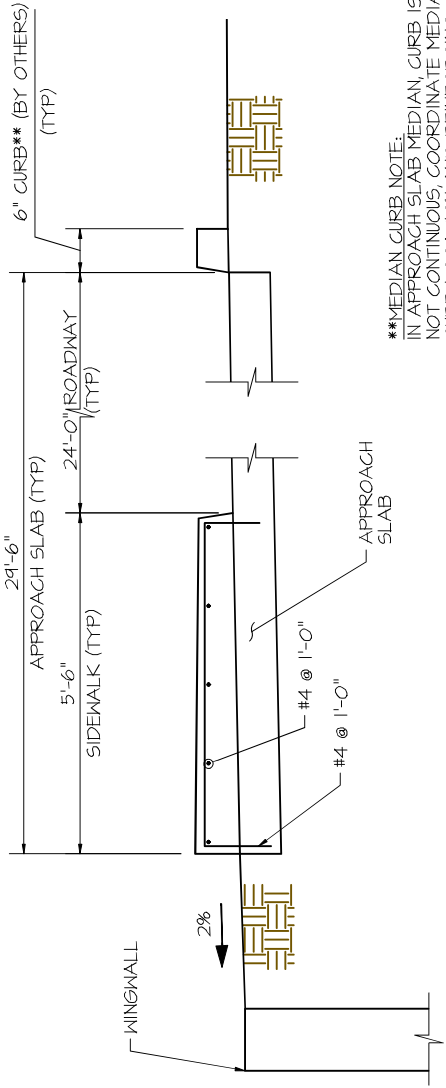


SECTION (S B)


APPROACH SLAB REINFORCEMENT
NOT SHOWN FOR CLARITY

**MEDIAN CURB NOTE:
IN APPROACH SLAB MEDIAN, CURB IS
NOT CONTINUOUS; COORDINATE MEDIAN
CURB LOCATION AND REINFORCING
LOCATIONS WITH THE CIVIL SHEETS.

AS-BUILT/
CONSTRUCTED

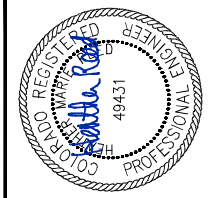

07-12-22

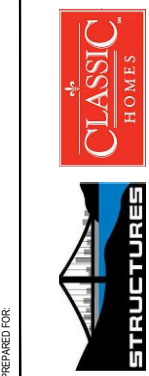

PREPARED FOR:

BY:

DATE:

REVISIONS

1 REVISED BEARING PAD DEPTH

2

3

4

5

6

7

DESIGNED BY:

HMR

DRAWN BY:

AJM

PROJECT MANAGER

HMR

DATE:

7/12/22

PROJECT TITLE

FOREST LAKES BRIDGES

PROJECT LOCATION

MONUMENT, CO


STRUCTURE:

APPROACH SLAB


SHEET NO.

B19


THIS DRAWING (AND ANY E-FILES) IS THE PROPERTY OF STEAMBOAT STRUCTURES. IT IS NOT TO BE USED IN ANY MANNER THAT MAY BE A VIOLATION OF ANY APPLICABLE LAW, REGULATION, OR CONTRACT. ALL RIGHTS ARE RESERVED. NO PART OF THIS DRAWING IS TO BE REPRODUCED OR TRANSMITTED IN ANY FORM OR BY ANY MEANS, ELECTRONIC OR MECHANICAL, INCLUDING PHOTOCOPYING, RECORDING, OR BY ANY INFORMATION STORAGE AND RETRIEVAL SYSTEM, WITHOUT THE WRITTEN PERMISSION OF STEAMBOAT STRUCTURES. ACCEPTANCE OF THIS DRAWING IS AN AGREEMENT TO THE ABOVE.

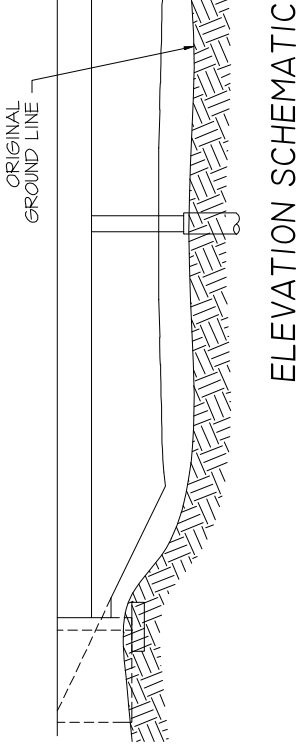

ELEVATION SCHEMATIC

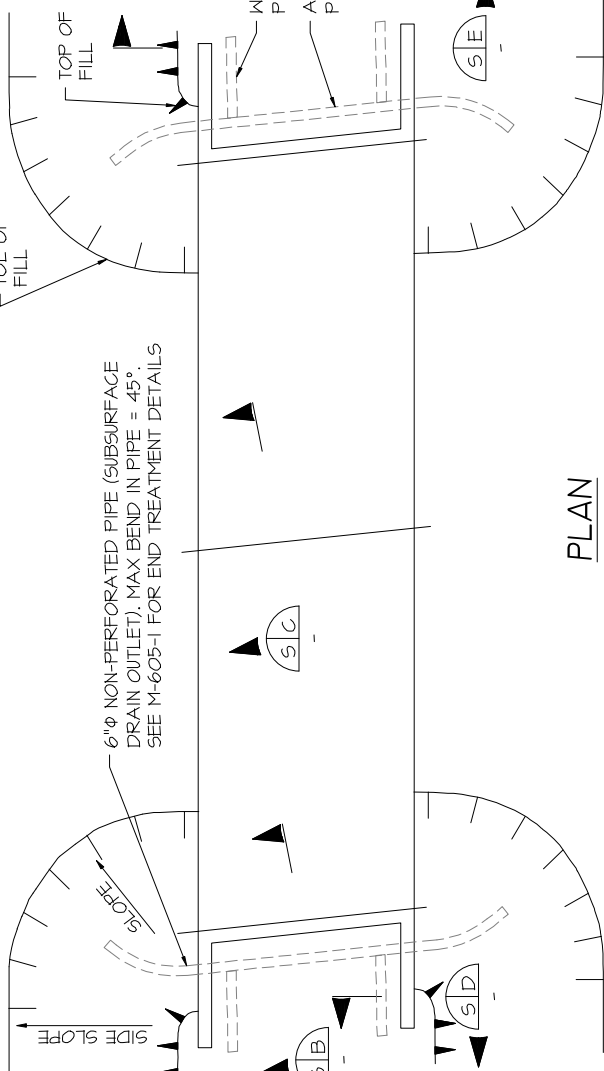


PLAN

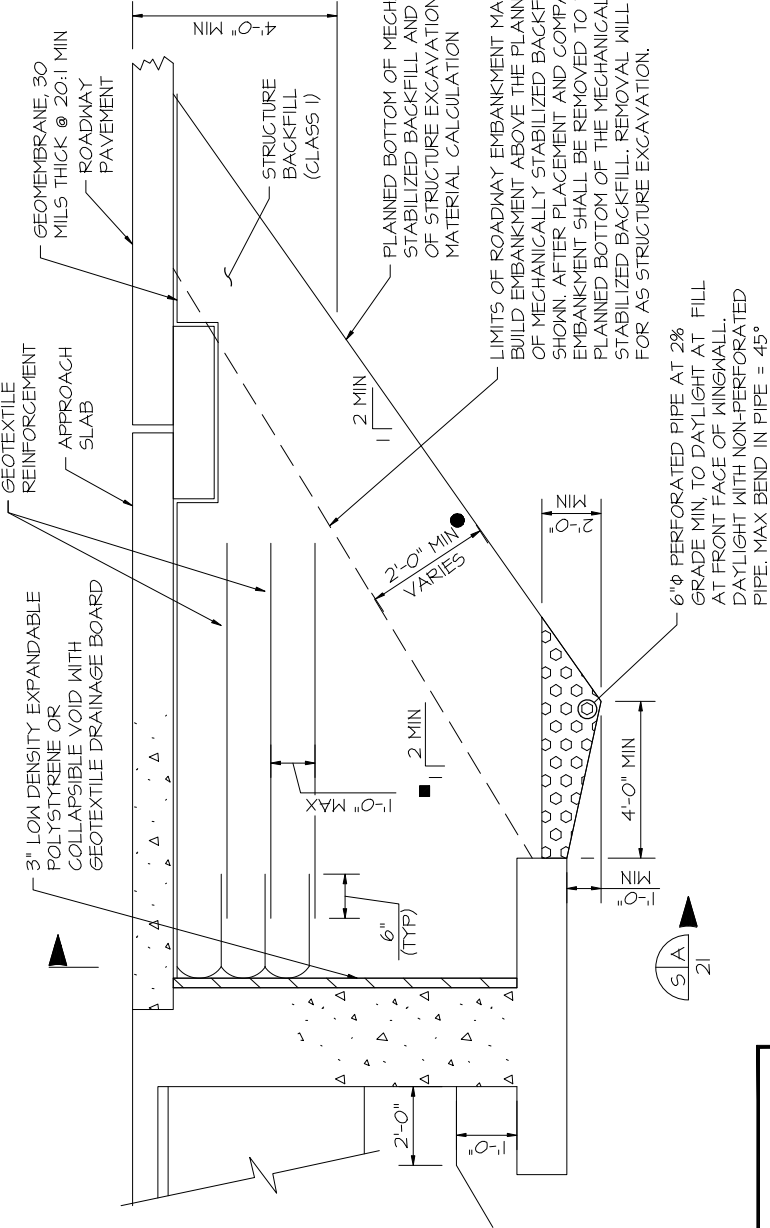

SECTION PERPENDICULAR TO ABUTMENT



07-12-22

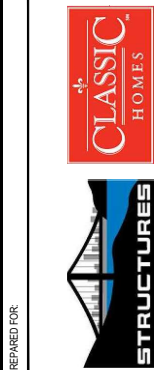

DESIGNED BY:	HMR
DRAWN BY:	AJM
PROJECT MANAGER	HMR
DATE:	7/12/22

PROJECT TITLE
FOREST LAKES BRIDGES


PROJECT LOCATION
MONUMENT, CO

BACKFILL DETAILS (1 OF 2)

SHEET NO.

B20

LEGEND

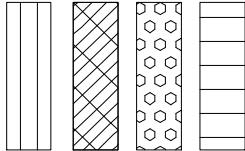


STRUCTURE BACKFILL (CLASS I) WITH MECHANICAL REINFORCEMENT AS SHOWN ON THE PLANS

REFER TO CIVIL PLANS FOR GRADING IN FRONT OF ABUTMENTS AND WINGWALLS

FILTER MATERIAL

STRUCTURE BACKFILL (CLASS I)

SECTION (BACKFILL) (S) (B)

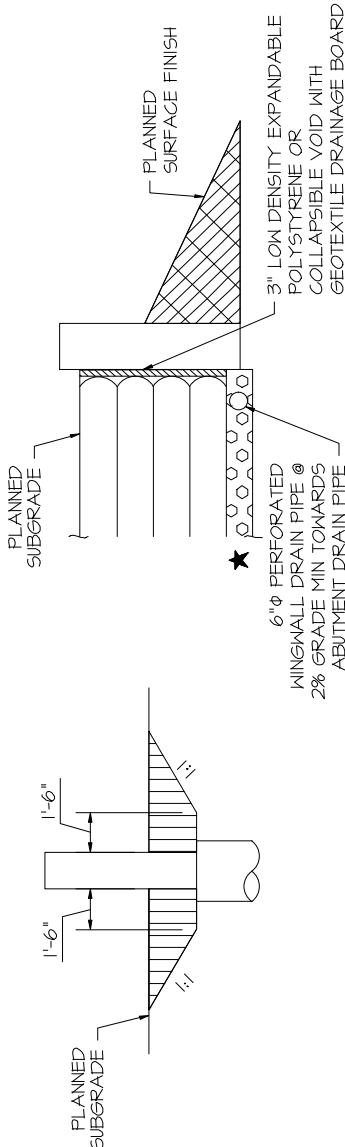

SECTION (BACKFILL) (S) (C)

SECTION (BACKFILL) (S) (D)



SECTION (BACKFILL) (S) (E)

★ FILTER MATERIAL IS ONLY USED IN AREA NEAR THE ABUTMENT AND NOT AT THE END OF THE WINGWALL


NOTES:

- REFER TO M-206-2 FOR EXCAVATION LIMITS.
- GEOTEXTILE REINFORCEMENT SHALL BE WOVEN FABRIC WITH A MINIMUM AVERAGE ROLL VALUE OF 4800 LB/FT FOR INSTALLATIONS WITH A GAP AND 2400 LB/FT FOR INSTALLATIONS WITHOUT A GAP BASED ON ASTM D4545.
- GEOTEXTILE REINFORCEMENT SHALL BE PLACED BY ALTERNATING MACHINE DIRECTION (MD) WITH GROSS MACHINE DIRECTION (XD) FROM LAYER TO LAYER.
- THE GEOTEXTILE REINFORCEMENT WRAP AT BACK FACE OF ABUTMENT SHALL BE PULLED BACK SLACK FREE WITH ITS END ANCHORED TO SOIL UNDERNEATH WITH STAPLES OR PINS.
- MINIMUM SPLICE OF ALL GEOTEXTILE SHALL CONSIST OF 6" OF OVERLAP.
- PAYMENT FOR ALL WORK ITEMS SHOWN WILL BE MADE UNDER ITEM 206 MECHANICAL REINFORCEMENT OF SOIL (CY) AND ITEM 206 STRUCTURE BACKFILL (CLASS I) (CY) AND SHALL INCLUDE THE COST FOR 6 INCH ϕ PERFORATED PIPE UNDERDRAIN AND SUBSURFACE DRAIN OUTLET (6 INCH ϕ NON-PERFORATED PIPE) AND FILTER MATERIAL (CLASS B) QUANTITIES.
- INSTALLATION OF PIPE UNDERDRAIN, SUBSURFACE DRAIN OUTLET, AND GEOCOMPOSITE DRAIN WILL CONFORM TO THE CONSTRUCTION REQUIREMENTS OF SECTION 605.03, 605.06 AND 605.04, RESPECTIVELY.
- GEOCOMPOSITE DRAINAGE BOARD SHALL BE PLACED ON THE SOIL SIDE OF WALLS AND ABUTMENTS.

- MEASURED PERPENDICULAR TO PLANNED BOTTOM OF MECHANICALLY STABILIZED BACKFILL
- PAYMENT BASED ON 2:1 SLOPE. ADDITIONAL QUANTITIES SHALL BE INCLUDED IN THE WORK.

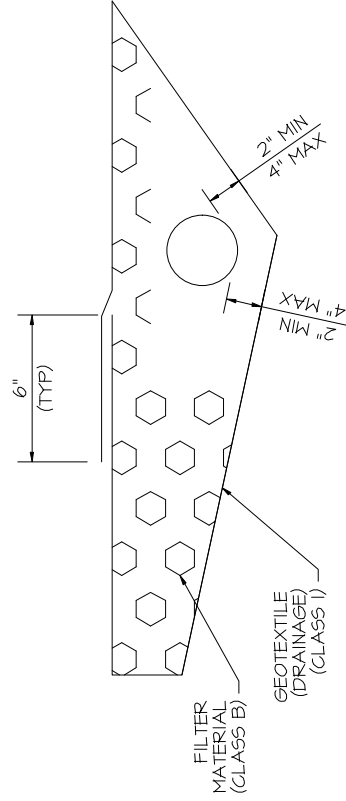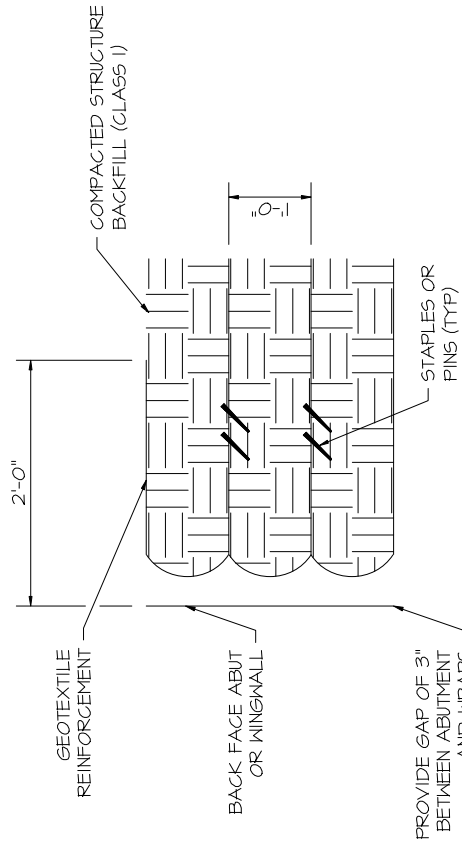


6 INCH PERFORATED PIPE UNDERDRAIN

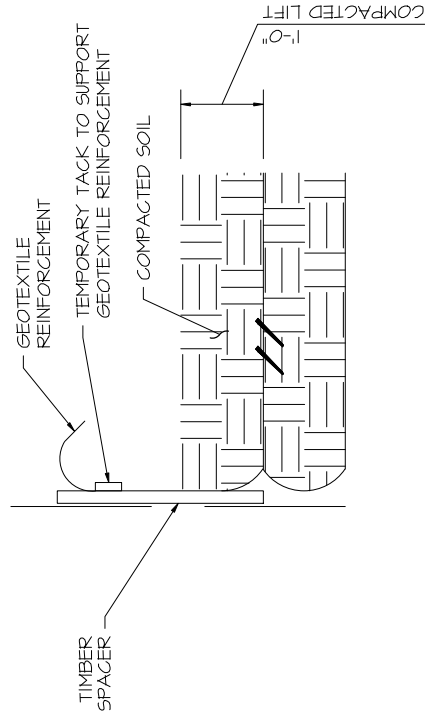


GAP DETAIL STEP 1


WHEN REQUIRED, THE GEOTEXTILE REINFORCEMENT WRAP AT BACK FACE OF ABUTMENT OR WINGWALL SHALL BE TEMPORARILY HUNG WITH A SPACER BOARD AND TACK STRIP. AFTER REACHING TOTAL OF 10' COMPACTED LIFT, THE TACK STRIP SHALL BE REMOVED AND TEXTILE REINFORCEMENT SHALL BE PULLED BACK SLACK FREE WITH ITS END ANCHORED TO SOIL UNDERNEATH WITH STAPLE OR PINS BEFORE THE SPACER BOARD IS PULLED. ANY ALTERNATE METHOD TO MAINTAIN THE MINIMUM GAP BETWEEN ABUTMENT CONCRETE AND REINFORCED SOIL MAY BE PROPOSED TO THE ENGINEER FOR APPROVAL

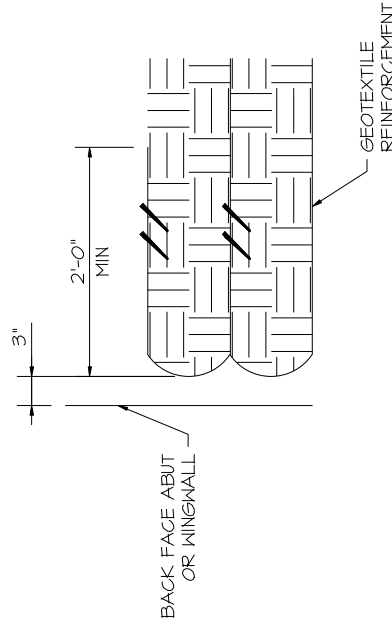


GAP DETAIL STEP 2

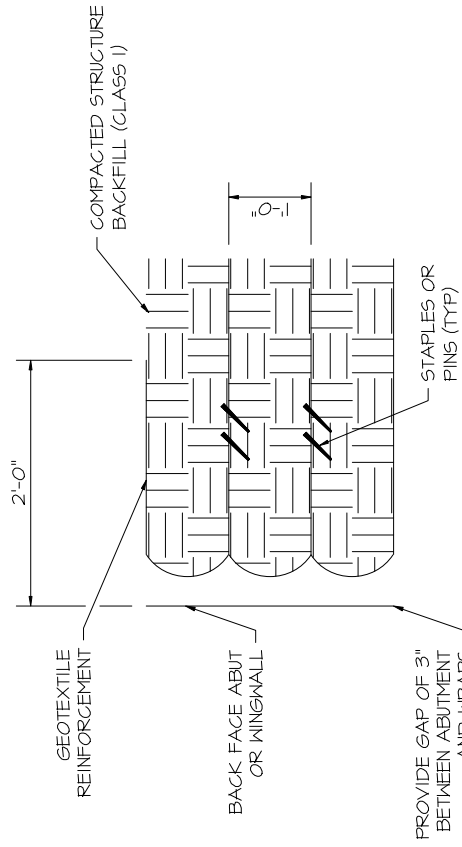

WRAP DETAIL

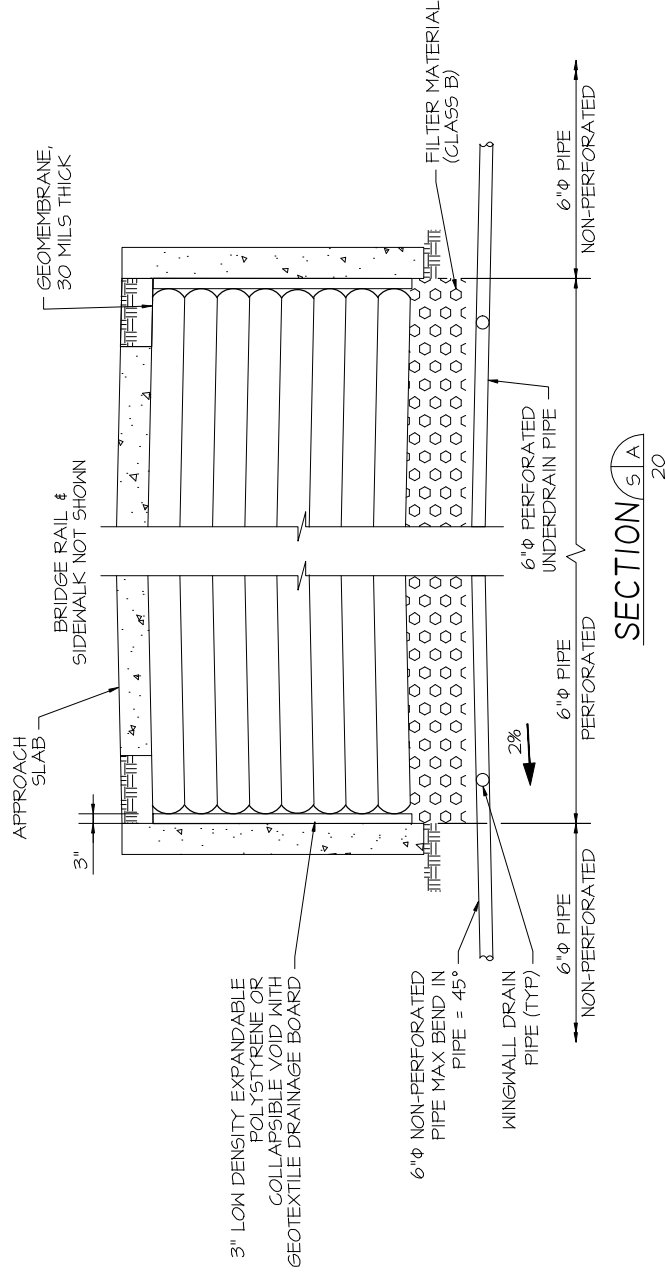



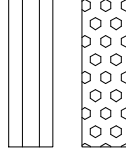


LEGEND



- NOTES:

1. REFER TO M-206-2 FOR EXCAVATION LIMITS.
2. GEOTEXTILE REINFORCEMENT SHALL BE MOVEN FABRIC WITH A MINIMUM AVERAGE ROLL VALUE OF 4800 LB/FT FOR INSTALLATIONS WITH A GAP AND 2400 LB/FT FOR INSTALLATIONS WITHOUT A GAP BASED ON ASTM D4545.
3. GEOTEXTILE REINFORCEMENT SHALL BE PLACED BY ALTERNATING MACHINE DIRECTION (MD) WITH CRO65 MACHINE DIRECTION (XD) FROM LAYER TO LAYER.
4. THE GEOTEXTILE REINFORCEMENT WRAP AT BACK FACE OF ABUTMENT SHALL BE PULLED BACK SLACK FREE WITH ITS END ANCHORED TO SOIL UNDERNEATH WITH STAPLES OR PINS.
5. MINIMUM SPLICE OF ALL GEOFABRIC SHALL CONSIST OF 6" OF OVERLAP.
6. PAYMENT FOR ALL WORK ITEMS SHOWN WILL BE MADE UNDER ITEM 206 MECHANICAL REINFORCEMENT OF SOIL (CY) AND ITEM 206 STRUCTURE BACKFILL (CLASS 1) (CY) AND SHALL INCLUDE THE COST FOR 6 INCH ϕ PERFORATED PIPE UNDERDRAIN AND SUBSURFACE DRAIN OUTLET (6 INCH ϕ NON-PERFORATED PIPE) AND FILTER MATERIAL (CLASS B) QUANTITIES.
7. INSTALLATION OF PIPE UNDERDRAIN, SUBSURFACE DRAIN OUTLET, AND GEOCOMPOSITE DRAIN WILL CONFORM TO THE CONSTRUCTION REQUIREMENTS OF SECTION 605.03, 605.06 AND 605.04, RESPECTIVELY.
8. GEOCOMPOSITE DRAINAGE BOARD SHALL BE PLACED ON THE SOIL SIDE OF WALLS AND ABUTMENTS.

AS-BUILT/ CONSTRUCTED

	REVISIONS		PREPARED FOR:		 	 		
	DATE	BY	DATE	BY				
	1 REVISED BEARING PAD DEPTH	49431	C5-14-21	HMR				
	2							
	3							
4								
5								
6								
7								
DESIGNED BY:		HMR		PROJECT TITLE		PROJECT LOCATION		
DRAWN BY:		AJM		FOREST LAKES BRIDGES		MONUMENT, CO		
PROJECT MANAGER:		HMR		BACKFILL DETAILS (2 OF 2)		STRUCTURE JOB: SHEET NO. B21		
DATE:		7/12/22						