

GUNTZELMAN PORCELAIN PINES SUBDIVISION


EPC STORMWATER REVIEW COMMENTS
IN ORANGE BOXES WITH BLACK TEXT

PUBLIC WATER LINE IMPROVEMENTS

COUNTY OF EL PASO, STATE OF COLORADO FEBRUARY 2023

Please remove the GEC Plan from this construction drawing submittal since the GEC Plan was submitted separately.

If these plans only show the design information for the water line improvements, where will the design work be shown for the road? Add roadwork design information to these plans

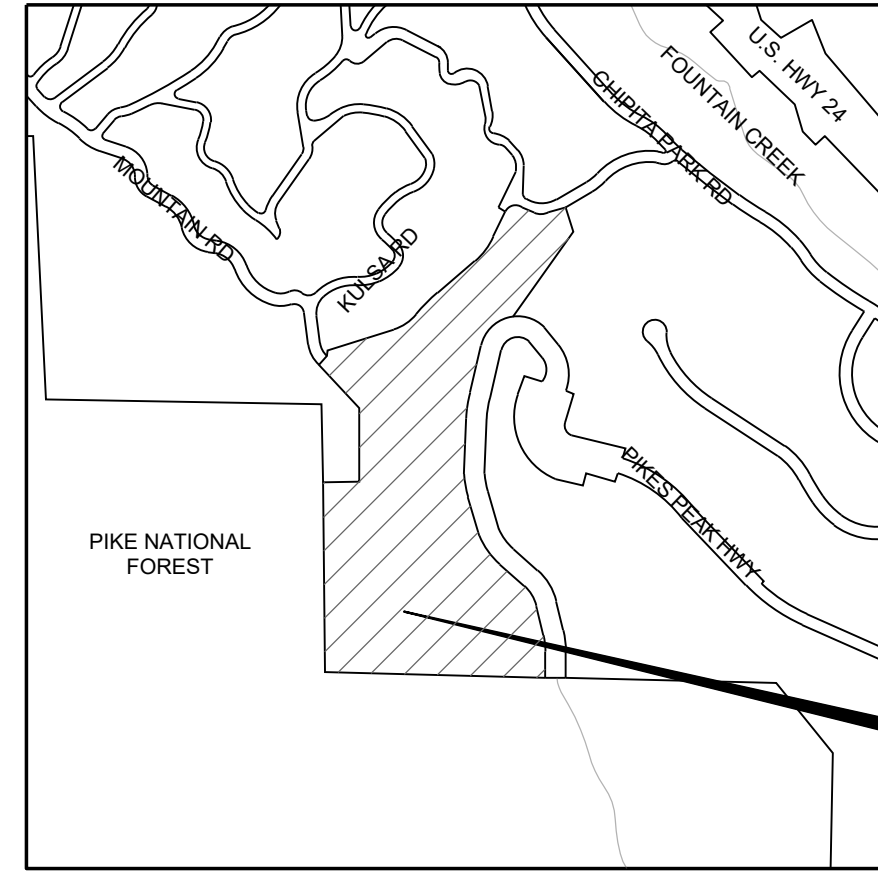

VICINITY MAP
(NOT TO SCALE)

PROJECT
LOCATION

OWNER/DEVELOPER PLAN APPROVAL

I, THE UNDERSIGNED OWNER/DEVELOPER AGREES THAT THEY SHALL, AT THEIR EXPENSE, BE SOLELY RESPONSIBLE FOR 1) THE INSTALLATION OF THE PROPOSED UTILITY INFRASTRUCTURE IN ACCORDANCE WITH THESE PLANS, AND 2) ALL DAMAGES AND DEFECTS ARISING FROM, OR RELATED TO, THE INSTALLATION, MAINTENANCE OR OPERATION OF THE PUBLIC UTILITY INFRASTRUCTURE FROM THE DATE OF PRELIMINARY ACCEPTANCE FOR A PERIOD OF TWO YEARS, OR UNTIL FINAL ACCEPTANCE, WHICHEVER IS LATER.

THE UNDERSIGNED UNDERSTANDS THAT ALL PRIVATE UTILITY INFRASTRUCTURE, AS INDICATED ON THESE PLANS, SHALL REMAIN THE PROPERTY OF THE OWNER AND SHALL BE MAINTAINED BY THE OWNER, AS REQUIRED BY COLORADO SPRINGS UTILITIES' LINE EXTENSION AND SERVICE STANDARDS.

PUBLIC FACILITIES PROPOSED PRIVATE FACILITIES PROPOSED

SIGNED: _____ DATE: _____
OWNER/DEVELOPER
Kristian Gunzelman
OWNER/DEVELOPER (PRINT NAME)

SIGNED: _____ DATE: _____
OWNER/DEVELOPER
Christa Gunzelman
OWNER/DEVELOPER (PRINT NAME)

DBA: _____

ADDRESS: 5381 Sugar Camp Road
Milford, OH 45150

PHONE: 513-722-4343 EMAIL: kristian.gunzelman@me.com

DESIGN PROFESSIONAL STATEMENT

THESE WATER/WASTEWATER PLANS WERE PREPARED UNDER MY DIRECT SUPERVISION IN ACCORDANCE WITH COLORADO SPRINGS UTILITIES CRITERIA.

BRETT LOUK, COLORADO P.E. NO. 0055474

DATE _____

LIST OF CONTACTS


OWNER:
KRISTIAN & CHRISTA GUNTZELMAN
5381 SUGAR CAMP ROAD
MILFORD, OH 45150
(513) 722-4343

ENGINEER:
BRETT LOUK
SMH CONSULTANTS, P.A.
411 SOUTH TEJON STREET, SUITE I
COLORADO SPRINGS, CO 80903
(719) 465-2145

UTILITY REVIEW - WATER/ELECTRIC:
COLORADO SPRINGS UTILITIES
1521 HANCOCK EXPRESSWAY
COLORADO SPRINGS, CO 80903
(719) 668-8262

UTILITY REVIEW - GAS:
BLACK HILLS ENERGY
198 COUNTY LINE ROAD
PALMER LAKE, CO 80133
(719) 332-5856

SURVEYOR:
TIM SLOAN, VICE PRESIDENT
SMH CONSULTANTS, P.A.
411 SOUTH TEJON STREET, STE I
COLORADO SPRINGS, CO 80903
(719) 465-2145

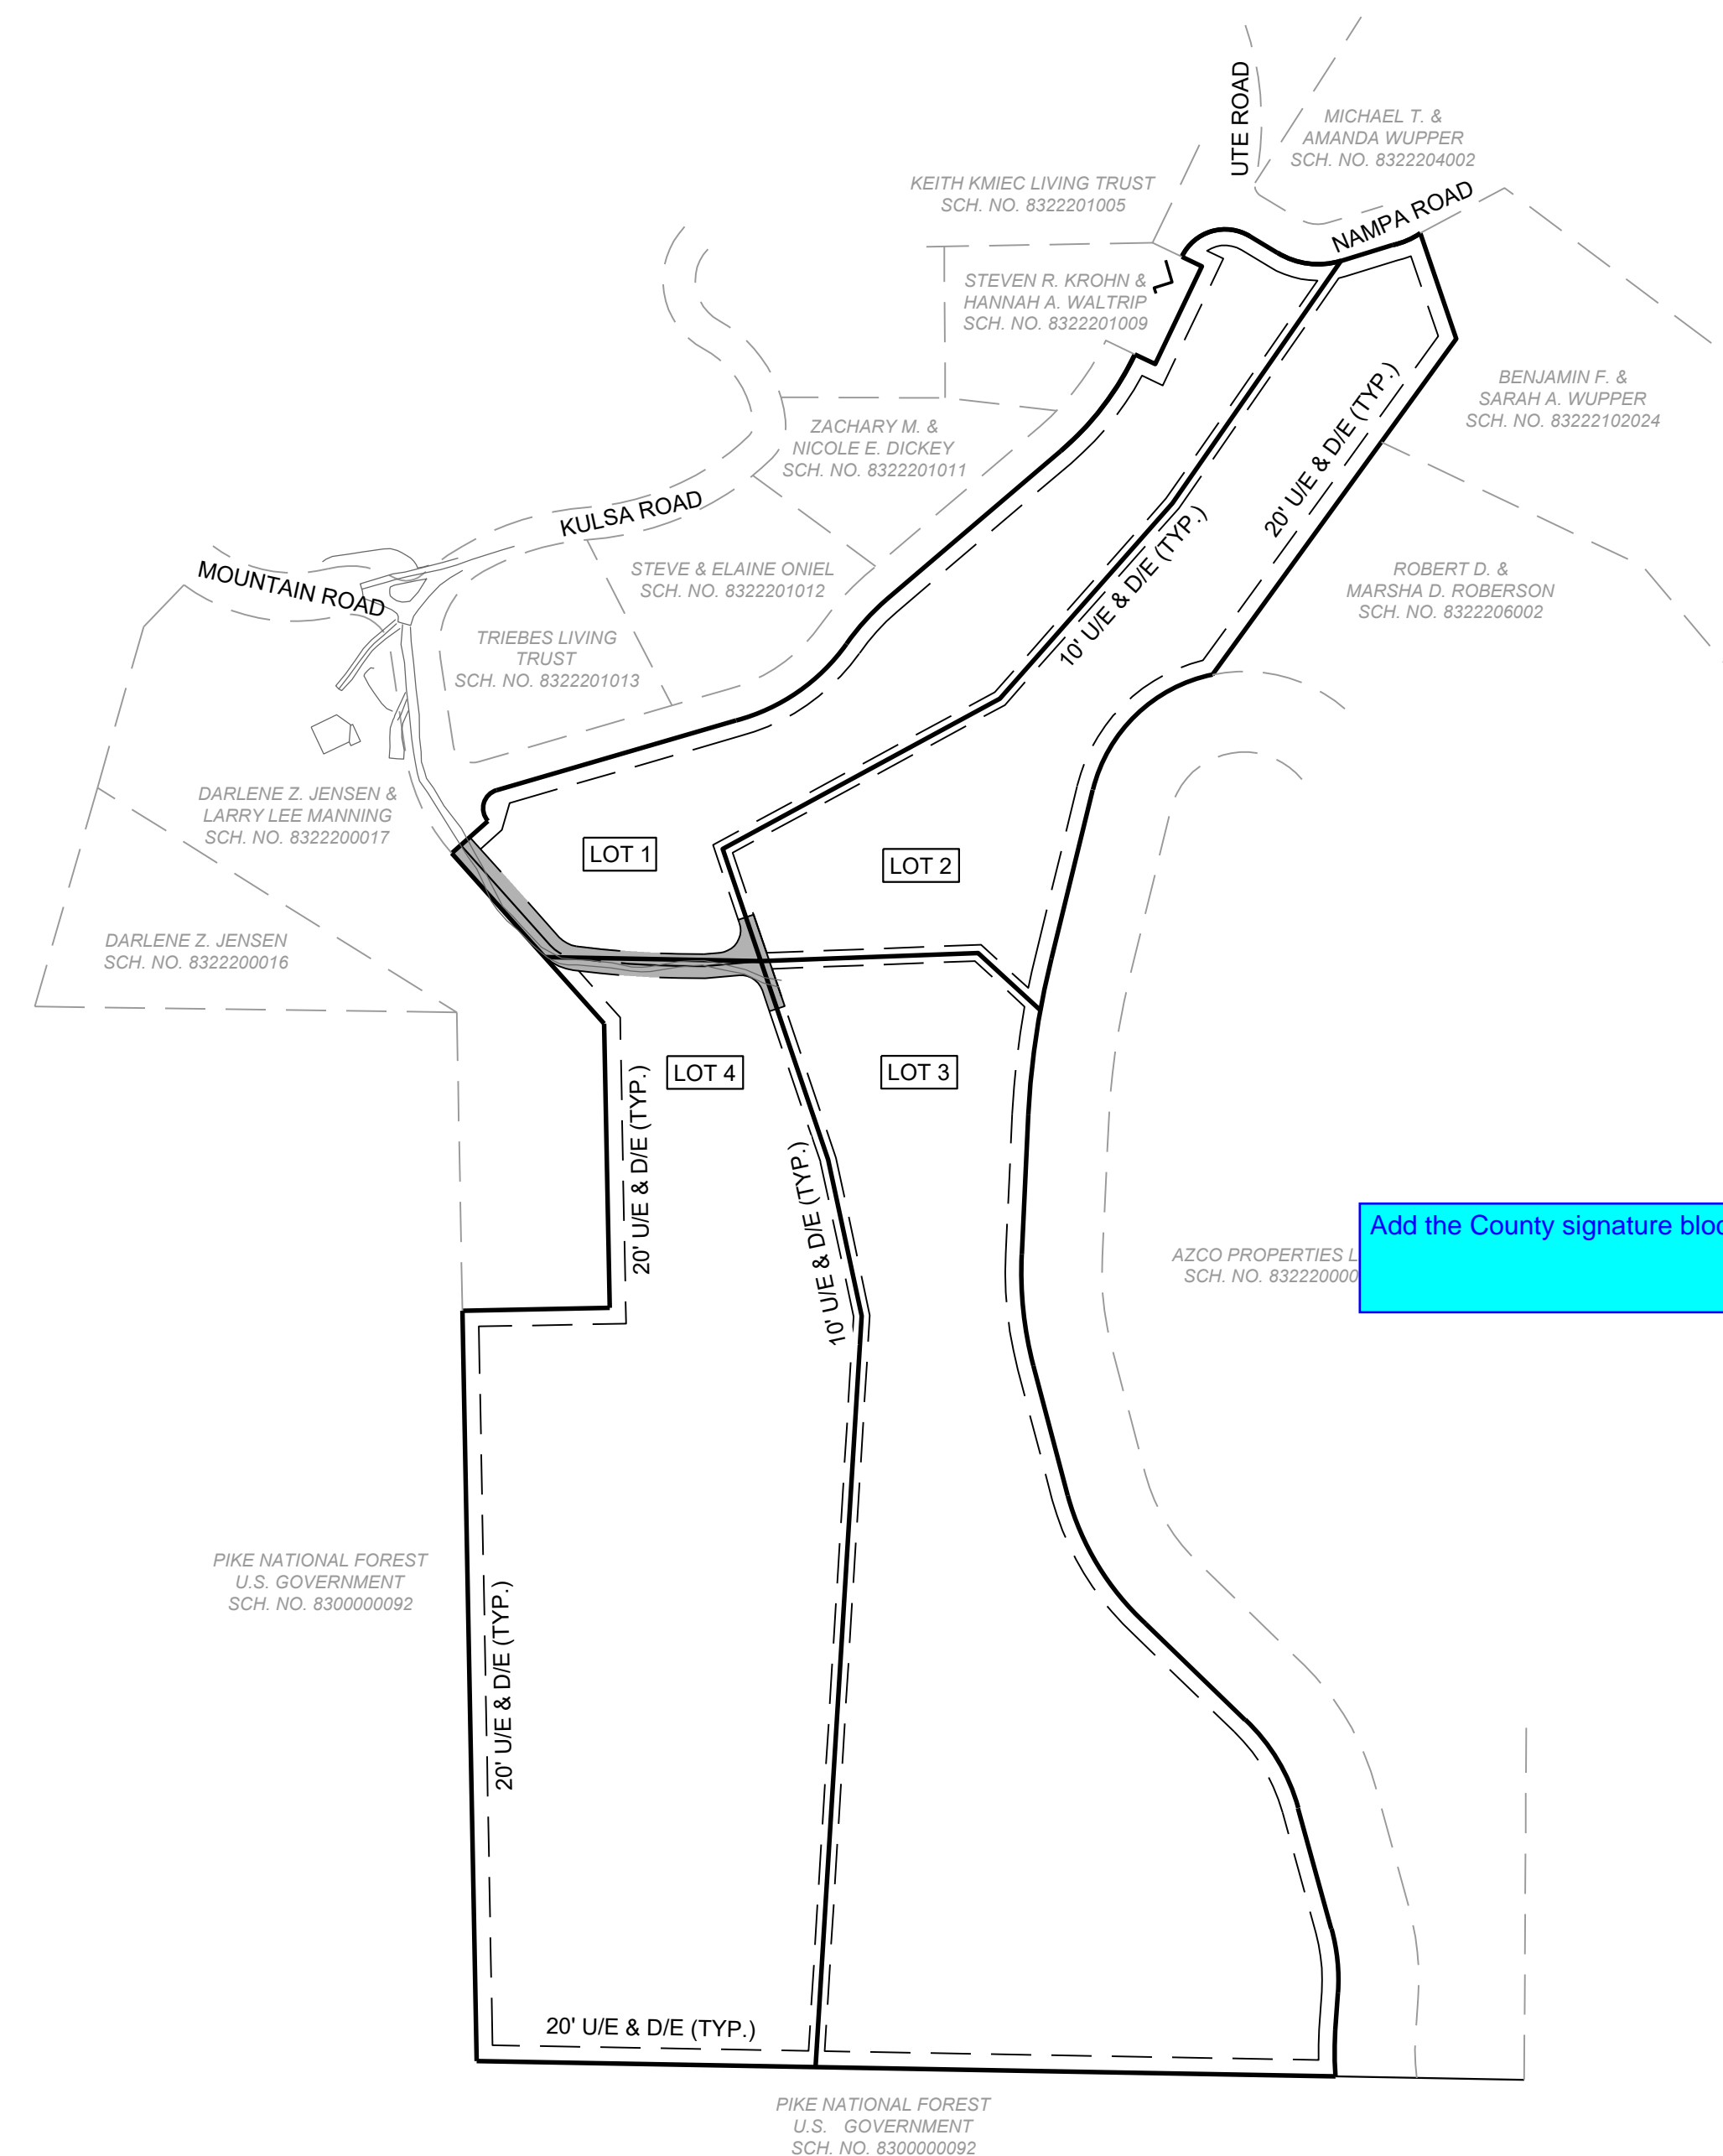

SITE MAP
SCALE: 1" = 200'

PLAN INFORMATION BLOCK

FIMS MAP NUMBER:
TAX SCHEDULE NO.: 8322200018
PRESSURE ZONE: UTE PASS LOWER
MAX STATIC PRESSURE: XX PSI
UTILITY DESIGN CAD FILE NO.:
UAP FILE NO.: N/A
DEVELOPMENT PLAN NO.: N/A
APPROVAL DATE: N/A
PLAT REC. NO.:
PUBLIC UTILITY EASEMENT REC. NO.: N/A
NOTICE OF PRIVATE WASTEWATER SYSTEM REC. NO.: N/A
NOTICE OF PRIVATE WATER SYSTEM REC. NO.: N/A

CAUTION - NOTICE TO CONTRACTORS:

- ALL UTILITY LOCATIONS SHOWN ARE BASED ON MAPS PROVIDED BY THE APPROPRIATE UTILITY COMPANY AND FIELD SURFACE EVIDENCE AT THE TIME OF SURVEY AND IS TO BE CONSIDERED AN APPROXIMATE LOCATION ONLY. IT IS THE CONTRACTOR'S RESPONSIBILITY TO FIELD VERIFY THE LOCATION OF ALL UTILITIES, PUBLIC OR PRIVATE, WHETHER SHOWN ON THE PLANS OR NOT PRIOR TO CONSTRUCTION. REPORT ANY DISCREPANCIES TO THE ENGINEER PRIOR TO CONSTRUCTION.
- WHERE A PROPOSED UTILITY CROSSES AN EXISTING UTILITY, IT IS THE CONTRACTOR'S RESPONSIBILITY TO FIELD VERIFY THE HORIZONTAL AND VERTICAL LOCATION OF SUCH EXISTING UTILITY, EITHER THROUGH POT-HOLING OR ALTERNATIVE METHOD. REPORT INFORMATION TO THE ENGINEER PRIOR TO CONSTRUCTION.

INDEX TO SHEETS

- WATER LINE COVER SHEET
- WATER LINE GENERAL NOTES
- WATER LINE PLAN
- WATER LINE DETAILS

SAFETY NOTICE TO CONTRACTOR:

IN ACCORDANCE WITH GENERALLY ACCEPTED CONSTRUCTION PRACTICES, THE CONTRACTOR WILL BE SOLELY AND COMPLETELY RESPONSIBLE FOR CONDITIONS OF THE JOB SITE, INCLUDING THE SAFETY OF ALL PERSONS AND PROPERTY DURING PERFORMANCE OF THE WORK. THIS REQUIREMENT WILL APPLY CONTINUOUSLY AND NOT BE LIMITED TO NORMAL WORKING HOURS.

WARRANTY / DISCLAIMER:

THE DESIGNS REPRESENTED IN THESE PLANS ARE IN ACCORDANCE WITH ESTABLISHED PRACTICES OF CIVIL ENGINEERING FOR THE DESIGN FUNCTIONS AND USES INTENDED BY THE OWNER AT THIS TIME. HOWEVER, NEITHER SMH CONSULTANTS NOR ITS PERSONNEL CAN OR DO WARRANTY THESE DESIGNS OR PLANS AS CONSTRUCTED, EXCEPT IN THE SPECIFIC CASES WHERE SMH CONSULTANTS INSPECTS AND CONTROLS THE PHYSICAL CONSTRUCTION ON THE SITE.

THE DESIGNS REPRESENTED IN THESE PLANS ARE BASED OFF OF A TOPOGRAPHIC SURVEY PREPARED BY RAMPART SURVERYS, LLC AND PROVIDED TO SMH CONSULTANTS. SMH CONSULTANTS NOR ITS PERSONNEL CAN OR DO WARRANTY THE ACCURACY OF THE TOPOGRAPHICAL SURVEY AND THEREFORE DOES NOT WARRANTY THAT PART OF THE DESIGN BASED ON THE TOPOGRAPHICAL SURVEY.

COLORADO SPRINGS UTILITIES RESIDENTIAL UTILITY SERVICE DESIGN APPROVAL

PROJECT NUMBER: 2021-W057
WORK ORDER NUMBER: 3721812

PROJECT NUMBER: N/A
WORK ORDER NUMBER: N/A
CSU SHEET _____ OF _____

APPROVAL EXPIRES ONE (1) YEAR FROM THE DATE ABOVE AND RESUBMITTAL OF THESE PLANS FOR REVIEW AND APPROVAL IS REQUIRED IF CONSTRUCTION DOES NOT BEGIN DURING THIS PERIOD.

COLORADO SPRINGS UTILITIES WATER MAIN DESIGN APPROVAL

PROJECT NUMBER: 2021-W057
WORK ORDER NUMBER: 3721812

CSU SHEET _____ OF _____

APPROVAL EXPIRES ONE (1) YEAR FROM THE DATE ABOVE AND RESUBMITTAL OF THESE PLANS FOR REVIEW AND APPROVAL IS REQUIRED IF CONSTRUCTION DOES NOT BEGIN DURING THIS PERIOD.



CALL BEFORE YOU
DIG - DRILL - BLAST

KANSAS:
P: 800-344-7233
F: 316-687-3753
COLORADO:
P: 800-922-1987
F: 303-234-1712

The utilities as shown on this drawing were developed from the information available. This is not implied nor intended to be the complete inventory of utilities in this area. It is the clients/contractors responsibility to verify the location of all utilities (whether shown or not) and protect said utilities from any damage.

Add "PCD File No. MS234"

SMH
CONSULTANTS

www.smhconsultants.com
Civil Engineering • Land Surveying
Landscape Architecture
Manhattan, KS - HQ
(785) 776-0541
Dodge City, KS
(620) 255-1952
Overland Park, KS
(913) 444-9615
Colorado Springs, CO
(719) 465-2145

GUNTZELMAN PORCELAIN PINES

PRELIMINARY DOCUMENTS NOT FOR CONSTRUCTION

EL PASO COUNTY, COLORADO


REVISION DESCRIPTION
(DESCRIPTION)

REVISION DATE

000000

NORTH

TITLE SHEET

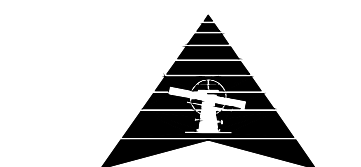

SCALE: 1" = 200'

PROJECT #: 2107-0307
CHECKED BY: BML
DRAWN BY: JAM

DATE: 02/15/2023

SHEET #

1

TOTAL SHEETS 6

WATER PLAN NOTES

THE CONTRACTOR SHALL NOTIFY COLORADO SPRINGS UTILITIES' INSPECTIONS OFFICE 719-668-4658 A MINIMUM OF 48 HOURS PRIOR TO THE START OF CONSTRUCTION.

GENERAL:

- ALL CONSTRUCTION METHODS AND MATERIALS SHALL MEET *COLORADO SPRINGS UTILITIES' WATER LINE EXTENSION AND SERVICE STANDARDS (WATER LESS)*.
- THE CONTRACTOR SHALL OBTAIN LOCATES PRIOR TO ANY EXCAVATION.
- COLORADO SPRINGS UTILITIES DOES NOT GUARANTEE THE ACCURACY OF LOCATIONS OF EXISTING PIPELINES, HYDRANTS, VALVES AND SERVICE LINES. IF FIELD CONDITIONS ARE FOUND TO BE DIFFERENT THAN SHOWN ON THE PLANS, THE CONTRACTOR SHALL NOTIFY THE INSPECTOR AND THE ENGINEER OF RECORD IMMEDIATELY.
- NO TREES OR STRUCTURES ARE PERMITTED WITHIN FIFTEEN FEET (15') OF A WATER MAIN.
- THE CONTRACTOR IS RESPONSIBLE FOR ANY DAMAGE TO ANY UTILITY FACILITIES AS A RESULT OF HIS ACTIONS. THE CONTRACTOR SHALL MAKE ALL THE REQUIRED REPAIRS IMMEDIATELY TO THE SATISFACTION OF COLORADO SPRINGS UTILITIES.
- ALL FIELD STAKING SHALL COMPLY WITH THE *WATER LESS*.
- THE CONTRACTOR SHALL MAKE THEIR BEST EFFORT TO ENSURE THAT WATER SERVICE TO ADJACENT PROPERTIES IS MAINTAINED DURING CONSTRUCTION.
- CORROSION PROTECTION MEASURES SHALL COMPLY WITH THE *WATER LESS*.
- NO SERVICE TAPS WILL BE ALLOWED UNTIL THE MAIN IS EXTENDED TO THE NEXT MAIN-LINE VALVE.
- NO SERVICE TAPS SHALL BE MADE UNTIL AUTHORIZATION HAS BEEN GRANTED BY THE COLORADO SPRINGS UTILITIES' INSPECTOR.
- ALL BENDS SHALL BE FIELD STAKED PRIOR TO CONSTRUCTION AND THE STATIONING ON THE FIELD STAKES SHALL MATCH THE STATIONING ON THE PLANS.
- FIELD MODIFICATIONS TO A FIRE SERVICE LINE OR FIRE HYDRANT DESIGN OR LOCATION MAY NEED TO BE APPROVED BY THE DESIGN ENGINEER, COLORADO SPRINGS FIRE DEPARTMENT AND COLORADO SPRINGS UTILITIES, AS REQUIRED BY THE INSPECTOR.
- REUSE OR SALVAGE OF ANY MATERIAL IS LEFT TO THE DISCRETION OF THE COLORADO SPRINGS UTILITIES INSPECTOR.
- ALL TRENCH BACKFILL AND COMPACTION SHALL BE IN ACCORDANCE WITH SECTION 206 OF THE *CITY OF COLORADO SPRINGS STANDARD SPECIFICATIONS MANUAL*.
- ALL WATER SERVICE LINES SHOULD ENTER THE BUILDING WITHIN 5 FEET OF AN EXTERIOR WALL. EXPOSED WATER PLUMBING SHALL BE MINIMIZED INSIDE THE BUILDING PRIOR TO THE WATER METER AND/OR APPROVED BACKFLOW PREVENTION ASSEMBLY OR METHOD.

WATER PROJECT - SPECIFIC NOTES

APPLICABLE	NOT-APPLICABLE	
<input type="checkbox"/>	<input checked="" type="checkbox"/>	ANY EXISTING STUBS AND APPURTENANCES THAT WILL NOT BE USED SHALL BE REMOVED AND REPLACED WITH AN ACCEPTABLE SECTION OF MAIN AT THE EXPENSE OF THE CONTRACTOR.
<input type="checkbox"/>	<input checked="" type="checkbox"/>	A CONNECTION TO AN EXISTING STUB IS PROPOSED. COLORADO SPRINGS UTILITIES DOES NOT GUARANTEE THE ACCURACY OF THE DEPTHS OR LOCATIONS OF EXISTING STUBS SHOWN ON ANY "AS-BUILT" DRAWINGS.
<input type="checkbox"/>	<input checked="" type="checkbox"/>	A WATER STUB-OUT(S) IS/ARE PROPOSED. COLORADO SPRINGS UTILITIES DOES NOT GUARANTEE THAT THE DESIGN OR INSTALLATION OF THE PROPOSED WATER STUB-OUT WILL MEET FUTURE DEVELOPMENT NEEDS.
<input type="checkbox"/>	<input checked="" type="checkbox"/>	A WATER QUALITY PLAN HAS BEEN APPROVED FOR THIS PROJECT

UTILITY SERVICE PLAN NOTES

THE CONTRACTOR SHALL NOTIFY COLORADO SPRINGS UTILITIES' INSPECTIONS OFFICE 719-668-4658 A MINIMUM OF 48 HOURS PRIOR TO THE START OF CONSTRUCTION.

GENERAL:

- ALL CONSTRUCTION METHODS AND MATERIALS SHALL MEET *COLORADO SPRINGS UTILITIES' WASTEWATER AND WATER LINE EXTENSION AND SERVICE STANDARDS (WATER/WASTEWATER LESS)*.
- COLORADO SPRINGS UTILITIES DOES NOT GUARANTEE THE ACCURACY OF LOCATIONS OF EXISTING PIPELINES, MANHOLES, HYDRANTS, VALVES AND SERVICE LINES. IF FIELD CONDITIONS ARE FOUND TO BE DIFFERENT THAN SHOWN ON THE PLANS, THE CONTRACTOR SHALL NOTIFY THE INSPECTOR AND THE DESIGN ENGINEER IMMEDIATELY.
- THE CONTRACTOR IS RESPONSIBLE FOR ANY DAMAGE TO ANY UTILITY FACILITIES AS A RESULT OF HIS ACTIONS. THE CONTRACTOR SHALL MAKE ALL THE REQUIRED REPAIRS IMMEDIATELY TO THE SATISFACTION OF COLORADO SPRINGS UTILITIES.
- ALL FIELD STAKING SHALL COMPLY WITH THE *WATER/WASTEWATER LESS*.
- CORROSION PROTECTION MEASURES SHALL COMPLY WITH THE *WATER/WASTEWATER LESS*.
- FINAL LOCATION OF ALL WASTEWATER AND WATER SERVICES SHALL BE APPROVED IN THE FIELD BY THE COLORADO SPRINGS UTILITIES INSPECTOR.
- ALL TRENCH BACKFILL AND COMPACTION SHALL BE IN ACCORDANCE WITH SECTION 206 OF THE *CITY OF COLORADO SPRINGS STANDARD SPECIFICATIONS MANUAL AND SECTION 5.18 OF THE WATER LESS*.

WASTEWATER:

- SERVICE STUBS SHALL BE INSTALLED A MINIMUM OF SEVEN FEET (7') INTO THE PROPERTY, UNLESS OTHERWISE SHOWN, AND THE END OF THE STUB SHALL BE MARKED WITH A 2"X4"X12" STEEL OR WOODEN POST.
- SERVICES SHALL BE CONNECTED A MINIMUM OF FIVE FEET (5') FROM THE OUTSIDE EDGE OF ANY MANHOLE ON THE MAIN LINE AND SHALL MAINTAIN TWO FEET (2') OF SEPARATION BETWEEN TAPS CENTER TO CENTER.
- ALL CLEANOUTS SHALL BE THE SAME SIZE AS THE SERVICE LINE.
- THE CONTRACTOR SHALL NOTIFY EL PASO COUNTY DEPARTMENT OF HEALTH AND ENVIRONMENT WHEN ANY SEPTIC TANK IS TO BE ABANDONED AND PAY ALL FEES NECESSARY TO OBTAIN A PERMIT.

WATER:

- SERVICE STUBS SHALL BE INSTALLED WITH THE CURB STOP AT OR NEAR PROPERTY LINE AND SHALL NOT BE INSTALLED WITHIN DRIVEWAYS OR SIDEWALKS (SEE DETAIL DRAWING B2-3).
- SERVICE TAPS SHALL BE MADE A MINIMUM OF THREE FEET (3') FROM THE BELL OR APPURTENANCE ON THE WATER MAIN. TAPS SHALL BE A MINIMUM OF THREE FEET (3') APART ON THE SAME SIDE OF THE WATER MAIN AND A MINIMUM OF ONE-AND-A-HALF FEET (1.5') WHEN TAPS ARE MADE ON OPPOSITE SIDES OF THE WATER MAIN.
- ALL SERVICES FOR COMMERCIAL USE AND SOME RESIDENTIAL USES REQUIRE INSTALLATION OF A BACKFLOW PREVENTION ASSEMBLY IMMEDIATELY AFTER THE METER. THE BACKFLOW PREVENTION ASSEMBLY SHALL BE APPROVED BY THE FOUNDATION FOR CROSS-CONNECTION CONTROL AND HYDRAULIC RESEARCH OF THE UNIVERSITY OF SOUTHERN CALIFORNIA (USC-FCCCHR) AND INSTALLED IN ACCORDANCE WITH THIS LISTING. PLEASE REFERENCE THE WATER LINE EXTENSION STANDARDS FOR ADDITIONAL REQUIREMENTS.
- ALL TAPS ON COLORADO SPRINGS UTILITIES WATER MAINS SHALL BE PERFORMED BY COLORADO SPRINGS UTILITIES. ALL OTHER TAPS SHALL BE PERFORMED BY THE CONTRACTOR.
- ANY ABANDONED SERVICES MUST BE PHYSICALLY DISCONNECTED AT THE MAIN. ANY NECESSARY REPAIRS TO THE MAIN AND/OR SHUT DOWN OF THE TAPPING VALVE SHALL BE AS DIRECTED BY COLORADO SPRINGS UTILITIES.
- ALL WATER SERVICE LINES SHOULD ENTER THE BUILDING WITHIN 5 FEET OF AN EXTERIOR WALL. EXPOSED WATER PLUMBING SHALL BE MINIMIZED INSIDE THE BUILDING PRIOR TO THE WATER METER AND/OR APPROVED BACKFLOW PREVENTION ASSEMBLY OR METHOD.
- ALL HDPE WATER SERVICE LINES MUST EXTEND A MINIMUM OF 6 INCHES ABOVE THE FLOOR AND BE 90 DEGREES FROM THE FLOOR PLAN TO ALLOW FOR BRACING AND TRANSITION TO THE METER LOOP ASSEMBLY.

LEGAL DESCRIPTION:

A portion of the parcel described in that Quitclaim Deed, recorded January 22, 2020 under Reception No. 220009194, in the Official Public Records of El Paso County, Colorado, located in the Northwest 1/4 of Section 22, Township 13 South, Range 68 West, of the 6th P.M., being more particularly described as follows,

COMMENCING at the Center 1/4 Corner of said Section 22; thence along the south line of the Southeast 1/4 of the Northwest 1/4 of said Section 22, N88°57'03"W, (Bearings are based on the south line of the Southeast 1/4 of the Northwest 1/4 of said Section 22, monumented at the Center 1/4 Corner of said Section 22 by a 1" iron pipe with a 2-1/2" brass cap stamped "1938 U.S. GENERAL LAND OFFICE SURVEY", 0.5' above grade and monumented at the West Center 1/16 Corner by a 1" iron pipe with a 2-1/2" brass cap stamped 1938 U.S. GENERAL LAND OFFICE SURVEY", flush with grade, having a measured bearing of N88°57'03"W, a distance of 1301.48 feet), a distance of 234.34 feet to the southeast corner of said parcel, being the POINT OF BEGINNING; thence continuing along said south line of the Southeast 1/4 of the Northwest 1/4 of said Section 22, N88°57'03"W, a distance of 1067.14 feet to the West 1/16 Corner of said Section 22; thence along the North-South Center line of the Northwest 1/4 of said Section 22, N01°07'31"W, a distance of 932.25 feet; thence leaving said North-South Center line, N88°52'29"E, a distance of 182.97 feet; thence N01°09'07"W, a distance of 353.05 feet; thence N41°49'19"W, a distance of 283.92 feet to a point on south right-of-way line of Nampa Road; thence along the south right-of-way line of said Nampa Road, the following seven (7) courses:

- N48°13'23"E, a distance of 60.11 feet;
- along the arc of a non-tangent curve to the right, whose center bears N48°07'42"E, having a radius of 23.65 feet, a central angle of 115°53'06", a distance of 47.83 feet;
- N73°46'14"E, a distance of 315.39 feet;
- along the arc of a non-tangent curve to the left, whose center bears N16°10'04"W, having a radius of 245.85 feet, a central angle of 38°16'52", a distance of 164.26 feet;
- along the arc of a reverse curve to the right, whose center bears S54°53'21"E, having a radius of 303.82 feet, a central angle 14°01'04", a distance of 74.33 feet;
- N49°31'01"E, a distance of 285.03 feet;
- along the arc of a non-tangent curve to the left, whose center bears N40°28'22"W, having a radius of 364.10 feet, a central angle of 23°57'14", a distance of 152.22 feet, to a point on the southeast line of that Right-of-Way Vacation recorded under Book 3122 Page 824 in the Official Public Records of El Paso County, Colorado;

Thence continuing along said southeast line of said Right-of-Way Vacation, N25°35'01"E, a distance of 134.87 feet; thence S64°25'10"E, a distance of 27.90 feet; thence N25°34'50"E, a distance of 134.68 feet; thence N64°25'10"W, a distance of 27.90 feet to a point on the south right-of-way line of Nampa Road; thence along said south right-of-way line, the following five (5) courses:

- along the arc of a non-tangent curve to the right, whose center bears S64°26'18"E, having a radius of 59.60 feet, a central angle of 95°53'57", a distance of 90.76 feet;
- S58°29'48"E, a distance of 40.03 feet;
- along the arc of a non-tangent curve to the left, whose center bears N31°15'02"E, having a radius of 96.71 feet, a central angle of 48°28'43", a distance of 81.83 feet;
- N72°58'37"E, a distance of 67.62 feet;
- along the arc of a non-tangent curve to the left, whose center bears N12°19'30"W, having a radius of 96.71 feet, a central angle of 22°07'11", a distance of 37.34 feet, to a point on the west line of Pikes Peak Mountain Estates, recorded November 5, 2001 under Reception No. 201161507;

Thence continuing along said west line of Pikes Peak Mountain Estates, the following two (2) courses:

- S18°49'36"E, a distance of 136.79 feet;
- S35°59'27"W, a distance of 515.72 feet, to a point on the west right-of-way line of Pikes Peak Toll Road;

Thence continuing along said west right-of-way line of Pikes Peak Toll Road, the following, thirteen (13) courses:

- Along the arc of a non-tangent curve to the left, whose center bears S11°39'01"E, having a radius of 193.42 feet, a central angle of 64°29'48", a distance of 217.73 feet;
- S13°45'10"W, a distance of 216.22 feet;
- Along the arc of a non-tangent curve to the left, whose center bears S76°02'47"E, having a radius of 1005.40 feet, a central angle of 11°10'16", a distance of 196.03 feet;
- S02°43'25"W, a distance of 173.36 feet;
- Along the arc of a non-tangent curve to the left, whose center bears S87°14'50"E, having a radius of 460.30 feet, a central angle of 17°26'00", a distance of 140.06 feet;
- S14°46'15"E, a distance of 167.06 feet;
- Along the arc of a non-tangent curve to the left, whose center bears S74°40'19"E, having a radius of 338.00 feet, a central angle of 31°57'04", a distance of 186.49 feet;
- S45°59'03"E, a distance of 171.85 feet;
- Along the arc of a non-tangent curve to the right, whose center bears S43°26'18"E, having a radius of 238.00 feet, a central angle of 31°14'04", a distance of 129.74 feet;
- S15°27'25"E, a distance of 155.45 feet;
- Along the arc of a non-tangent curve to the right, whose center bears S74°31'58"E, having a radius of 238.00 feet, a central angle of 19°18'37", a distance of 80.21 feet;
- S43°26'18"E, a distance of 46.77 feet;
- Along the arc of a non-tangent curve to the left, whose center bears S86°04'29"E, having a radius of 363.70 feet, a central angle of 09°00'56", a distance of 57.23 feet, to the POINT OF BEGINNING.

BENCHMARK:
SURVEY CONTROL POINT AND PROPERTY CORNER
AS SHOW HEREON.



www.smhconsultants.com
Civil Engineering • Land Surveying
Landscape Architecture
Manhattan, KS - HQ
(785) 776-0541
Dodge City, KS
(620) 255-1952
Overland Park, KS
(913) 444-9615
Colorado Springs, CO
(719) 465-2145

GUNTZELMAN PORCELAIN PINES

PRELIMINARY DOCUMENTS NOT FOR CONSTRUCTION



EL PASO COUNTY, COLORADO

REVISION DESCRIPTION
(DESCRIPTION)



REVISION DATE
00/00/00

NORTH

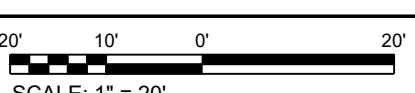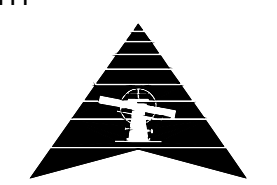

SCALE: 1" = 20'

PROJECT #: 2107-0307
CHECKED BY: BML
DRAWN BY: JAM

DATE: 02/15/2023

SHEET #

2

TOTAL SHEETS 6



CALL BEFORE YOU
DIG - DRILL - BLAST
KANSAS:
P: 800-344-7233
F: 316-887-3753
COLORADO:
P: 800-922-1987
F: 303-234-1712

The utilities as shown on this drawing were developed from the information available. This is not implied nor intended to be the complete inventory of utilities in this area. It is the clients/contractors responsibility to verify the location of all utilities (whether shown or not) and protect said utilities from any damage.

WATER LINE GENERAL NOTES

DESIGN GUIDELINES FOR PRIVATE STREET WITH PUBLIC UTILITIES

MANDATORY DESIGN REQUIREMENTS:

- ALL DRIVE AISLES AND UTILITY INSTALLATIONS SHALL BE IN ACCORDANCE WITH CITY SPECIFICATIONS AND THE COLORADO SPRINGS UTILITIES LINE EXTENSION & SERVICE STANDARDS.
- THE GAS MAIN MAY BE CENTERED IN THE DRIVE AISLE AS DIRECTED BY COLORADO SPRINGS UTILITIES FIELD ENGINEERS.
- ELECTRIC CONDUIT IS REQUIRED FOR ALL SECONDARY SERVICE CONDUCTORS. THE DEVELOPER/CONTRACTOR SHALL PROVIDE AND INSTALL THE SECONDARY SERVICES WITH THE APPROVAL AND INSPECTION BY COLORADO SPRINGS UTILITIES FIELD ENGINEERS.
- ADEQUATE SPACE FOR TRANSFORMERS SHALL BE PROVIDED OUTSIDE THE DRIVE AISLE AND THE LOCATION OF THE TRANSFORMER MUST BE APPROVED BY COLORADO SPRINGS UTILITIES FIELD ENGINEERS. BOLLARDS MAY BE REQUIRED FOR THE PROTECTION OF ELECTRICAL EQUIPMENT AND/OR TRANSFORMERS. REFERENCE THE ELECTRIC LINE EXTENSION & SERVICE STANDARDS APPENDIX F STANDARD 15-2 AND 18-302.
- BOLLARDS ARE REQUIRED FOR THE PROTECTION OF GAS METERS. REFERENCE THE GAS LINE EXTENSION & SERVICE STANDARDS FIGURE 10.

WASTEWATER:


- THE DIAMETER OF THE WASTEWATER MAIN SHALL NOT BE GREATER THAN 8 INCHES.
- THE MAXIMUM DEPTH OF THE WASTEWATER MAIN SHALL NOT BE GREATER THAN 14 FEET MEASURED FROM FINAL GRADE (PAVEMENT) TO THE WASTEWATER PIPE INVERT.
- COLORADO SPRINGS UTILITIES-APPROVED, LOAD-RATED, SLIP TYPE VALVE BOX TOP SECTIONS ARE REQUIRED OVER STANDARD WASTEWATER SERVICE LINE CLEANOUTS. VALVE BOX TOPS TO BE MARKED WITH "SEWER". CLEANOUT LIDS SHALL BE RECESSED 4 TO 6 INCHES BELOW FINAL GRADE. SEE DETAIL BELOW.


WATER:

- THE DIAMETER OF THE WATER MAIN SHALL NOT BE GREATER THAN 8 INCHES.
- COLORADO SPRINGS UTILITIES-APPROVED, LOAD-RATED, SLIP TYPE VALVE BOX TOP SECTION ARE REQUIRED OVER STANDARD WATER STOP BOXES. CURB STOP LID SHALL BE RECESSED 3-4 INCHES BELOW FINAL GRADE. VALVE BOX TOPS TO BE MARKED WITH "WATER". SEE DETAIL BELOW.

NOTE:

- THE UTILITY SERVICE PLAN FOR THE PROPOSED DEVELOPMENT SHALL SHOW THE PROJECT-SPECIFIC LOCATION OF ALL UTILITIES AND APPURTENANCES SHOWN ON DETAIL DRAWINGS A3-14 AND A3-15. APPROVAL SHALL BE ON A CASE BY CASE BASIS.

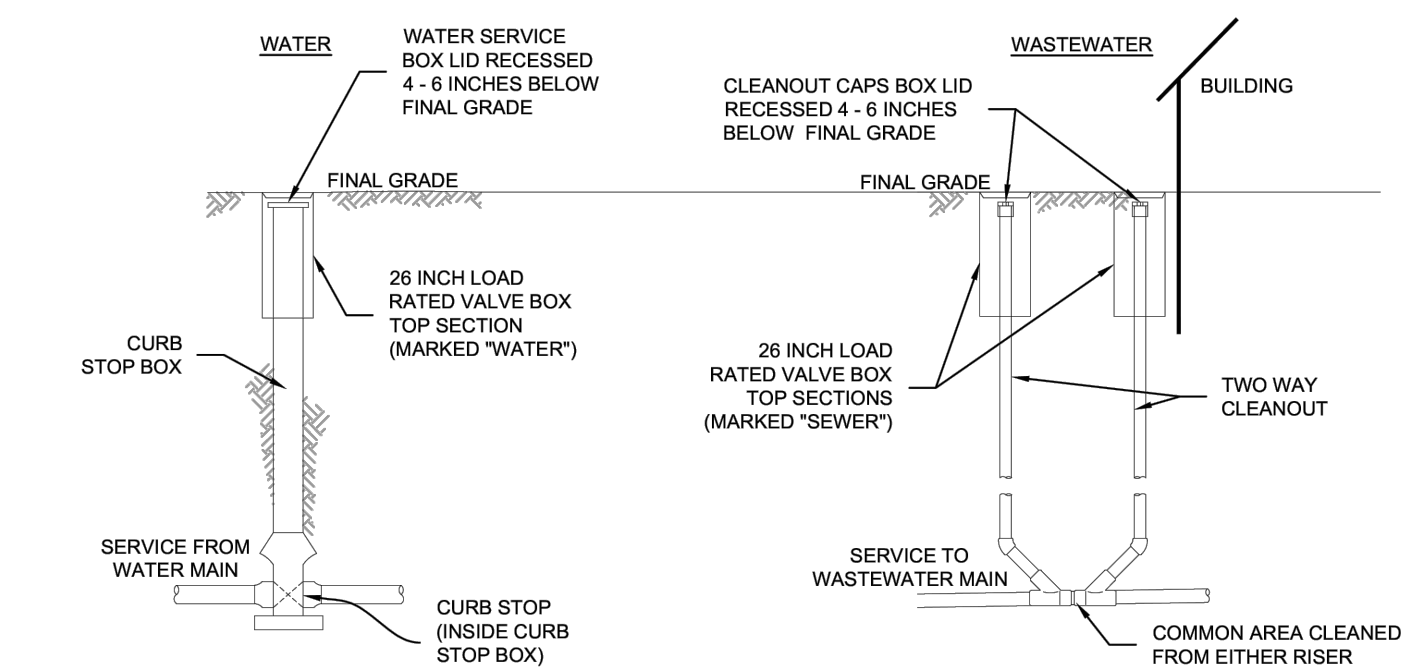



PRIVATE STREET WITH PUBLIC UTILITIES GUIDELINES

A3-12
DATED 07/2022


DESIGN GUIDELINES FOR PRIVATE STREET WITH PUBLIC UTILITIES

WATER:

- THE DIAMETER OF THE WATER MAIN SHALL NOT BE GREATER THAN 8 INCHES. COLORADO SPRINGS UTILITIES-APPROVED, LOAD-RATED, SLIP TYPE VALVE BOX TOP SECTIONS ARE REQUIRED OVER STANDARD WATER STOP BOXES. CURB STOP LID SHALL BE RECESSED 3-4 INCHES BELOW FINAL GRADE. VALVE BOX TOPS TO BE MARKED WITH "WATER". SEE DETAIL DRAWING A3-12.
- CURB STOPS SHALL BE LOCATED ON A CASE BY CASE BASIS PER THE FOLLOWING OPTIONS:
 - TO INSTALL CURB STOPS IN THE DRIVEWAY, CURB STOP SHALL BE LOCATED A MINIMUM OF 2 FT FROM THE EDGE OF ASPHALT OR CURB AND GUTTER. THE CURB STOP SHALL BE LOCATED A MINIMUM OF 6 FEET FROM THE FOUNDATION PROVIDED THE FOUNDATION HAS A MINIMUM 3 FOOT BELOW FINISHED GRADE FOUNDATION WALL (THIS ALLOWS FOR A 1.5:1 SLOPE WITHOUT UNDERMINING THE BUILDING FOUNDATION). CURB STOPS SHALL BE INSTALLED IN ADJUSTABLE TRAFFIC RATED BOXES PER THE CURRENT WATER LESS. SEE DETAIL DRAWING A3-15.
 - GIVEN THE NEED FOR 1 FOOT OF SEPARATION BETWEEN EDGE OF ASPHALT / BACK OF CURB & GUTTER TO THE UTILITY TRENCH, A 2 FEET WIDE TRENCH, AND 2 FEET OF SEPARATION BETWEEN THE TRENCH AND THE CENTER OF THE CURB STOP, IT IS UNLIKELY THAT DRIVEWAYS CAN BE MUCH LESS THAN 11 FEET LONG. SOME FLEXIBILITY FROM THESE DRIVEWAY LENGTH REQUIREMENTS MAY BE SUPPORTED WHERE ONE OR MORE OF THE FOLLOWING CONDITIONS EXIST:
 - CURVED STREETS RESTRICT THE ABILITY TO PROVIDE ALL UNITS OF STRUCTURE TO COMPLY WITH DRIVEWAY LENGTH STANDARDS.
 - DESIRE FOR ARCHITECTURAL ARTICULATION WITHIN INDIVIDUAL STRUCTURES CREATE VARIABLE DRIVEWAY LENGTHS.
 - THE PROVISION OF AMPLE ON-STREET AND/OR OFF-STREET GUEST PARKING WITHIN THE PROJECT REDUCES THE DEMAND TO PARK IN UNIT DRIVEWAYS.
 - SLOPE OR OTHER SITE CONSTRAINTS RESTRICT THE ABILITY FOR ALL UNITS OF STRUCTURE TO COMPLY WITH DRIVEWAY LENGTH STANDARDS.
- LOCATE CURB STOPS IN PRIVATE STREETS. CURB STOPS SHALL BE INSTALLED IN ADJUSTABLE TRAFFIC RATED BOXES. SEE DETAIL DRAWING A3-15.
- CONSTRUCT A MANIFOLD IN OPEN SPACES OR AREAS WHERE SEPARATION CRITERIA FROM UTILITIES AND STRUCTURES CAN BE MET. SEE DETAIL DRAWING A3-17. COLORADO SPRINGS UTILITIES SHALL MAINTAIN THE SERVICE LINE FROM THE PUBLIC WATER MAIN TO THE SECONDARY CURB STOP. THE INDIVIDUAL PROPERTY OWNER SHALL MAINTAIN THE WATER SERVICE LINE FROM THE SECONDARY CURB STOP TO THE PREMISE TO BE SERVED. IF THE CUSTOMER DAMAGES THE SECONDARY CURB STOP THEY SHALL BE RESPONSIBLE FOR ITS REPAIR. IF THE WATER SERVICE LINE CROSSES PRIVATE PROPERTY A PRIVATE EASEMENT SHALL BE REQUIRED OF SUFFICIENT WIDTH TO ALLOW FOR FUTURE OPERATION AND MAINTENANCE.
- CONSTRUCT PRIVATE COMMON SERVICE LINES FROM THE MAIN TO EACH UNIT WITH A MASTER METER, AND BACKFLOW PREVENTION ASSEMBLY. THE RESPONSIBILITY FOR MAINTENANCE OF COMMON SERVICE LINES AND MASTER METERS SHALL BE THE HOMEOWNERS ASSOCIATION OR ANOTHER COMMERCIAL ENTITY. SEE DETAIL DRAWING A3-19.
- UNIT DEVELOPMENTS FOR RESIDENTIAL PURPOSES THAT HAVE EACH UNIT SEPARATELY METERED ARE NOT REGULATED FOR BACKFLOW PREVENTION, AND DO NOT AUTOMATICALLY REQUIRE BACKFLOW PREVENTION. HOWEVER, IF THE BUILDING HAS MULTIPLE UNITS SERVED BY A SINGLE METER, IT IS REGULATED AND REQUIRES A BACKFLOW PREVENTION ASSEMBLY SEE SECTION 2.7.7 FOR REQUIREMENTS.

NOTE:

- THE DEVELOPMENT PLAN FOR THE PROPOSED DEVELOPMENT SHALL SHOW TYPICAL DETAILS FOR THE PROJECT-SPECIFIC LOCATION OF ALL UTILITIES, SERVICE LINES, CURB STOPS AND APPURTENANCES. LOCATION APPROVAL SHALL BE ON A CASE BY CASE BASIS.



PRIVATE STREET WITH PUBLIC UTILITIES GUIDELINES

A3-13
DATED 11/2022

PER SLIP JOINT OF DIP PIPE

PIPE DATA	MFRSL DEFL.	DESIGN DEFLECTION (80% MAX.)		APPROX. RADIUS FOR DEFLECTING CURVES WITHOUT BENDS	
		(HORZ. DEFL.)	(VERT. DEFL.)	20'	10'
4"					
6"					
8"	5'00"	4'00"	6.99%	286'	256'
10"					
12"					
14"	4'00"	3'12"	5.59%	356'	322'
16"					
18"					
20"					
24"	3'00"	2'24"	4.19%	477'	430'
30"					
36"					
42"	2'00"	1'36"	2.79%	716'	645'

SHADED COLUMN IS MANUFACTURERS REFERENCE ONLY


PER SLIP JOINT OF PVC PIPE WHICH DEFLECTION COUPLINGS

PIPE DATA	MFRSL TOTAL JOINT DEFL. W/ COUPL.	DESIGN DEFLECTION (80% MAX.)		MIN. RADIUS FOR DEFLECTING CURVES WITH HIGH DEFLECT. COUPLINGS
		(HORZ. DEFL.)	(VERT. DEFL.)	
4"	5'00"	4'00"	6.99%	286'
6"	5'00"	4'00"	6.99%	286'
8"	5'00"	4'00"	6.99%	286'
12"	5'00"	4'00"	6.99%	286'
18"				
NO DEFLECTION COUPLINGS FOR 18" OR GREATER				

SHADED COLUMN IS MANUFACTURERS REFERENCE ONLY

NOTES:

- COLORADO SPRINGS UTILITIES USES A 1.25 SAFETY FACTOR TO AVOID OVER DEFLECTION OF THE PIPE.
- SLIP JOINT PVC PIPE SHALL NOT BE DEFLECTED WITHOUT THE USE OF HIGH DEFLECTION COUPLINGS (HDC).



MAXIMUM PIPELINE DEFLECTION DATA FOR DIP AND PVC PIPE

A4-1
DATED 03/2014

THRUST BLOCK DIMENSIONS AND VOLUMES - PVC & DIP 250 psi

MAIN SIZE (in.)	TYPE OF FITTING	MINIMUM BEARING SURFACE AREA (ft²)	MINIMUM A _y (ft)	MINIMUM A _x (ft)	MINIMUM C _y (ft)	MINIMUM C _x (ft)	MINIMUM B (ft)	APPROXIMATE VOLUME (yd³)
4	11.25" BEND	1.00	1.00	1.00	0.25	0.33	2.00	0.25
4	22.5" BEND	2.00	1.41	1.41	0.21	0.33	2.00	0.25
4	45" BEND	3.50	1.87	1.87	0.42	0.33	2.00	0.25
4	TEE & DEAD END	4.75	2.18	2.18	0.67	0.33	2.00	0.25
6	11.25" BEND	2.00	1.41	1.41	0.25	0.50	2.00	0.25
6	22.5" BEND	3.75	1.94	1.94	0.38	0.50	2.00	0.25
6	45" BEND	7.25	2.69	2.69	0.58	0.50	2.00	0.25
6	TEE & DEAD END	9.50	3.08	3.08	0.83	0.50	2.00	0.50
8	11.25" BEND	3.25	1.80	1.80	0.34	0.67	2.00	0.25
8	22.5" BEND	6.50	2.55	2.55	0.48	0.67	2.00	0.25
8	45" BEND	12.50	3.57	3.50	0.87	0.67	2.00	0.50
8	TEE & DEAD END	16.25	4.54	3.50	1.08	0.67	2.00	0.75

THRUST BLOCK DIMENSIONS AND VOLUMES - PVC (Maximum Static Pressure = 170 psi)


MAIN SIZE (in.)	TYPE OF FITTING	MINIMUM BEARING SURFACE AREA (ft²)	MINIMUM A _y (ft)	MINIMUM A _x (ft)	MINIMUM C _y (ft)	MINIMUM C _x (ft)	MINIMUM B (ft)	APPROXIMATE VOLUME (yd³)
12	11.25" BEND	4.75	2.18	2.18	0.43	1.00	2.00	0.25
12	22.5" BEND	9.25	3.04	3.04	0.64	1.00	2.00	0.50
12	45" BEND	18.00	4.92	3.89	1.00	1.00	2.00	0.75
12	TEE & DEAD END	23.50	6.42	3.86	1.46	1.00	2.48	1.00
16	11.25" BEND	8.00	2.83	2.83	0.44	1.33	2.00	0.50
16	22.5" BEND	16.00	4.27	3.75	0.66	1.33	2.00	0.75
16	45" BEND	31.00	6.27	3.75	1.00	1.33	3.64	1.75
16	TEE & DEAD END	40.50	10.80	3.75	1.92	1.33	4.44	3.00

THRUST BLOCK DIMENSIONS AND VOLUMES - DIP (Maximum Static Pressure = 250 psi)

MAIN SIZE (in.)	TYPE OF FITTING	MINIMUM BEARING SURFACE AREA (ft²)	MINIMUM A _y (ft)	MINIMUM A _x (ft)	MINIMUM C _y (ft)	MINIMUM C _x (ft)	MINIMUM B (ft)	APPROXIMATE VOLUME (yd³)
12	11.25" BEND	6.75	2.60	2.60	0.43	1.00	2.00	0.50
12	22.5" BEND	13.50	3.99	3.96	0.84	1.00	2.00	0.90
12	45" BEND	26.25	7.17	3.66	1.00	1.00	3.09	1.50
12	TEE & DEAD END	34.25	9.36	3.66	1.46	1.00	3.95	2.25
16	11.25" BEND	11.75	3.43	3.43	0.44	1.33	2.00	0.50
16	22.5" BEND	23.25	6.20	3.75	0.66	1.33	2.77	1.00
16	45" BEND	45.50	12.13	3.75	1.00	1.33	5.57	4.00
16	TEE & DEAD END	59.50	15.87	3.75	1.92	1.33	6.98	6.50

NOTES:


- THE MINIMUM BEARING SURFACE AREAS SHOWN ARE BASED ON A MAX STATIC PIPE PRESSURE OF 170/250 POUNDS PER SQUARE INCH PLUS A SAFETY FACTOR OF 1.5 AND AN ALLOWABLE SOIL BEARING CAPACITY OF 1500 POUNDS PER SQUARE FOOT. BEARING SURFACE AREA IS ROUNDED UP TO THE NEAREST 0.25 SQUARE FEET. REFERENCE AWWA M-23 AND M-41.
- THE DESIGN ENGINEER IS RESPONSIBLE FOR VERIFYING ASSUMPTIONS BASED ON ACTUAL SITE CONDITIONS. IF SITE CONDITIONS VARY FROM THE ASSUMPTIONS THE DESIGN ENGINEER SHALL PROVIDE A SITE SPECIFIC DESIGN IN ACCORDANCE WITH AWWA M-23, PVC PIPE - DESIGN AND INSTALLATION AND AWWA M-41, DUCTILE-IRON PIPE AND FITTINGS. SITE SPECIFIC DESIGNS INCLUDING GEOTECHNICAL INFORMATION SHALL BE SUBMITTED TO COLORADO SPRINGS UTILITIES FOR REVIEW.
- THE MINIMUM BEARING SURFACE AREA AND APPROXIMATE VOLUME OF CONCRETE SHALL BE SHOWN ON THE CONSTRUCTION PLANS FOR ALL CONCRETE THRUST BLOCKS. CONCRETE MIX SHALL BE PER MATERIAL CHAPTER 4.
- THE APPROXIMATE VOLUMES SHOWN ARE BASED ON THE MINIMUM BEARING SURFACE AREA AND THE MINIMUM TRENCH DIMENSIONS. THE APPROXIMATE VOLUME IS ROUNDED UP TO THE NEAREST 0.25 CUBIC YARDS.
- THESE CHARTS MAY ONLY BE USED IF THE BLOCK HEIGHT (A_y) IS EQUAL TO OR LESS THAN ONE HALF THE TOTAL DEPTH (H_t) FROM THE FINISHED GRADE TO THE BOTTOM OF THE BLOCK. THE MINIMUM DIMENSIONS SHOWN ARE BASED ON A PIPE DEPTH OF 5 FEET. SEE DETAIL DRAWING A4-3.
- A SITE SPECIFIC DESIGN SHALL BE REQUIRED FOR PIPES LARGER THAN 18 INCHES OR MAX STATIC PIPE PRESSURES GREATER THAN 250 POUNDS PER SQUARE INCH. THE DESIGN ENGINEER HAS THE OPTION OF PROVIDING A SITE SPECIFIC DESIGN FOR PIPES SMALLER THAN 16 INCHES OR MAX STATIC PRESSURES LESS THAN 250 POUNDS PER SQUARE INCH.
- ALL CALCULATIONS SHALL BE PROVIDED TO COLORADO SPRINGS UTILITIES FOR REVIEW.



CONCRETE THRUST REACTION BLOCKS

A4-2
DATED 03/2014


CONCRETE THRUST REACTION BLOCK REQUIREMENTS FOR TEES OR TAPS

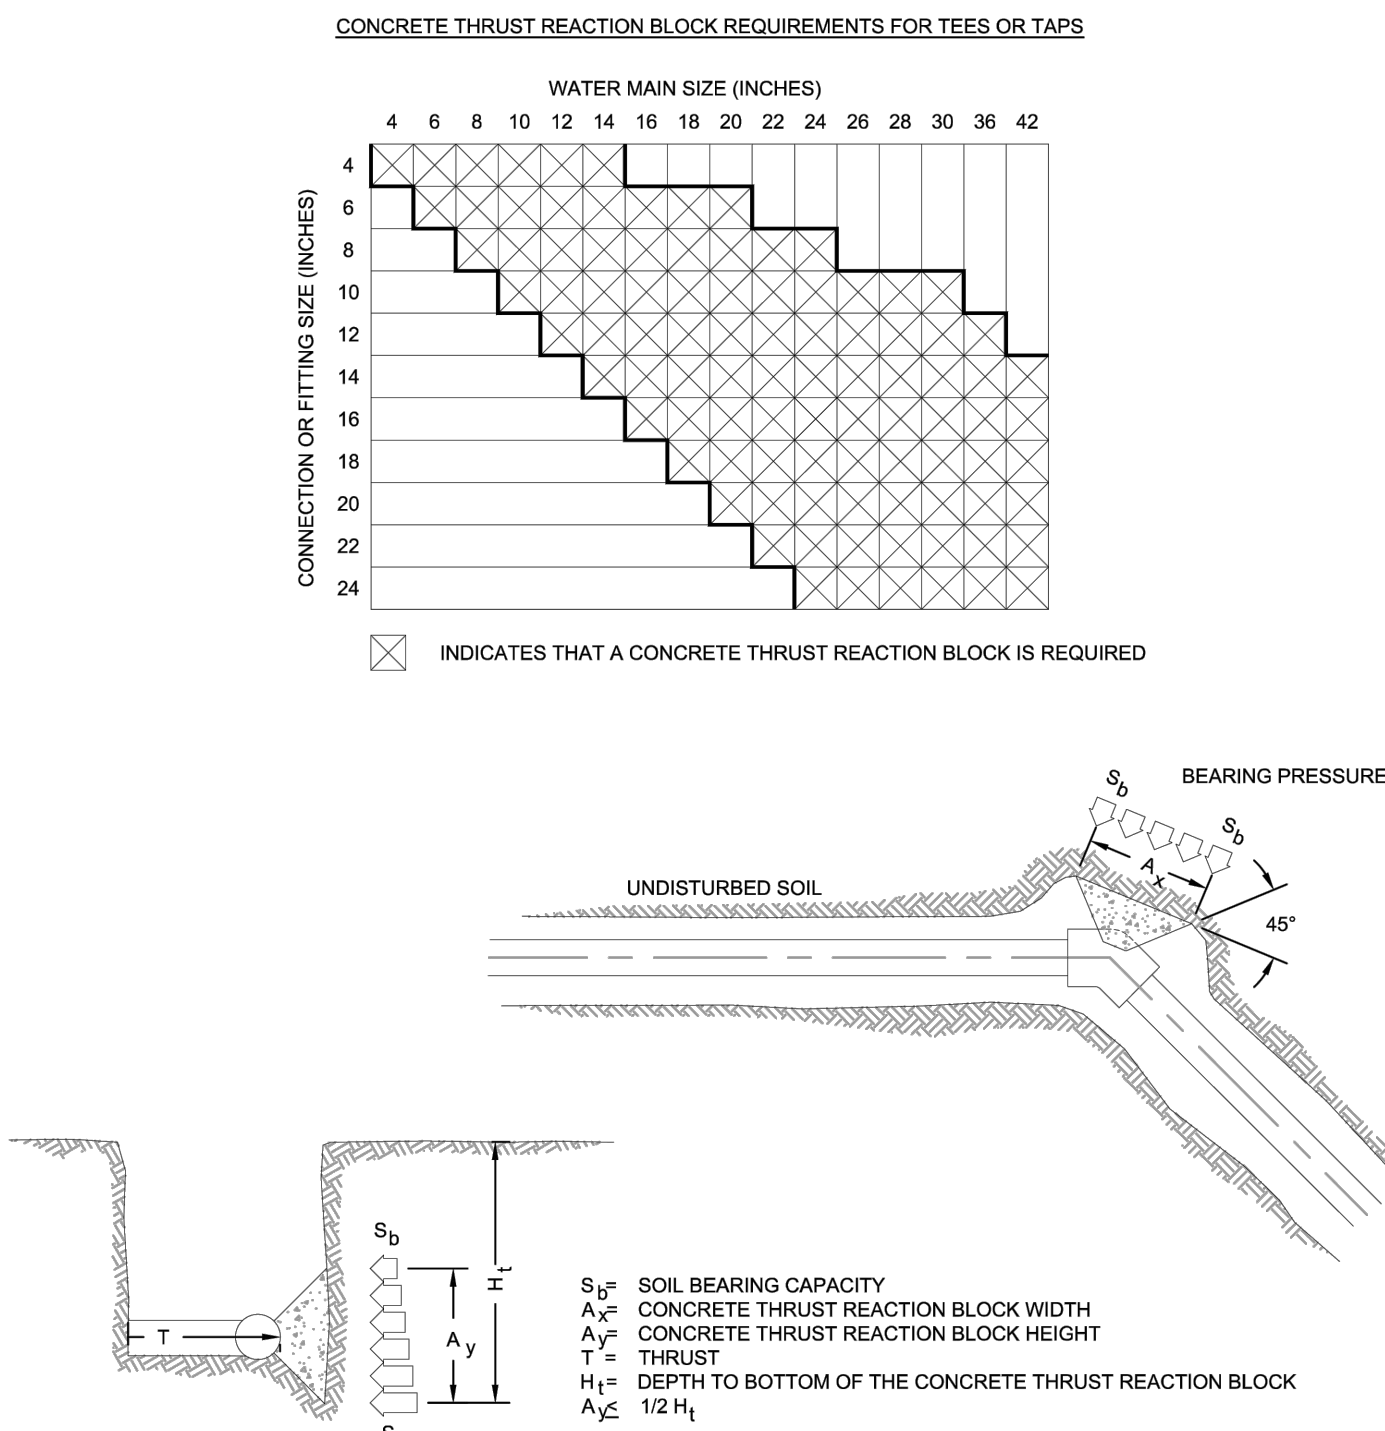

X INDICATES THAT A CONCRETE THRUST REACTION BLOCK IS REQUIRED

NOTES:

- A SITE SPECIFIC DESIGN SHALL BE REQUIRED FOR CONNECTIONS OR FITTING SIZE COMBINATIONS NOT SHOWN ABOVE.
- THE CONCRETE THRUST REACTION BLOCK SHALL BEAR AGAINST UNDISTURBED SOIL.
- THE CONCRETE THRUST REACTION BLOCK SHALL BE INSTALLED WITH A 45° ANGLE FROM THE FITTING TO THE UNDISTURBED SOIL AS SHOWN IN THE DRAWING ABOVE.
- REFER TO DETAIL DRAWING A4-2 FOR STANDARD CONCRETE THRUST REACTION BLOCK DIMENSIONS AND VOLUMES.
- DUCTILE IRON FITTINGS AND PIPE SHALL BE WRAPPED IN POLYETHYLENE TUBING WHERE ADJACENT TO CONCRETE.




CONCRETE THRUST REACTION BLOCKS

A4-3
DATED 03/2014

L = MINIMUM RESTRAINED PIPE LENGTH (FEET)


PIPE DIAMETER	45° BEND			22-1/2° BEND			11-1/4° BEND			DEAD END VALVE OR FLUG TO INCLUDE IN LINE VALVES (SEE NOTE 5)			
	MAX. STATIC PRESSURE (PSI)	<100	100-150	150-200	<100	100-150	150-200	<100	100-150		150-200		
6 INCH	DUCTILE IRON AND PVC	6	9	12	3	5	6	2	3	3	49	73	97
8 INCH	DUCTILE IRON AND PVC	8	12	16	4	6	8	2	3	4	63	94	125
12 INCH	DUCTILE IRON AND PVC	12	17	23	6	8	11	3	4	6	89	133	177
16 INCH	DUCTILE IRON AND PVC	15	22	29	7	11	14	4	5	7			
20 INCH	DUCTILE IRON AND PVC	18	26	35	9	13	17	4	6	8			
24 INCH	DUCTILE IRON AND PVC	20	30	40	10	15	20	5	7	10			
30 INCH	DUCTILE IRON AND PVC	24	36	48	12	18	24	6	9	12			
36 INCH	DUCTILE IRON AND PVC	28	42	56	14	20	27	7	10	14			

USE CONCRETE REVERSE ANCHOR

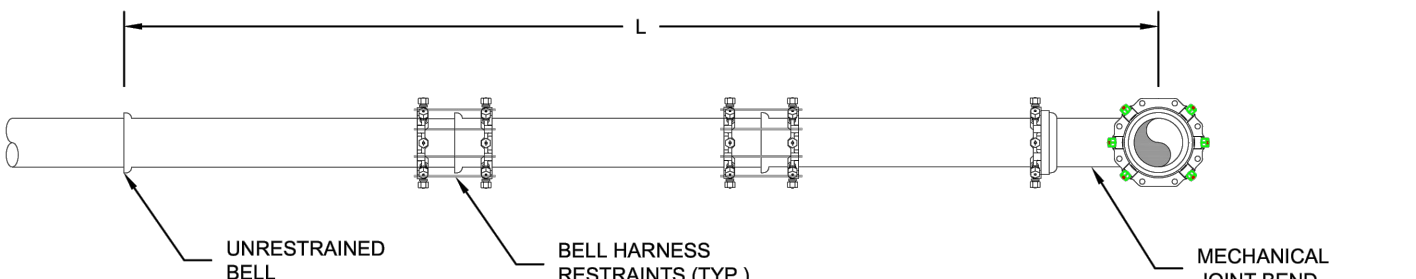







NOTES:

- PRESSURE GREATER THAN 200 PSI REQUIRE SPECIAL DESIGN APPROVED BY SPRINGS UTILITIES. APPROVED BY COLORADO SPRINGS UTILITIES.
- LENGTH IS BASED ON MINIMUM 5 FEET OF GROUND COVER AND SOIL COMPACTED ACCORDING TO CHAPTER 5 OF THESE WATER LESS. IF THE DEPTH IS LESS THAN 5 FEET RESTRAINED LENGTH MUST BE DESIGNED BY THE DESIGN ENGINEER.
- APPROVED METHODS OF RESTRAINED PIPE BEYOND INITIAL FITTING SHALL BE IN ACCORDANCE WITH CHAPTER 4.
- RESTRAINED PIPE LENGTH APPLIES TO CONDITIONS WHERE NO CONCRETE THRUST REACTION BLOCK IS PRESENT.
- CALCULATIONS ARE BASED ON A POORLY GRADED SANDS, GRAVEL AND GRAVEL-SAND MIXTURE, LITTLE OR NO FINES, TYPE 4 BEDDING CONDITIONS - PIPE BEDDED IN SAND, GRAVEL OR CRUSHED SAND STONE TO A DEPTH OF 1/8 PIPE DIAMETER (4" MIN.), FACTOR OF SAFETY 2.1.
- FIGURES ARE BASED ON DIP WRAPPED IN POLYETHYLENE MATERIAL.
- MEASUREMENTS ARE IN FEET.
- USE CRA FOR DOWN TURNING BENDS.
- RESTRAINED LENGTH FOR DEAD END MAY BE USED AT THE DISCRETION OF COLORADO SPRINGS UTILITIES.




RESTRAINED PIPE LENGTH (FEET) W/MECHANICAL JOINT RESTRAINTS

A4-4
DATED 03/2014

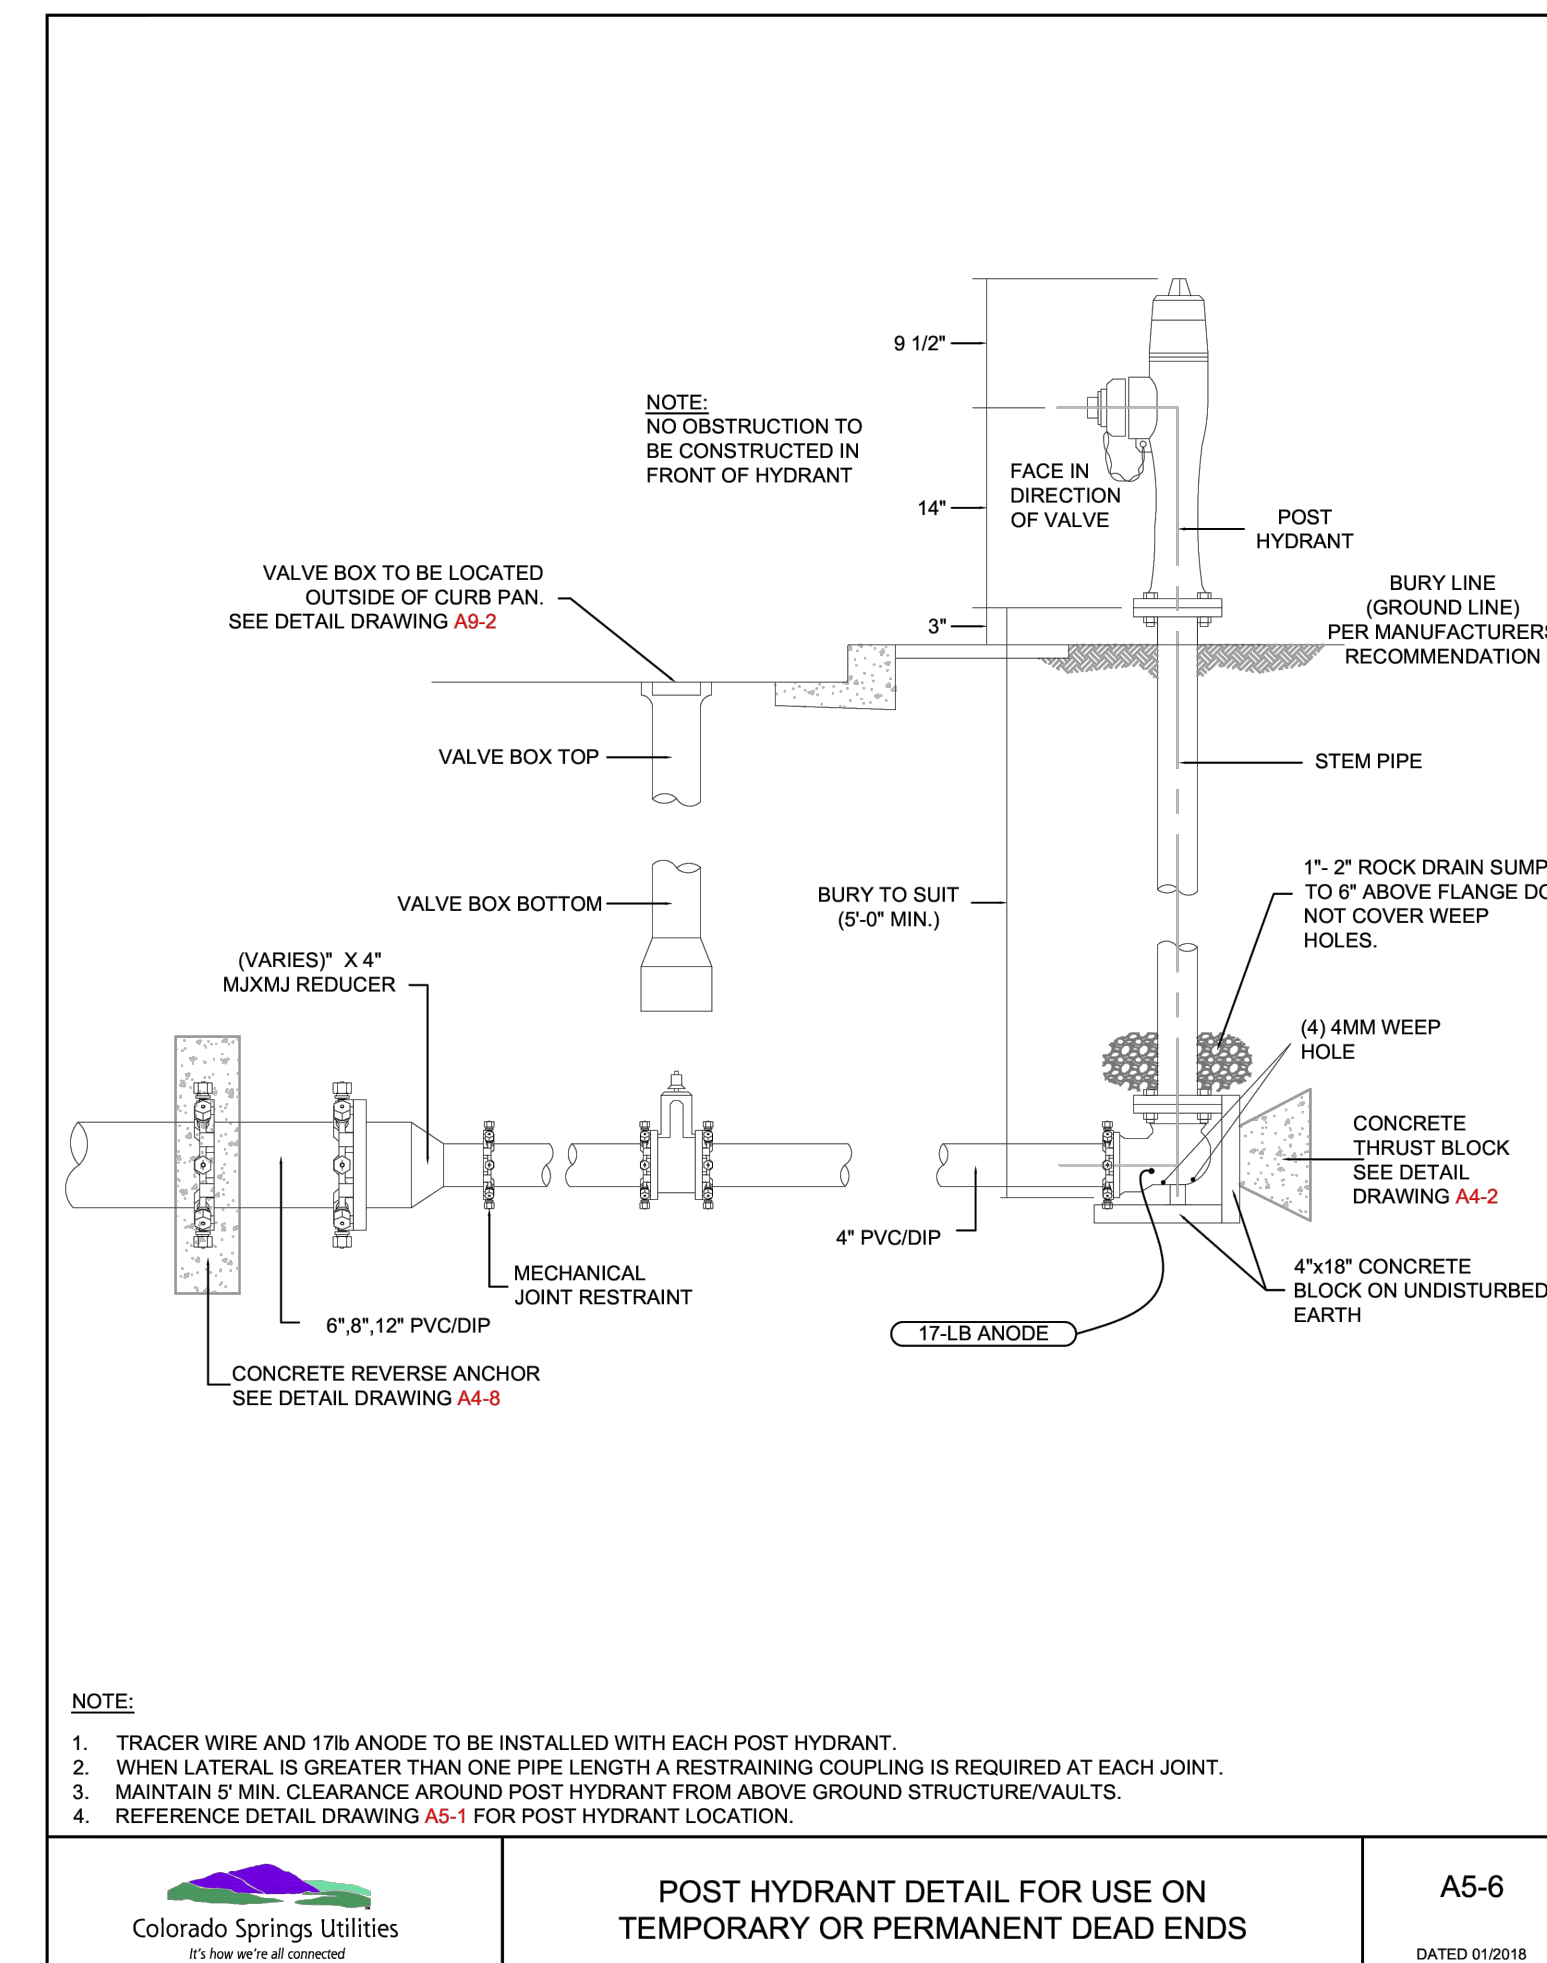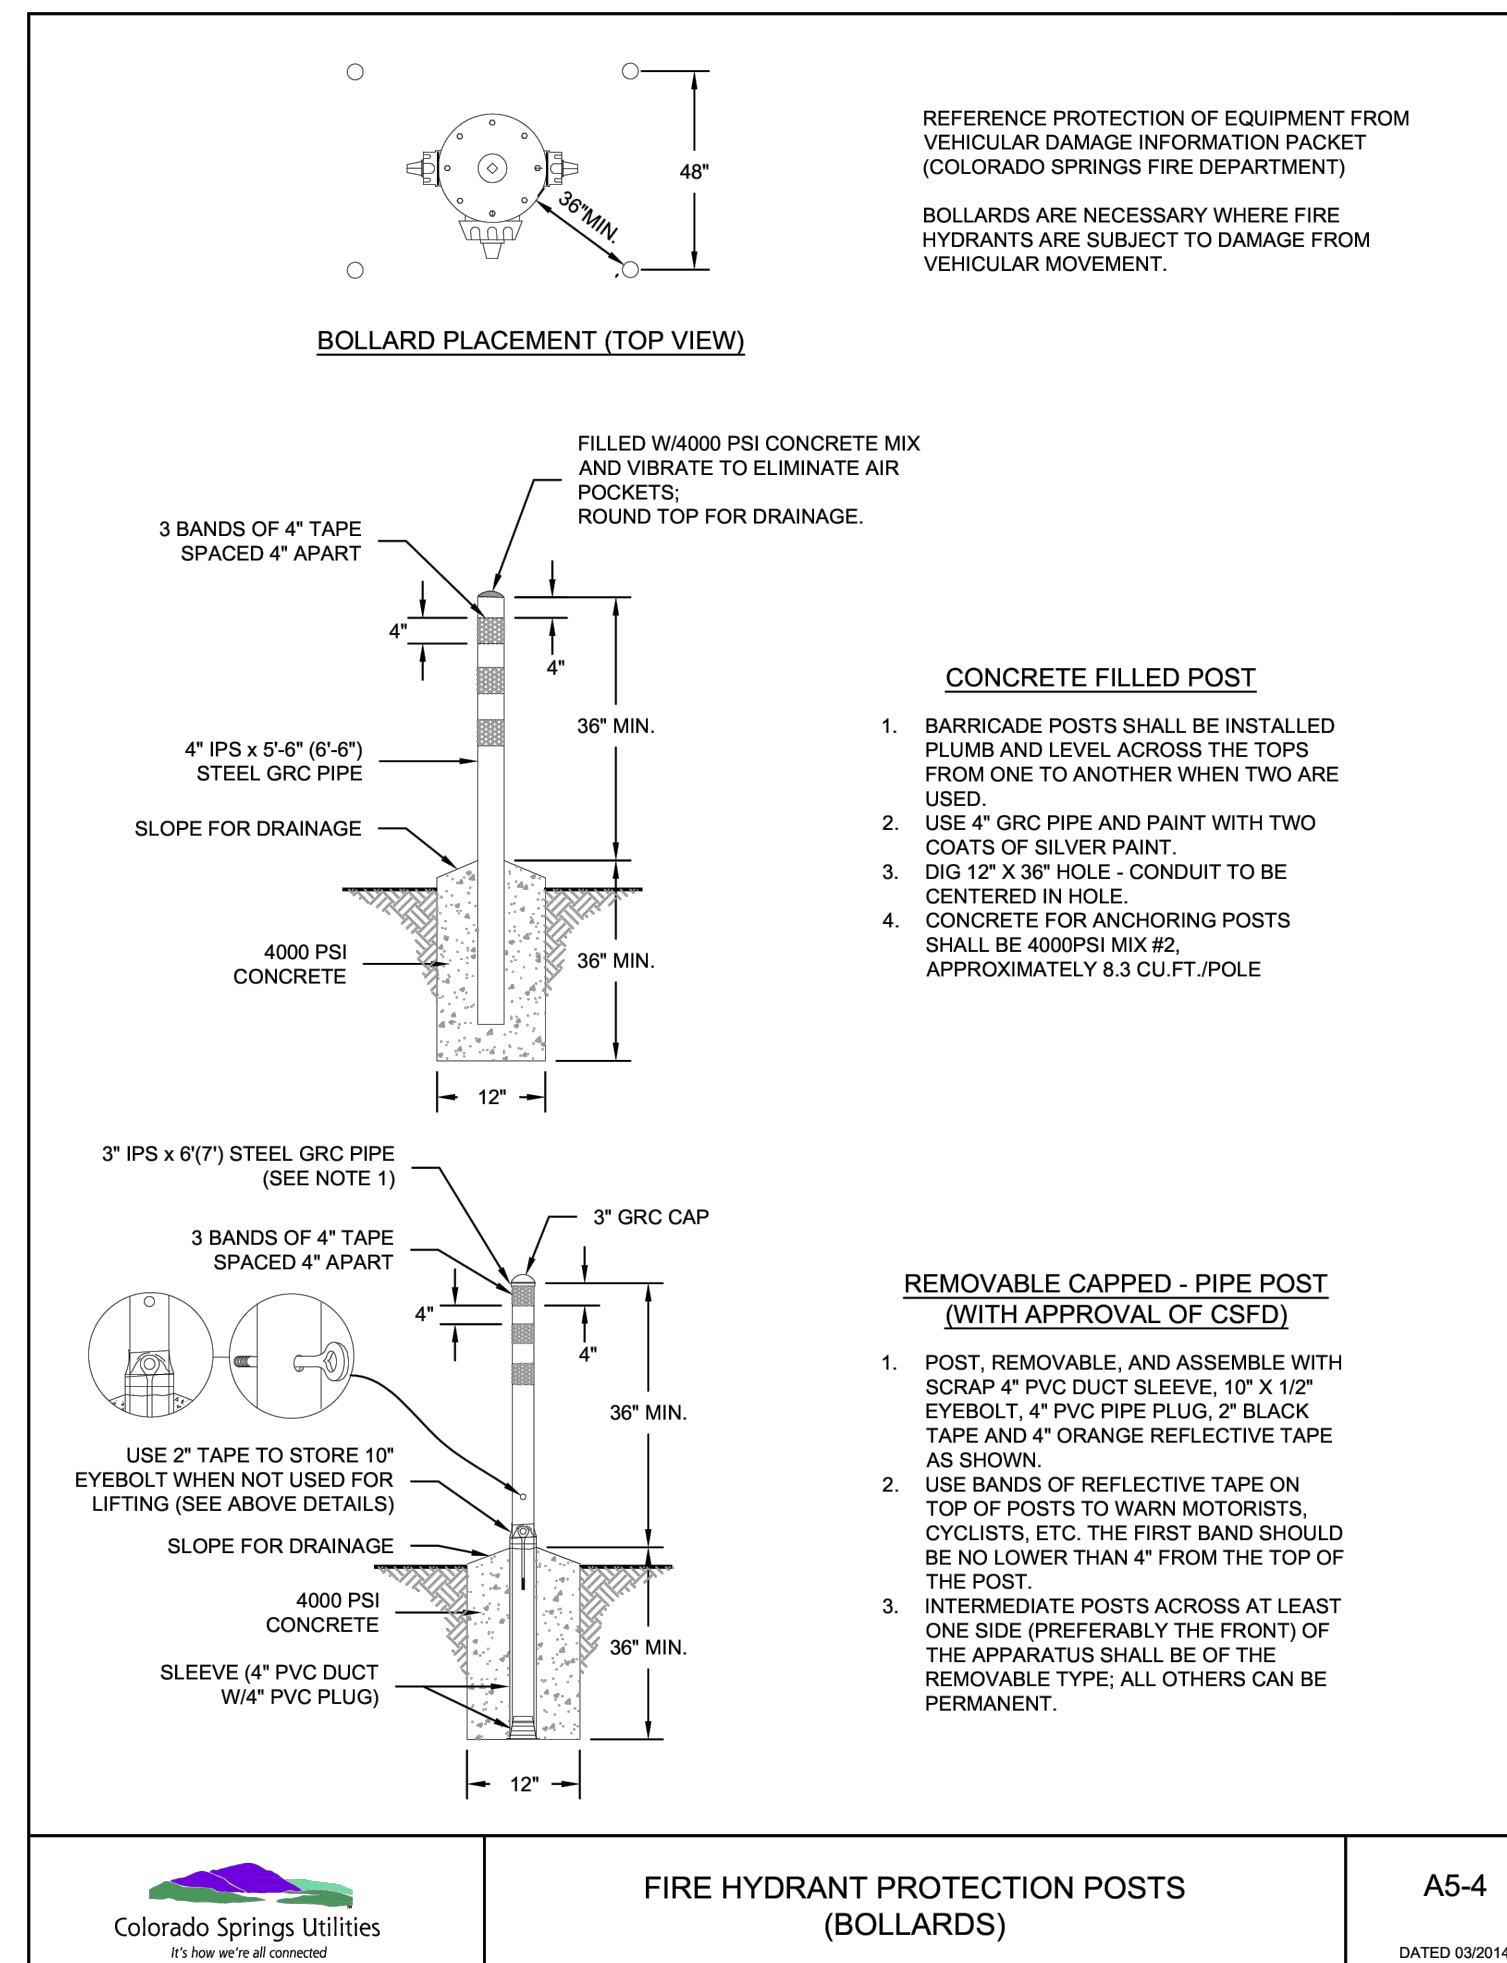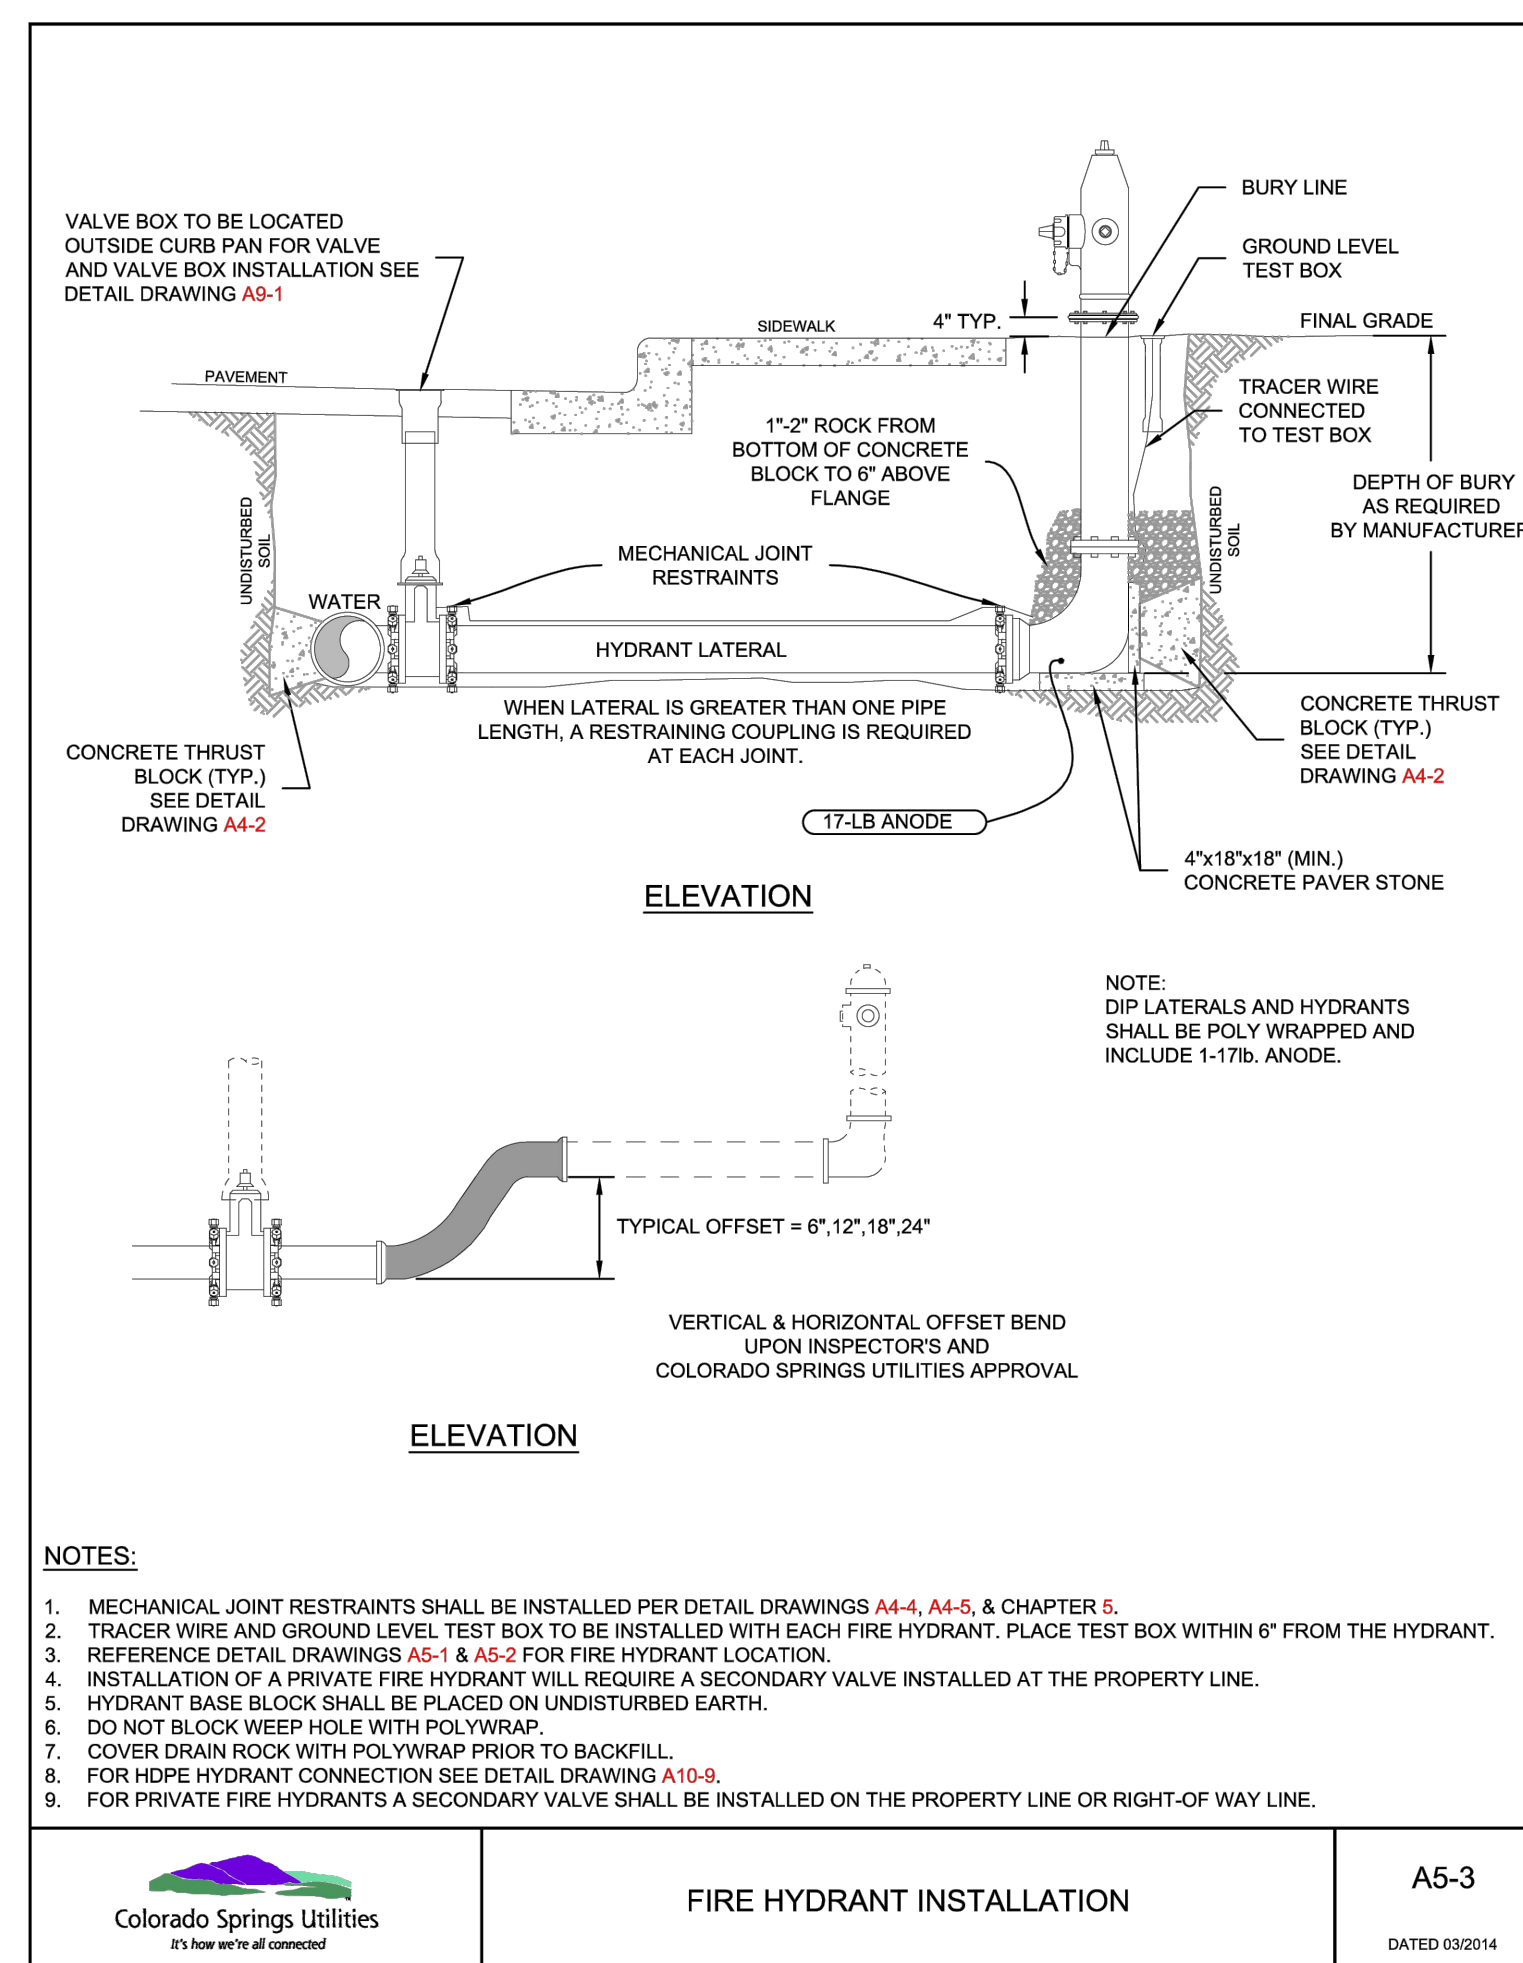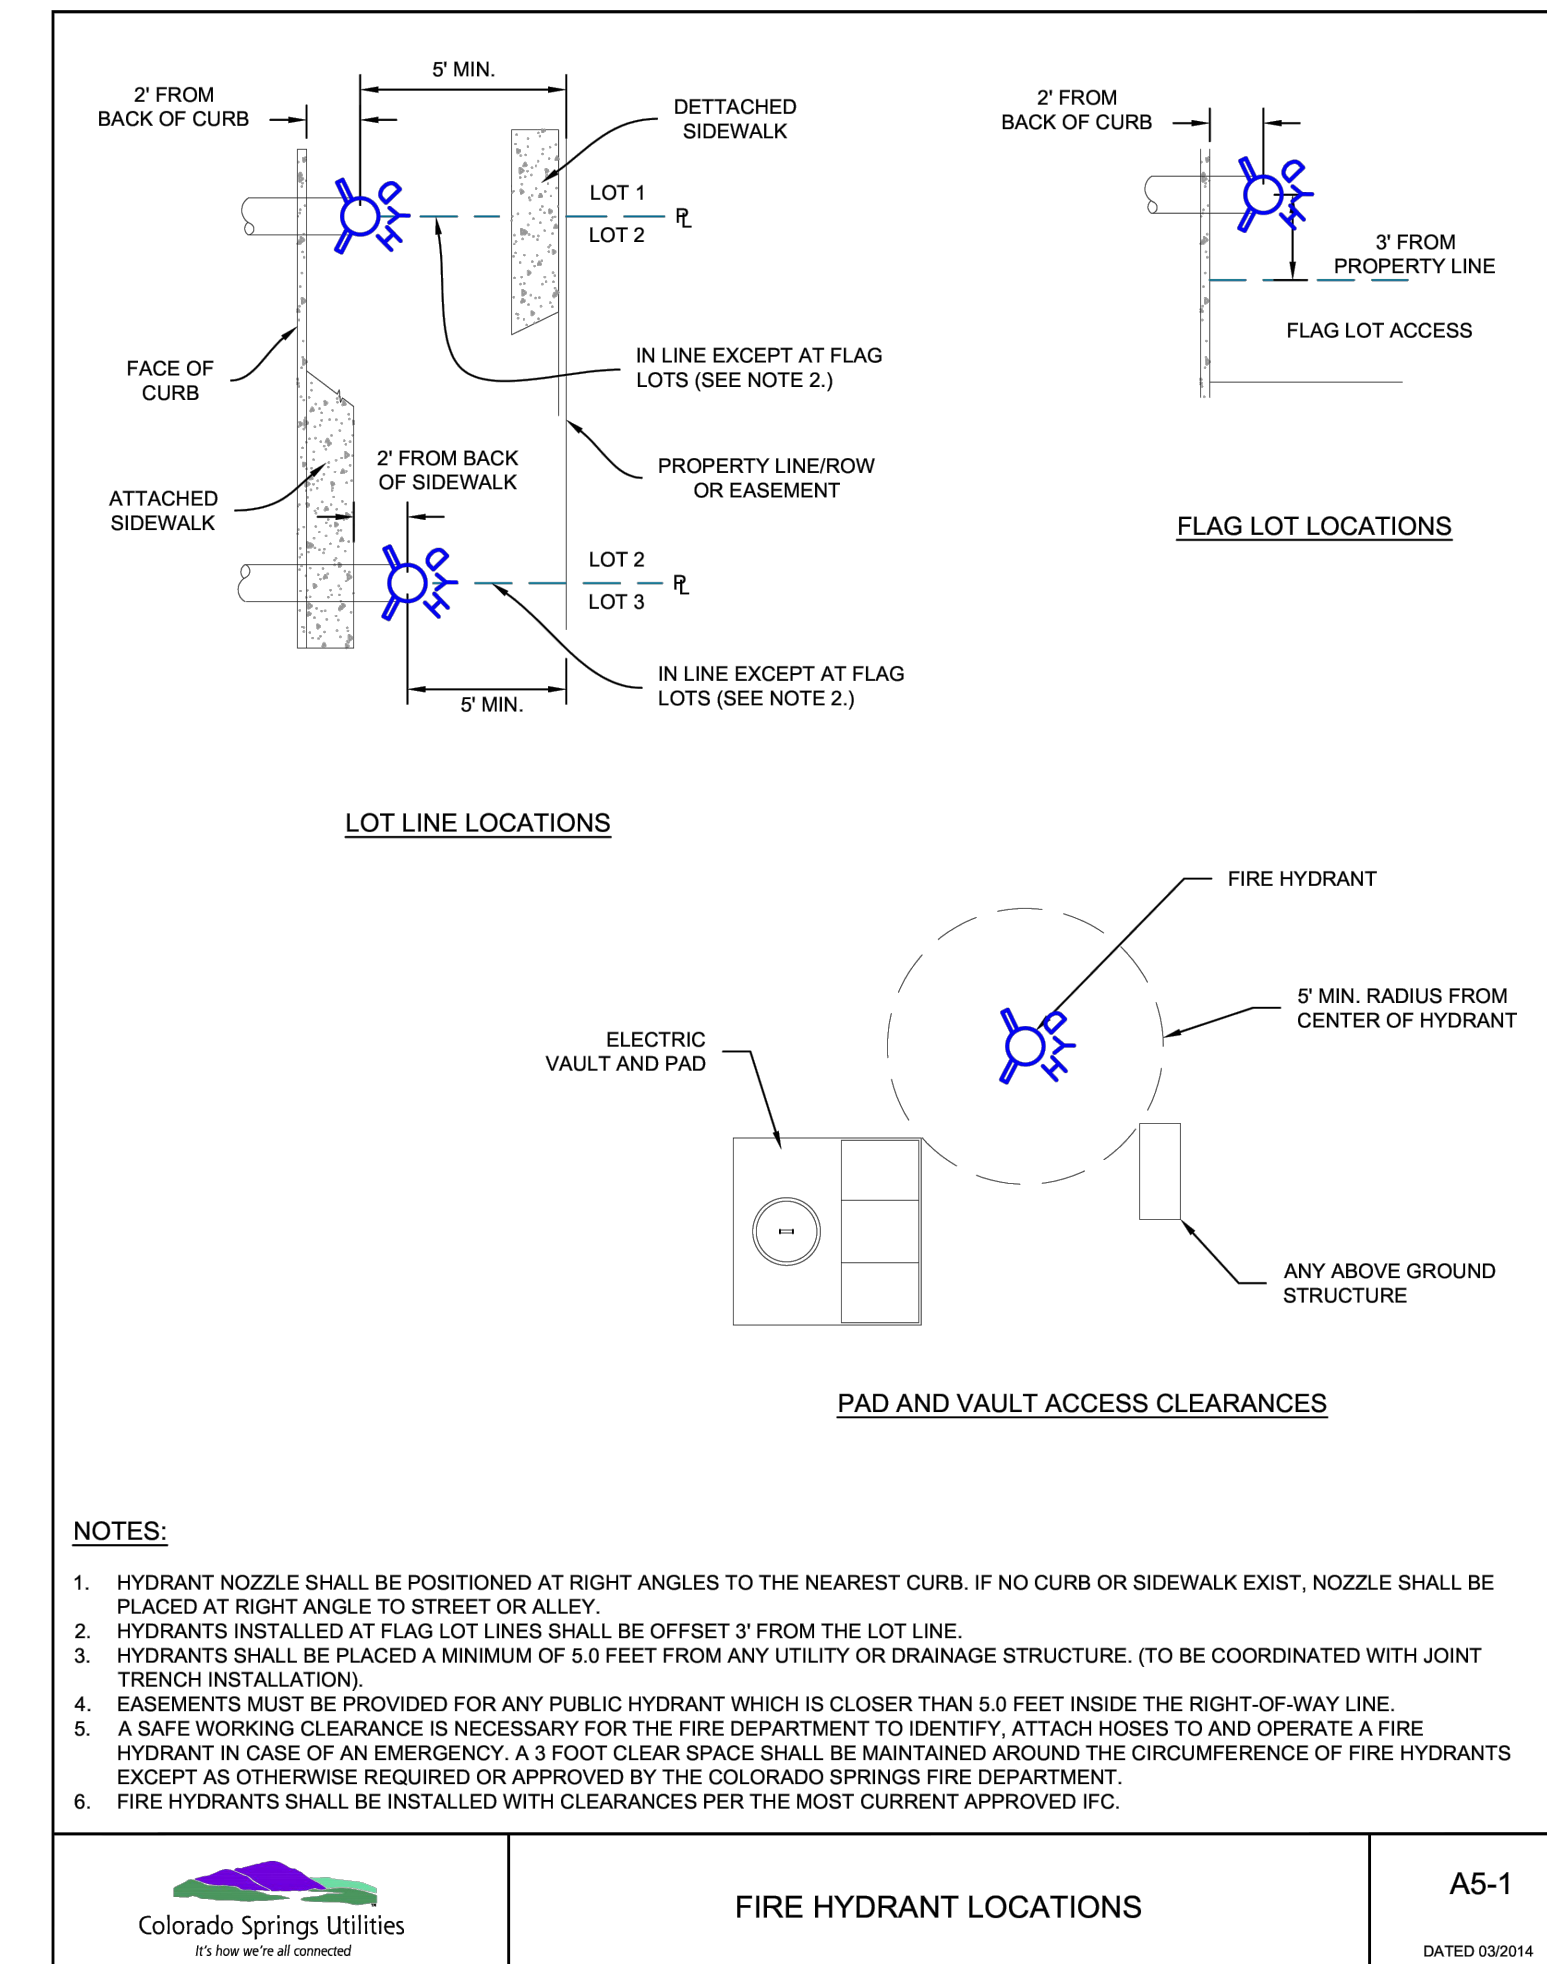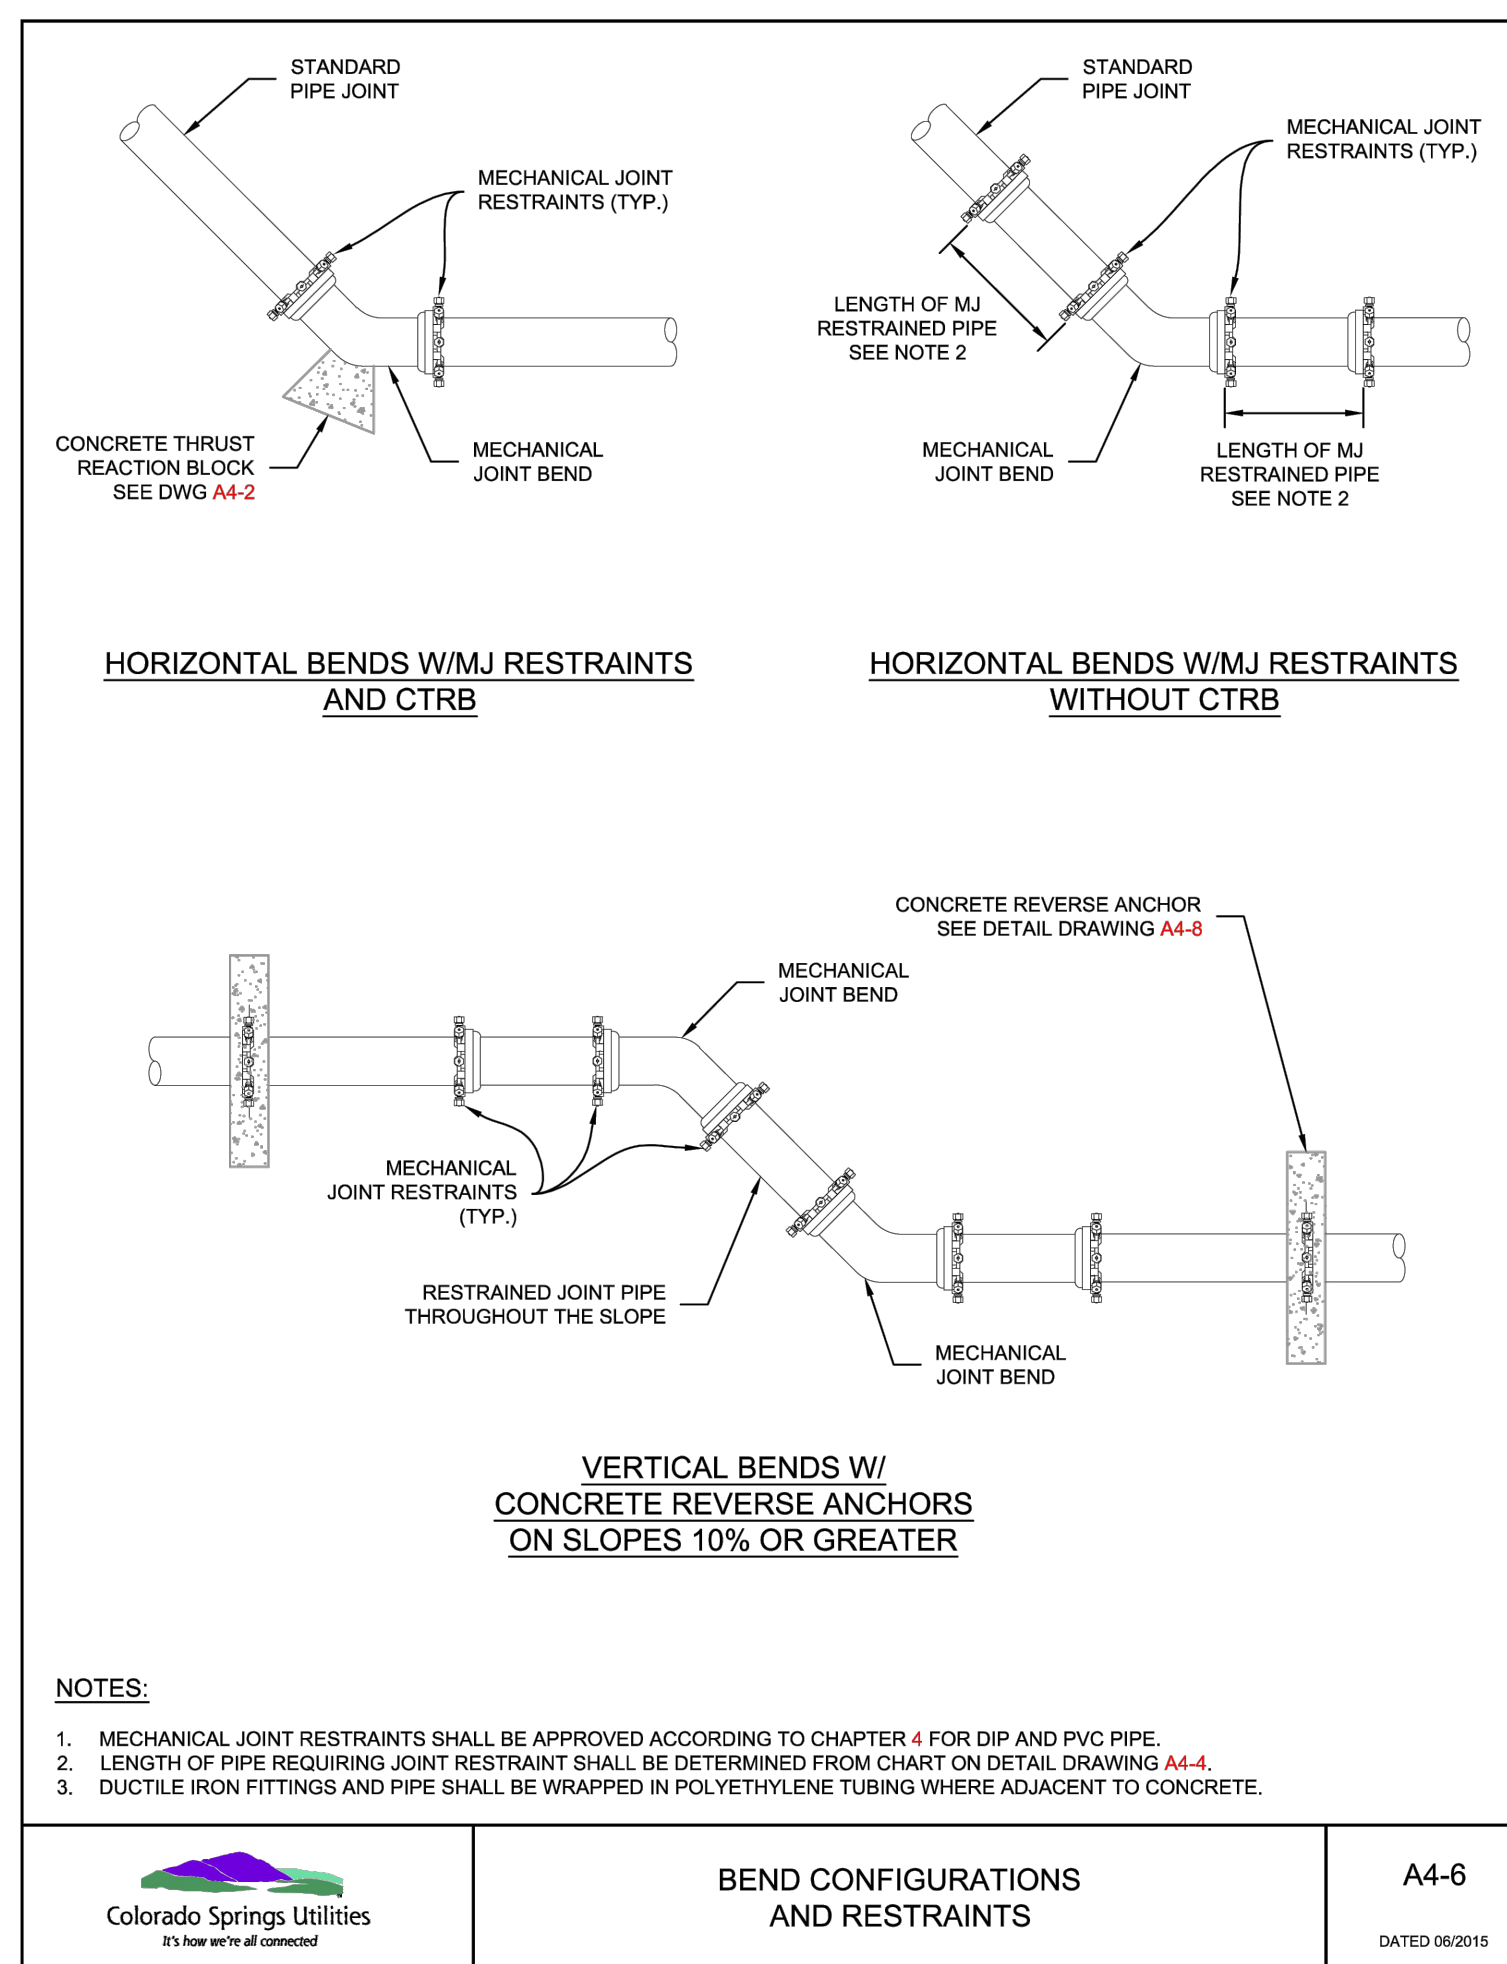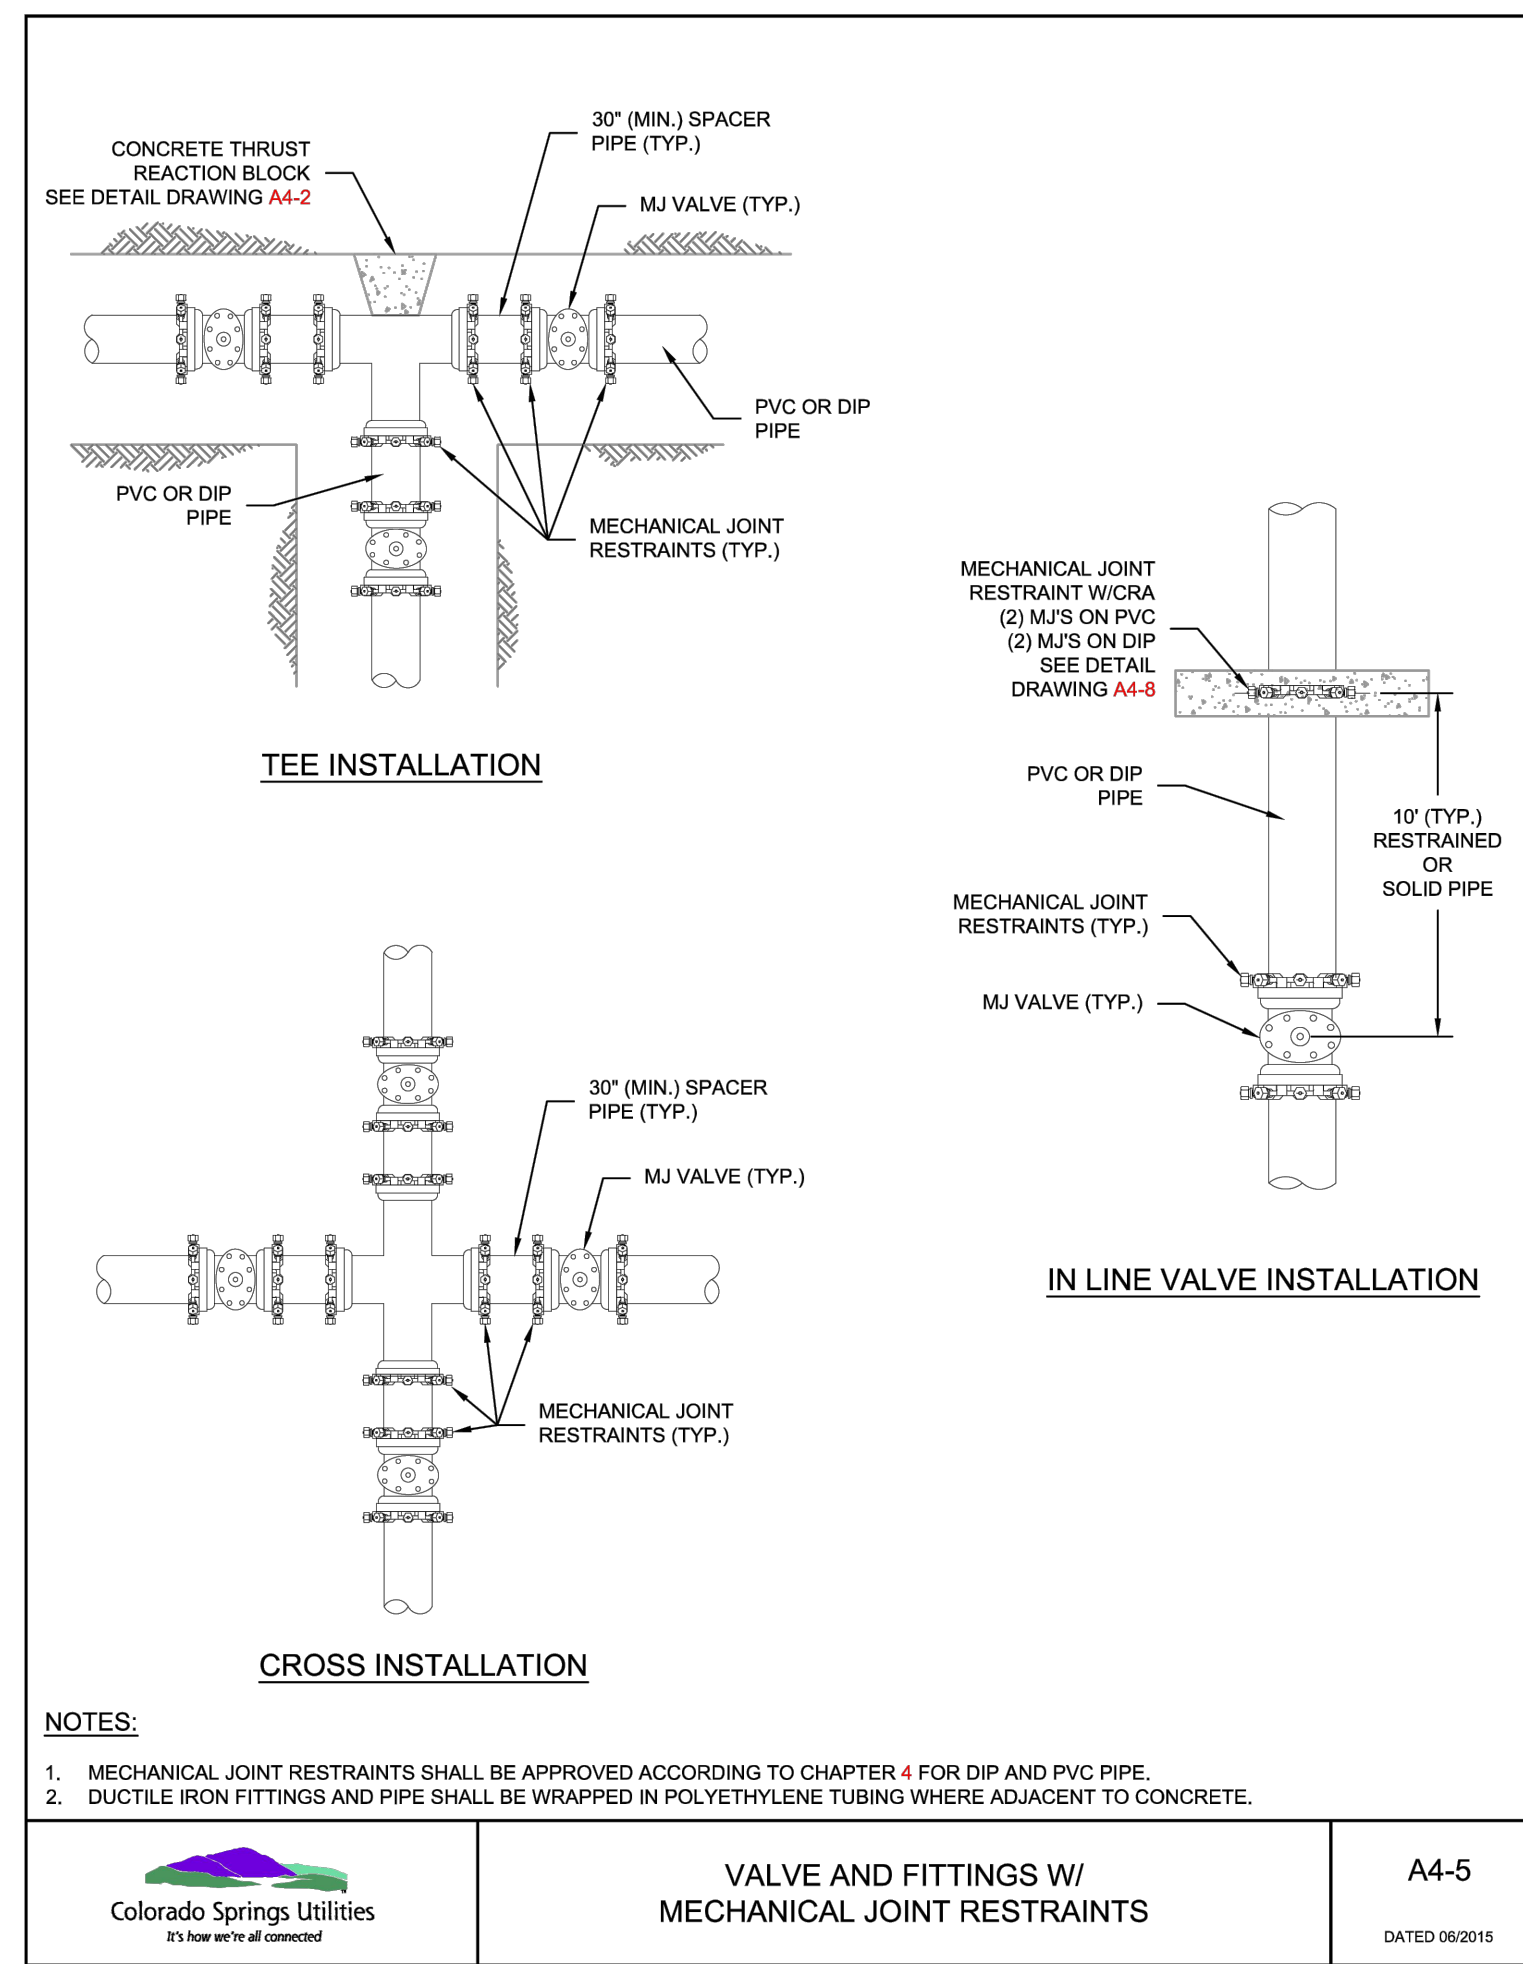

Add the County's Standard Utility Tech Repair Detail. See ECM Appendix F.

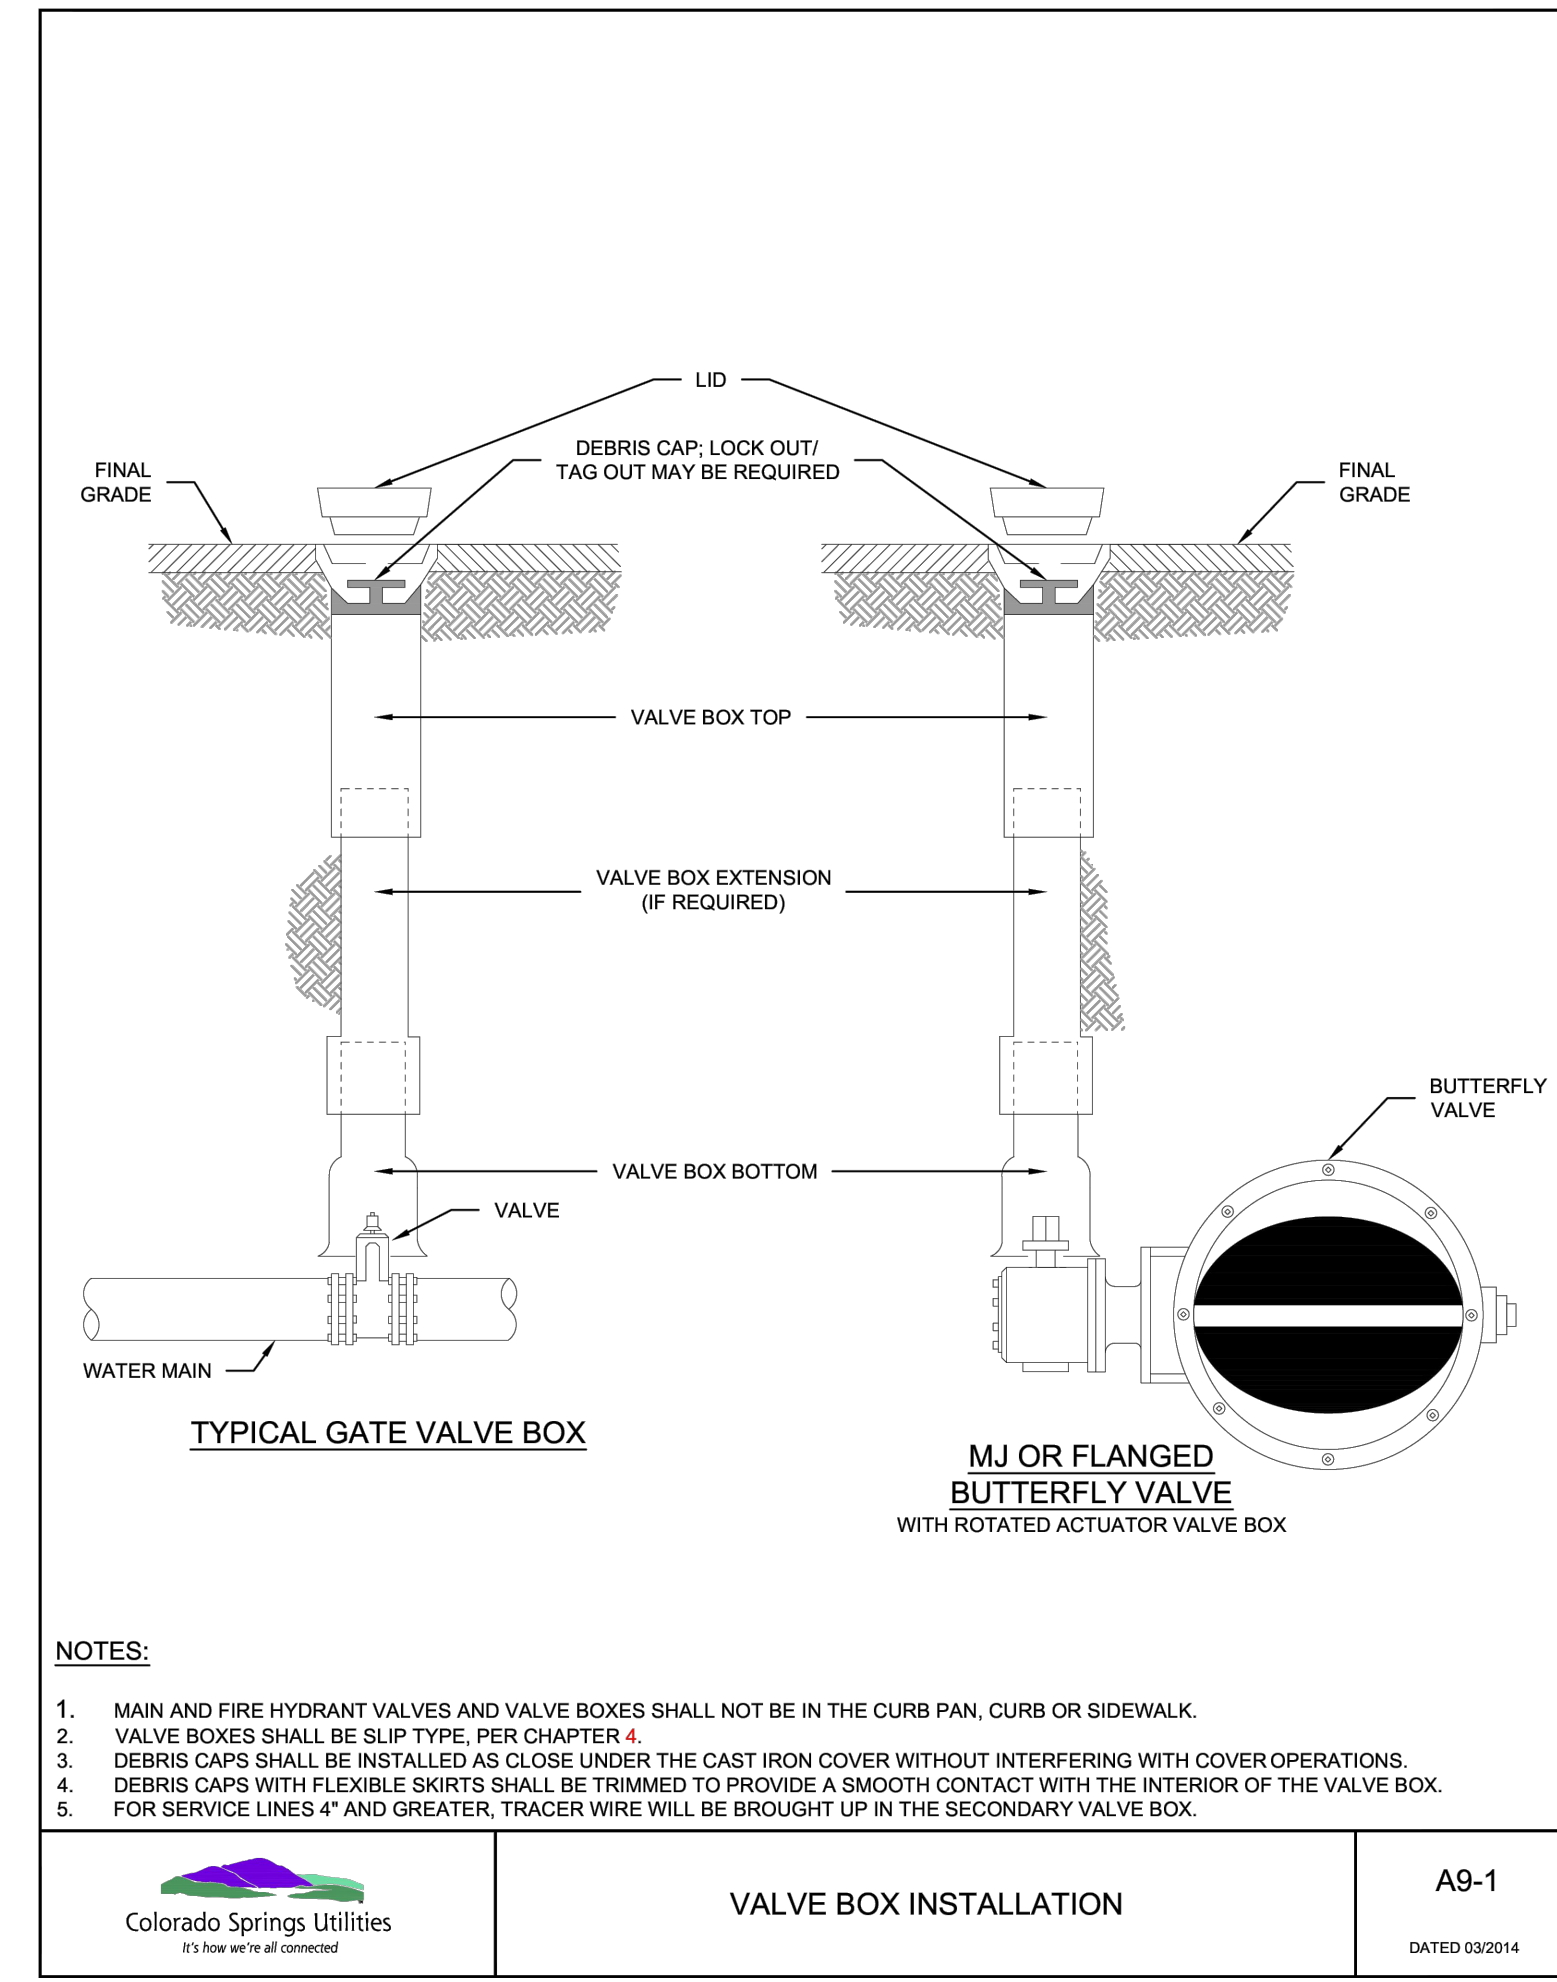

REVISION DATE	REVISION DESCRIPTION (DESCRIPTION)
00/00/00	

NORTH

SCALE: NOT TO SCALE
PROJECT #: 2107-0307
CHECKED BY: BML
DRAWN BY: JAM
DATE: 02/15/2023
SHEET # **6**
TOTAL SHEETS 6

WATER LINE DETAILS

GUNTZELMAN PORCELAIN PINES SUBDIVISION

GRADING AND EROSION CONTROL PLAN

COUNTY OF EL PASO, STATE OF COLORADO

FEBRUARY 2023

remove GEC from CD file. GEC comments provided with GEC Plan_v1




www.smhconsultants.com
Civil Engineering • Land Surveying
Landscape Architecture
Manhattan, KS - HQ
(785) 776-0541
Dodge City, KS
(620) 255-1952
Overland Park, KS
(913) 444-9615
Colorado Springs, CO
(719) 465-2145

GUNTZELMAN PORCELAIN PINES

PRELIMINARY DOCUMENTS NOT FOR CONSTRUCTION

EL PASO COUNTY, COLORADO

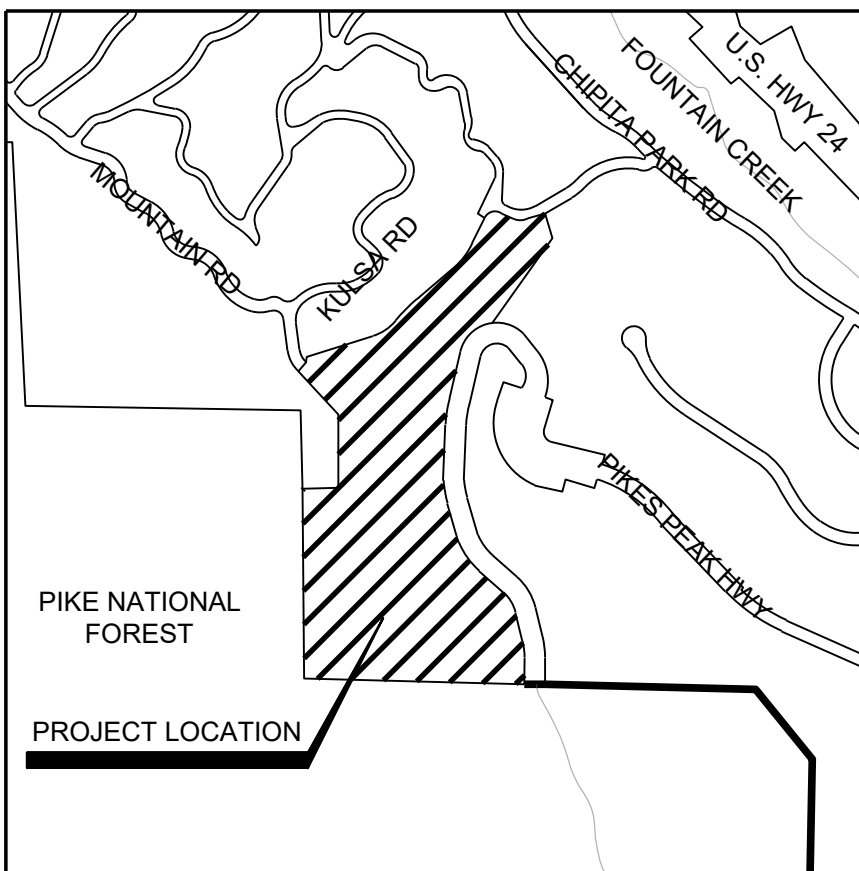


VICINITY MAP
(NOT TO SCALE)

GENERAL NOTES:

- IT SHALL BE THE RESPONSIBILITY OF THE CONTRACTOR TO VERIFY THE EXISTENCE AND LOCATION OF ALL UNDERGROUND UTILITIES ADJACENT TO THE SITE. THE OMISSION FROM, OR INCLUSION OF, UTILITY LOCATIONS ON THE PLANS IS NOT TO BE CONSIDERED AS THE NON-EXISTENCE OF OR A DEFINITE LOCATION OF EXISTING UNDERGROUND UTILITIES.
- THE CONTRACTOR SHALL TAKE THE NECESSARY PRECAUTIONS TO PROTECT EXISTING UTILITIES, BUILDINGS, FENCES, AND ROADWAYS FROM DAMAGE DUE TO THIS OPERATION. ANY DAMAGE TO THE ABOVE WILL BE REPAIRED AT THE CONTRACTOR'S EXPENSE, AND ANY SERVICE DISRUPTION WILL BE SETTLED BY THE CONTRACTOR. GRADINGS SHALL BE COMPLETED TO A SUBGRADE TOLERANCE OF PLUS OR MINUS 0.2'.
- CONTRACTOR SHALL OBTAIN COPIES OF THE SOILS REPORT FROM THE GEOTECHNICAL ENGINEER AND THEY SHALL BE KEPT ONSITE DURING ALL EARTHWORK.
- THE SITE SHALL BE STRIPPED A MINIMUM OF 0.5' BELOW EXISTING GRADE, OR AS RECOMMENDED BY THE GEOTECHNICAL REPORT. ONLY APPLICABLE IN PREVIOUSLY UNDISTURBED AREAS. AREA OF PROPOSED DETAILED GRADING HAS ALREADY BEEN DISTURBED.
- MAXIMUM CUT/FILL SLOPES SHALL NOT EXCEED 2:1.
- DUST CONTROL SHALL BE SUPPLIED BY THE GRADING CONTRACTOR THROUGHOUT THE DURATION OF THE PROJECT PER THE COUNTY HEALTH DEPARTMENT SPECIFICATIONS.

STANDARD NOTES FOR EL PASO COUNTY CONSTRUCTION PLANS:

- ALL DRAINAGE AND ROADWAY CONSTRUCTION SHALL MEET THE STANDARDS AND SPECIFICATIONS OF THE CITY OF COLORADO SPRINGS/EL PASO COUNTY DRAINAGE CRITERIA MANUAL, VOLUMES 1 AND 2, AND THE EL PASO COUNTY ENGINEERING CRITERIA MANUAL.
- CONTRACTOR SHALL BE RESPONSIBLE FOR THE NOTIFICATION AND FIELD NOTIFICATION OF ALL EXISTING UTILITIES, WHETHER SHOWN ON THE PLANS OR NOT, BEFORE BEGINNING CONSTRUCTION. LOCATION OF EXISTING UTILITIES SHALL BE VERIFIED BY THE CONTRACTOR PRIOR TO CONSTRUCTION. CALL 811 TO CONTACT THE UTILITY NOTIFICATION CENTER OF COLORADO (UNCC).
- CONTRACTOR SHALL KEEP A COPY OF THESE APPROVED PLANS, THE GRADING AND EROSION CONTROL PLAN, THE STORMWATER MANAGEMENT PLAN (SWMP), THE SOILS AND GEOTECHNICAL REPORT, AND THE APPROPRIATE DESIGN AND CONSTRUCTION STANDARDS AND SPECIFICATIONS AT THE JOB SITE AT ALL TIMES, INCLUDING THE FOLLOWING:
 - EL PASO COUNTY ENGINEERING CRITERIA MANUAL (ECM)
 - CITY OF COLORADO SPRINGS/EL PASO COUNTY DRAINAGE CRITERIA MANUAL, VOLUMES 1 AND 2
 - COLORADO DEPARTMENT OF TRANSPORTATION (CDOT) STANDARD SPECIFICATIONS FOR ROAD AND BRIDGE CONSTRUCTION
 - CDOT M & S STANDARDS
- NOTWITHSTANDING ANYTHING DEPICTED IN THESE PLANS IN WORDS OR GRAPHIC REPRESENTATION, ALL DESIGN AND CONSTRUCTION RELATED TO ROADS, STORM DRAINAGE AND EROSION CONTROL SHALL CONFORM TO THE STANDARDS AND REQUIREMENTS OF THE MOST RECENT VERSION OF THE RELEVANT ADOPTED EL PASO COUNTY STANDARDS, INCLUDING THE LAND DEVELOPMENT CODE, THE ENGINEERING CRITERIA MANUAL, THE DRAINAGE CRITERIA MANUAL, AND THE DRAINAGE CRITERIA MANUAL VOLUME 2. ANY DEVIATIONS FROM REGULATIONS AND STANDARDS MUST BE REQUESTED, AND APPROVED, IN WRITING. ANY MODIFICATIONS NECESSARY TO MEET CRITERIA AFTER-THE-FACT WILL BE ENTIRELY THE DEVELOPER'S RESPONSIBILITY TO RECTIFY.
- IT IS THE DESIGN ENGINEER'S RESPONSIBILITY TO ACCURATELY SHOW EXISTING CONDITIONS, BOTH ONSITE AND OFFSITE, ON THE CONSTRUCTION PLANS. ANY MODIFICATIONS NECESSARY DUE TO CONFLICTS, OMISSIONS, OR CHANGED CONDITIONS WILL BE ENTIRELY THE DEVELOPER'S RESPONSIBILITY TO RECTIFY.
- CONTRACTOR SHALL SCHEDULE A PRE-CONSTRUCTION MEETING WITH EL PASO COUNTY PLANNING AND COMMUNITY DEVELOPMENT - INSPECTIONS, PRIOR TO STARTING CONSTRUCTION.
- IT IS THE CONTRACTOR'S RESPONSIBILITY TO UNDERSTAND THE REQUIREMENTS OF ALL JURISDICTIONAL AGENCIES AND TO OBTAIN ALL REQUIRED PERMITS, INCLUDING BUT NOT LIMITED TO EL PASO COUNTY EROSION AND STORMWATER QUALITY CONTROL PERMIT (ESQCP), REGIONAL BUILDING FLOODPLAIN DEVELOPMENT PERMIT, U.S. ARMY CORPS OF ENGINEERS-ISSUED 401 AND/OR 404 PERMITS, AND COUNTY AND STATE FUGITIVE DUST PERMITS.
- CONTRACTOR SHALL NOT DEVIATE FROM THE PLANS WITHOUT FIRST OBTAINING WRITTEN APPROVAL FROM THE DESIGN ENGINEER AND PCD. CONTRACTOR SHALL NOTIFY THE DESIGN ENGINEER IMMEDIATELY UPON DISCOVERY OF ANY ERRORS OR INCONSISTENCIES.
- ALL STORM DRAIN PIPES SHALL BE CLASS B OR CLASS III UNLESS OTHERWISE NOTED AND APPROVED BY PCD.
- CONTRACTOR SHALL COORDINATE GEOTECHNICAL TESTING PER ECM STANDARDS. PAVEMENT DESIGN SHALL BE APPROVED BY EL PASO COUNTY PCD PRIOR TO PLACEMENT OF CURB AND GUTTER AND PAVEMENT.
- ALL CONSTRUCTION TRAFFIC MUST ENTER/EXIT THE SITE AT APPROVED CONSTRUCTION ACCESS POINTS.
- SIGHT VISIBILITY TRIANGLES AS IDENTIFIED IN THE PLANS SHALL BE PROVIDED AT ALL INTERSECTIONS. OBSTRUCTIONS GREATER THAN 18 INCHES ABOVE FLOWLINE ARE NOT ALLOWED WITHIN SITE TRIANGLES.
- SIGNING AND STRIPING SHALL COMPLY WITH EL PASO COUNTY DEPARTMENT OF PUBLIC WORKS AND MUTCD CRITERIA.
- CONTRACTOR SHALL OBTAIN ANY PERMITS REQUIRED BY EL PASO COUNTY DEPARTMENT OF PUBLIC WORKS, INCLUDING WORK WITH THE RIGHT-OF-WAY AND SPECIAL TRANSPORT PERMITS.
- THE LIMITS OF CONSTRUCTION SHALL REMAIN WITHIN THE PROPERTY LINE UNLESS OTHERWISE NOTED. THE OWNER/DEVELOPER SHALL OBTAIN WRITTEN PERMISSION AND EASEMENTS, WHERE REQUIRED, FROM ADJOINING PROPERTY OWNER(S) PRIOR TO ANY OFF-SITE DISTURBANCE, GRADING OR CONSTRUCTION.

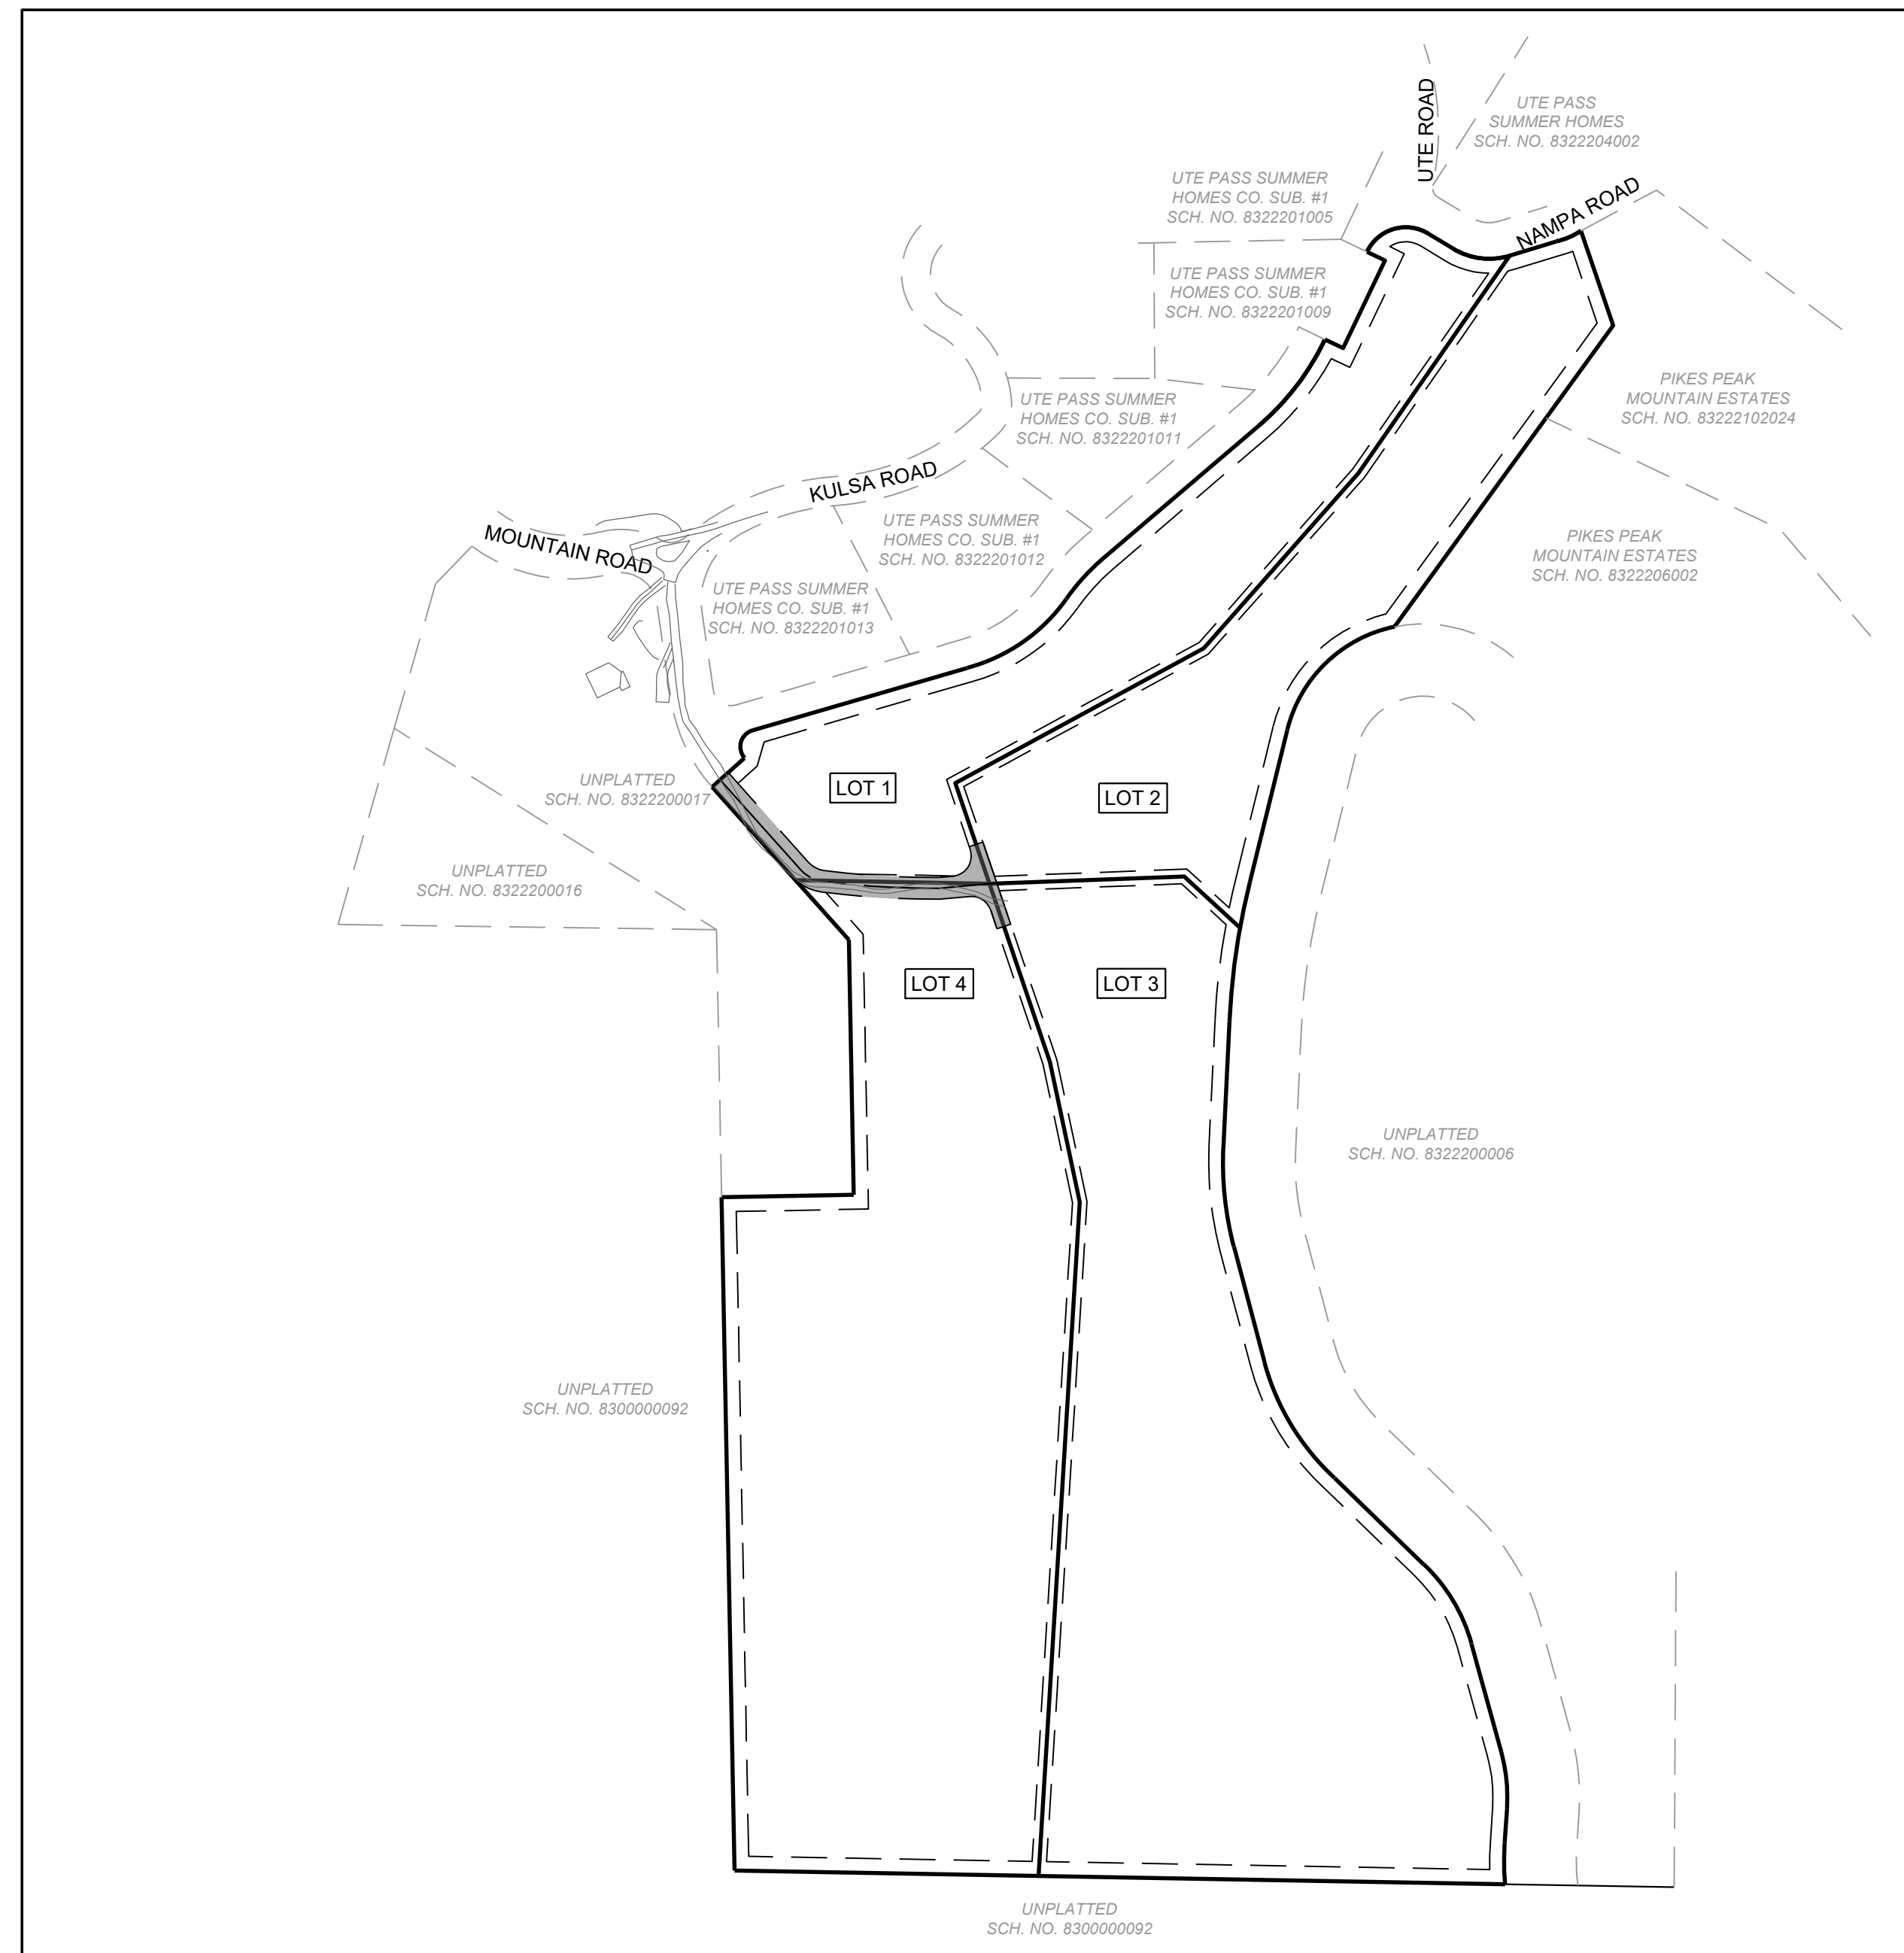

SITE MAP
SCALE: 1" = 200'

EROSION CONTROL COST ESTIMATE				
ITEM	QUANTITY	UNIT	UNIT COST	AMOUNT
PERMANENT/TEMPORARY SEEDING	0.63	AC	\$600.00	\$378.00
PERMANENT/TEMPORARY MULCHING	0.63	AC	\$500.00	\$315.00
PERMANENT/TEMPORARY EROSION CONTROL BLANKET	3058	SY	\$6.00	\$18,348.00
VEHICLE TRACKING CONTROL	1	EA	\$2,250.00	\$2,250.00
SILT FENCE	1639	LF	\$2.50	\$4,097.50
ROCK CHECK DAM	1	EA	\$500.00	\$500.00
CULVERT INLET PROTECTION	1	EA	\$150.00	\$150.00
CONCRETE WASHOUT	1	EA	\$760.00	\$760.00
STABILIZED STAGING AREA	1	EA	\$5,900.00	\$5,900.00
SUB-TOTAL				\$32,698.50
MAINTENANCE (35% OF CONSTRUCTION)				\$11,444.48
TOTAL				\$44,142.98

SMH CONSULTANTS DOES NOT GUARANTEE THAT THE CONSTRUCTION COSTS WILL NOT VARY FROM THIS CONSTRUCTION COST OPINION.

AGENCIES

OWNER/DEVELOPER:
KRISTIAN & CHRISTA GUNTZELMAN
5381 SUGAR CAMP ROAD
MILFORD, OH 45150
(513) 722-4343

CIVIL ENGINEER:
BRETT LOUK
SMH CONSULTANTS, P.A.
411 SOUTH TEJON STREET, SUITE 1
COLORADO SPRINGS, CO 80903
(719) 465-2145

SURVEYOR:
TIM SLOAN
SMH CONSULTANTS, P.A.
411 S TEJON STREET, SUITE 1
COLORADO SPRINGS, CO 80903
465-2145

COUNTY ENGINEERING:
LUPE PACKMAN
EL PASO COUNTY PLANNING AND COMMUNITY DEVELOPMENT
2880 INTERNATIONAL CIRCLE, SUITE 110
COLORADO SPRINGS, CO 80910
(719) 520-7550

GAS:
BOB SWATEK
BLACK HILLS ENERGY
198 COUNTY LINE ROAD
PALMER LAKE, CO 80133
(719) 332-5856

ELECTRIC:
COLORADO SPRINGS UTILITIES
1521 HANCOCK EXPRESSWAY
COLORADO SPRINGS, CO 80903
(719) 668-8262

FIRE DISTRICT:
KAREN BODINE
CASCADE FIRE PROTECTION DISTRICT
8015 SEVERY AVE, PO BOX 366
CASCADE, CO 80809
(719) 694-9549

INDEX OF SHEETS

1	GEC COVER
2	GEC PLAN
3	GEC NOTES AND GEC DETAILS
4-5	GEC DETAILS

ENGINEER'S STATEMENT

THIS GRADING AND EROSION CONTROL PLAN WAS PREPARED UNDER MY DIRECTION AND SUPERVISION AND IS CORRECT TO THE BEST OF MY KNOWLEDGE AND BELIEF. SAID PLAN HAS BEEN PREPARED ACCORDING TO THE CRITERIA ESTABLISHED BY THE COUNTY FOR GRADING AND EROSION CONTROL PLANS. I ACCEPT RESPONSIBILITY FOR ANY LIABILITY CAUSED BY ANY NEGLIGENT ACTS, ERRORS OR OMISSIONS ON MY PART IN PREPARING THIS PLAN.

BRETT LOUK, COLORADO P.E. # _____ DATE: _____

OWNER'S/DEVELOPER'S STATEMENT

I, THE OWNER/DEVELOPER HAVE READ AND WILL COMPLY WITH THE REQUIREMENTS OF THE GRADING AND EROSION CONTROL PLAN.

KRISTIAN GUNTZELMAN _____ DATE: _____

CHRISTA GUNTZELMAN _____ DATE: _____

EL PASO COUNTY:

COUNTY PLAN REVIEW IS PROVIDED ONLY FOR GENERAL CONFORMANCE WITH COUNTY DESIGN CRITERIA. THE COUNTY IS NOT RESPONSIBLE FOR THE ACCURACY AND ADEQUACY OF THE DESIGN, DIMENSIONS, AND/OR ELEVATIONS WHICH SHALL BE CONFIRMED AT THE JOB SITE. THE COUNTY THROUGH THE APPROVAL OF THIS DOCUMENT ASSUMES NO RESPONSIBILITY FOR COMPLETENESS AND/OR ACCURACY OF THIS DOCUMENT.

FILED IN ACCORDANCE WITH THE REQUIREMENTS OF THE EL PASO COUNTY LAND DEVELOPMENT CODE, DRAINAGE CRITERIA MANUAL VOLUMES 1 AND 2, AND ENGINEERING CRITERIA MANUAL, AS AMENDED.

IN ACCORDANCE WITH ECM SECTION 1.12, THESE CONSTRUCTION DOCUMENTS WILL BE VALID FOR CONSTRUCTION FOR A PERIOD OF 2 YEARS FROM THE DATE SIGNED BY THE EL PASO COUNTY ENGINEER. IF CONSTRUCTION HAS NOT STARTED WITHIN THOSE 2 YEARS, THE PLANS WILL NEED TO BE RESUBMITTED FOR APPROVAL, INCLUDING PAYMENT OF REVIEW FEES AT THE PLANNING AND COMMUNITY DEVELOPMENT DIRECTOR'S DISCRETION.

JOSHUA PALMER, COUNTY ENGINEER _____ DATE: _____

BASIS OF BEARINGS:

BASIS OF BEARINGS IS THE SOUTH LINE OF THE SOUTHEAST 1/4 OF THE NORTHWEST 1/4 OF SECTION 22, TOWNSHIP 13 SOUTH, RANGE 68 WEST MONUMENTED AT THE CENTER 1/4 CORNER BY A 1" IRON PIPE WITH A 2-1/2" BRASS CAP STAMPED "1938 U.S. GENERAL LAND OFFICE SURVEY", 0.5' ABOVE GRADE AND AT THE WEST 1/16 CENTER CORNER BY A 1" IRON PIPE WITH A 2-1/2" BRASS CAP STAMPED "1938 U.S. GENERAL LAND OFFICE SURVEY AND ASSUMED TO BEAR NORTH 88 DEGREES 58 MINUTES 46 SECONDS WEST, 1301.48 FEET.

811 CALL BEFORE YOU DIG - DRILL - BLAST

KANSAS:
P: 800-344-7233
F: 316-687-3753

COLORADO:
P: 800-922-1987
F: 303-234-1712

The utilities as shown on this drawing were developed from the information available. This is not implied nor intended to be the complete inventory of utilities in this area. It is the client/contractor's responsibility to verify the location of all utilities (whether shown or not) and protect said utilities from any damage.

CAUTION - NOTICE TO CONTRACTORS:


- ALL UTILITY LOCATIONS SHOWN ARE BASED ON MAPS PROVIDED BY THE APPROPRIATE UTILITY COMPANY AND FIELD SURFACE EVIDENCE AT THE TIME OF SURVEY AND IS TO BE CONSIDERED AN APPROXIMATE LOCATION ONLY. IT IS THE CONTRACTOR'S RESPONSIBILITY TO FIELD VERIFY THE LOCATION OF ALL UTILITIES, PUBLIC OR PRIVATE, WHETHER SHOWN ON THE PLANS OR NOT PRIOR TO CONSTRUCTION. REPORT ANY DISCREPANCIES TO THE ENGINEER PRIOR TO CONSTRUCTION.
- WHERE A PROPOSED UTILITY CROSSES AN EXISTING UTILITY, IT IS THE CONTRACTOR'S RESPONSIBILITY TO FIELD VERIFY THE HORIZONTAL AND VERTICAL LOCATION OF SUCH EXISTING UTILITY, EITHER THROUGH POT-HOLING OR ALTERNATIVE METHOD. REPORT INFORMATION TO THE ENGINEER PRIOR TO CONSTRUCTION.

REVISION DESCRIPTION (DESCRIPTION)

REVISION DATE

00/00/00

NORTH

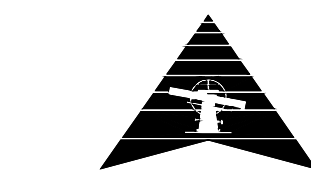

200' 100' 0' 200'
SCALE: 1" = 200'

PROJECT #: 2107-0307
CHECKED BY: BML
DRAWN BY: JAM

DATE: 02/15/2023

SHEET #

1

TOTAL SHEETS 5

GRADING & EROSION CONTROL COVER SHEET


remove GEC from CD file

GUNTZELMAN PORCELAIN PINES

PRELIMINARY DOCUMENTS NOT FOR CONSTRUCTION

EL PASO COUNTY, COLORADO

GRADING & EROSION CONTROL PLAN

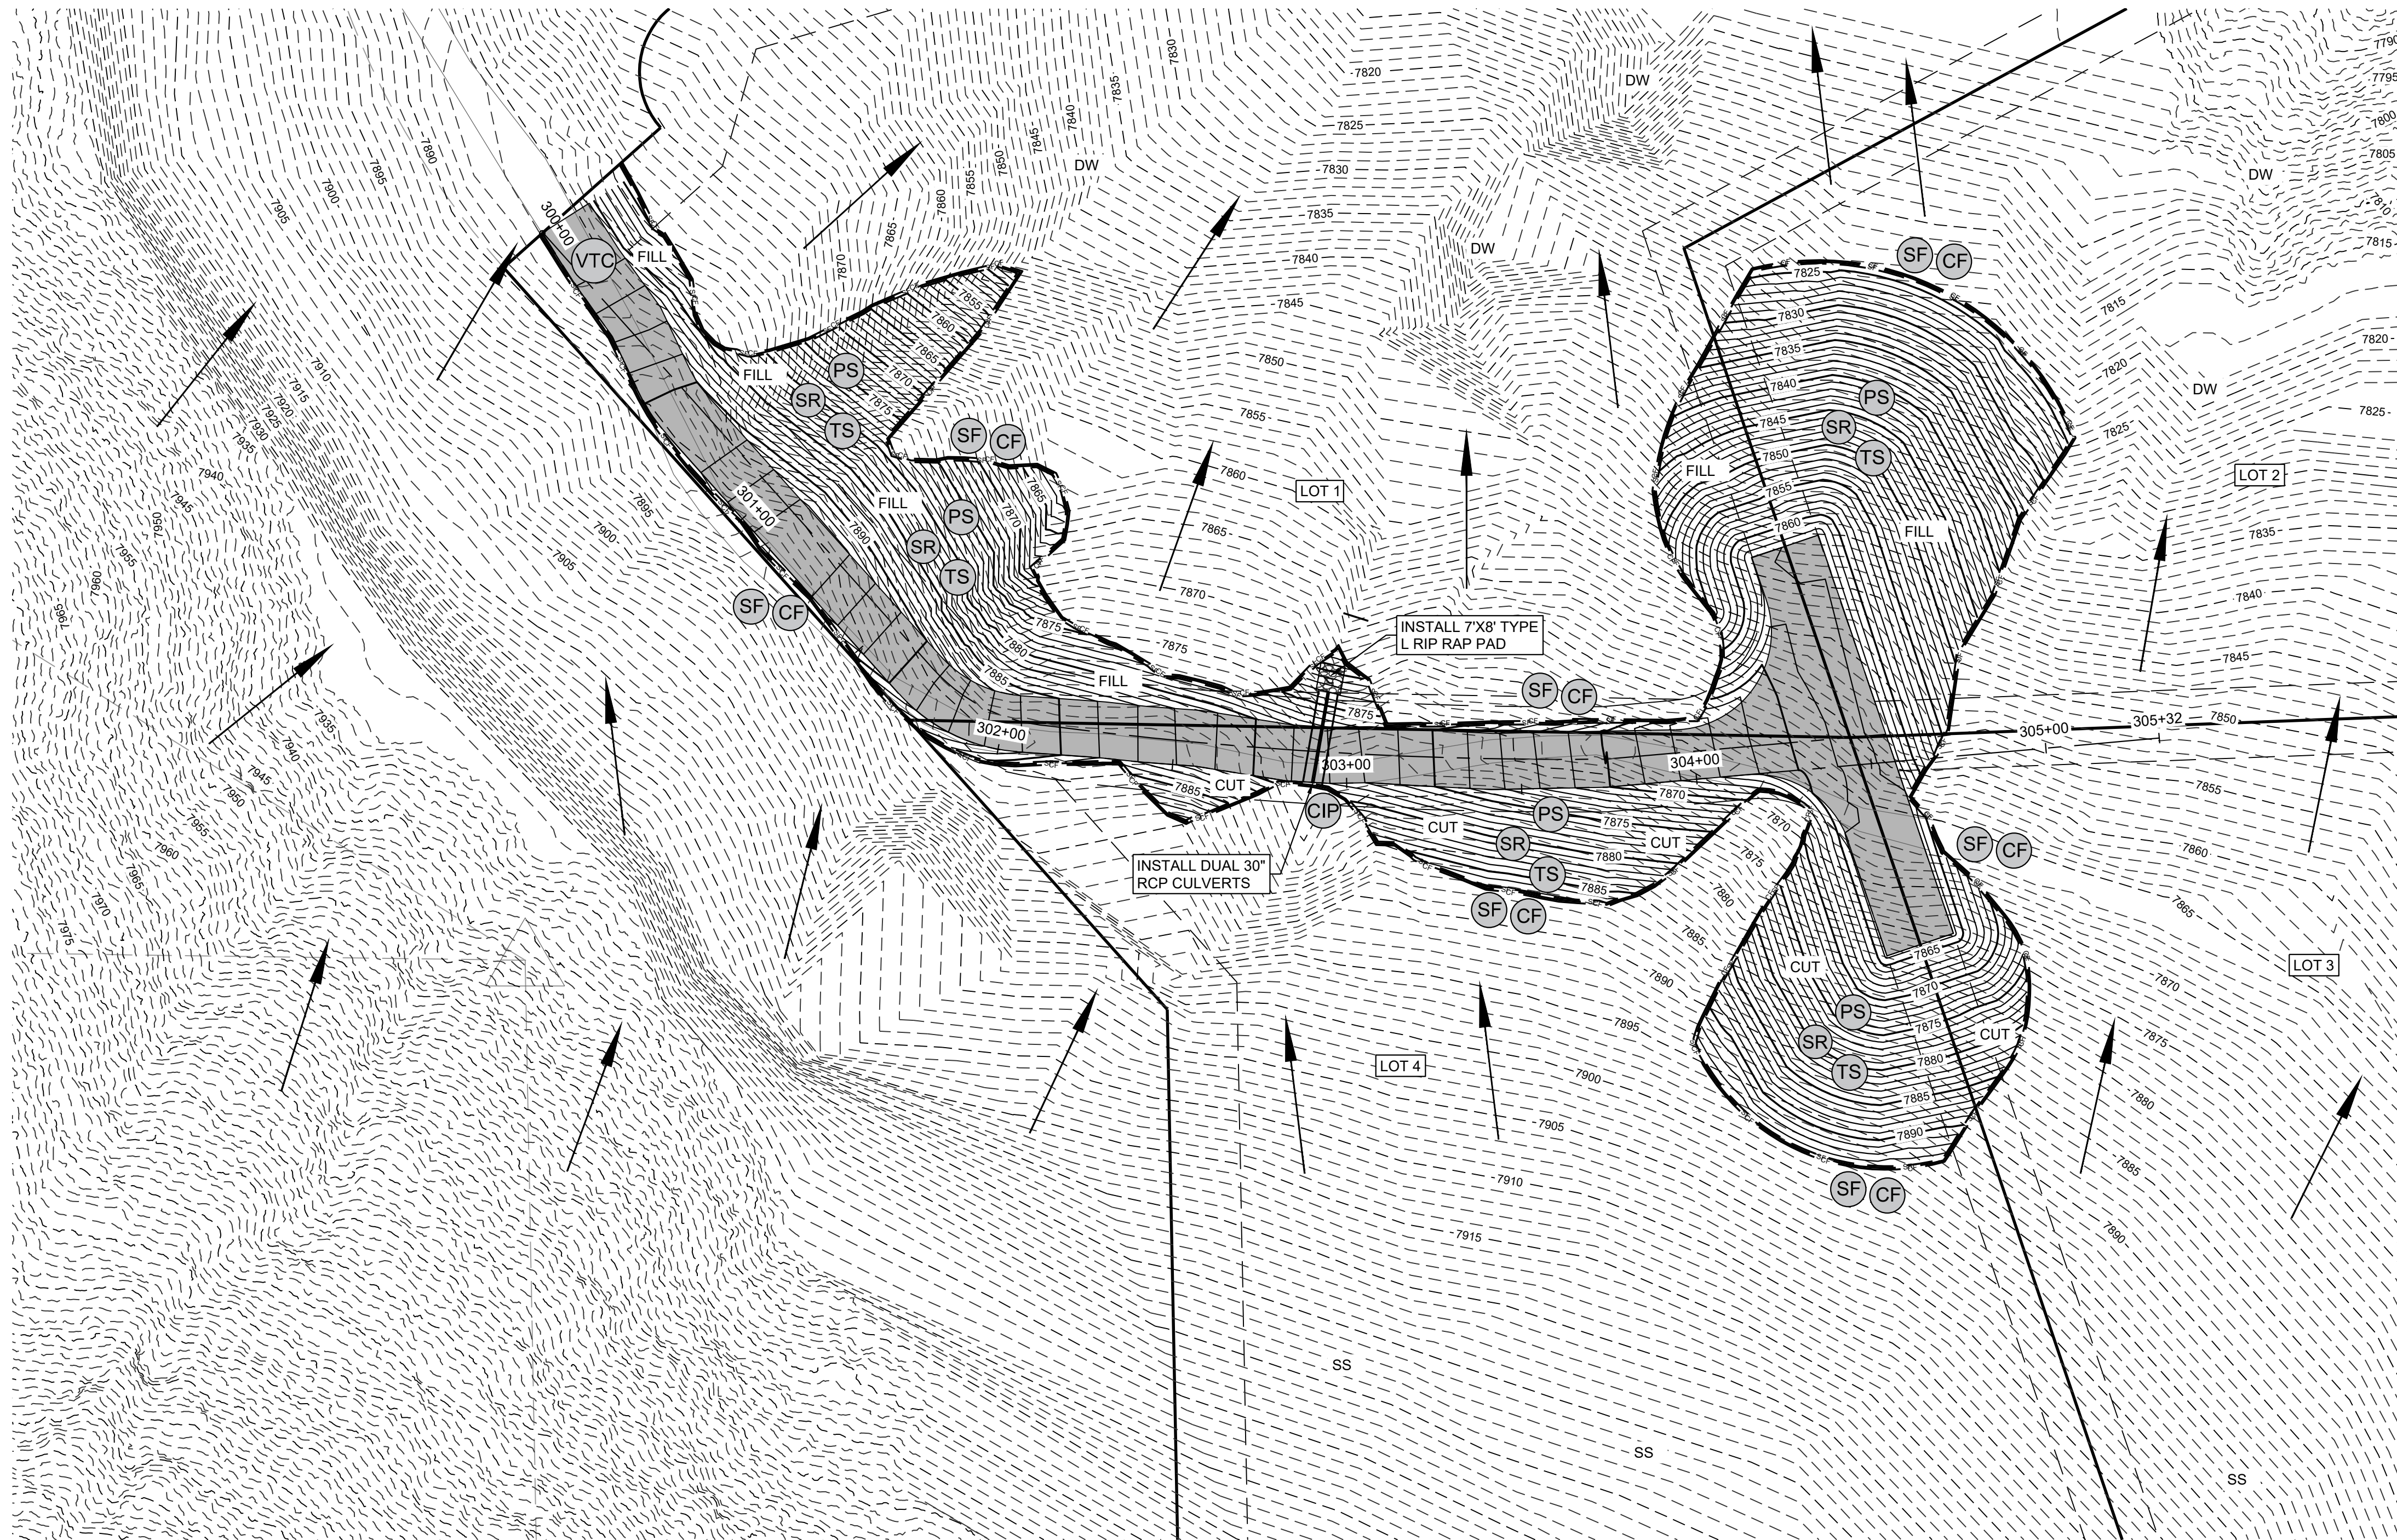



LEGEND

	PROPOSED PRIVATE DRIVE/DRIVEWAY
	VEHICLE TRACKING CONTROL
	PERMANENT SEEDING
	TEMPORARY SEEDING
	SILT FENCE
	STOCKPILE PROTECTION
	STABILIZED STAGING AREA
	CONCRETE WASHOUT AREA
	CULVERT INLET PROTECTION
	SURFACE ROUGHENING
	CONSTRUCTION FENCE
	SITE (CONTACTS AND PERMITS) AND WASHOUT POSTING
DW	DRAINAGE WAY
SS	STEEP SLOPES
	PROPOSED STORM SEWER
	LOT LINE
	LIMITS OF CONSTRUCTION/DISTURBANCE
	FLOW DIRECTION ARROW
	EXISTING CONTOUR
	PROPOSED CONTOUR

- NOTES:**
1. FUTURE LOT OWNERS SHALL PROVIDE AN ENGINEERED SITE PLAN AT TIME OF BUILDING PERMIT. ENGINEERED SITE PLAN SHALL INDICATE ANY REQUIRED CULVERTS FOR EACH INDIVIDUAL LOT. LOT OWNERS WILL BE RESPONSIBLE FOR INSTALLATION OF CULVERTS REQUIRED FOR THEIR DRIVEWAY AND SITE LAYOUT.
 2. THE SITE IS CURRENTLY UNDEVELOPED AND HEAVILY FORESTED. SOIL DATA FOR THE PROPERTY WAS OBTAINED FROM THE UNITED STATES DEPARTMENT OF AGRICULTURE NATURAL RESOURCES CONSERVATION SERVICE (NRCS) WEB SOIL SURVEY. SOILS WITHIN THE SITE ARE LEGAULT-ROCK OUTCROP, HYDROLOGIC SOIL GROUP D, AND TECOLOTE, HYDROLOGIC SOIL GROUP B.
 3. PRIVATE DRIVE/DRIVEWAY CONSTRUCTION PER GEOTECH REPORT AND CASCADE FIRE DEPARTMENT SPECIFICATIONS.
 4. STOCKPILE LOCATION FOR THIS PROJECT TO BE LOCATED BY CONTRACTOR AND ADDED TO THE SWMP/GEC UPON DETERMINATION.
 5. LOCATION OF STORAGE FOR MAINTENANCE EQUIPMENT, CONCRETE WASHOUT, AND TEMPORARY DISPOSAL AREAS WILL BE ADDED TO THE GEC/SWMP BY CONTRACTOR.
 6. ALL NON-STRUCTURAL CONTROL MEASURES SUCH AS STREET SWEEPING, GOOD HOUSEKEEPING, AND ETC. SHALL BE EMPLOYED BY THE CONTRACTOR AS NECESSARY AND AS OUTLINED IN THE SWMP.
 7. MAXIMUM CUT FILL SLOPES SHALL NOT EXCEED 2:1.
 8. ALL FILL MATERIAL SHALL BE APPROVED BY A LICENSED ENGINEER.
 9. ALL STRIPPED TOPSOIL SHALL BE STOCKPILED FOR RE-USE, IF POSSIBLE.
 10. LOCATION OF PORTABLE TOILET, STABILIZED STAGING AREA, AND SITE (CONTACTS AND PERMITS) AND WASHOUT POSTING TO BE ADDED TO THIS PLAN AND SWMP BY CONTRACTOR.
 11. CONSTRUCTION FENCE AND SILT FENCE OFFSET FOR CLARITY. CONTRACTOR TO ENSURE CCM'S ARE PLACED DOWNSTREAM OF DISTURBED AREAS TO PREVENT SEDIMENT FROM LEAVING SITE.

REVISION DATE	REVISION DESCRIPTION (DESCRIPTION)
00/00/00	

NORTH

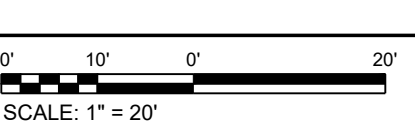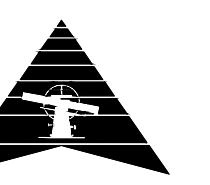


PROJECT #: 2107-0307
CHECKED BY: BML
DRAWN BY: JAM

DATE: 02/15/2023

SHEET #

2

TOTAL SHEETS 5

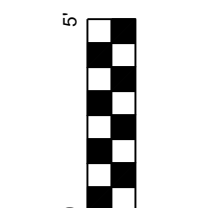

remove GEC from CD file

EROSION CONTROL BLANKET

STAKING PATTERN PER MANUFACTURER SPECIFICATION OR 18" O.C.

OVERLAPPING JOINT

6" OVERLAP

6"x6" TRENCH (TYPICAL)

KEY IN EDGES

PERIMETER ANCHOR TRENCH

JOINT ANCHOR TRENCH

INTERMEDIATE CHECK SLOT

OVERLAPPING JOINT

STAPLE CHECK TO BE USED ON SLOPE EVERY 15 FEET

ECB

STORMWATER ENTERPRISE

APPROVED: [Signature]

ISSUED: 10/7/19

REVISION: 8/18/2020

DRAWING NO. 900-ECB-1

PORTABLE TOILET

CONTRACTOR SHALL ANCHOR PORTABLE TOILET TO THE GROUND, AT A MINIMUM OF TWO OPPOSING CORNERS (ON A DIAGONAL) USING U-SHAPED REBAR STAKES

PORTABLE TOILET PLAN

ISOMETRIC

CONTRACTOR SHALL ANCHOR PORTABLE TOILET TO THE GROUND, AT A MINIMUM OF TWO OPPOSING CORNERS (ON A DIAGONAL) USING U-SHAPED REBAR STAKES OR OTHER EFFECTIVE ANCHORING

PT

STORMWATER ENTERPRISE

APPROVED: [Signature]

ISSUED: 2/19/19

REVISION: 8/18/2020

DRAWING NO. 900-PT

INSTALLATION NOTES

- 100% NATURAL AND BIODEGRADABLE MATERIALS ARE REQUIRED FOR EROSION CONTROL BLANKETS. TRM PRODUCTS MAY BE USED WHERE APPROPRIATE AS DESIGNATED BY THE ENGINEER.
- IN AREAS WHERE EROSION CONTROL BLANKETS ARE SHOWN ON THE PLANS, THE PERMITTEE SHALL PLACE TOPSOIL AND PERFORM FINAL GRADING, SURFACE PREPARATION, AND SEEDING AND MULCHING. SUBGRADE SHALL BE SMOOTH AND MOIST PRIOR TO EROSION CONTROL BLANKET INSTALLATION, AND THE EROSION CONTROL BLANKET SHALL BE IN FULL CONTACT WITH THE SUBGRADE. NO GAPS OR VOIDS SHALL EXIST UNDER THE BLANKET.
- PERIMETER ANCHOR TRENCH SHALL BE USED ALONG THE OUTSIDE PERIMETER OF ALL BLANKET AREAS.
- JOINT ANCHOR TRENCH SHALL BE USED TO JOIN ROLLS OF EROSION CONTROL BLANKETS TOGETHER (LONGITUDINALLY AND TRANSVERSELY) FOR ALL EROSION CONTROL BLANKETS.
- INTERMEDIATE CHECK SLOT OR STAPLE CHECK SHALL BE INSTALLED EVERY 15' DOWN SLOPES. IN DRAINAGEWAYS, INSTALL CHECK SLOTS EVERY 25' PERPENDICULAR TO FLOW DIRECTION.
- OVERLAPPING JOINT DETAIL SHALL BE USED TO JOIN ROLLS OF EROSION CONTROL BLANKETS TOGETHER FOR EROSION CONTROL BLANKETS ON SLOPES.
- MATERIAL SPECIFICATIONS OF EROSION CONTROL BLANKETS SHALL CONFORM TO TABLE ECB-1.
- ANY AREAS OF SEEDING AND MULCHING DISTURBED IN THE PROCESS OF INSTALLING EROSION CONTROL BLANKETS SHALL BE RESEEDED AND MULCHED.
- STRAW EROSION CONTROL BLANKETS SHALL NOT BE USED WITHIN STREAMS AND DRAINAGE CHANNELS.
- COMPACT ALL TRENCHES.

MAINTENANCE NOTES

- FREQUENT OBSERVATIONS AND MAINTENANCE ARE NECESSARY TO MAINTAIN CONTROL MEASURES IN EFFECTIVE OPERATING CONDITION. INSPECTIONS AND CORRECTIVE MEASURES SHOULD BE DOCUMENTED THOROUGHLY.
- EROSION CONTROL BLANKETS SHALL BE LEFT IN PLACE TO EVENTUALLY BIODEGRADE. TRM MUST BE REMOVED AT THE DISCRETION OF THE DEC INSPECTOR.
- ANY EROSION CONTROL BLANKET PULLED OUT, TORN, OR OTHERWISE DAMAGED SHALL BE REPAIRED OR REINSTALLED. ANY SUBGRADE AREAS BELOW GEOTEXTILE THAT HAVE ERODED TO CREATE A VOID UNDER THE BLANKET, OR THAT REMAIN DEVOID OF GRASS SHALL BE REPAIRED, RESEEDED AND MULCHED AND THE EROSION CONTROL BLANKET REINSTALLED.

TYPE	COCONUT CONTENT	STRAW CONTENT	EXCELISIOR CONTENT	RECOMMENDED NETTING
STRAW	-	100%	-	DOUBLE/NATURAL
STRAW-COCONUT	30% MIN.	70% MAX.	-	DOUBLE/NATURAL
COCONUT	100%	-	-	DOUBLE/NATURAL
EXCELISIOR	-	-	100%	DOUBLE/NATURAL

ECB

STORMWATER ENTERPRISE

APPROVED: [Signature]

ISSUED: 10/7/19

REVISION: 8/18/2020

DRAWING NO. 900-ECB-2

SILT FENCE

J-HOOK INSTALLATION

SECTION A-A

POSTS SHOULD OVERLAP SO THAT NO GAPS EXIST

SF

STORMWATER ENTERPRISE

APPROVED: [Signature]

ISSUED: 10/7/19

REVISION: 8/18/2020

DRAWING NO. 900-SF

SEEDING & MULCHING

ALL SOIL TESTING, SOILS AMENDMENT AND FERTILIZER DOCUMENTATION, AND SEED LOAD AND BAG TICKETS MUST BE ADDED TO THE CSWMP.

SOIL PREPARATION

- IN AREAS TO BE SEEDDED, THE UPPER 6 INCHES OF THE SOIL MUST NOT BE HEAVILY COMPACTED, AND SHOULD BE IN FRABLE CONDITION. LESS THAN 85% STANDARD PROCTOR DENSITY IS ACCEPTABLE. AREAS OF COMPACTION OR GENERAL CONSTRUCTION ACTIVITY MUST BE SCARIFIED TO A DEPTH OF 6 TO 12 INCHES PRIOR TO SPREADING TOPSOIL TO BREAK UP COMPACTED LAYERS AND PROVIDE A BLENDING ZONE BETWEEN DIFFERENT SOIL LAYERS.
- AREAS TO BE PLANTED SHALL HAVE AT LEAST 4 INCHES OF TOPSOIL SUITABLE TO SUPPORT PLANT GROWTH.
- THE CITY RECOMMENDS THAT EXISTING AND/OR IMPORTED TOPSOIL BE TESTED TO IDENTIFY SOIL DEFICIENCIES AND ANY SOIL AMENDMENTS NECESSARY TO ADDRESS THESE DEFICIENCIES. SOIL AMENDMENTS AND/OR FERTILIZERS SHOULD BE ADDED TO CORRECT TOPSOIL DEFICIENCIES BASED ON SOIL TESTING RESULTS.
- TOPSOIL SHALL BE PROTECTED DURING THE CONSTRUCTION PERIOD TO RETAIN ITS STRUCTURE AVOID COMPACTION, AND TO PREVENT EROSION AND CONTAMINATION. STRIPPED TOPSOIL MUST BE STORED IN AN AREA AWAY FROM MACHINERY AND CONSTRUCTION OPERATIONS, AND CARE MUST BE TAKEN TO PROTECT THE TOPSOIL AS A VALUABLE COMMODITY. TOPSOIL MUST NOT BE STRIPPED DURING UNDESIRABLE WORKING CONDITIONS (E.G. DURING WET WEATHER OR WHEN SOILS ARE SATURATED). TOPSOIL SHALL NOT BE STORED IN SWALES OR IN AREAS WITH POOR DRAINAGE.

SEEDING

- ALLOWABLE SEED MIXES ARE INCLUDED IN THE CITY OF COLORADO SPRINGS STORMWATER CONSTRUCTION MANUAL. ALTERNATIVE SEED MIXES ARE ACCEPTABLE IF INCLUDED IN AN APPROVED LANDSCAPING PLAN.
- SEED SHOULD BE DRILL-SEEDED WHENEVER POSSIBLE.
- SEED DEPTH MUST BE 1/4 TO 1/2 INCHES WHEN DRILL-SEEDING IS USED.
- BROADCAST SEEDING OR HYDRO-SEEDING WITH TACKIFIER MAY BE SUBSTITUTED ON SLOPES STEEPER THAN 3:1 OR ON OTHER AREAS NOT PRACTICAL TO DRILL SEED.
- SEEDING RATES MUST BE DOUBLED FOR BROADCAST SEEDING OR INCREASED BY 50% IF USING A BRILLION DRILL OR HYDRO-SEEDING.
- BROADCAST SEEDING MUST BE LIGHTLY HAND-RAKED INTO THE SOIL.

MULCHING

- MULCHING SHOULD BE COMPLETED AS SOON AS PRACTICABLE AFTER SEEDING; HOWEVER PLANTED AREAS MUST BE MULCHED NO LATER THAN 14 DAYS AFTER PLANTING.
- MULCHING REQUIREMENTS INCLUDE:
 - HAY OR STRAW MULCH
 - ONLY CERTIFIED WEED-FREE AND CERTIFIED SEED-FREE MULCH MAY BE USED. MULCH MUST BE APPLIED AT 2 TONS/ACRE AND ADEQUATELY SECURED BY CRIMPING AND/OR TACKIFIER.
 - CRIMPING MUST NOT BE USED ON SLOPES GREATER THAN 3:1 AND MULCH FIBERS MUST BE TUCKED INTO THE SOIL TO A DEPTH OF 3 TO 4 INCHES.
 - TACKIFIER MUST BE USED IN PLACE OF CRIMPING ON SLOPES STEEPER THAN 3:1.
 - HYDRAULIC MULCHING
 - HYDRAULIC MULCHING IS AN OPTION ON STEEP SLOPES OR WHERE ACCESS IS LIMITED.
 - IF HYDRO-SEEDING IS USED, MULCHING MUST BE APPLIED AS A SEPARATE SECOND OPERATION.
 - WOOD CELLULOSE FIBERS MIXED WITH WATER MUST BE APPLIED AT A RATE OF 2,000 TO 2,500 POUNDS/ACRE, AND TACKIFIER MUST BE APPLIED AT A RATE OF 100 POUNDS/ACRE.
- EROSION CONTROL BLANKET
 - EROSION CONTROL BLANKET MAY BE USED IN PLACE OF TRADITIONAL MULCHING METHODS.

CAUTION - NOTICE TO CONTRACTORS:

- ALL UTILITY LOCATIONS SHOWN ARE BASED ON MAPS PROVIDED BY THE APPROPRIATE UTILITY COMPANY AND FIELD SURFACE EVIDENCE AT THE TIME OF SURVEY AND IS TO BE CONSIDERED AN APPROXIMATE LOCATION ONLY. IT IS THE CONTRACTOR'S RESPONSIBILITY TO FIELD VERIFY THE LOCATION OF ALL UTILITIES, PUBLIC OR PRIVATE, WHETHER SHOWN ON THE PLANS OR NOT PRIOR TO CONSTRUCTION. REPORT ANY DISCREPANCIES TO THE ENGINEER PRIOR TO CONSTRUCTION.
- WHERE A PROPOSED UTILITY CROSSES AN EXISTING UTILITY, IT IS THE CONTRACTOR'S RESPONSIBILITY TO FIELD VERIFY THE HORIZONTAL AND VERTICAL LOCATION OF SUCH EXISTING UTILITY, EITHER THROUGH POT-HOLING OR ALTERNATIVE METHOD. REPORT INFORMATION TO THE ENGINEER PRIOR TO CONSTRUCTION.

811 CALL BEFORE YOU DIG - DRILL - BLAST

KANSAS: P: 800-344-7233 F: 316-687-3753

COLORADO: P: 800-922-1987 F: 303-234-1712

The utilities as shown on this drawing were developed from the information available. This is not implied nor intended to be the complete inventory of utilities in this area. It is the client's responsibility to verify the location of all utilities (whether shown or not) and protect said utilities from any damage.

ECB

SMH CONSULTANTS

www.smhconsultants.com
Civil Engineering • Land Surveying
Landscape Architecture

Manhattan, KS - HQ
(785) 776-0541

Dodge City, KS
(620) 255-1952

Overland Park, KS
(913) 444-9615

Colorado Springs, CO
(719) 465-2145

GUNTZELMAN PORCELAIN PINES

PRELIMINARY DOCUMENTS NOT FOR CONSTRUCTION

EL PASO COUNTY, COLORADO

REVISION	DATE	DESCRIPTION
1	08/08/20	
2		
3		
4		
5		
6		
7		
8		
9		
10		

GRADING & EROSION CONTROL DETAILS

SCALE: NOT TO SCALE



PROJECT #: 2107-0307
CHECKED BY: BML
DRAWN BY: JAM

DATE: 02/15/2023


SHEET # **4**

TOTAL SHEETS 5

remove GEC from CD file

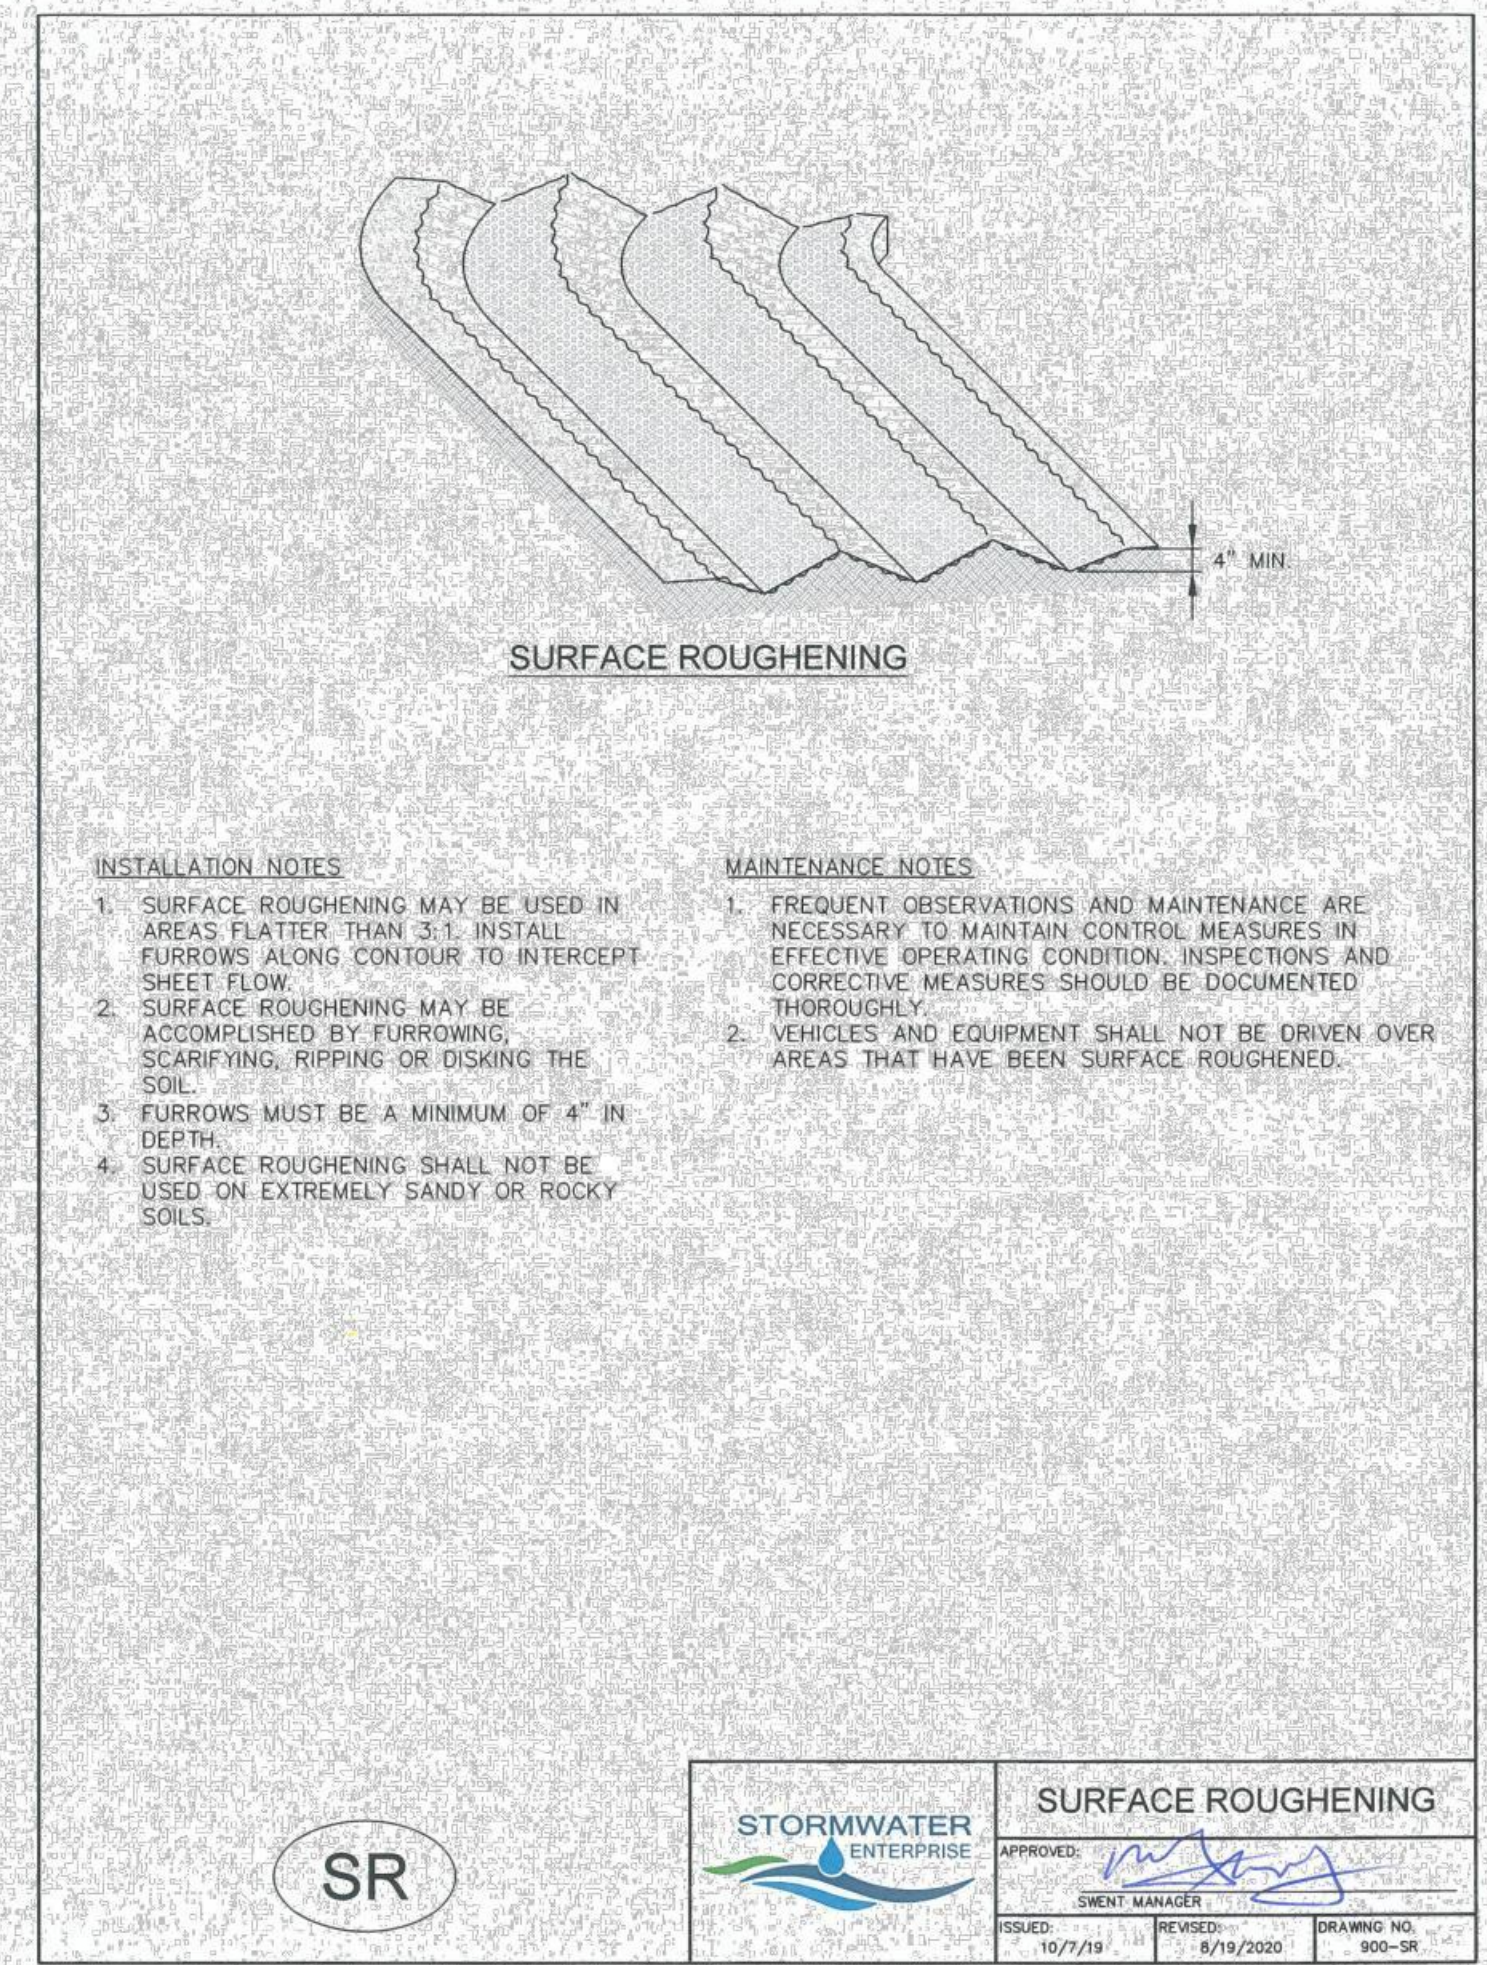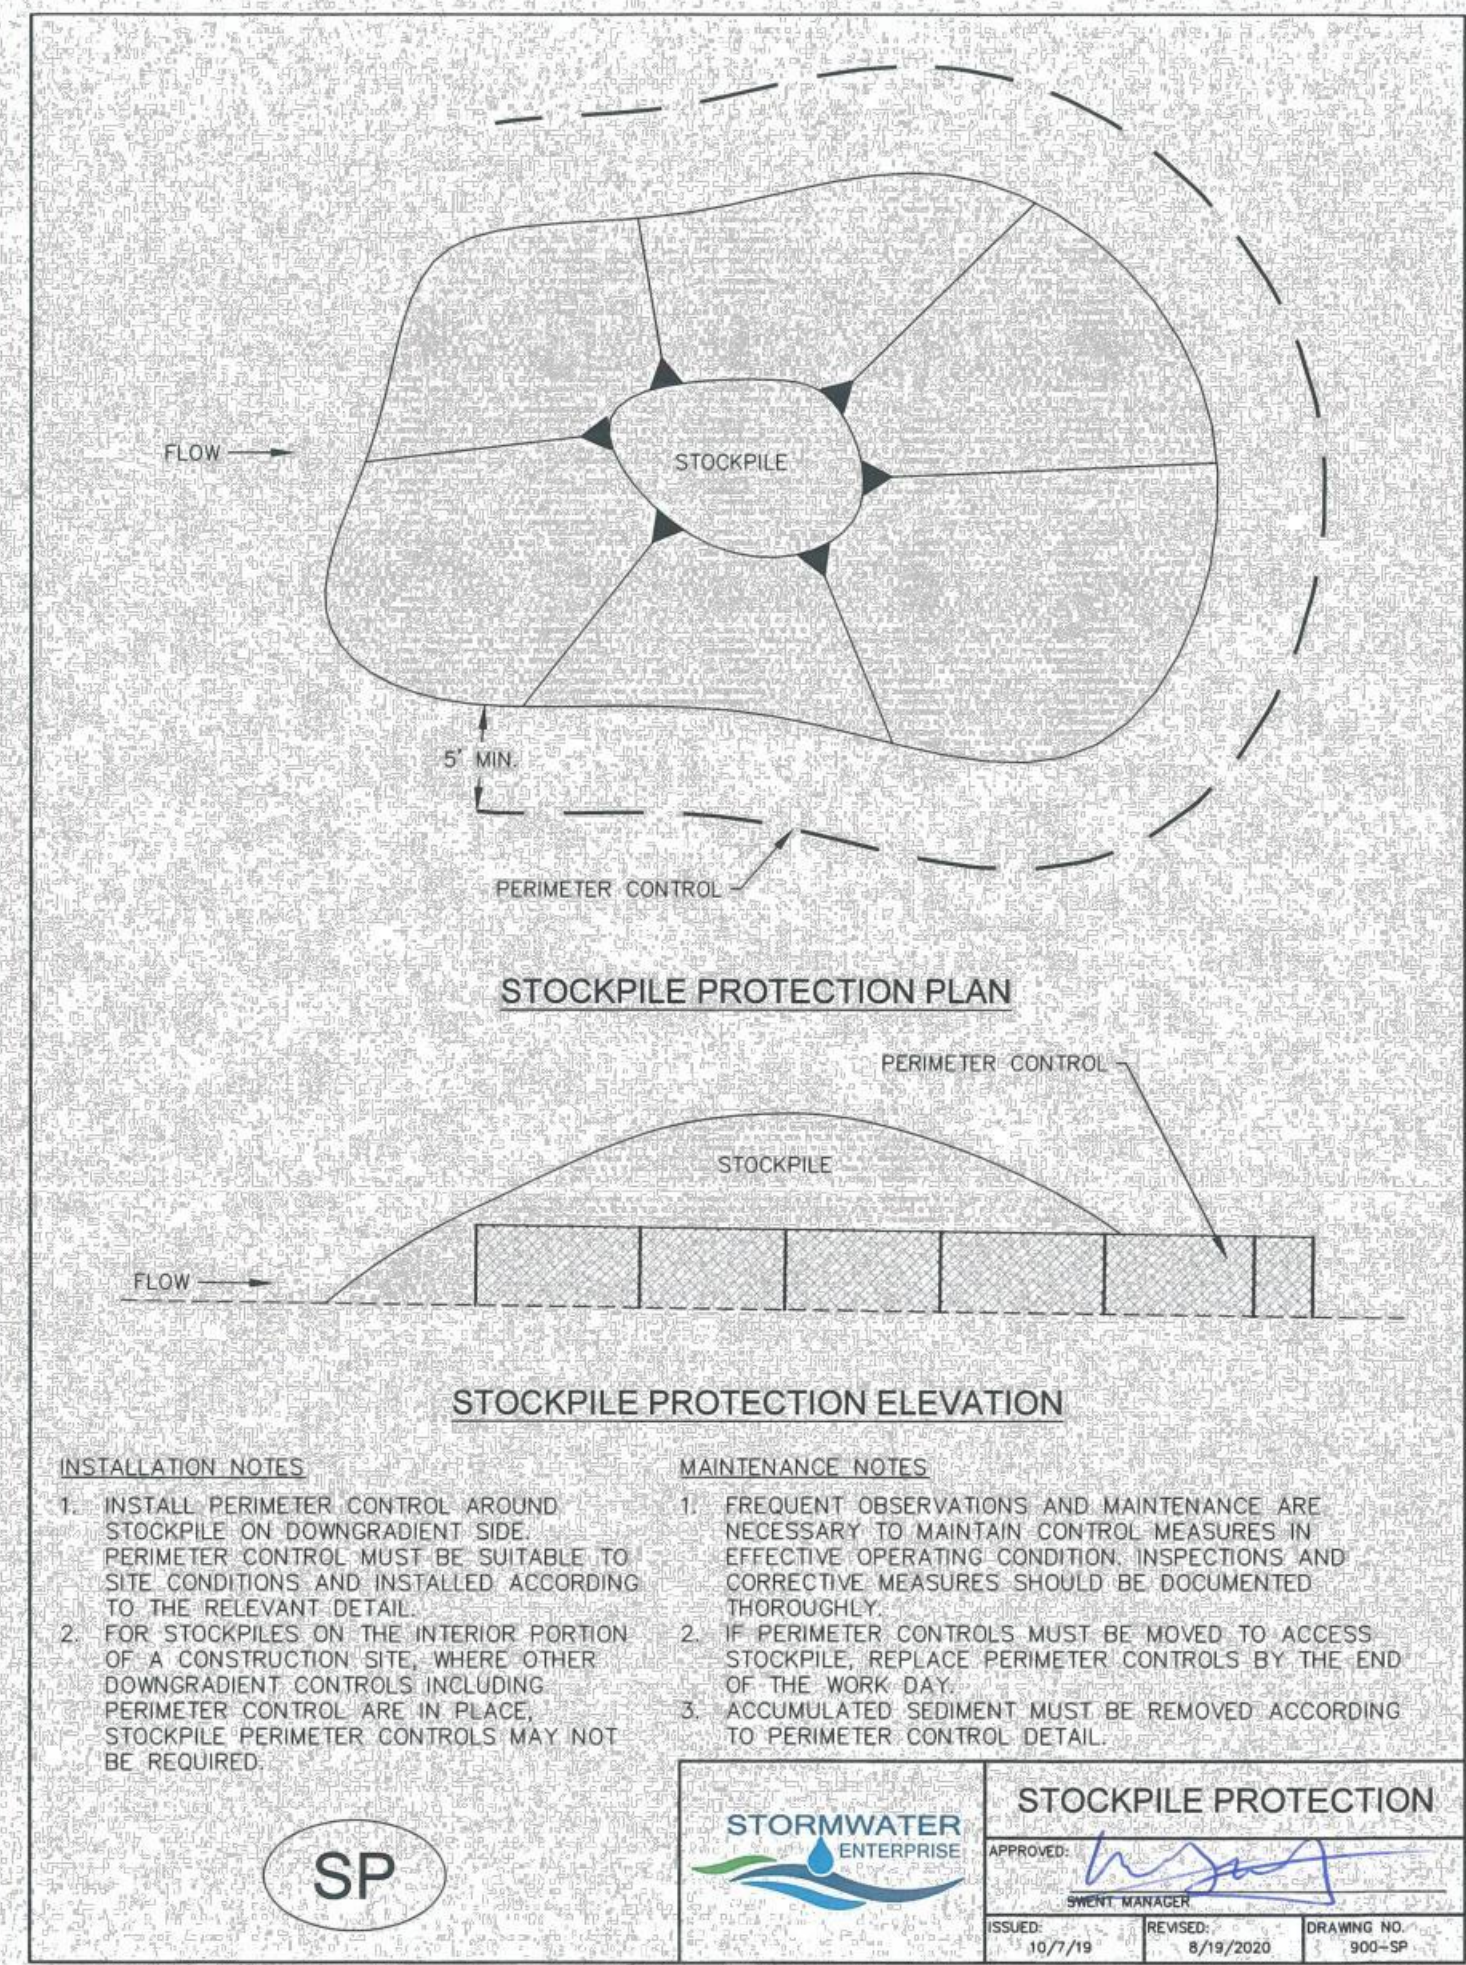

Stabilized Staging Area (SSA) SM-6

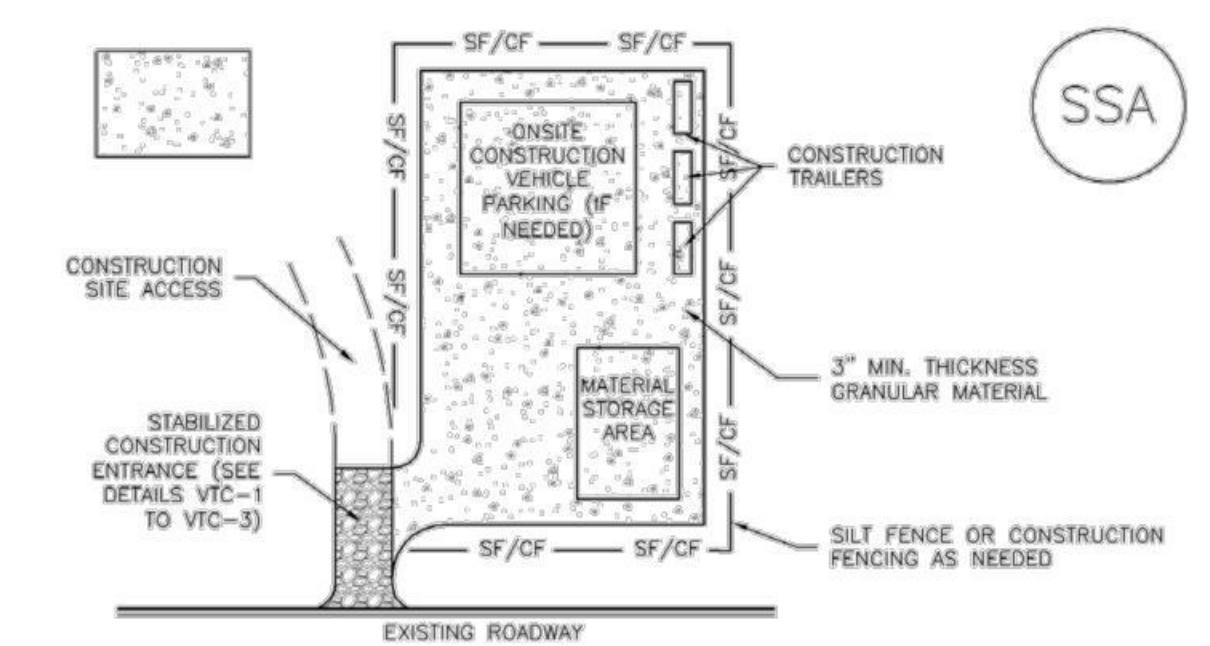

- SSA-1. STABILIZED STAGING AREA**
- STABILIZED STAGING AREA INSTALLATION NOTES**
- SEE PLAN VIEW FOR -LOCATION OF STAGING AREA(S). -CONTRACTOR MAY ADJUST LOCATION AND SIZE OF STAGING AREA WITH APPROVAL FROM THE LOCAL JURISDICTION.
 - STABILIZED STAGING AREA SHOULD BE APPROPRIATE FOR THE NEEDS OF THE SITE. OVERSIZING RESULTS IN A LARGER AREA TO STABILIZE FOLLOWING CONSTRUCTION.
 - STAGING AREA SHALL BE STABILIZED PRIOR TO OTHER OPERATIONS ON THE SITE.
 - THE STABILIZED STAGING AREA SHALL CONSIST OF A MINIMUM 3" THICK GRANULAR MATERIAL.
 - UNLESS OTHERWISE SPECIFIED BY LOCAL JURISDICTION, ROCK SHALL CONSIST OF DOT SECT. #703, AASHTO #3 COARSE AGGREGATE OR 6" (MINUS) ROCK.
 - ADDITIONAL PERIMETER BMPs MAY BE REQUIRED INCLUDING BUT NOT LIMITED TO SILT FENCE AND CONSTRUCTION FENCING.
- STABILIZED STAGING AREA MAINTENANCE NOTES**
- INSPECT BMPs EACH WORKDAY, AND MAINTAIN THEM IN EFFECTIVE OPERATING CONDITION. MAINTENANCE OF BMPs SHOULD BE PROACTIVE, NOT REACTIVE. INSPECT BMPs AS SOON AS POSSIBLE (AND ALWAYS WITHIN 24 HOURS) FOLLOWING A STORM THAT CHUSES SURFACE EROSION, AND PERFORM NECESSARY MAINTENANCE.
 - FREQUENT OBSERVATIONS AND MAINTENANCE ARE NECESSARY TO MAINTAIN BMPs IN EFFECTIVE OPERATING CONDITION. INSPECTIONS AND CORRECTIVE MEASURES SHOULD BE DOCUMENTED THOROUGHLY.
 - WHERE BMPs HAVE FAILED, REPAIR OR REPLACEMENT SHOULD BE INITIATED UPON DISCOVERY OF THE FAILURE.
 - ROCK SHALL BE REAPPLIED OR REGRADED AS NECESSARY IF RUTTING OCCURS OR UNDERLYING SUBGRADE BECOMES EXPOSED.

November 2010 Urban Drainage and Flood Control District Urban Storm Drainage Criteria Manual Volume 3 SSA-3



CAUTION - NOTICE TO CONTRACTORS:

- ALL UTILITY LOCATIONS SHOWN ARE BASED ON MAPS PROVIDED BY THE APPROPRIATE UTILITY COMPANY AND FIELD SURFACE EVIDENCE AT THE TIME OF SURVEY AND IS TO BE CONSIDERED AN APPROXIMATE LOCATION ONLY. IT IS THE CONTRACTOR'S RESPONSIBILITY TO FIELD VERIFY THE LOCATION OF ALL UTILITIES, PUBLIC OR PRIVATE, WHETHER SHOWN ON THE PLANS OR NOT PRIOR TO CONSTRUCTION. REPORT ANY DISCREPANCIES TO THE ENGINEER PRIOR TO CONSTRUCTION.
- WHERE A PROPOSED UTILITY CROSSES AN EXISTING UTILITY, IT IS THE CONTRACTOR'S RESPONSIBILITY TO FIELD VERIFY THE HORIZONTAL AND VERTICAL LOCATION OF SUCH EXISTING UTILITY, EITHER THROUGH POT-HOLING OR ALTERNATIVE METHOD. REPORT INFORMATION TO THE ENGINEER PRIOR TO CONSTRUCTION.

811 CALL BEFORE YOU DIG - DRILL - BLAST

KANSAS: P: 800-344-7233 F: 316-687-3753
 COLORADO: P: 800-922-1987 F: 303-234-1712

The utilities as shown on this drawing were developed from the information available. This is not implied nor intended to be the complete inventory of utilities in this area. It is the client's/contractor's responsibility to verify the location of all utilities (whether shown or not) and protect said utilities from any damage.

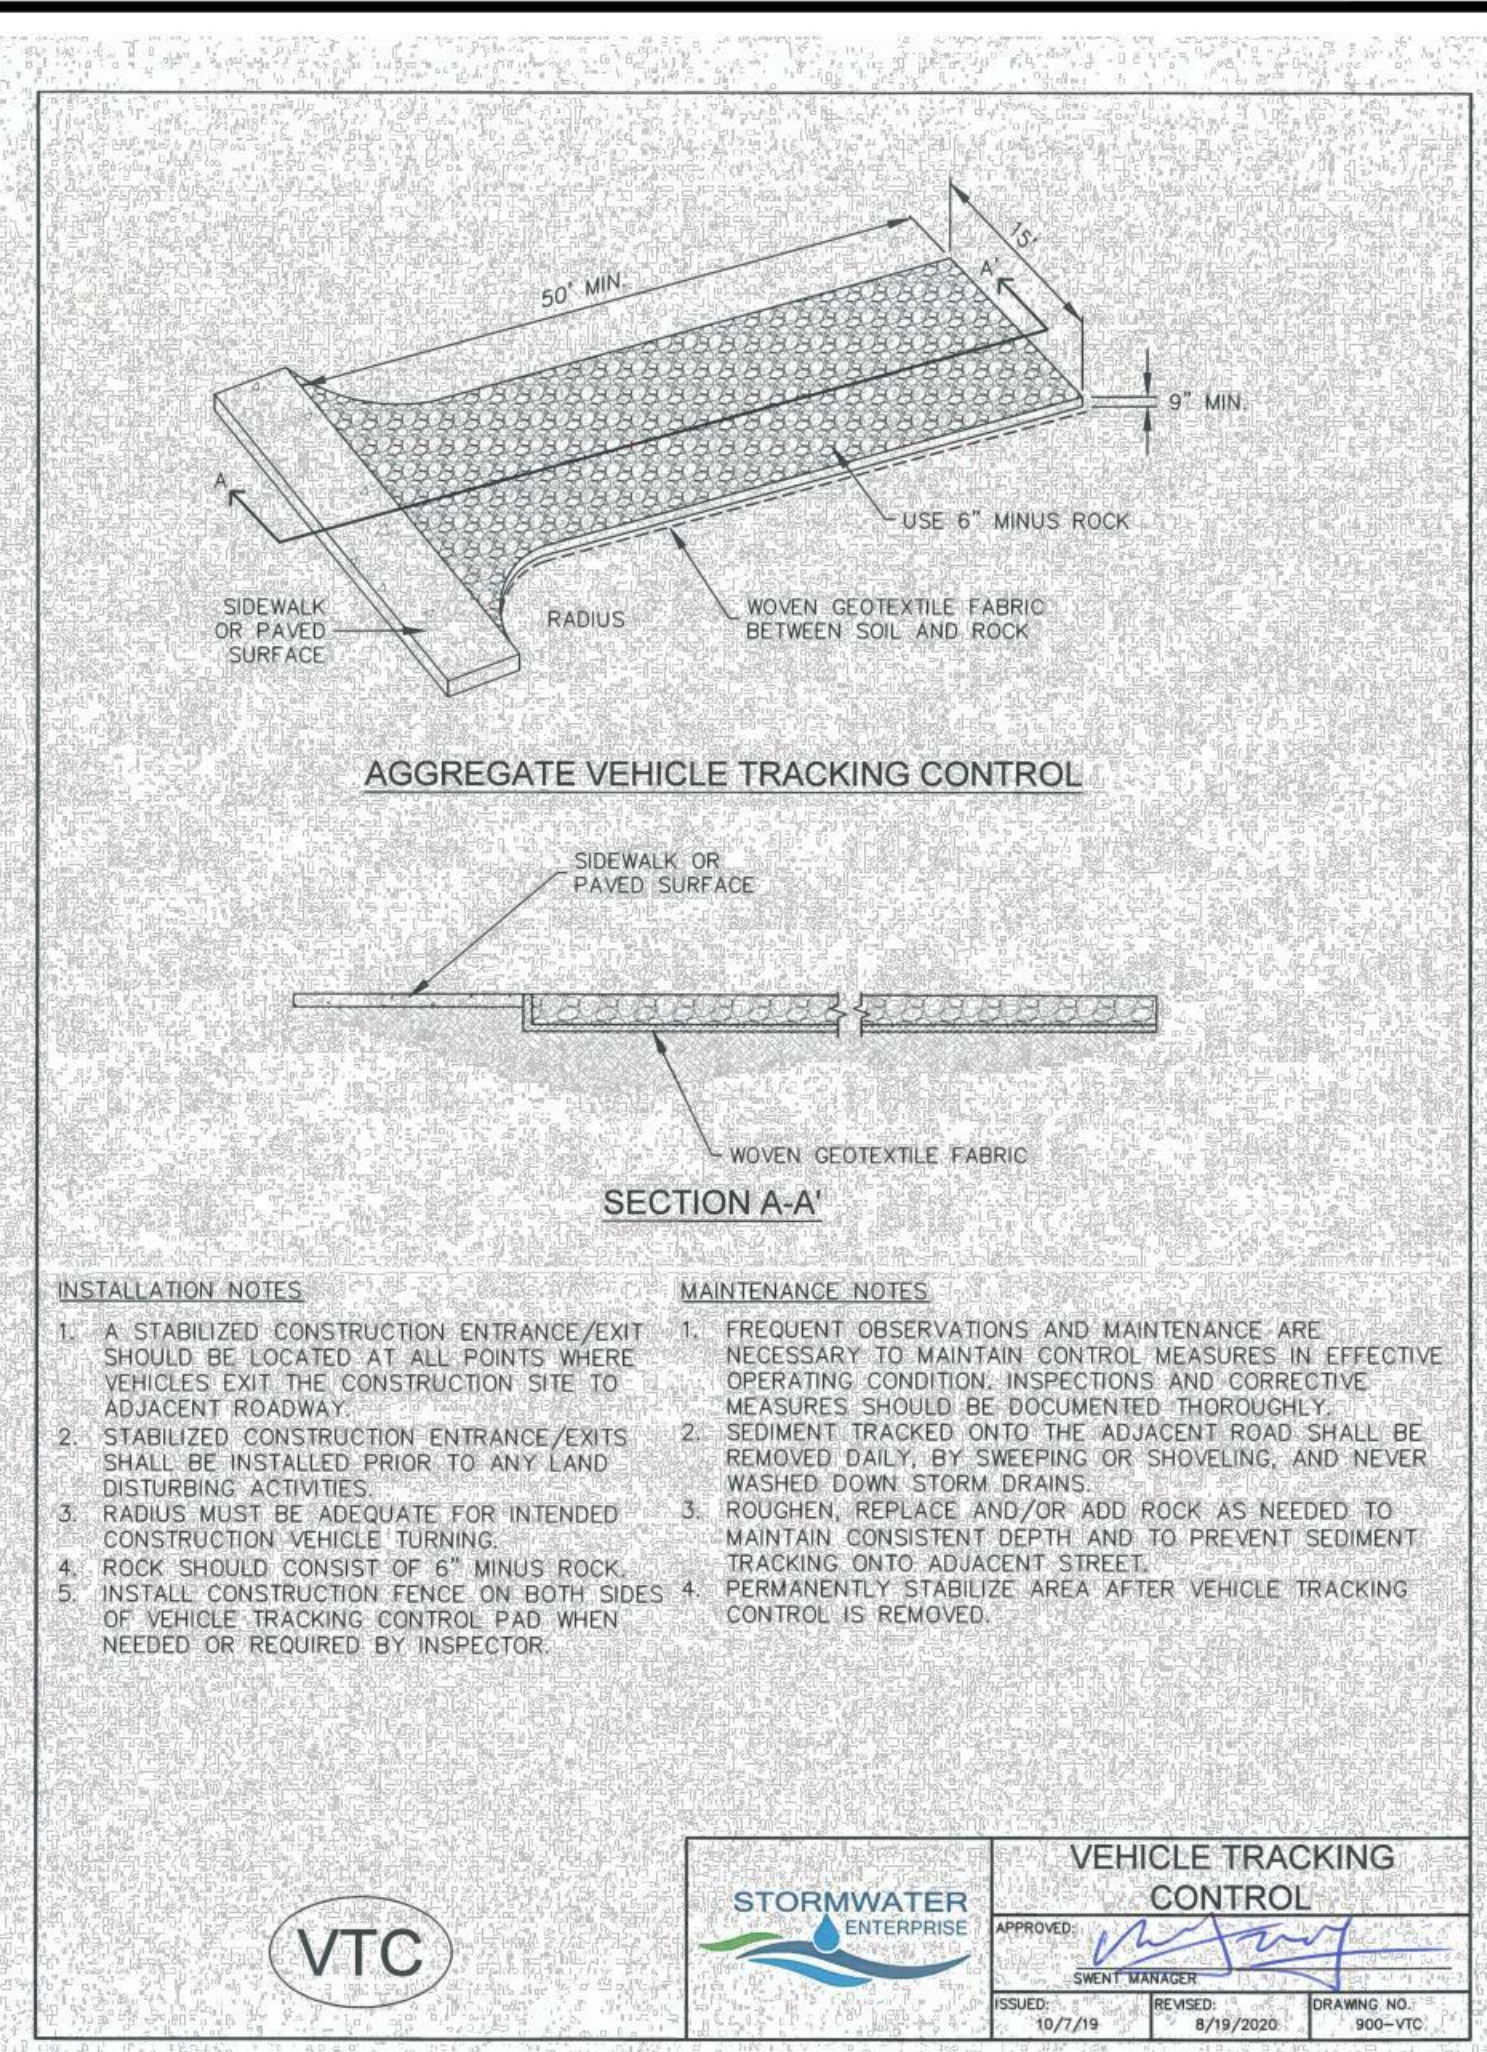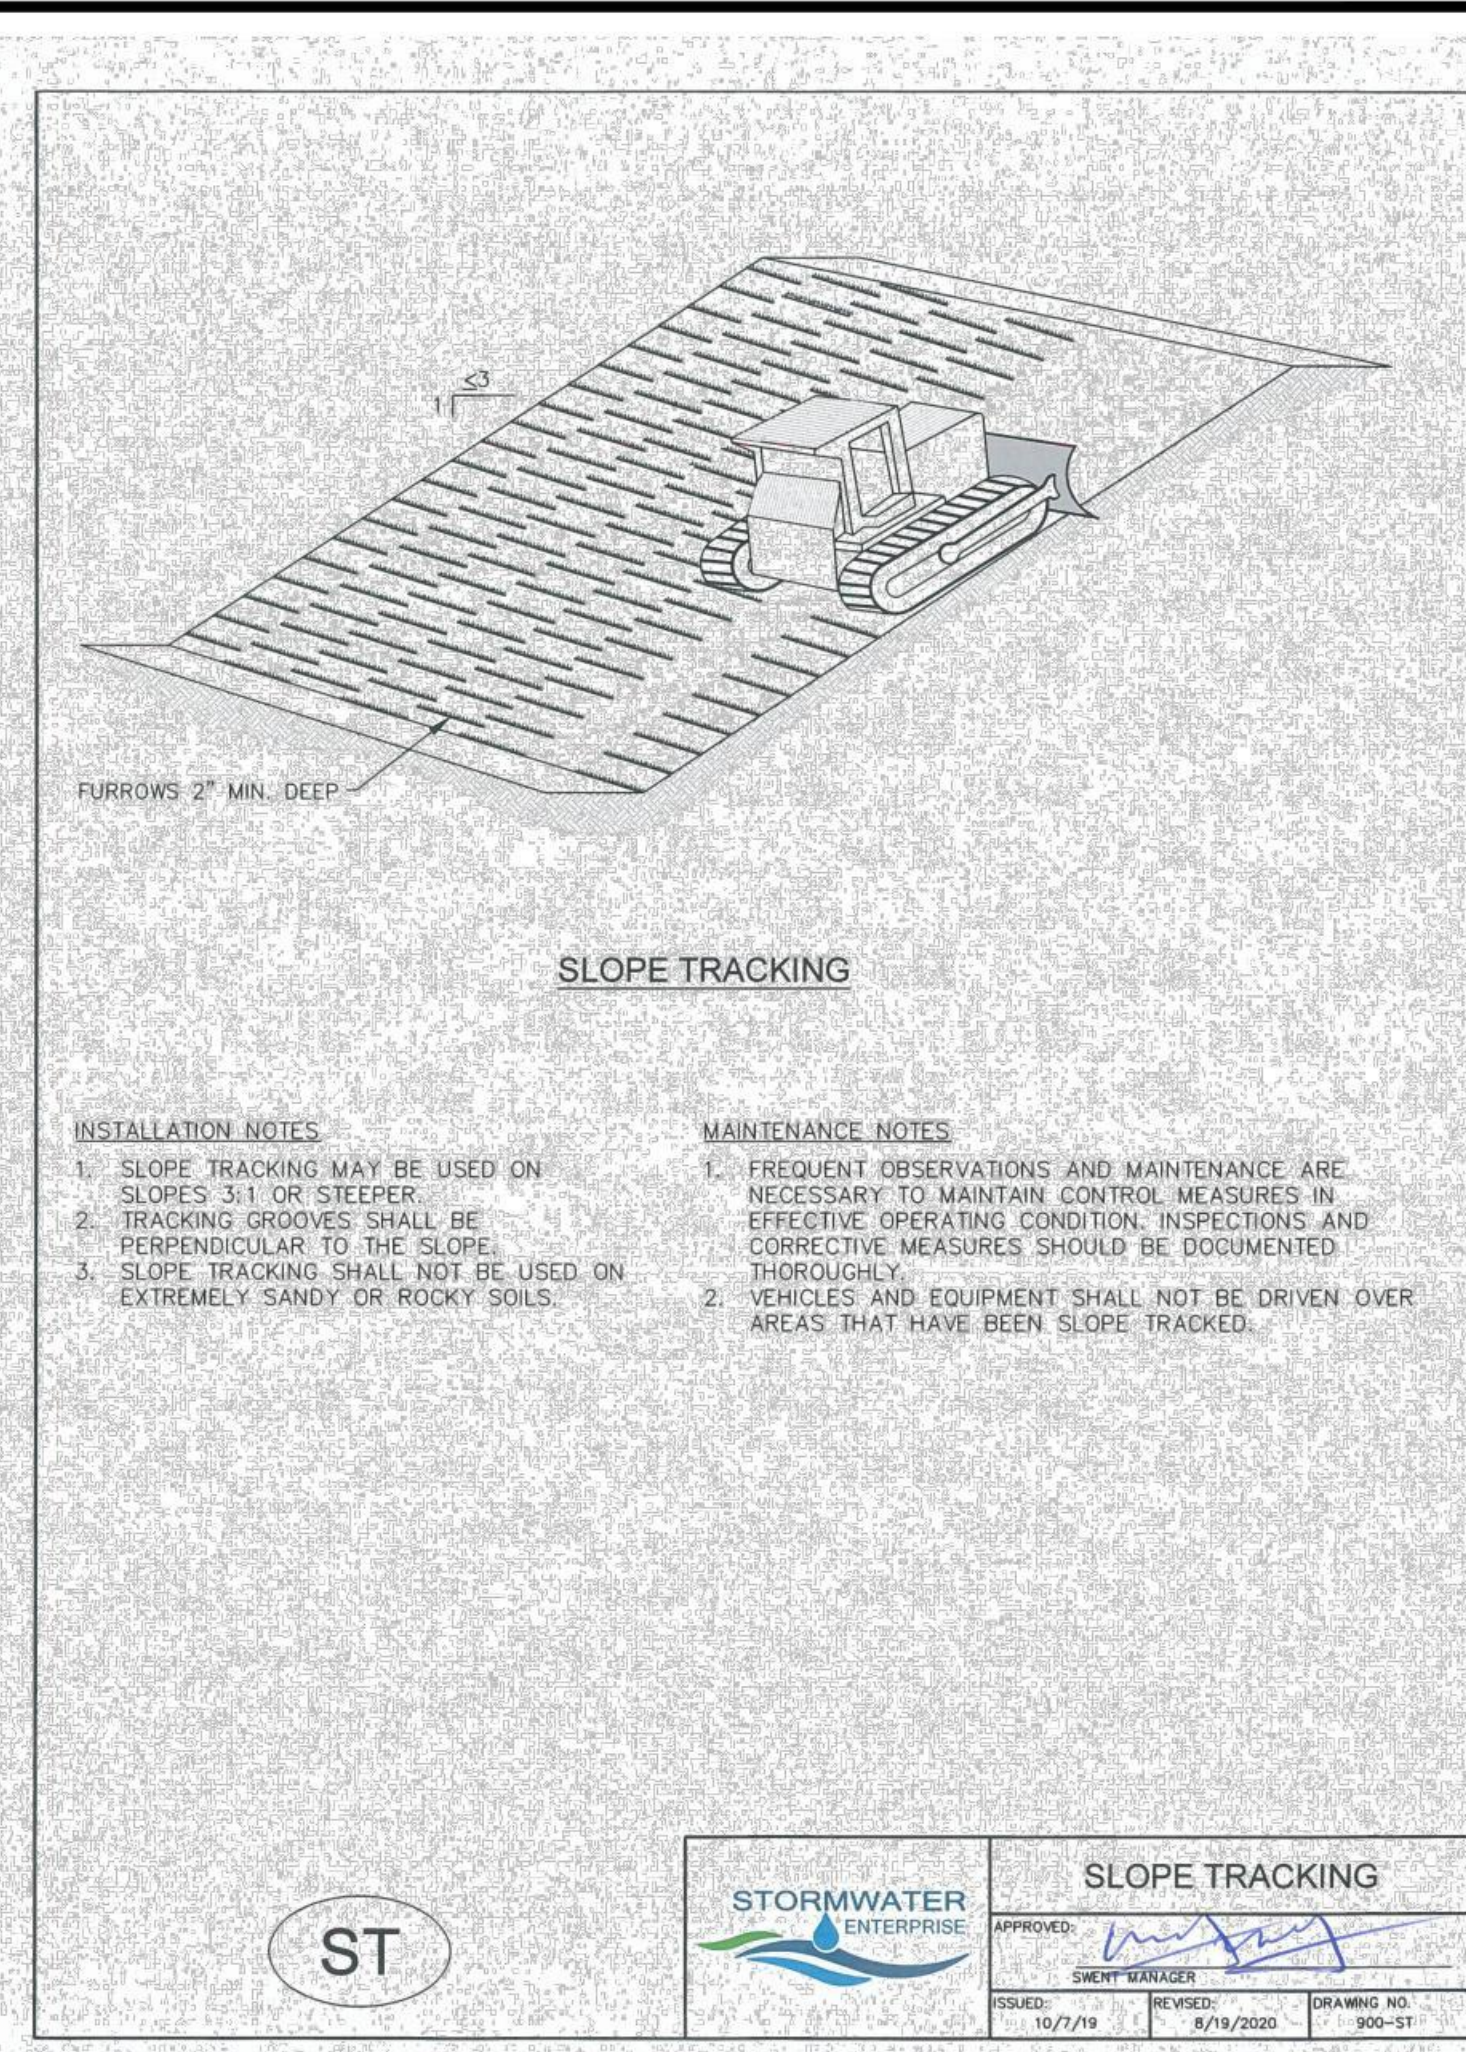

SM-6 Stabilized Staging Area (SSA)

- STABILIZED STAGING AREA MAINTENANCE NOTES**
- STABILIZED STAGING AREA SHALL BE ENLARGED IF NECESSARY TO CONTAIN PARKING, STORAGE, AND UNLOADING/LOADING OPERATIONS.
 - THE STABILIZED STAGING AREA SHALL BE REMOVED AT THE END OF CONSTRUCTION. THE GRANULAR MATERIAL SHALL BE REMOVED OR, IF APPROVED BY THE LOCAL JURISDICTION, USED ON SITE, AND THE AREA COVERED WITH TOPSOIL, SEEDS AND MULCHED OR OTHERWISE STABILIZED IN A MANNER APPROVED BY LOCAL JURISDICTION.
- NOTE: MANY MUNICIPALITIES PROHIBIT THE USE OF RECYCLED CONCRETE AS GRANULAR MATERIAL FOR STABILIZED STAGING AREAS DUE TO DIFFICULTIES WITH RE-ESTABLISHMENT OF VEGETATION IN AREAS WHERE RECYCLED CONCRETE WAS PLACED.
- NOTE: MANY JURISDICTIONS HAVE BMP DETAILS THAT VARY FROM UDFCD STANDARD DETAILS. CONSULT WITH LOCAL JURISDICTIONS AS TO WHICH DETAIL SHOULD BE USED WHEN DIFFERENCES ARE NOTED.
- (DETAILS ADAPTED FROM DOUGLAS COUNTY, COLORADO, NOT AVAILABLE IN AUTOCAD)

SSA-4 Urban Drainage and Flood Control District Urban Storm Drainage Criteria Manual Volume 3 November 2010

SMH CONSULTANTS

www.smhconsultants.com
 Civil Engineering • Land Surveying
 Landscape Architecture

Manhattan, KS - HQ (785) 776-0544
 Dodge City, KS (620) 255-1952
 Overland Park, KS (913) 444-9615
 Colorado Springs, CO (719) 465-2145

GUNTZELMAN PORCELAIN PINES

PRELIMINARY DOCUMENTS NOT FOR CONSTRUCTION

EL PASO COUNTY, COLORADO

REVISION DATE	000000	REVISION DESCRIPTION	(DESCRIPTION)
REVISION DATE		REVISION DESCRIPTION	
REVISION DATE		REVISION DESCRIPTION	
NORTH			
SCALE: NOT TO SCALE			
PROJECT #: 2107-0307			
CHECKED BY: BML			
DRAWN BY: JAM			
DATE: 02/15/2023			
SHEET #			
5			
TOTAL SHEETS 5			

GRADING & EROSION CONTROL DETAILS