


SFD19533  
 PLAT 11176  
 PUD  
 ADU1931 MOTHER IN LAW  
 IN THE BASEMENT

**DISAPPROVED**  
**Plan Review**


05/03/2019 2:26:44 PM  
 dsdarchuleta

EPC Planning & Community  
 Development Department

- (1) MISSING ACC LETTER OF APPROVAL
- (2) MISSING MOTHER-IN-LAW AFFIDAVIT
- (3) MUST IDENTIFY MOTHER-IN-LAW APARTMENT ON PLANS  
 (ADD STOVE TO PLAN)

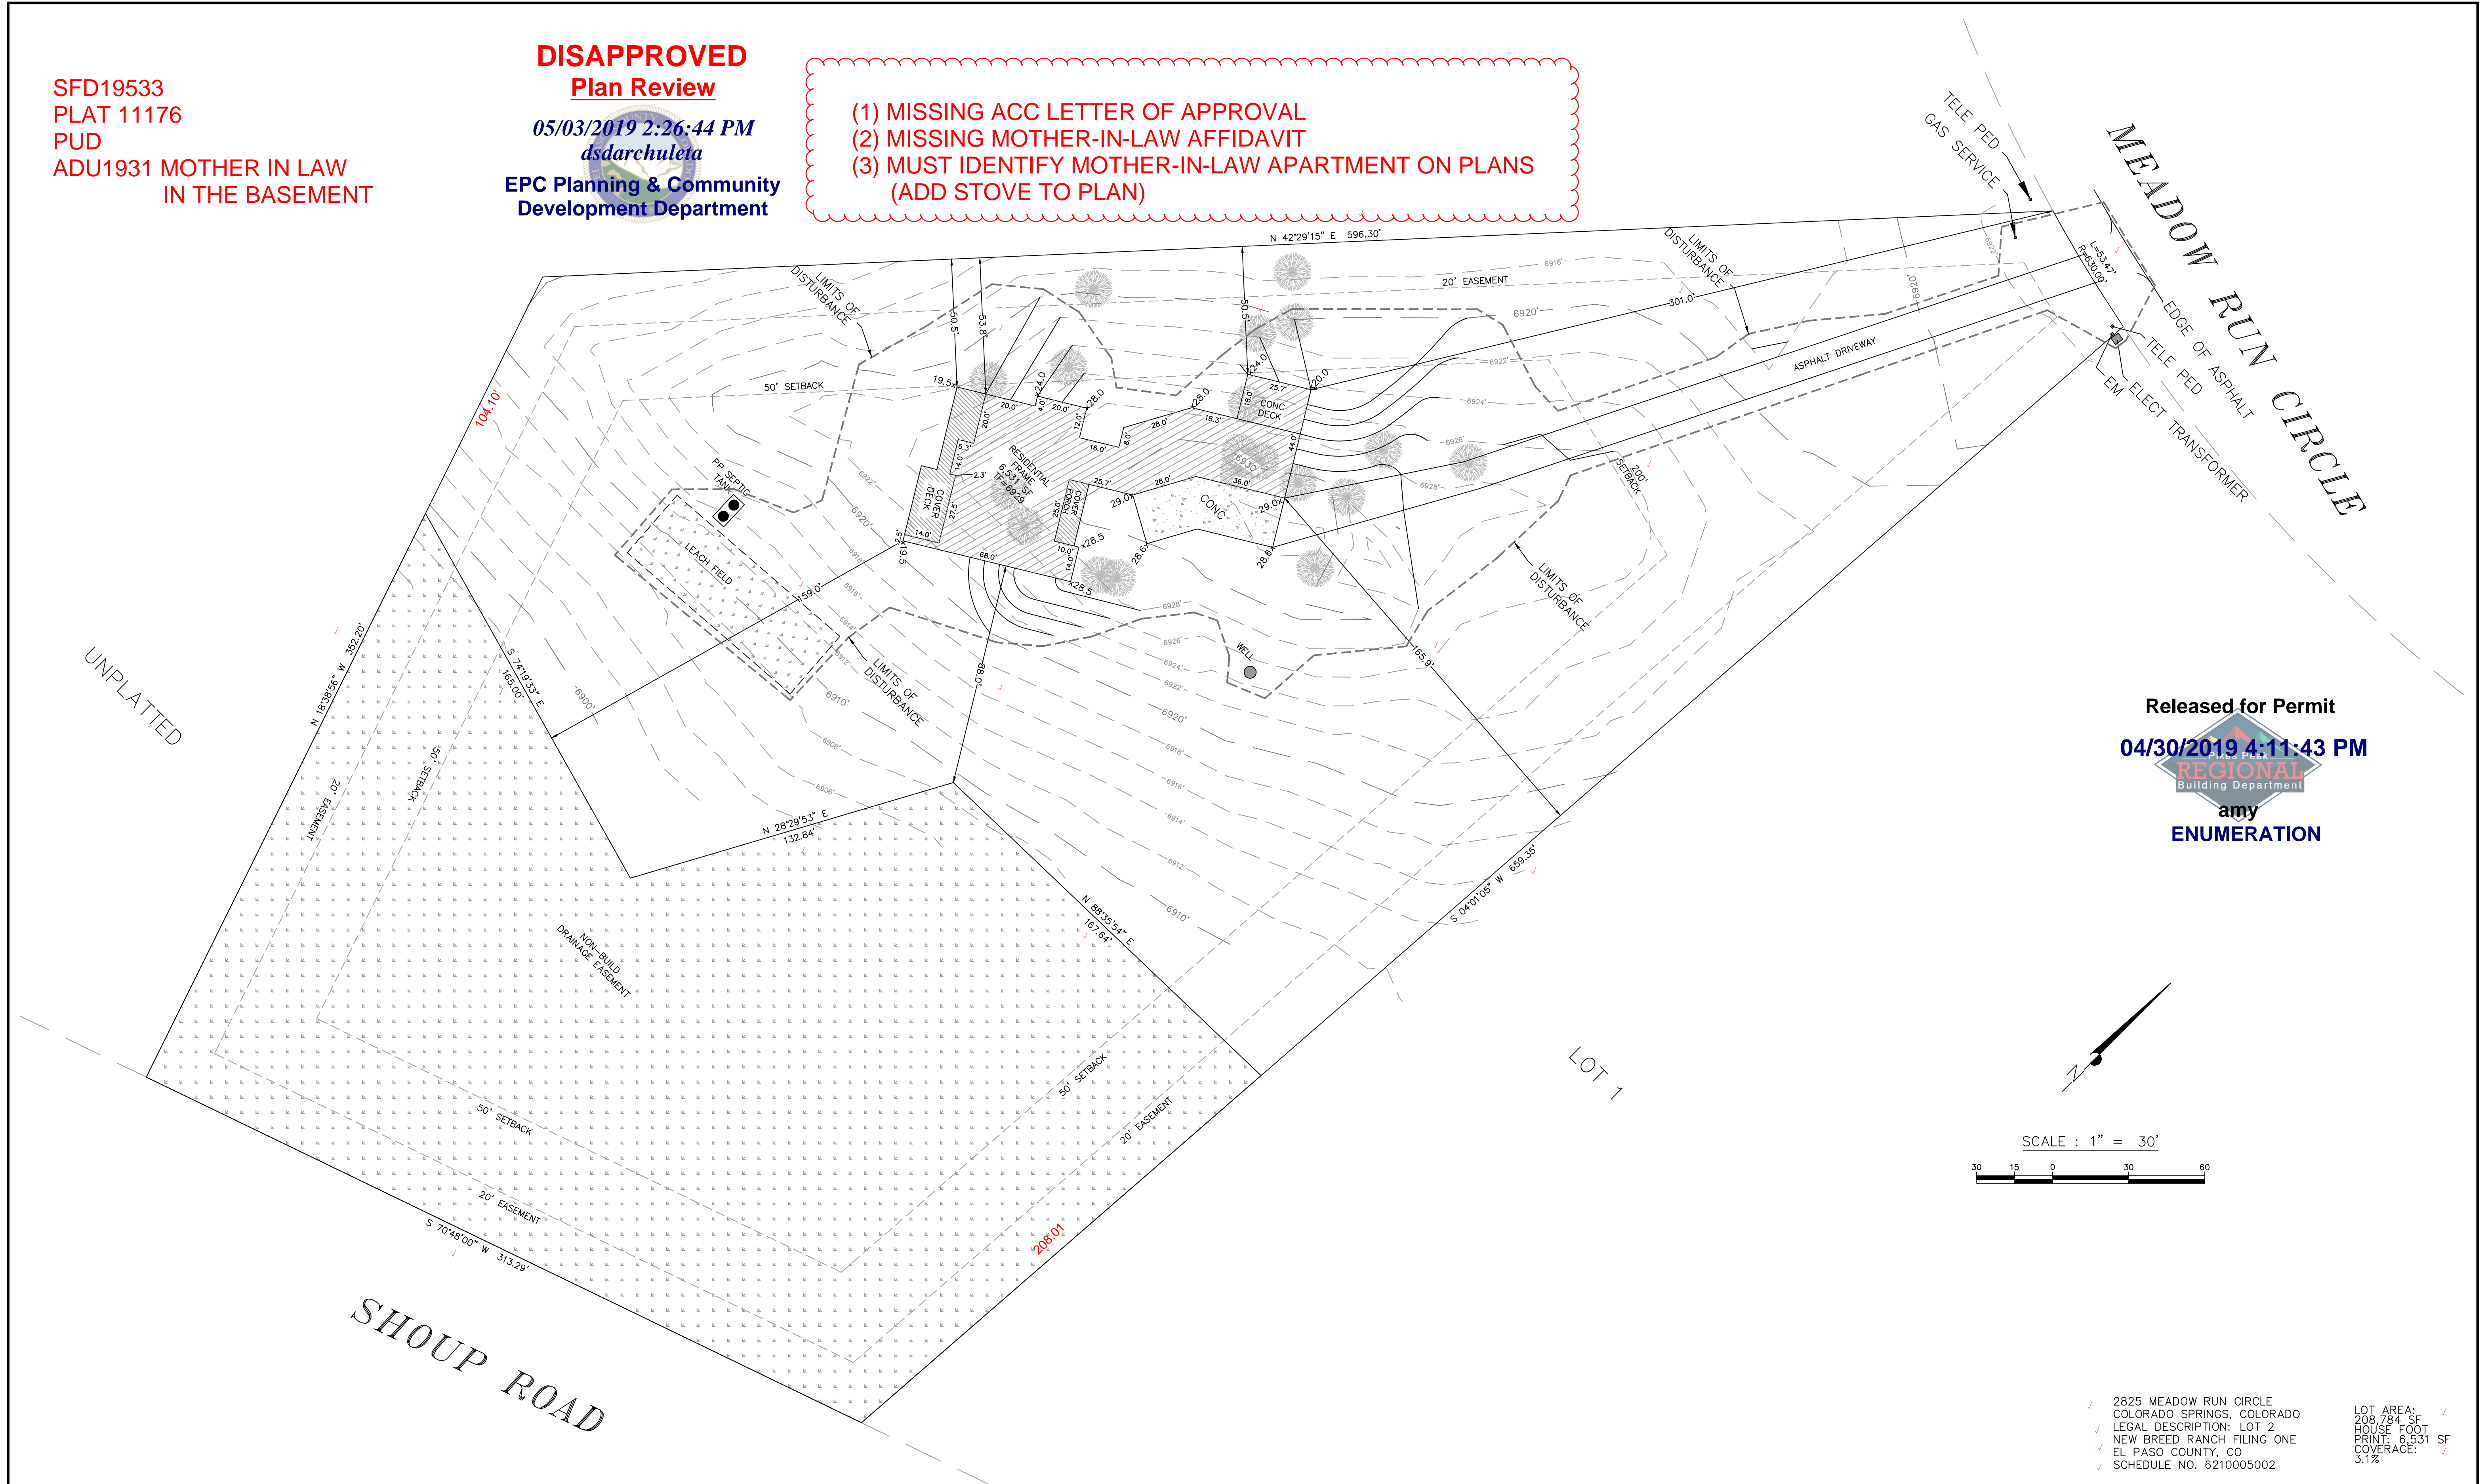

Released for Permit  
 04/30/2019 4:11:43 PM  
 REGIONAL Building Department  
 amy  
 ENUMERATION

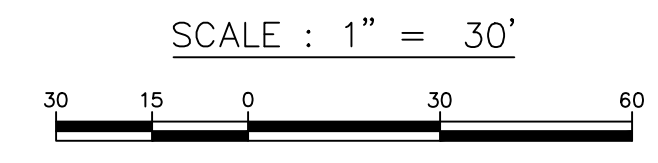


2825 MEADOW RUN CIRCLE  
 COLORADO SPRINGS, COLORADO  
 LEGAL DESCRIPTION: LOT 2  
 NEW BREED RANCH FILING ONE  
 EL PASO COUNTY, CO  
 SCHEDULE NO. 6210005002

LOT AREA: 208,784 SF  
 HOUSE FOOT PRINT: 6,531 SF  
 COVERAGE: 3.1%

REGISTERED LAND SURVEYOR IN THE STATE OF COLORADO, NO 27605 FOR AND ON BEHALF OF POLARIS SURVEYING, INC. NOTICE: ACCORDING TO COLORADO LAW, YOU MUST COMMENCE ANY LEGAL ACTION BASED UPON ANY DEFECT IN THIS SURVEY WITHIN THREE YEARS AFTER YOU FIRST DISCOVER SUCH DEFECT. IN NO EVENT, MAY ANY ACTION BASED UPON ANY DEFECT IN THIS SURVEY BE COMMENCED MORE THAN TEN YEARS FROM THE DATE OF CERTIFICATION SHOWN HEREON.

BYERLY RESIDENCE

PALMER RIDGE CONST.  
 PHONE: 720/368-0824

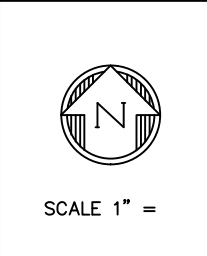

REVISIONS					
ZONE	REV	DESCRIPTION	DATE	APPROVED	

DRAWN BY:  
 CHECKED BY:  
 JOB NO:

DATE:  
 DRAWING NO:  
 SHEET:

POLARIS SURVEYING, INC.  
 1903 Lelary Street, Suite 102  
 COLORADO SPRINGS, CO 80909  
 (719)448-0844 FAX (719)448-9225

For: