

# EAGLE RISING FILING NO. 1

A PORTION OF THE EAST HALF (E1/2) OF SECTION 29, TOWNSHIP 12 SOUTH, RANGE 65 WEST OF THE SIXTH PRINCIPAL MERIDIAN, EL PASO COUNTY, COLORADO

Add missing note per V3 comment:  
This property is subject to a Stormwater Facility Maintenance Agreement and easement as recorded at Reception No. \_\_\_\_\_ of the records of El Paso County. The Eagle Rising Owners Association is responsible for maintenance of the subject drainage facilities.

## KNOW ALL MEN BY THESE PRESENTS:

THAT CASAS LIMITED PARTNERSHIP #4, A COLORADO LIMITED PARTNERSHIP, BEING THE OWNER OF THE FOLLOWING DESCRIBED TRACT OF LAND:

## LEGAL DESCRIPTION:

A PARCEL OF LAND IN THE SOUTHWEST QUARTER OF THE NORTHEAST QUARTER (SW1/4 NE1/4) AND THE NORTHWEST QUARTER OF THE SOUTHWEST QUARTER (NW1/4, SE1/4) SECTION 29, T12S, R65W, OF THE 6th P.M., EL PASO COUNTY, COLORADO, BEING MORE PARTICULARLY DESCRIBED AS FOLLOWS:

BEGINNING AT THE SOUTHEAST CORNER OF THAT PARCEL DESCRIBED BY WARRANTY DEED RECORDED UNDER RECEPTION NO. 216091687 OF THE RECORDS OF EL PASO COUNTY, COLORADO;  
THENCE N00°24'08"W ALONG THE EAST LINE THEREOF, 1,324.07 FEET TO THE SOUTH LINE OF "PARK FOREST ESTATES FILING NO. 2" AS RECORDED IN BOOK B-2 AT PAGE 52 OF THE RECORDS OF EL PASO COUNTY, COLORADO;  
THENCE N89°11'11"E ALONG THE SOUTH LINE THEREOF, 405.98 FEET;  
THENCE S00°51'58"E A DISTANCE OF 128.76 FEET;  
THENCE S34°53'38"E A DISTANCE OF 165.41 FEET;  
THENCE S37°00'44"E A DISTANCE OF 37.27 FEET;  
THENCE S41°23'30"E A DISTANCE OF 32.71 FEET;  
THENCE S42°49'51"E A DISTANCE OF 258.35 FEET;  
THENCE S45°49'45"W A DISTANCE OF 314.01 FEET;  
THENCE S43°27'20"E A DISTANCE OF 540.81 FEET;  
THENCE S43°02'35"E A DISTANCE OF 499.61 FEET;  
THENCE S33°35'45"W A DISTANCE OF 165.64 FEET;  
THENCE N61°55'48"W A DISTANCE OF 467.41 FEET;  
THENCE S50°31'31"W A DISTANCE OF 334.09 FEET;  
THENCE S34.73 FEET ON THE ARC OF A NON-TANGENT CURVE TO THE RIGHT, SAID CURVE HAVING A RADIUS OF 405.00 FEET, A CENTRAL ANGLE OF 472°11'17" THE CHORD OF 325.28 FEET WHICH BEARS S07°07'31"W;  
THENCE S56°24'15"E, NON-TANGENT TO THE PREVIOUS COURSE, 474.06 FEET;  
THENCE S83°20'23"W A DISTANCE OF 384.26 FEET;  
THENCE S07°08'16"E A DISTANCE OF 325.86 FEET;  
THENCE N72°20'57"W A DISTANCE OF 437.27 FEET;  
THENCE N00°23'34"W A DISTANCE OF 298.01 FEET;  
THENCE 19.87 FEET ON THE ARC OF A NON-TANGENT CURVE TO THE LEFT, SAID CURVE HAVING A RADIUS OF 100.55 FEET, A CENTRAL ANGLE OF 11°19'26" THE CHORD OF 19.84 FEET WHICH BEARS N84°30'00"W TO A POINT OF TANGENT;  
THENCE S89°15'17"W A DISTANCE OF 8.18 FEET TO THE EAST LINE OF "EAGLE WING ESTATES" AS RECORDED UNDER RECEPTION NO. 204074316 OF THE RECORDS OF EL PASO COUNTY, COLORADO;  
THENCE N00°23'00"W ALONG SAID EAST LINE, 805.83 FEET TO THE POINT OF BEGINNING.

SAID PARCEL CONTAINS A CALCULATED AREA OF 1,536,904 SQUARE FEET (35.282 ACRES, MORE OR LESS).

## BASIS OF BEARINGS:

A PORTION OF THE NORTH-SOUTH CENTERLINE OF SECTION 29, T12S, R65W, 6TH P.M., EL PASO COUNTY, COLORADO, BEING MONUMENTED AT THE SOUTH 1/16TH QUARTER WITH A FOUND 2 1/2" ALUMINUM CAP STAMPED "S1/16 S29 - 1997 - PLS 4842" FROM WHICH THE NORTH 1/16TH QUARTER, MONUMENTED WITH A 2 1/2" ALUMINUM CAP STAMPED "RAMPART SURVEY, INC - N1/16 SEC. 29 - 2005 - PLS 26965", BEARS N00°23'34"W A DISTANCE OF 2,647.80 FEET.  
ALL BEARINGS ARE GRID BEARINGS OF THE COLORADO STATE PLANE COORDINATE SYSTEM, CENTRAL ZONE, NORTH AMERICAN DATUM 1983, BASED ON SIMULTANEOUS STATIC GLOBAL POSITIONING SYSTEM (GPS) OBSERVATIONS OF THE MONUMENTS AT THE ENDS OF THE BASIS OF BEARINGS LINE.  
DATE OF OBSERVATIONS: DECEMBER 12, 2022. LENGTH OF OBSERVATIONS: 1 HOUR 42 MINUTES.

## ACCEPTANCE CERTIFICATE FOR TRACTS A & B:

### EAGLE RISING OWNERS ASSOCIATION

THE DEDICATION OF TRACT A FOR THE PURPOSES SPECIFIED IN PLAT NOTE 27 IS HEREBY ACCEPTED FOR OWNERSHIP AND MAINTENANCE BY THE EAGLE RISING OWNERS ASSOCIATION.

THE DEDICATION OF TRACT B FOR THE PURPOSES SPECIFIED IN PLAT NOTE 28 IS HEREBY ACCEPTED FOR MAINTENANCE BY THE EAGLE RISING OWNERS ASSOCIATION. APPROVAL IS GRANTED FOR THIS PLAT OF "EAGLE RISING FILING NO. 1".

BY: STEPHEN J. JACOBS, JR, AS PRESIDENT, EAGLE RISING OWNERS ASSOCIATION


STATE OF COLORADO }  
COUNTY OF EL PASO } ss

ACKNOWLEDGED BEFORE ME THIS \_\_\_\_\_ DAY OF \_\_\_\_\_, 2023, A.D. BY STEPHEN J. JACOBS, JR, AS PRESIDENT, EAGLE RISING OWNERS ASSOCIATION

WITNESS BY HAND AND OFFICIAL SEAL:

MY COMMISSION EXPIRES: \_\_\_\_\_

NOTARY PUBLIC: \_\_\_\_\_

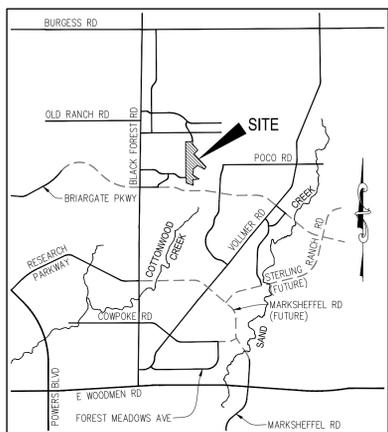

VICINITY MAP  
N.T.S.

## OWNERS CERTIFICATE/DEDICATION STATEMENT:

THE UNDERSIGNED, BEING ALL THE OWNERS, MORTGAGEES, BENEFICIARIES OF DEEDS OF TRUST AND HOLDERS OF OTHER INTERESTS IN THE LAND DESCRIBED HEREIN, HAVE LAID OUT, SUBDIVIDED, AND PLATTED SAID LANDS INTO LOTS, TRACTS, STREETS, AND EASEMENTS AS SHOWN HEREON UNDER THE NAME AND SUBDIVISION OF "EAGLE RISING FILING NO. 1". ALL PUBLIC IMPROVEMENTS SO PLATTED ARE HEREBY DEDICATED TO PUBLIC USE AND SAID OWNER DOES HEREBY COVENANT AND AGREE THAT THE PUBLIC IMPROVEMENTS WILL BE CONSTRUCTED TO EL PASO COUNTY STANDARDS AND THAT PROPER DRAINAGE AND EROSION CONTROL FOR SAME WILL BE PROVIDED AT SAID OWNER'S EXPENSE, ALL TO THE SATISFACTION OF THE BOARD OF COUNTY COMMISSIONERS OF EL PASO COUNTY, COLORADO. UPON ACCEPTANCE BY RESOLUTION, ALL PUBLIC IMPROVEMENTS SO DEDICATED WILL BECOME MATTERS OF MAINTENANCE BY EL PASO COUNTY, COLORADO. THE UTILITY EASEMENTS SHOWN HEREON ARE HEREBY DEDICATED FOR PUBLIC UTILITIES AND COMMUNICATION SYSTEMS AND OTHER PURPOSES AS SHOWN HEREON. THE ENTITIES RESPONSIBLE FOR PROVIDING THE SERVICES FOR WHICH THE EASEMENTS ARE ESTABLISHED ARE HEREBY GRANTED THE PERPETUAL RIGHT OF INGRESS AND EGRESS FROM AND TO ADJACENT PROPERTIES FOR INSTALLATION, MAINTENANCE AND REPLACEMENT OF UTILITY LINES AND RELATED FACILITIES.

THE AFOREMENTIONED CASAS LIMITED PARTNERSHIP #4, A COLORADO LIMITED PARTNERSHIP, HAS EXECUTED THIS INSTRUMENT THIS \_\_\_\_\_ DAY OF \_\_\_\_\_, 2023, A.D.

BY: \_\_\_\_\_

STEPHEN J. JACOBS, JR, AS GENERAL PARTNER, CASAS LIMITED PARTNERSHIP #4, A COLORADO LIMITED PARTNERSHIP

STATE OF COLORADO }  
COUNTY OF EL PASO } ss

THE FOREGOING INSTRUMENT WAS ACKNOWLEDGED BEFORE ME THIS THIS \_\_\_\_\_ DAY OF \_\_\_\_\_, 2023, A.D. BY STEPHEN J. JACOBS, JR, AS GENERAL PARTNER, CASAS LIMITED PARTNERSHIP #4, A COLORADO LIMITED PARTNERSHIP

WITNESS BY HAND AND OFFICIAL SEAL:

MY COMMISSION EXPIRES: \_\_\_\_\_

NOTARY PUBLIC: \_\_\_\_\_

## ACCEPTANCE CERTIFICATE FOR TRACT B:

### MYPAD INC., A COLORADO CORPORATION

THE DEDICATION OF TRACT B FOR THE PURPOSES SPECIFIED IN PLAT NOTE 28 IS HEREBY ACCEPTED FOR OWNERSHIP BY MYPAD INC., AND MAINTENANCE BY THE EAGLE RISING OWNERS ASSOCIATION. APPROVAL IS GRANTED FOR THIS PLAT OF "EAGLE RISING FILING NO. 1".

BY: STEPHEN J. JACOBS, JR, AS PRESIDENT, MYPAD INC., A COLORADO CORPORATION

STATE OF COLORADO }  
COUNTY OF EL PASO } ss

ACKNOWLEDGED BEFORE ME THIS \_\_\_\_\_ DAY OF \_\_\_\_\_, 2023, A.D. BY STEPHEN J. JACOBS, JR, AS PRESIDENT, MYPAD INC., A COLORADO CORPORATION

WITNESS BY HAND AND OFFICIAL SEAL:

MY COMMISSION EXPIRES: \_\_\_\_\_

NOTARY PUBLIC: \_\_\_\_\_

## GENERAL PLAT NOTES:

- THE PROPERTY LIES WITHIN ZONE X, AREA OF MINIMAL FLOOD HAZARD (FIRM PANEL NO. 08041C0527G, EFFECTIVE DATE DECEMBER 7, 2018.) DRAINAGE CONCERNS WERE IDENTIFIED IN THE MASTER DEVELOPMENT DRAINAGE PLAN/PRELIMINARY DRAINAGE REPORT BY MONUMENT VALLEY ENGINEERS, INC., DATED NOVEMBER 17, 2023. SAID STUDY FOUND THAT 100 YEAR WATER SURFACE ELEVATIONS EXTEND INTO SOME OF THE LOTS PLATTED HEREBY. FOR LOTS AFFECTED BY THE STUDIED FLOODPLAIN AREA ALL STRUCTURES SHALL BE AT LEAST 2 FEET ABOVE THE BASE FLOODPLAIN ELEVATION.
- THIS PLAT DOES NOT CONSTITUTE A TITLE SEARCH BY M&S CIVIL CONSULTANTS, INC FOR EITHER OWNERSHIP OR EASEMENTS OF RECORD. FOR THE EASEMENTS OF RECORD SHOWN HEREON, M&S CIVIL CONSULTANTS RELIED ON A COMMITMENT FOR TITLE INSURANCE ISSUED BY LEGACY TITLE GROUP AS AGENT FOR STEWART TITLE COMPANY WITH AN EFFECTIVE DATE OF JUNE 14, 2022 AT 8:00 A.M., COMMITMENT NO. 1705644, REVISION NUMBER C2.
- UNLESS SHOWN OTHERWISE, ALL SIDE LOT LINES ARE HEREBY PLATTED WITH A TEN (10) FOOT WIDE PUBLIC UTILITY AND DRAINAGE EASEMENT. ALL FRONT LOT LINES WITH A FIFTEEN (15) FOOT WIDE PUBLIC IMPROVEMENT AND DRAINAGE EASEMENT, REAR LOT LINES ARE HEREBY PLATTED WITH A TEN (10) FOOT WIDE PUBLIC UTILITY AND DRAINAGE EASEMENT. LOTS 1, 2, 3, 4, 5, 9, AND 10 ARE PLATTED WITH A THIRTY (30') WIDE PUBLIC UTILITY AND DRAINAGE EASEMENT (AS SHOWN ON SHEET 2). THE RESPONSIBILITY FOR MAINTENANCE OF THESE EASEMENTS IS HEREBY VESTED WITH THE INDIVIDUAL PROPERTY OWNER.
- MAILBOXES SHALL BE INSTALLED IN ACCORDANCE WITH EL PASO COUNTY DEPARTMENT OF TRANSPORTATION AND UNITED STATES POSTAL SERVICES REGULATIONS.
- WASTE WATER TREATMENT WILL BE PROVIDED VIA INDIVIDUAL ON-SITE SEPTIC SYSTEMS, DESIGNED, PERMITTED, CONSTRUCTED AND OPERATED PER THE EL PASO COUNTY PUBLIC HEALTH DEPARTMENT AND THE COLORADO STATE HEALTH DEPARTMENT'S CODES AND REGULATIONS. SEWAGE TREATMENT IS THE RESPONSIBILITY OF EACH INDIVIDUAL PROPERTY OWNER. THE EL PASO COUNTY DEPARTMENT OF HEALTH AND ENVIRONMENT MAY REQUIRE AN ENGINEER DESIGNED SYSTEM PRIOR TO PERMIT APPROVAL. THESE SYSTEMS MAY COST MORE TO DESIGN, INSTALL, AND MAINTAIN.
- WATER SERVICES FOR ALL LOTS AND THE FIVE (5) EXISTING FIRE HYDRANTS IS PROVIDED BY THE PARK FOREST WATER DISTRICT, SUBJECT TO THE DISTRICT'S RULES, REGULATIONS AND SPECIFICATIONS.
- INDIVIDUAL LOT OWNERS ACKNOWLEDGE ACCEPTANCE OF OFF-SITE HISTORIC STORMWATER FLOWS AND EAGLE RISING NO. 1 DEVELOPED FLOWS. PROPERTY OWNERS ARE RESPONSIBLE FOR MAINTAINING PROPER STORM WATER DRAINAGE IN AND THROUGH THEIR PROPERTY. PUBLIC EASEMENTS AS SPECIFICALLY NOTED ON THE PLAT SHALL BE MAINTAINED BY THE INDIVIDUAL LOT OWNERS UNLESS OTHERWISE INDICATED. ALL PROPERTY OWNERS SHALL MAINTAIN THE PORTION OF DRAINAGE EASEMENTS WITH THEIR PROPERTIES. STRUCTURES, FENCES, MATERIALS, OR LANDSCAPING THAT COULD IMPEDE THE FLOW OF RUNOFF SHALL NOT BE PLACED IN DRAINAGE EASEMENTS. NO STRUCTURE OR FENCES ARE PERMITTED WITHIN THE AREAS DESIGNATED "FLOODPLAIN" OR "NO-BUILD".
- THE ADDRESSES EXHIBITED ON THIS PLAT ARE FOR INFORMATIONAL PURPOSES ONLY. THEY ARE NOT THE LEGAL DESCRIPTION AND ARE SUBJECT TO CHANGE.
- ELECTRIC SERVICE PROVIDED BY MOUNTAIN VIEW ELECTRIC.
- NATURAL GAS SERVICE PROVIDED BY BLACK HILLS ENERGY.
- FIBER-OPTIC TELECOM SERVICE PROVIDED BY CENTURY LINK.
- THE DEVELOPER SHALL COMPLY WITH FEDERAL AND STATE LAWS, REGULATIONS ORDINANCES, REVIEW AND PERMIT REQUIREMENTS, AND OTHER AGENCY REQUIREMENTS, IF ANY, OF APPLICABLE AGENCIES INCLUDING, BUT NOT LIMITED TO, THE COLORADO DEPARTMENT OF PARKS AND WILDLIFE, COLORADO DEPARTMENT OF TRANSPORTATION, U.S. ARMY CORP. OF ENGINEERS, THE U.S. FISH AND WILDLIFE SERVICE AND/OR COLORADO DEPARTMENT OF STATE PARKS AND WILDLIFE REGARDING THE ENDANGERED SPECIES ACT, PARTICULARLY AS IT RELATES TO THE PREBLE'S MEADOW JUMPING MOUSE AS A LISTED THREATENED SPECIES.
- NO LOT, OR INTEREST THEREIN, SHALL BE SOLD, CONVEYED, OR TRANSFERRED WHETHER BY DEED OR BY CONTRACT, NOR SHALL BUILDING PERMITS BE ISSUED, UNTIL AND UNLESS EITHER THE REQUIRED PUBLIC IMPROVEMENTS HAVE BEEN CONSTRUCTED AND COMPLETED AND PRELIMINARILY ACCEPTED IN ACCORDANCE WITH THE SUBDIVISION IMPROVEMENTS AGREEMENT BETWEEN THE APPLICANT/OWNER AND EL PASO COUNTY AS RECORDED UNDER RECEPTION NUMBER \_\_\_\_\_ IN THE OFFICE OF THE CLERK AND RECORDER OF EL PASO COUNTY, COLORADO OR, IN THE ALTERNATIVE, OTHER COLLATERAL IS PROVIDED TO MAKE PROVISION FOR THE COMPLETION OF SAID IMPROVEMENTS IN ACCORDANCE WITH THE EL PASO COUNTY LAND DEVELOPMENT CODE AND ENGINEERING CRITERIA MANUAL. ANY SUCH ALTERNATIVE COLLATERAL MUST BE APPROVED BY THE BOARD OF COUNTY COMMISSIONERS OR, IF PERMITTED BY THE SUBDIVISION IMPROVEMENTS AGREEMENT, BY THE PLANNING AND COMMUNITY DEVELOPMENT DEPARTMENT DIRECTOR AND MEET THE POLICY AND PROCEDURE REQUIREMENTS OF EL PASO COUNTY PRIOR TO THE RELEASE BY THE COUNTY OF ANY LOTS FOR SALE, CONVEYANCE OR TRANSFER. THIS PLAT RESTRICTION MAY BE REMOVED OR RESCINDED BY THE BOARD OF COUNTY COMMISSIONERS OR, IF PERMITTED BY THE SUBDIVISION IMPROVEMENTS AGREEMENT, BY THE PLANNING AND COMMUNITY DEVELOPMENT DEPARTMENT DIRECTOR UPON EITHER APPROVAL OF AN ALTERNATIVE FORM OF COLLATERAL OR COMPLETION AND PRELIMINARY ACCEPTANCE BY THE EL PASO BOARD OF COUNTY COMMISSIONERS OF ALL IMPROVEMENTS REQUIRED TO BE CONSTRUCTED AND COMPLETED IN ACCORDANCE WITH SAID SUBDIVISION IMPROVEMENTS AGREEMENT. THE PARTIAL RELEASE OF LOTS FOR SALE, CONVEYANCE OR TRANSFER MAY ONLY BE GRANTED IN ACCORDANCE WITH ANY PLANNED PARTIAL RELEASE OF LOTS AUTHORIZED BY THE SUBDIVISION IMPROVEMENTS AGREEMENT.

Add note if individual lot owners will be responsible for culvert construction and driveway grading:  
Lots 3, 4, 5, 6, and 7 require engineered site plans for installation of culverts, grading, and easements as applicable.

- PROPERTY IS SUBJECT TO THE TERMS, CONDITIONS, PROVISIONS, AGREEMENTS AND OBLIGATIONS CONTAINED IN RESOLUTION NO. 20-043 OF THE BOARD OF COUNTY COMMISSIONERS, AS RECORDED AT REC. NO. 220200116 OF THE EL PASO COUNTY RECORDS.
- THE FOLLOWING REPORTS HAVE BEEN SUBMITTED IN ASSOCIATION WITH THE PRELIMINARY PLAN/FINAL PLAT FOR THIS SUBDIVISION AND ARE ON FILE AT THE COUNTY PLANNING AND COMMUNITY DEVELOPMENT DEPARTMENT: TRANSPORTATION IMPACT STUDY; DRAINAGE REPORT; WATER RESOURCES REPORT; WASTEWATER DISPOSAL REPORT; GEOLOGY AND SOILS REPORT; FIRE PROTECTION AND WILDFIRE MITIGATION PLAN; NATURAL FEATURES REPORT.
- NEW DRIVEWAYS LOCATIONS WILL REQUIRE BLACK FOREST FIRE PROTECTION DISTRICT APPROVAL. NO NEW DRIVEWAY ONTO AN EL PASO COUNTY ROAD SHALL BE ESTABLISHED UNLESS AN ACCESS PERMIT HAS BEEN GRANTED BY EL PASO COUNTY. APPROVED DRIVEWAYS CURRENTLY EXIST FOR 10195 KURIE DRIVE AND 7495 EAGLE WING DRIVE.
- THE PROPERTY OWNERS SHALL BE REQUIRED TO PAY TRAFFIC IMPACT FEES IN ACCORDANCE WITH THE EL PASO COUNTY ROAD IMPACT FEE PROGRAM RESOLUTION (RESOLUTION NO. 19-471), OR ANY AMENDMENTS HERETO, AT OR PRIOR TO THE TIME OF BUILDING PERMIT SUBMITTAL, THE FEE OBLIGATION, IF NOT PAID AT TIME OF FINAL PLAT RECORDING SHALL BE DOCUMENTED ON ALL SALES DOCUMENTS TO ENSURE THAT A TITLE SEARCH WOULD FIND THE FEE OBLIGATION BEFORE THE SALE OF THE PROPERTY.
- LOT OWNERS ARE ADVISED THAT SEVERAL AREAS ON THIS FILING CONTAIN GEOLOGIC HAZARDS INCLUDING STANDING WATER, WET AREAS, SEASONALLY HIGH WATER AND WET AREAS, AND POTENTIALLY UNSTABLE SLOPES. LOCATION OF THESE CONSTRAINTS ARE REFERENCED IN THE ENTECH ENGINEERING REPORT NO. 221458, DATED JANUARY 25, 2023. LOT OWNERS AND HOMEBUILDERS SHOULD CONSULT THIS REPORT, WHICH IS ON FILE AT THE EL PASO COUNTY PLANNING AND COMMUNITY DEVELOPMENT DEPARTMENT AND ONLINE VIA EDARP.
  - "NO BUILD LINES" ON LOTS 6, 7, 8, AND 9.
  - PONDED WATER ON LOTS 3, 4, 5, AND 6.
  - POTENTIALLY UNSTABLE SLOPE ON LOT 4 UNTIL MITIGATED.
  - SEASONAL SHALLOW GROUND WATER IN DRAINAGE EASEMENTS ON LOTS 1, 7, 8, AND 10.
  - SHALLOW BEDROCK MAY REQUIRE ENGINEERED SEPTIC SYSTEMS ON PORTIONS OF LOTS 3, 5, AND 9.
  - SEPTIC SYSTEMS ARE NOT RECOMMENDED ON PORTIONS OF LOTS 3, 6, 7, AND 8.
- EXISTING CORRAL FENCE CROSSES LOT LINES ON LOTS 3 AND 4.
- EXISTING HOUSE AT 7495 EAGLE WING DRIVE, INDOOR ARENA, STABLE, EQUIPMENT SHOP, CONTAINERS, AND BARN ON LOT 6 EXCEEDS CURRENT BUILDING SIZE REQUIREMENTS AND 10% IMPERVIOUS SURFACE AREA OF LOT AND ARE ALLOWED BY EL PASO COUNTY AND EAGLE RISING OWNERS ASSOCIATION.
- LOT 7 REQUIRES BUILDING PERMIT FOR MAIN HOUSE PRIOR TO APPLYING FOR ADDITIONAL BUILDING PERMITS. EXISTING GARAGE, CHICKEN FACILITY, TOOL CONTAINER, FENCE, AND GREENHOUSE ARE ALLOWED BY EL PASO COUNTY AND EAGLE RISING OWNERS ASSOCIATION. LOT 10 EXISTING HOUSE AT 10195 KURIE RD., DETACHED GARAGE AND DRIVEWAY ACCESS TO KURIE ROAD ARE ALLOWED BY EL PASO COUNTY AND EAGLE RISING OWNERS ASSOCIATION.
- THE ARTICLES OF INCORPORATION FOR THE EAGLE RISING OWNERS ASSOCIATION DOCUMENTS ARE FILED UNDER INSTRUMENT NO. 20181706832 OF THE OFFICE OF SECRETARY OF STATE.
- COVENANTS AFFECTING THIS SUBDIVISION SHOULD BE READ BY LOT OWNERS. DECLARATION OF COVENANTS, CONDITIONS, AND RESTRICTIONS (CCRS) IS RECORDED AT RECEPTION NO. \_\_\_\_\_ OF THE RECORDS OF EL PASO COUNTY.
- TRACT A (EAGLE WING VIEW, PRIVATE ROAD) SHALL BE OWNED AND MAINTAINED BY THE EAGLE RISING OWNERS ASSOCIATION, THEREFORE EL PASO COUNTY SHALL NOT BEAR ANY RESPONSIBILITY OF THE MAINTENANCE OF THIS PRIVATE TRACT. TRACT IS MORE OR LESS COINCIDENTAL WITH THE ACCESS EASEMENT GRANTED IN PERMANENT EASEMENT AGREEMENT RECORDED UNDER RECEPTION NO. 220120887 OF THE EL PASO COUNTY RECORDS. TRACT A WILL NOT BE MAINTAINED BY EL PASO COUNTY.
- TRACT B LAND AND WELL SHALL BE OWNED BY MYPAD, INC., AND OR ASSIGNS. THE EXISTING WELL ON TRACT B SHALL BE EQUIPPED, OPERATED, MAINTAINED, AND REPLACED BY THE EAGLE RISING OWNERS ASSOCIATION IN ACCORDANCE WITH INCLUSION AGREEMENT RECORDED OCTOBER 4, 2013 UNDER RECEPTION NO. 213125555 AND RE-RECORDED SEPTEMBER 16, 2014 UNDER RECEPTION NO. 214084282, AND DISTRICT COURT WATER DIVISION No. 2, COLORADO CASE NUMBER 2014CW3010 RECORDED NOVEMBER 13, 2015 UNDER RECEPTION NO. 215123578 OBLIGATE PARK FOREST WATER DISTRICT TO PROVIDE THE WATER SUPPLY FOR "STOCK WATERING, COMMON AREA LANDSCAPE IRRIGATION, HOBBY USE AND IRRIGATION OF COMMUNITY GARDENS". ACCESS GRANTED TO MYPAD, INC. AND THE EAGLE RISING OWNERS ASSOCIATION WILL BE GRANTED BY IQ INVESTORS, LLC BY SEPARATE EASEMENT AGREEMENT.
- PER FINAL DRAINAGE REPORT: EAGLE RISING FILING NO. 1, IF TOTAL LOT IMPERVIOUS AREA EXCEEDS 10 PERCENT, INDIVIDUAL LOT SITE PLAN MUST BE ENGINEERED TO MEET WATER QUALITY REQUIREMENTS.

## SURVEYORS CERTIFICATE

I VERNON P. TAYLOR, A DULY REGISTERED PROFESSIONAL LAND SURVEYOR IN THE STATE OF COLORADO, DO HEREBY CERTIFY THAT THIS PLAT TRULY AND CORRECTLY REPRESENTS THE RESULTS OF A SURVEY MADE ON DATE OF SURVEY, BY ME OR UNDER MY DIRECT SUPERVISION AND THAT ALL MONUMENTS EXIST AS SHOWN HEREON; THAT MATHEMATICAL CLOSURE ERRORS ARE LESS THAN 1:10,000; AND THAT SAID PLAT HAS BEEN PREPARED IN FULL COMPLIANCE WITH ALL APPLICABLE LAWS OF THE STATE OF COLORADO DEALING WITH MONUMENTS, SUBDIVISION, OR SURVEYING OF LAND AND ALL APPLICABLE PROVISIONS OF THE EL PASO COUNTY LAND DEVELOPMENT CODE.

I ATTEST THE ABOVE ON THIS \_\_\_\_\_ DAY OF \_\_\_\_\_, 2023.

Correct note per V2/V3 comment

and will be constructed in accordance with per Land Development Code Sections 6.3.3.C.2 and 6.3.3.C.3.

VERNON P. TAYLOR  
COLORADO PLS NO. 25966,  
FOR AND ON BEHALF OF  
M&S CIVIL CONSULTANTS, INC.

There is no record of driveway permits.

Eagle Wing is the now designated private road 10195 Kurie Drive has no permit on file. Provide permit #s or delete the highlighted portion.

## NOTICE:

ACCORDING TO COLORADO LAW, YOU MUST COMMENCE ANY LEGAL ACTION BASED UPON ANY DEFECT IN THIS SURVEY WITHIN THREE YEARS AFTER YOU FIRST DISCOVER SUCH DEFECT. IN NO EVENT, MAY ANY ACTION BASED UPON ANY DEFECT IN THIS SURVEY BE COMMENCED MORE THAN TEN YEARS FROM THE DATE OF THE CERTIFICATION SHOWN HEREON.

## BOARD OF COUNTY COMMISSIONERS CERTIFICATE:

THIS PLAT FOR "EAGLE RISING FILING NO. 1" WAS APPROVED FOR FILING BY THE EL PASO COUNTY, COLORADO BOARD OF COUNTY COMMISSIONERS ON THE \_\_\_\_\_ DAY OF \_\_\_\_\_, 2023, SUBJECT TO ANY NOTES SPECIFIED HEREON AND ANY CONDITIONS INCLUDED IN THE RESOLUTION OF APPROVAL. THE DEDICATIONS OF LAND TO THE PUBLIC FOR STREETS AND EASEMENTS ARE ACCEPTED, BUT PUBLIC IMPROVEMENTS THEREON WILL NOT BECOME THE MAINTENANCE RESPONSIBILITY OF EL PASO COUNTY UNTIL PRELIMINARY ACCEPTANCE OF THE PUBLIC IMPROVEMENTS IN ACCORDANCE WITH THE REQUIREMENTS OF THE LAND DEVELOPMENT CODE AND ENGINEERING CRITERIA MANUAL, AND THE SUBDIVISION IMPROVEMENTS AGREEMENT.

CHAIR, BOARD OF COUNTY COMMISSIONERS \_\_\_\_\_ DATE \_\_\_\_\_

DIRECTOR, PLANNING AND COMMUNITY DEVELOPMENT \_\_\_\_\_ DATE \_\_\_\_\_

## CLERK AND RECORDER:

STATE OF COLORADO )  
COUNTY OF EL PASO ) ss

I HEREBY CERTIFY THAT THIS INSTRUMENT WAS FILED FOR RECORD IN MY OFFICE AT \_\_\_\_\_ O'CLOCK \_\_\_\_\_ M., THIS \_\_\_\_\_ DAY OF \_\_\_\_\_, 2023, A.D., AND DULY RECORDED UNDER RECEPTION NO. \_\_\_\_\_ OF THE RECORDS OF EL PASO COUNTY, COLORADO.

BY: \_\_\_\_\_  
STEVE SCHLEIKER, EL PASO COUNTY CLERK AND RECORDER

Provide the fee values

## FEES:

DRAINAGE FEES: \_\_\_\_\_  
BRIDGE FEES: \_\_\_\_\_  
SCHOOL FEES: \_\_\_\_\_  
PARK FEES: \_\_\_\_\_

\$61,516.11 Cottonwood Creek  
\$4,486.46

## SUMMARY:

	ACRES	PERCENT
10 LOTS	33.623	95.30%
2 TRACTS	1.318	3.73%
RIGHT-OF-WAY	0.341	0.97%
TOTAL	35.282	100.00%


See comment letter for additional comments.




212 N. WAHSATCH AVE., STE 305  
COLORADO SPRINGS, CO 80903  
PHONE: 719.955.5485

**LEGEND:**

- SF SQUARE FEET
- (R) RADIAL BEARING
- (0000) ADDRESS
- Ch CHORD
- ChB CHORD BEARING
- SET No 5 REBAR AND 1.25" ORANGE CAP STAMPED "M&S CIVIL PLS 25966" FLUSH W/ EXISTING GRADE UNLESS NOTED OTHERWISE
- FOUND MONUMENT AS LABELED, FLUSH W/ EXISTING GRADE UNLESS NOTED OTHERWISE
- SUBDIVISION BOUNDARY
- LOT/TRACT LINES
- RIGHT-OF-WAY LINES
- CENTERLINE
- EASEMENT LINES
- NO-BUILD LINES
- EXISTING/ADJACENT SUBDIVISION LINES, PROPERTY LINES, AND RIGHTS-OF-WAY
- EXISTING CENTERLINES
- EXISTING EASEMENT LINES
- SECTION/QUARTER SECTION LINE
- FLDWY FEMA FIRM FLOODWAY
- 7113 FEMA FIRM BASE FLOOD ELEVATION (BFE)
- 100YR STUDIED 100 YEAR WATER SURFACE ELEVATION (MASTER DEVELOPMENT DRAINAGE PLAN/ PRELIMINARY DRAINAGE REPORT - MONUMENT VALLEY ENGINEERS, INC, NOVEMBER 17, 2023)

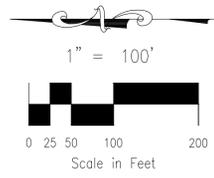

**EAGLE RISING FILING NO. 1**  
A PORTION OF THE EAST HALF (E 1/2) OF SECTION 29, TOWNSHIP 12 SOUTH,  
RANGE 65 WEST OF THE SIXTH PRINCIPAL MERIDIAN, EL PASO COUNTY, COLORADO

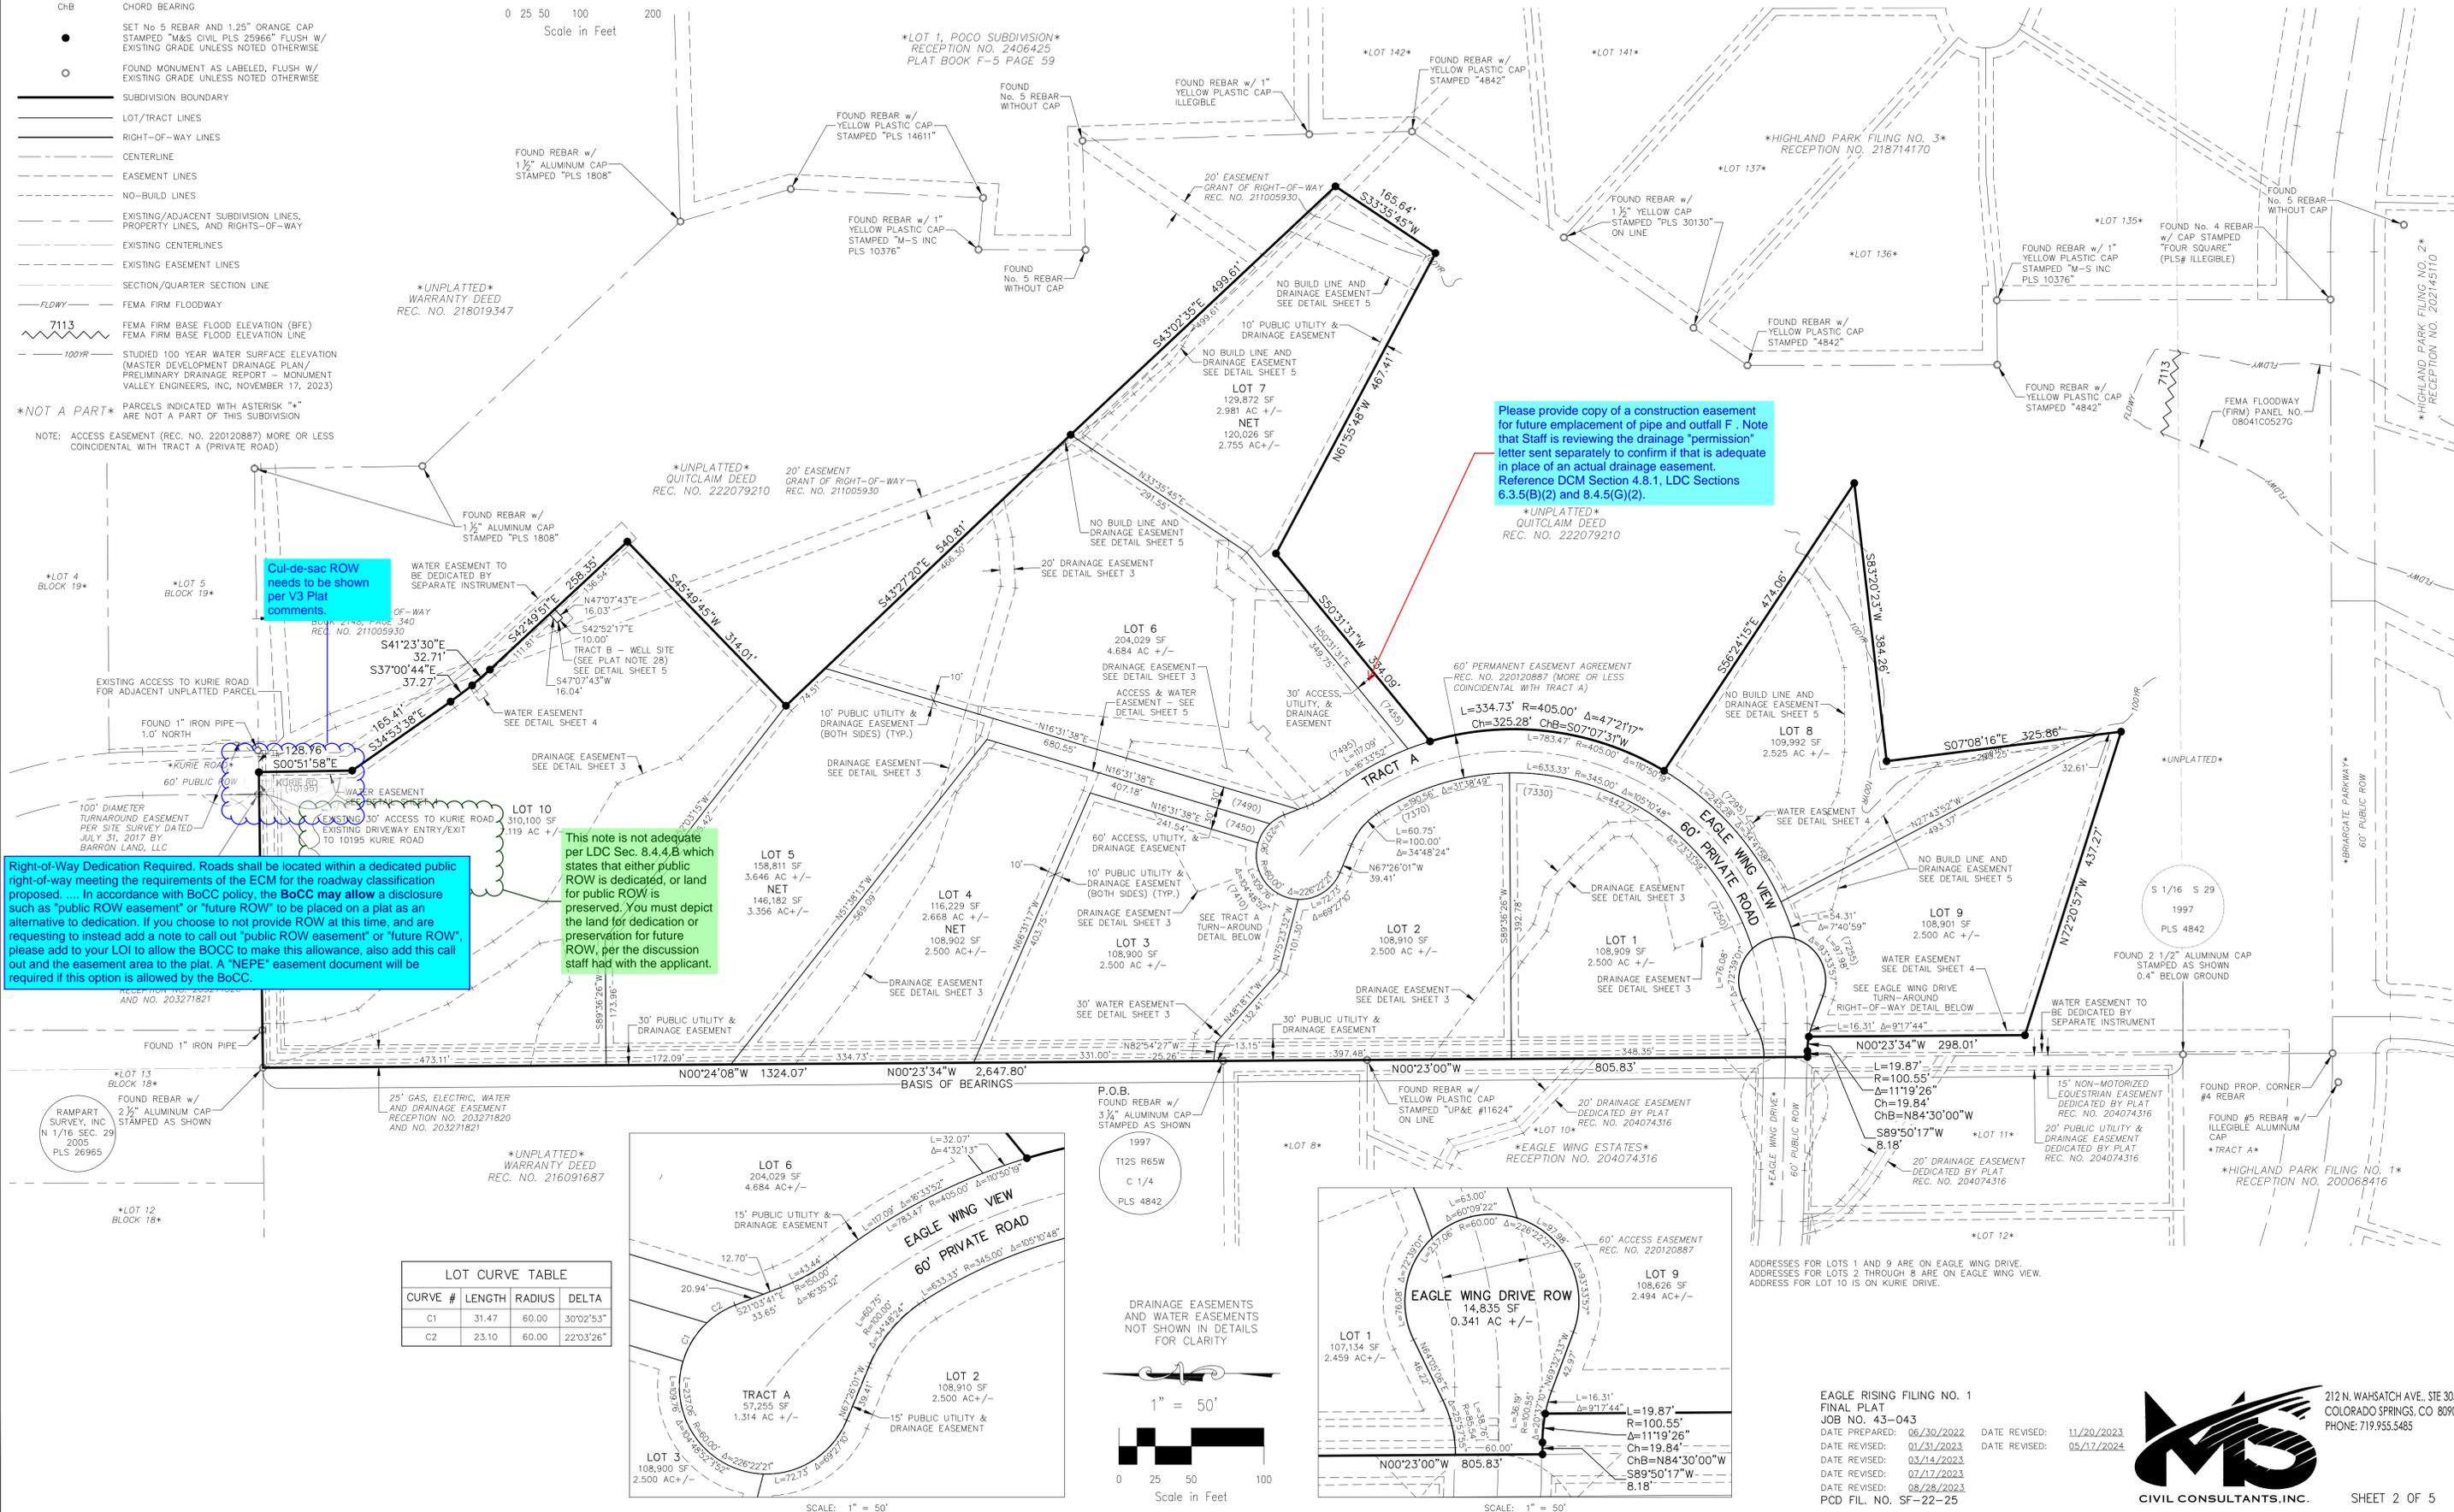



**Cul-de-sac ROW needs to be shown per V3 Plat comments.**

**Right-of-Way Dedication Required. Roads shall be located within a dedicated public right-of-way meeting the requirements of the ECM for the roadway classification proposed. ... In accordance with BoCC policy, the BoCC may allow a disclosure such as "public ROW easement" or "future ROW" to be placed on a plat as an alternative to dedication. If you choose to not provide ROW at this time, and are requesting to instead add a note to call out "public ROW easement" or "future ROW", please add to your LOI to allow the BoCC to make this allowance, also add this call out and the easement area to the plat. A "NEPE" easement document will be required if this option is allowed by the BoCC.**

**This note is not adequate per LDC Sec. 8.4.4.B which states that either public ROW is dedicated, or land for public ROW is preserved. You must depict the land for dedication or preservation for future ROW, per the discussion staff had with the applicant.**

**Please provide copy of a construction easement for future emplacement of pipe and outfall F. Note that Staff is reviewing the drainage "permission" letter sent separately to confirm if that is adequate in place of an actual drainage easement. Reference DCM Section 4.8.1, LDC Sections 6.3.5(B)(2) and 8.4.5(G)(2).**

LOT CURVE TABLE			
CURVE #	LENGTH	RADIUS	DELTA
C1	31.47	60.00	30°02'53"
C2	23.10	60.00	22°03'26"

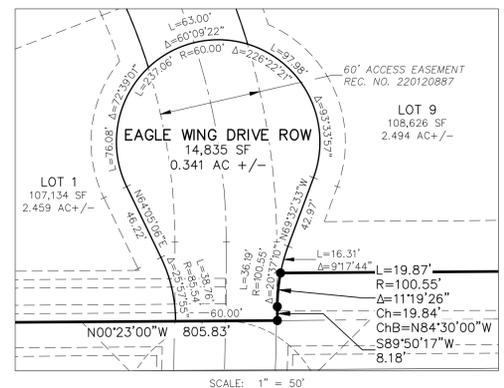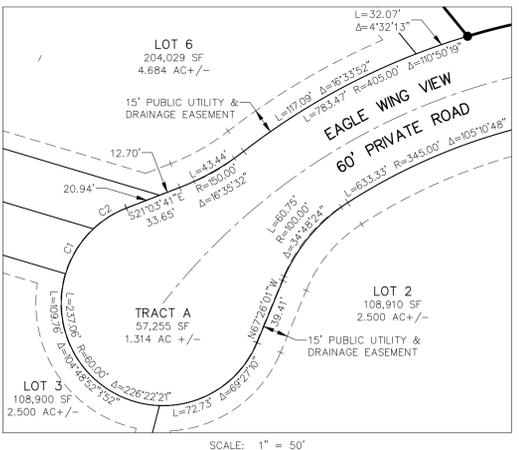

File: C:\3003A\Eagle Rising\Draw\140045 Eagle Rising No. 1 FPL.dwg PlotStamp: 5/20/2024 3:32 PM


EAGLE RISING FILING NO. 1  
FINAL PLAT  
JOB NO. 43-043  
DATE PREPARED: 06/30/2022 DATE REVISION: 11/20/2023  
DATE REVISION: 01/31/2023 DATE REVISION: 03/14/2023  
DATE REVISION: 07/17/2023 DATE REVISION: 08/28/2023  
PCD FIL. NO. SF-22-25

212 N. WAHSATCH AVE., STE 305  
COLORADO SPRINGS, CO 80903  
PHONE: 719.955.5485


SHEET 2 OF 5

**EAGLE RISING FILING NO. 1**  
 A PORTION OF THE EAST HALF (E1/2) OF SECTION 29, TOWNSHIP 12 SOUTH,  
 RANGE 65 WEST OF THE SIXTH PRINCIPAL MERIDIAN, EL PASO COUNTY, COLORADO  
**DRAINAGE EASEMENTS DETAILS**  
 WATER EASEMENTS (SEE SHEET 4) AND NO-BUILD LINES (SEE SHEET 5)  
 NOT SHOWN FOR CLARITY



- LEGEND:**
- SF SQUARE FEET
  - (R) RADIAL BEARING
  - (0000) ADDRESS
  - Ch CHORD
  - ChB CHORD BEARING
  - SET No 5 REBAR AND 1.25" ORANGE CAP STAMPED "M&S CIVIL PLS 25966" FLUSH W/ EXISTING GRADE UNLESS NOTED OTHERWISE
  - FOUND MONUMENT AS LABELED, FLUSH W/ EXISTING GRADE UNLESS NOTED OTHERWISE
  - SUBDIVISION BOUNDARY
  - LOT/TRACT LINES
  - RIGHT-OF-WAY LINES
  - CENTERLINE
  - EASEMENT LINES
  - EXISTING/ADJACENT SUBDIVISION LINES, PROPERTY LINES, AND RIGHTS-OF-WAY
  - EXISTING CENTERLINES
  - EXISTING EASEMENT LINES
  - SECTION/QUARTER SECTION LINE
  - PARCELS INDICATED WITH ASTERISK "\*" ARE NOT A PART OF THIS SUBDIVISION
- NOTE: ACCESS EASEMENT (REC. NO. 220120887) MORE OR LESS COINCIDENTAL WITH TRACT A (PRIVATE ROAD)

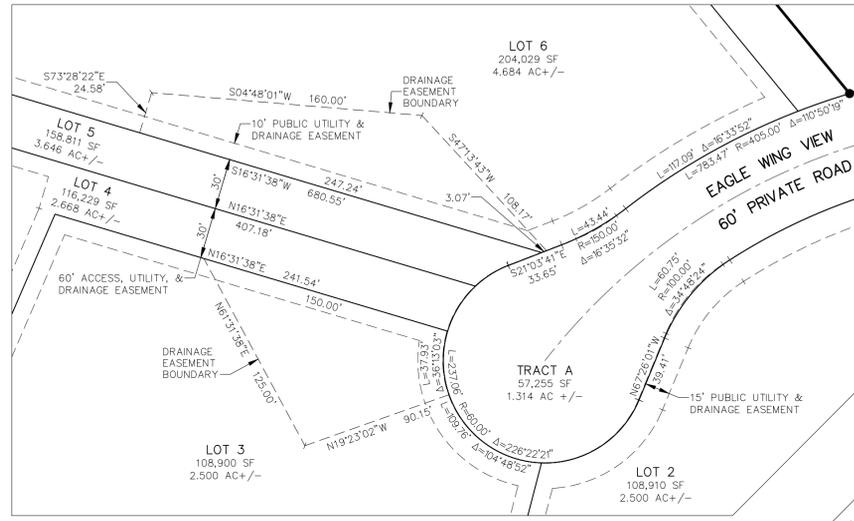

**DRAINAGE EASEMENT DETAILS**  
 LOTS 3 & 6  
 SCALE: 1" = 50'

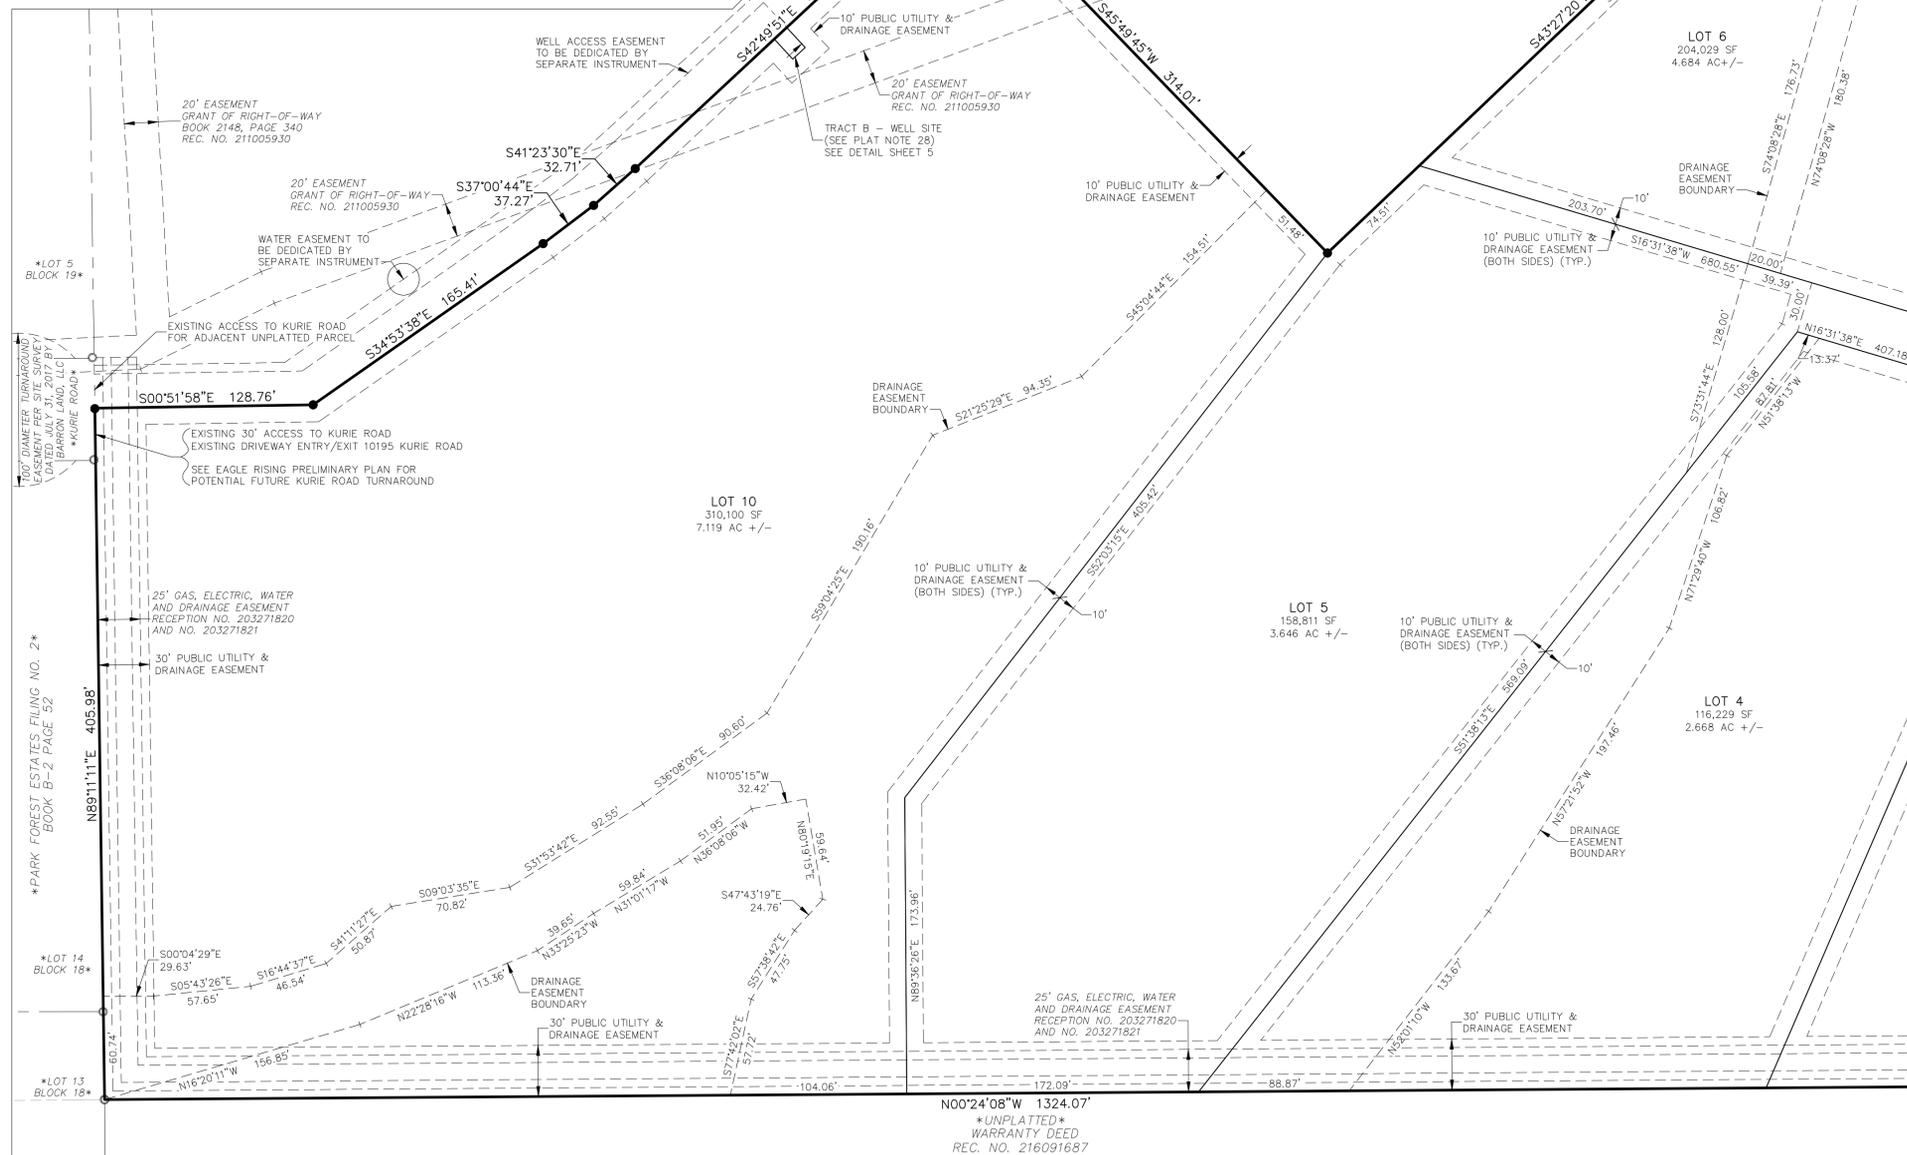

**DRAINAGE EASEMENT DETAILS**  
 LOTS 4, 5, 6, & 10  
 SCALE: 1" = 50'

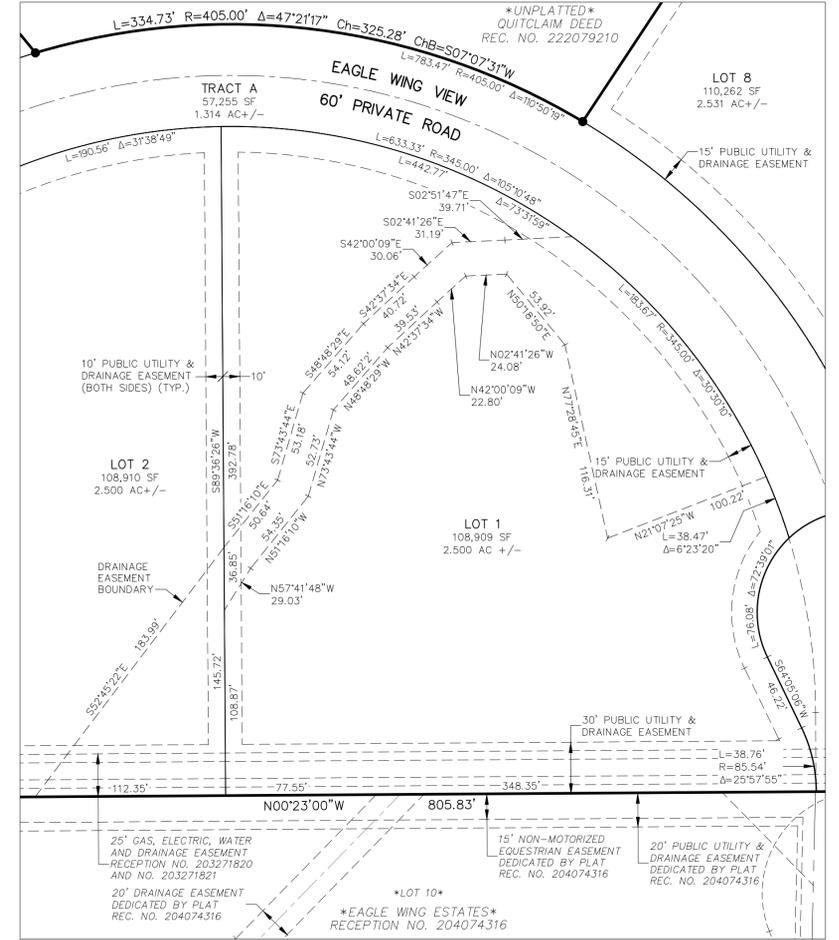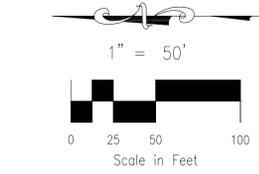

**DRAINAGE EASEMENT DETAIL**  
 LOTS 1 & 2  
 SCALE: 1" = 50'

EAGLE RISING FILING NO. 1  
 FINAL PLAT  
 JOB NO. 43-043  
 DATE PREPARED: 06/30/2022  
 DATE REVISION: 01/31/2023  
 DATE REVISION: 03/14/2023  
 DATE REVISION: 07/17/2023  
 DATE REVISION: 08/28/2023  
 PCD FIL. NO. SF-22-25



DATE REVISION: 11/20/2023  
 DATE REVISION: 05/17/2024

212 N. WAHSATCH AVE., STE 305  
 COLORADO SPRINGS, CO 80903  
 PHONE: 719.955.5485


SHEET 3 OF 5

**EAGLE RISING FILING NO. 1**  
 A PORTION OF THE EAST HALF (E1/2) OF SECTION 29, TOWNSHIP 12 SOUTH,  
 RANGE 65 WEST OF THE SIXTH PRINCIPAL MERIDIAN, EL PASO COUNTY, COLORADO  
**WATER EASEMENTS DETAILS**  
 DRAINAGE EASEMENTS (SEE SHEET 3) AND NO-BUILD LINES (SEE SHEET 5)  
 NOT SHOWN FOR CLARITY


- LEGEND:**
- SF SQUARE FEET
  - (R) RADIAL BEARING
  - (0000) ADDRESS
  - Ch CHORD
  - ChB CHORD BEARING
  - SET NO. 5 REBAR AND 1.25" ORANGE CAP STAMPED "M&S CIVIL PLS 25966" FLUSH W/ EXISTING GRADE UNLESS NOTED OTHERWISE
  - FOUND MONUMENT AS LABELED, FLUSH W/ EXISTING GRADE UNLESS NOTED OTHERWISE
  - SUBDIVISION BOUNDARY
  - LOT/TRACT LINES
  - RIGHT-OF-WAY LINES
  - CENTERLINE
  - EASEMENT LINES
  - EXISTING/ADJACENT SUBDIVISION LINES, PROPERTY LINES, AND RIGHTS-OF-WAY
  - EXISTING CENTERLINES
  - EXISTING EASEMENT LINES
  - SECTION/QUARTER SECTION LINE
  - PARCELS INDICATED WITH ASTERISK "\*" ARE NOT A PART OF THIS SUBDIVISION
- NOTE: ACCESS EASEMENT (REC. NO. 220120887) MORE OR LESS COINCIDENTAL WITH TRACT A (PRIVATE ROAD)

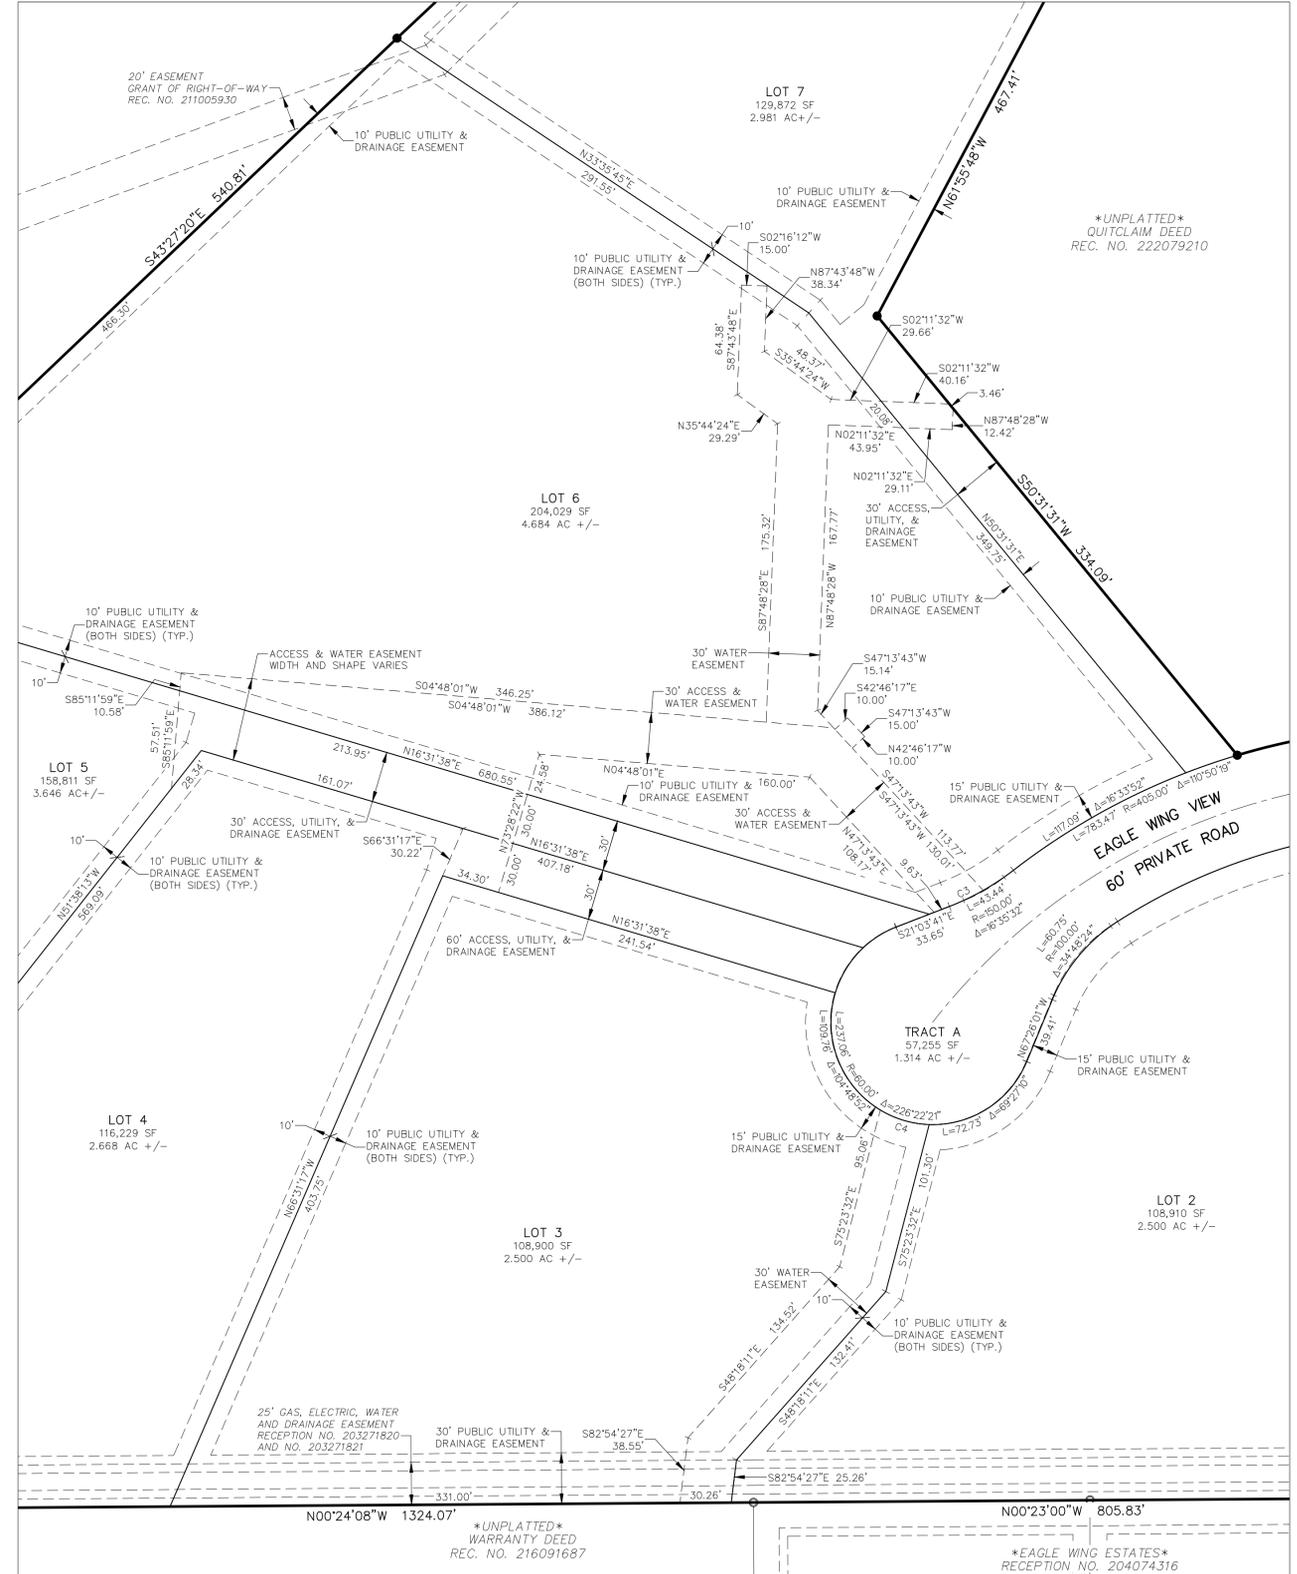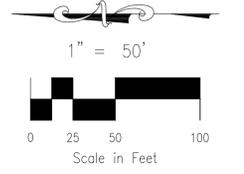


**ACCESS & WATER EASEMENT DETAILS**  
 LOTS 3, 5, 6, & 7  
 SCALE: 1" = 50'

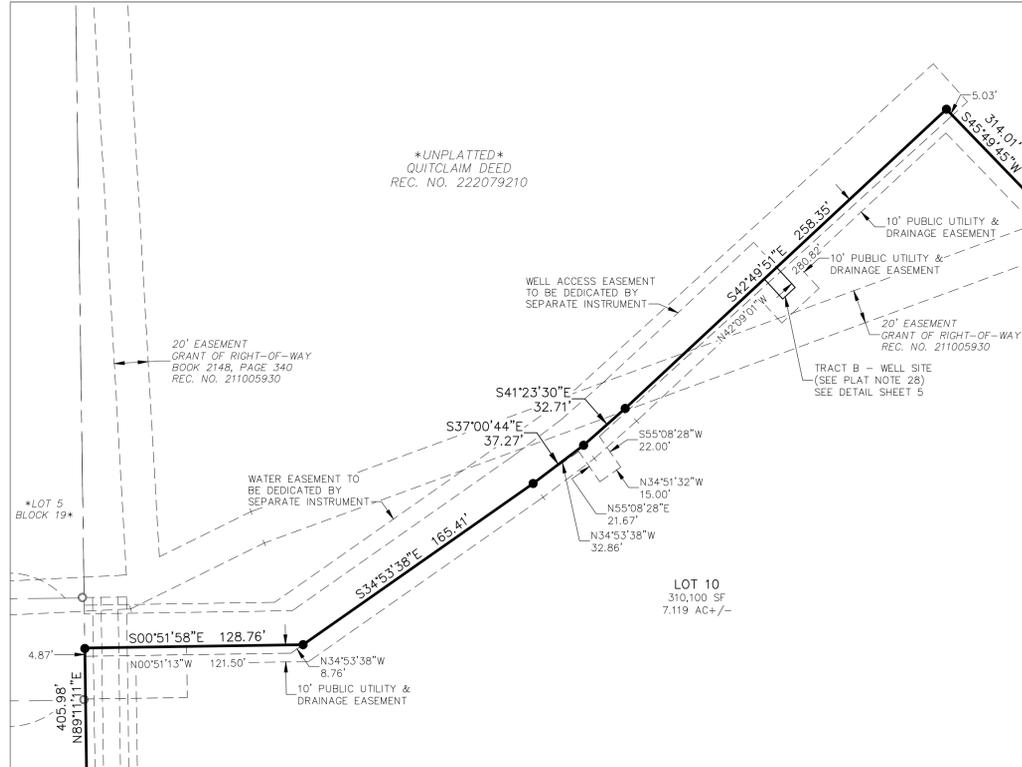

**WATER EASEMENT DETAILS**  
 LOT 10  
 SCALE: 1" = 50'

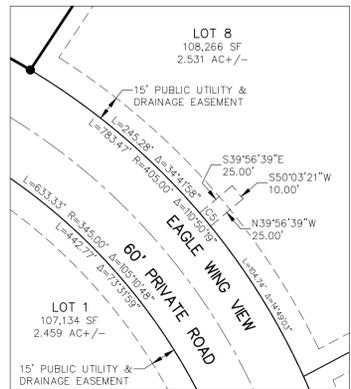

**WATER EASEMENT DETAIL**  
 LOT 8  
 SCALE: 1" = 50'

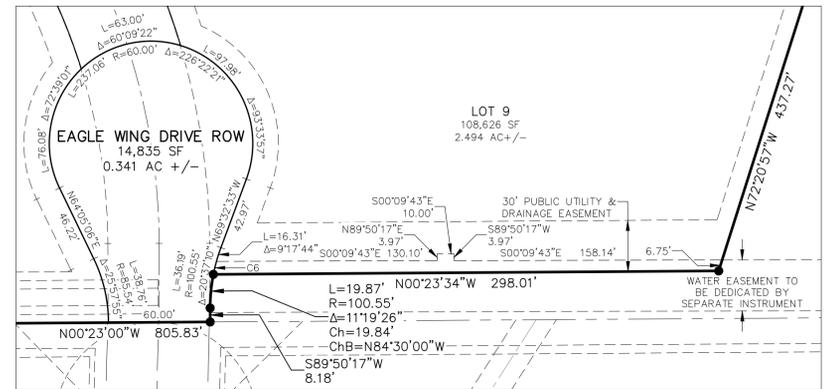

**WATER EASEMENT DETAIL**  
 LOT 9  
 SCALE: 1" = 50'

EASEMENT CURVE TABLE					
CURVE #	ARC LENGTH	RADIUS	DELTA	CHORD LENGTH	CHORD BEARING
C3	22.09	150.00	8°26'15"	22.07	N25°16'48"W
C4	30.34	59.50	29°13'14"	30.02	S16°30'17"W
C5	10.00	405.00	1°24'53"	10.00	N50°03'21"E
C6	7.85	100.55	4°28'27"	7.85	S76°36'04"E

EAGLE RISING FILING NO. 1  
 FINAL PLAT  
 JOB NO. 43-043  
 DATE PREPARED: 06/30/2022 DATE REVISED: 11/20/2023  
 DATE REVISED: 01/31/2023 DATE REVISED: 05/17/2024  
 DATE REVISED: 03/14/2023  
 DATE REVISED: 07/17/2023  
 DATE REVISED: 08/28/2023  
 PCD FIL. NO. SF-22-25






212 N. WAHSATCH AVE., STE 305  
 COLORADO SPRINGS, CO 80903  
 PHONE: 719.955.5485

SHEET 4 OF 5

File: C:\3003A\Eagle Rising\Draw\43043 Eagle Rising No. 1 Final.dwg Plotstamp: 5/17/2024 9:33 AM

**EAGLE RISING FILING NO. 1**  
 A PORTION OF THE EAST HALF (E 1/2) OF SECTION 29, TOWNSHIP 12 SOUTH,  
 RANGE 65 WEST OF THE SIXTH PRINCIPAL MERIDIAN, EL PASO COUNTY, COLORADO  
**NO-BUILD LINES / DRAINAGE EASEMENTS**  
**TRACT B DETAILS**  
 WATER EASEMENTS (SEE SHEET 4) NOT SHOWN FOR CLARITY

- LEGEND:**
- SF SQUARE FEET
  - (R) RADIAL BEARING
  - (0000) ADDRESS
  - Ch CHORD
  - ChB CHORD BEARING
  - SET No 5 REBAR AND 1.25" ORANGE CAP STAMPED "M&S CIVIL PLS 25966" FLUSH W/ EXISTING GRADE UNLESS NOTED OTHERWISE
  - FOUND MONUMENT AS LABELED, FLUSH W/ EXISTING GRADE UNLESS NOTED OTHERWISE
  - SUBDIVISION BOUNDARY
  - LOT/TRACT LINES
  - RIGHT-OF-WAY LINES
  - CENTERLINE
  - EASEMENT LINES
  - NO-BUILD LINES
  - EXISTING/ADJACENT SUBDIVISION LINES, PROPERTY LINES, AND RIGHTS-OF-WAY
  - EXISTING CENTERLINES
  - EXISTING EASEMENT LINES
  - SECTION/QUARTER SECTION LINE
  - 100YR STUDIED 100 YEAR WATER SURFACE ELEVATION (MASTER DEVELOPMENT DRAINAGE PLAN/ PRELIMINARY DRAINAGE REPORT - MONUMENT VALLEY ENGINEERS, INC, NOVEMBER 17, 2023)
  - 7121.4 STUDIED BASE FLOOD ELEVATION (BFE) STUDIED BASE FLOOD ELEVATION LINE
  - PARCELS INDICATED WITH ASTERISK "\*" ARE NOT A PART OF THIS SUBDIVISION
- NOTE: ACCESS EASEMENT (REC. NO. 220120887) MORE OR LESS COINCIDENTAL WITH TRACT A (PRIVATE ROAD)

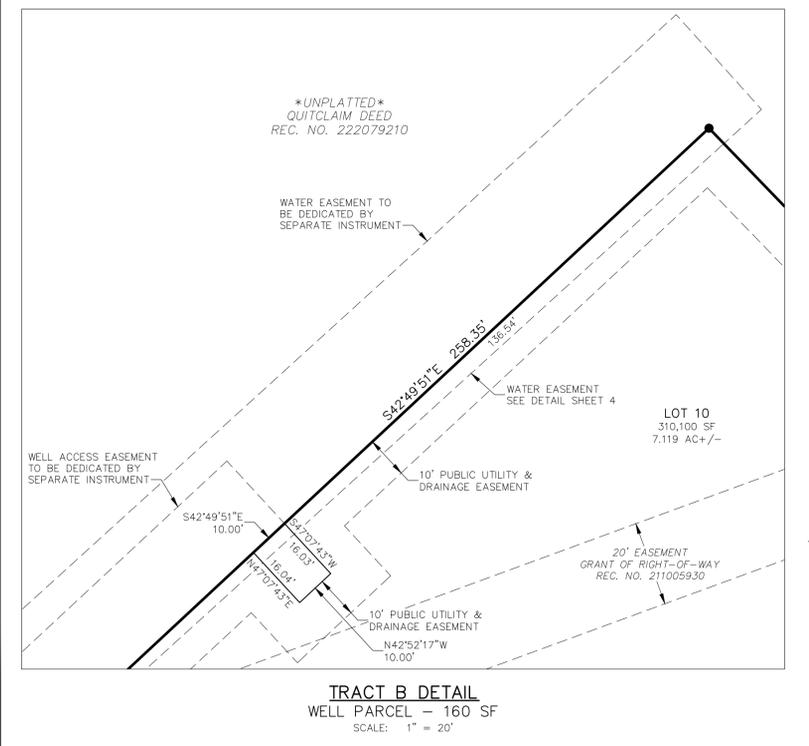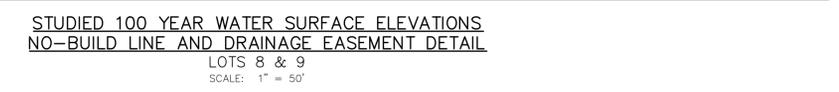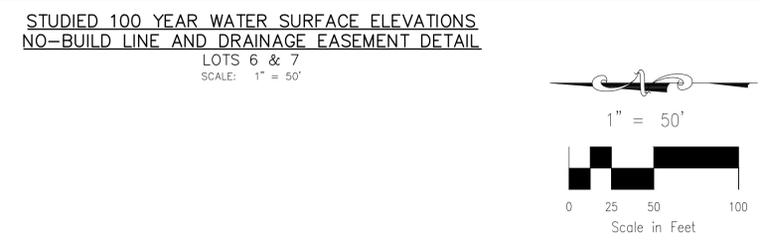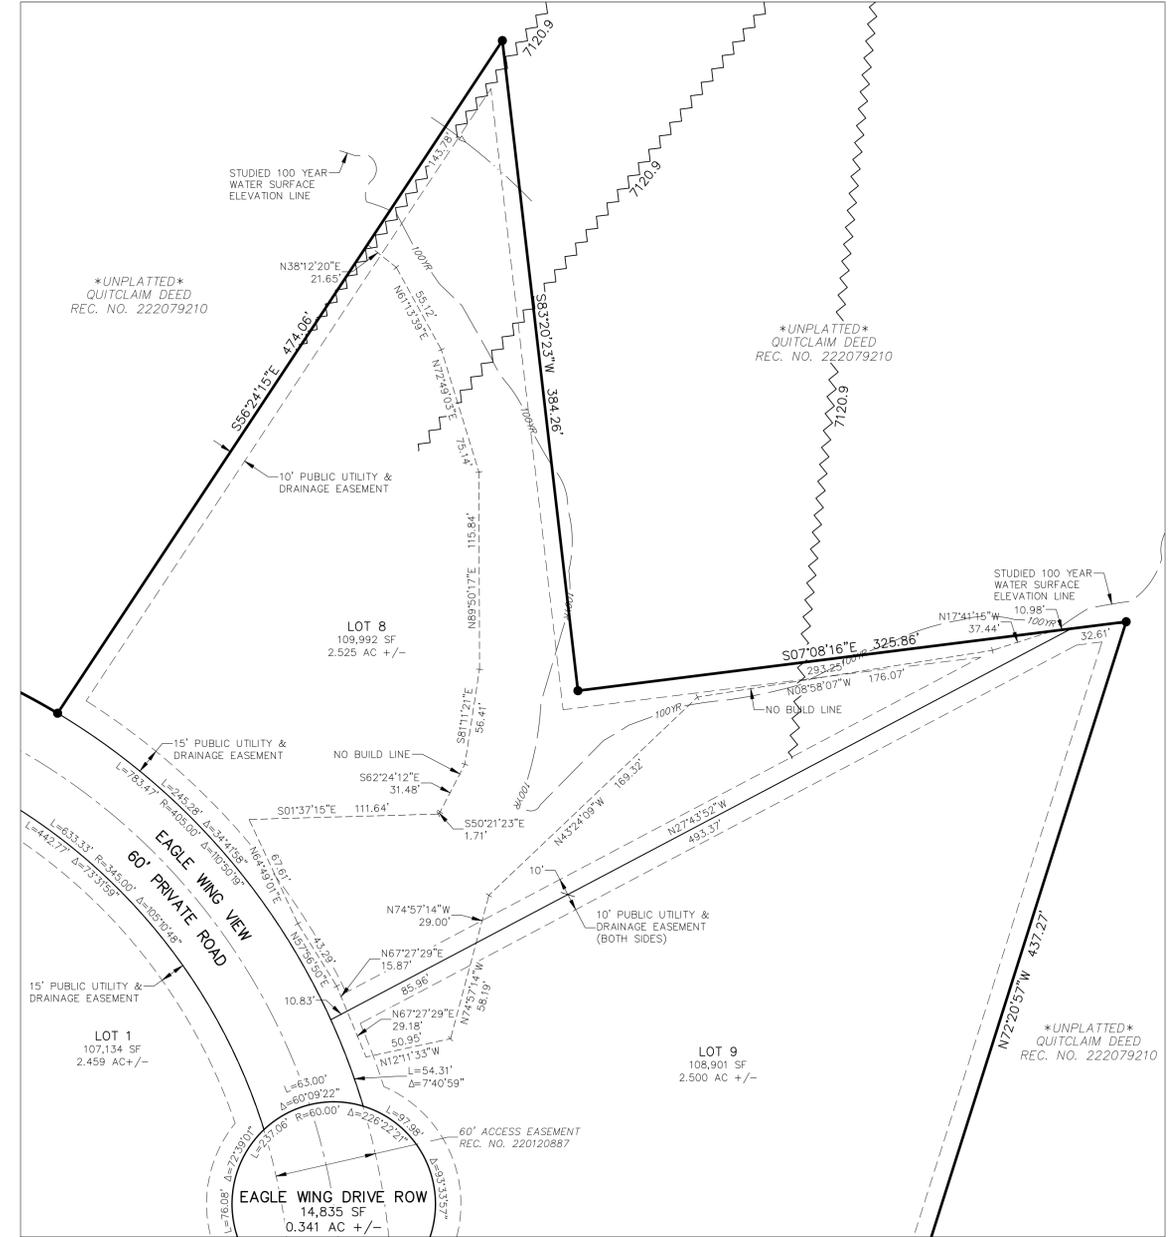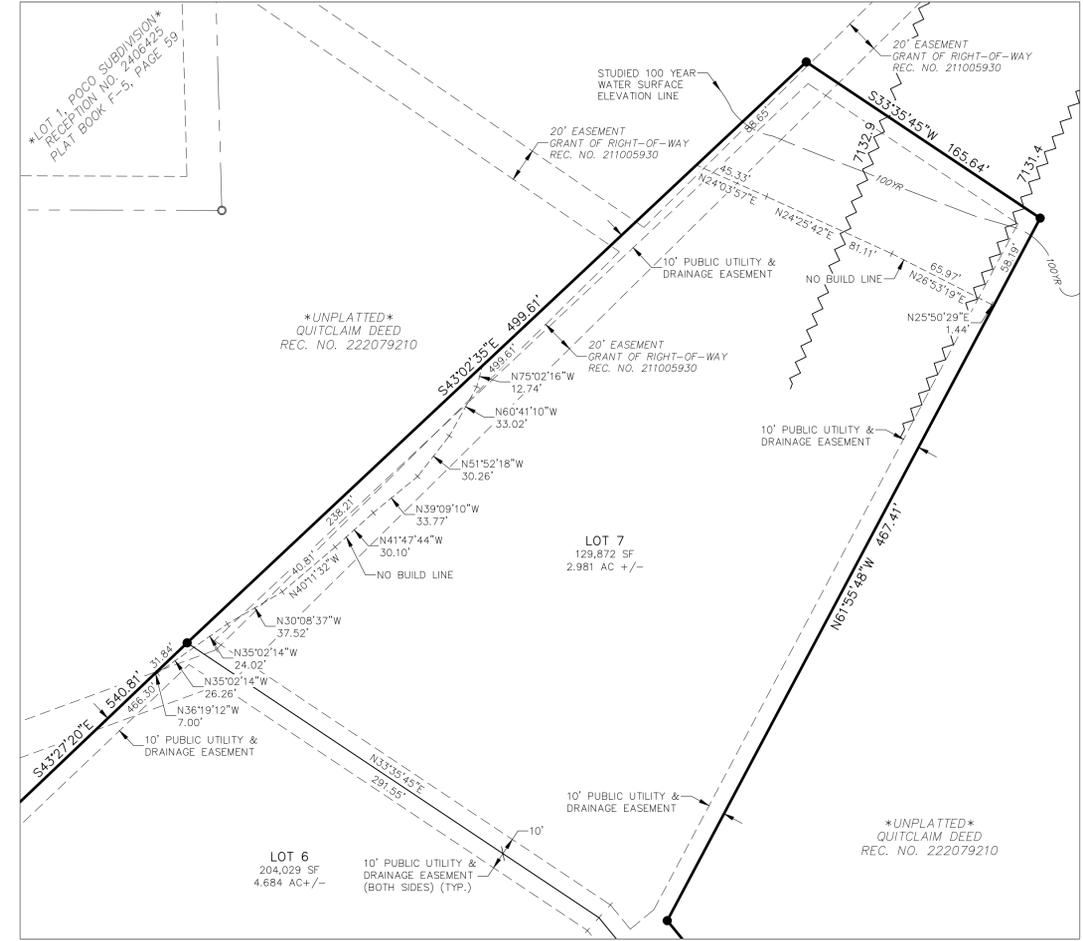

EAGLE RISING FILING NO. 1  
 FINAL PLAT  
 JOB NO. 43-043  
 DATE PREPARED: 06/30/2022 DATE REVISED: 11/20/2023  
 DATE REVISED: 01/31/2023 DATE REVISED: 05/17/2024  
 DATE REVISED: 03/14/2023  
 DATE REVISED: 07/17/2023  
 DATE REVISED: 08/28/2023  
 PCD FIL. NO. SF-22-25

212 N. WAHSATCH AVE., STE 305  
 COLORADO SPRINGS, CO 80903  
 PHONE: 719.955.5485

SHEET 5 OF 5

File: C:\3003A[Eagle Rising]Survey\Draw\43043 Eagle Rising No. 1 Final.dwg Plotstamp: 5/17/2024 9:33 AM