
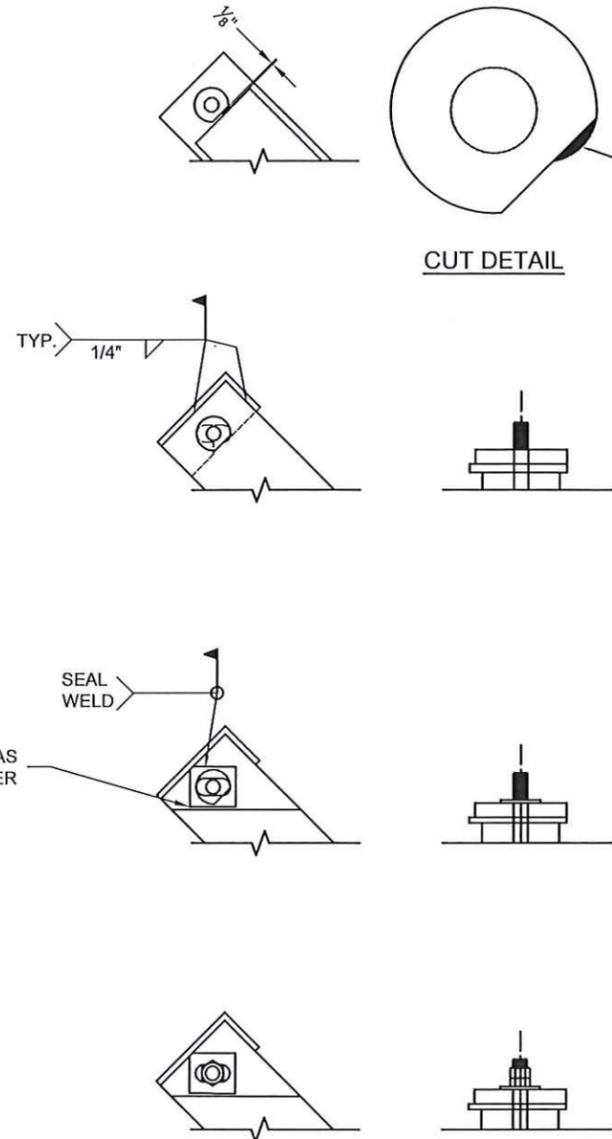
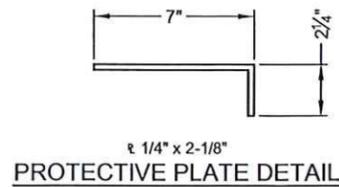
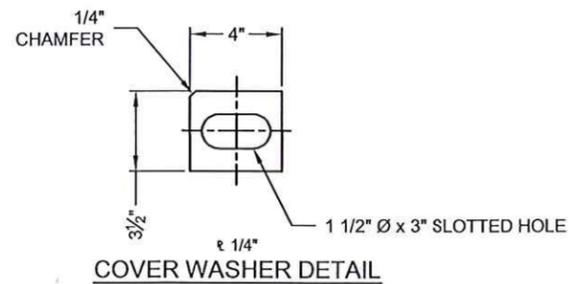
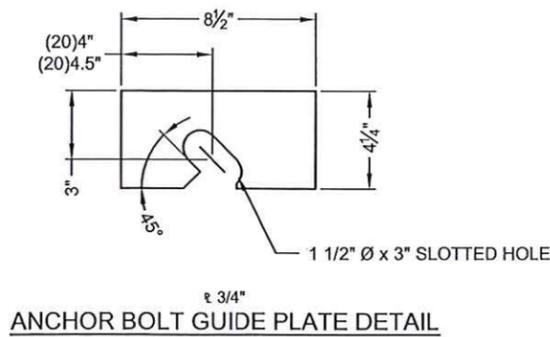
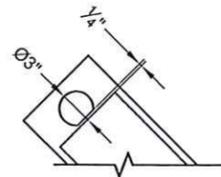
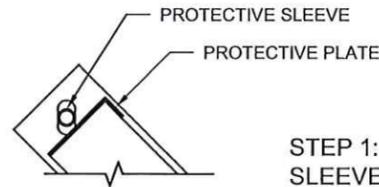


**GENERAL NOTES:**

1. CONTECH ENGINEERED SOLUTIONS HAS AISC QUALITY CERTIFIED BRIDGE FABRICATION - ADVANCED (MAJOR) WITH A FRACTURE CRITICAL AND SOPHISTICATED PAINT ENDORSEMENT.
2. MATERIALS: (UNLESS NOTED OTHERWISE):
  - a. STRUCTURAL STEEL: ASTM A588 WEATHERING STEEL
3. ALL WELDING SHALL USE THE GAS METAL ARC WELDING OR FLUX CORED ARC WELDING PROCESS.

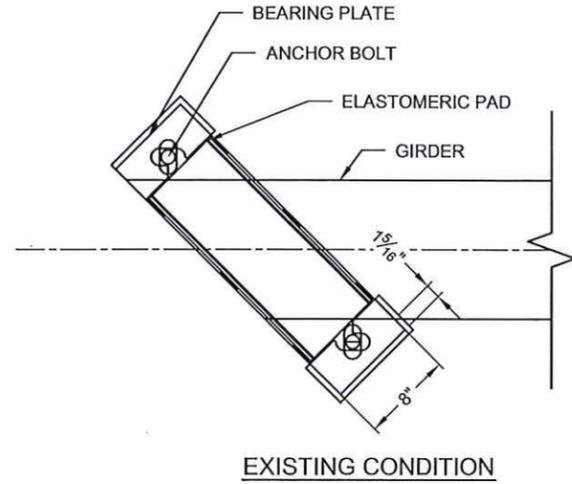

The design and information shown on this drawing is provided as a service to the project owner, engineer or contractor. It is not to be used, reproduced or modified in any manner without the prior written consent of Contech. Failure to do so may result in Contech's liability being limited to the extent of the fee paid for such use. If discrepancies between the supplied information upon which the drawing is based and actual field conditions are encountered as site work progresses, these discrepancies must be reported to Contech immediately. Contech shall not be held responsible for any design, construction or other errors or omissions based on missing, incomplete or inaccurate information supplied by others.

MARK	DATE	REVISION DESCRIPTION	BY
RP	4/29/2022	BRIDGE BEARING FIELD REPAIR	NBE
AB-1	10/29/2021	AS-BUILT FINALS	TLF
AB	9/28/2021	AS-BUILT FINALS	TLF
EO	7/22/2021	APPROVED FOR CONSTRUCTION	TLF

100'-0" x 30'-0"  
MESA TOP DRIVE SOUTH BRIDGE  
ELITE PROPERTIES of AMERICA, INC  
FOUNTAIN, CO

**CONTECH**  
ENGINEERED SOLUTIONS LLC  
www.ContechES.com

**BIG R**  
BRIDGE

DATE: 7/24/2020

DESIGNED: NBE	DRAWN: RDH
CHECKED: NBE	APPROVED: NBE
PROJECT No.: 621715	SEQUENCE No.:
SHEET:	1 OF 1