AUTHORITY

THIS PUD IS AUTHORIZED BY CHAPTER 4 OF THE EL PASO COUNTY LAND DEVELOPMENT CODE, ADOPTED PURSUANT TO THE COLORADO PLANNED UNIT DEVELOPMENT ACT OF

APPLICABILITY

THE PROVISIONS OF THIS PUD SHALL RUN WITH THE LAND. THE LANDOWNERS. THEIR SUCCESSORS, HEIRS, OR ASSIGNS SHALL BE BOUND BY THIS DEVELOPMENT PLAN, AS AMENDED AND APPROVED BY THE PLANNING AND COMMUNITY DEVELOPMENT DEPARTMENT DIRECTOR OR BOARD OF COUNTY COMMISSIONERS

ADOPTION

THE ADOPTION OF THIS PUD / PRELIMINARY PLAN SHALL EVIDENCE THE FINDINGS AND DECISIONS OF THE EL PASO COUNTY BOARD OF COUNTY COMMISSIONERS THAT THIS PLAN FOR FLYING HORSE NORTH PUD PARCELS 1-6 IS IN GENERAL CONFORMITY WITH THE EL PASO COUNTY MASTER PLAN, EL PASO COUNTY POLICY PLAN; IS AUTHORIZED UNDER PROVISION OF THE EL PASO COUNTY LAND DEVELOPMENT CODE; AND THAT THE EL PASO COUNTY LAND DEVELOPMENT CODE AND THIS DEVELOPMENT PLAN COMPLIES WITH THE COLORADO PLANNED UNIT DEVELOPMENT ACT OF 1972, AS AMENDED.

RELATIONSHIP TO COUNTY REGULATIONS

THE PROVISIONS OF THIS PUD/PRELIMINARY PLAN SHALL PREVAIL AND GOVERN THE DEVELOPMENT OF FLYING HORSE NORTH PUD PARCELS 1-6, PROVIDED, HOWEVER, THAT WHERE THE PROVISIONS OF THIS DEVELOPMENT PLAN DO NOT ADDRESS A PARTICULAR SUBJECT, THE RELEVANT PROVISIONS OF THE EL PASO COUNTY LAND DEVELOPMENT CODE, AS AMENDED AND IN EFFECT AT THE TIME OF THE PUD/PRELIMINARY PLAN APPROVAL (OR OWNER ACKNOWLEDGE THE PUD/PRELIMINARY PLAN CHANGES WITH THE CODE), OR ANY OTHER APPLICABLE RESOLUTIONS OR REGULATIONS OF EL PASO COUNTY, SHALL BE APPLICABLE.

ENFORCEMENT

TO FURTHER THE MUTUAL INTEREST OF THE RESIDENTS, OCCUPANTS, AND OWNERS OF THE PUD/PRELIMINARY PLAN AND OF THE PUBLIC IN THE PRESERVATION OF THE INTEGRITY OF THIS PLAN, THE PROVISIONS OF THIS PLAN RELATING TO THE USE OF LAND AND THE LOCATION OF COMMON OPEN SPACE SHALL RUN IN FAVOR OF EL PASO COUNTY AND SHALL BE ENFORCEABLE AT LAW OR IN EQUITY BY THE COUNTY WITHOUT LIMITATION ON ANY POWER OR REGULATION OTHERWISE GRANTED BY LAW.

CONFLICT

WHERE THERE IS MORE THAN ONE PROVISION WITHIN THE PUD/PRELIMINARY PLAN THAT COVER THE SAME SUBJECT MATTER, THE PROVISION WHICH IS MOST RESTRICTIVE OR IMPOSES HIGHER STANDARDS OR REQUIREMENTS SHALL GOVERN

MAXIMUM LEVEL OF DEVELOPMENT

THE TOTAL NUMBER OF DWELLINGS SHOWN ON THE PUD/PRELIMINARY PLAN FOR DEVELOPMENT WITHIN THE SPECIFIED PLANNING AREAS IN THE MAXIMUM DEVELOPMENT REQUESTED FOR PLATTING OR CONSTRUCTION (PLUS ANY APPROVED DENSITY TRANSFERS). THE ACTUAL NUMBER OF DWELLINGS OR LEVEL OF DEVELOPMENT MAY BE LESS DUE TO SUBDIVISION OR SITE DEVELOPMENT PLAN REQUIREMENTS. LAND CARRYING CAPACITY. OR OTHER REQUIREMENTS OF THE BOARD OF COUNTY COMMISSIONERS. APPLICANT MAY TRANSFER ANY LOSS OF DENSITY FROM A PARCEL TO ANOTHER PARCEL (EXCEEDING THE DENSITY FOR THAT PARCEL) AS LONG AS THE TOTAL MAXIMUM UNIT COUNT FOR THE PROJECT IS NOT EXCEEDED.

PROJECT TRACKING

AT THE TIME OF ANY FINAL PLAT APPLICATION, THE APPLICANT SHALL PROVIDE A SUMMARY OF THE DEVELOPMENT, TO DATE, TO DEVELOPMENT SERVICES DEPARTMENT, IN ORDER TO ASSURE MAXIMUM DEVELOPMENT UNIT LIMITS FOR THE ENTIRE PROJECT ARE NOT EXCEEDED. DENSITY TRANSFERS SHALL BE SHOWN BETWEEN PARCELS AS THEY HAVE OCCURRED.

OVERALL PROJECT STANDARDS

THE STANDARD ZONING REQUIREMENTS OF THE EL PASO COUNTY LAND DEVELOPMENT CODE INCLUDING OFF-STREET PARKING, LANDSCAPING, SITE DEVELOPMENT, ACCESSORY AND TEMPORARY USES, BY SPECIAL REVIEW AND VARIANCE PROCESSES SHALL APPLY TO THIS PUD/PRELIMINARY PLAN, EXCEPT AS MODIFIED IN THIS SUBMITTAL

LEGAL DESCRIPTION:

SEE SHEET 2

FLYING HORSE NORTH PUD DEVELOPMENT GUIDELINES

FLYING HORSE NORTH IS A PLANNED RESIDENTIAL COMMUNITY LOCATED GENERALLY WEST OF BLACK FOREST ROAD AND SOUTH OF HODGEN ROAD IN EL PASO COUNTY COLORADO. THE PROPERTY CONSISTS OF 1,1417 ACRES OF LAND. FLYING HORSE NORTH IS A PLANNED UPSCALE, AMENITIZED RESIDENTIAL COMMUNITY, WITH PLANS FOR A GOLF COURSE, CLUBHOUSE AND SUBSTANTIAL OPEN SPACE WITHIN THE COMMUNITY.

PERMITTED USES WITHIN THE FLYING HORSE NORTH PUD INCLUDE SINGLE FAMILY HOMES, GOLF COURSE, AND ASSOCIATED FACILITIES WHICH MAY INCLUDE CLUBHOUSE, MAINTENANCE FACILITIES, RESTROOMS, SHELTERS, DRIVING RANGE, PONDS DESIGNED FOR WATER STORAGE, OPEN SPACE, TRAILS AND ASSOCIATED RECREATIONAL FACILITIES.

PERMITTED ACCESSORY USES SHALL INCLUDE AND BE SUBJECT TO THE REGULATIONS OF SECTION 5.2.2 OF THE 2024 LAND DEVELOPMENT CODE, AS MAY BE AMENDED IN THE FUTURE. IN ADDITION, ACCESSORY LIVING QUARTERS (GUEST HOUSE) MAY BE CONSTRUCTED ON LOTS DESIGNATED FOR SUCH USE BY THE ARCHITECTURAL CONTROL COMMITTEE. ACCESSORY LIVING QUARTERS (GUEST HOUSE) MAY NOT EXCEED TWO-THOUSAND (2,000) SQUARE FEET OF LIVING SPACE AND MAY NOT HAVE A KITCHEN UNLESS AN AFFIDAVIT SIGNED BY THE OWNER IS FILING FOR RECORDING WITH THE CLERK AND RECORDED ACKNOWLEDGING THAT THE ACCESSORY LIVING QUARTER (GUEST HOUSE) MAY NOT BE LEASED OR RENTED. AFFIDAVITS AVAILABLE FROM THE EL PASO COUNTY PLANNING AND COMMUNITY DEVELOPMENT DEPARTMENT. ALL ELECTRIC, GAS CENTRAL OR MUNICIPAL SEWER AND WATER SERVICES TO THE ACCESSORY LIVING QUARTER (GUEST HOUSE) SHALL BE INTERCONNECTED TO AND INDISTINGUISHABLE FROM THAT OF THE PRINCIPAL DWELLING UNIT AND SHALL NOT HAVE SEPARATE METERS, SERVICE LINES OR BILLINGS.

PERMITTED TEMPORARY USES MAY INCLUDE RESIDENTIAL SALES OFFICE AND GOLF CLUB BUILDING.

a.ALL PERMANENT SIGNS SHALL BE LOCATED WITHIN DESIGNATED TRACTS.

b.MAJOR COMMUNITY SIGNS AS IDENTIFIED ON THE PUD PRELIMINARY PLAN MAY HAVE A MAXIMUM SIZE OF 150 SQUARE FEET. STRUCTURES ASSOCIATED WITH THESE SIGNS ARE LIMITED TO 45' IN HEIGHT MEASURED FROM FINISHED GRADE. c.MINOR COMMUNITY SIGNS AS IDENTIFIED ON THE PUD PRELIMINARY PLAN MAY HAVE A MAXIMUM SIZE OF 75 SQUARE FEET. STRUCTURES ASSOCIATED WITH THESE SIGNS ARE LIMITED TO 10' IN HEIGHT MEASURED FROM FINISHED GRADE.

d.DIRECTIONAL SIGNS ARE PERMITTED AND LIMITED TO 15 SQUARE FEET.

e.SETBACKS OF THE PUD ZONE DO NOT APPLY TO SIGNS WITHIN THE FLYING HORSE NORTH PUD, HOWEVER, ALL OTHER SETBACK PROVISIONS, ESPECIALLY RELATIVE TO PUBLIC SAFETY, WILL BE CONSISTENT WITH THE PROVISIONS OF THE EL PASO COUNTY LAND USE CODE.

LAND DESIGNATED AS GOLF COURSE SHALL ALSO BE DETERMINED TO BE OPEN SPACE. SHOULD THE GOLF COURSE SHOWN ON THE PUD PRELIMINARY PLANS NOT BE CONSTRUCTED, OR SHOULD SAID GOLF COURSE USE BE TERMINATED, THE LAND MAY ONLY BE USED FOR OPEN SPACE OR RECREATIONAL USES.

a. MAXIMUM LOT COVERAGE: TWENTY (20) PERCENT

b. MAXIMUM BUILDING HEIGHT: THIRTY-FIVE (35) FEET. THE GOLF CLUBHOUSE OR RECREATIONAL FACILITY MAY HAVE A MAXIMUM HEIGHT OF FORTY-FIVE (45) FEET c. SETBACK MINIMUMS:

• FRONT YARD: THIRTY (30) FEET MINIMUM • SIDE YARD: TEN (10) FEET MINIMUM

• CORNER LOT SIDE YARD: TWENTY (20) FEET MINIMUM

 REAR YARD: THIRTY-FIVE (35) FEET MINIMUM d. MINIMUM LOT SIZE: 2.5 ACRES

e. ACCESSORY BUILDING MUST COMPLY WITH THE SETBACKS ESTABLISHED ABOVE, EXCEPT THAT THE REAR YARD SETBACK MAY BE REDUCED TO TWENTY (20) FEET FOR ANY LOTS THAT DO NOT ABUT A PUBLIC STREET OR THE GOLF COURSE. ACCESSORY STRUCTURES ARE ARCHITECTURAL COVENANTS REGARDING BUILDING COLORS AND MATERIALS TO BE CONSISTENT WITH THE PRIMARY STRUCTURE OF THE SITE.

f. PROJECTIONS INTO SETBACKS ARE GOVERNED BY THE LAND DEVELOPMENT CODE IN EFFECT AT THE TIME OF PUD PRELIMINARY PLAN APPROVAL g. MAIL KIOSK STRUCTURES MAY HAVE A MAXIMUM HEIGHT OF TWELVE (12) FEET, WIDTH OF FIVE (5) FEET AND DEPTH OF TEN (10) FEET.

a. STREETS WITHIN FLYING HORSE NORTH SUBDIVISION PROVIDE GENERAL VEHICULAR CIRCULATION THROUGHOUT THE DEVELOPMENT. ALL STREETS SHALL BE PUBLICLY OWNED AND MAINTAINED. CONSTRUCTION WILL BE TO EL PASO COUNTY STANDARDS UNLESS OTHERWISE MODIFIED BY THIS PUD PRELIMINARY PLAN. ALL STREETS WILL BE PAVED UNLESS OTHERWISE INDICATED.

a. ALL COMMON LANDSCAPE, OPEN SPACE, PARKS, TRACTS AND DRAINAGE FACILITIES WITHIN THIS DEVELOPMENT SHALL BE OWNED AND MAINTAINED BY THE FLYING HORSE NORTH

b. LANDSCAPE MAINTENANCE WITHIN RIGHT-OF-WAY IS THE RESPONSIBILITY OF THE FLYING HORSE NORTH HOA OR METROPOLITAN DISTRICT WITH A COUNTY AGREEMENT. c. NO LANDSCAPING SHALL OBSTRUCT SIGHT DISTANCE TRIANGLES PER THE EL PASO COUNTY ENGINEERING CRITERIA MANUAL. THE MINIMUM HORIZONTAL CLEARANCE FOR

SIDEWALKS AROUND UTILITY STRUCTURES, FURNITURE, AND OTHER ENCROACHMENTS SHALL BE FOUR (4) FEET OR GREATER TO PROVIDE SAFE CONDITIONS FOR PEDESTRIANS d. PROPOSED TRAILS TO BE SOFT SURFACE (I.E. CRUSHED REFINES) AND FINAL TRAIL ALIGNMENT TO BE DETERMINED ON GRADE, VEGETATION, AND OTHER EXISTING SITE FEATURES

e. ANY FUTURE NON-REGIONAL TRAILS TO BE OWNED AND MAINTAINED BY THE FLYING HORSE NORTH HOA.

AT THE TIME OF THE FINAL PLAT

a. RESTROOMS, SHELTERS, AND MAINTENANCE BUILDINGS ARE PERMITTED IN TRACTS DESIGNATES FOR USE AS GOLF COURSE AND OPEN SPACE PARKS.

ARCHITECTURAL CONTROL COMMITTEE REVIEW / COVENANTS


a. COVENANTS FOR FLYING HORSE NORTH HAVE BEEN CREATED BY SEPARATE DOCUMENTS. THE COVENANTS ESTABLISH RULES AND REGULATIONS FOR THE PROPERTY WITHIN THE SUBDIVISION AND ESTABLISH THE GOVERNANCE MECHANISM OF THE SUBDIVISION, INCLUDING THE CREATION OF THE ARCHITECTURAL CONTROL COMMITTEE. ARCHITECTURAL CONTROL COMMITTEE REVIEW AND APPROVAL IS REQUIRED PRIOR TO APPLICATION FOR COUNTY PERMITS.


FLYING HORSE NORTH FILING NO. 4

PUD PRELIMINARY PLAN

AN AMENDMENT TO FLYING HORSE NORTH PUD DEVELOPMENT PLAN / PRELIMINARY PLAN

A PORTION OF SECTIONS 34 (NE 1/4), 35 (NW 1/4, & NE 1/4) AND 36 TOWNSHIP 11 SOUTH, RANGE 66 WEST AND A PORTION OF SECTIONS 30 (SW 1/4, SE 1/4, & NE 1/4) AND 31 (SW 1/4, NW 1/4, & NE 1/4), TOWNSHIP 11 SOUTH, RANGE 65 WEST OF THE SIXTH PRINCIPAL MERIDIAN, COUNTY OF EL PASO, STATE OF COLORADO

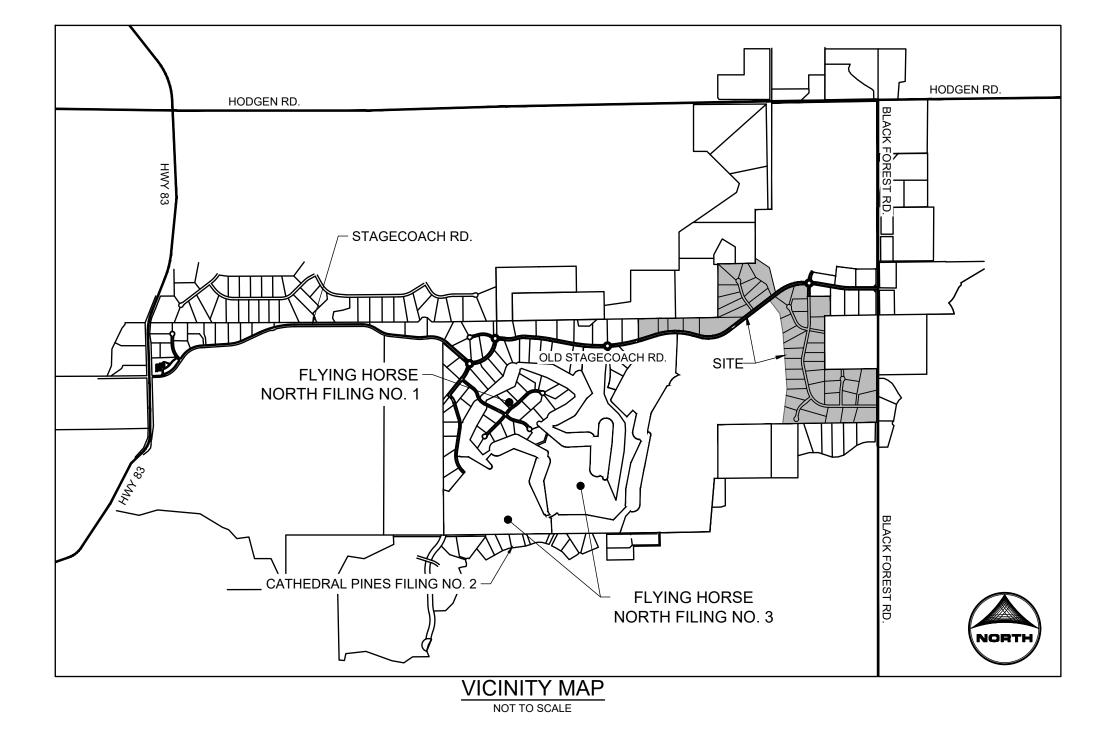

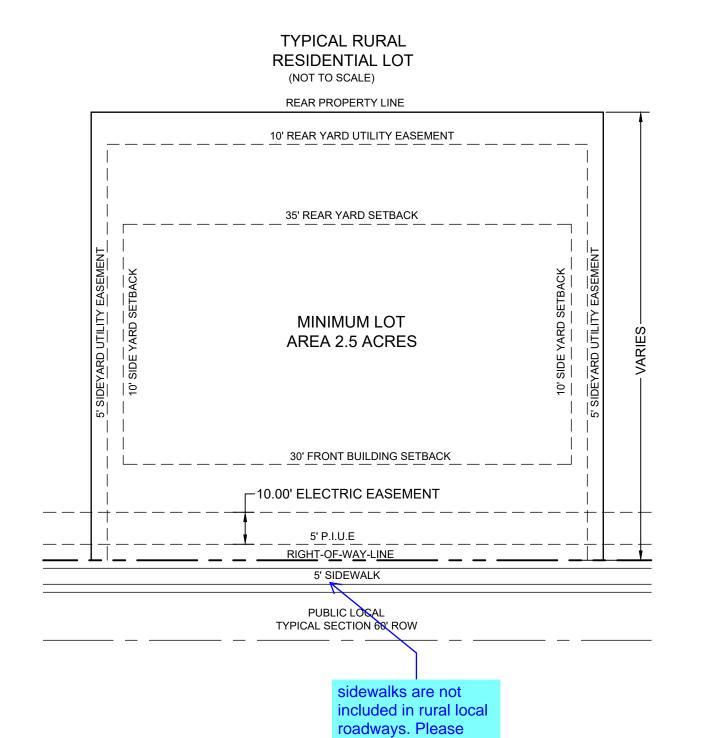

SITE DATA

TAX ID NUMBER: **EXISTING LAND USE:** PROPOSED LAND USE **EXISTING ZONING:** SITE ACREAGE: PROPOSED NUMBER OF UNITS PROPOSED GROSS DENSITY

OPEN SPACE REQUIRED: OPEN SPACE PROVIDED: 25% CONTIGUOUS USABLE OPEN SPACE REQUIRED: 25% CONTIGUOUS USABLE OPEN SPACE PROVIDED:

765,693 SF (10% OF SITE AREA) 970,081 SF (12.7% OF SITE AREA) 191,423 SF 199.1 AC (Golf Course)

OWNER/DEVELOPER: 6385 CORPORATE DRIVE, STE. 200 COLORADO SPRINGS, CO 80919 ATTN: DREW BALSICK

PLANNER/LANDSCAPE ARCHITECT HR GREEN DEVELOPMENT, LLC. 1975 RESEARCH PARKWAY, STE. 160 COLORADO SPRINGS, CO 80920 ATTN: BLAINE PERKINS

CIVIL ENGINEER: HR GREEN DEVELOPMENT, LLC. 1975 RESEARCH PARKWAY, STE. 160 COLORADO SPRINGS, CO 80920 ATTN: RICHARD LYON, PE

EDWARD JAMES SURVEYING INC. 926 ELKTON DRIVE COLORADO SPRINGS, CO 80907 ATTN: JON TESSIN, PLS

6 S. TEJON ST. #618 COLORADO SPRINGS, CO 80903 ATTN: MIKE ROCHA

CONTACTS

880 INTERNATIONAL CIRCLE, STE. 110 COLORADO SPRINGS, CO 80910 ATTN: RYAN HOWSER

> 2880 INTERNATIONAL CIRCLE, STE. 110 COLORADO SPRINGS, CO 80910 ATTN: DANIEL TORRES. PE

> > NATURAL GAS BLACK HILLS ENERGY ATTN: ADAM MAGOON

MOUNTAIN VIEW ELECTRIC ASSOCIATION

ATTN: GINA PERRY

GENERAL NOTES:

MINOR CHANGES SUCH AS MINOR LOT OR TRACT LINE ADJUSTMENTS UPON FINAL ENGINEERING WILL NOT REQUIRE A PUD OR PRELIMINARY PLAN AMENDMENT 2. EL PASO COUNTY DOES NOT OWN AND IS NOT RESPONSIBLE FOR THE UNDERDRAINS OR GROUNDWATER DISCHARGE SYSTEMS SHOWN ON THESE PLANS AND ASSUMES NO

LIABILITY FOR WATER RIGHTS ADMINISTRATION BY APPROVING THESE PLANS. THERE SHALL BE NO DIRECT LOT ACCESS TO BLACK FOREST ROAD.

THE SUBDIVIDER / DEVELOPER HAS FAMILIARIZED ITSELF WITH THE CURRENT AMERICANS WITH DISABILITIES ACT (ADA) LAWS AND ACCESSIBILITY STANDARDS AND HAS LAID OUT THE PLAT AND ASSOCIATED GRADING AND CONSTRUCTION PLANS SO THAT ALL SITE ELEMENTS MEET THE APPLICABLE ADA DESIGN STANDARDS AS PUBLISHED BY THE UNITED STATES DEPARTMENT OF JUSTICE. APPROVAL OF THIS PLAT AND ASSOCIATED CONSTRUCTION DOCUMENTS BY EL PASO COUNTY DOES NOT ASSURE COMPLIANCE WITH THE ADA OR ANY REGULATIONS OR GUIDELINES ENACTED OR PROMULGATED UNDER OR WITH RESPECT TO SUCH LAWS. IT IS THE RESPONSIBILITY OF THE DEVELOPER / HOME BUILDER TO ENSURE ADA ACCESSIBILITY DURING CONSTRUCTION OF THE PRIVATE SIDEWALKS.

DEVELOPER SHALL COMPLY WITH FEDERAL AND STATE LAWS, REGULATIONS, ORDINANCES, REVIEW AND PERMIT REQUIREMENTS, AND OTHER AGENCY REQUIREMENTS, IF ANY, OF APPLICABLE AGENCIES INCLUDING, BUT NOT LIMITED TO, THE COLORADO DIVISION OF WILDLIFE, COLORADO DEPARTMENT OF TRANSPORTATION, U.S. ARMY CORPS OF ENGINEERS AND THE U.S. FISH AND WILDLIFE SERVICE REGARDING THE ENDANGERED SPECIES ACT, PARTICULARLY AS IT RELATES TO THE LISTED SPECIES (E.G. PREBLE'S **MEADOW JUMPING MOUSE).**

6. THE FOLLOWING AREAS HAVE BEEN FOUND TO BE IMPACTED BY POTENTIAL GEOLOGIC HAZARDS. MITIGATION MEASURES AND A MAP OF THE HAZARDS CAN BE FOUND IN THE REPORT ENTITLED SOIL AND GEOLOGY STUDY FLYING HORSE NORTH FILING NO. 4, ENTECH ENGINEERING, SEPTEMBER 11, 2024 IN FILE PUDSPXXXX AVAILABLE AT THE EL PASO

COUNTY PLANNING AND COMMUNITY DEVELOPMENT DEPARTMENT, POTENTIAL HAZARD AREAS ALSO MAPPED WITHIN THIS PUD. ARTIFICIAL FILL OF HOLOCENE AGE (MAN-PLACE FILL DEPOSITS ASSOCIATED):

5131000002

.27 DU/AC

AGRICULTURAL (VACANT)

175.78 AC - 100% RI

SINGLE FAMILY RESIDENTIAL

Previous not addressed ALLUVIUM OF HOLOCENE AGE (RECENT WATER DEPOSITED SEDIMENTS ALONG DRAINAGES)

COLLUVIUM OF QUATERNARY AGE OVERLYING THE DAWSON FORMATION OF TERTIARY TO CRETACEOUS AGE (SHEETWASH AND RESIDUAL SOIL DEPOSITS OVERLYING ARKOSIC SANDSTONE WITH INTERBEDDED CLAYSTONE AND SILTSTONE):

FEDERAL EMERGENCY MANAGEMENT AGENCY (FEMA), FLOOD INSURANCE RATE MAP NUMBER 08041CO315G, EFFECTIVE DATE, DECEMBER 7, 2018, INDICATES THE AREA IN THE VICINITY OF THIS PARCEL OF LAND TO BE A ZONE X (AREA DETERMINED TO BE OUT OF THE 500 YEAR FLOODPLAIN).

FINAL PLAT WILL SHOW EASEMENTS FOR DRAINAGE FACILITIES AND WATER QUALITY FACILITIES. EASEMENTS OR TRACTS FOR PONDS WILL BE SHOWN ON PRELIMINARY PLAN AND FINAL PLAT.


DDO IECT HISTORY TRACKER

PROJECT HISTORY TRACKER					
COUNTY FIL. NO.	PROJECT NAME	RECORDING NO.	RECORDING DATE		
PUD162	FLYING HORSE NORTH PLANNED UNIT DEVELOPMENT	217032585	3/22/2017		
PUDSP244	FLYING HORSE NORTH FILING NO. 4 PUD PRELIMINARY PLAN MINOR AMENDMENT	TBD	TBD		

OVERALL DEVELOPMENT DWELLING UNIT TRACKER*				
FILING	DWELLING UNITS			
1	81			
2	N/A			
3	51			
4	48			
TOTAL	180			

*PER THE APPROVED 2016 FLYING HORSE PUD PLAN, 283 RESIDENTIAL UNITS ARE ALLOWED.

LAND USE TABLE				
LAND USE	AREA (ACRES)	% OF LAND		
RESIDENTIAL	142.88 AC	81.3 %		
RIGHT-OF-WAY	10.60 AC	6.0 %		
TRACTS	22.27 AC	12.7 %		

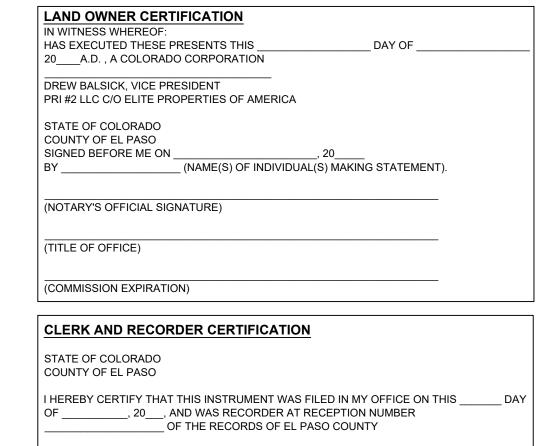

||COVER

EL PASO COUNTY CLERK AND RECORDER

EL PASO COUNTY CERTIFICATION

THIS PUD PRELIMINARY PLAN AMENDMENT (MINOR) FOR FLYING HORSE NORTH FILING NO. 4 WAS APPROVED BY THE EL PASO COUNTY, COLORADO PLANNING AND COMMUNITY DEVELOPMENT DEPARTMENT DIRECTOR ON THE DAY OF, , SUBJECT TO ANY NOTES OR CONDITIONS SPECIFIED HEREON. ALL PREVIOUS CONDITIONS OF APPROVAL AND NOTATIONS APPLY.

PLANNING AND COMMUNITY DEVELOPMENT DIRECTOR

SHEET INDEX 1 - COVER

2 - LEGAL 3 - TYPICAL ROADWAY SECTIONS

4 - ZONING MAP 5 - OVERALL SITE PLAN AND ADJACENT OWNERS

6 - SITE PLAN 1

7 - SITE PLAN 2 8 - SITE PLAN 3

9 - SITE PLAN 4

10 - 2016 PUD AMENDMENT - AREA OF CHANGE 11 - GEOLOGIC HAZARDS CONSTRAINT MAP

PCD FILE NO.: PUDSP244

DRAWN BY: <u>DLH</u> JOB DATE: 10/29/2024 OFFICIAL DRAWINGS APPROVED: KMH JOB NUMBER: <u>211030.140</u> IF NOT ONE INCH. CAD DATE: <u>11/1/2024</u> ADJUST SCALE ACCORDINGLY CAD FILE: J:\2021\211030\CAD\Dwgs\C\PUD-Amendment-F4\Cover

NO. DATE BY REVISION DESCRIPTION

HRGreen FAX: 713.965.0044

HR GREEN - COLORADO SPRINGS 1975 RESEARCH PARKWAY SUITE 230 COLORADO SPRINGS, CO 80920 PHONE: 719.300.4140

FLYING HORSE NORTH FILING NO. 4 PUD PRELIMINARY PLAN MINOR AMENDMENT PRI #2, LLC. EL PASO COUNTY, CO

Per previous

comment: Include the original preliminary

PUD PRELIMINARY PLAN MINOR AMENDMENT

DATE

FLYING HORSE NORTH FILING NO. 4

PUD PRELIMINARY PLAN

AN AMENDMENT TO FLYING HORSE NORTH PUD DEVELOPMENT PLAN / PRELIMINARY PLAN

A PORTION OF SECTIONS 34 (NE 1/4), 35 (NW 1/4, & NE 1/4) AND 36 TOWNSHIP 11 SOUTH, RANGE 66 WEST AND A PORTION OF SECTIONS 30 (SW 1/4, SE 1/4, & NE 1/4) AND 31 (SW 1/4, NW 1/4, & NE 1/4), TOWNSHIP 11 SOUTH, RANGE 65 WEST OF THE SIXTH PRINCIPAL MERIDIAN, COUNTY OF EL PASO, STATE OF COLORADO

LEGAL DESCRIPTION

FLYING HORSE NORTH FILING NO. 4

TWO (2) PARCELS OF LAND BEING A PORTION OF NORTHEAST QUARTER OF SECTION 36, TOWNSHIP 11 SOUTH, RANGE 66 WEST, A PORTION OF SOUTH HALF OF SECTION 30, AND A PORTION OF NORTH HALF OF SECTION 31, TOWNSHIP 11 SOUTH, RANGE 65 WEST THE SIXTH PRINCIPAL MERIDIAN, BEING MORE PARTICULARLY DESCRIBED AS FOLLOWS:

BASIS OF BEARINGS: THE NORTH LINE OF THE NORTHEAST QUARTER OF THE NORTHEAST QUARTER OF SECTION 36, TOWNSHIP 11 SOUTH, RANGE 66 WEST OF THE SIXTH PRINCIPAL MERIDIAN, BEING MONUMENTED AT THE WEST END BY A 1" YELLOW PLASTIC CAP STAMPED "18235" AND THE EAST END BY A 2" ALUMINUM CAP STAMPED "32439" WITH APPROPRIATE MARKINGS, IS ASSUMED TO BEAR N89°03'58"E A DISTANCE OF 1.332.09 FEET.

PARCEL 1:

COMMENCING AT THE NORTHWEST CORNER OF SECTION 31, TOWNSHIP 11 SOUTH, RANGE 65 WEST OF THE SIXTH PRINCIPAL MERIDIAN, SAID POINT BEING THE POINT OF BEGINNING; THENCE N89°06'20"E ON THE NORTH OF LINE OF THE NORTHWEST QUARTER OF THE NORTHWEST QUARTER OF SAID SECTION 31 A DISTANCE OF 1,474.13 FEET TO THE WEST SIXTEENTH CORNER OF SAID SECTION 31; THENCE N00°08'36"E ON THE WEST LINE OF THE SOUTHEAST QUARTER OF THE SOUTHWEST QUARTER OF SECTION 30, TOWNSHIP 15 SOUTH, RANGE 65 WEST OF THE SIXTH PRINCIPAL MERIDIAN, A DISTANCE OF 1325.48 FEET TO THE SOUTHWEST SIXTEENTH CORNER OF SAID SECTION 30; THENCE N89°03'20"E ON THE NORTH LINE OF THE SOUTHEAST QUARTER OF THE SOUTHWEST QUARTER OF SAID SECTION 30,, A DISTANCE OF 920.27 FEET; THENCE N00°08'15"E A DISTANCE OF 128.29 FEET; THENCE S55°57'42"E A DISTANCE OF 423.40 FEET; THENCE S13°57'08"E A DISTANCE OF 628.43 FEET TO A POINT ON THE NORTHERLY RIGHT-OF-WAY LINE OF OLD STAGECOACH ROAD AS PLATTED IN FLYING HORSE NORTH FILING NO.1. RECORDED UNDER RECEPTION NUMBER 218714238; THENCE ON SAID NORTHERLY RIGHT-OF-WAY LINE THE FOLLOWING SIX (6) COURSES:

- 1. S52°41'25"W A DISTANCE OF 1,517.83 FEET TO A POINT OF CURVE;
- 2. ON THE ARC OF A CURVE TO THE RIGHT HAVING A DELTA OF 52°50'29", A RADIUS OF 760.00 FEET A DISTANCE OF 700.92 FEET TO A POINT OF TANGENT.
- N74°28'06"W A DISTANCE OF 169.05 FEET TO A POINT OF CURVE;
 ON THE ARC OF A CURVE TO THE LEFT, HAVING A DELTA OF 32°53'45", A RADIUS OF 1,640.00 FEET, A DISTANCE OF 941.59 FEET TO A POINT OF
- 5. S72°38'09"W A DISTANCE OF 400.46 FEET TO A POINT OF CURVE;
- 6. ON THE ARC OF A CURVE TO THE RIGHT, HAVING A DELTA OF 00°45'53", A RADIUS OF 3,460.00 FEET A DISTANCE OF 46.18 FEET TO A POINT ON CURVE, SAID POINT BEING THE SOUTHEAST CORNER OF LOT 28 OF SAID FLYING HORSE NORTH FILING NO. 1;

THENCE N00°13'46"W ON THE EAST LINE OF SAID LOT 28, A DISTANCE OF 497.29 FEET TO A POINT ON THE NORTH LINE OF THE NORTHEAST QUARTER OF SECTION 36, TOWNSHIP 11 SOUTH, RANGE 66 WEST OF THE SIXTH PRINCIPAL MERIDIAN; THENCE N89°03'58"E ON SAID NORTH LINE A DISTANCE OF 491.20 FEET TO THE POINT OF BEGINNING.

CONTAINING A CALCULATED AREA OF 2,475,776 SQUARE FEET OR 56.836 ACRES, MORE OR LESS.

PARCEL 2:

COMMENCING AT THE SOUTHEAST CORNER OF LOT 80, FLYING HORSE NORTH FILING NO.1, RECORDED UNDER RECEPTION NUMBER 218714238, SAID POINT BEING ON THE WESTERLY LINE OF LOT 79, FLYING HORSE NORTH FILING NO. 1, SAID POINT BEING THE POINT OF BEGINNING; THENCE S00°00'00"E ON THE WEST LINE OF SAID LOT 79, A DISTANCE OF 477.97 FEET TO A POINT ON THE SOUTH LINE OF THE SOUTHEAST QUARTER OF SECTION 30, TOWNSHIP 11 SOUTH, RANGE 65 WEST OF THE SIXTH PRINCIPAL MERIDIAN.

THENCE S89°04'37"W, ON THE SOUTH LINE OF THE SOUTHEAST QUARTER OF THE SOUTHEAST QUARTER OF SAID SECTION 30, A DISTANCE OF 144.30 FEET TO THE EAST SIXTEENTH CORNER OF SECTION 31; THENCE S00°00'11"E, ON THE EAST LINE OF THE NORTHWEST QUARTER OF THE NORTHEAST QUARTER OF SAID SECTION 31, A DISTANCE OF 1,326.67 FEET TO THE NORTHEAST SIXTEENTH CORNER OF SAID SECTION 31; THENCE N89°08'21"E, ON THE NORTH LINE OF THE SOUTHEAST QUARTER OF THE NORTHEAST QUARTER OF SAID SECTION 31, A DISTANCE OF 1,289.57 FEET TO A POINT ON THE WESTERLY RIGHT OF WAY LINE OF BLACK FOREST ROAD, SAID POINT BEING 30.00 FEET WEST OF AND PARALLEL TO THE EAST LINE OF THE SOUTHEAST QUARTER OF THE NORTHEAST QUARTER OF SAID SECTION 31; THENCE S00°00'54"W, ON THE WESTERLY RIGHT OF WAY LINE OF SAID BLACK FOREST ROAD BEING ALSO 30.00 FEET WEST OF AND PARALLEL TO THE EAST LINE OF THE SOUTHEAST QUARTER OF THE NORTHEAST QUARTER OF SAID

SECTION 31, A DISTANCE OF 1,328.09 FEET TO A POINT ON THE SOUTH LINE OF THE SOUTHEAST QUARTER OF THE NORTHEAST QUARTER OF SAID SECTION 31; THENCE S89°11'15"W, ON THE SOUTH LINE OF THE NORTHEAST QUARTER OF SAID SECTION 31, A DISTANCE OF 2,327.40 FEET; THENCE N07°08'46"E A DISTANCE OF 860.74 FEET; THENCE N04°05'31"W A DISTANCE OF 1,388.17 FEET; THENCE N09°22'22"W A DISTANCE OF 488.58 FEET; THENCE N37°18'35"W A DISTANCE OF 402.75 FEET TO A POINT ON THE SOUTHERLY RIGHT-OF-WAY LINE OF OLD STAGECOACH ROAD AS PLATTED IN FLYING HORSE NORTH FILING NO.1, RECORDED UNDER RECEPTION NUMBER 218714238; THENCE ON THE BOUNDARY OF SAID FLYING HORSE NORTH FILING NO.1 THE FOLLOWING EIGHT (8) COURSES:

- 1. N52°41'25"E A DISTANCE OF 330.02 FEET TO A POINT OF CURVE;
- 2. ON THE ARC OF A CURVE TO THE RIGHT HAVING A DELTA OF 38°46'50", A RADIUS OF 960.00 FEET A DISTANCE OF 649.77 FEET TO A POINT OF TANGENT.
- 3. S88°31'45"E A DISTANCE OF 8.27 FEET TO A POINT ON CURVE;
- 4. ON THE ARC OF A CURVE TO THE LEFT WHOSE CENTER BEARS N67°53'33"E, HAVING A DELTA OF 48°57'51", A RADIUS OF 100.00 FEET A DISTANCE OF 85.46 FEET TO A POINT ON CURVE;
- 5. S01°28'15"W A DISTANCE OF 152.16 FEET TO A POINT OF CURVE;
- ON THE ARC OF A CURVE TO THE LEFT HAVING A DELTA OF 00°53'47", A
 RADIUS OF 5,030.00 FEET A DISTANCE OF 78.69 FEET TO A POINT ON CURVE;
 S89°25'32"E A DISTANCE OF 60.00 FEET;
- 8. N89°59'56"E A DISTANCE OF 505.80 FEET TO THE POINT OF BEGINNING

CONTAINING A CALCULATED AREA OF 5,181,149 SQUARE FEET OR 119.943 ACRES, MORE OR LESS.

PARCEL 1 AND PARCEL 2 CONTAIN A TOTAL CALCULATED AREA OF 7,656,925 SQUARE FEET OR 175.779 ACRES.

PCD FILE NO.: PUDSP24

 DRAWN BY:
 DLH
 JOB DATE:
 10/29/2024
 BAR IS ONE INCH ON OFFICIAL DRAWINGS.

 APPROVED:
 KMH
 JOB NUMBER:
 211030.140
 0
 1"

 CAD DATE:
 11/1/2024
 IF NOT ONE INCH, ADJUST SCALE ACCORDINGLY

 CAD FILE:
 J:\2021\211030\CAD\Dwgs\C\PUD-Amendment-F4\Cover

NO. DATE BY REVISION DESCRIPTION



HR GREEN - COLORADO SPRINGS 1975 RESEARCH PARKWAY SUITE 230 COLORADO SPRINGS, CO 80920 PHONE: 719.300.4140

FLYING HORSE NORTH FILING NO. 4
PUD PRELIMINARY PLAN MINOR AMENDMENT
PRI #2, LLC.
EL PASO COUNTY, CO


PUD PRELIMINARY PLAN MINOR AMENDMENT


SHEET


PUD PRELIMINARY PLAN MINOR AMENDMENT

A MINOR AMENDMENT TO THE 2016 FHN PUD


A PORTION OF SECTIONS 34 (NE 1/4), 35 (NW 1/4, & NE 1/4) AND 36 TOWNSHIP 11 SOUTH, RANGE 66 WEST AND A PORTION OF SECTIONS 30 (SW 1/4, SE 1/4, & NE 1/4) AND 31 (SW 1/4, NW 1/4, & NE 1/4), TOWNSHIP 11 SOUTH, RANGE 65 WEST OF THE SIXTH PRINCIPAL MERIDIAN, COUNTY OF EL PASO, STATE OF COLORADO

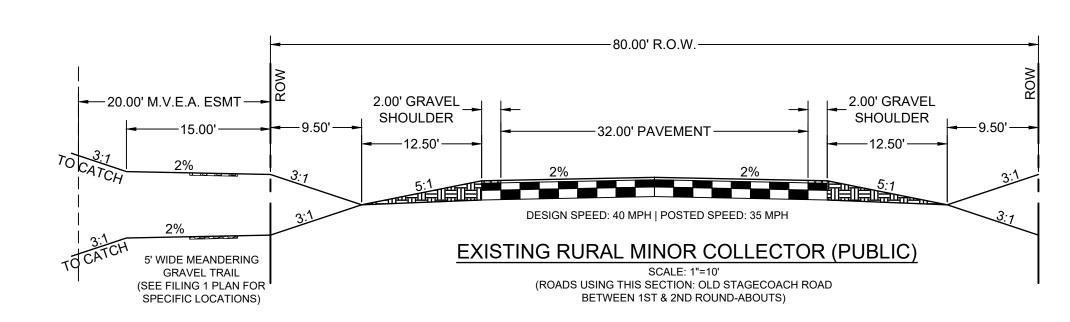

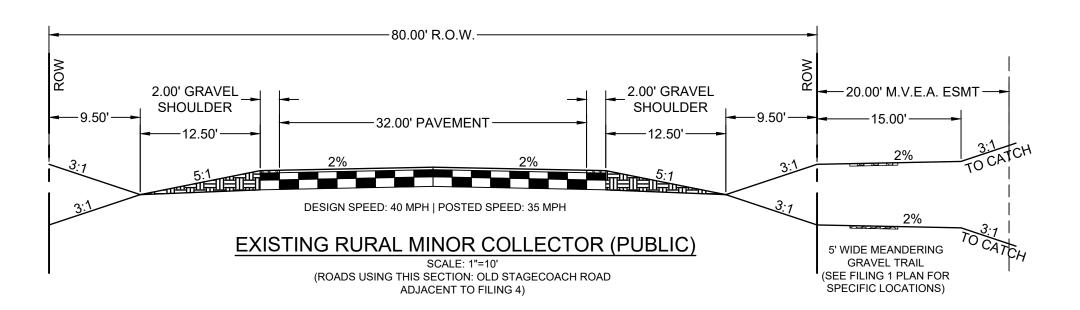

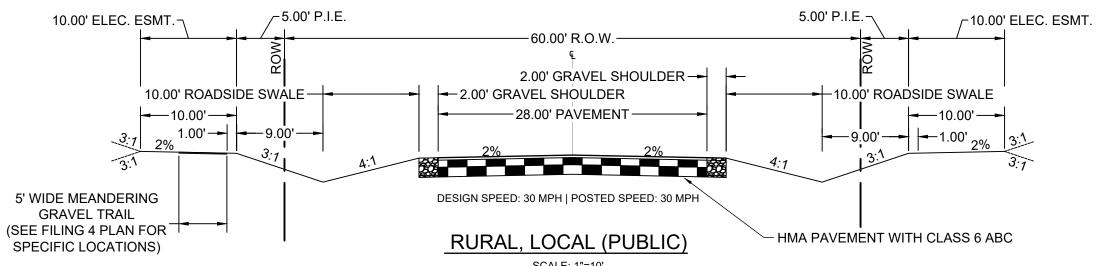

(ROADS USING THIS SECTION: RUBBLE DRIVE, GIMME WAY, STABLEFORD TERRACE, BUNKER TRAIL, FRINGE PLACE)

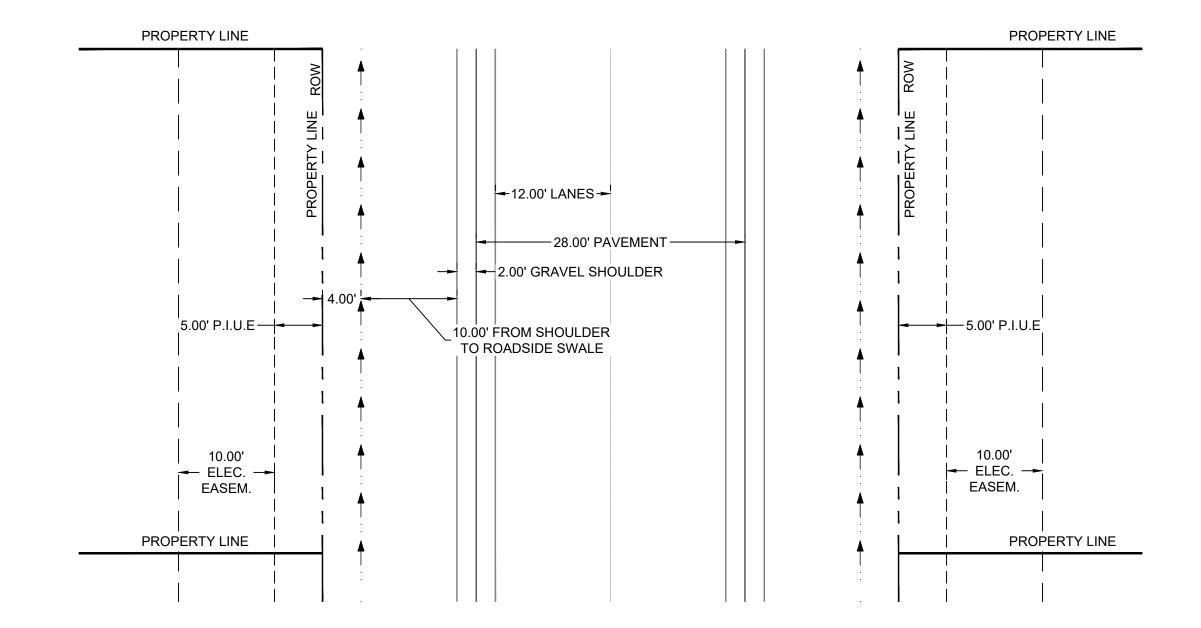

PCD FILE NO.: PUDSP244

BAR IS ONE INCH ON DRAWN BY: <u>DLH</u> JOB DATE: <u>9/16/2024</u> OFFICIAL DRAWINGS. APPROVED: KMH JOB NUMBER: <u>211030.140</u> IF NOT ONE INCH, ADJUST SCALE ACCORDINGLY. CAD DATE: <u>11/1/2024</u> CAD FILE: J:\2021\211030\CAD\Dwgs\C\PUD-Amendment-F4\Typ_lot_and_roads

NO. DATE BY REVISION DESCRIPTION



HR GREEN - COLORADO SPRINGS 1975 RESEARCH PARKWAY SUITE 230 COLORADO SPRINGS, CO 80920 PHONE: 719.300.4140 HRGreen FAX: 713.965.0044

FLYING HORSE NORTH FILING NO. 4 PUD PRELIMINARY PLAN MINOR AMENDMENT PRI #2, LLC. EL PASO COUNTY, CO

PUD PRELIMINARY PLAN MINOR AMENDMENT TYPICAL ROADWAY SECTIONS

SHEET TRS

