



VICINITY MAP OF NOTIFIED NEIGHBORS FOR 12610 CRUMP ROAD RURAL HOME OCCUPATION

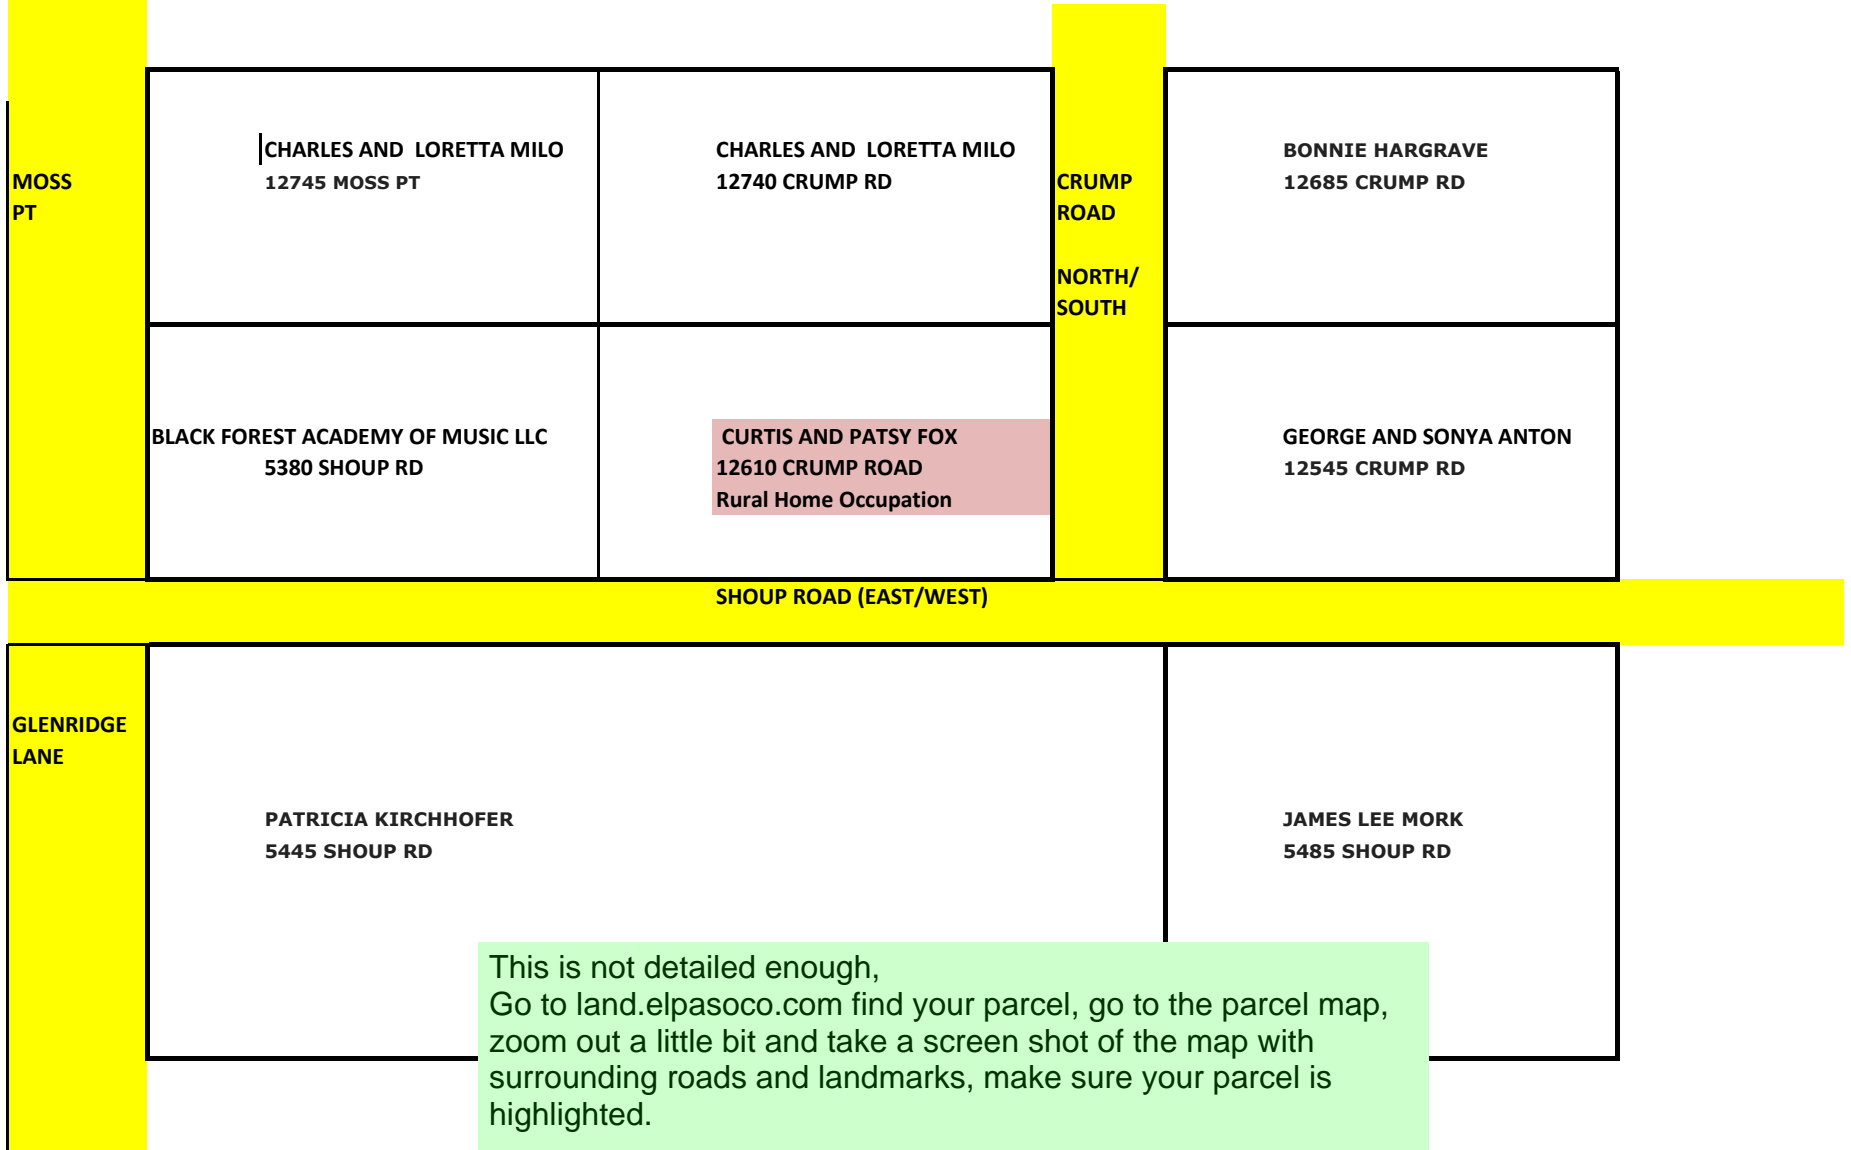

Markup Summary

dskendall (1)

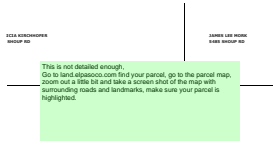

Subject: Text Box
Page Label: 1
Lock: Locked
Author: dskendall
Date: 12/28/2018 2:14:46 PM
Color: ■

This is not detailed enough, Go to land.elpasoco.com find your parcel, go to the parcel map, zoom out a little bit and take a screen shot of the map with surrounding roads and landmarks, make sure your parcel is highlighted.