

THE MARKETS AT BENT GRASS PRELIMINARY PLAN

A PORTION OF THE SOUTHWEST QUARTER OF SECTION 1 TOWNSHIP 13 SOUTH,
RANGE 65 WEST OF THE 6TH PRINCIPAL MERIDIAN, EL PASO COUNTY, COLORADO
NEC OF WOODMEN RD. & BENT GRASS MEADOWS DR., FALCON, COLORADO

SP262

GENERAL NOTES

- ALL EXISTING INFORMATION SHOWN HEREIN IS FROM AN ALTA SURVEY, PREPARED BY GALLOWAY & COMPANY, LLC, DATED 07/01/2025.
- ALL SITE GRADING, UTILITIES, AND PUBLIC ROADWAY CONNECTIONS WILL BE CONSTRUCTED IN ONE PHASE. FORTHCOMING PAD LOT DEVELOPMENTS WILL REQUIRE SEPARATE SITE DEVELOPMENT PLAN (PDR) APPLICATIONS SUBMITTED TO EL PASO COUNTY FOR REVIEW AND APPROVAL.
- NO RAILROAD RIGHTS-OF-WAY EXIST ON THE PROPERTY.
- NO MINERAL RESOURCE AREAS NOR HISTORIC OR ARCHEOLOGICAL SIGNIFICANT SITES WERE LOCATED ON THE PROPERTY.
- NO MAJOR ROCK OUTCROPPINGS NOR WOODED AREAS EXIST ON THE PROPERTY.
- THE PROPERTY IS SUBJECT TO THE FINDINGS, SUMMARY, AND CONCLUSIONS OF THE WETLAND DELINEATION REPORT BY BRISTLECONE ECOLOGY, LLC DATED 02/26/2026, IN FILE SP262 AVAILABLE AT THE EL PASO COUNTY DEVELOPMENT SERVICES DEPARTMENT.
- THE PROPERTY IS SUBJECT TO THE FINDINGS, SUMMARY, AND CONCLUSIONS OF THE NOXIOUS WEED MANAGEMENT PLAN BY BRISTLECONE ECOLOGY, LLC DATED 02/26/2026, IN FILE SP262 AVAILABLE AT THE EL PASO COUNTY DEVELOPMENT SERVICES DEPARTMENT.
- CROSS-LOT ACCESS AND PARKING WILL BE PROVIDED BY SHARED ACCESS EASEMENT PART OF THE FORTHCOMING FINAL PLAT APPLICATION.

FLOODPLAIN NOTES

- A PORTION OF THE SITE IS LOCATED WITH ZONE AE AS DETERMINED BY THE FLOOD INSURANCE RATE MAP (FIRM) NUMBER 0804100553G, EFFECTIVE DATE 12/7/2018. THE EFFECTIVE 100-YEAR FLOODPLAIN IS PRIMARILY LOCATED ON THE EASTERN SIDE OF THE SITE, AS DEPICTED ON THE PRELIMINARY DRAINAGE REPORT.
- A LETTER OF MAP REVISION (LOMR) IS IN PROCESS DUE TO RECENT CHANNEL IMPROVEMENTS TO THE UNANDED TRIBUTARY TO BLACK SQUIRREL CREEK NO. 2. THESE CHANNEL IMPROVEMENTS ARE ASSOCIATED WITH FALCON MEADOWS AT BENT GRASS DRAINAGE CHANNEL PROJECT (EPC FILE NOS. CR2114 & ASB2525). THE CORRECTED 100-YEAR FLOODPLAIN IS CONTAINED WITHIN PROPOSED TRACT A.
- ALL PROPOSED IMPROVEMENTS SHOWN IN THIS PRELIMINARY PLAN REMAIN OUTSIDE OF THE CORRECTED 100-YEAR FLOODPLAIN. THE LOMR IS EXPECTED TO BE PROCESSED WITH FEMA PRIOR TO CONSTRUCTION STARTING FOR THIS DEVELOPMENT. THEREFORE, NO FLOODPLAIN DEVELOPMENT PERMIT IS EXPECTED TO BE REQUIRED FOR THIS PROJECT.

SOILS & GEOLOGY NOTES

- THE PROPERTY(S) IS SUBJECT TO THE FINDINGS, SUMMARY, AND CONCLUSIONS OF THE GEOTECHNICAL AND SOILS EVALUATION REPORT BY VIVID ENGINEERING GROUP, DATED 02/25/2026. THE PROJECT SITE EXHIBITS NO GEOLOGIC HAZARDS THAT POSE A SIGNIFICANT RISK TO THE PROPOSED PROJECT OR ADJACENT PROPERTIES THAT CAN BE MITIGATED THROUGH PROPER LAND USAGE PLANNING, FOUNDATION DESIGN, ENGINEERING DESIGN, AND/OR CONSTRUCTION PRACTICE GENERALLY DISCUSSED IN SAID REPORT. RECOMMENDATIONS REGARDING MITIGATION OF THE IDENTIFIED POTENTIAL HAZARDS MUST BE ADDRESSED IN THE LOT SPECIFIC GEOTECHNICAL INVESTIGATION REPORT, OR THROUGH THE USE OF CURRENT BUILDING DESIGN CODES. ADDITIONAL RECOMMENDATIONS PERTINENT TO THIS DEVELOPMENT ARE PROVIDED IN SAID REPORT.
- THE FOLLOWING LOTS HAVE BEEN FOUND TO BE IMPACTED BY GEOLOGIC HAZARDS OR CONSTRAINTS. GEOLOGIC CONDITIONS CAN BE FOUND IN THE REPORT BY VIVID ENGINEERING GROUP, REVISION 1, DATED 08/08/2026, IN THE FILE SP262 AVAILABLE AT THE EL PASO COUNTY PLANNING AND COMMUNITY DEVELOPMENT DEPARTMENT.

POTENTIALLY SEASONALLY HIGH GROUNDWATER: LOTS 1-14 AND TRACTS A-D

OTHER HAZARDS OR CONSTRAINTS:

- POTENTIALLY LOOSE OR COMPRESSIBLE SOILS: LOTS 1, 2, 4-6, 9, 10, 13 AND TRACTS A & B
- CLAYS AND CLAYSTONE WITH LOW EXPANSION POTENTIAL: LOTS 1, 2, 7, 8, 11, 12 AND TRACTS B-D

*** SUBJECT TO SITE-SPECIFIC INVESTIGATIONS, IDENTIFIED HAZARDS AND CONSTRAINTS SHALL BE ADDRESSED BY PROJECT-SPECIFIC MITIGATION MEASURES. FUTURE DEVELOPERS OF IDENTIFIED LOTS SHOULD CONSIDER APPROPRIATE MITIGATION MEASURES FOR SHALLOW GROUNDWATER, SUCH AS INCORPORATING FOUNDATION DRAINAGE SYSTEMS.

LAND USE SUMMARY TABLE

USE	AREA (AC)	% OF LAND
COMMERCIAL	37.05	68.7%
DRAINAGE	1.44	2.7%
OPEN SPACE	12.31	22.8%
PUBLIC IMPROVEMENT	3.11	5.8%

LIST OF ABBREVIATIONS

SHT - SHEET
Δ - DEFLECTION ANGLE
L - LENGTH
R - RADIUS
CB - CHORD BEARING
C - CHORD LENGTH
N - NORTH/NORTHEAST
W - WEST
E - EAST/EASTING
S - SOUTH
DET - DETAIL
EX - EXISTING
W/ - WITH
PC - POINT OF CURVATURE/PORTLAND CEMENT
WVF - WELDED WIRE FABRIC
VERT - VERTICAL
OC - ON CENTER
FDC - FIRE DEPARTMENT CONNECTION
CT - COURT
DR - DRIVE
TYP - TYPICAL
REC - RECEPTION NUMBER
Ø, DIA - DIAMETER
PT - POINT OF TANGENCY
MIN - MINIMUM
MAX - MAXIMUM
HDPE - HIGH DENSITY POLYETHYLENE
REF - REFERENCE

*A REZONE MAP AMENDMENT APPLICATION WAS SUBMITTED TO EL PASO COUNTY TO REZONE THE EXISTING PARCEL 5301000016 FROM I-2 TO CR.

STANDARD EL PASO COUNTY PLAT NOTES

- THE FOLLOWING REPORTS HAVE BEEN SUBMITTED IN ASSOCIATION WITH THE PRELIMINARY PLAT: FINAL PLAT FOR THIS SUBDIVISION AND THE FINAL FILE AT THE COUNTY PLANNING AND COMMUNITY DEVELOPMENT DEPARTMENT: TRANSPORTATION IMPACT STUDY; DRAINAGE REPORT; WATER RESOURCES REPORT; WASTEWATER DISPOSAL REPORT; GEOTECHNICAL AND SOILS REPORT; FIRE PROTECTION REPORT; WILDLIFE HAZARD REPORT; NATURAL FEATURES REPORT.
- ALL PROPERTY OWNERS ARE RESPONSIBLE FOR MAINTAINING PROPER STORM WATER DRAINAGE IN AND THROUGH THEIR PROPERTY. PUBLIC DRAINAGE EASEMENTS AS SPECIFICALLY NOTED ON THE PLAT SHALL BE MAINTAINED BY THE INDIVIDUAL LOT OWNERS UNLESS OTHERWISE INDICATED. STRUCTURES, FENCES, MATERIALS OR LANDSCAPING THAT COULD IMPEDE THE FLOW OF RUNOFF SHALL NOT BE PLACED IN DRAINAGE EASEMENTS.
- DEVELOPER SHALL COMPLY WITH FEDERAL AND STATE LAWS, REGULATIONS, ORDINANCES, REVIEW AND PERMIT REQUIREMENTS, AND OTHER AGENCY REQUIREMENTS, IF ANY, OF APPLICABLE AGENCIES INCLUDING, BUT NOT LIMITED TO, THE COLORADO DIVISION OF WILDLIFE, COLORADO DEPARTMENT OF TRANSPORTATION, U.S. ARMY CORPS OF ENGINEERS AND THE U.S. FISH AND WILDLIFE SERVICE REGARDING THE ENDANGERED SPECIES ACT, PARTICULARLY AS IT RELATES TO THE LISTED SPECIES IDENTIFIED IN THE PROJECT'S ENVIRONMENTAL ASSESSMENT.
- THE ADDRESSES EXHIBITED ON THIS PLAT ARE FOR INFORMATIONAL PURPOSES ONLY. THEY ARE NOT THE LEGAL DESCRIPTION AND ARE SUBJECT TO CHANGE.
- NO DRIVEWAY SHALL BE ESTABLISHED UNLESS AN ACCESS PERMIT HAS BEEN GRANTED BY EL PASO COUNTY. MAILBOXES SHALL BE INSTALLED IN ACCORDANCE WITH ALL EL PASO COUNTY AND UNITED STATES POSTAL SERVICE REGULATIONS.
- NO LOT OR INTEREST THEREIN, SHALL BE SOLD, CONVEYED, OR TRANSFERRED WHETHER BY DEED OR BY CONTRACT, NOR SHALL BUILDING PERMITS BE ISSUED, UNTIL AND UNLESS EITHER THE REQUIRED PUBLIC AND COMMON DEVELOPMENT IMPROVEMENTS HAVE BEEN CONSTRUCTED AND COMPLETED AND PRELIMINARILY ACCEPTED IN ACCORDANCE WITH THE SUBDIVISION IMPROVEMENTS AGREEMENT BETWEEN THE APPLICANT/OWNER AND EL PASO COUNTY AS RECORDED UNDER RECEPTION NUMBER _____ IN THE OFFICE OF THE CLERK AND RECORDER OF EL PASO COUNTY, COLORADO OR, IN THE ALTERNATIVE, OTHER COLLATERAL IS PROVIDED TO MAKE PROVISION FOR THE COMPLETION OF SAID IMPROVEMENTS IN ACCORDANCE WITH THE EL PASO COUNTY LAND DEVELOPMENT CODE AND ENGINEERING CRITERIA MANUAL. ANY SUCH ALTERNATIVE COLLATERAL MUST BE APPROVED BY THE BOARD OF COUNTY COMMISSIONERS OR, IF PERMITTED BY THE SUBDIVISION IMPROVEMENTS AGREEMENT, BY THE PLANNING AND COMMUNITY DEVELOPMENT DEPARTMENT DIRECTOR AND MEET THE POLICY AND PROCEDURE REQUIREMENTS OF EL PASO COUNTY PRIOR TO THE RELEASE BY THE COUNTY OF ANY LOTS FOR SALE, CONVEYANCE OR TRANSFER.
- THIS PLAT RESTRICTION MAY BE REMOVED OR RESCINDED BY THE BOARD OF COUNTY COMMISSIONERS OR, IF PERMITTED BY THE SUBDIVISION IMPROVEMENTS AGREEMENT, BY THE PLANNING AND COMMUNITY DEVELOPMENT DEPARTMENT DIRECTOR UPON EITHER APPROVAL OF AN ALTERNATIVE FORM OF COLLATERAL OR COMPLETION AND PRELIMINARY ACCEPTANCE, BY THE EL PASO BOARD OF COUNTY COMMISSIONERS OF ALL IMPROVEMENTS REQUIRED TO BE CONSTRUCTED IN ACCORDANCE WITH SAID SUBDIVISION IMPROVEMENTS AGREEMENT. THE PARTIAL RELEASE OF LOTS FOR SALE, CONVEYANCE OR TRANSFER MAY ONLY BE GRANTED IN ACCORDANCE WITH ANY PLANNED PARTIAL RELEASE OF LOTS AUTHORIZED BY THE SUBDIVISION IMPROVEMENTS AGREEMENT.

THE SUBDIVIDER(S) AGREES ON BEHALF OF HIM/HERSELF AND ANY DEVELOPER OR BUILDER SUCCESSORS AND ASSIGNEES THAT SUBDIVIDER AND/OR SAID SUCCESSORS AND ASSIGNS SHALL BE REQUIRED TO PAY TRAFFIC IMPACT FEES IN ACCORDANCE WITH THE EL PASO COUNTY ROAD IMPACT FEE PROGRAM RESOLUTION, RESOLUTION NO. 19-4711, OR ANY AMENDMENTS THERETO, AT OR PRIOR TO THE TIME OF BUILDING PERMIT SUBMITTAL. THE FEE OBLIGATION, IF NOT PAID AT FINAL PLAT RECORDING, SHALL BE DOCUMENTED ON ALL SALES DOCUMENTS AND ON PLAT NOTES TO ENSURE THAT A TITLE SEARCH WOULD FIND THE FEE OBLIGATION BEFORE SALE OF THE PROPERTY.

10. THE PRIVATE ROADS AS SHOWN ON THIS PLAT WILL NOT BE MAINTAINED BY EL PASO COUNTY UNTIL AND UNLESS THE STREETS ARE CONSTRUCTED IN CONFORMANCE WITH EL PASO COUNTY STANDARDS IN EFFECT AT THE DATE OF THE REQUEST FOR DEDICATION AND MAINTENANCE.

11. DEVELOPER IS RESPONSIBLE FOR OPERATION & MAINTENANCE OF ALL PRIVATE ROAD EASEMENTS.

12. DUE TO HIGH GROUNDWATER IN THE AREA, ALL FOUNDATIONS SHALL INCORPORATE AN UNDERGROUND DRAINAGE SYSTEM.

13. WOODMEN ROAD DISTRICT NOTE: ALL PROPERTY WITHIN THIS SUBDIVISION IS WITHIN THE BOUNDARIES OF THE WOODMEN ROAD METROPOLITAN DISTRICT AND, AS SUCH, IS SUBJECT TO A MILL LEVY, PLATING FEES AND BUILDING PERMIT FEES FOR THE PURPOSE OF FINANCING CONSTRUCTION OF SPECIFIED IMPROVEMENTS TO WOODMEN ROAD.

14. WATER AND WASTEWATER SERVICE FOR THIS SUBDIVISION IS PROVIDED BY THE DISTRICT (WHM) SUBJECT TO THE DISTRICT'S RULES, REGULATIONS AND SPECIFICATIONS. SUBDIVIDER/DEVELOPER IS RESPONSIBLE FOR EXTENDING UTILITIES TO EACH LOT OR TRACT.

15. UNLESS OTHERWISE INDICATED, ALL SIDE, FRONT, AND REAR LOT LINES ARE HEREBY PLATTED ON EITHER SIDE WITH A 10 FOOT (USE 5 FEET FOR LOTS SMALLER THAN 2.5 ACRES) PUBLIC UTILITY AND DRAINAGE EASEMENT UNLESS OTHERWISE INDICATED. ALL EXTERIOR SUBDIVISION BOUNDARIES ARE HEREBY PLATTED WITH A 20 FOOT (USE 7 FEET FOR LOTS SMALLER THAN 2.5 ACRES) PUBLIC UTILITY AND DRAINAGE EASEMENT. THE SOLE RESPONSIBILITY FOR MAINTENANCE OF THESE EASEMENTS IS HEREBY VESTED WITH THE INDIVIDUAL PROPERTY OWNERS.



Gas and Electric: The subdivider/developer is responsible for extending utilities to each lot, tract or building site.

Gas and electric service for this subdivision is provided by _____ (Provider name(s)) subject to the District's (Providers) rules, regulations and specifications. (Combined note, which can be broken into separate notes for gas or electric in the case of different providers)

NOTES ADDED.

REVISED ACCORDINGLY.

Please add: PCD File CR261

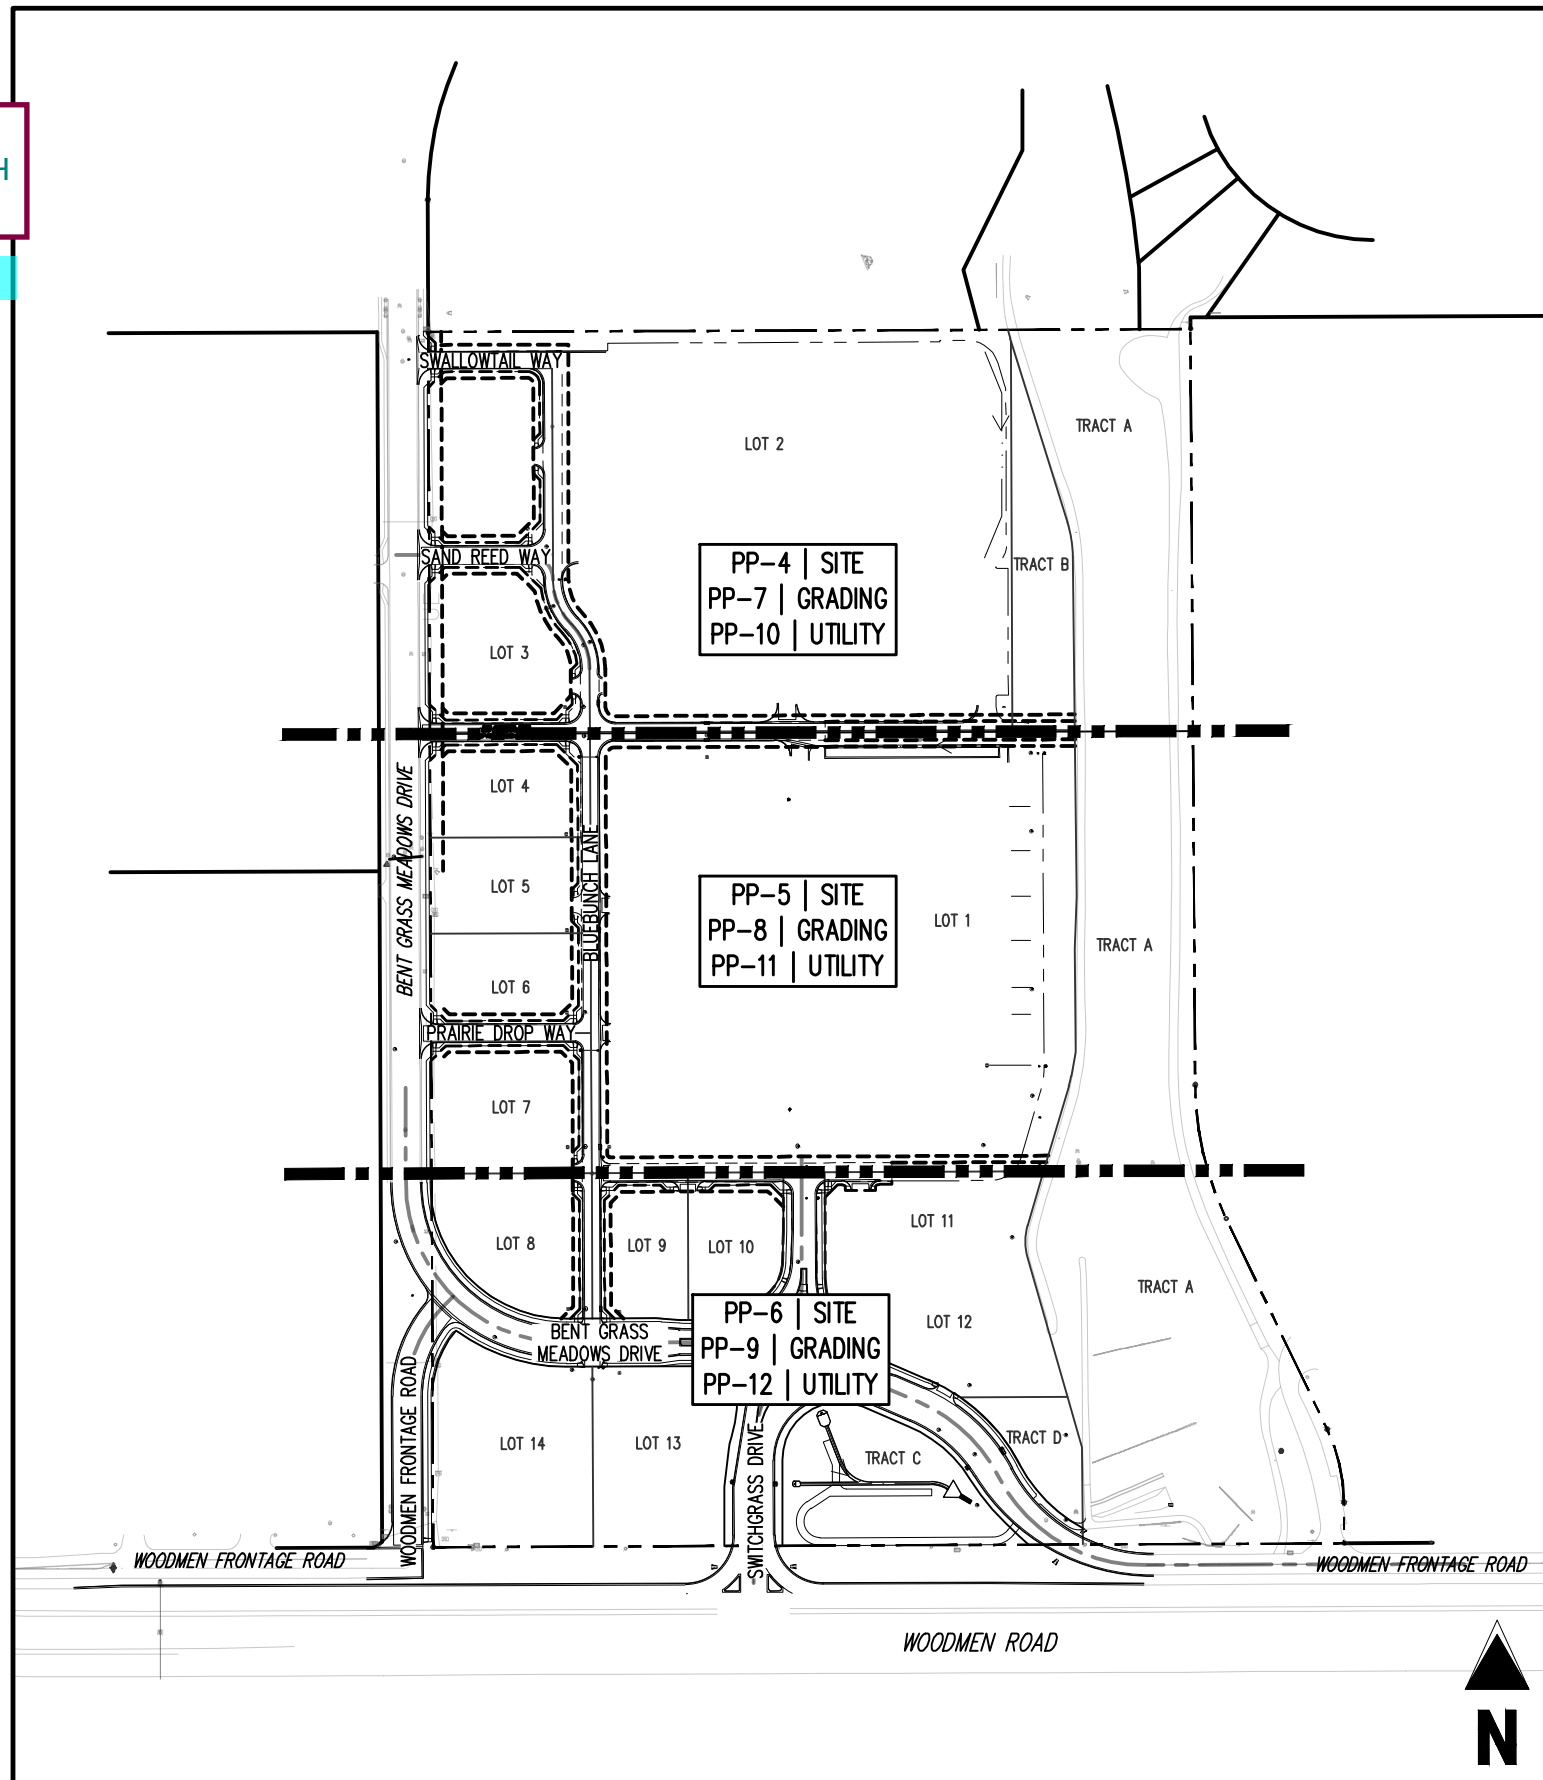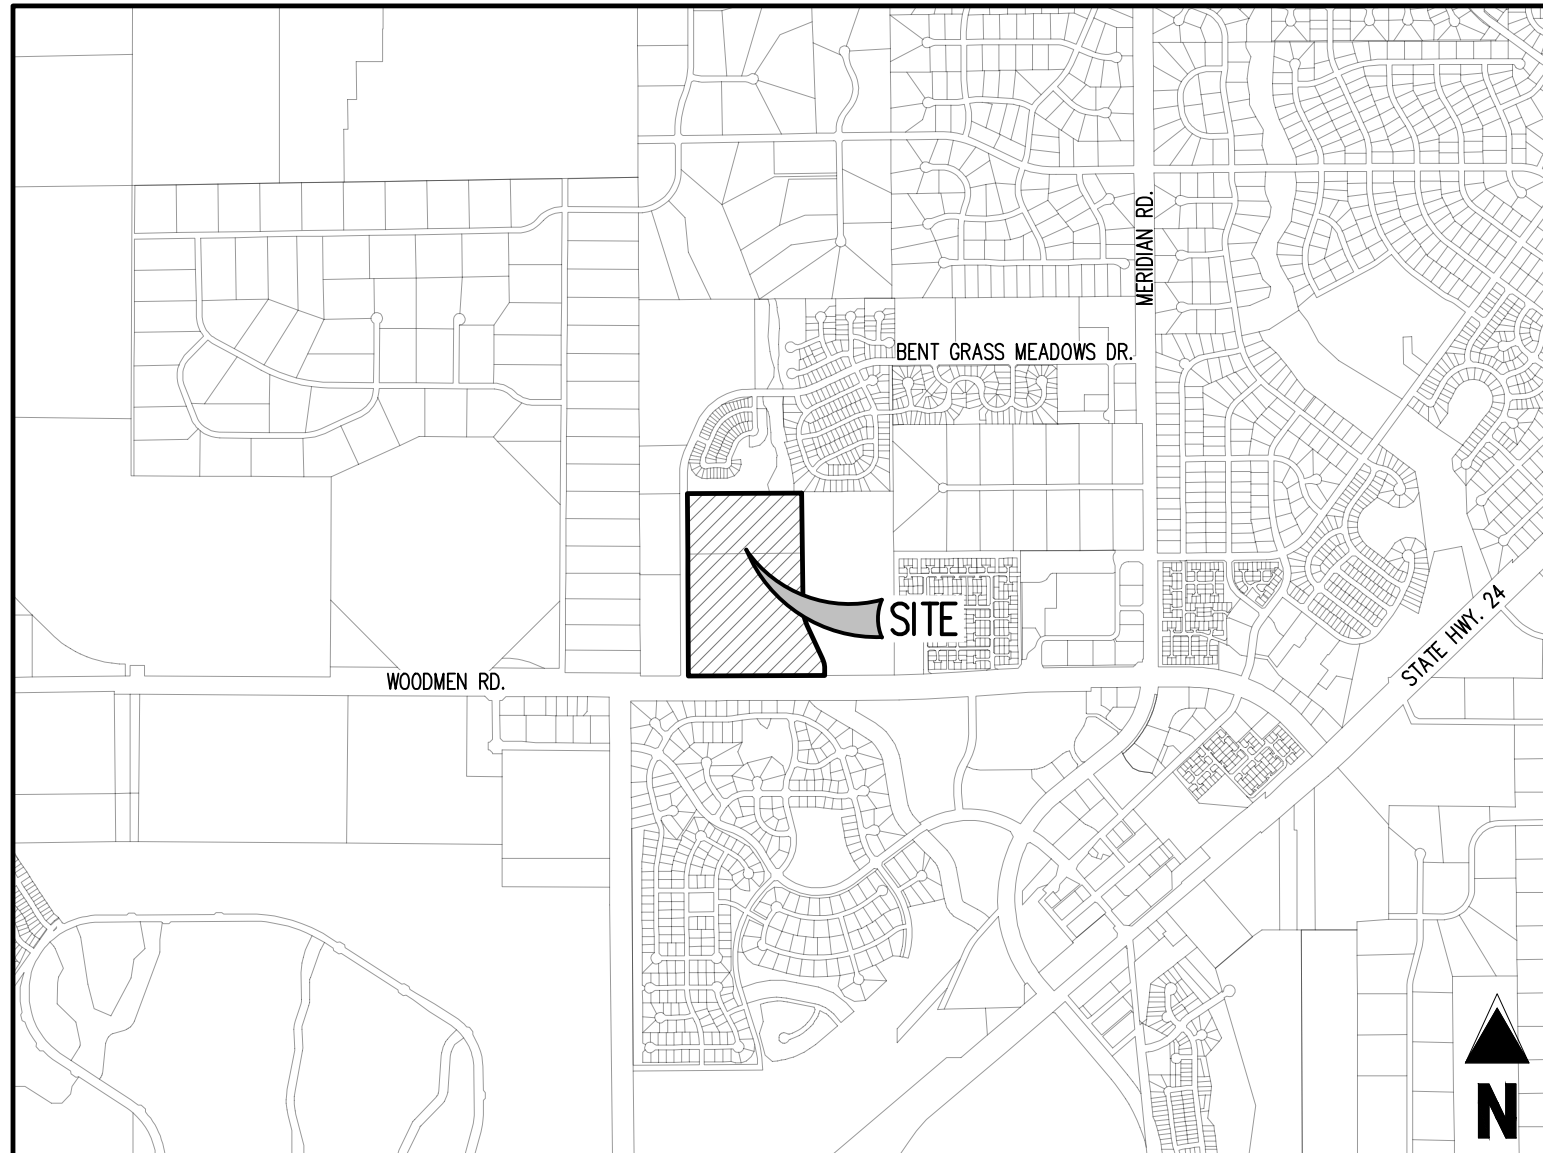

SITE & KEY MAP

SCALE: 1"=300'

SHEET INDEX		
SHEET NO.	DESCRIPTION	SHEET TITLE
1	PP-1	COVER SHEET
2	PP-2	TYPICAL ROADWAY SECTIONS
3	PP-3	LOT & TRACT PLAN
4	PP-4	PRELIMINARY SITE PLAN
5	PP-5	PRELIMINARY SITE PLAN
6	PP-6	PRELIMINARY SITE PLAN
7	PP-7	PRELIMINARY GRADING PLAN
8	PP-8	PRELIMINARY GRADING PLAN
9	PP-9	PRELIMINARY GRADING PLAN
10	PP-10	PRELIMINARY UTILITY PLAN
11	PP-11	PRELIMINARY UTILITY PLAN
12	PP-12	PRELIMINARY UTILITY PLAN

SITE DATA TABLE			
EXISTING			
TAX SCHEDULE NO.	ACREAGE	ZONE DISTRICT	LAND USE
5301000016	17.173	I-2*	VACANT
5301000017	36.741	CR	VACANT
5301002007			
TOTAL	53.914	-	-
DRAINAGE BASIN:	FALCON		
SKETCH PLAN:	N/A		
PROPOSED			
DEVELOPMENT SCHEDULE:	SPRING 2027		
LAND USE & OWNERSHIP/MAINTENANCE:	SEE SHEET PP-3		
ZONE DISTRICT:	CR		
GROSS DENSITY; NET DENSITY:	N/A		
LANDSCAPE SETBACKS:	25 FT MAJOR ARTERIAL (WOODMEN ROAD), 20 FT MAJOR ARTERIALS (BENT GRASS MEADOWS DRIVE, WOODMEN FRONTAGE ROAD); 10-FT ALL OTHER NON-ARTERIALS		
BUILDING SETBACKS:	FRONT: 50-FT; REAR: 25-FT; SIDE (STREET): 25-FT; SIDE (INTERIOR): 0-FT		
MIN. LOT SIZE	N/A		
MAX BUILDING HEIGHT	45'-0"		
MAX LOT COVERAGE	N/A		

PROJECT CONTACTS

DEVELOPER & APPLICANT

EVERGREEN DEVELOPMENT
1873 SOUTH BELLARE ST., SUITE 1200
DENVER, CO 80222
CONTACT: SEAN MURPHY
EMAIL: SMURPHY@EVERGREENDEV.COM
TEL: (303) 757-0414

CIVIL ENGINEER

GALLOWAY & COMPANY, LLC
1155 KELLY JOHNSON BLVD., SUITE 305
COLORADO SPRINGS, CO 80920
CONTACT: JEFFREY ODOR, PE
EMAIL: JEFFREY.ODOR@GALLOWAYUS.COM
TEL: (719) 308-2519

SURVEYOR

GALLOWAY & COMPANY, INC.
1155 KELLY JOHNSON BLVD., SUITE 305
COLORADO SPRINGS, CO 80920
CONTACT: BRIAN DENNIS, PLS
EMAIL: BRIANDENNIS@GALLOWAYUS.COM
TEL: (719) 900-7232

TRAFFIC ENGINEER

SM ROCHA, LLC
6 SOUTH TEJON STREET, SUITE 618
COLORADO SPRINGS, COLORADO 80903
CONTACT: MIKE ROCHA
EMAIL: MIKE@SMROCHA.COM
TEL: (719) 203-6639

GEOTECHNICAL ENGINEER

VIVID ENGINEERING GROUP
1053 ELKTON DRIVE
COLORADO SPRINGS, CO 80907
CONTACT: NATE LOWMEYER, PE
EMAIL: NLOWMEYER@VIVIDENGINEERING.COM
TEL: (719) 896-4356

ECOLOGIST

BRISTLECONE ECOLOGY, LLC
2023 W SCOTT PLACE
DENVER, CO 80211
CONTACT: DAN MAYNARD
EMAIL: DMAYNARD@BRISTLECONEECOLOGY.COM
TEL: (971) 237-3906

AGENCY CONTACTS

EL PASO COUNTY

EL PASO COUNTY PLANNING & COMMUNITY DEVELOPMENT
2880 INTERNATIONAL CIRCLE, SUITE 110
COLORADO SPRINGS, CO 80910
CONTACT: LAURA J. HUTTON
EMAIL: LAURA.HUTTON@ELPASO.CO.GOV
TEL: (719) 520-6449 - 6300

FIRE PROTECTION

FALCON FIRE PROTECTION DISTRICT
7030 OLD MERIDIAN RD.
FALCON, CO 80831
CONTACT: TRENT HAWING
EMAIL: TRENT.HAWING@FALCONFIREPRO.ORG
TEL: (719) 495-4050

WATER

WOODMEN HILLS METRO DISTRICT
8046 EASTONVILLE ROAD
FALCON, CO 80831
CONTACT: CODY RITTER
EMAIL: CODY@WHMID.ORG
TEL: (719) 495-2500

WASTEWATER

WOODMEN HILLS METRO DISTRICT
8046 EASTONVILLE ROAD
FALCON, CO 80831
CONTACT: CODY RITTER
EMAIL: CODY@WHMID.ORG
TEL: (719) 495-2500

ELECTRIC

MOUNTAIN VIEW ELECTRIC ASSOCIATION, INC.
11140 E WOODMEN RD.
FALCON, CO 80831
CONTACT: LAURA J. HUTTON
EMAIL: LAURA.HUTTON@MVEA.ORG
TEL: (800) 388-9881

GAS

COLORADO SPRINGS UTILITIES
1521 SOUTH HANCOCK EXPRESSWAY, MC 1812
COLORADO SPRINGS, CO 80921
CONTACT: BLANCHE M. LUDKER
EMAIL: BLANCHE.M.LUDKER@CSUTILITIES.ORG
TEL: (719) 668-8259

Please remove on this page and throughout the plan.

REVISED ACCORDINGLY.

BASIS OF BEARING

ALL BEARINGS ARE GRID BEARINGS OF THE COLORADO STATE PLANE COORDINATE SYSTEM, CENTRAL ZONE, NORTH AMERICAN DATUM 1983. THE SOUTH LINE OF THE SOUTHWEST QUARTER OF SECTION 1, TOWNSHIP 13 SOUTH, RANGE 65 WEST BEARS N89°45'24"E, MONUMENTED BY THE SOUTHWEST CORNER OF SAID SECTION 1, BEING A 2-1/2" ALUMINUM CAP IN RANGE BOX STAMPED "DIXIEE BARREL 1985 LS 17664", AND MONUMENTED BY THE SOUTH QUARTER CORNER OF SAID SECTION 1, BEING A 2-1/2" ALUMINUM CAP IN RANGE BOX STAMPED "1985 LS 17664".

BENCHMARK

COLORADO SPRINGS UTILITIES (CSU) FACILITIES INFORMATION MANAGEMENT SYSTEM (FIMS) BENCHMARK BL75, BEING A 2" ALUMINUM CAP IN CONCRETE HEADWALL ON THE SOUTH SIDE OF E. WOODMEN ROAD, 1,600 FEET WEST OF THE INTERSECTION OF FOXTAIL MEADOW LANE. NGVD29 ELEVATION: 6892.53

SITE BENCHMARK #1:

CHISELED CROSS IN CONCRETE INLET SHOWN HEREIN. NGVD29 ELEVATION: 6920.74

SITE BENCHMARK #2:

NAIL WITH 1-1/2" ALUMINUM DISC STAMPED "CSAM LLC PLS 32439". NGVD29 ELEVATION: 6899.33

LEGAL DESCRIPTION

NOTE: THE BASES OF BEARING FOR THIS PROJECT DIFFERS FROM THE RECORDED DEED BY -03°148". THE PROVIDED LEGAL DESCRIPTION IS CONSISTENT WITH THE RECORDED DEED. BEARINGS SHOWN IN THESE PLANS ARE BASED ON THE BASIS OF BEARING IDENTIFIED WITHIN THESE PLANS.

A PARCEL OF LAND DESCRIBED IN SPECIAL WARRANTY DEED RECORDED AT RECEPTION NUMBER 207122803, AND DESCRIBED AS FOLLOWS:

A PARCEL OF LAND BEING THAT PORTION OF SECTION 1, TOWNSHIP 13 SOUTH, RANGE 65 WEST OF THE 6TH P.M., EL PASO COUNTY, COLORADO, DESCRIBED AS FOLLOWS:

BEGINNING AT THE NORTHEAST CORNER OF LATIGO BUSINESS CENTER FILING NO. 1 (RECEPTION NO. 205075726, EL PASO COUNTY, COLORADO RECORDS) (ALL BEARINGS IN THIS DESCRIPTION ARE RELATIVE TO THE NORTHERLY LINE OF SAID FILING, WHICH BEARS S 89 DEGREES 42 MINUTES 50 SECONDS E ASSUMED); THENCE S 89 DEGREES 42 MINUTES 50 SECONDS E ALONG THE EASTERLY EXTENSION OF SAID FILING'S NORTHERLY LINE, 1190.72 FEET TO A POINT ON THE EASTERLY LINE OF THAT INGRESS/EGRESS AND UTILITY EASEMENT AS DESCRIBED BY DOCUMENT (BOOK 3268, PAGE 517, SAID EL PASO COUNTY RECORDS); THENCE S 00 DEGREES 07 MINUTES 47 SECONDS W ALONG SAID EASEMENT'S EASTERLY LINE, 627.84 FEET; THENCE N 89 DEGREES 42 MINUTES 50 SECONDS W, 1192.23 FEET TO A POINT ON THE EASTERLY LINE OF SAID FILING; THENCE N 00 DEGREES 16 MINUTES 02 SECONDS E ALONG SAID FILING'S EASTERLY LINE, 627.84 FEET TO THE POINT OF BEGINNING.

TOGETHER WITH A PARCEL OF LAND DESCRIBED IN WARRANTY DEED RECORDED AT RECEPTION NUMBER 219113681, AND DESCRIBED AS FOLLOWS:

A PORTION OF THE SOUTHWEST ONE-QUARTER OF SECTION 1, TOWNSHIP 13 SOUTH, RANGE 65 WEST OF THE 6TH P.M., ALSO BEING A PORTION OF LOT 2, LATIGO BUSINESS & RESEARCH CENTER FILING NO. 1 (PLAT BOOK M-3, PAGE 76, EL PASO COUNTY, COLORADO RECORDS), SITUATE IN EL PASO COUNTY, COLORADO, DESCRIBED AS FOLLOWS:

COMMENCING AT THE SOUTHEAST CORNER OF LATIGO BUSINESS CENTER FILING NO. 1 (RECEPTION NO. 205075726, SAID EL PASO COUNTY RECORDS) (ALL BEARINGS IN THIS DESCRIPTION ARE RELATIVE TO THE EASTERLY LINE OF SAID FILING, WHICH BEARS NORTH 00 DEGREES 16 MINUTES 02 SECONDS EAST ASSUMED);

THENCE NORTH 00 DEGREES 16 MINUTES 02 SECONDS EAST ALONG SAID FILING'S EASTERLY LINE, 30.00 FEET TO THE POINT OF BEGINNING OF THE PARCEL HEREIN DESCRIBED;

THENCE CONTINUE NORTH 00 DEGREES 16 MINUTES 02 SECONDS EAST ALONG SAID EASTERLY LINE, 1270.75 FEET;

THENCE SOUTH 89 DEGREES 42 MINUTES 50 SECONDS EAST, 1192.23 FEET TO A POINT ON THE EASTERLY LINE OF THAT INGRESS/EGRESS EASEMENT DESCRIBED BY DOCUMENT (BOOK 3268, PAGE 517, SAID RECORDS) (THE FOLLOWING FIVE (5) COURSES ARE ALONG SAID EASEMENT'S EASTERLY LINE);

1) SOUTH 00 DEGREES 07 MINUTES 47 SECONDS WEST, 552.54 FEET;

2) ON A CURVE TO THE LEFT, SAID CURVE HAVING A CENTRAL ANGLE OF 25 DEGREES 15 MINUTES 43 SECONDS, A RADIUS OF 490.87 FEET, AN ARC LENGTH OF 216.43 FEET;

3) SOUTH 25 DEGREES 07 MINUTES 56 SECONDS EAST, 365.00 FEET;

4) ON A CURVE TO THE RIGHT, SAID CURVE HAVING A CENTRAL ANGLE OF 25 DEGREES 25 MINUTES 06 SECONDS, A RADIUS OF 266.04 FEET, AN ARC LENGTH OF 118.02 FEET;

5) SOUTH 00 DEGREES 17 MINUTES 10 SECONDS WEST, 65.00 FEET TO A POINT ON THE NORTHERLY RIGHT-OF-WAY LINE OF WOODMEN ROAD (60' R.O.W.);

THENCE NORTH 89 DEGREES 42 MINUTES 50 SECONDS WEST ALONG SAID WOODMEN ROAD'S NORTHERLY RIGHT-OF-WAY LINE, 1423.26 FEET TO THE POINT OF BEGINNING.

TOTAL PROPERTY AREA: 533.914 ACRES

SURVEY NOTES

- ANY PERSON WHO KNOWINGLY REMOVES, ALTERS OR DEFACES ANY PUBLIC LAND SURVEY MONUMENT OR LAND BOUNDARY MONUMENT OR ACCESSORY COMBATS A CLASS TWO (2) MISDEMEANOR PURSUANT TO C.R.S. §18-4-508.

OWNER OF RECORD

LENA GAL CASE
119 N WAWATCH AVE
COLORADO SPRINGS, CO 80903

OWNER OF RECORD

CYNTHIA BEYOND
10924 E HIGHWAY 24
Peyton, CO 80831

APPLICANT

EVERGREEN DEVCO, INC.
1873 SOUTH BELLARE ST., SUITE 1200
DENVER, CO 80222
TEL: (303) 757-0414

PLAN PREPARER

JEFFREY ODOR
GALLOWAY & CO. LLC
1155 KELLY JOHNSON BLVD., SUITE 305
COLORADO SPRINGS, CO 80920
TEL: (719) 308-2519

BASED ON SURVEY PERFORMED BY GALLOWAY & COMPANY, LLC ON 07/01/2025

Galloway

1155 Kelly Johnson Blvd., Suite 305
Colorado Springs, CO 80920
719.900.7220
GallowayUS.com

Galloway & Company, LLC

PRELIMINARY
NOT FOR BIDDING
NOT FOR CONSTRUCTION

Evergreen
Multi-family Retail Industrial



PRELIMINARY PLAN
THE MARKETS AT BENT GRASS
EVERGREEN DEVELOPMENT
EPC FILE #: SP262

NEC OF WOODMEN RD. & BENT GRASS MEADOWS DR.
FALCON, COLORADO

Date Issue / Description Init.

03/04/2026 1ST PRELIMINARY PLAN SUBMITTAL

06/22/2026 2ND PRELIMINARY PLAN SUBMITTAL

06/22/2026 2ND PRELIMINARY PLAN SUBMITTAL


06/22

THE MARKETS AT BENT GRASS

A PORTION OF THE SOUTHWEST QUARTER OF SECTION 1 TOWNSHIP 13 SOUTH,
RANGE 65 WEST OF THE 6TH PRINCIPAL MERIDIAN, EL PASO COUNTY, COLORADO


NOTE:

IT IS INTENDED TO MAINTAIN THE EXISTING ROAD SECTION AS CONSTRUCTED. THE EXISTING ATTACHED SIDEWALK WILL BE REMOVED AND A DETACHED SIDEWALK CONSTRUCTED.

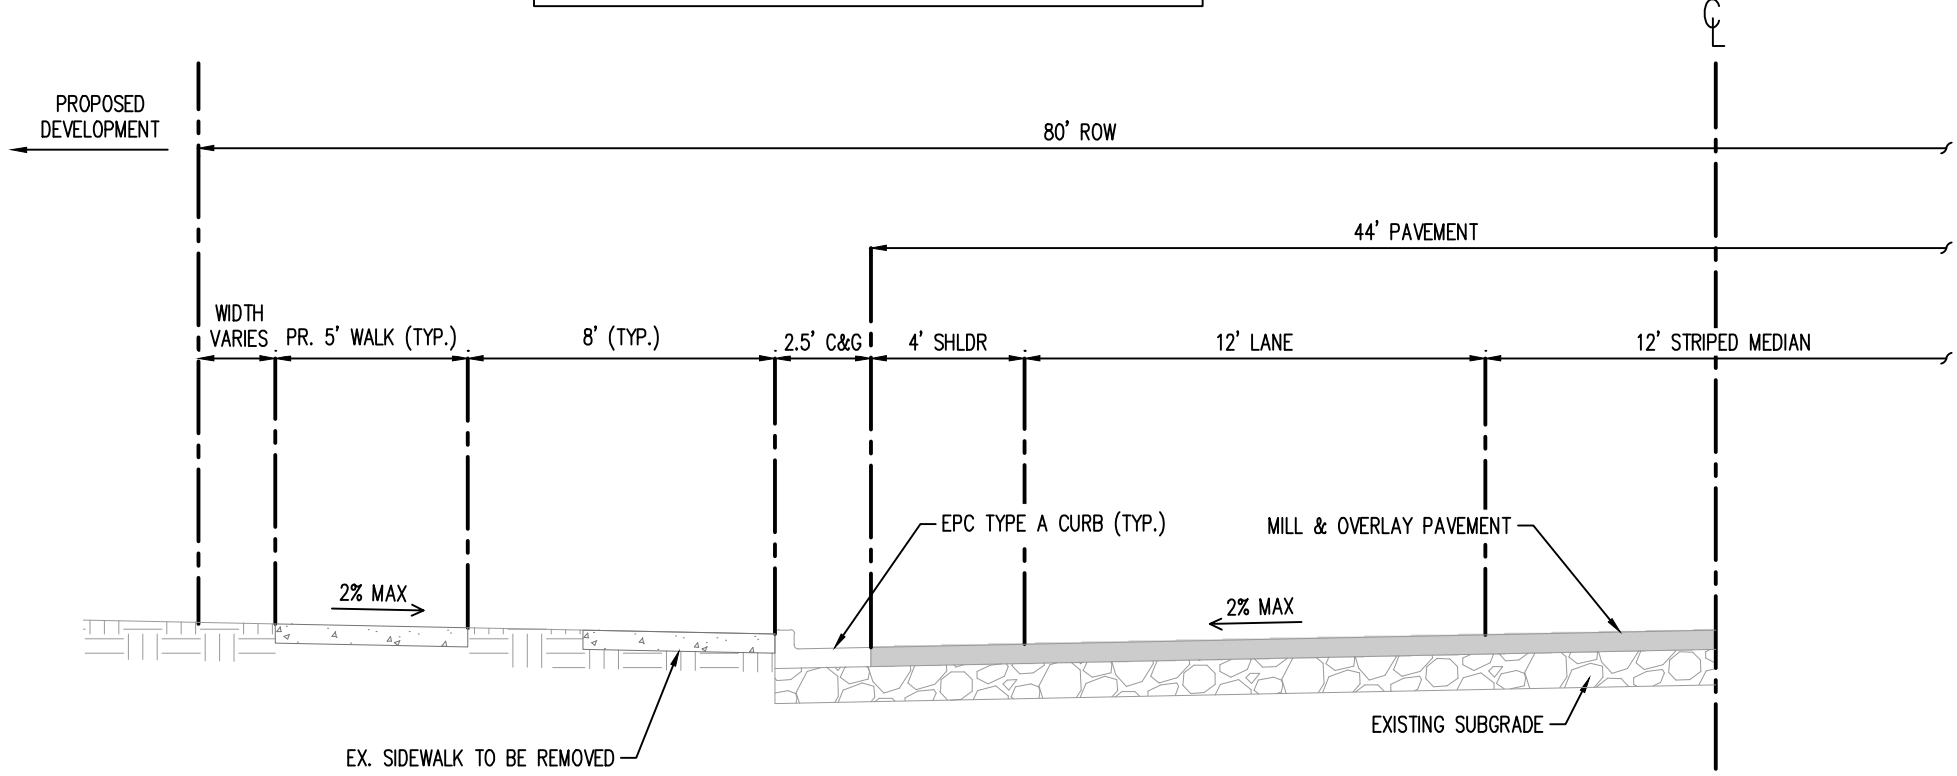


TYPICAL STREET SECTION - MODIFIED URBAN NONRESIDENTIAL COLLECTOR
(BENT GRASS MEADOWS DRIVE - STA: 11+33 TO 23+80)
SCALE: 1"=5'

POSTED SPEED LIMIT: 35 MPH
DESIGN SPEED LIMIT: 40 MPH
MAXIMUM ADT: 20,000

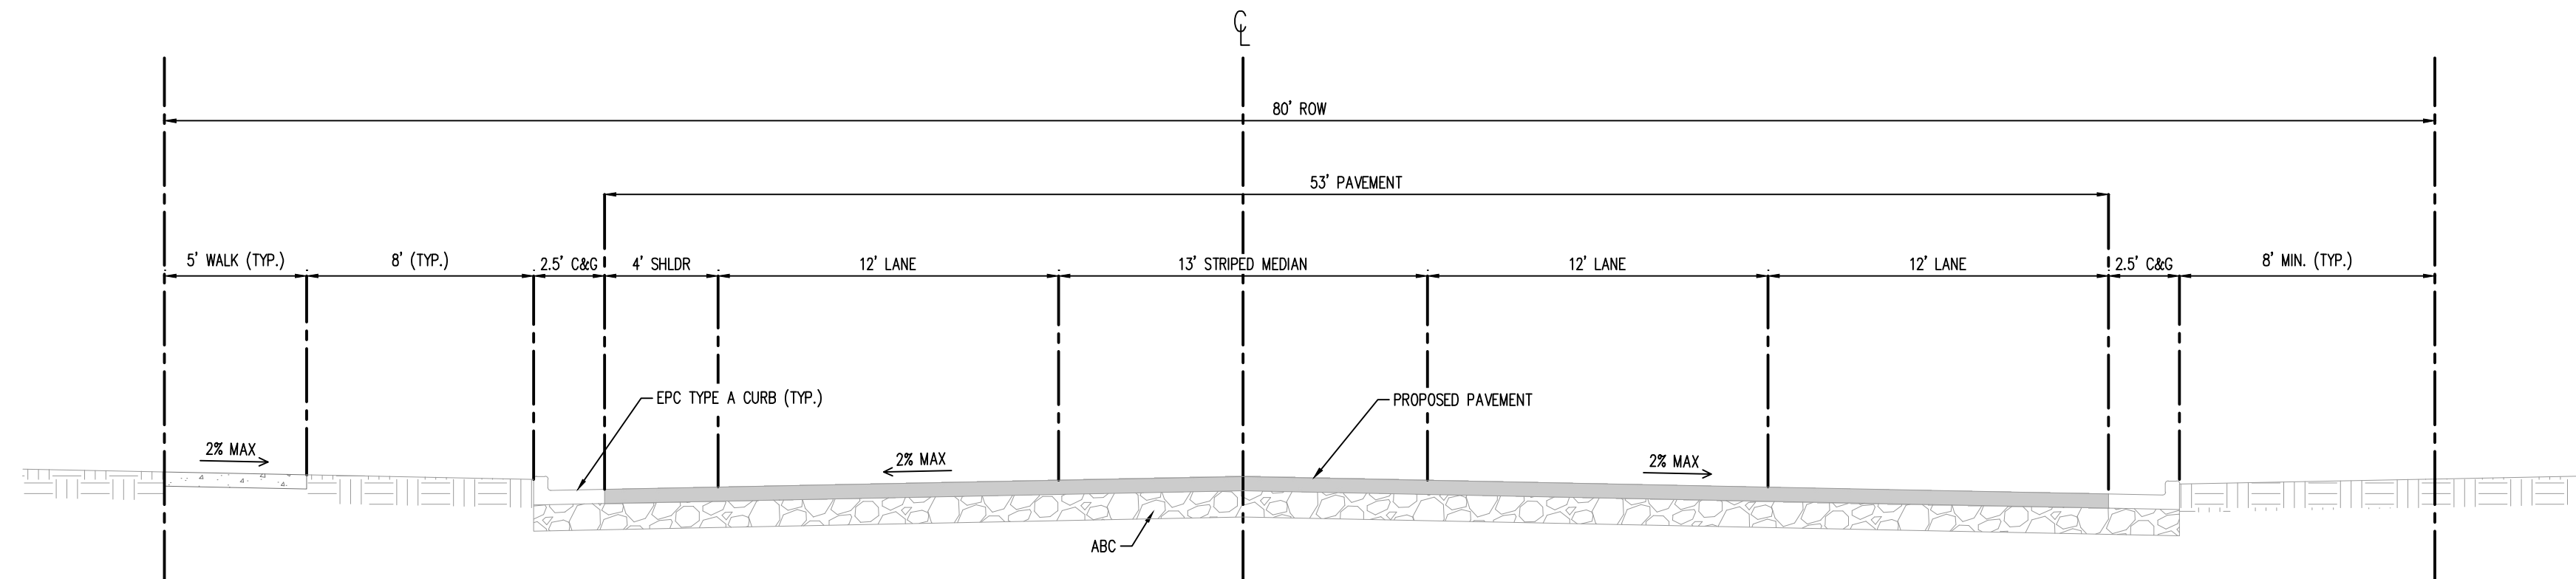


TYPICAL STREET SECTION - MODIFIED URBAN NONRESIDENTIAL COLLECTOR
(BENT GRASS MEADOWS DRIVE - STA: 32+94 TO 34+96)
SCALE: 1"=5'

POSTED SPEED LIMIT: 35 MPH
DESIGN SPEED LIMIT: 40 MPH
MAXIMUM ADT: 20,000

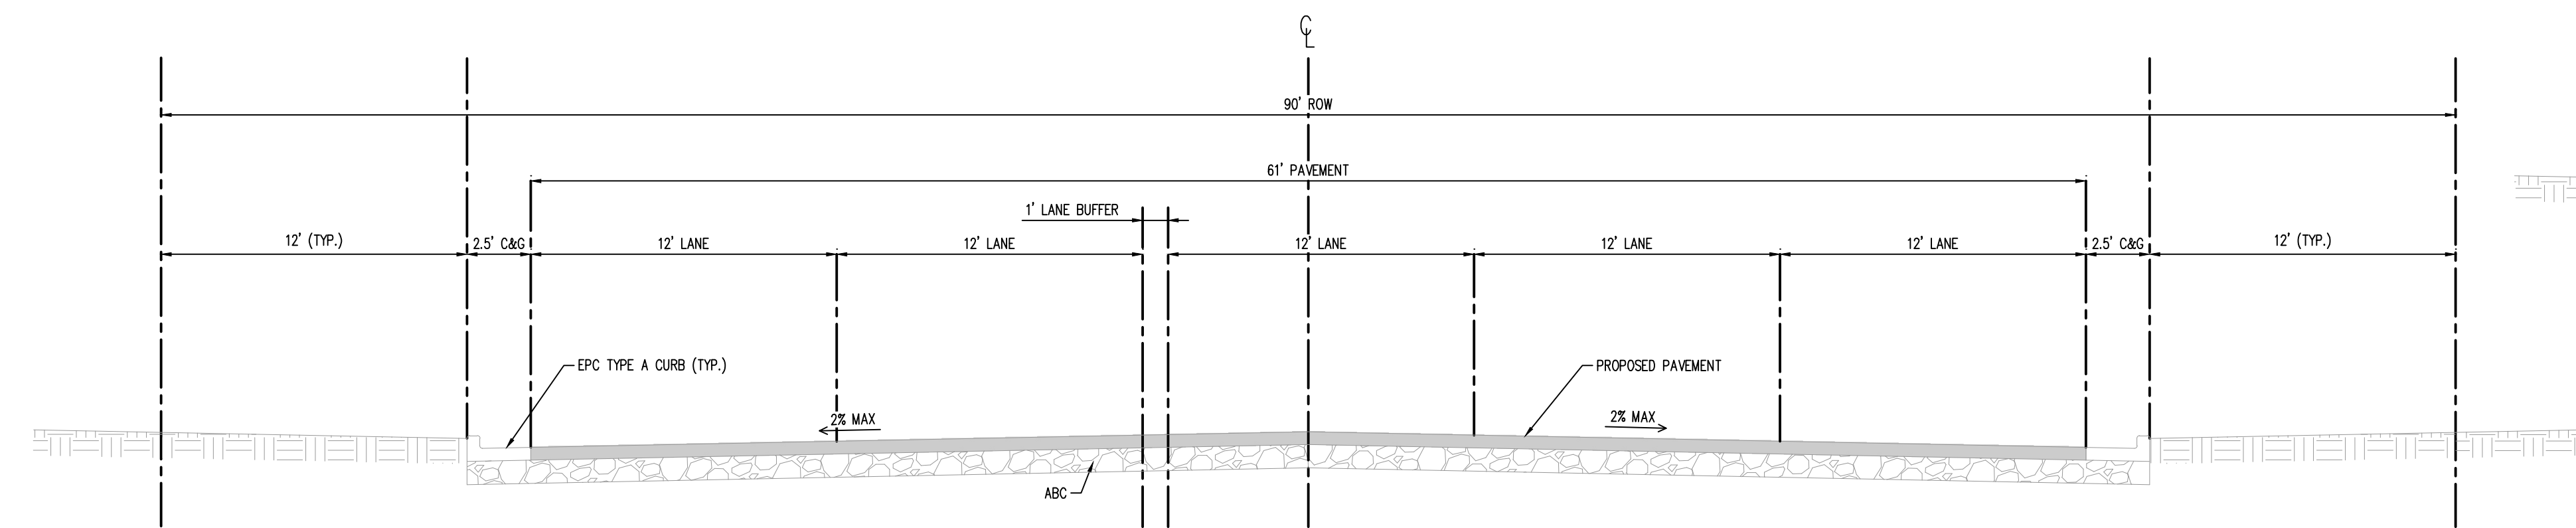


TYPICAL STREET SECTION
(SWITCHGRASS DRIVE - STA: 28+81 TO 29+56)
SCALE: 1"=5'

POSTED SPEED LIMIT: 20 MPH
DESIGN SPEED LIMIT: 25 MPH
MAXIMUM ADT: 3,000

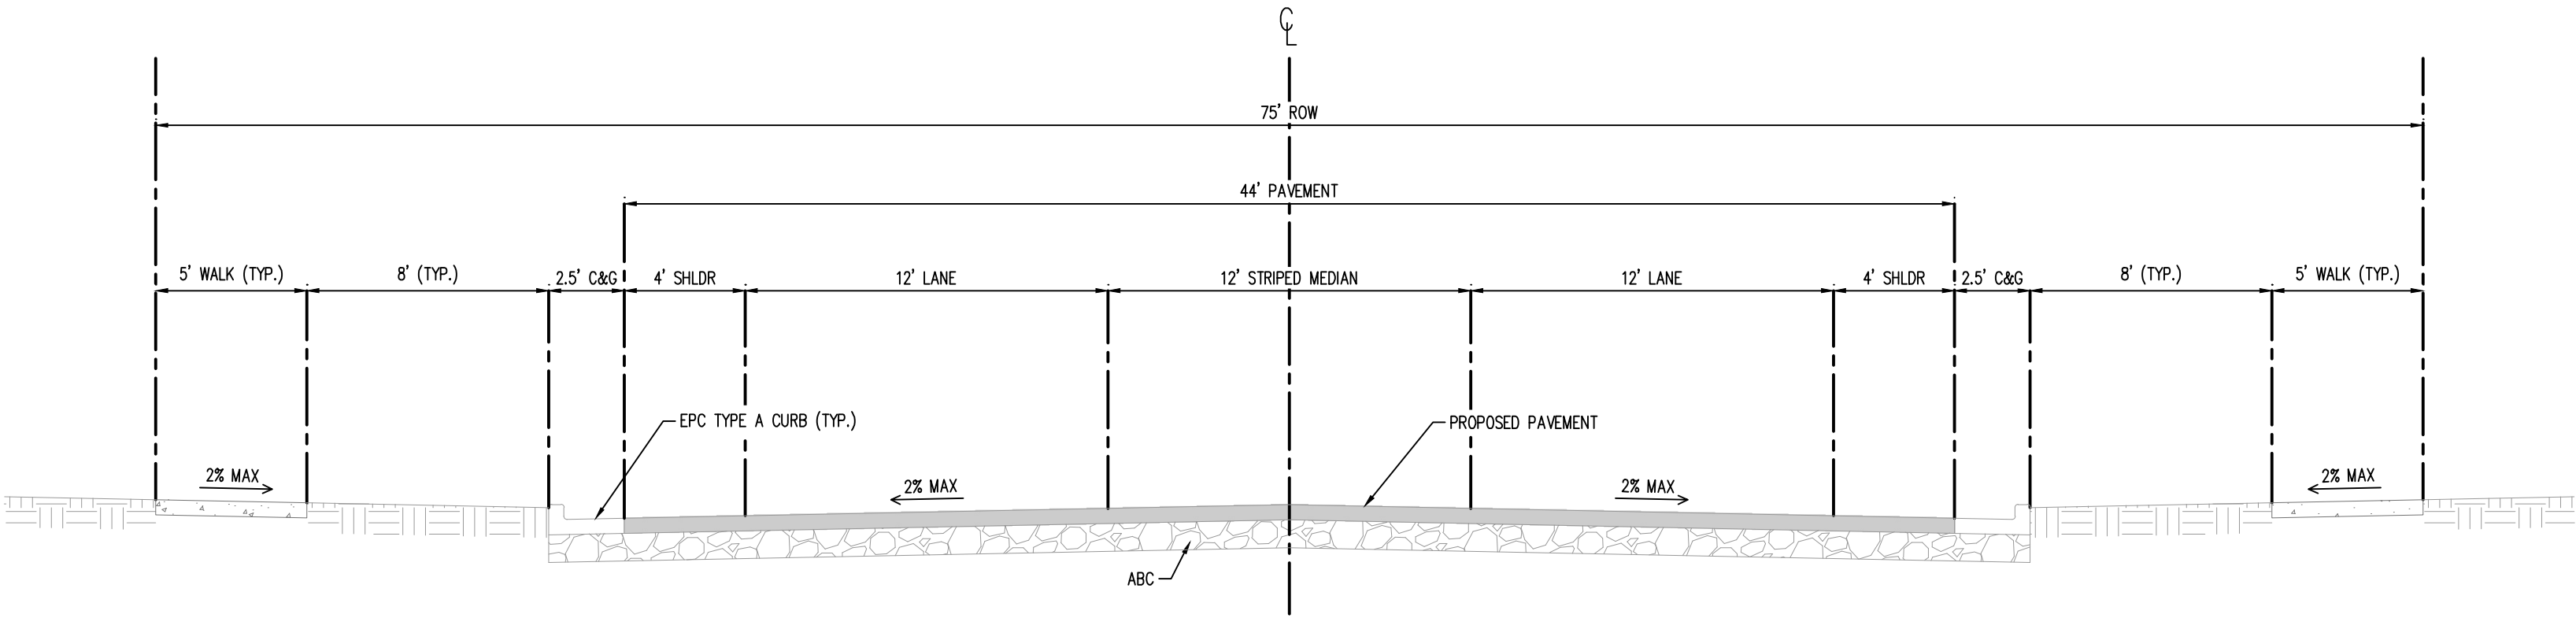

TYPICAL STREET SECTION - MODIFIED URBAN NONRESIDENTIAL COLLECTOR
(BENT GRASS MEADOWS DRIVE - STA: 23+80 TO 29+17)
SCALE: 1"=5'

POSTED SPEED LIMIT: 35 MPH
DESIGN SPEED LIMIT: 40 MPH
MAXIMUM ADT: 20,000

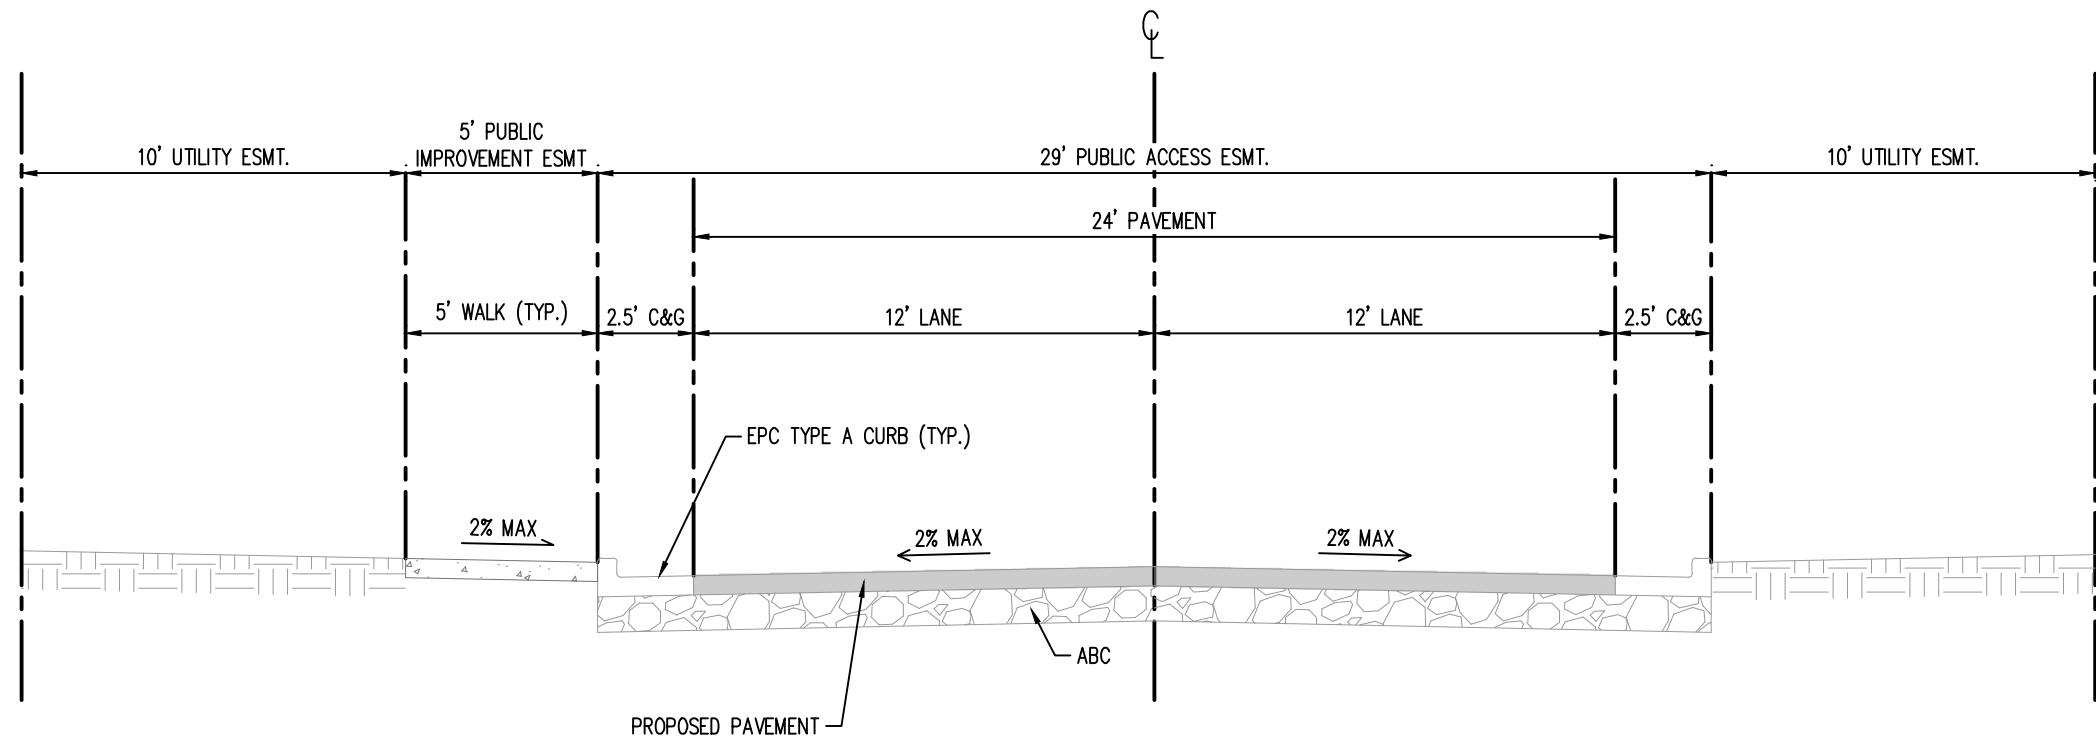


TYPICAL STREET SECTION
(PRIVATE ROAD)
SCALE: 1"=5'

POSTED SPEED LIMIT: 20 MPH
DESIGN SPEED LIMIT: 25 MPH
MAXIMUM ADT: 3,000

REVISED TO 12' LANE.
KEYNOTE ADDED.

Should be 12' lane. Please
note all proposed deviations
with a keynote or symbol

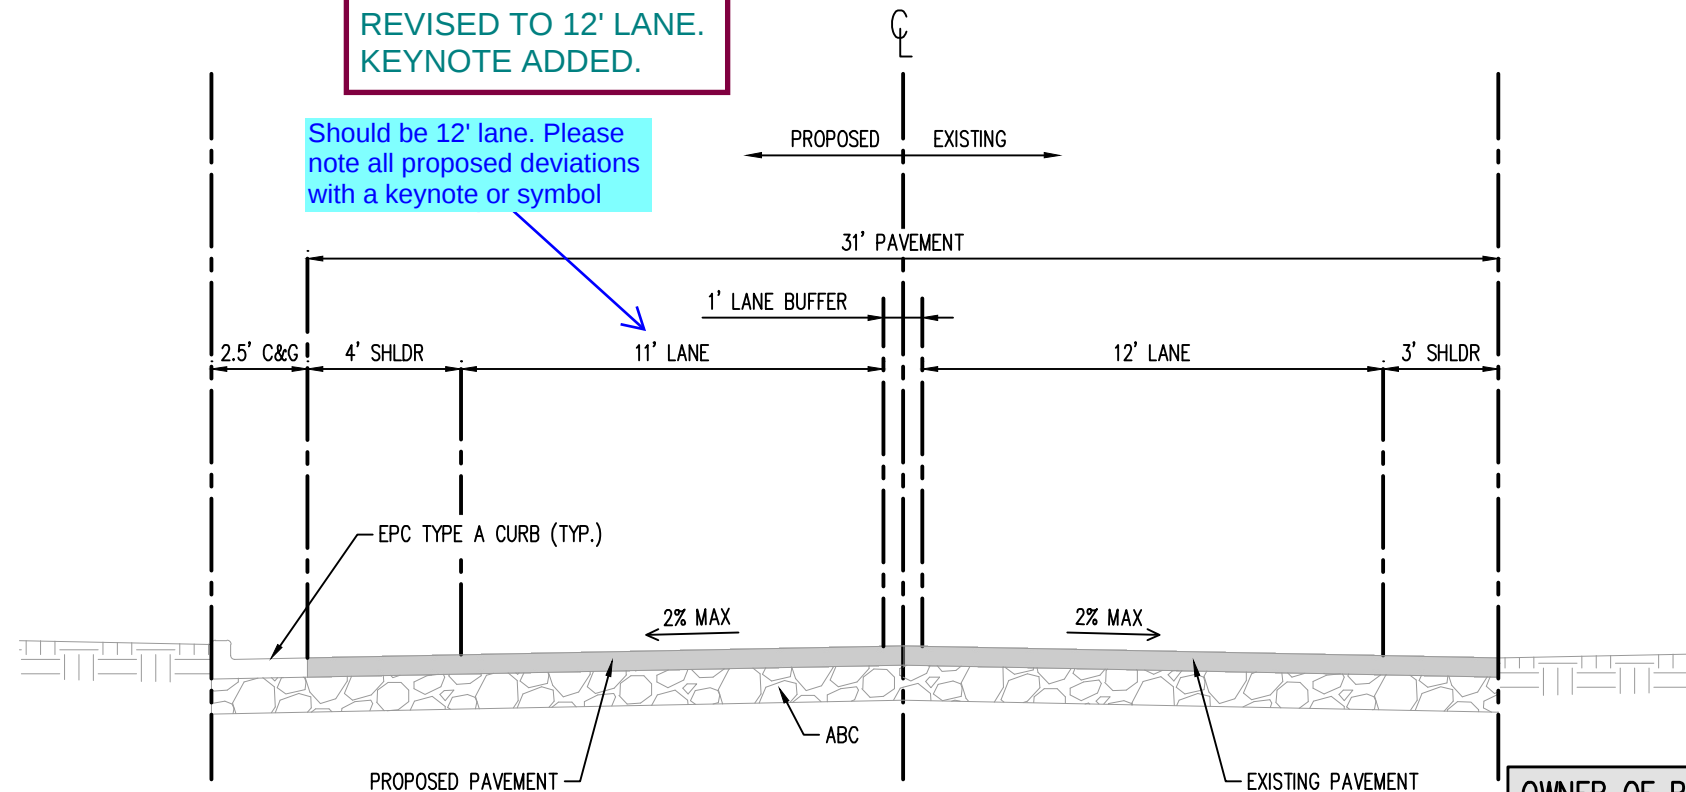

TYPICAL STREET SECTION
(CONNECTION TO EX. WOODMEN FRONTAGE ROAD - STA: 38+10)
SCALE: 1"=5'

POSTED SPEED LIMIT: 35 MPH
DESIGN SPEED LIMIT: 40 MPH
MAXIMUM ADT: 20,000

REVISED
ACCORDINGLY.

RIGHT-OF-WAY WIDTH AND LANDSCAPE BUFFERS VARY THROUGHOUT
THE PUBLIC ROW AS NEEDED TO TRANSITION INTO AND OUT OF THE
ROUNDOABOUT.



Galloway

1155 Kelly Johnson Blvd., Suite 305
Colorado Springs, CO 80920
719.900.7220
GallowayUS.com

Galloway & Company, LLC

PRELIMINARY
NOT FOR BIDDING
NOT FOR CONSTRUCTION



PRELIMINARY PLAN
THE MARKETS AT BENT GRASS
EVERGREEN DEVELOPMENT
EPC FILE #: SP262
NEC OF WOODMEN RD. & BENT GRASS MEADOWS DR.
FALCON, COLORADO

#	Date	Issue / Description	Init.
1	03/04/2026	1ST PRELIMINARY PLAN SUBMITTAL	
2	05/22/2026	2ND PRELIMINARY PLAN SUBMITTAL	
3			
4			
Project No: EDI02
Drawn By: ELB, AGC
Checked By: JAO, TJE, CMWJ
Date: 05/22/2026

TYPICAL ROADWAY SECTIONS

SP262

OWNER OF RECORD
LENA GAIL CASE
119 N. WAINWATER AVE
COLORADO SPRINGS, CO 80903

OWNER OF RECORD
CYNTHIA DEYOUNG
10924 E HIGHWAY 24
PEYTON, CO 80831

APPLICANT
EVERGREEN DEVCO, INC.
1873 SOUTH BELLAIRE ST., SUITE 1200
DENVER, CO 80222
TEL: (303) 757-0414

PLAN PREPARER
JEFFREY ODOR
GALLOWAY & CO. LLC
1155 KELLY JOHNSON BLVD., SUITE 305
COLORADO SPRINGS, CO, 80920
TEL: (719) 308-2519

BASED ON SURVEY PERFORMED BY GALLOWAY & COMPANY, LLC
ON 07/01/2025



A PORTION OF THE SOUTHWEST QUARTER OF SECTION 1 TOWNSHIP 13 SOUTH,
RANGE 65 WEST OF THE 6TH PRINCIPAL MERIDIAN, EL PASO COUNTY, COLORADO



PP-3
3 OF 12

THE MARKETS AT BENT GRASS


A PORTION OF THE SOUTHWEST QUARTER OF SECTION 1 TOWNSHIP 13 SOUTH,
RANGE 65 WEST OF THE 6TH PRINCIPAL MERIDIAN, EL PASO COUNTY, COLORADO

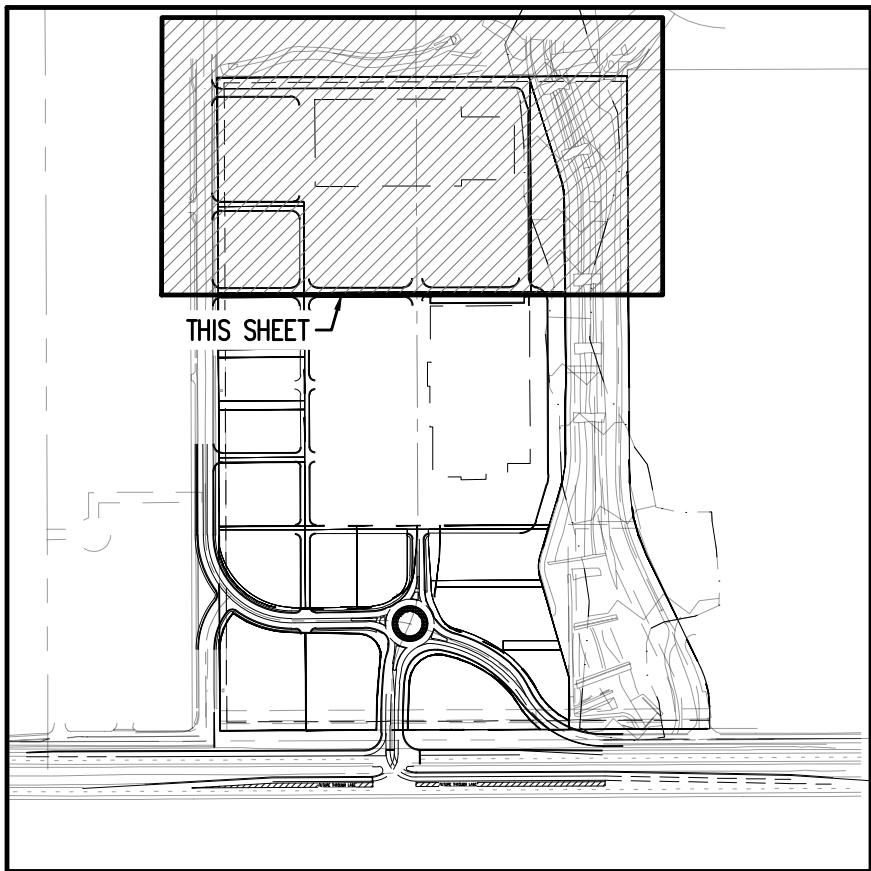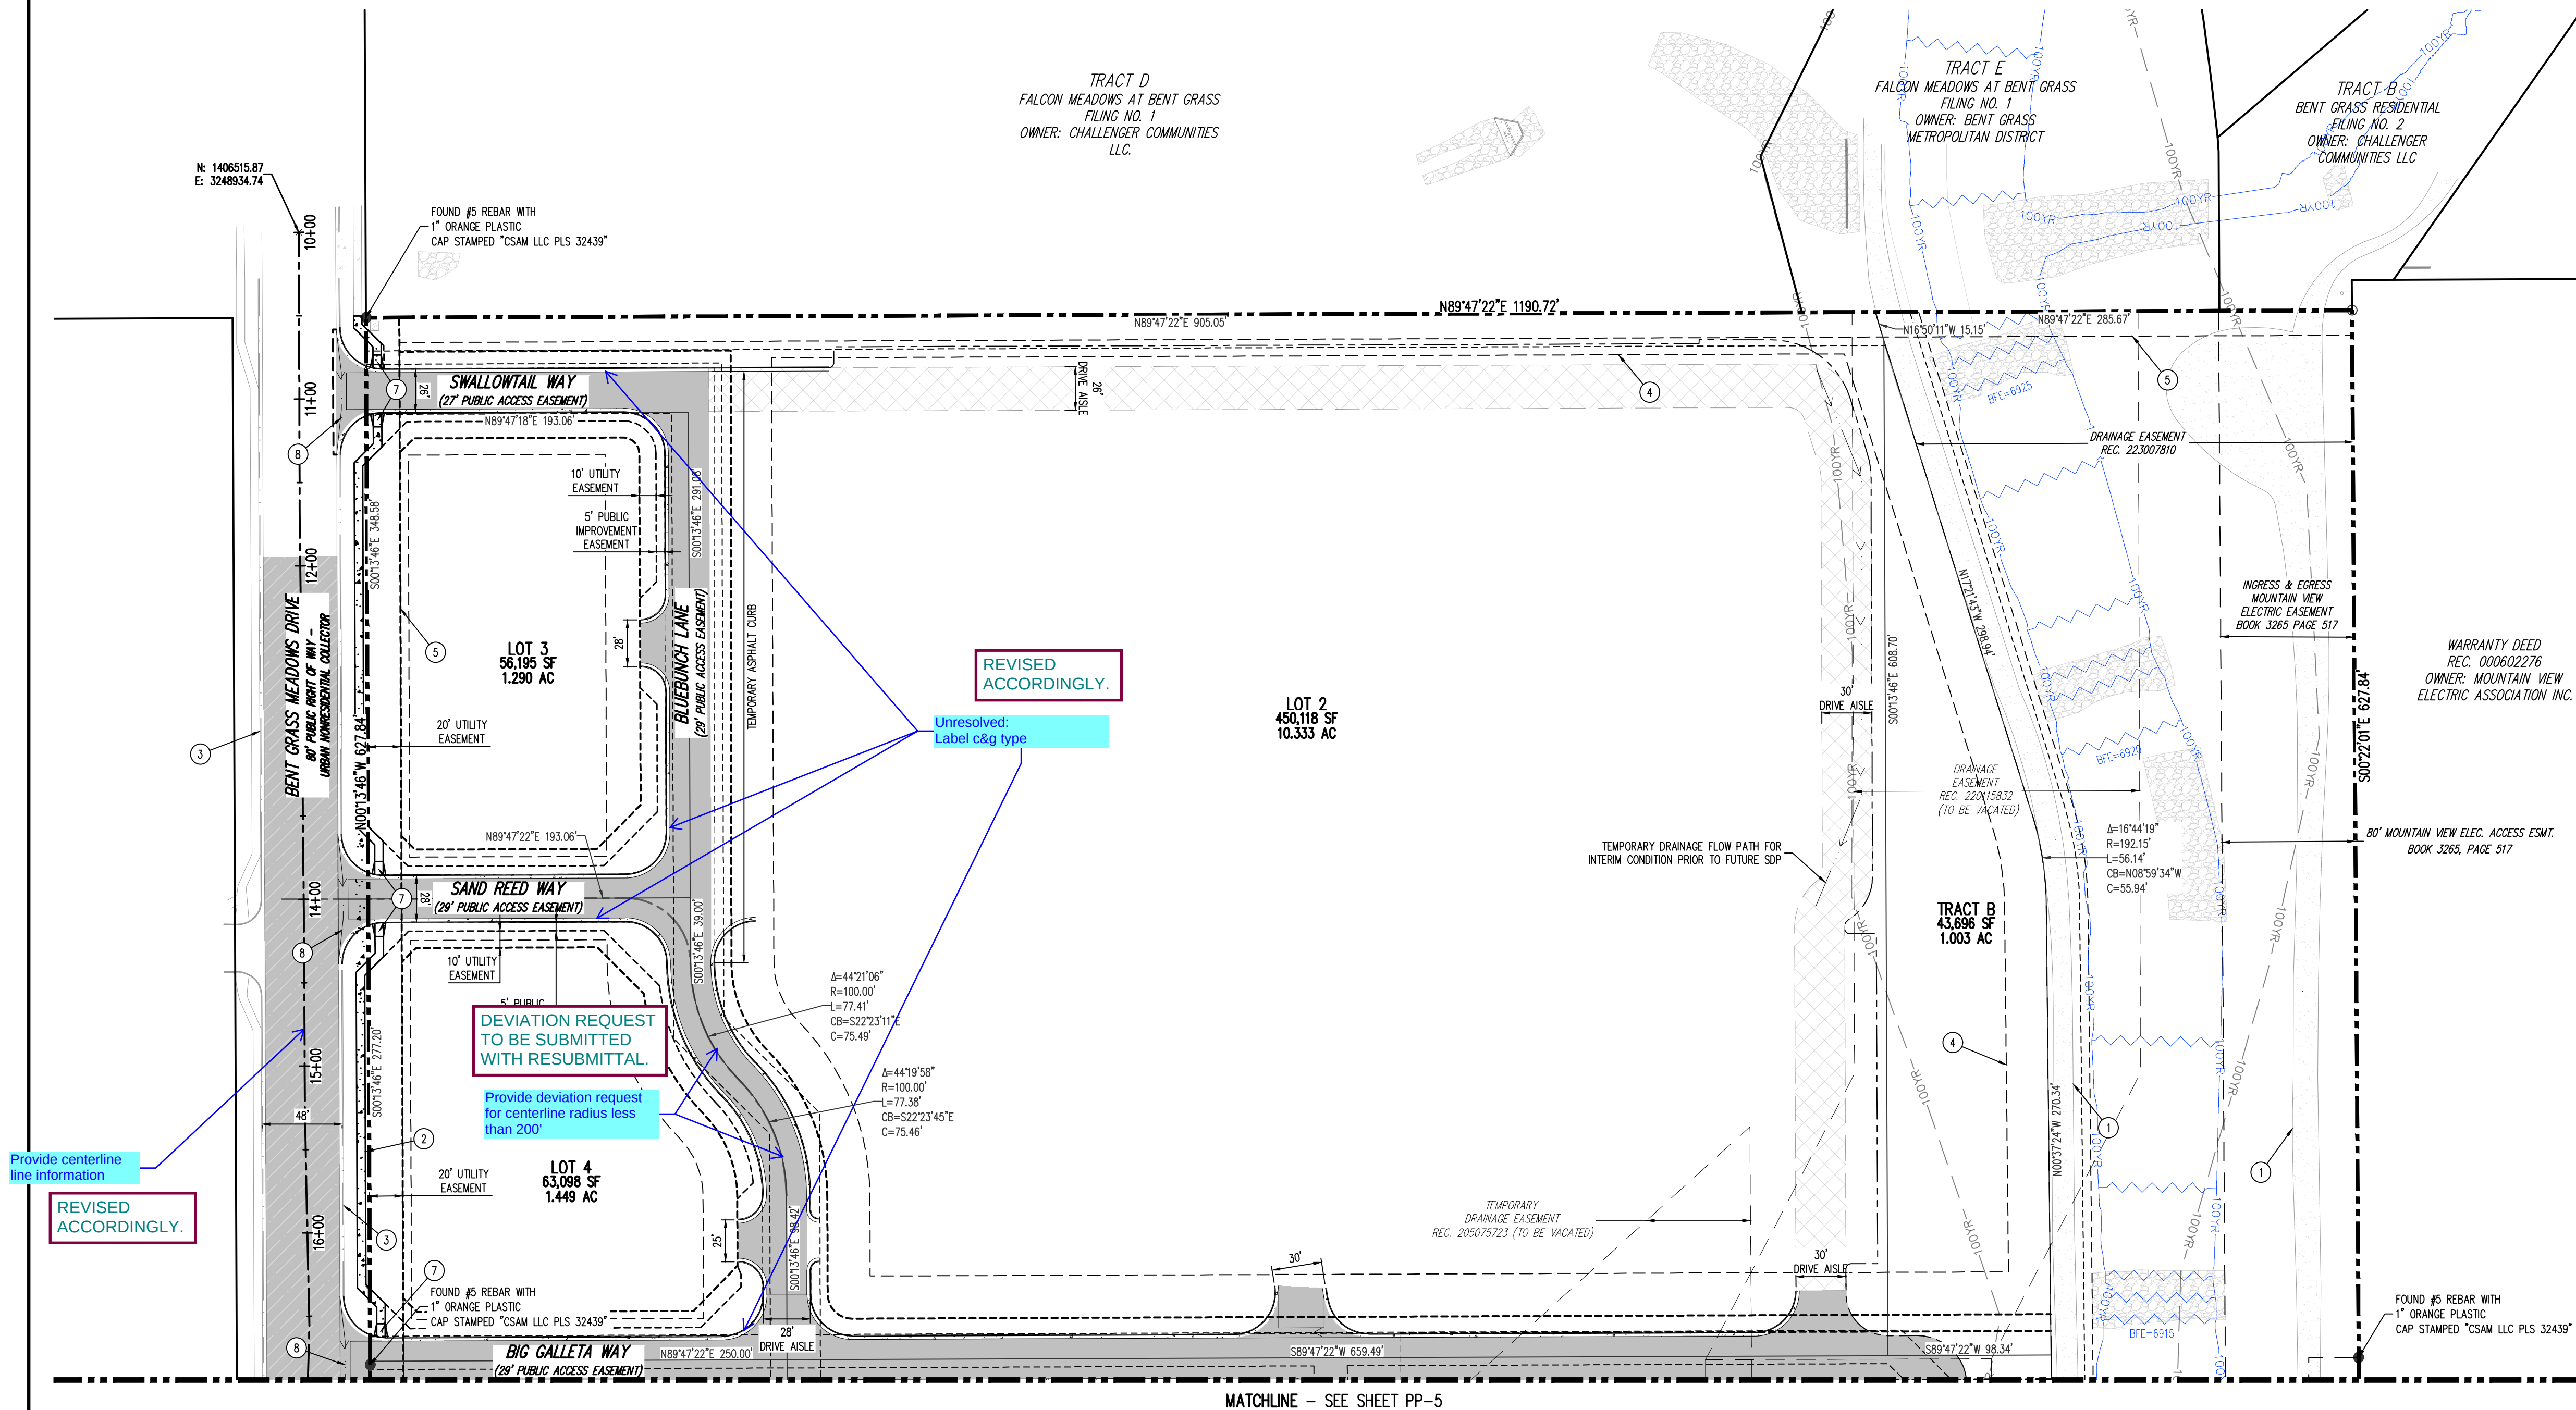

- SITE LEGEND**
- OVERALL PROPERTY BOUNDARY LINE
 - PROPERTY BOUNDARY LINE
 - ADJACENT PROPERTY BOUNDARY LINE
 - RIGHT OF WAY BOUNDARY LINE
 - ROAD CENTERLINE
 - EXISTING EASEMENT LINE
 - PROPOSED EASEMENT LINE
 - BUILDING SETBACK LINE
 - LANDSCAPE SETBACK LINE
 - PROPOSED SAWCUT LINE
 - PROPOSED FLOW PATH
 - EXISTING TO REMAIN
 - PROPOSED NEW
 - PROPOSED EDGE OF ASPHALT
 - PROPOSED EDGE OF GRAVEL
 - PROPOSED FLOODPLAIN BOUNDARY
 - EXISTING FLOODPLAIN BOUNDARY
 - PROPOSED CURB AND GUTTER
 - PROPOSED SPILL CURB AND GUTTER
 - PROPOSED FIRE LANE CURB PAINT
 - EXISTING CURB AND GUTTER

- PAVING LEGEND**
- MILL & OVERLAY ASPHALT
 - CONCRETE SIDEWALK
 - STANDARD DUTY CONCRETE
 - STANDARD DUTY ASPHALT
 - HEAVY DUTY ASPHALT
 - EXISTING CONCRETE
 - EXISTING ASPHALT
 - EXISTING CONCRETE SIDEWALK
 - EXISTING GRAVEL ROAD
 - FUTURE SDP DRIVE AISLE

- SCHEDULE**
- EXISTING PATH
 - 5' PROPOSED SIDEWALK
 - EPC TYPE A CURB & GUTTER (TYP.)
 - BUILDING SETBACK
 - LANDSCAPE SETBACK
 - FUTURE BUILDING SITE
 - PROPOSED PEDESTRIAN CURB RAMP (TYP.)
 - 6' PROPOSED CROSSPARK (TYP.)

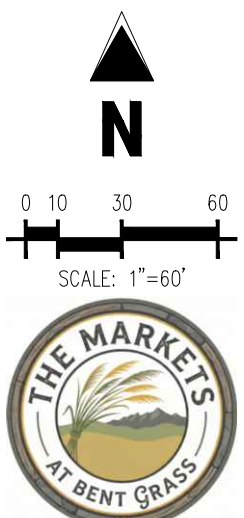

OWNER OF RECORD	
LENA GAIL CASE 119 N. WASHCATCH AVE COLORADO SPRINGS, CO 80903	
OWNER OF RECORD	
CYNTHIA DEYOUNG 10924 E HIGHWAY 24 PEYTON, CO 80831	
APPLICANT	
EVERGREEN DEVCO, INC. 1873 SOUTH BELLAIRE ST., SUITE 1200 DENVER, CO 80222 TEL: (303) 757-0414	
PLAN PREPARER	
JEFFREY ODOR GALLOWAY & CO. LLC 1155 KELLY JOHNSON BLVD., SUITE 305 COLORADO SPRINGS, CO, 80920 TEL: (719) 308-2519	
BASED ON SURVEY PERFORMED BY GALLOWAY & COMPANY, LLC ON 07/01/2025	

Galloway

1155 Kelly Johnson Blvd., Suite 305
Colorado Springs, CO 80920
719.900.7220
GallowayUS.com

Galloway & Company, LLC

PRELIMINARY
NOT FOR BIDDING
NOT FOR CONSTRUCTION

Evergreen
Multi-family Retail Industrial



PRELIMINARY PLAN
THE MARKETS AT BENT GRASS
EVERGREEN DEVELOPMENT
EPC FILE #: SP262

NEC OF WOODMEN RD. & BENT GRASS MEADOWS DR.
FALCON, COLORADO

#	Date	Issue / Description	Int.
1	03/04/2025	1ST PRELIMINARY PLAN SUBMITTAL	-
2	05/22/2025	2ND PRELIMINARY PLAN SUBMITTAL	-
3			
4			
Project No:	ED102
Drawn By:	ELB, AGC
Checked By:	JAO, TJE, CMWJ
Date:	05/22/2025




PRELIMINARY SITE PLAN

SP262

PP-4

4 OF 12

A PORTION OF THE SOUTHWEST QUARTER OF SECTION 1 TOWNSHIP 13 SOUTH,
RANGE 65 WEST OF THE 6TH PRINCIPAL MERIDIAN, EL PASO COUNTY, COLORADO

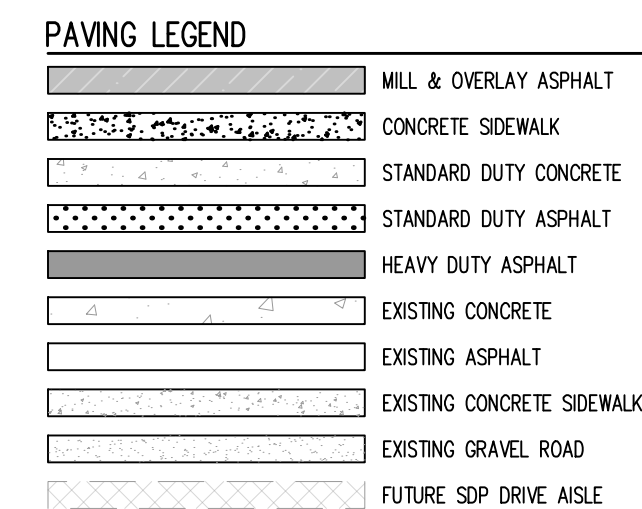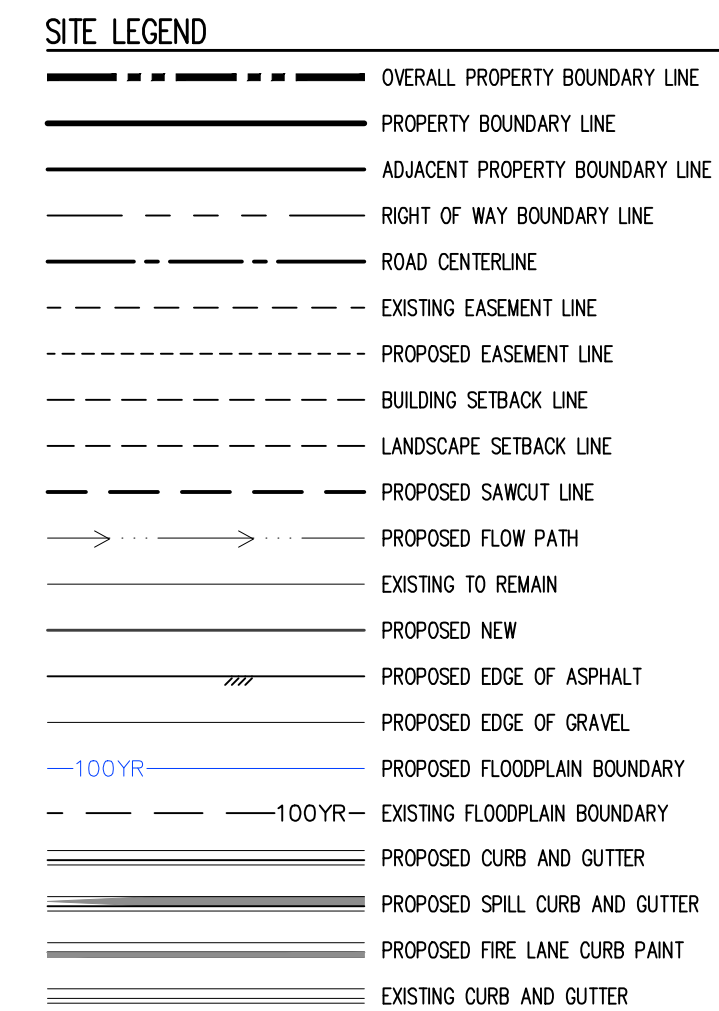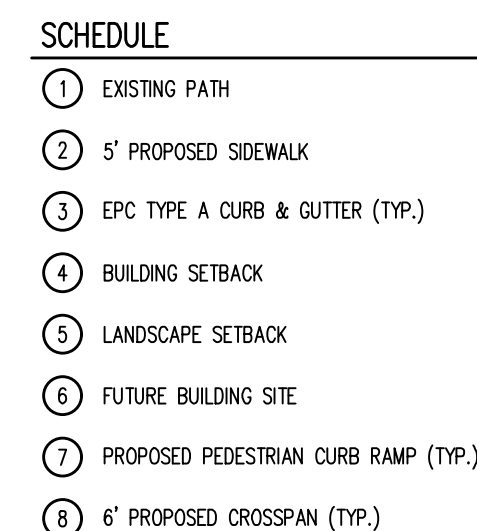[illegible]


Project No:	ED002
Drawn By:	ELB, AGC
Checked By:	JAO, TJE, CMWJ
Date:	05/22/2026

PRELIMINARY SITE PLAN


SP262

PP-5
5 OF 12


A PORTION OF THE SOUTHWEST QUARTER OF SECTION 1 TOWNSHIP 13 SOUTH,
RANGE 65 WEST OF THE 6TH PRINCIPAL MERIDIAN, EL PASO COUNTY, COLORADO

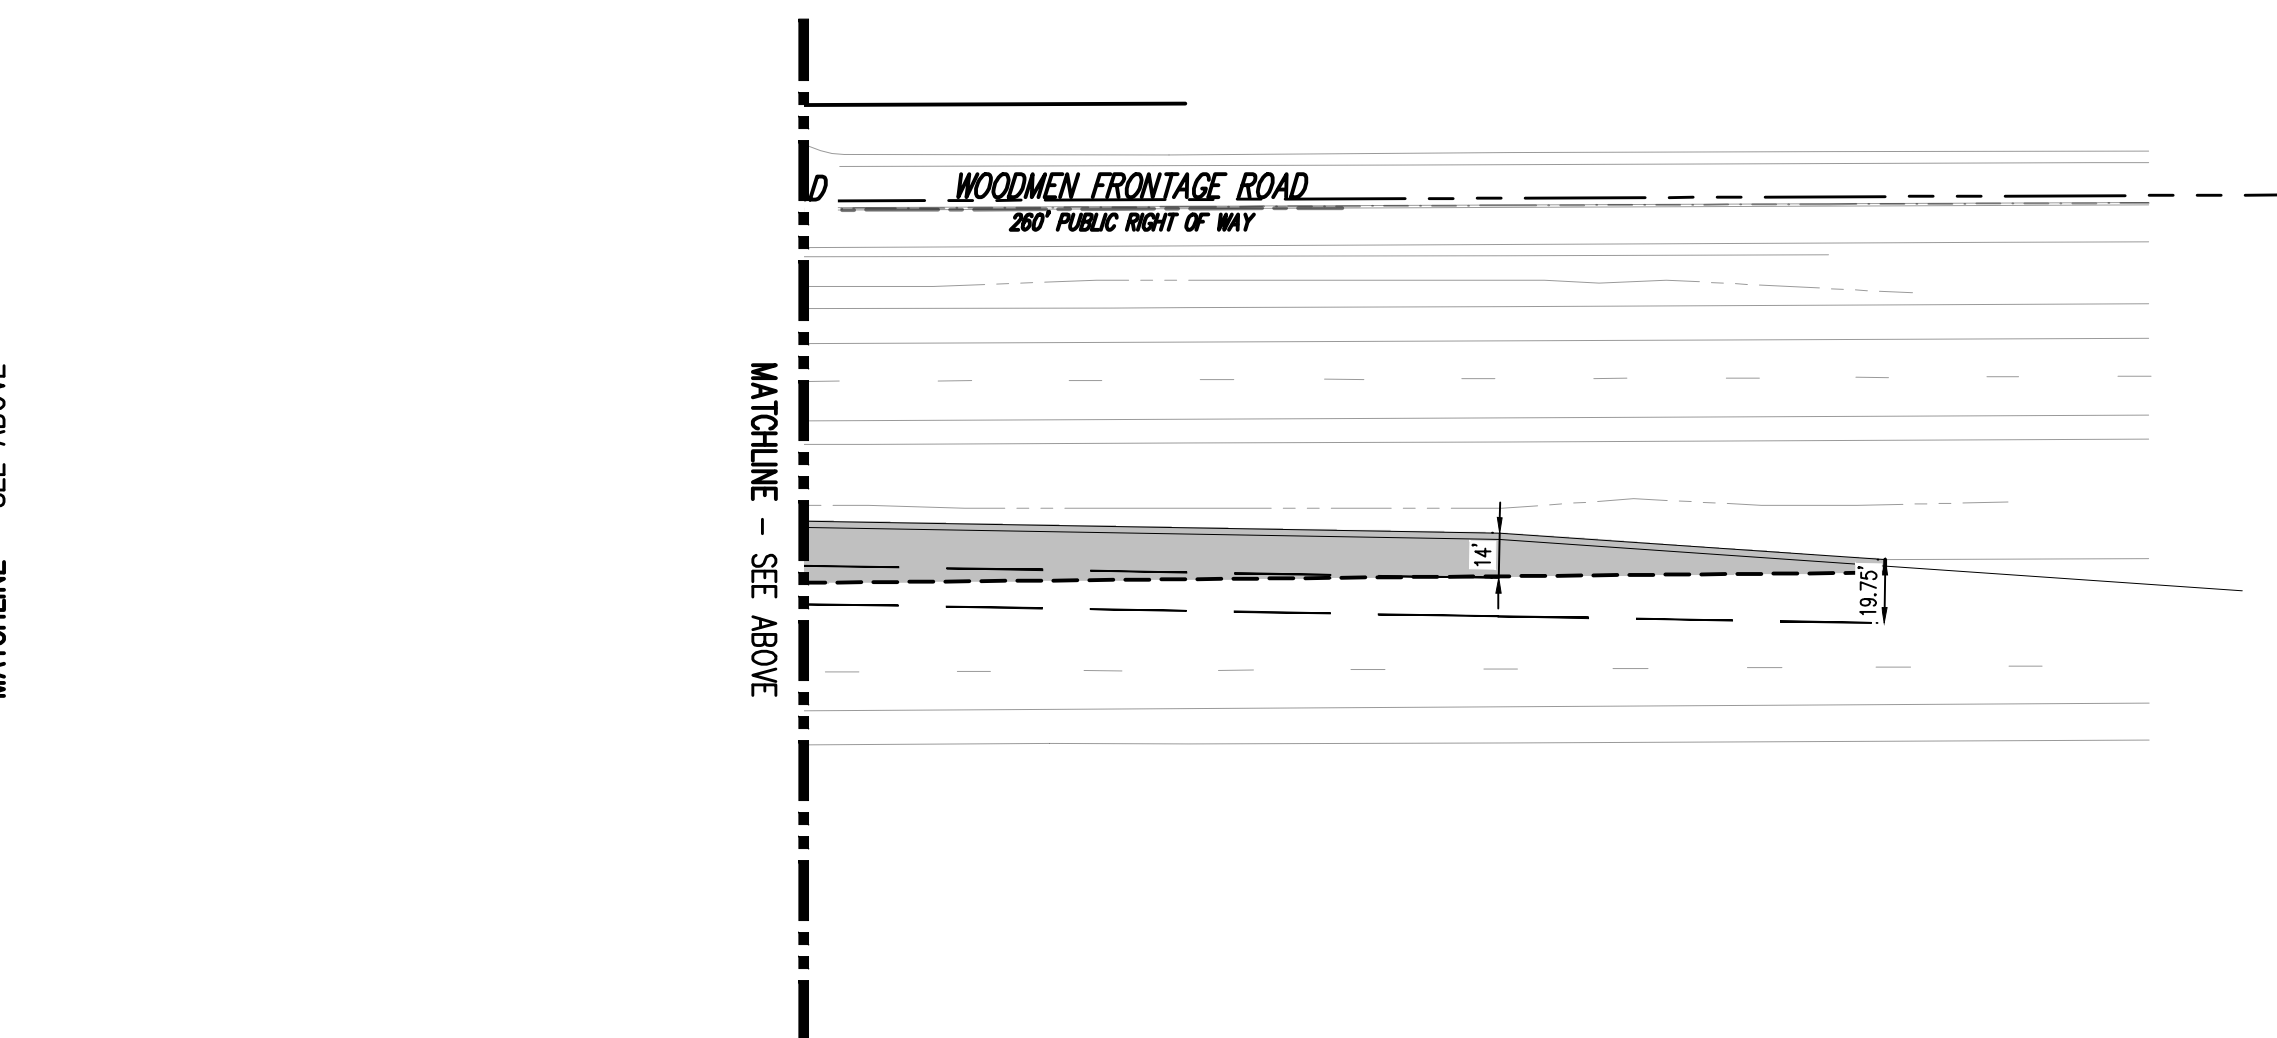

REVISED
ACCORDINGLY.

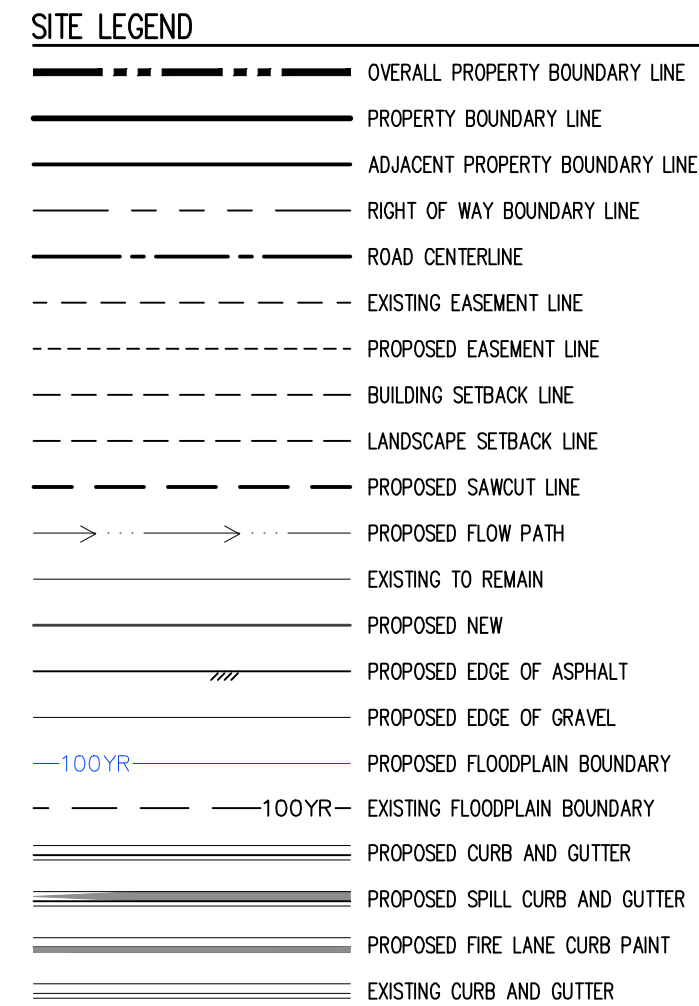

PAVING LEGEND

 	MILL & OVERLAY ASPHALT
	CONCRETE SIDEWALK
	STANDARD DUTY CONCRETE
	STANDARD DUTY ASPHALT
	HEAVY DUTY ASPHALT
	EXISTING CONCRETE
	EXISTING ASPHALT
	EXISTING CONCRETE SIDEWALK
	EXISTING GRAVEL ROAD
	FUTURE SPD DRIVE AISLE

OWNER OF RECORD LENA GAIL CASE 119 N WASHINGTON AVE COLORADO SPRINGS, CO 80903
OWNER OF RECORD CYNTHIA DEYOUNG 10924 E HIGHWAY 24 PEYTON, CO 80831
APPLICANT EVERGREEN DEVCO, INC. 1873 SOUTH BELLAIRE ST., SUITE 1200 DENVER, CO 80222 TEL: (303) 757-0414
PLAN PREPARER JEFFREY OODR GALLOWAY & CO. LLC 1155 KELLY JORDAN BLVD., SUITE 305 COLORADO SPRINGS, CO, 80920 TEL: (719) 308-2519
BASING ON SURVEY PERFORMED BY GALLOWAY & COMPANY, LLC ON 07/01/2025

NEC OF WOODMEN RD. & BENT GRASS MEADOWS DR.
FALCON, COLORADO


[illegible]

Project No:	ED102
Drawn By:	ELB, AGC
Checked By:	JAO, TJE, CMWJ
Date:	05/22/2026


PRELIMINARY SITE PLAN

SP262

A PORTION OF THE SOUTHWEST QUARTER OF SECTION 1 TOWNSHIP 13 SOUTH,
RANGE 65 WEST OF THE 6TH PRINCIPAL MERIDIAN, EL PASO COUNTY, COLORADO

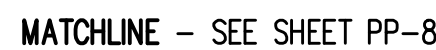

---	540'	---	EXISTING MAJOR CONTOUR
			EXISTING MINOR CONTOUR
			PROPOSED MAJOR CONTOUR
			PROPOSED MINOR CONTOUR
			SD
			EXISTING STORM SEWER (LESS THAN 12")
			EXISTING STORM SEWER (12" AND LARGER)
			SD
			PROPOSED STORM SEWER (LESS THAN 12")
			SD SD SD SD SD SD SD SD SD SD
			PROPOSED STORM SEWER (12" AND LARGER)
			PROPOSED STORM SEWER MANHOLE
			PROPOSED STORM INLET
			LOD
			100YR
			100YR
			PROPOSED SLOPE (PERCENT)
			PROPOSED SLOPE (RISE:RUN)

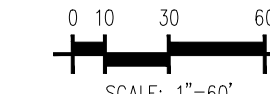

BASED ON SURVEY PERFORMED BY GALLOWAY & COMPANY, LLC
ON 07/01/2025

7 OF 12

A PORTION OF THE SOUTHWEST QUARTER OF SECTION 1 TOWNSHIP 13 SOUTH,
RANGE 65 WEST OF THE 6TH PRINCIPAL MERIDIAN, EL PASO COUNTY, COLORADO



MATCHLINE - SEE SHEET PP-9



- - - - -	5460	EXISTING MAJOR CONTOUR
- - - - -		EXISTING MINOR CONTOUR
- - - - -	5485	PROPOSED MAJOR CONTOUR
- - - - -		PROPOSED MINOR CONTOUR
- - - - -	SD	EXISTING STORM SEWER (LESS THAN 12")
- - - - -		EXISTING STORM SEWER (12" & LARGER)
- - - - -	SD	PROPOSED STORM SEWER (LESS THAN 12")
- - - - -	SD 12" SD 12" SD 12"	PROPOSED STORM SEWER (12" & LARGER)
- - - - -		PROPOSED STORM SEWER MANHOLE
- - - - -		PROPOSED STORM INLET
- - - - -	L.O.D.	LIMIT OF DISTURBANCE
- - - - -	100'YR	PROPOSED FLOODPLAIN BOUNDARY
- - - - -	100'YR	EXISTING FLOODPLAIN BOUNDARY
- - - - -	X.XXX%	PROPOSED SLOPE (PERCENT)
- - - - -	X.X	PROPOSED SLOPE (RISE/RUN)



Galloway & Company, LLC

PRELIMINARY
NOT FOR BIDDING
NOT FOR CONSTRUCTION



NEC OF WOODMEN RD. & BENT GRASS MEADOWS DR.
FALCON, COLORADO

[illegible]

Project No:	EDI02
Drawn By:	ELB, AGC
Checked By:	JAO, TJE, CMWJ
Date:	05/22/2026

PRELIMINARY GRADING PLAN

SP262

8 OF 12


LENA GAIL CASE
119 N WAHSATCH AVE
COLORADO SPRINGS, CO 80903

CYNTHIA DEYOUNG
10924 E HIGHWAY 24
PEYTON, CO 80831


EVERGREEN DEVCO, INC.
1873 SOUTH BELLAIRE ST., SUITE 1200
DENVER, CO 80222
TEL: (303) 757-0414

JEFFREY ODOR
GALLOWAY & CO. LLC
1155 KELLY JOHNSON BLVD., SUITE 305
COLORADO SPRINGS, CO, 80920
TEL: (719) 308-2519

BASED ON SURVEY PERFORMED BY GALLOWAY & COMPANY, LLC
ON 07/01/2025

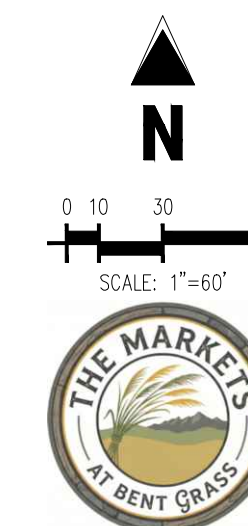

A PORTION OF THE SOUTHWEST QUARTER OF SECTION 1 TOWNSHIP 13 SOUTH,
RANGE 65 WEST OF THE 6TH PRINCIPAL MERIDIAN, EL PASO COUNTY, COLORADO

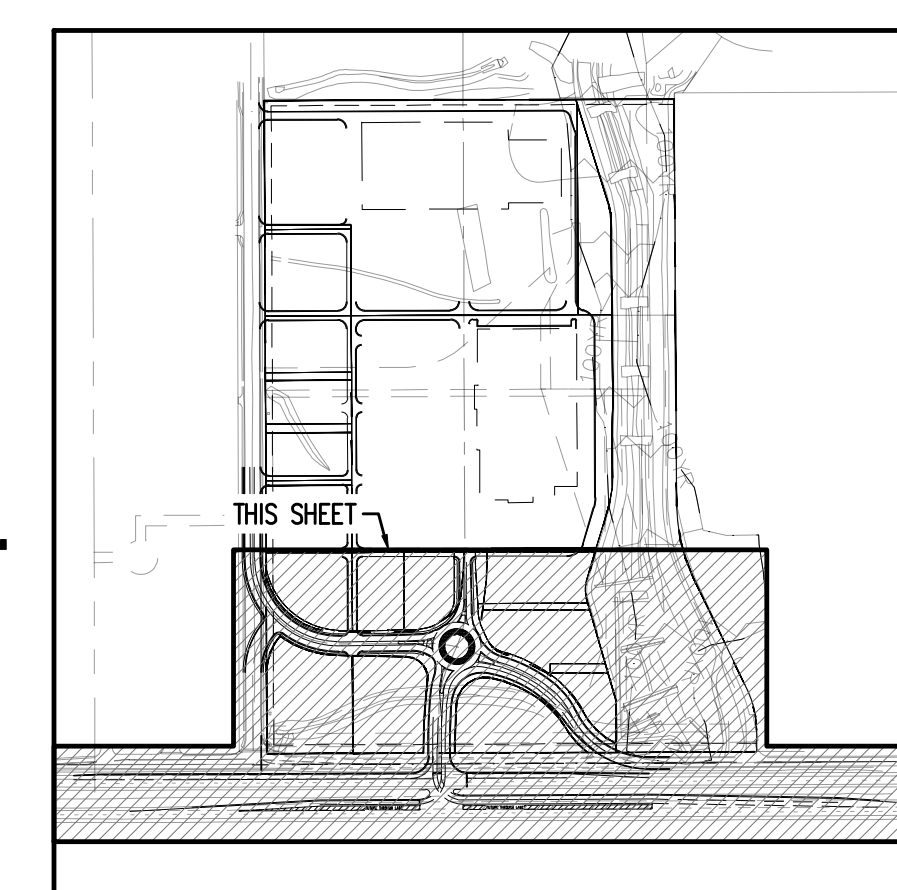

KEYMAP
NOT TO SCALE

GRADING LEGEND

- | | |
|--|---------------------------------------|
| | EXISTING MAJOR CONTOUR |
| | EXISTING MINOR CONTOUR |
| | PROPOSED MAJOR CONTOUR |
| | PROPOSED MINOR CONTOUR |
| | EXISTING STORM SEWER (LESS THAN 12") |
| | EXISTING STORM SEWER (12" AND LARGER) |
| | PROPOSED STORM SEWER (LESS THAN 12") |
| | PROPOSED STORM SEWER (12" AND LARGER) |
| | PROPOSED STORM SEWER MANHOLE |
| | PROPOSED STORM INLET |
| | LIMIT OF DISTURBANCE |
| | FLOODPLAIN FLOODPLAIN BOUNDARY |
| | EXISTING FLOODPLAIN BOUNDARY |
| | PROPOSED SLOPE (PERCENT) |
| | PROPOSED SLOPE (RISE:RUN) |

1155 Kelly Johnson Blvd., Suite 305
Colorado Springs, CO 80920
719.900.7220
GallowayUS.com

Galloway & Company, LLC

PRELIMINARY
NOT FOR BIDDING
NOT FOR CONSTRUCTION



PRELIMINARY PLAN
THE MARKETS AT BENT GRASS
EVERGREEN DEVELOPMENT
EPC FILE #: SP262
SUNEC OF WOODMEN RD. & BENT GRASS MEADOWS DR.
FALCON, COLORADO

[illegible]

Project No:	ED10
Drawn By:	ELB, AG
Checked By:	JAO, TJE, CMW
Date:	05/22/2002

PRELIMINARY GRADING PLAN

SP262

OWNER OF RECORD

LENA GAIL CASE
119 N WAHSATCH AVE
COLORADO SPRINGS, CO 80903

OWNER OF RECORD

CYNTHIA DEYOUNG
10924 E HIGHWAY 24
PEYTON, CO 80831


APPLICANT

EVERGREEN DEVCO, INC.
1873 SOUTH BELLAIRE ST., SUITE 1200
DENVER, CO 80222
TEL: (303) 757-0414


PLAN PREPARER

JEFFREY ODOR
GALLOWAY & CO. LLC
1155 KELLY JOHNSON BLVD., SUITE 305
COLORADO SPRINGS, CO, 80920
TEL: (719) 308-2519

BASED ON SURVEY PERFORMED BY GALLOWAY & COMPANY, LLC
ON 07/01/2025

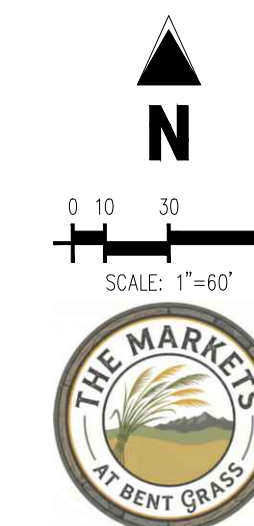

A PORTION OF THE SOUTHWEST QUARTER OF SECTION 1 TOWNSHIP 13 SOUTH,
RANGE 65 WEST OF THE 6TH PRINCIPAL MERIDIAN, EL PASO COUNTY, COLORADO

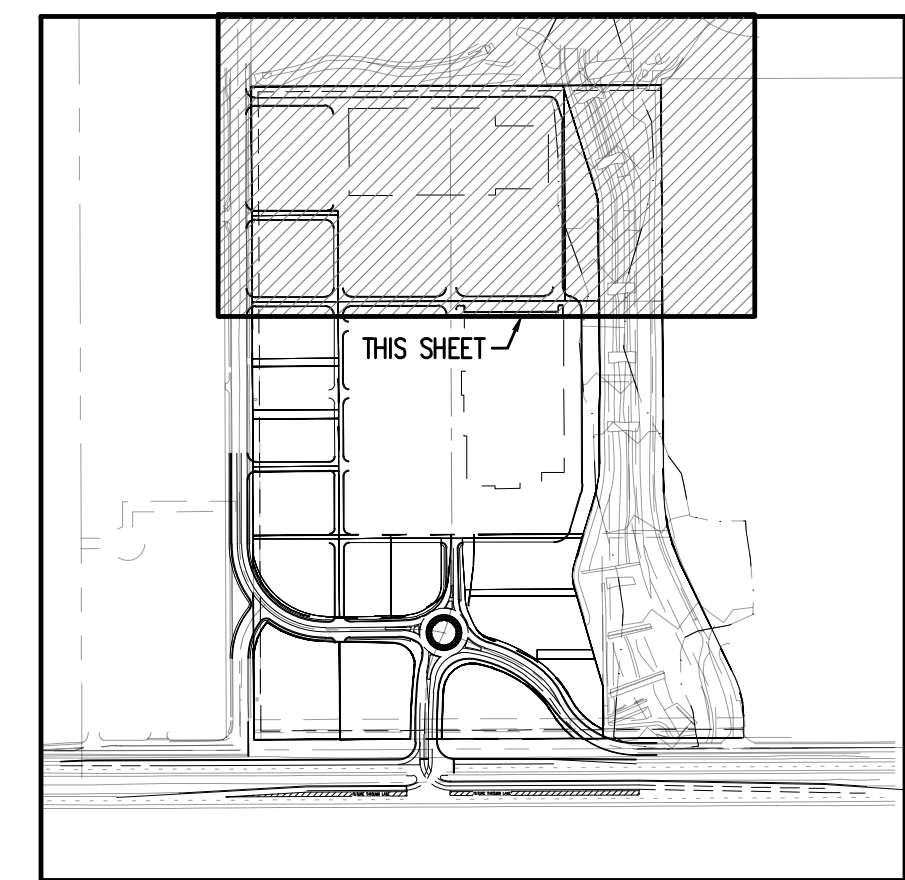

KEYMAP
NOT TO SCALE

— W —	EXISTING WATER LINE
— W —	PROPOSED WATER LINE
— SS —	EXISTING SANITARY SEWER
— SS —	PROPOSED SANITARY SEWER
— SD —	EXISTING STORM SEWER (LESS THAN 12")
— SD —	EXISTING STORM SEWER (12" & LARGER)
— SD —	PROPOSED STORM SEWER (12" & LARGER)
— UE —	EXISTING UNDERGROUND ELECTRICAL
— FO —	EXISTING FIBER OPTIC LINE
— FO —	PROPOSED FIBER OPTIC LINE
— UT —	EXISTING UNDERGROUND TELEPHONE
— UT —	PROPOSED UNDERGROUND TELEPHONE
— G —	EXISTING GAS LINE
	EXISTING ELECTRIC SWITCH BOX
	EXISTING ELECTRIC VAULT
	EXISTING ELECTRIC BOX
	EXISTING PAD MOUNTED TRANSFORMER
	EXISTING FIBER OPTIC PEDESTAL
	EXISTING FIBER OPTIC MANHOLE
	EXISTING FIBER OPTIC PULLBOX
	EXISTING TRAFFIC SIGNAL CABINET
	EXISTING TRAFFIC SIGNAL VAULT
	EXISTING TELEPHONE MANHOLE
	EXISTING TELEPHONE PEDESTAL
	EXISTING TELEPHONE VAULT
	EXISTING GAS VALVE
	EXISTING SANITARY SEWER MANHOLE
	PROPOSED SANITARY SEWER MANHOLE
	EXISTING SANITARY STORM MANHOLE
	PROPOSED STORM SEWER MANHOLE
	PROPOSED STORM INLET
	EXISTING WATER VALVE
	EXISTING FIRE HYDRANT
	PROPOSED FIRE HYDRANT

- ① PROPOSED 3" PVC WATER LINE
- ② PROPOSED 2" WATER SERVICE
- ③ PROPOSED 8" PVC WATER LINE
- ④ PROPOSED FIRE HYDRANT
- ⑤ PROPOSED 6" FIRE LINE
- ⑥ PROPOSED 6" SANITARY SEWER SERVICE (PUBLIC)
- ⑦ PROPOSED 8" SANITARY SEWER LINE (PUBLIC)
- ⑧ PROPOSED 5' CONCENTRIC SANITARY SEWER MANHOLE
- ⑨ EXISTING FIRE HYDRANT
- ⑩ PROPOSED FIRE SERVICE
- ⑪ PROPOSED 8" SANITARY SEWER (PRIVATE)

PRELIMINARY
NOT FOR BIDDING
NOT FOR CONSTRUCTION



NEC OF WOODMEN RD. & BENT GRASS MEADOWS DR.
FALCON, COLORADO

[illegible]

Project No:	ED02
Drawn By:	ELB, AGC
Checked By:	JAO, TJE, CMWJ
Date:	05/22/2026

SP262

0 OF 12

H:\E\Engineering Development\CO, El Paso County - ED000102 - Bent Grass Commercial\DC\12-Plan\ED102_P_10-Utility Plan.dwg - Evan Baczak - 5/27/2026

© Galloway & Company, LLC. Instrument of Service. Not to be copied, disclosed, or reproduced without written consent.


LENA GAIL CASE
119 N WAHSATCH AVE
COLORADO SPRINGS, CO 80903

CYNTHIA DEYOUNG
10924 E HIGHWAY 24
PEYTON, CO 80831


EVERGREEN DEVCO, INC.
1873 SOUTH BELLAIRE ST., SUITE 1200
DENVER, CO 80222
TEL: (303) 757-0414

JEFFREY ODOR
GALLOWAY & CO. LLC
1155 KELLY JOHNSON BLVD., SUITE 305
COLORADO SPRINGS, CO, 80920
TEL: (719) 308-2519

BASED ON SURVEY PERFORMED BY GALLOWAY & COMPANY, LLC
ON 07/01/2025

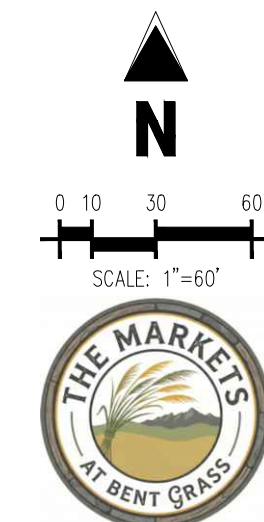

A PORTION OF THE SOUTHWEST QUARTER OF SECTION 1 TOWNSHIP 13 SOUTH,
RANGE 65 WEST OF THE 6TH PRINCIPAL MERIDIAN, EL PASO COUNTY, COLORADO

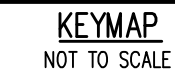

— W —	EXISTING WATER LINE
— W —	PROPOSED WATER LINE
— SS —	EXISTING SANITARY SEWER
— SS —	PROPOSED SANITARY SEWER
— SD —	EXISTING STORM SEWER (LESS THAN 12")
	EXISTING STORM SEWER (12" AND LARGER)
	PROPOSED STORM SEWER (12" AND LARGER)
— UE —	EXISTING UNDERGROUND ELECTRICAL
— FO —	EXISTING FIBER OPTIC LINE
— FO —	PROPOSED FIBER OPTIC LINE
— UT —	EXISTING UNDERGROUND TELEPHONE
— UT —	PROPOSED UNDERGROUND TELEPHONE
— G —	EXISTING GAS LINE
	EXISTING ELECTRIC SWITCH BOX
	EXISTING ELECTRIC VAULT
	EXISTING ELECTRIC BOX
	EXISTING PAD MOUNTED TRANSFORMER
	EXISTING FIBER OPTIC PEDESTAL
	EXISTING FIBER OPTIC MANHOLE
	EXISTING FIBER OPTIC PULLBOX
	EXISTING TRAFFIC SIGNAL CABINET
	EXISTING TRAFFIC SIGNAL VAULT
	EXISTING TELEPHONE MANHOLE
	EXISTING TELEPHONE PEDESTAL
	EXISTING TELEPHONE VAULT
	EXISTING GAS VALVE
	EXISTING SANITARY SEWER MANHOLE
	PROPOSED SANITARY SEWER MANHOLE
	EXISTING SANITARY STORM MANHOLE
	PROPOSED STORM SEWER MANHOLE
	PROPOSED STORM INLET
	EXISTING WATER VALVE
	EXISTING FIRE HYDRANT
	PROPOSED FIRE HYDRANT

- ① PROPOSED 3" PVC WATER LINE
- ② PROPOSED 2" WATER SERVICE
- ③ PROPOSED 8" PVC WATER LINE
- ④ PROPOSED FIRE HYDRANT
- ⑤ PROPOSED 6" FIRE LINE
- ⑥ PROPOSED 6" SANITARY SEWER SERVICE (PUBLIC)
- ⑦ PROPOSED 8" SANITARY SEWER LINE (PUBLIC)
- ⑧ PROPOSED 5' CONCENTRIC SANITARY SEWER MANHOLE
- ⑨ EXISTING FIRE HYDRANT
- ⑩ PROPOSED FIRE SERVICE
- ⑪ PROPOSED 8" SANITARY SEWER (PRIVATE)

[illegible]

Project No:	ED102
Drawn By:	ELB, AGC
Checked By:	JAO, TJE, CMW
Date:	05/22/2028

PRELIMINARY UTILITY PLAN

SP262

PP-11

PRELIMINARY
NOT FOR BIDDING
NOT FOR CONSTRUCTION





PRELIMINARY PLAN
THE MARKETS AT BENT GRASS
EVERGREEN DEVELOPMENT
EPC FILE #: SP262
NEC OF WOODMEN RD. & BENT GRASS MEADOWS DR.
FALCON, COLORADO

H.E.E. van den Broek - Bart Geus Commercial OC/M2, Plan/ED/102_P.11-JUNNY Plan dwg - Enar Baczak - 52720265

© Galloway & Company, LLC. Instrument of Service. Not to be copied, disclosed, or reproduced without written consent.

THE MARKETS AT BENT GRASS


A PORTION OF THE SOUTHWEST QUARTER OF SECTION 1 TOWNSHIP 13 SOUTH,
RANGE 65 WEST OF THE 6TH PRINCIPAL MERIDIAN, EL PASO COUNTY, COLORADO

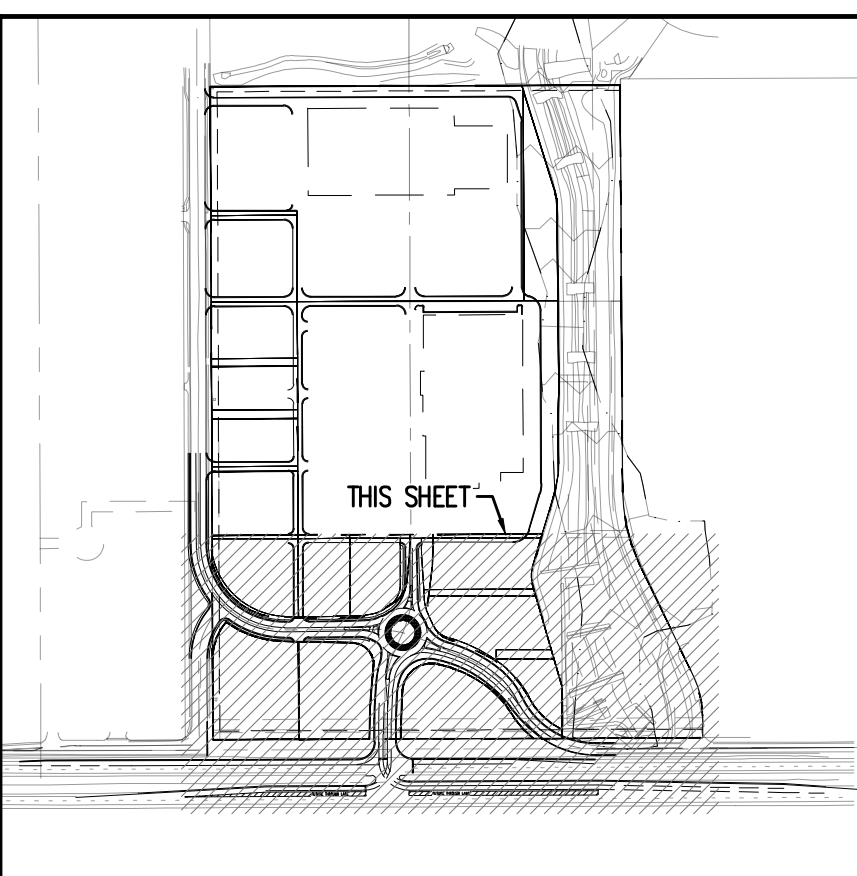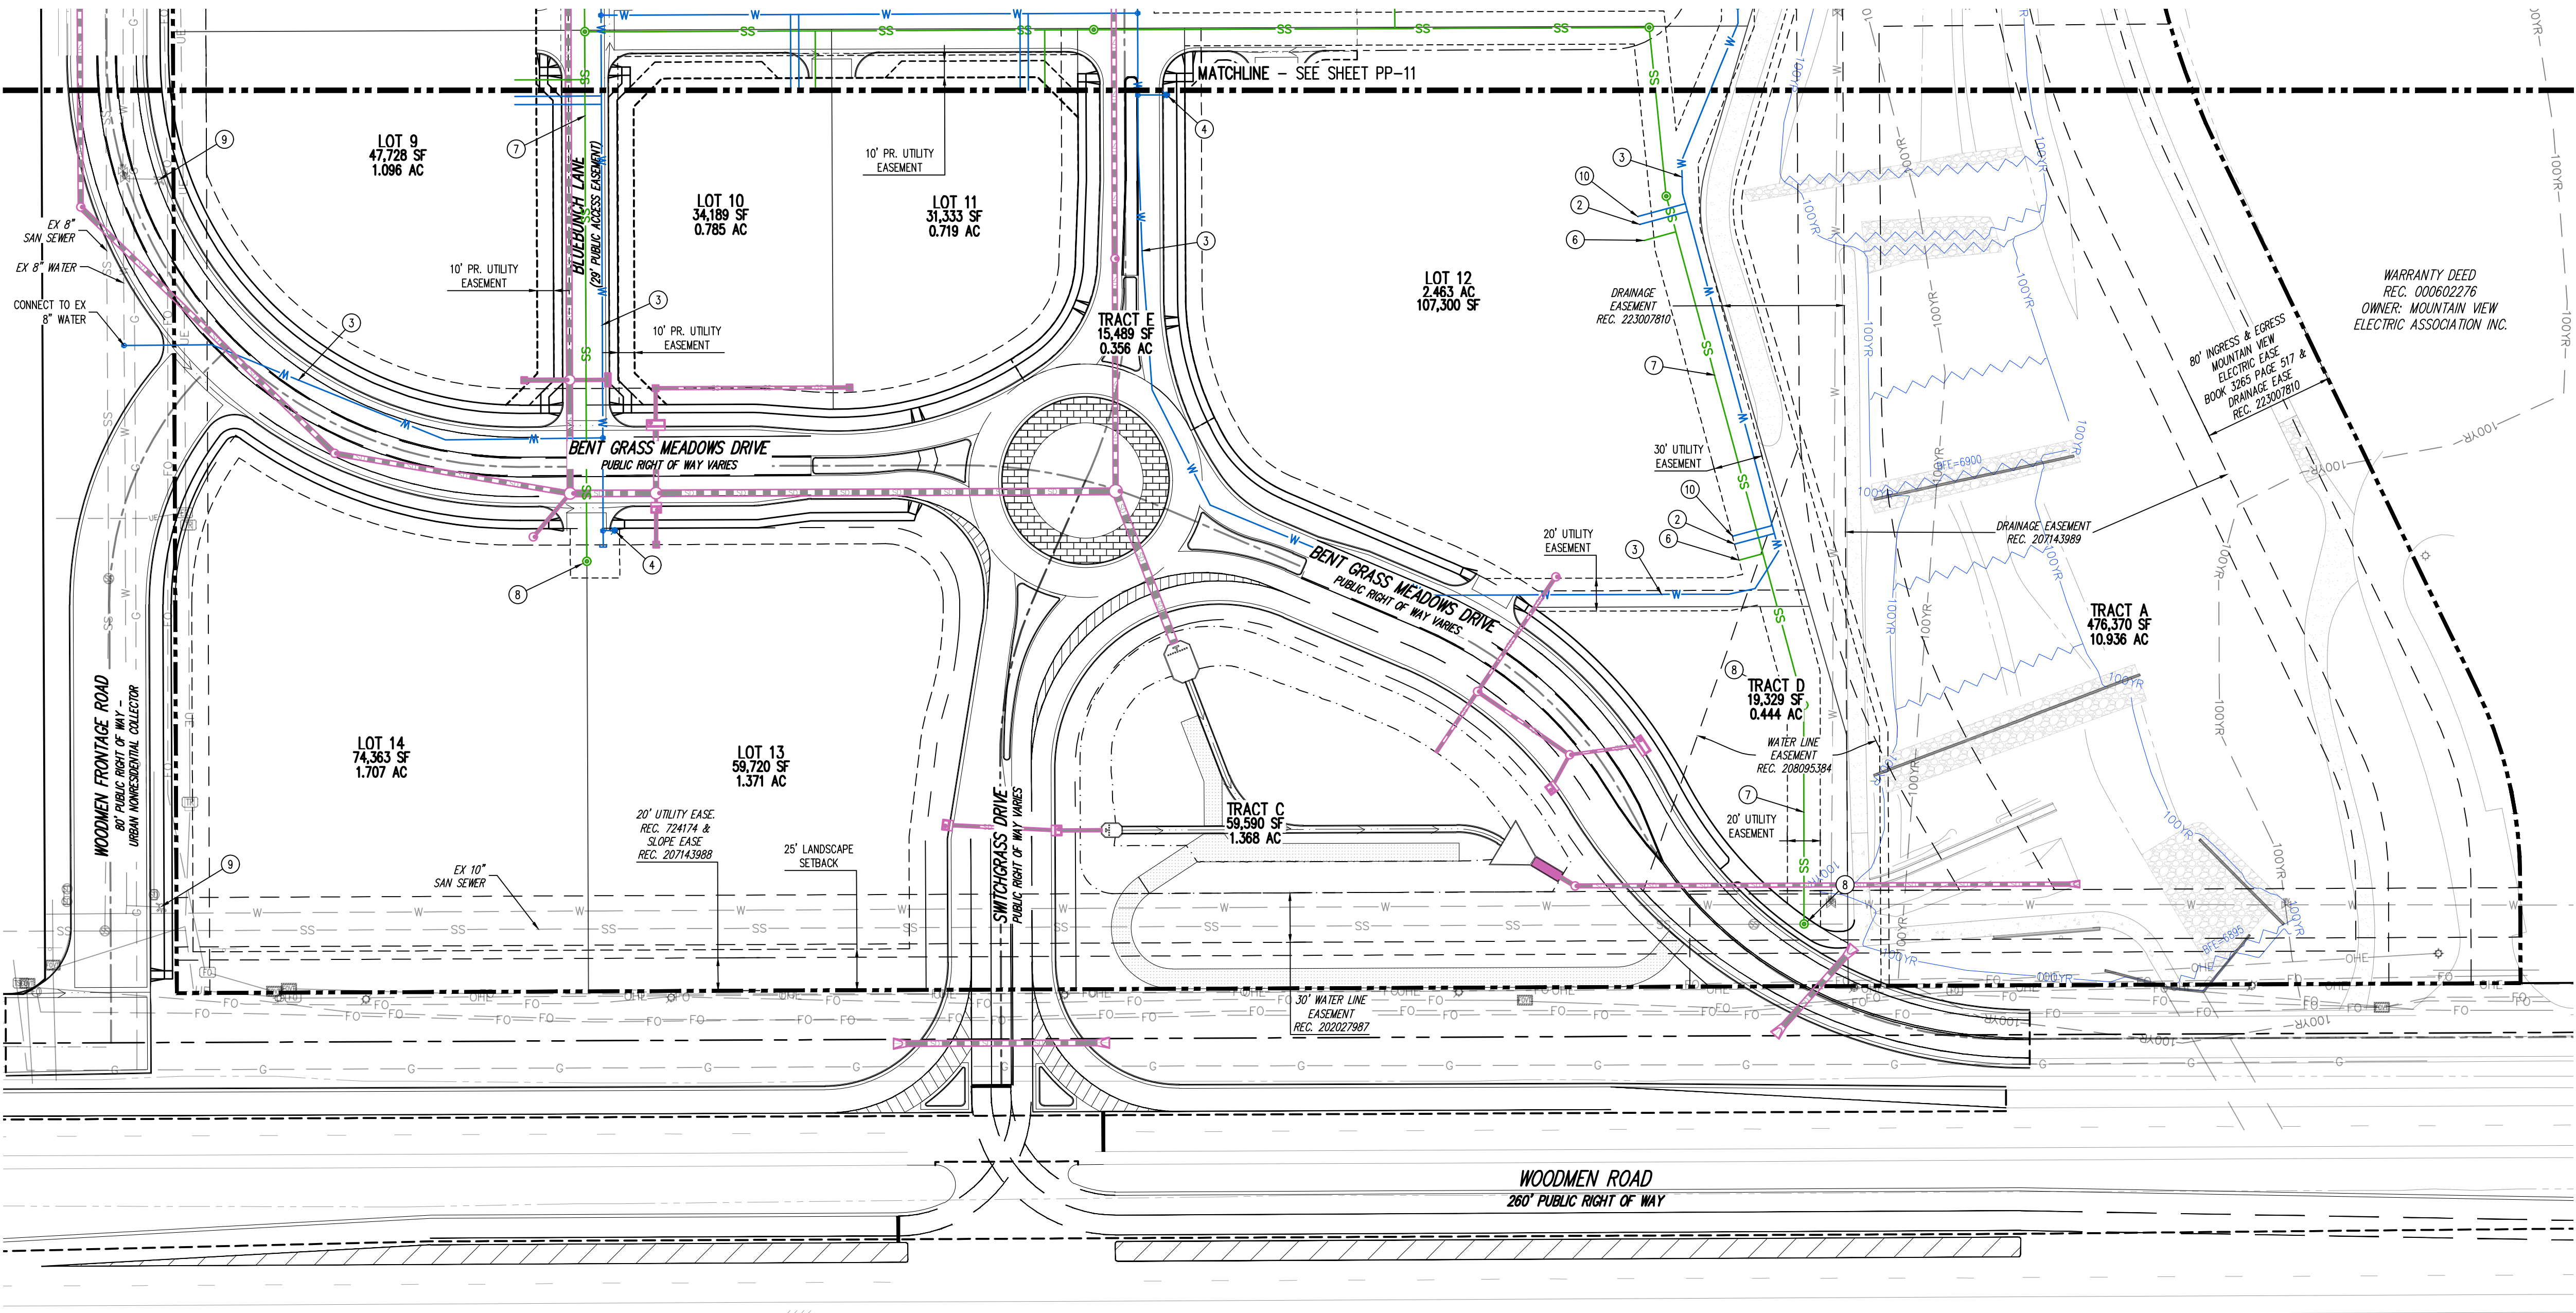

- UTILITY LEGEND
- EXISTING WATER LINE
 - PROPOSED WATER LINE
 - EXISTING SANITARY SEWER
 - PROPOSED SANITARY SEWER
 - EXISTING STORM SEWER (LESS THAN 12")
 - EXISTING STORM SEWER (12" AND LARGER)
 - PROPOSED STORM SEWER (12" AND LARGER)
 - EXISTING UNDERGROUND ELECTRICAL
 - EXISTING FIBER OPTIC LINE
 - PROPOSED FIBER OPTIC LINE
 - EXISTING UNDERGROUND TELEPHONE
 - PROPOSED UNDERGROUND TELEPHONE
 - EXISTING GAS LINE
 - EXISTING ELECTRIC SWITCH BOX
 - EXISTING ELECTRIC VAULT
 - EXISTING ELECTRIC BOX
 - EXISTING PAD MOUNTED TRANSFORMER
 - EXISTING FIBER OPTIC PEDESTAL
 - EXISTING FIBER OPTIC MANHOLE
 - EXISTING FIBER OPTIC PULLBOX
 - EXISTING TRAFFIC SIGNAL CABINET
 - EXISTING TRAFFIC SIGNAL VAULT
 - EXISTING TELEPHONE MANHOLE
 - EXISTING TELEPHONE PEDESTAL
 - EXISTING TELEPHONE VAULT
 - EXISTING GAS VALVE
 - EXISTING SANITARY SEWER MANHOLE
 - PROPOSED SANITARY SEWER MANHOLE
 - EXISTING SANITARY STORM MANHOLE
 - PROPOSED STORM SEWER MANHOLE
 - PROPOSED STORM INLET
 - EXISTING WATER VALVE
 - EXISTING FIRE HYDRANT
 - PROPOSED FIRE HYDRANT

- SCHEDULE
- 1 PROPOSED 3" PVC WATER LINE
 - 2 PROPOSED 2" WATER SERVICE
 - 3 PROPOSED 8" PVC WATER LINE
 - 4 PROPOSED FIRE HYDRANT
 - 5 PROPOSED 6" FIRE LINE
 - 6 PROPOSED 6" SANITARY SEWER SERVICE (PUBLIC)
 - 7 PROPOSED 8" SANITARY SEWER LINE (PUBLIC)
 - 8 PROPOSED 5" CONCENTRIC SANITARY SEWER MANHOLE
 - 9 EXISTING FIRE HYDRANT
 - 10 PROPOSED FIRE SERVICE
 - 11 PROPOSED 8" SANITARY SEWER (PRIVATE)

OWNER OF RECORD	
LENA GAIL CASE 119 N. WANSATCH AVE COLORADO SPRINGS, CO 80903	
OWNER OF RECORD	
CYNTHIA DEYOUNG 10924 E HIGHWAY 24 PEYTON, CO 80831	
APPLICANT	
EVERGREEN DEVCO, INC. 1873 SOUTH BELLAIRE ST., SUITE 1200 DENVER, CO 80222 TEL: (303) 757-0414	
PLAN PREPARER	
JEFFREY ODOR GALLOWAY & CO. LLC 1155 KELLY JOHNSON BLVD., SUITE 305 COLORADO SPRINGS, CO, 80920 TEL: (719) 308-2519	
BASED ON SURVEY PERFORMED BY GALLOWAY & COMPANY, LLC ON 07/01/2025	

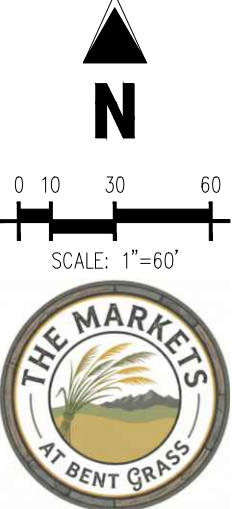

Galloway

1155 Kelly Johnson Blvd., Suite 305
Colorado Springs, CO 80920
719.900.7220
GallowayUS.com

Galloway & Company, LLC

PRELIMINARY
NOT FOR BIDDING
NOT FOR CONSTRUCTION

Evergreen
Multi-family Retail Industrial



PRELIMINARY PLAN
THE MARKETS AT BENT GRASS
EVERGREEN DEVELOPMENT
EPC FILE #: SP262
NEC OF WOODMEN RD. & BENT GRASS MEADOWS DR.
FALCON, COLORADO

#	Date	Issue / Description	Init.
1	03/04/2026	1ST PRELIMINARY PLAN SUBMITTAL	
2	05/22/2026	2ND PRELIMINARY PLAN SUBMITTAL	

Project No: EDI02
Drawn By: ELB, AGC
Checked By: JAO, TJE, CMWJ
Date: 05/22/2026

PRELIMINARY UTILITY PLAN

SP262