### STANDARD NOTES FOR EL PASO COUNTY GRADING & EROSION PLAN:

- STORMWATER DISCHARGES FROM CONSTRUCTION SITES SHALL NOT CAUSE OR THREATEN TO CAUSE POLLUTION, CONTAMINATION, OR DEGRADATION OF STATE WATERS. ALL WORK AND EARTH DISTURBANCE SHALL BE DONE IN A
- MANNER THAT MINIMIZES POLLUTION OF ANY ON-SITE OR OFF-SITE WATERS, INCLUDING WETLANDS NOTWITHSTANDING ANYTHING DEPICTED IN THESE PLANS IN WORDS OR GRAPHIC REPRENSENTATION, ALL DESIGN AND CONSTRUCTION RELATED TO ROADS, STORM DRAINAGE AND EROSION CONTROL SHALL CONFORM TO THE STANDARDS AND REQUIREMENTS OF THE MOST RECENT VERSION OF THE RELEVANT ADOPTED EL PASO COUNTY STANDARDS, INCLUDING THE LAND DEVELOPMENT CODE, THE ENGINEERING CRITERIA MANUAL, THE DRAINAGE CRITERIA MANUAL AND THE DRAINAGE CRITERIA MANUAL VOLUME 2. ANY DEVIATIONS FROM REGULATIONS AND STANDARDS MUST BE REQUESTED, AND APPROVED, IN WRITING.
- A SEPARATE STORMWATER MANAGEMENT PLAN (SWMP) FOR THIS PROJECT SHALL BE COMPLETED AND AN EROSION AND STORMWATER QUALITY CONTROL PERMIT (ESQCP) ISSUED PRIOR TO COMMENCING CONSTRUCTION. MANAGEMENT OF THE SWMP DURING CONSTRUCTION IS THE RESPONSIBILITY OF THE DESIGNATED QUALIFIED STORMWATER MANAGER OR CERTIFIED EROSION CONTROL INSPECTOR. THE SWMP SHALL BE LOCATED ON-SITE AT ALL TIMES DURING CONSTRUCTION AND SHALL BE KEPT UP TO DATE WITH WORK PROGRESS AND CHANGES IN THE FIELD
- ONCE THE ESQCP IS APPROVED AND A "NOTICE TO PROCEED" HAS BEEN ISSUED, THE CONTRACTOR MAY INSTALL THE INITIAL STAGE EROSION AND SEDIMENT CONTROL MEASURES AS INDICATED ON THE APPROVED GEC. A PRECONSTRUCTION MEETING BETWEEN THE CONTRACTOR, ENGINEER, AND EL PASO COUNTY WILL BE HELD PRIOR TO ANY CONSTRUCTION. IT IS THE RESPONSIBILITY OF THE APPLICANT TO COORDINATE THE MEETING TIME AND PLACE
- CONTROL MEASURES MUST BE INSTALLED PRIOR TO COMMENCEMENT OF ACTIVITIES THAT COULD CONTRIBUTE POLLUTANTS TO STORMWATER. CONTROL MEASURES FOR ALL SLOPES, CHANNELS, DITCHES, AND DISTURBED LAND
- AREAS SHALL BE INSTALLED IMMEDIATELY UPON COMPLETION OF THE DISTURBANCE. ALL CONSTRUCTION CONTROL MEASURES SHALL BE MAINTAINED UNTIL PERMANENT STABILIZATION MEASURES ARE
- IMPLEMENTED. TEMPORARY CONSTRUCTION CONTROL MEASURES MUST BE REMOVED PRIOR TO PERMIT CLOSEOUT. TEMPORARY STABILIZATION SHALL BE IMPLEMENTED ON DISTURBED AREAS AND STOCKPILES WHERE GROUND DISTURBING CONSTRUCTION ACTIVITY HAS PERMANENTLY CEASED OR TEMPORARILY CEASED FOR LONGER THAN 14
- FINAL STABILIZATION MUST BE IMPLEMENTED AT ALL APPLICABLE CONSTRUCTION SITES. FINAL STABILIZATION IS ACHIEVED WHEN ALL GROUND DISTURBING ACTIVITIES ARE COMPLETE AND ALL DISTURBED AREAS EITHER HAVE A UNIFORM VEGETATIVE COVER WITH INDIVIDUAL PLANT DENSITY OF 70 PERCENT OF PRE-DISTURBANCE LEVELS ESTABLISHED OR EQUIVALENT PERMANENT ALTERNATIVE STABILIZATION METHOD IS IMPLEMENTED. ALL TEMPORARY
- SEDIMENT AND EROSION CONTROL MEASURES SHALL BE REMOVED UPON FINAL STABILIZATION AND BEFORE PERMIT ALL PERMANENT STORMWATER MANAGEMENT FACILITIES SHALL BE INSTALLED AS DESIGNED IN THE APPROVED PLANS.

ANY PROPOSED CHANGES THAT EFFECT THE DESIGN OR FUNCTION OF PERMANENT STORMWATER MANAGEMENT

- STRUCTURES MUST BE APPROVED BY THE ECM ADMINISTRATOR PRIOR TO IMPLEMENTATION. . EARTH DISTURBANCES SHALL BE CONDUCTED IN SUCH A MANNER SO AS TO EFFECTIVELY MINIMIZE ACCELERATED SOIL EROSION AND RESULTING SEDIMENTATION. ALL DISTURBANCES SHALL BE DESIGNED, CONSTRUCTED, AND COMPLETED SO THAT THE EXPOSED AREA OF ANY DISTURBED LAND SHALL BE LIMITED TO THE SORTEST PRACTICAL PERIOD OF TIME. PRE-EXISTING VEGETATION SHALL BE PROTECTED AND MAINTAINED WITHIN 50 HORIZONTAL FEET OF A WATERS OF THE STATE UNLESS SHOWN TO BE INFEASIBLE AND SPECIFICALLY REQUESTED AND APPROVED
- COMPACTION OF SOIL MUST BE PREVENTED IN AREAS DESIGNATED FOR INFILTRATION CONTROL MEASURES OR WHERE FINAL STABILIZATION WILL BE ACHIEVED BY THE VEGETATIVE COVER. AREAS DESIGNATED FOR INFILTRATION CONTROL MEASURES SHALL ALSO BE PROTECTED FROM SEDIMENTATION DURING CONSTRUCTION UNTIL FINAL STABILIZATION IS ACHIEVED. IF COMPACTION PREVENTION IS NOT FEASIBLE DUE TO SITE CONSTRAINTS, ALL AREAS DESIGNATED FOR INFILTRATION AND VEGETATION CONTROL MEASURES MUST BE LOOSENED PRIOR TO INSTALLATION OF THE CONTROL
- 2. ANY TEMPORARY OR PERMANENT FACILITY DESIGNED AND CONSTRUCTED FOR THE CONVEYANCE OF STORMWATER AROUND, THROUGH, OR FROM THE EARTH DISTURBANCE AREA SHALL BE A STABILIZED CONVEYANCE DESIGNED TO
- MINIMIZE EROSION AND THE DISCHARGE OF SEDIMENT OFF-SITE. 3. CONCRETE WASH WATER SHALL BE CONTAINED AND DISPOSED OF IN ACCORDANCE WITH THE SHALL BE DISCHARGED TO OR ALLOWED TO ENTER STATE WATERS, INCLUDING ANY SURFACE OR SUBSURFACE STORM DRAINAGE SYSTEM OR FACILITIES. CONCRETE WASHOUTS SHALL NOT BE LOCATED IN AN AREA WHERE SHALLOW GROUNDWATER MAY BE PRESENT. OR WITHIN 50 FEET OF A SURFACE WATER BODY, CREEK OR STREAM.
- LEAVE THE SITE IN THE FORM OF SURFACE RUNOFF UNLESS AN APPROVED STATE DEWATERING PERMIT IS IN PLACE
- . EROSION CONTROL BLANKETING OR OTHER PROTECTIVE COVERING SHALL BE USED ON SLOPES STEEPER THAN 3:1. 16. CONTRACTOR SHALL BE RESPONSIBLE FOR THE REMOVAL OF ALL WASTES FROM THE CONSTRUCTION SITE FOR DISPOSAL IN ACCORDANCE WITH LOCAL AND STATE REGULATORY REQUIREMENTS. NO CONSTRUCTION DEBRIS, TREE SLASH, BUILDING MATERIAL WASTES OR UNUSED BUILDING MATERIALS SHALL BE BURIED, DUMPED, OR DISCHARGED
- 17. WASTE MATERIALS SHALL NOT BE TEMPORARILY PLACED OR STORED IN THE STREET, ALLEY, OR OTHER PUBLIC WAY, UNLESS IN ACCORDANCE WITH AN APPROVED TRAFFIC CONTROL PLAN. CONTROL MEASURES MAY BE REQUIRED BY EL
- PASO COUNTY ENGINEERING IF DEEMED NECESSARY. BASED ON SPECIFIC CONDITIONS AND CIRCUMSTANCES. 18. TRACKING OF SOILS AND CONSTRUCTION DEBRIS OFF—SITE SHALL BE MINIMIZED. MATERIALS TRACKED OFF—SITE
- SHALL BE CLEANED UP AND PROPERLY DISPOSED OF IMMEDIATELY. . THE OWNER/DEVELOPER SHALL BE RESPONSIBLE FOR THE REMOVAL OF ALL CONSTRUCTION DEBRIS, DIRT, TRASH ROCK, SEDIMENT, SOIL, AND SAND THAT MAY ACCUMULATE IN ROADS, STORM DRAINS AND OTHER DRAINAGE
- CONVEYANCE SYSTEMS AND STORMWATER APPURTENANCES AS A RESULT OF SITE DEVELOPMENT. 20. THE QUANTITY OF MATERIALS STORED ON THE PROJECT SITE SHALL BE LIMITED, AS MUCH AS PRACTICAL, TO THAT QUANTITY REQUIRED TO PERFORM THE WORK IN AN ORDERLY SEQUENCE. ALL MATERIALS STORED ON-SITE SHALL BE
- STORED IN A NEAT, ORDERLY MANNER, IN THEIR ORIGINAL CONTAINERS, WITH ORIGINAL MANUFACTURER'S LABELS. 21. NO CHEMICAL(S) HAVING THE POTENTIAL TO BE RELEASED IN STORMWATER ARE TO BE STORED OR USED ON-SITE

UNLESS PERMISSION FOR THE USE OF SUCH CHEMICAL(S) IS GRANTED IN WRITING BY THE ECM ADMINISTRATOR. IN

- GRANTING APPROVAL FOR THE USE OF SUCH CHEMICAL(S), SPECIAL CONDITIONS AND MONITORING MAY BE REQUIRED. 22. BULK STORAGE OF ALLOWED PETROLEUM PRODUCTS OR OTHER ALLOWED LIQUID CHEMICALS IN EXCESS OF 55 GALLONS SHALL REQUIRE ADEQUATE SECONDARY CONTAINMENT PROTECTION TO CONTAIN ALL SPILLS ON-SITE AND TO PREVENT ANY SPILLED MATERIALS FROM ENTERING STATE WATERS. ANY SURFACE OR SUBSURFACE STORM
- DRAINAGE SYSTEM OR OTHER FACILITIES. 23. NO PERSON SHALL CAUSE THE IMPEDIMENT OF STORMWATER FLOW IN THE CURB AND GUTTER OR DITCH EXCEPT WITH APPROVED SEDIMENT CONTROL MEASURES.
- 24. OWNER/DEVELOPER AND THEIR AGENTS SHALL COMPLY WITH THE "COLORADO WATER QUALITY CONTROL ACT" (TITLE 25, ARTICLE 8, CRS), AND THE "CLEAN WATER ACT" (33 USC 1344), IN ADDITION TO THE REQUIREMENTS OF THE LAND DEVELOPMENT CODE, DCM VOLUME II AND THE ECM APPENDIX I. ALL APPROPRIATE PERMITS MUST BE OBTAINED BY THE CONTRACTOR PRIOR TO CONSTRUCTION (1041, NPDES, FLOODPLAIN, 404, FUGITIVE DUST, ETC.). IN THE EVENT OF CONFLICTS BETWEEN THESE REQUIREMENTS AND OTHER LAWS, RULES, OR REGULATIONS OF OTHER FEDERAL, STATE, LOCAL, OR COUNTY AGENCIES, THE MOST RESTRICTIVE LAWS, RULES, OR REGULATIONS SHALL
- 25. ALL CONSTRUCTION TRAFFIC MUST ENTER/EXIT THE SITE ONLY AT APPROVED CONSTRUCTION ACCESS POINTS.
- 26. PRIOR TO CONSTRUCTION THE PERMITTEE SHALL VERIFY THE LOCATION OF EXISTING UTILITIES. 27. A WATER SOURCE SHALL BE AVAILABLE ON-SITE DURING EARTHWORK OPERATIONS AND SHALL BE UTILIZED AS
- REQUIRED TO MINIMIZE DUST FROM EARTHWORK EQUIPMENT AND WIND.
- 28. THE SOILS REPORT FOR THIS SITE HAS BEEN PREPARED BY RMG-ROCKY MOUNTAIN GROUP, DATED OCTOBER 8, 2021 AND SHALL BE CONSIDERED A PART OF THESE PLANS.
- 29. AT LEAST TEN (10) DAYS PRIOR TO THE ANTICIPATED START OF CONSTRUCTION, FOR PROJECTS THAT WILL DISTURB ONE (1) ACRE OR MORE, THE OWNER OR OPERATOR OF CONSTRUCTION ACTIVITY SHALL SUBMIT A PERMIT APPLICATION FOR STORMWATER DISCHARGE TO THE COLORADO DEPARTMENT OF PUBLIC HEALTH AND ENVIRONMENT. WATER QUALITY DIVISION. THE APPLICATION CONTAINS CERTIFICATION OF COMPLETION OF A STORMWATER MANAGEMENT PLAN (SWMP), OF WHICH THIS GRADING AND EROSION CONTROL PLAN MAY BE A PART. FOR INFORMATION OR APPLICATION MATERIALS CONTACT:

COLORADO DEPARTMENT OF PUBLIC HEALTH AND ENVIRONMENT WATER QUALITY CONTROL DIVISION WQCD-PERMITS 4300 CHERRY CREEK DRIVE SOUTH

DENVER, CO 80246-1530 ATTN: PERMITS UNIT

# CHALLENGER HOMES FALCON HIGHLANDS SOUTH

SITUATED IN SECTION 12, TOWNSHIP 13 SOUTH, RANGE 65 WEST OF THE SIXTH PRINCIPAL MERIDIAN, COUNTY OF EL PASO, STATE OF COLORADO GRADING & EROSION CONTROL PLANS



# **LEGAL DESCRIPTION:**

A PORTION OF SECTION 12, TOWNSHIP 13 SOUTH, RANGE 65 WEST OF THE SIXTH PRINCIPAL MERIDIAN, COUNTY OF EL

### PROJECT DESCRIPTION:

378 SINGLE-FAMILY RESIDENTIAL LOT DEVELOPMENT OVER 125.5 ACRES.

### FLOODPLAIN STATEMENT:

THE SUBJECT PROPERTY IS NOT LOCATED IN A DESIGNATED FLOODPLAIN AS SHOWN ON THE FEMA FLOOD INSURANCE RATE MAP 08041C0561G, EFFECTIVE DECEMBER 7, 2018.

### NOTE:

DETENTION AND WATER QUALITY ARE PROVIDED IN THE EXISTING DOWNSTREAM WATER QUALITY AND DETENTION POND FACILITIES, POND 1, 2 & WU. LOCATED EAST OF THE PROPOSED DEVELOPMENT, NORTHWEST OF HIGHWAY 24.

### DESCRIPTION OF CONSTRUCTION ACTIVITIES:

ANTICIPATED STARTING AND COMPLETION TIME PERIOD OF SITE GRADING:

JANUARY 2023

EXPECTED DATE ON WHICH THE FINAL STABILIZATION WILL BE COMPLETED:

OCTOBER 2023

TOTAL AREA OF THE SITE TO BE CLEARED, EXCAVATED, OR GRADED:

APPROXIMATELY 115 ACRES

### **RECEIVING WATERS:**

ULTIMATE RECEIVING WATER IS SAND CREEK DRAINAGE BASIN AND FALCON DRAINAGE BASIN. SOIL TYPE:

THE SITE IS UNDERLAIN BY BLAKELAND-FLUVAQUENTIC HAPLAQUOILS, HYDROLOGIC SOIL GROUP A.

SHEET SHEET TITLE NUMBER COVER INITIAL GECP INITIAL GECP INITIAL GECP INITIAL GECP INTERIM GECP INTERIM GECP INTERIM GECP INTERIM GECP FINAL GECP FINAL GECP FINAL GECP FINAL GECP DETAIL GECP DETAIL GECP DETAIL GECP

DETAIL GECP

SHEET LIST TABLE

CHALLENGER HOMES

8605 EXPLORER DRIVE

STE. 250 COLORADO SPRINGS, CO 80920

(719) 598-5192

CONTACT: JIM BYERS

SURVEYOR: ATWELL, LLC.

143 UNION BLVD.

STE. 700

LAKEWOOD, CO 80228

(303) 462-1100

CONTACT: KENNETH SCHRAMM

ENGINEER'S STATEMENT

PCD-ENGINEERING REVIEW COMMENTS

IN BLUE BOXES WITH BLUE TEXT

THIS GRADING AND EROSION CONTROL PLAN WAS PREPARED UNDER MY DIRECT SUPERVISION AND IS CORRECT TO THE BEST OF MY KNOWLEDGE AND BELIEF. SAID PLAN HAS BEEN PREPARED ACCORDING TO THE CRITERIA ESTABLISHED BY THE COUNTY FOR GRADING AND EROSION CONTROL PLANS. I ACCEPT RESPONSIBILITY FOR ANY LIABILITY CAUSED BY ANY NEGLIGENT ACTS, ERRORS OR OMISSIONS ON MY PART IN PREPARING THIS PLAN.

ENGINEER OF RECORD SIGNATURE RICHARD D. LYON, PE

**EPC STORMWATER REVIEW COMMENTS** 

IN ORANGE BOXES WITH BLACK TEXT

### OWNER'S STATEMENT

I, THE OWNER/DEVELOPER HAVE READ AND WILL COMPLY WITH THE REQUIREMENTS OF THE GRADING AND EROSION CONTROL PLAN.

08/30/2022

### EL PASO COUNTY

COUNTY PLAN REVIEW IS PROVIDED ONLY FOR GENERAL CONFORMANCE WITH COUNTY DESIGN CRITERIA. THE COUNTY IS NOT RESPONSIBLE FOR THE ACCURACY AND ADEQUACY OF THE DESIGN, DIMENSIONS, AND/OR ELEVATIONS WHICH SHALL BE CONFIRMED AT THE JOB SITE. THE COUNTY THROUGH THE APPROVAL OF THIS DOCUMENT ASSUMES NO RESPONSIBILITY FOR COMPLETENESS AND/OR ACCURACY OF THIS DOCUMENT.

FILED IN ACCORDANCE WITH THE REQUIREMENTS OF THE EL PASO COUNTY LAND DEVELOPMENT CODE, DRAINAGE CRITERIA MANUAL VOLUMES 1 AND 2, AND ENGINEERING CRITERIA MANUAL, AS

IN ACCORDANCE WITH ECM SECTION 1.12. THESE CONSTRUCTION DOCUMENTS WILL BE VALID FOR CONSTRUCTION FOR A PERIOD OF 2 YEARS FROM THE DATE SIGNED BY THE EL PASO COUNTY ENGINEER. IF CONSTRUCTION HAS NOT STARTED WITHIN THOSE 2 YEARS, THE PLANS WILL NEED TO BE RESUBMITTED FOR APPROVAL INCLUDING PAYMENT OF REVIEW FEES AT THE PLANNING AND COMMUNITY DEVELOPMENT DIRECTOR'S DISCRETION.

COUNTY ENGINEER / ECM ADMINISTRATOR DATE

# **GENERAL NOTES:**

WOODMEN HILLS METROPOLITAN

8046 EASTVILLE ROAD

FALCON, CO 80831

(719) 495-2500

CONTACT: RYAN MANGINO

143 UNION BLVD.,

LAKEWOOD, CO 80228

(303) 462-1100 CONTACT: RICHARD LYON

**EL PASO COUNTY:** 3275 AKERS DRIVE

COLORADO SPRINGS, CO 80922

(719) 520-6460 CONTACT: ELIZABETH NIIJKAMP

**CIVIL ENGINEER:** 

- 1. EXISTING VEGETATION OF SITE IS APPROXIMATELY 97.0 PERCENT CONSISTING OF NATIVE GRASSES AND WEEDS.
- 2. CONCLUSIONS FROM SOILS/GEOTECHNICAL REPORT AND GEOLOGIC HAZARDS REPORT INCORPORATED IN GRADING DESIGN (SLOPES, EMBANKMENTS, MATERIALS, MITIGATION, ETC.)
- 3. THERE ARE NO LOCATIONS OF ANY DEDICATED ASPHALT / CONCRETE BATCH PLANTS.
- 4. THE USE OF CONSTRUCTION OFFICE TRAILERS REQUIRE PCD PERMITTING.

JOSHUA PALMER, P.E.

- 5. NO DEWATERING OPERATIONS ARE ANTICIPATED AT THIS TIME. IF THE CONTRACTOR DISCOVERS GROUNDWATER, ALL CONSTRUCTION SHALL STOP UNTIL PROPER PROCEDURES APPROVED BY THE ENGINEER OF RECORD AND EL PASO COUNTY ARE PUT IN PLACE.
- 6. THERE IS NO PROPOSED OFFSITE DISTURBANCE AND THERE ARE NO OFFSITE STORMWATER CONTROL MEASURES PROPOSED.
- 7. THERE ARE NO PROPOSED RETAINING WALLS LOCATED WITHIN COUNTY RIGHT-OF-WAY.
- 8. STRUCTURAL CONTROL MEASURES INCLUDE PONDS 1, 2, AND WU AND PROPOSED GRASSLINED SWALE.

**BENCHMARK:** 

ELEVATIONS ARE BASED UPON SW COR SEC. 12, T13S, R65W, 6TH PM, FND. 3.25" ALUM. CAP. (ELEVATION: 6810.43=NAVD88).


BASIS OF BEARINGS:

BEARINGS ARE BASED UPON THE WEST LINE OF THE SOUTHWEST QUARTER OF SECTION 12. TOWNSHIP 13 SOUTH, RANGE 65 WEST OF THE SIXTH PRINCIPAL MERIDIAN, MONUMENTED AT THE SOUTH END BY A FOUND3-1/4" ALUMINUM CAP STAMPED "AZTEC CONSULTANTS PLS 38256" AND AT THE NORTH END BY A FOUND 3-1/4" ALUMINUM CAP STAMPED "PLS 4842".

now what's **below**. Call before you dig

TRUCTION SITE SAFETY

EPRODUCTION SHALL BE MA WITHOUT THE PRIOR WRITTE

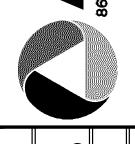

ADO


8/31/2022 SUBMITTAL TO EPC


REVISIONS


COUNTY FILE NO. PUDSP-22-005


JD || CH.


RDL 21005234

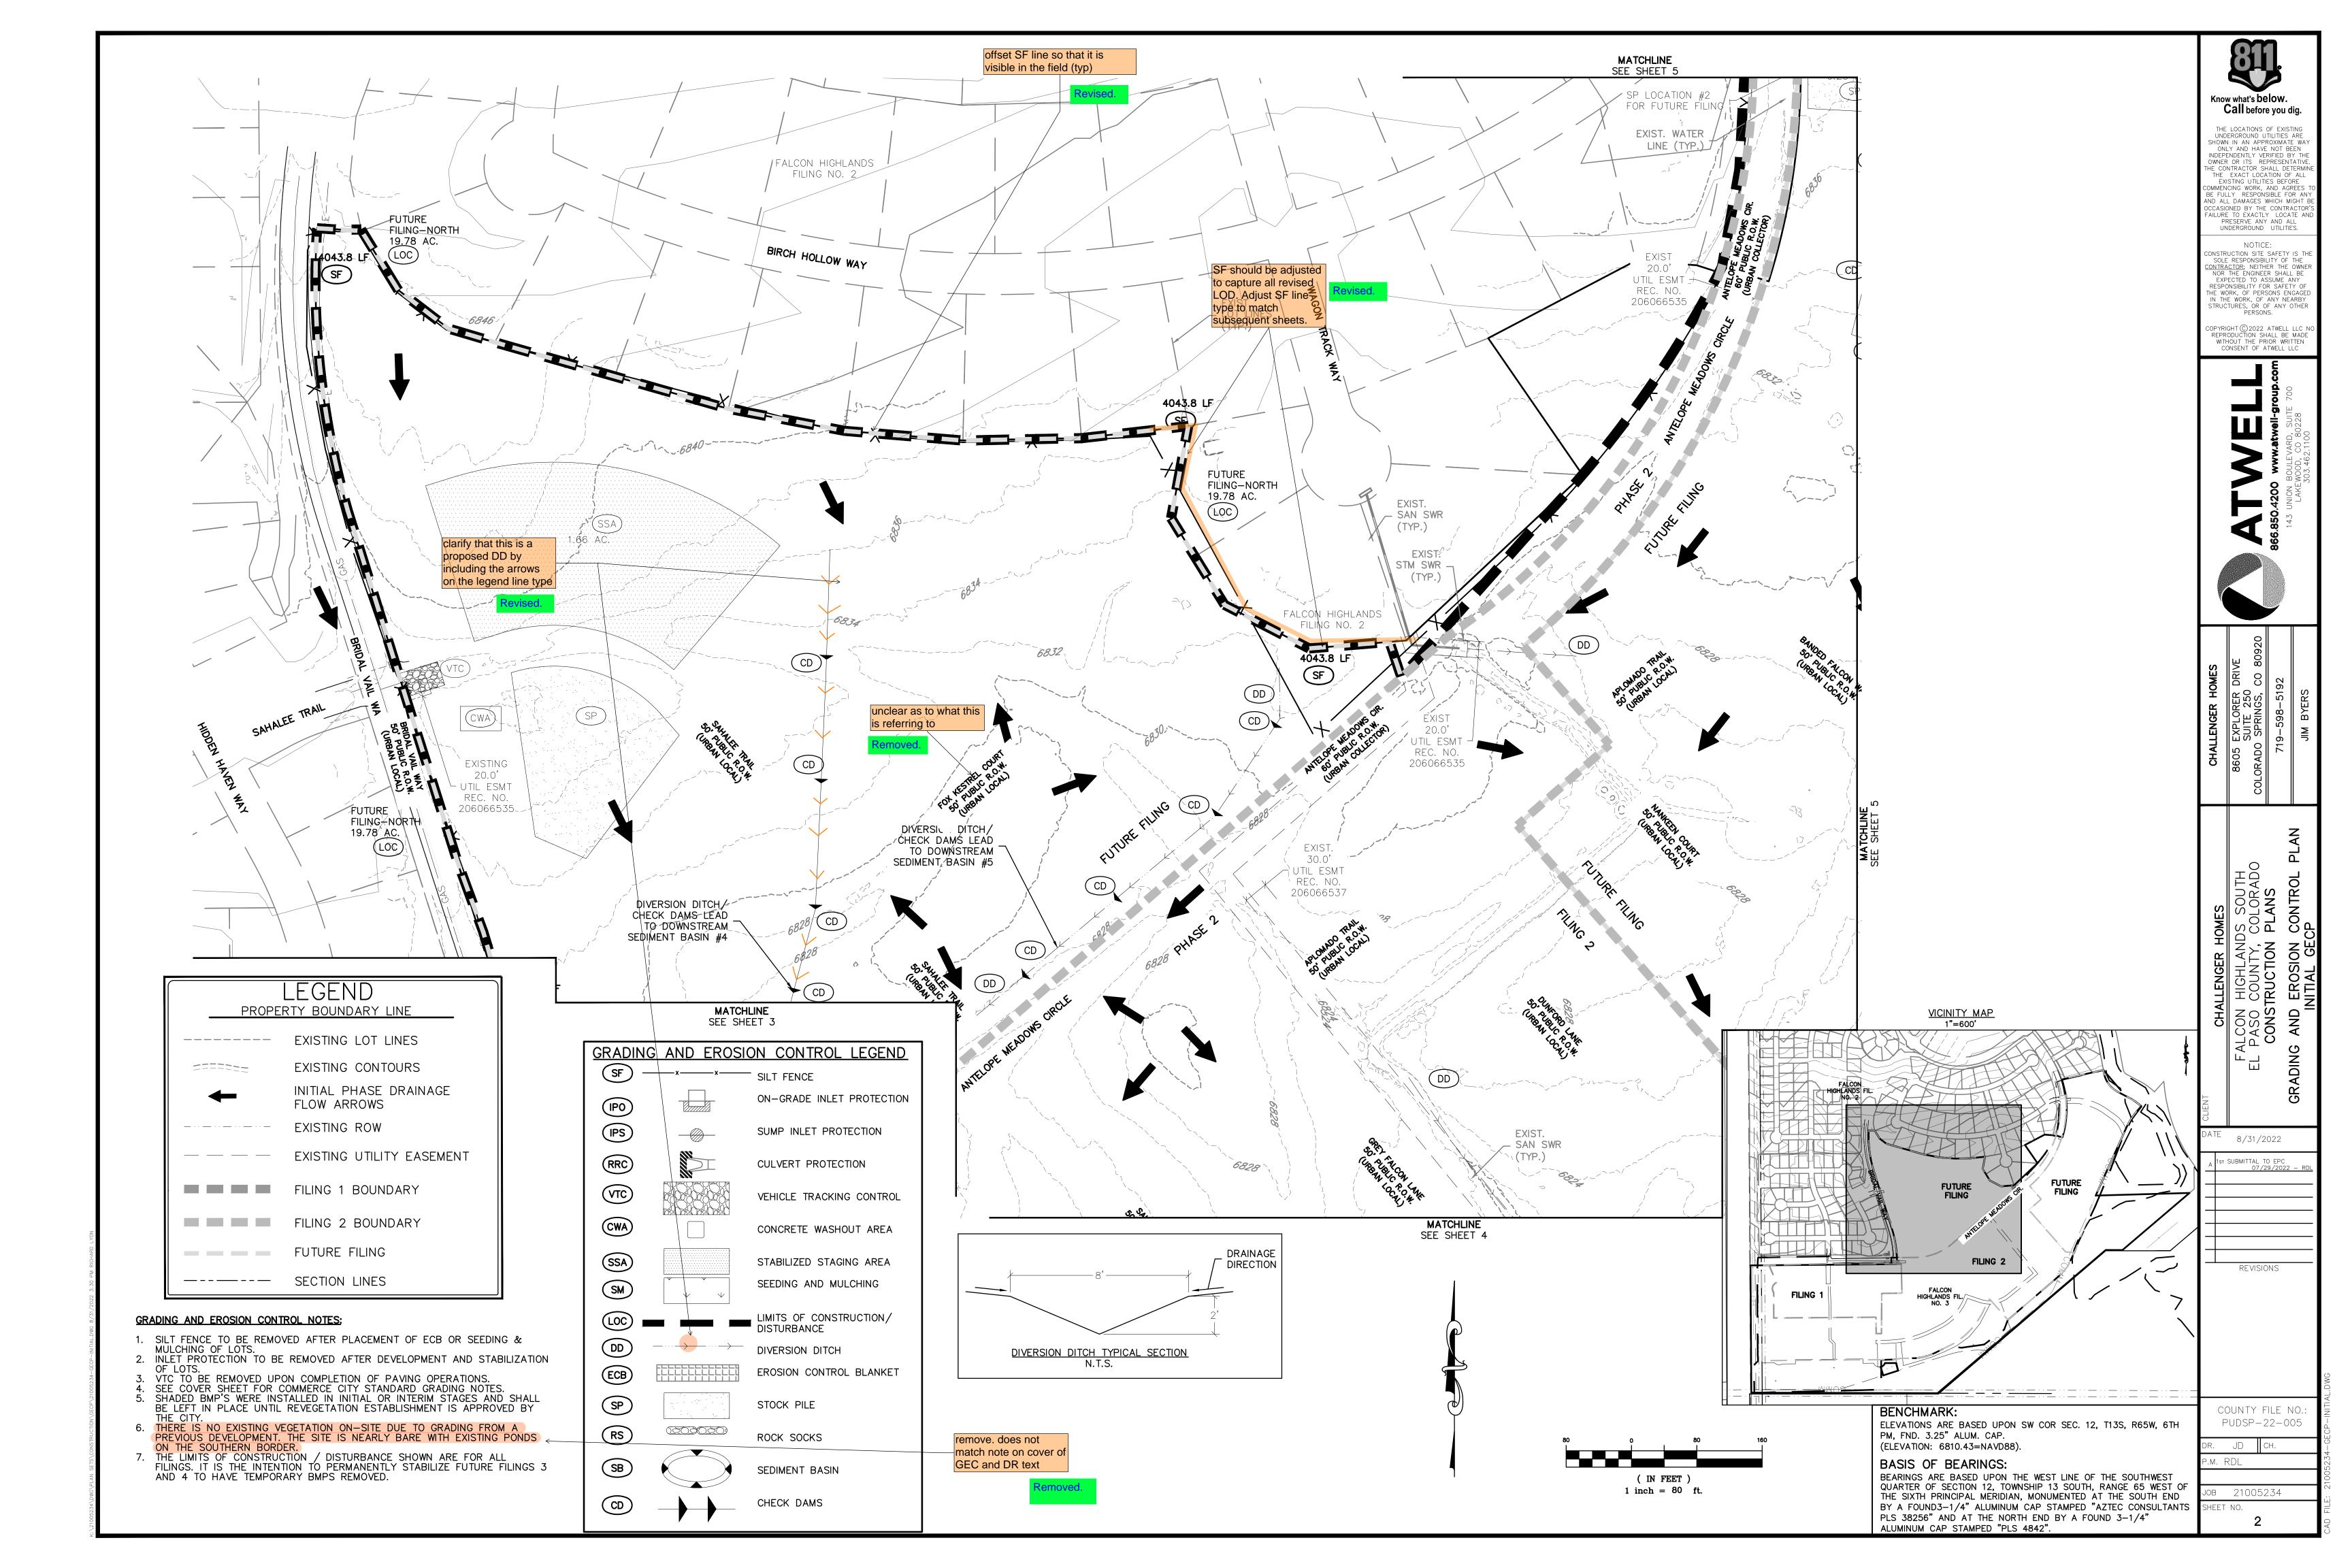


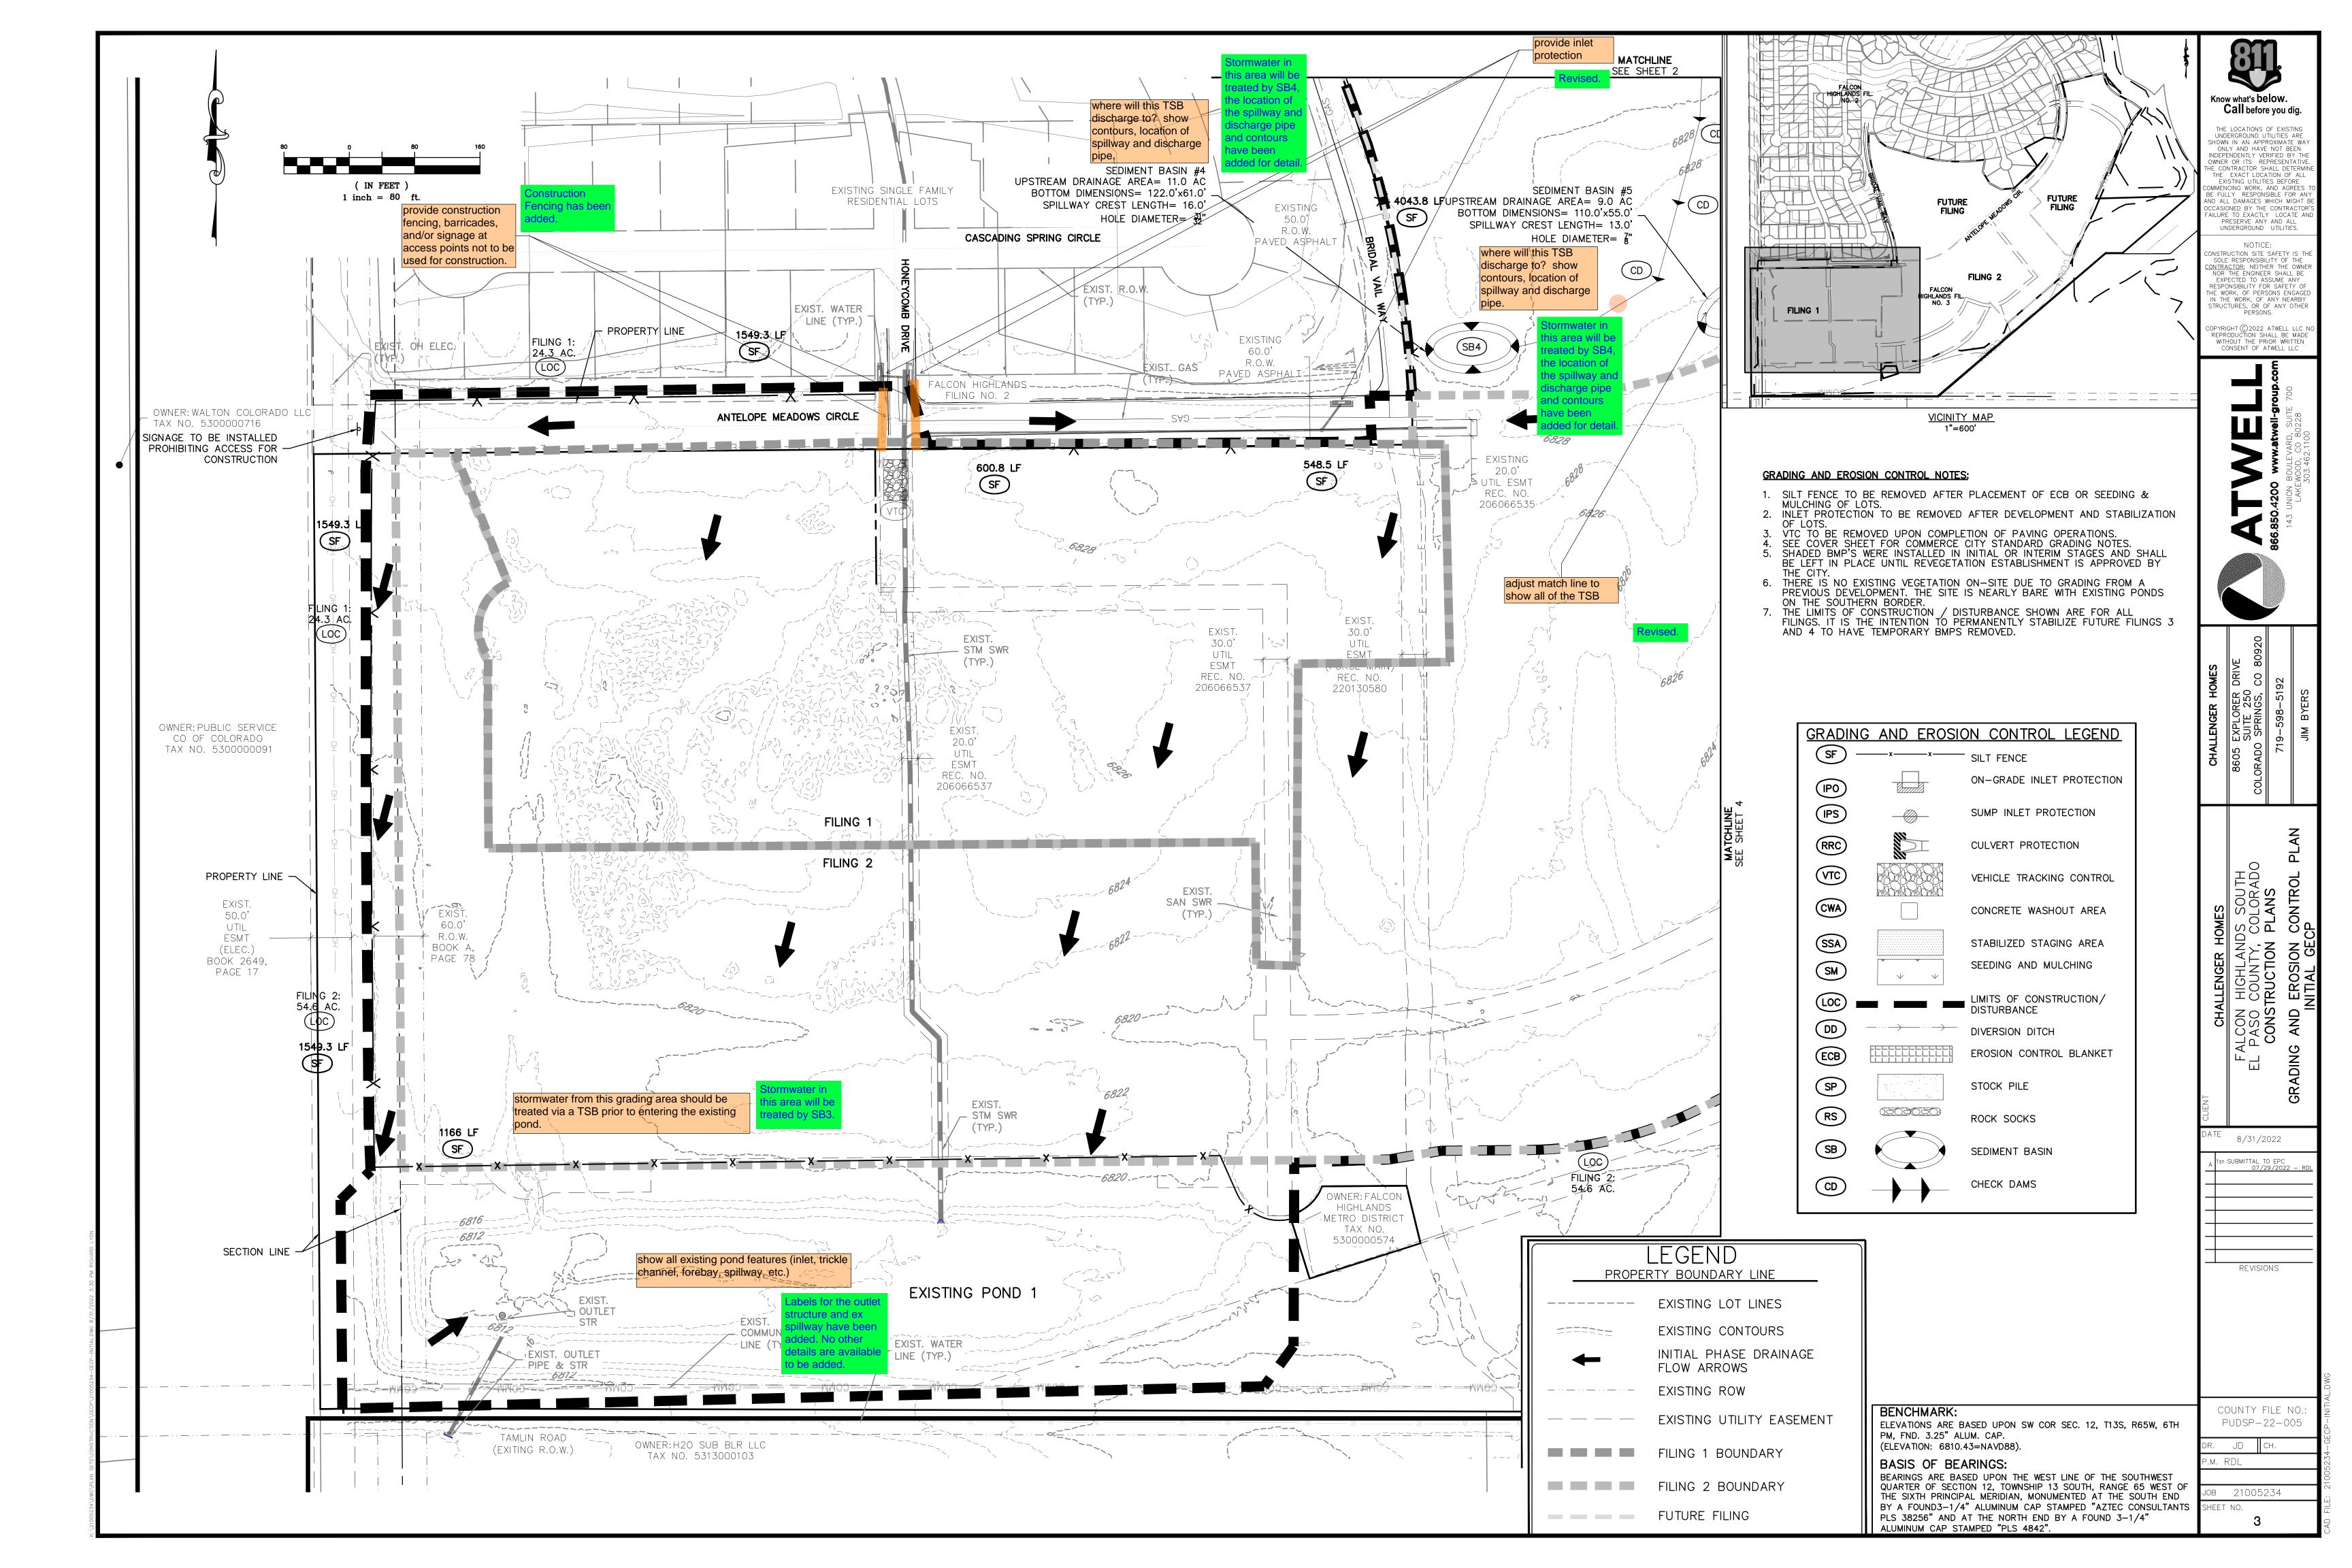


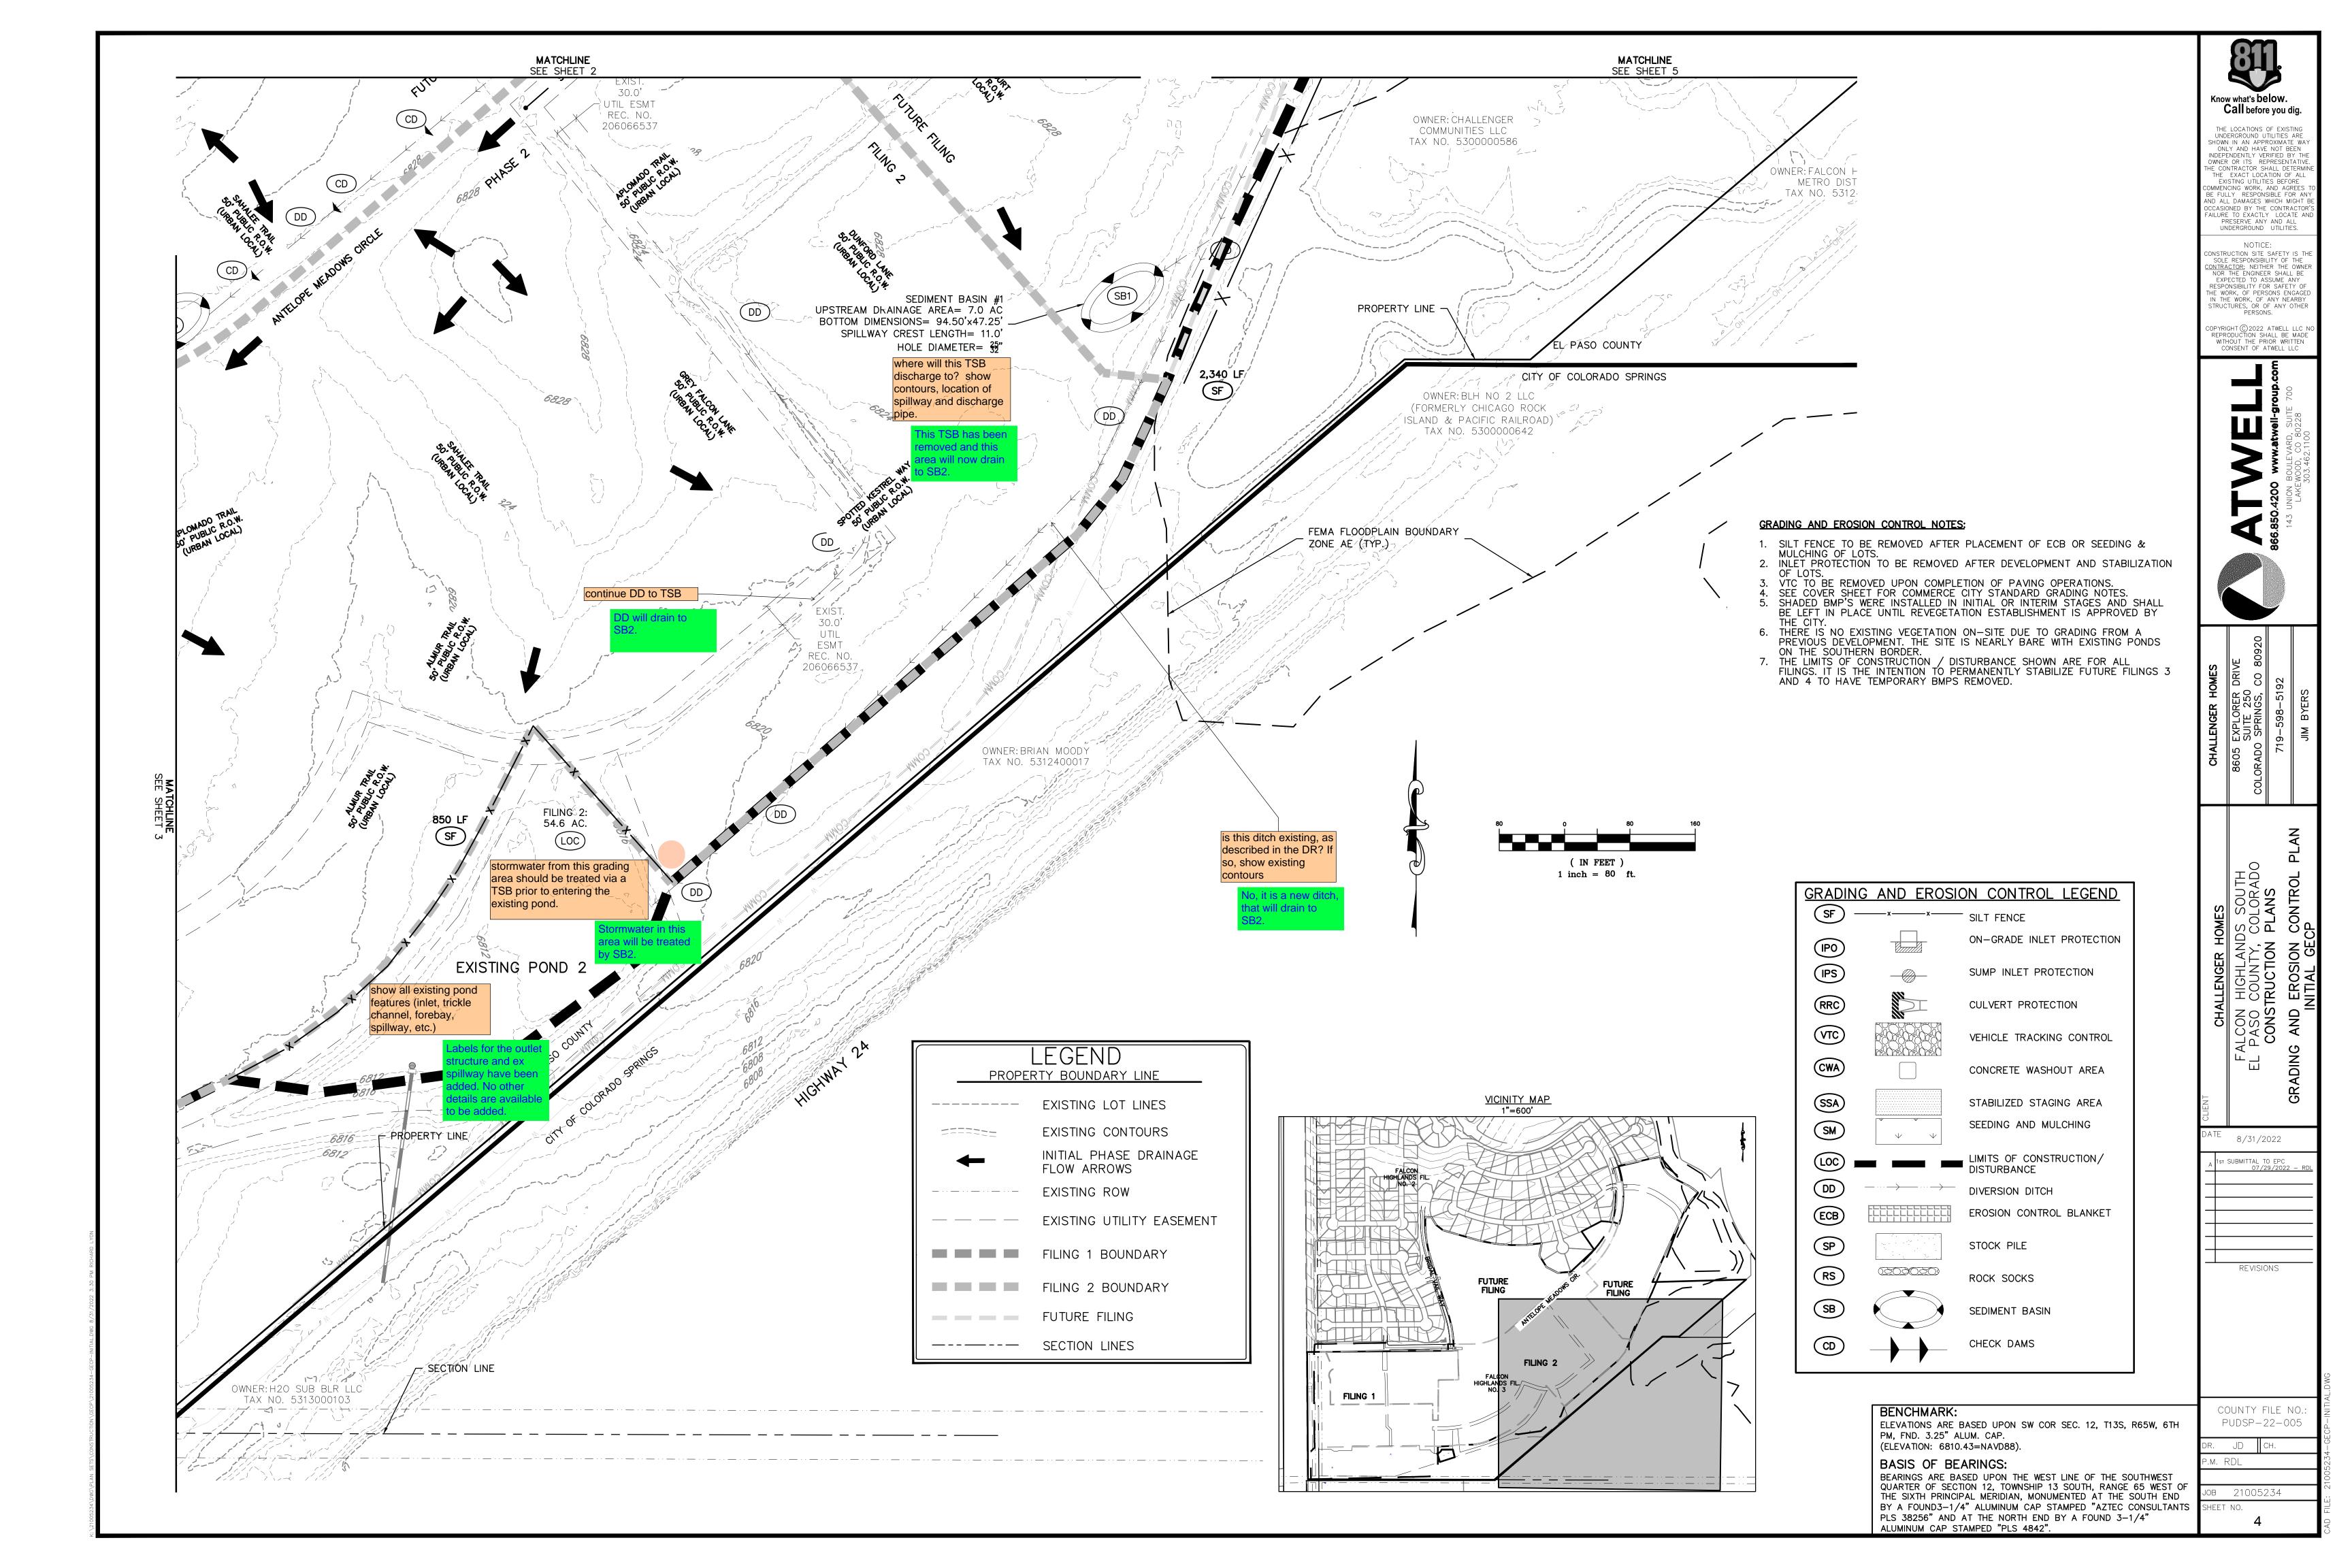


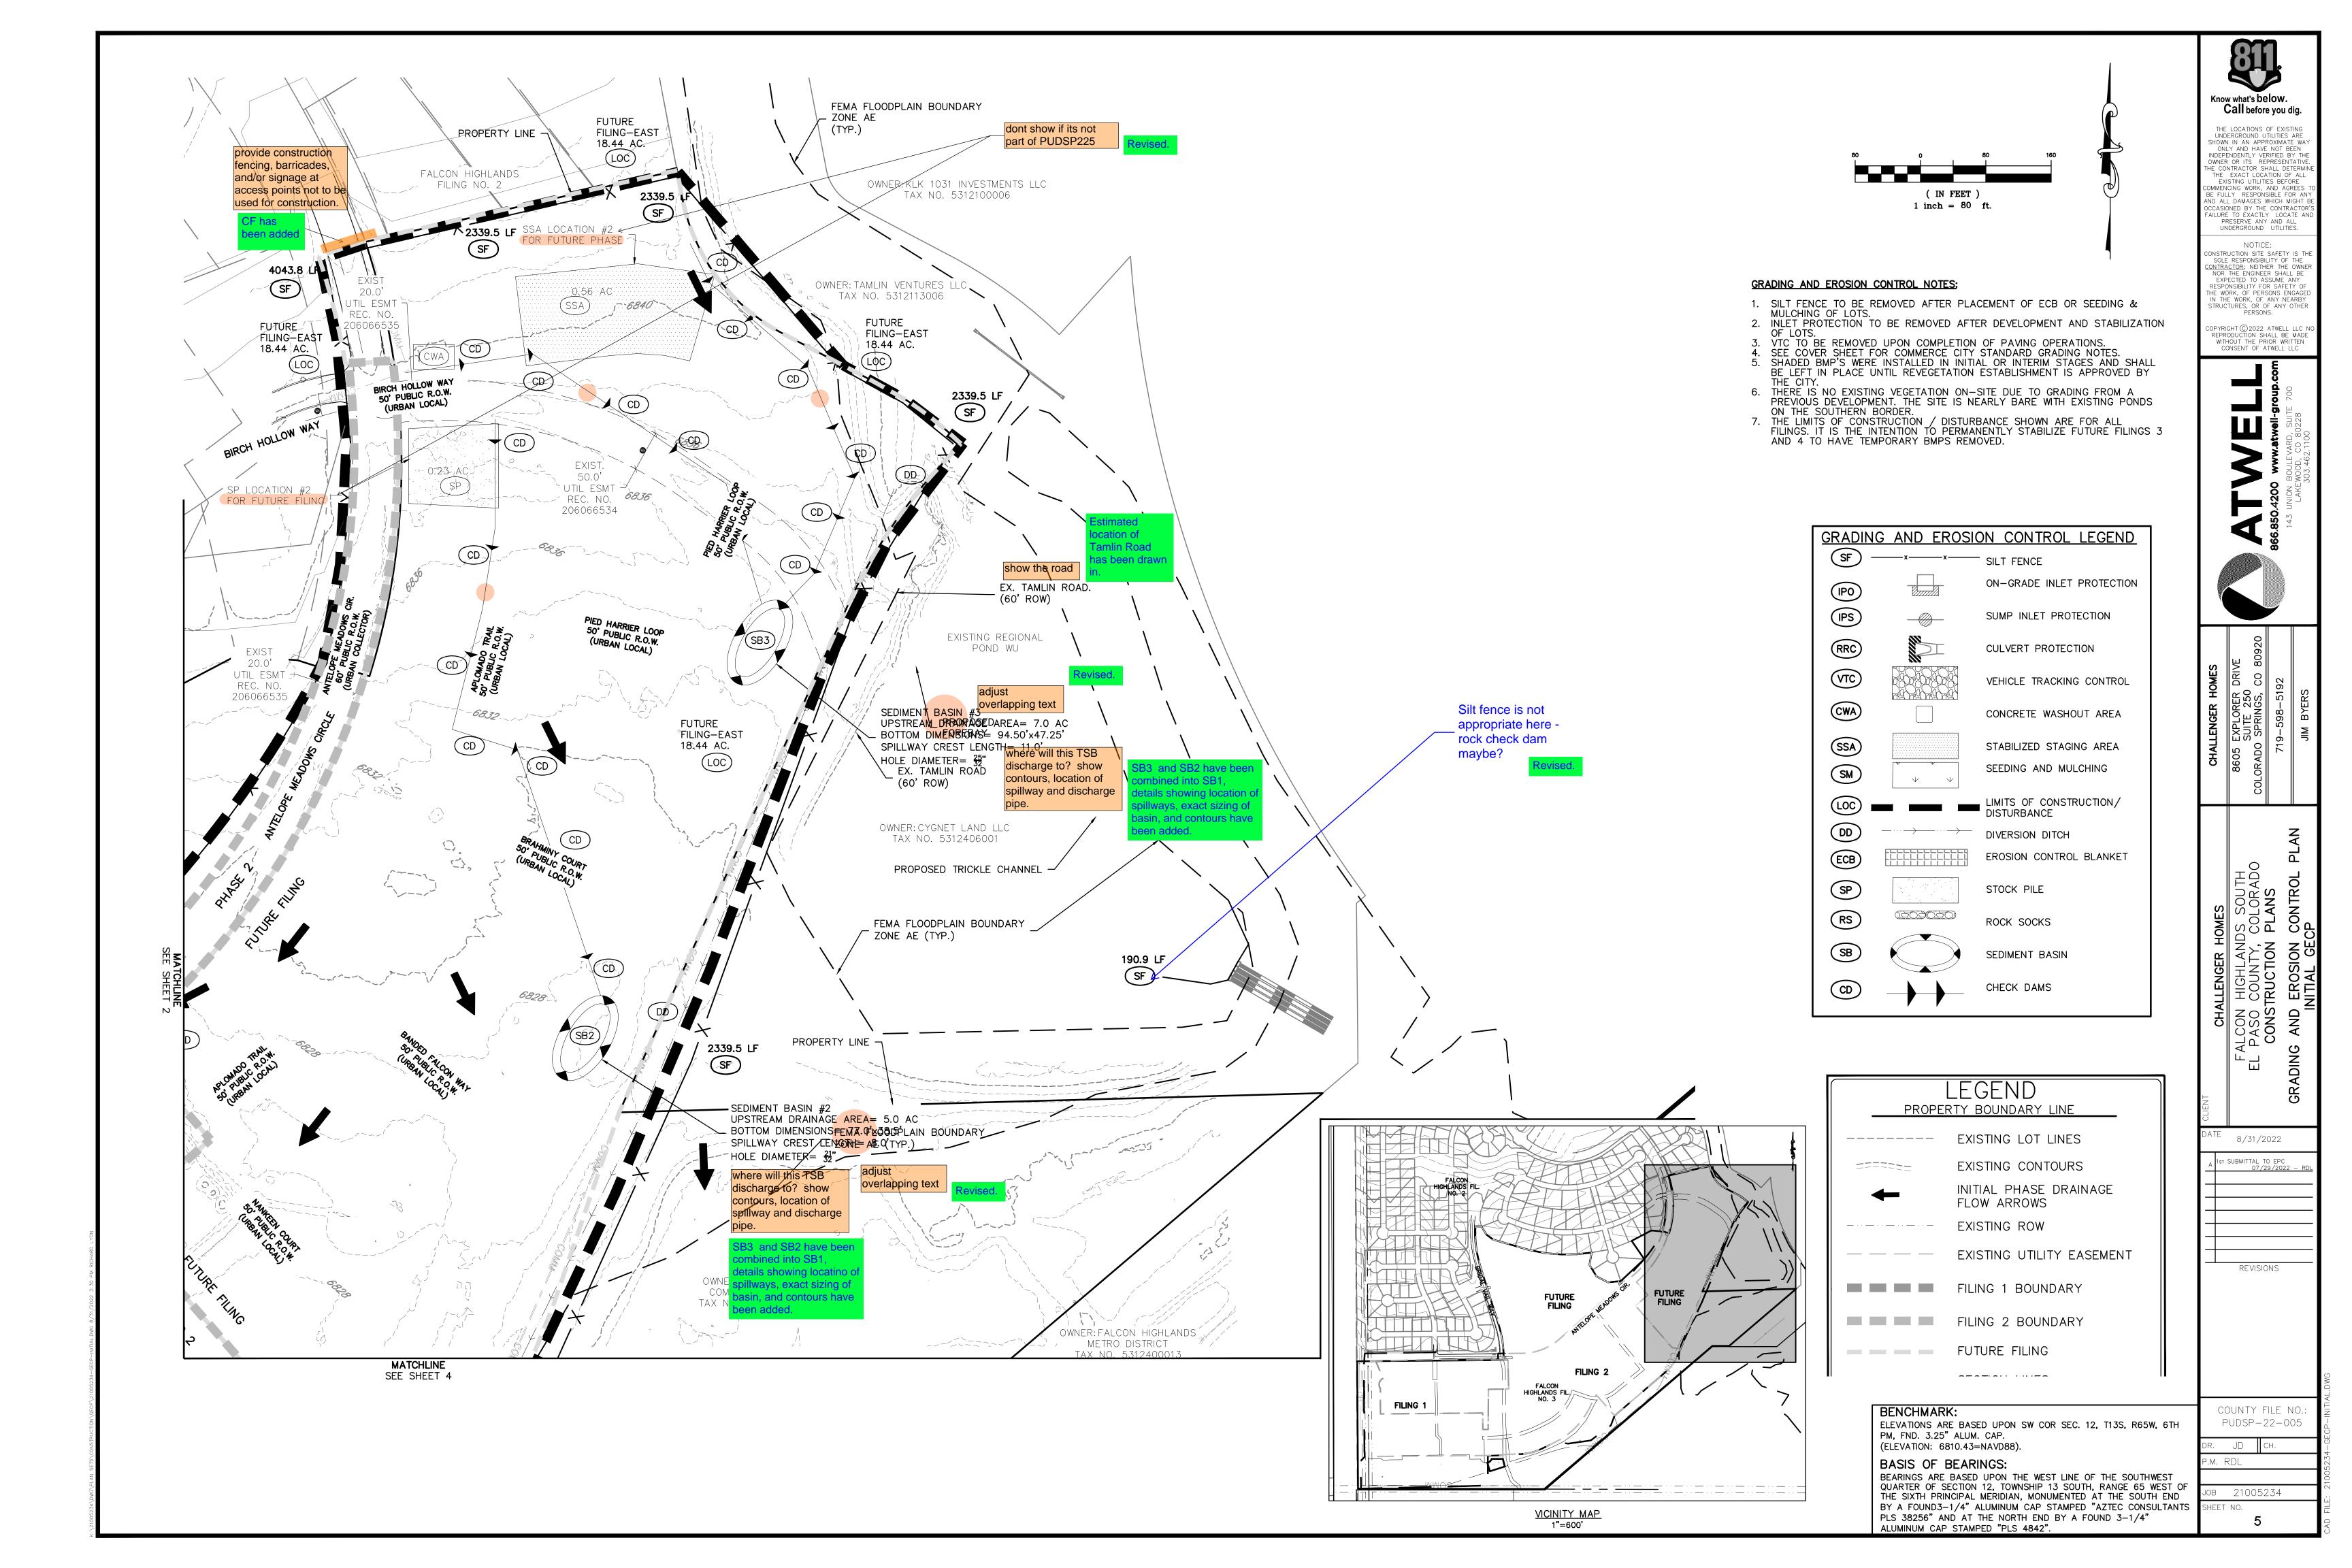


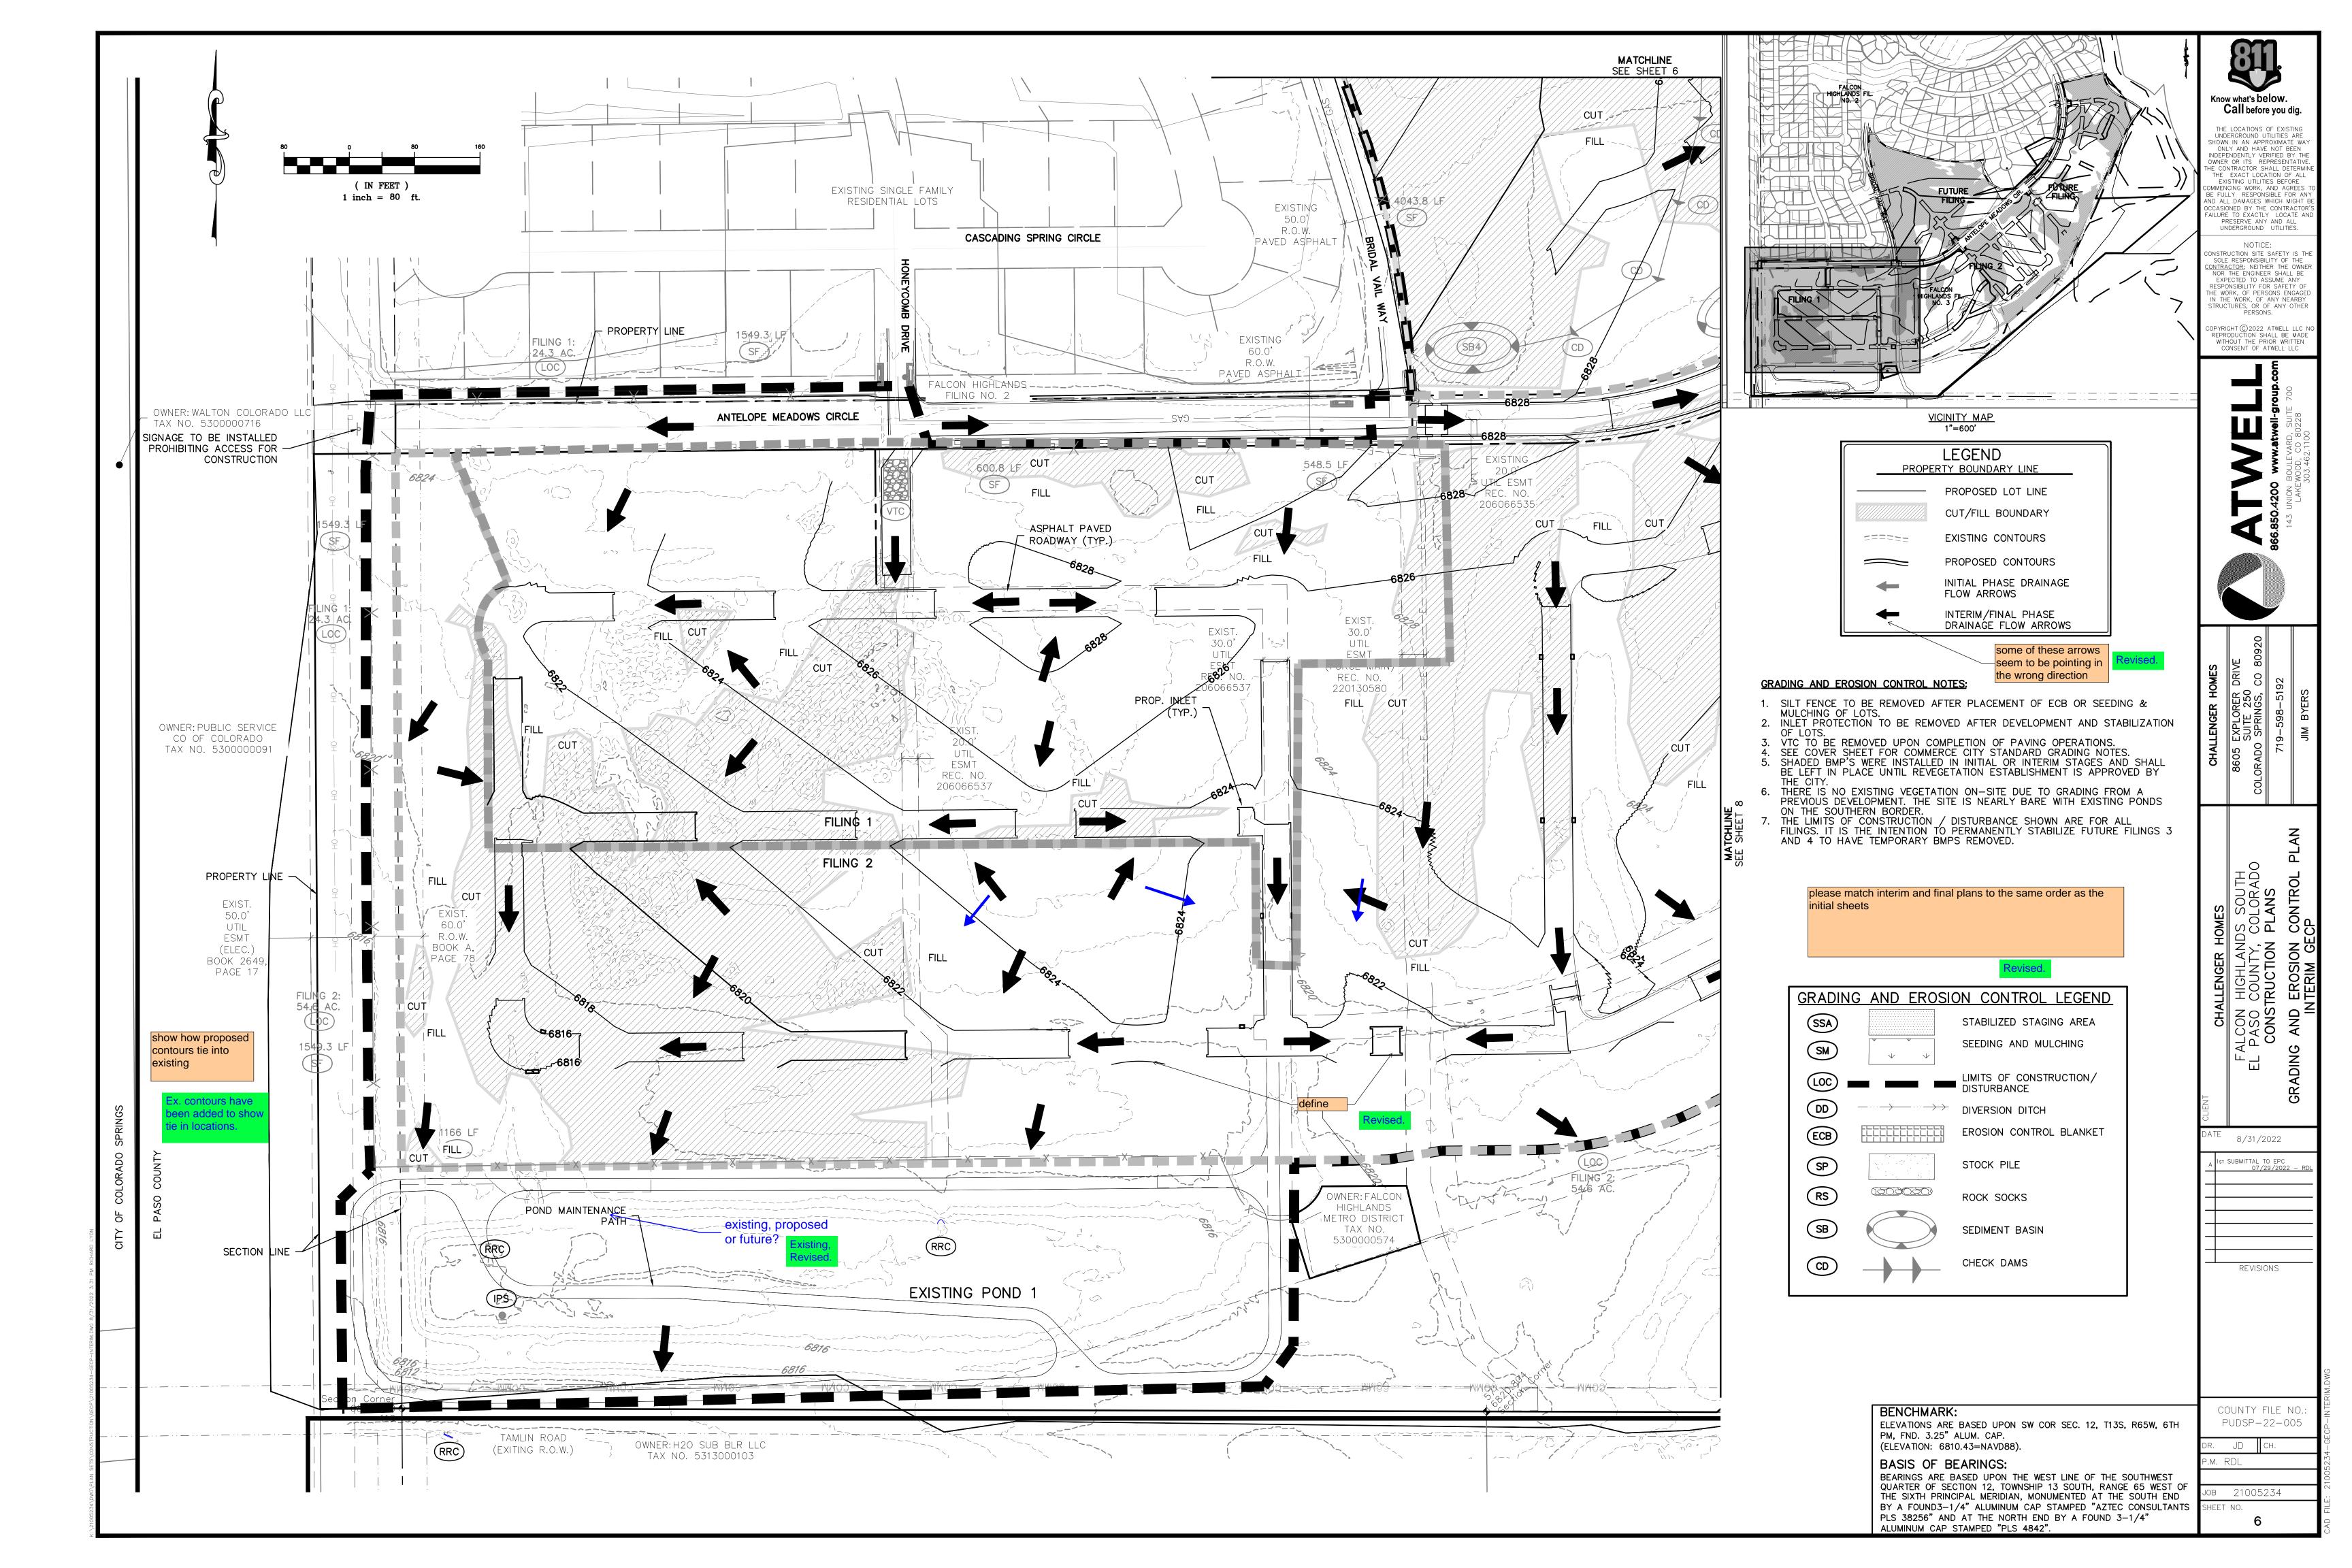


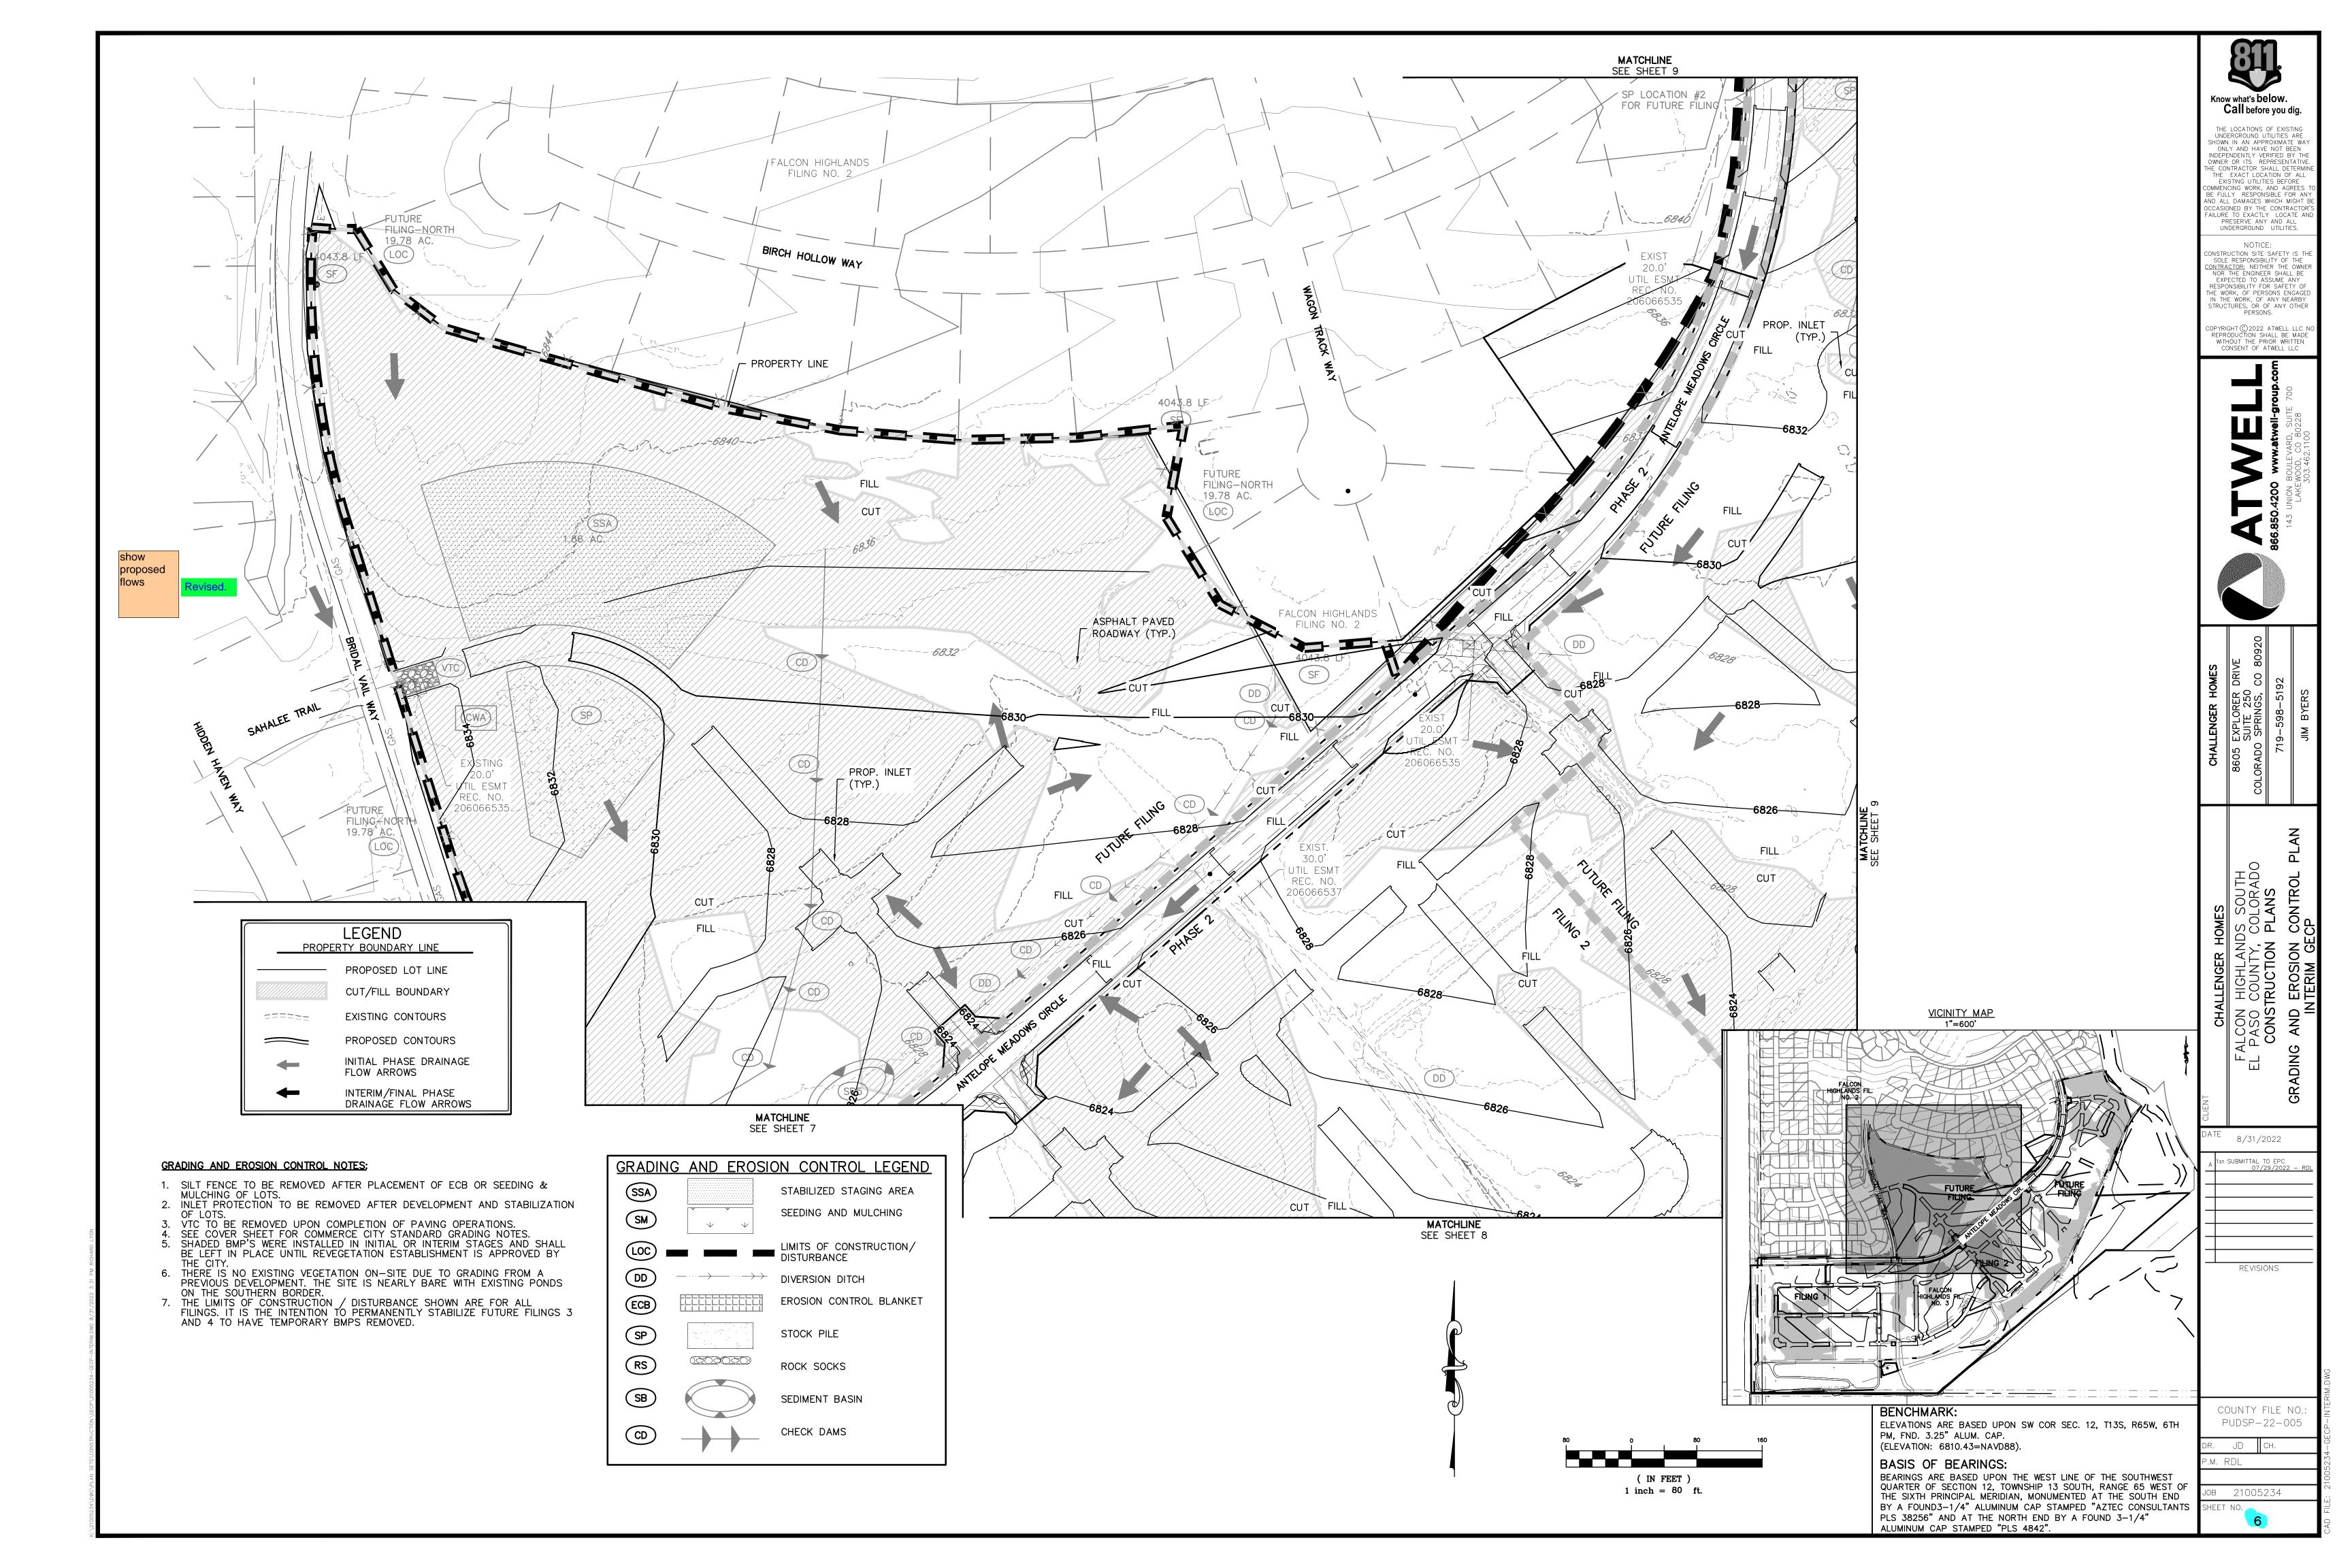


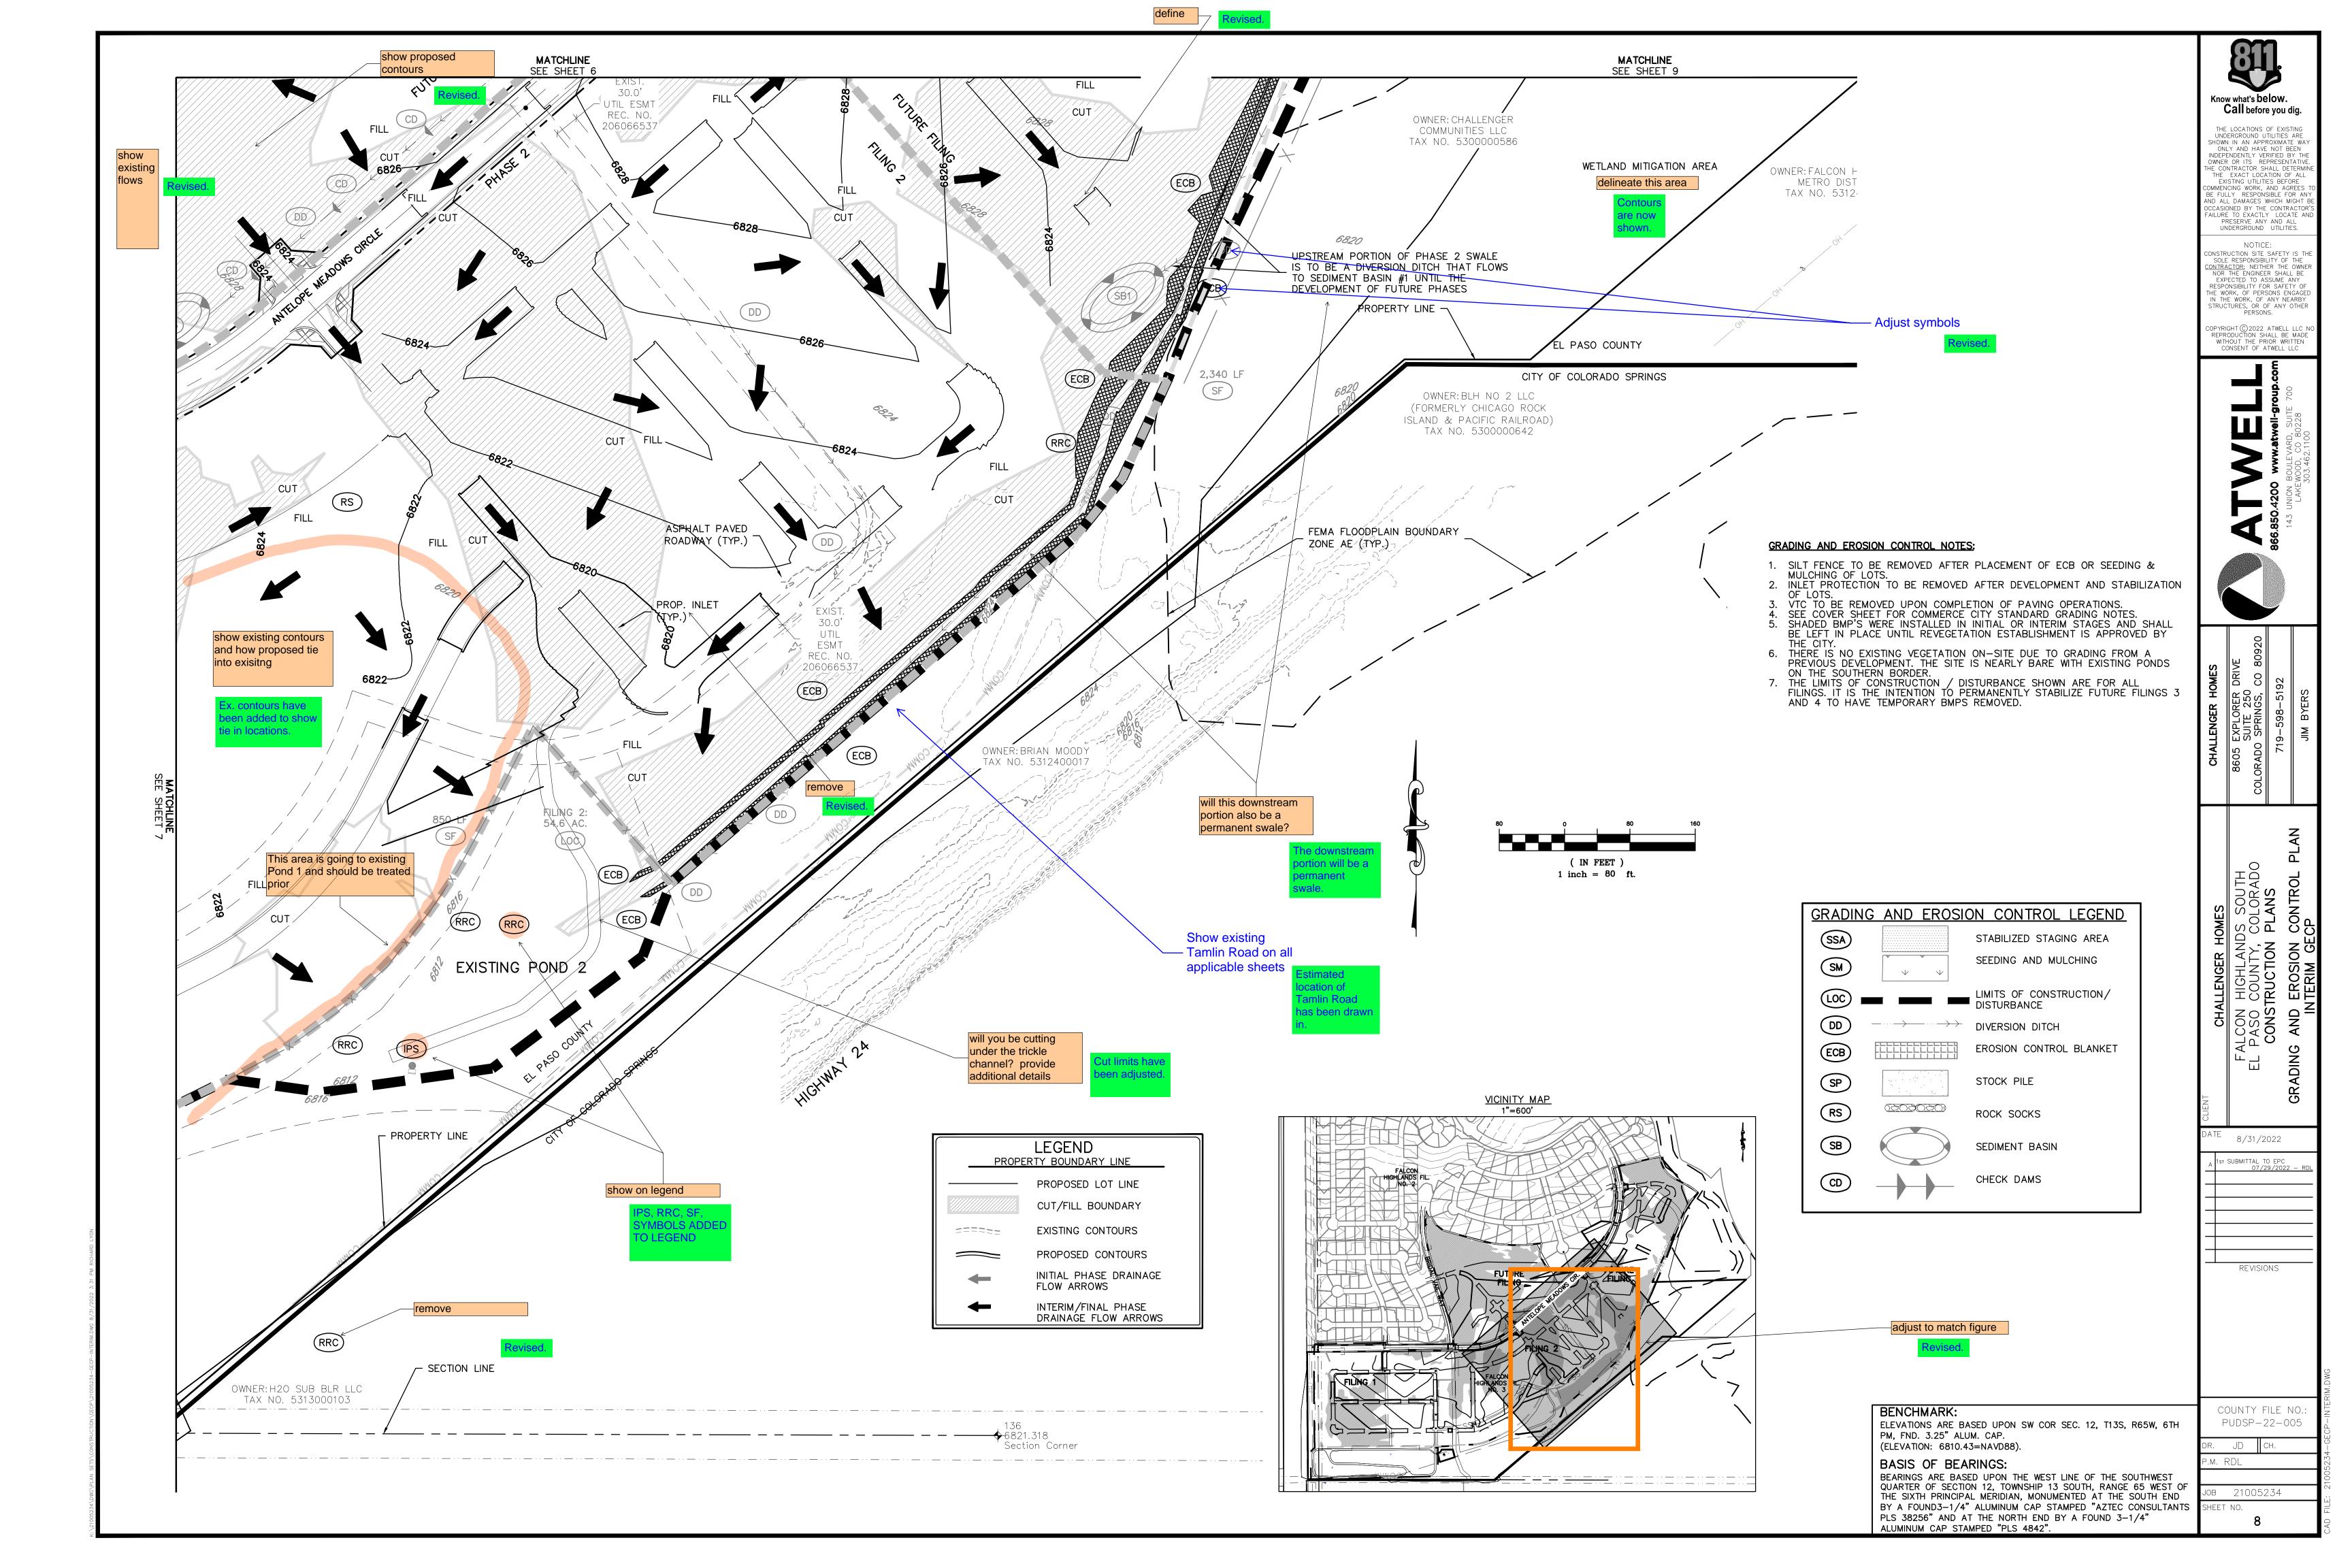


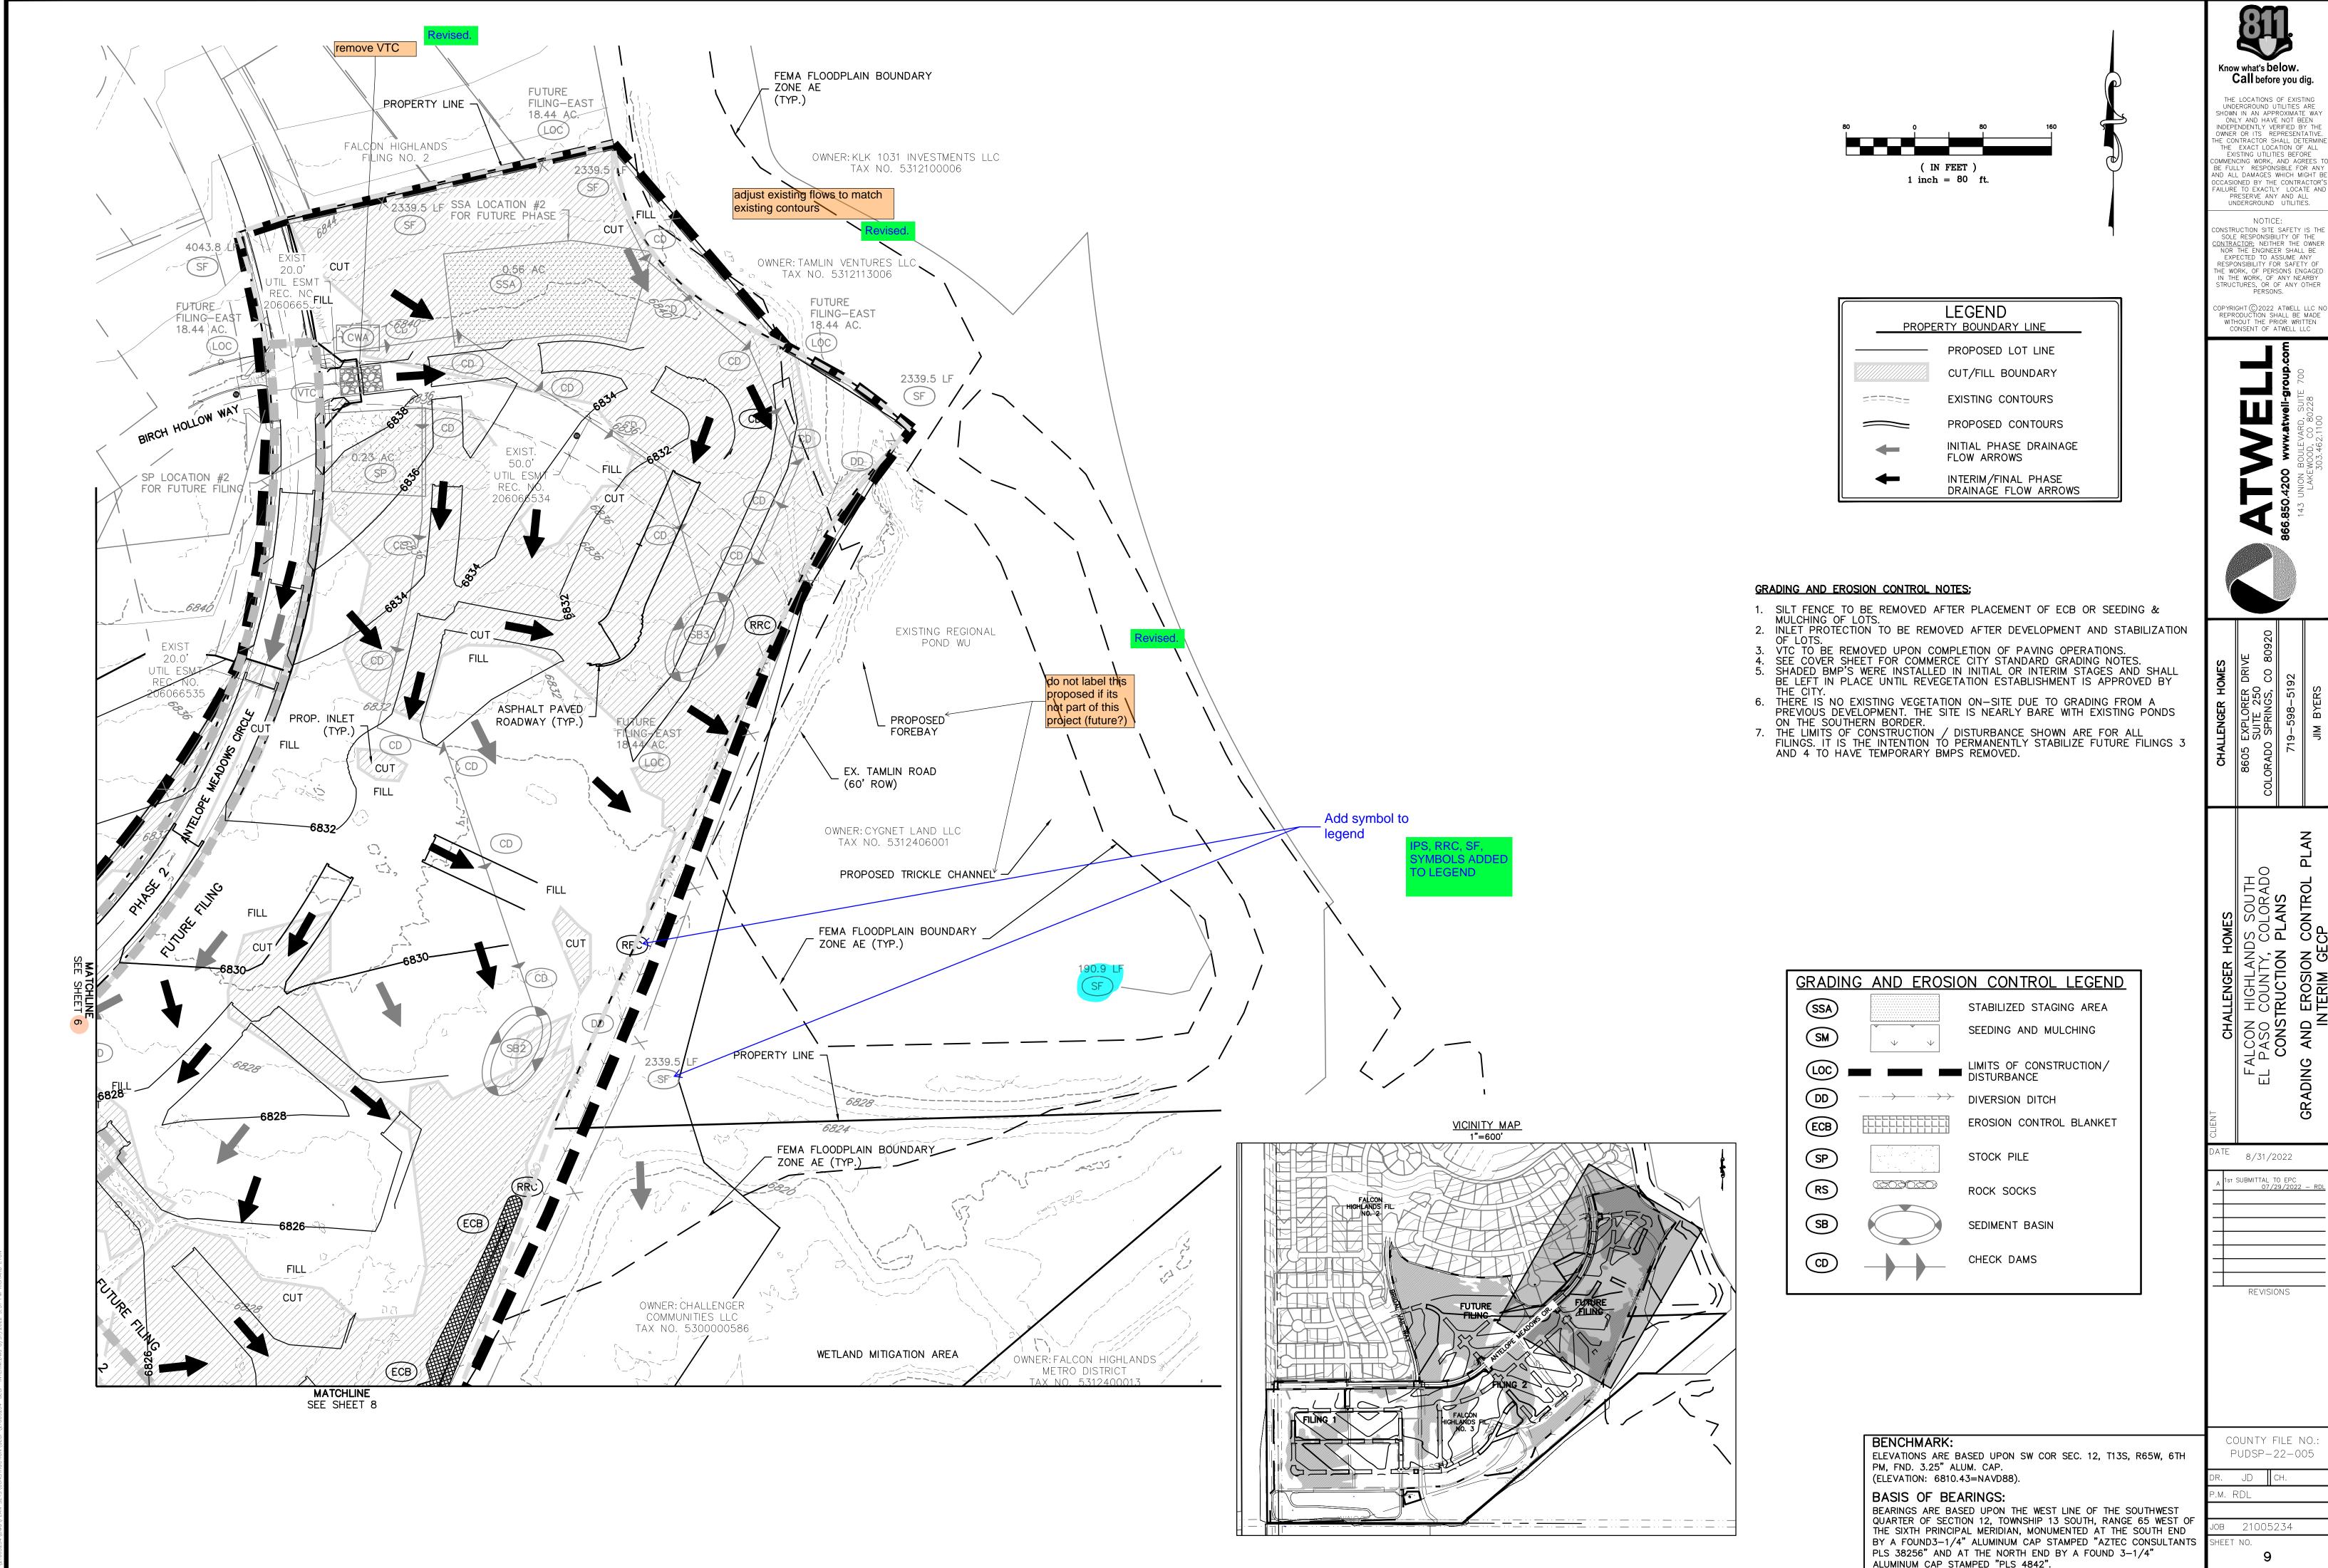

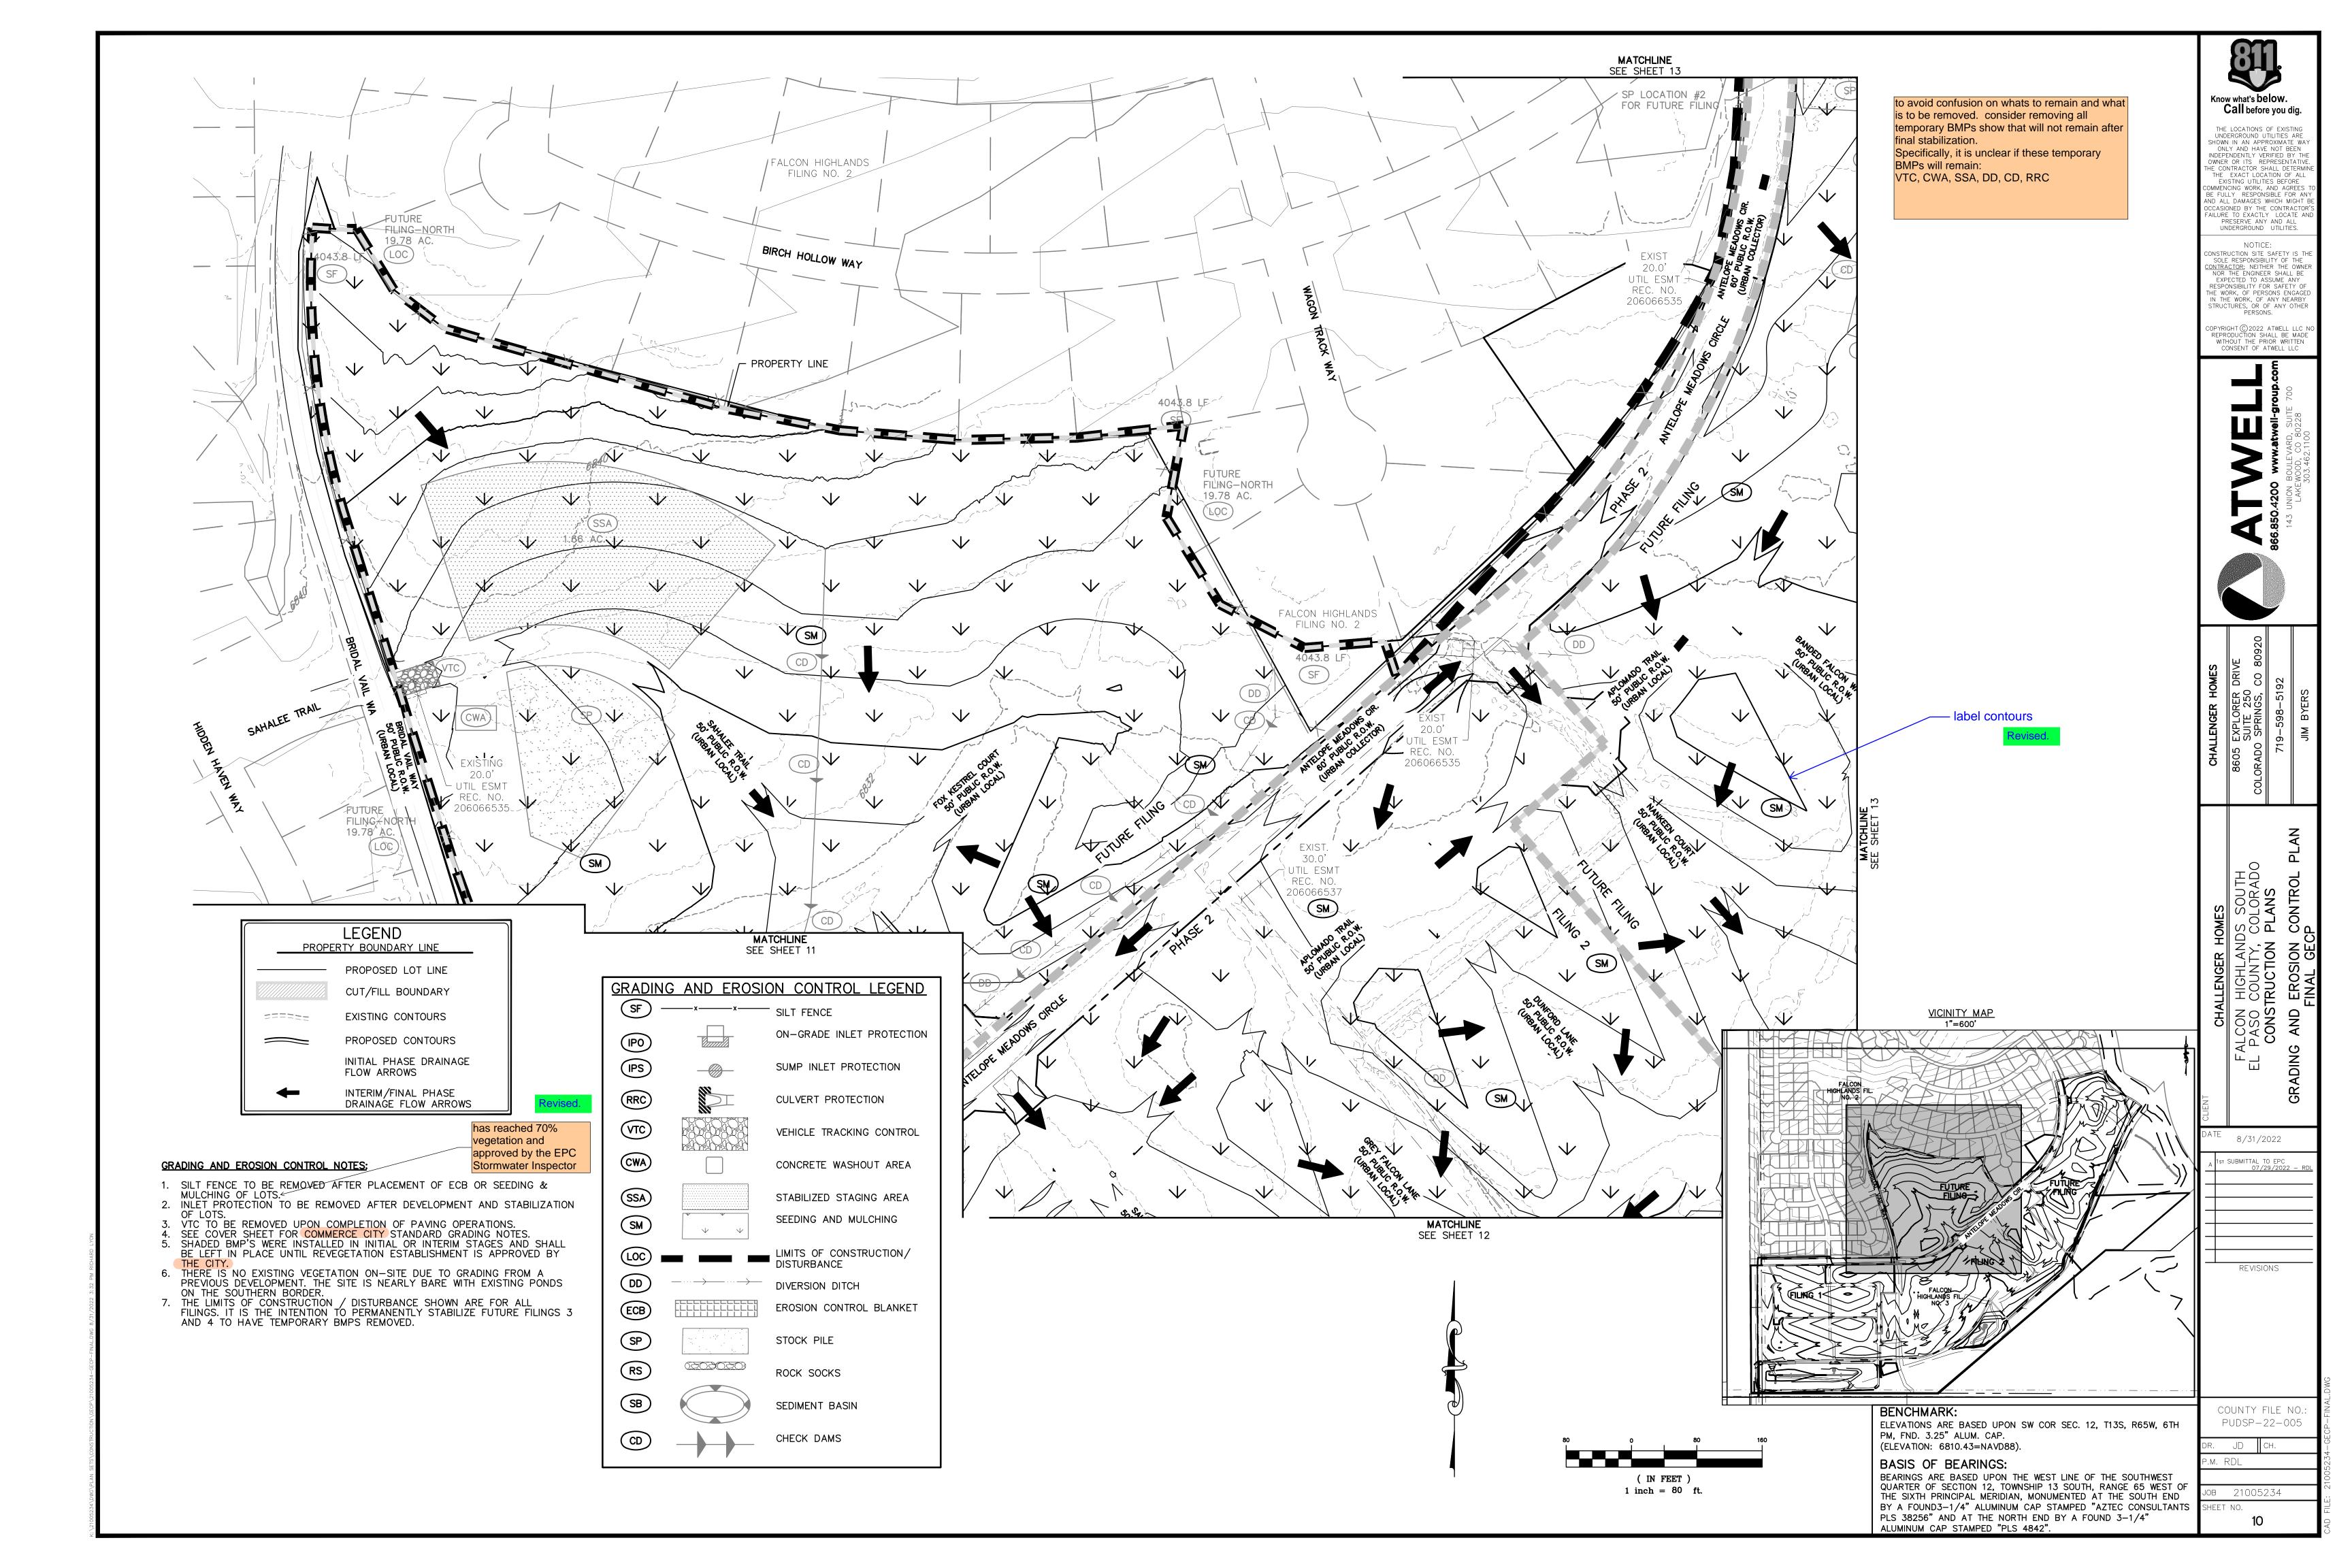

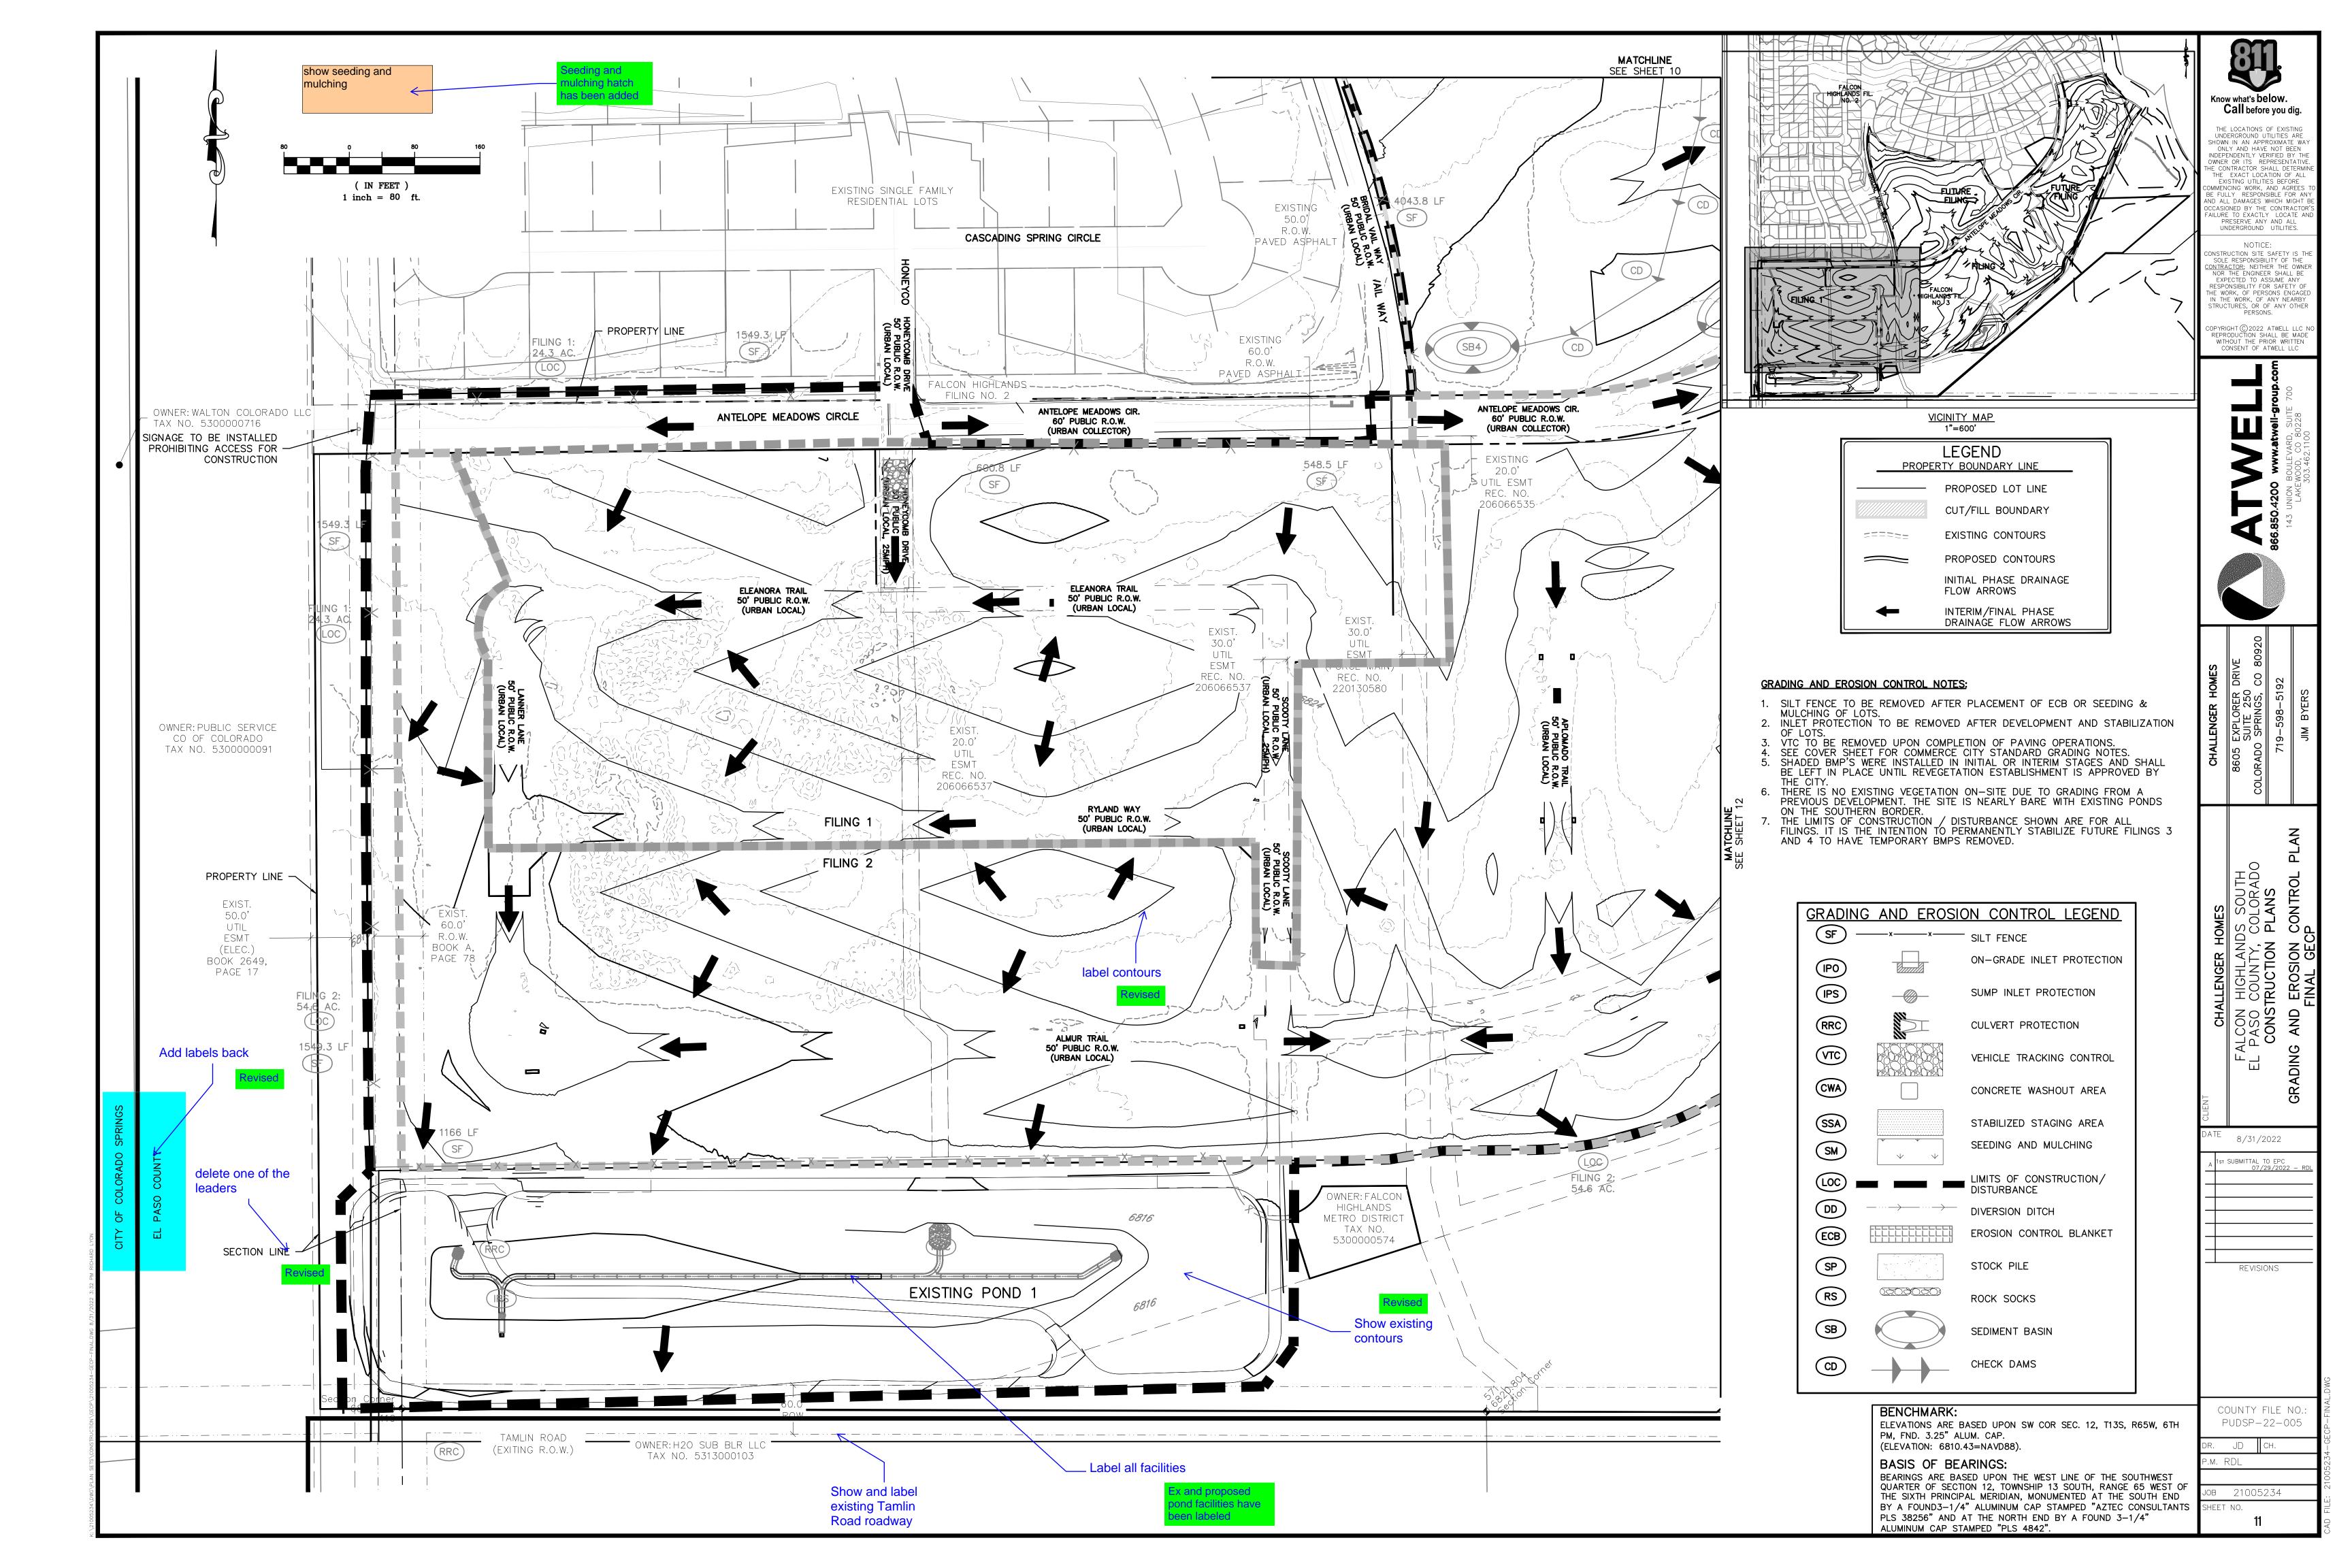

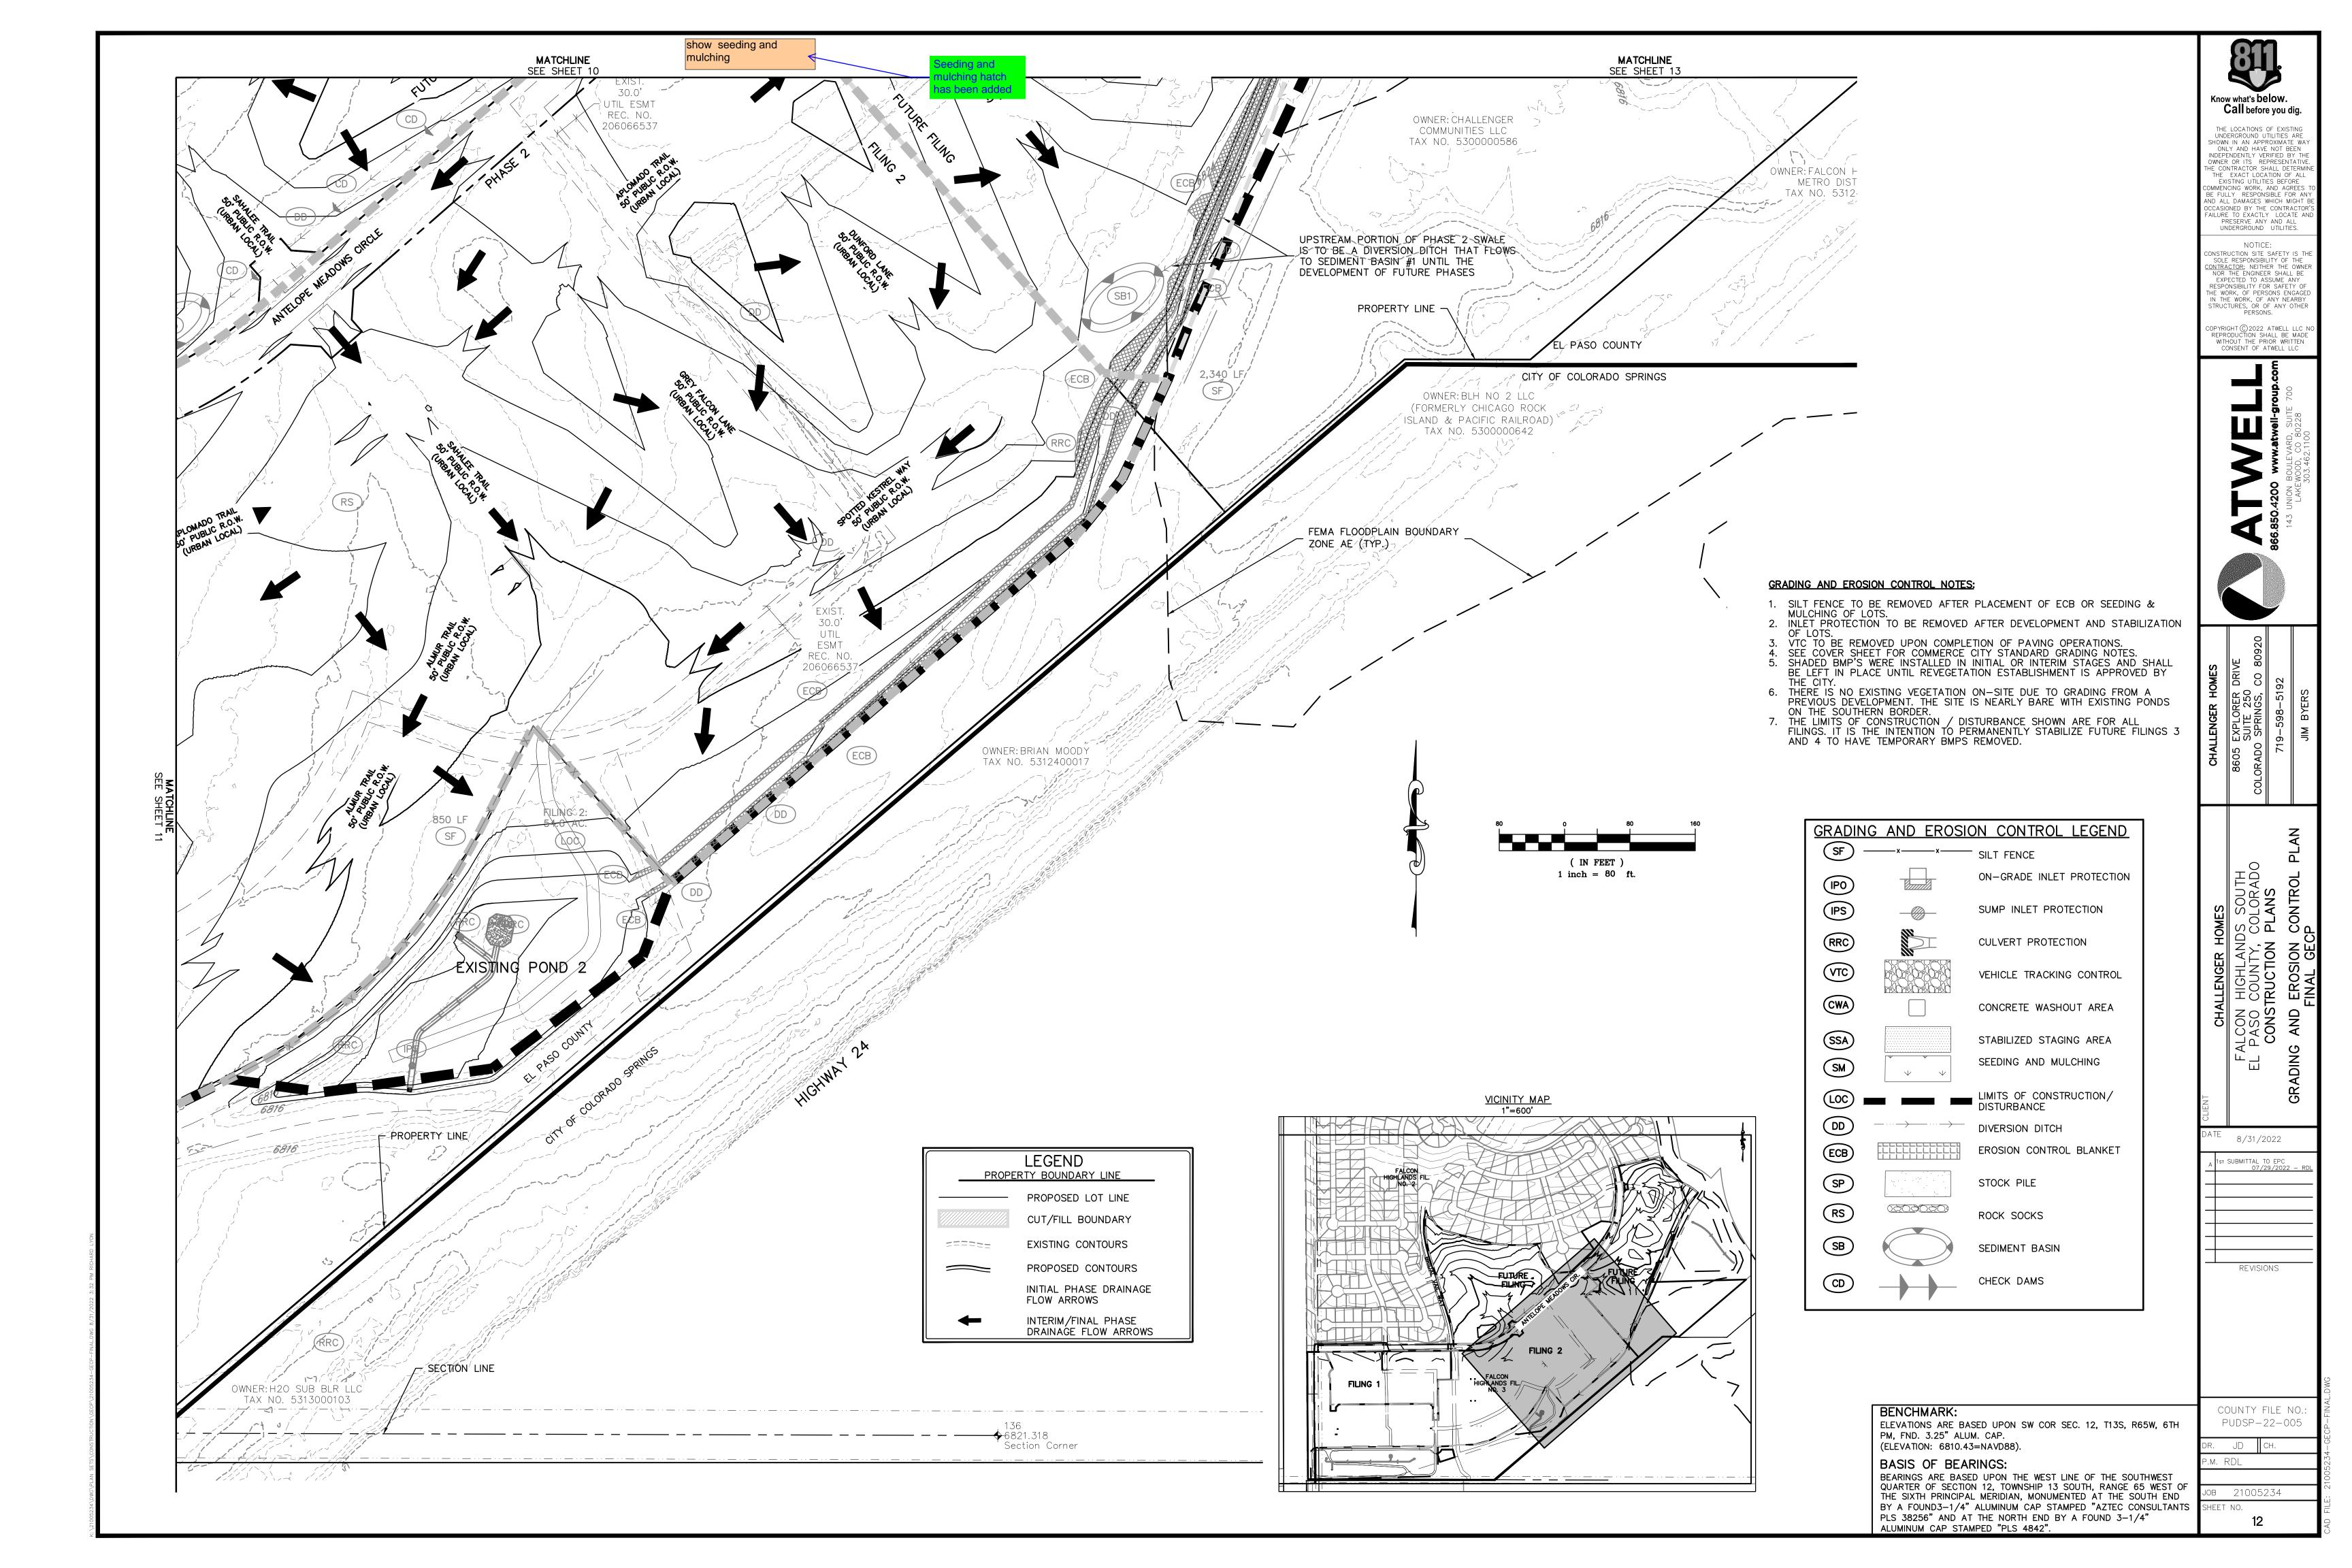

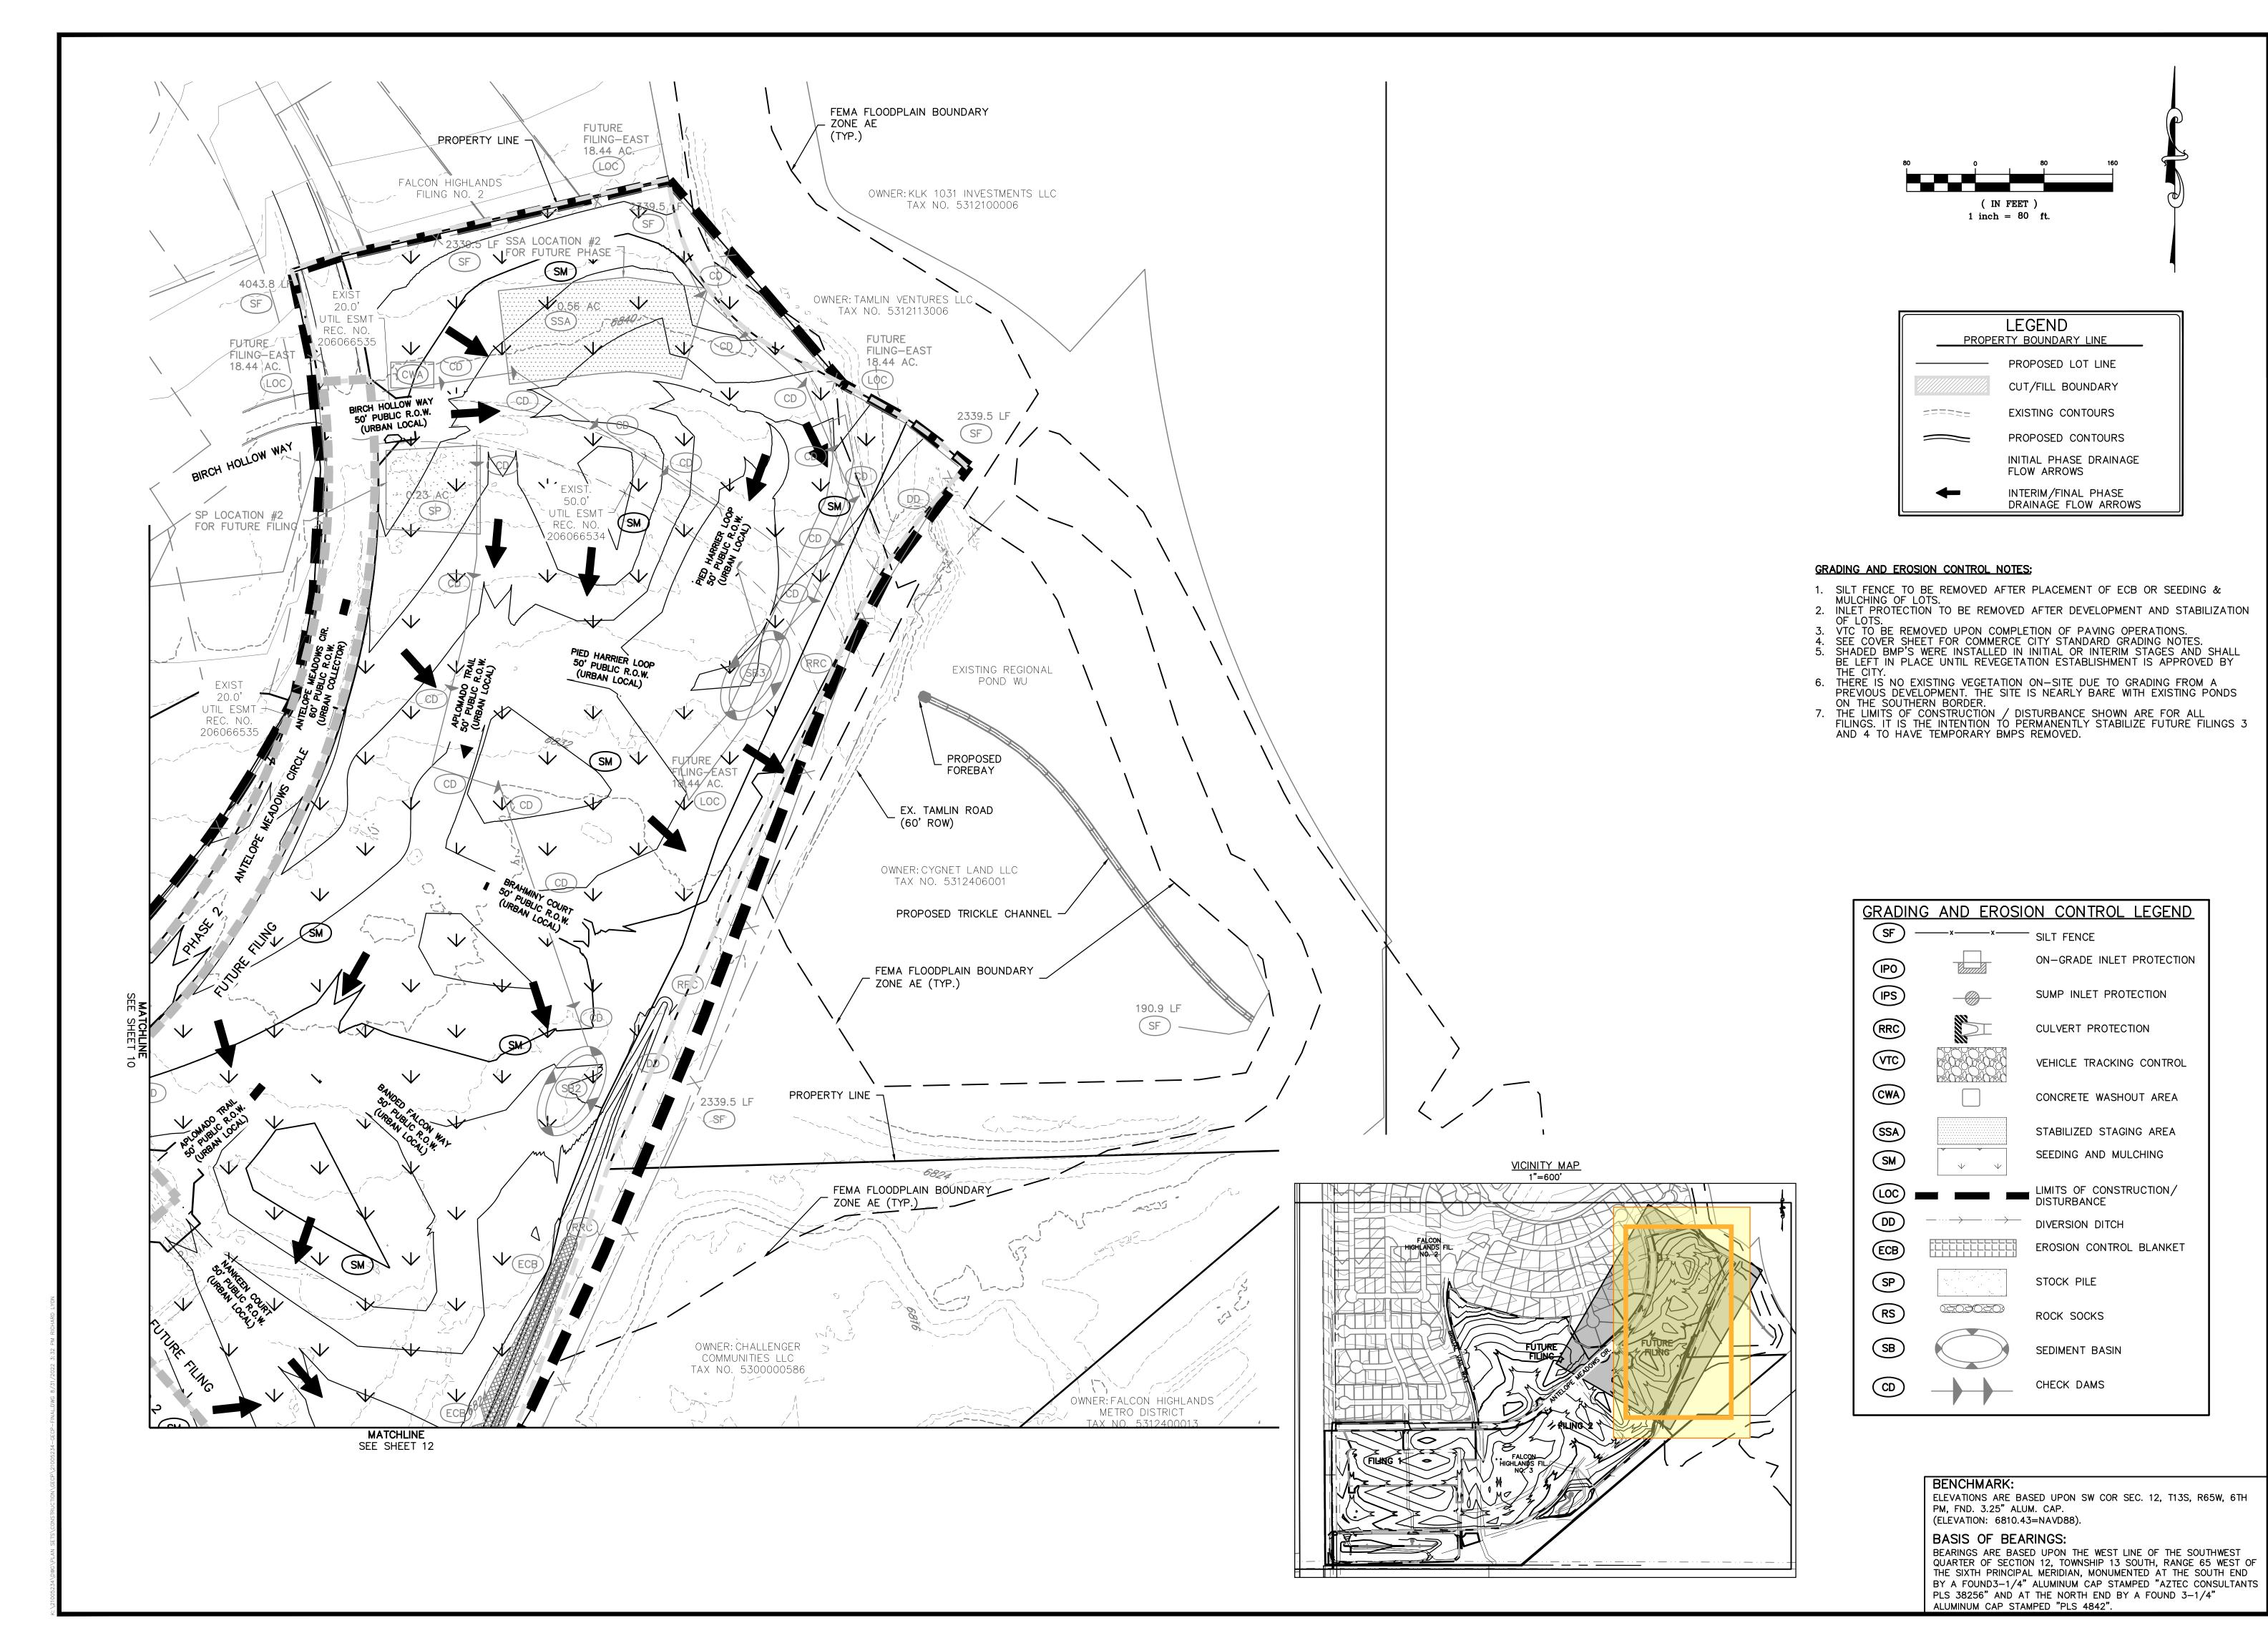



Know what's below. Call before you dig. THE LOCATIONS OF EXISTING

THE LOCATIONS OF EXISTING
UNDERGROUND UTILITIES ARE
SHOWN IN AN APPROXIMATE WA
ONLY AND HAVE NOT BEEN
INDEPENDENTLY VERIFIED BY TH
OWNER OR ITS REPRESENTATIVE
THE CONTRACTOR SHALL DETERMI
THE EXACT LOCATION OF ALL
EXISTING UTILITIES BEFORE
COMMENCING WORK, AND AGREES
BE FULLY RESPONSIBLE FOR AND
ALL DAMAGES WHICH MIGHT
OCCASIONED BY THE CONTRACTOF
FAILURE TO EXACTLY LOCATE AL
PRESERVE ANY AND ALL
LINDERGROUND LITHLITES UNDERGROUND UTILITIES.

NO HICE:

CONSTRUCTION SITE SAFETY IS THE
SOLE RESPONSIBILITY OF THE
CONTRACTOR; NEITHER THE OWNER
NOR THE ENGINEER SHALL BE
EXPECTED TO ASSUME ANY
RESPONSIBILITY FOR SAFETY OF
THE WORK, OF PERSONS ENGAGED
IN THE WORK, OF ANY NEARBY
STRUCTURES, OR OF ANY OTHER
PERSONS.

COPYRIGHT © 2022 ATWELL LLC REPRODUCTION SHALL BE MADE WITHOUT THE PRIOR WRITTEN CONSENT OF ATWELL LLC



8/31/2022 T SUBMITTAL TO EPC

REVISIONS

COUNTY FILE NO.

JD CH. 1. RDL 21005234

PUDSP-22-005

HIGH FLOW CHANNEL.

RECP-7

STAKING PATTERNS BY SLOPE OR CHANNEL TYPE

Urban Drainage and Flood Control District

Urban Storm Drainage Criteria Manual Volume 3

November 2010

MIN.

Urban Drainage and Flood Control District

Urban Storm Drainage Criteria Manual Volume 3

WCOD STAKE DETAIL

November 2010

EXCELSIOR

RECP-8

DOUBLE/ NATURAL

November 2010

November 2010

Urban Drainage and Flood Control District

Urban Storm Drainage Criteria Manual Volume 3

100%

Urban Drainage and Flood Control District

Urban Storm Drainage Criteria Manual Volume 3

Know what's below.

Call before you dig.

THE LOCATIONS OF EXISTIN UNDERGROUND UTILITIES ARE SHOWN IN AN APPROXIMATE W ONLY AND HAVE NOT BEEN INDEPENDENTLY VERIFIED BY T OWNER OR ITS REPRESENTATI FULLY RESPONSIBLE FOR ALL DAMAGES WHICH MIGH CASIONED BY THE CONTRAC UNDERGROUND UTILITIES.

STRUCTION SITE SAFETY IS SOLE RESPONSIBILITY OF T ONTRACTOR; NEITHER THE OWN NOR THE ENGINEER SHALL BE EXPECTED TO ASSUME ANY ESPONSIBILITY FOR SAFETY WORK, OF PERSONS ENGA IN THE WORK, OF ANY NEARBY STRUCTURES, OR OF ANY OTHEF PERSONS.

OPYRIGHT © 2022 ATWELL LLC REPRODUCTION SHALL BE MAD WITHOUT THE PRIOR WRITTEN CONSENT OF ATWELL LLC

RS-3

S SOUTH COLORADO PLANS CONTROL P

PASO COUNTY, CONSTRUCTION

8/31/2022 SUBMITTAL TO EPC

REVISIONS

RECP-9

COUNTY FILE NO PUDSP-22-005 JD CH.

1. RDL 21005234

SP

SILT FENCE (SEE SF DETAIL FOR

INSTALLATION REQUIREMENTS)

SILT FENCE (SEE SF DETAIL FOR

INSTALLATION REQUIREMENTS)

SECTION A

STOCKPILE PROTECTION MAINTENANCE NOTES

STOCKPILE PROTECTION MAINTENANCE NOTES

PERIMETER CONTROLS BY THE END OF THE WORKDAY.

(DETAILS ADAPTED FROM PARKER, COLORADO, NOT AVAILABLE IN AUTOCAD)

DISCOVERY OF THE FAILURE.

EROSION, AND PERFORM NECESSARY MAINTENANCE.

1. INSPECT BMPs EACH WORKDAY, AND MAINTAIN THEM IN EFFECTIVE OPERATING CONDITION.
MAINTENANCE OF BMPs SHOULD BE PROACTIVE, NOT REACTIVE. INSPECT BMPs AS SOON AS

POSSIBLE (AND ALWAYS WITHIN 24 HOURS) FOLLOWING A STORM THAT CAUSES SURFACE

2. FREQUENT OBSERVATIONS AND MAINTENANCE ARE NECESSARY TO MAINTAIN BMPs IN

EFFECTIVE OPERATING CONDITION. INSPECTIONS AND CORRECTIVE MEASURES SHOULD BE

3. WHERE BMPs HAVE FAILED, REPAIR OR REPLACEMENT SHOULD BE INITIATED UPON

4. IF PERIMETER PROTECTION MUST BE MOVED TO ACCESS SOIL STOCKPILE, REPLACE

5. STOCKPILE PERIMETER CONTROLS CAN BE REMOVED ONCE ALL THE MATERIAL FROM THE

NOTE: MANY JURISDICTIONS HAVE BMP DETAILS THAT VARY FROM UDFCD STANDARD DETAILS. CONSULT WITH LOCAL JURISDICTIONS AS TO WHICH DETAIL SHOULD BE USED WHEN

TARP ANCHOR -

SÉDIMENT CONTROL LOG

SOIL/LANDSCAPE

6" PVC PIPE

IN FLOWLINE

CURB LINE

— FOR DRAINAG

- 6" PVC PIPE

Call before you dig. THE LOCATIONS OF EXISTING UNDERGROUND UTILITIES ARE SHOWN IN AN APPROXIMATE W ONLY AND HAVE NOT BEEN INDEPENDENTLY VERIFIED BY TO OWNER OR ITS REPRESENTATIVE EXISTING UTILITIES BEFORE MMENCING WORK, AND AGREES E FULLY RESPONSIBLE FOR A

> NOTICE:
>
> CONSTRUCTION SITE SAFETY IS THE SOLE RESPONSIBILITY OF THE CONTRACTOR; NEITHER THE OWNE NOR THE ENGINEER SHALL BE EXPECTED TO ASSUME ANY RESPONSIBILITY FOR SAFETY OF THE WORK, OF PERSONS ENGAGE IN THE WORK, OF ANY NEARBY STRUCTURES, OR OF ANY OTHER PERSONS.

D ALL DAMAGES WHICH MIGH

UNDERGROUND UTILITIES.

CCASIONED BY THE CONTRACT

Know what's below.

COPYRIGHT © 2022 ATWELL LLC REPRODUCTION SHALL BE MAD WITHOUT THE PRIOR WRITTEN CONSENT OF ATWELL LLC

RER 250 IGS, --519

S SOUTH COLORADO PLANS CONTROL P FALCON HIGHLANDS PASO COUNTY, C

8/31/2022

SUBMITTAL TO EPC

REVISIONS

(DETAILS ADAPTED FROM CITY OF BROOMFELD, COLORADO, NOT AVAILABLE IN AUTOCAD)

DOWN STORM SEWER DRAINS.

MATERIALS STAGING IN ROADWAY MAINTENANCE NOTES

1. INSPECT BMPs EACH WORKDAY, AND MAINTAIN THEM IN EFFECTIVE OPERATING CONDITION.
MAINTENANCE OF BMPs SHOULD BE PROACTIVE, NOT REACTIVE. INSPECT BMPs AS SOON AS POSSIBLE (AND ALWAYS WITHIN 24 HOURS) FOLLOWING A STORM THAT CAUSES SURFACE

2. FREQUENT OBSERVATIONS AND MAINTENANCE ARE NECESSARY TO MAINTAIN BMPs IN EFFECTIVE OPERATING CONDITION. INSPECTIONS AND CORRECTIVE MEASURES SHOULD BE

3. WHERE BMPs HAVE FAILED, REPAIR OR REPLACEMENT SHOULD BE INITIATED UPON DISCOVERY OF THE FAILURE.

NOTE: MANY JURISDICTIONS HAVE BMP DETAILS THAT VARY FROM UDFCD STANDARD DETAILS. CONSULT WITH LOCAL JURISDICTIONS AS TO WHICH DETAIL SHOULD BE USED WHEN

4. INSPECT PVC PIPE ALONG CURB LINE FOR CLOGGING AND DEBRIS. REMOVE OBSTRUCTIONS 5. CLEAN MATERIAL FROM PAVED SURFACES BY SWEEPING OR VACUUMING.

DIFFERENCES ARE NOTED. (DETAILS ADAPTED FROM AURORA, COLORADO)

ROAD CL TARP ANCHOR (CINDER BUCKET OF WATER) / POLY LINER BERM MATERIAL (TRIANGULAR SILT DIKE, 6"MIN.

### SP-2. MATERIALS STAGING IN ROADWAY

MATERIALS STAGING IN ROADWAYS INSTALLATION NOTES

1. SEE PLAN VIEW FOR -LOCATION OF MATERIAL STAGING AREA(S).

-CONTRACTOR MAY ADJUST LOCATION AND SIZE OF STAGING AREA WITH APPROVAL FROM THE LOCAL JURISDICTION.

2. FEATURE MUST BE INSTALLED PRIOR TO EXCAVATION, EARTHWORK OR DELIVERY OF 3. MATERIALS MUST BE STATIONED ON THE POLY LINER. ANY INCIDENTAL MATERIALS

DEPOSITED ON PAVED SECTION OR ALONG CURB LINE MUST BE CLEANED UP PROMPTLY. 4. POLY LINER AND TARP COVER SHOULD BE OF SIGNIFICANT THICKNESS TO PREVENT DAMAGE OR LOSS OF INTEGRITY.

5. SAND BAGS MAY BE SUBSTITUTED TO ANCHOR THE COVER TARP OR PROVIDE BERMING 6. FEATURE IS NOT INTENDED FOR USE WITH WET MATERIAL THAT WILL BE DRAINING AND/OR

SPREADING OUT ON THE POLY LINER OR FOR DEMOLITION MATERIALS. 7. THIS FEATURE CAN BE USED FOR: -UTILITY REPAIRS.

-WHEN OTHER STAGING LOCATIONS AND OPTIONS ARE LIMITED.

-OTHER LIMITED APPLICATION AND SHORT DURATION STAGING.

November 2010 Urban Drainage and Flood Control District Urban Storm Drainage Criteria Manual Volume 3

SP-5

**SM-4** 

**SM-4** 

Urban Drainage and Flood Control District Urban Storm Drainage Criteria Manual Volume 3

November 2010

Vehicle Tracking Control (VTC)

STABILIZED CONSTRUCTION ENTRANCE/EXIT INSTALLATION NOTES

-LOCATION OF CONSTRUCTION ENTRANCE(S)/EXIT(S).

CONSTRUCTION MAT OR TRM).

DISTURBING ACTIVITIES.

WHERE THERE WILL BE LIMITED VEHICULAR ACCESS.

-TYPE OF CONSTRUCTION ENTRANCE(S)/EXITS(S) (WITH/WITHOUT WHEEL WASH,

2. CONSTRUCTION MAT OR TRM STABILIZED CONSTRUCTION ENTRANCES ARE ONLY TO BE USED ON SHORT DURATION PROJECTS (TYPICALLY RANGING FROM A WEEK TO A MONTH)

4. STABILIZED CONSTRUCTION ENTRANCE/EXIT SHALL BE INSTALLED PRIOR TO ANY LAND

6. UNLESS OTHERWISE SPECIFIED BY LOCAL JURISDICTION, ROCK SHALL CONSIST OF DOT SECT. #703, AASHTO #3 COARSE AGGREGATE OR 6" (MINUS) ROCK.

1. INSPECT BMPs EACH WORKDAY, AND MAINTAIN THEM IN EFFECTIVE OPERATING CONDITION.

MAINTENANCE OF BMPs SHOULD BE PROACTIVE, NOT REACTIVE, INSPECT BMPs AS SOON AS

POSSIBLE (AND ALWAYS WITHIN 24 HOURS) FOLLOWING A STORM THAT CAUSES SURFACE

2. FREQUENT OBSERVATIONS AND MAINTENANCE ARE NECESSARY TO MAINTAIN  $\text{BMP}_{\text{S}}$  IN EFFECTIVE OPERATING CONDITION. INSPECTIONS AND CORRECTIVE MEASURES SHOULD BE DOCUMENTED THOROUGHLY.

5. SEDIMENT TRACKED ONTO PAVED ROADS IS TO BE REMOVED THROUGHOUT THE DAY AND

NOTE: MANY JURISDICTIONS HAVE BMP DETAILS THAT VARY FROM UDFCD STANDARD DETAILS. CONSULT WITH LOCAL JURISDICTIONS AS TO WHICH DETAIL SHOULD BE USED WHEN

KT THE END OF THE DAY BY SHOVELING OR SWEEPING. SEDIMENT MAY NOT BE WASHED

3. WHERE BMPs HAVE FAILED, REPAIR OR REPLACEMENT SHOULD BE INITIATED UPON DISCOVERY OF THE FAILURE.

4. ROCK SHALL BE REAPPLIED OR REGRADED AS NECESSARY TO THE STABILIZED ENTRANCE/EXIT TO MAINTAIN A CONSISTENT DEPTH.

WHERE VEHICLES ACCESS THE CONSTRUCTION SITE FROM PAVED RIGHT-OF-WAYS.

5. A NON-WOVEN GEOTEXTILE FABRIC SHALL BE PLACED UNDER THE STABILIZED

CONSTRUCTION ENTRANCE/EXIT PRIOR TO THE PLACEMENT OF ROCK.

STABILIZED CONSTRUCTION ENTRANCE/EXIT MAINTENANCE NOTES

EROSION, AND PERFORM NECESSARY MAINTENANCE.

3. A STABILIZED CONSTRUCTION ENTRANCE/EXIT SHALL BE LOCATED AT ALL ACCESS POINTS

**Vehicle Tracking Control (VTC) SM-4** 

> WW WASH WATER TO SEDIMENT TRAP Detail has been evised to show OR BASIN 5' min length Public Roadway NOTE: WASH WATER CHEMICALS OR SOAPS WITHOUT OBTAINING WASH RACK -A SEPARATE PERMIT

Urban Drainage and Flood Control District

Urban Storm Drainage Criteria Manual Volume 3


**Vehicle Tracking Control (VTC)** 


6'7" MIN. REINFORCED CONCRETE RACK ► DRAIN SPACE (MAY SUBSTITUTE STEEL CATTLE -GUARD FOR CONCRETE RACK)

VTC-2. AGGREGATE VEHICLE TRACKING CONTROL WITH WASH RACK

**Vehicle Tracking Control (VTC)** 



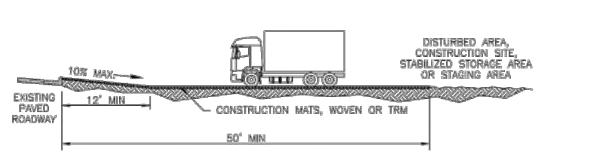

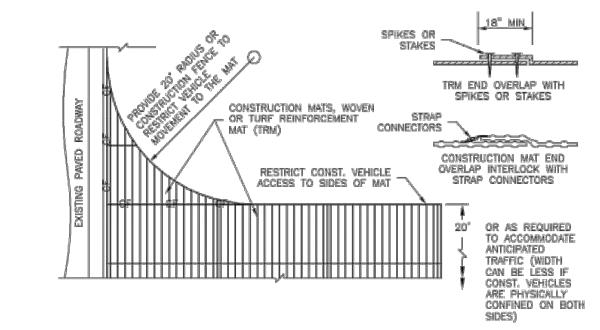

VTC-3. VEHICLE TRACKING CONTROL W/ CONSTRUCTION MAT OR TURF REINFORCEMENT MAT (TRM)

November 2010

November 2010

November 2010

COUNTY FILE NO PUDSP-22-005 JD CH.

ı. RDL 21005234

Urban Drainage and Flood Control District Urban Storm Drainage Criteria Manual Volume 3 VTC-3

Urban Drainage and Flood Control District Urban Storm Drainage Criteria Manual Volume 3

Urban Drainage and Flood Control District

Urban Storm Drainage Criteria Manual Volume 3

November 2010

INSTALL ROCK FLUSH WITH

COMPACTED SUBGRADE

OR BELOW TOP OF PAVEMENT

VTC-1. AGGREGATE VEHICLE TRACKING CONTROL

(WIDTH CAN BE

LESS IF CONST. VEHICLES ARE PHYSICALLY

CONFINED ON

BOTH SIDES)

UNLESS OTHERWISE SPECIFIED BY LOCAL JURISDICTION, USE

CDOT SECT. #703, AASHTO #3

NON-WOVEN GEOTEXTILE

COARSE AGGREGATE OR 6"

NON-WOVEN GEOTEXTILE FABRIC BETWEEN SOIL AND ROCK

UNLESS OTHERWISE SPECIFIED BY LOCAL

#3 COARSE AGGREGATE

OR 6" MINUS ROCK

JURISDICTION, USE COOT SECT. #703, AASHTO

VTC-4

**SM-4** 

November 2010

VTC-5

VTC-6

Urban Drainage and Flood Control District Urban Storm Drainage Criteria Manual Volume 3

\_\_ sr \_\_ sr \_\_ sr \_

EXISTING GROUND

SILT FENCE

GEOTEXTILE

- 6" MIN

BURIED

SILT FENCE

SECTION A

SF-1. SILT FENCE

Urban Drainage and Flood Control District

Urban Storm Drainage Criteria Manual Volume 3

DISTANCE TO OUTLET AND SHALL CONSIST OF A TEMPORARY SLOPE

OF SILT FENCE

POSTS SHALL BE JOINED AS

SHOWN, THEN ROTATED 180 DEG

IN DIRECTION SHOWN AND DRIVEN

1 ½" × 1 ½" (RECOMMENDED) WOODEN

FENCE POST WITH 10' MAX

AT JOINTS SO THAT NO GAPS -EXIST IN SILT FENCE

THICKNESS OF GEOTEXTILE HAS

BEEN EXAGGERATED, TY

CRUSHED ROCK

**SM-6** 

STABILIZED STAGING AREA MAINTENANCE NOTES

STORAGE, AND UNLOADING/LOADING OPERATIONS.

DIFFERENCES ARE NOTED.

5. STABILIZED STAGING AREA SHALL BE ENLARGED IF NECESSARY TO CONTAIN PARKING,

6. THE STABILIZED STAGING AREA SHALL BE REMOVED AT THE END OF CONSTRUCTION. THE

NOTE: MANY MUNICIPALITIES PROHIBIT THE USE OF RECYCLED CONCRETE AS GRANULAR MATERIAL FOR STABILIZED STAGING AREAS DUE TO DIFFICULTIES WITH RE-ESTABLISHMENT OF

NOTE: MANY JURISDICTIONS HAVE BMP DETAILS THAT VARY FROM UDFCD STANDARD DETAILS. CONSULT WITH LOCAL JURISDICTIONS AS TO WHICH DETAIL SHOULD BE USED WHEN

GRANULAR MATERIAL SHALL BE REMOVED OR, IF APPROVED BY THE LOCAL JURISDICTION, USED ON SITE, AND THE AREA COVERED WITH TOPSOIL, SEEDED AND MULCHED OR

OTHERWISE STABILIZED IN A MANNER APPROVED BY LOCAL JURISDICTION.

VEGETATION IN AREAS WHERE RECYCLED CONCRETE WAS PLACED.

(DETAILS ADAPTED FROM DOUGLAS COUNTY, COLORADO, NOT AVAILABLE IN AUTOCAD)

ONLY AND HAVE NOT BEEN INDEPENDENTLY VERIFIED BY TOWNER OR ITS REPRESENTATION EXISTING UTILITIES BEFORE MMENCING WORK, AND AGREE FULLY RESPONSIBLE FOR D ALL DAMAGES WHICH MIGH CCASIONED BY THE CONTRACT AILURE TO EXACTLY LOCATE

PRESERVE ANY AND ALL UNDERGROUND UTILITIES.

ISTRUCTION SITE SAFETY IS SOLE RESPONSIBILITY OF TH SOLE RESPONSIBILITY OF THE CONTRACTOR; NEITHER THE OWNE NOR THE ENGINEER SHALL BE EXPECTED TO ASSUME ANY ESPONSIBILITY FOR SAFETY OF THE WORK, OF PERSONS ENGAGE IN THE WORK, OF ANY NEARBY STRUCTURES, OR OF ANY OTHER PERSONS.

COPYRIGHT © 2022 ATWELL LLC REPRODUCTION SHALL BE MAD WITHOUT THE PRIOR WRITTEN CONSENT OF ATWELL LLC



RER 250 IGS, --518

8/31/2022

SUBMITTAL TO EPC

REVISIONS

COUNTY FILE NO. PUDSP-22-005

1. RDL

21005234

SILT FENCE INSTALLATION NOTES

SC-1

1. SILT FENCE MUST BE PLACED AWAY FROM THE TOE OF THE SLOPE TO ALLOW FOR WATER PONDING. SILT FENCE AT THE TOE OF A SLOPE SHOULD BE INSTALLED IN A FLAT LOCATION AT LEAST SEVERAL FEET (2-5 FT) FROM THE TOE OF THE SLOPE TO ALLOW ROOM FOR

2. A UNIFORM 6" X 4" ANCHOR TRENCH SHALL BE EXCAVATED USING TRENCHER OR SILT FENCE INSTALLATION DEVICE. NO ROAD GRADERS, BACKHOES, OR SIMILAR EQUIPMENT SHALL BE USED.

3. COMPACT ANCHOR TRENCH BY HAND WITH A "JUMPING JACK" OR BY WHEEL ROLLING. COMPACTION SHALL BE SUCH THAT SILT FENCE RESISTS BEING PULLED OUT OF ANCHOR

4. SILT FENCE SHALL BE PULLED TIGHT AS IT IS ANCHORED TO THE STAKES, THERE SHOULD BE NO NOTICEABLE SAG BETWEEN STAKES AFTER IT HAS BEEN ANCHORED TO THE STAKES. 5. SILT FENCE FABRIC SHALL BE ANCHORED TO THE STAKES USING 1" HEAVY DUTY STAPLES OR NAILS WITH 1" HEADS. STAPLES AND NAILS SHOULD BE PLACED 3" ALONG THE FABRIC DOWN THE STAKE.

6. AT THE END OF A RUN OF SILT FENCE ALONG A CONTOUR, THE SILT FENCE SHOULD BE TURNED PERPENDICULAR TO THE CONTOUR TO CREATE A "J-HOOK." THE "J-HOOK" EXTENDING PERPENDICULAR TO THE CONTOUR SHOULD BE OF SUFFICIENT LENGTH TO KEEP RUNOFF FROM FLOWING AROUND THE END OF THE SILT FENCE (TYPICALLY 10' - 20').

7. SILT FENCE SHALL BE INSTALLED PRIOR TO ANY LAND DISTURBING ACTIVITIES.

SILT FENCE MAINTENANCE NOTES 1. INSPECT BMPs EACH WORKDAY, AND MAINTAIN THEM IN EFFECTIVE OPERATING CONDITION.
MAINTENANCE OF BMPs SHOULD BE PROACTIVE, NOT REACTIVE. INSPECT BMPs AS SOON AS POSSIBLE (AND ALWAYS WITHIN 24 HOURS) FOLLOWING A STORM THAT CAUSES SURFACE EROSION, AND PERFORM NECESSARY MAINTENANCE.

2. FREQUENT OBSERVATIONS AND MAINTENANCE ARE NECESSARY TO MAINTAIN BMPs IN EFFECTIVE OPERATING CONDITION. INSPECTIONS AND CORRECTIVE MEASURES SHOULD BE DOCUMENTED THOROUGHLY.

3. WHERE BMP9 HAVE FAILED, REPAIR OR REPLACEMENT SHOULD BE INITIATED UPON

4. SEDIMENT ACCUMULATED UPSTREAM OF THE SILT FENCE SHALL BE REMOVED AS NEEDED TO MAINTAIN THE FUNCTIONALITY OF THE BMP, TYPICALLY WHEN DEPTH OF ACCUMULATED SEDIMENTS IS APPROXIMATELY 6".

5. REPAIR OR REPLACE SILT FENCE WHEN THERE ARE SIGNS OF WEAR, SUCH AS SAGGING, 6. SILT FENCE IS TO REMAIN IN PLACE UNTIL THE UPSTREAM DISTURBED AREA IS STABILIZED

AND APPROVED BY THE LOCAL JURISDICTION, OR IS REPLACED BY AN EQUIVALENT PERIMETER SEDIMENT CONTROL BMP. 7. WHEN SILT FENCE IS REMOVED, ALL DISTURBED AREAS SHALL BE COVERED WITH TOPSOIL,

SEEDED AND MULCHED OR OTHERWISE STABILIZED AS APPROVED BY LOCAL JURISDICTION. (DETAIL ADAPTED FROM TOWN OF PARKER, COLORADO AND CITY OF AURORA, NOT AVAILABLE IN AUTOCAD) NOTE: MANY JURISDICTIONS HAVE BMP DETAILS THAT VARY FROM UDFCD STANDARD DETAILS. CONSULT WITH LOCAL JURISDICTIONS AS TO WHICH DETAIL SHOULD BE USED WHEN DIFFERENCES ARE NOTED.

Urban Storm Drainage Criteria Manual Volume 3

Urban Drainage and Flood Control District November 2010

**Sediment Basin (SB)** 

SEDIMENT BASIN MAINTENANCE NOTES 1. INSPECT BMPs EACH WORKDAY, AND MAINTAIN THEM IN EFFECTIVE OPERATING CONDITION. MAINTENANCE OF BMPs SHOULD BE PROACTIVE, NOT REACTIVE. INSPECT BMPs AS SOON AS POSSIBLE (AND ALWAYS WITHIN 24 HOURS) FOLLOWING A STORM THAT CAUSES SURFACE EROSION, AND PERFORM NECESSARY MAINTENANCE.

2. FREQUENT OBSERVATIONS AND MAINTENANCE ARE NECESSARY TO MAINTAIN BMPs IN EFFECTIVE OPERATING CONDITION. INSPECTIONS AND CORRECTIVE MEASURES SHOULD BE DOCUMENTED THOROUGHLY.

3. WHERE BMPs HAVE FAILED, REPAIR OR REPLACEMENT SHOULD BE INITIATED UPON

4. SEDIMENT ACCUMULATED IN BASIN SHALL BE REMOVED AS NEEDED TO MAINTAIN BMP EFFECTIVENESS, TYPICALLY WHEN SEDIMENT DEPTH REACHES ONE FOOT (I.E., TWO FEET BELOW THE SPILLWAY CREST).

5. SEDIMENT BASINS ARE TO REMAIN IN PLACE UNTIL THE UPSTREAM DISTURBED AREA IS STABILIZED AND GRASS COVER IS ACCEPTED BY THE LOCAL JURISDICTION. 6. WHEN SEDIMENT BASINS ARE REMOVED, ALL DISTURBED AREAS SHALL BE COVERED WITH TOPSOIL, SEEDED AND MULCHED OR OTHERWISE STABILIZED AS APPROVED BY

LOCAL JURISDICTION. (DETAILS ADAPTED FROM DOUGLAS COUNTY, COLORADO)

NOTE: MANY JURISDICTIONS HAVE BMP DETAILS THAT VARY FROM UDFCD STANDARD DETAILS. CONSULT WITH LOCAL JURISDICTIONS AS TO WHICH DETAIL SHOULD BE USED WHEN

—— SF/CF ——— SF/CF – ONSITE CONSTRUCTION VEHICLE PARKING (IF NEEDED) SITE ACCESS 3" MIN. THICKNESS GRANULAR MATERIAL STABILIZED AREA CONSTRUCTION ENTRANCE (SEE -DETAILS VŤC-1 TO VTC-3) \_ SILT FENCE OR CONSTRUCTION FENCING AS NEEDED — SF/CF ——— SF/CF —J EXISTING ROADWAY

SSA-1. STABILIZED STAGING AREA

STABILIZED STAGING AREA INSTALLATION NOTES

-LOCATION OF STAGING AREA(S). -CONTRACTOR MAY ADJUST LOCATION AND SIZE OF STAGING AREA WITH APPROVAL FROM THE LOCAL JURISDICTION.

2. STABILIZED STAGING AREA SHOULD BE APPROPRIATE FOR THE NEEDS OF THE SITE. OVERSIZING RESULTS IN A LARGER AREA TO STABILIZE FOLLOWING CONSTRUCTION.

3. STAGING AREA SHALL BE STABILIZED PRIOR TO OTHER OPERATIONS ON THE SITE. 4. THE STABILIZED STAGING AREA SHALL CONSIST OF A MINIMUM 3" THICK GRANULAR

5. UNLESS OTHERWISE SPECIFIED BY LOCAL JURISDICTION, ROCK SHALL CONSIST OF DOT SECT. #703, AASHTO #3 COARSE AGGREGATE OR 6" (MINUS) ROCK.

6. ADDITIONAL PERIMETER BMPs MAY BE REQUIRED INCLUDING BUT NOT LIMITED TO SILT FENCE AND CONSTRUCTION FENCING.

STABILIZED STAGING AREA MAINTENANCE NOTES

1. INSPECT BMPs EACH WORKDAY, AND MAINTAIN THEM IN EFFECTIVE OPERATING CONDITION.
MAINTENANCE OF BMPs SHOULD BE PROACTIVE, NOT REACTIVE. INSPECT BMPs AS SOON AS POSSIBLE (AND ALWAYS WITHIN 24 HOURS) FOLLOWING A STORM THAT CAUSES SURFACE EROSION, AND PERFORM NECESSARY MAINTENANCE.

2. FREQUENT OBSERVATIONS AND MAINTENANCE ARE NECESSARY TO MAINTAIN BMP8 IN EFFECTIVE OPERATING CONDITION. INSPECTIONS AND CORRECTIVE MEASURES SHOULD BE

3. WHERE BMPs HAVE FAILED, REPAIR OR REPLACEMENT SHOULD BE INITIATED UPON DISCOVERY OF THE FAILURE.

4. ROCK SHALL BE REAPPLIED OR REGRADED AS NECESSARY IF RUTTING OCCURS OR UNDERLYING SUBGRADE BECOMES EXPOSED.

November 2010 Urban Drainage and Flood Control District

SSA-3 Urban Storm Drainage Criteria Manual Volume 3

SSA-4

Urban Drainage and Flood Control District Urban Storm Drainage Criteria Manual Volume 3

November 2010

**Sediment Basin (SB)** 

November 2010

SC-7

SF-3

SF-4

**Sediment Basin (SB)** 

TABLE SB-1. SIZING INFORMATION FOR STANDARD SEDIMENT BASIN Basin Bottom Width Spillway Crest Longth (CL), (ft) (W), (ft) nearest acre), (ac) 58 % 61

-FOR NONSTANDARD BASIN, SEE CONSTRUCTION DRAWINGS FOR DESIGN OF BASIN INCLUDING RISER HEIGHT H, NUMBER OF COLUMNS N, HOLE DIAMETER HD AND PIPE

ROCKS OR CONCRETE GREATER THAN 3 INCHES AND SHALL HAVE A MINIMUM OF 15 PERCENT BY WEIGHT PASSING THE NO. 200 SIEVE.

6. PIPE SCH 40 OR GREATER SHALL BE USED.

SEDIMENT BASIN INSTALLATION NOTES

-LOCATION OF SEDIMENT BASIN.

-TYPE OF BASIN (STANDARD BASIN OR NONSTANDARD BASIN).
-FOR STANDARD BASIN, BOTTOM WIDTH W, CREST LENGTH CL, AND HOLE

2. FOR STANDARD BASIN, BOTTOM DIMENSION MAY BE MODIFIED AS LONG AS BOTTOM AREA IS NOT REDUCED.

3. SEDIMENT BASINS SHALL BE INSTALLED PRIOR TO ANY OTHER LAND-DISTURBING ACTIVITY THAT RELIES ON ON BASINS AS A STORMWATER CONTROL. 4. EMBANKMENT MATERIAL SHALL CONSIST OF SOIL FREE OF DEBRIS, ORGANIC MATERIAL, AND

5. EMBANKMENT MATERIAL SHALL BE COMPACTED TO AT LEAST 95 PERCENT OF MAXIMUM DENSITY IN ACCORDANCE WITH ASTM D698.

7. THE DETAILS SHOWN ON THESE SHEETS PERTAIN TO STANDARD SEDIMENT BASIN(S) FOR DRAINAGE AREAS LESS THAN 15 ACRES. SEE CONSTRUCTION DRAWINGS FOR EMBANKMENT, STORAGE VOLUME, SPILLWAY, OUTLET, AND OUTLET PROTECTION DETAILS FOR ANY SEDIMENT BASIN(S) THAT HAVE BEEN INDIVIDUALLY DESIGNED FOR DRAINAGE AREAS

Urban Drainage and Flood Control District

# RIPRAP PAD HOLE DIAMETER, SEDIMENT BASIN PLAN \*EXCEPT WHERE THE HOLES EXCEED 1" OF SAME SIZED HOLES MAY BE USED SCHEOULE 40 . PVC OR GREATER D50=9" RIPRAP EXCAVATION TYPE L. (SEE TABLE, RIPRAP BEDDING MD=7, MAJOR DRAINAGE, VOL. 1) SECTION A CREST LENGTH EMBANKMENT El. 03.00 MATERIAL

August 2013

Urban Storm Drainage Criteria Manual Volume 3

Urban Storm Drainage Criteria Manual Volume 3

August 2013

Urban Drainage and Flood Control District

- D50=9" RIPRAP TYPE L

Urban Drainage and Flood Control District

August 2013

Urban Storm Drainage Criteria Manual Volume 3

JD CH.

SEE ROCK SOCK DESIGN

IP-1. BLOCK AND ROCK SOCK SUMP OR ON GRADE

INLET PROTECTION

2. CONCRETE "CINDER" BLOCKS SHALL BE LAID ON THEIR SIDES AROUND THE INLET IN A

3. GRAVEL BAGS SHALL BE PLACED AROUND CONCRETE BLOCKS, CLOSELY ABUTTING ONE ANOTHER AND JOINTED TOGETHER IN ACCORDANCE WITH ROCK SOCK DESIGN DETAIL.

3'-5' TYP.

IP-2. CURB ROCK SOCKS UPSTREAM OF

INLET PROTECTION

2. PLACEMENT OF THE SOCK SHALL BE APPROXIMATELY 30 DEGREES FROM PERPENDICULAR IN THE OPPOSITE DIRECTION OF FLOW.

3. SOCKS ARE TO BE FLUSH WITH THE CURB AND SPACED A MINIMUM OF 5 FEET APART.

4. AT LEAST TWO CURB SOCKS IN SERIES ARE REQUIRED UPSTREAM OF ON-GRADE INLETS.

Urban Drainage and Flood Control District

Urban Storm Drainage Criteria Manual Volume 3

16" CINDER

FLOW - COLUMN

BLOCK AND ROCK SOCK INLET

PROTECTION(SEE DETAIL IP-1)

2"x4" WOOD STUD -

DETAIL FOR JOINTING

16° CIND BLOCKS

BLOCK AND CURB SOCK INLET PROTECTION INSTALLATION NOTES.

SOCKS APPROX 30 DEG.

**一 (**图图)

S' MIN

CURB ROCK SOCK INLET PROTECTION INSTALLATION NOTES

1. SEE ROCK SOCK DESIGN DETAIL INSTALLATION REQUIREMENTS.

TWO CURB

1. SEE ROCK SOCK DESIGN DETAIL FOR INSTALLATION REQUIREMENTS.

Annual Control

CURB SOCK -

IP-4

FLOW - (28)

**SC-6** 

FLOW --

CULVERT INLET PROTECTION

CULVERT END SECTION

PLAN [ 108 MIN.

CULVERT INLET PROTECTION INSTALLATION NOTES

SEE PLAN VIEW FOR
 -LOCATION OF CULVERT INLET PROTECTION.

CULVERT INLET PROTECTION MAINTENANCE NOTES.

SEDIMENT DEPTH IS ½ THE HEIGHT OF THE ROCK SOCK.

(DETAILS ADAPTED FROM AURORA, COLORADO, NOT AVAILABLE IN AUTOCAD)

DOCUMENTED THOROUGHLY.

DISCOVERY OF THE FAILURE.

August 2013

- ROCK SOCK

SC-6

IP-7

D (12" MIN.) -

BACKFILL UPSTREAM

SECTION A

KEY IN ROCK SOCK O" ON BEDROCK, PAVEMENT OR RIPRAP

KEY IN ROCK SOCK 2" ON EARTH

SECTION B

<u>CIP-1. CULVERT INLET PROTECTION</u>

2. SEE ROCK SOCK DESIGN DETAIL FOR ROCK GRADATION REQUIREMENTS AND JOINTING

1. INSPECT BMP© EACH WORKDAY, AND MAINTAIN THEM IN EFFECTIVE OPERATING CONDITION.
MAINTENANCE OF BMP© SHOULD BE PROACTIVE, NOT REACTIVE. INSPECT BMP© AS SOON AS
POSSIBLE (AND ALWAYS WITHIN 24 HOURS) FOLLOWING A STORM THAT CAUSES SURFACE

2. FREQUENT OBSERVATIONS AND MAINTENANCE ARE NECESSARY TO MAINTAIN  $\mathsf{BMP}_B$  IN EFFECTIVE OPERATING CONDITION. INSPECTIONS AND CORRECTIVE MEASURES SHOULD BE

3. WHERE BMPs HAVE FAILED, REPAIR OR REPLACEMENT SHOULD BE INITIATED UPON

4. SEDIMENT ACCUMULATED UPSTREAM OF THE CULVERT SHALL BE REMOVED WHEN THE


5. CULVERT INLET PROTECTION SHALL REMAIN IN PLACE UNTIL THE UPSTREAM DISTURBED AREA IS PERMANENTLY STABILIZED AND APPROVED BY THE LOCAL JURISDICTION.

NOTE: MANY JURISDICTIONS HAVE BMP DETAILS THAT VARY FROM UDFCD STANDARD DETAILS. CONSULT WITH LOCAL JURISDICTIONS AS TO WHICH DETAIL SHOULD BE USED WHEN DIFFERENCES ARE NOTED.

Urban Drainage and Flood Control District

Urban Storm Drainage Criteria Manual Volume 3

Know what's below.

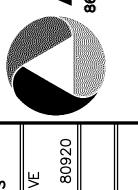

RER 250 1GS, 1-518

8/31/2022

ST SUBMITTAL TO EPC

REVISIONS

1. RDL


COUNTY FILE NO. PUDSP-22-005

JD CH.

17

DB 21005234

SC-6

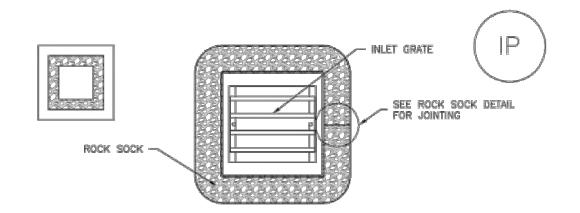

## IP-3. ROCK SOCK SUMP/AREA INLET PROTECTION

2. STRAW WATTLES/SEDIMENT CONTROL LOGS MAY BE USED IN PLACE OF ROCK SOCKS FOR INLETS IN PERVIOUS AREAS. INSTALL PER SEDIMENT CONTROL LOG DETAIL.



### IP-4. SILT FENCE FOR SUMP INLET PROTECTION

SILT FENCE INLET PROTECTION INSTALLATION NOTES

- 1. SEE SILT FENCE DESIGN DETAIL FOR INSTALLATION REQUIREMENTS.
- 2. POSTS SHALL BE PLACED AT EACH CORNER OF THE INLET AND AROUND THE EDGES AT A MAXIMUM SPACING OF 3 FEET.
- 3. STRAW WATTLES/SEDIMENT CONTROL LOGS MAY BE USED IN PLACE OF SILT FENCE FOR INLETS IN PERVIOUS AREAS. INSTALL PER SEDIMENT CONTROL LOG DETAIL.


Urban Drainage and Flood Control District August 2013 IP-5Urban Storm Drainage Criteria Manual Volume 3

3. SEDIMENT MUST BE PERIODICALLY REMOVED FROM THE OVEREXCAVATED AREA.

STRAW BALE BARRIER INLET PROTECTION INSTALLATION NOTES

Urban Drainage and Flood Control District IP-6 August 2013


Urban Storm Drainage Criteria Manual Volume 3

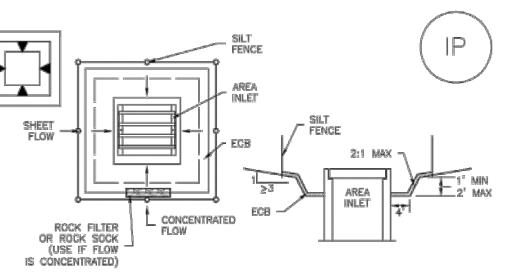

IP-5. OVEREXCAVATION INLET PROTECTION OVEREXCAVATION INLET PROTECTION INSTALLATION NOTES

1. THIS FORM OF INLET PROTECTION IS PRIMARILY APPLICABLE FOR SITES THAT HAVE NOT YET REACHED FINAL GRADE AND SHOULD BE USED ONLY FOR INLETS WITH A RELATIVELY SMALL CONTRIBUTING DRAINAGE AREA.

2. WHEN USING FOR CONCENTRATED FLOWS, SHAPE BASIN IN 2:1 RATIO WITH LENGTH ORIENTED TOWARDS DIRECTION OF FLOW.

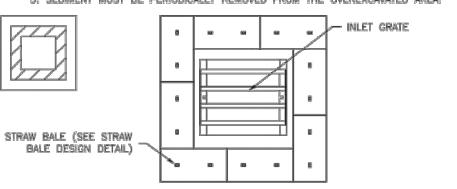

IP-6. STRAW BALE FOR SUMP INLET PROTECTION

 SEE STRAW BALE DESIGN DETAIL FOR INSTALLATION REQUIREMENTS. 2. BALES SHALL BE PLACED IN A SINGLE ROW AROUND THE INLET WITH ENDS OF BALES TIGHTLY ABUTTING ONE ANOTHER.

include seeding and mulching details and seed mix

August 2013

Details have beer

dded to sheet 1

ROCK SOCK SUMP/AREA INLET PROTECTION INSTALLATION NOTES

1. SEE ROCK SOCK DESIGN DETAIL FOR INSTALLATION REQUIREMENTS.