




0 50 100 Feet
SCALE: 1" = 50'

The numbering of the lots is confusing as there are only two distinct lots on the approved Site Development Plan. Please explain or number according to the official legal descriptions which are Lot 1, Block 1, and Lot 2, Block 1 in Space Village Fil No 4. To clarify, please leave the lot lines as they are approved, and indicate on this revised plans which uses are occurring on each lot, similar to the additional site plan you submitted. Please also ensure you are meeting the requirements of the Site Development Plan checklist at the link below:

<https://planningdevelopment.elpasoco.com/applications-and-checklists/#docaccess-e321615d4dc43f2a5f0cca4517e37c9a>

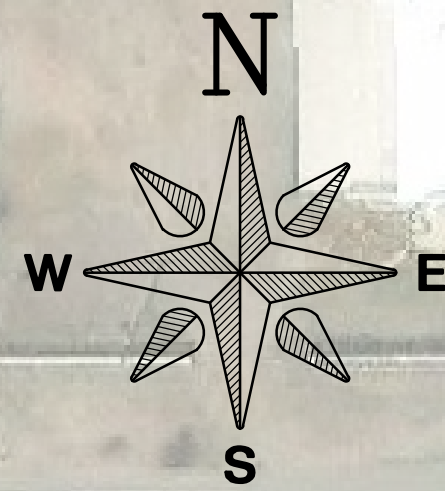