

PRELIMINARY/FINAL DRAINAGE REPORT

FOR

JUDGE ORR ROAD RV PARK & STORAGE DEVELOPMENT

**Prepared For:
Prairie Stone, LLC
9476 Dakota Dunes Lane
Peyton, CO 80831-4138**

**Prepared By:
Associated Design Professionals, Inc.
3520 Austin Bluffs Parkway
Colorado Springs, CO 80918
719.266-5212**

**ADP Project No.160301
November 6, 2018**

PCD Project #PPR-16-040





ENGINEER'S STATEMENT:

The attached drainage plan and report were prepared under my direction and supervision and are correct to the best of my knowledge and belief. Said drainage report has been prepared according to the criteria established by the County for drainage reports, and said report is in conformity with the master plan of the drainage basin. I accept responsibility for any liability caused by any negligent acts, errors or omissions on my part in preparing this report.

Michael A. Bartusek, P.E. #23329

DEVELOPER'S STATEMENT:

I, the Developer, have read and will comply with all of the requirements specified in this drainage report and plan.

By: _____
Andrea Minnich

Title: President

Address: Prairie Stone, LLC
9476 Dakota Dunes Lane
Peyton, CO 80831-4138

Filed in accordance the El Paso County Land Development Code, Drainage Criteria Manual Volumes 1 and 2, and the Engineering Criteria Manual, as amended.

Jennifer Irvine, County Engineer/ECM Administrator

Date

Conditions:

TABLE OF CONTENTS

General	1
Soils	1
Floodplain Statement	1
Method of Computation	1
Water Quality/Detention Concepts	2
Existing Drainage Conditions	2
Developed Drainage Conditions	4
Water Quality	5
Detention	5
Private Drainage Facilities Estimated Cost	6
Drainage Fees	6
Conclusions	6
References	8
Appendix A – Maps	A
Appendix B – Calculations	B
Appendix C – Design Charts	C
Back Pocket – Drainage Map	

**PRELIMINARY/FINAL DRAINAGE REPORT
JUDGE ORR ROAD RV PARK & STORAGE DEVELOPMENT**

GENERAL

The Judge Orr Road RV Park & Storage project consists of 35.0 acres located along Judge Orr Road just east of US 24 and approximately two miles northeast of Falcon, Colorado. The project is located within the previously approved Meadowlake Commons Master Plan area. The site is further described as being located in central El Paso County within the Southwest Quarter of Section 33, Township 12 South, Range 64 West of the 6th Principal Meridian, El Paso County, Colorado.

The proposed development lies within the Haegler Ranch Drainage Basin Planning Study area, prepared by URS Corporation in 2007. It is also included in the Meadowlake Commons MDDP, prepared by Springs Engineering in 2008. For this report, the existing flows for this project utilize the findings of the Meadowlake Commons MDDP.

SOILS

The Soil Conservation Service (NRCS) soil survey for El Paso County has identified the soil type in this study area as follows:

Map Symbol No.	Soil Name	Hydrologic Soil Group
19	Columbine Gravelly Sandy Loam	A

FLOODPLAIN STATEMENT

A small portion of the site is located within a Zone A floodplain as determined by FEMA on the Flood Insurance Rate Map (FIRM) Panel 08041C0575F, dated March 17, 1997.

METHOD OF COMPUTATION

The methodology used for this report is in accordance with the *City/County Drainage Criteria Manual*. The Rational Method for computation of runoff was used for local basin design.

$$Q = cia$$

Where	Q	=	Maximum rate of runoff in cubic feet per second
	c	=	Runoff coefficient representing drainage area characteristics
	i	=	Average rainfall intensity, in inches per hour, for the duration required for the runoff to become established
	a	=	Drainage basin size in acres

The overall drainage for the area including off-site flows was calculated using the US Army Corp of Engineers Hydrologic Engineering Center – Hydrologic Modeling System, Version 3.1.0 (HEC-HMS). The Soil Conservation Service (SCS) (since renamed National Resources Conservation Service - NRCS) curve number method was selected for calculating the runoff volumes from the drainage basins per the DCM. Runoff rates for the five-year minor storm and 100-year major design storm were calculated.

Times of concentration were estimated using the SCS procedures described in the DCM based upon the hydrologic soil type, the natural conditions found in the basins and the runoff curve numbers (CN) chart from Table 5-4 of the DCM.

The 100-year, 24-hour storm precipitation selected from the NOAA isopleth map in Figure 5-4e from the DCM was 4.6 inches. The ten-year, 24-hour storm precipitation selected from the rainfall depth-duration relationship chart in Figure 5-6 from the DCM was 3.1 inches. The five-year, 24-hour storm precipitation was derived from Figure 5-6 of the *City/County Drainage Criteria Manual*. The calculated rainfall amount was 2.6 inches. These numbers, along with SCS information, were used as input.

WATER QUALITY/DETENTION CONCEPTS

In accordance with current NPDES requirements, stormwater quality BMPs will be incorporated into the development of this project. Water quality facilities will be included in all proposed full spectrum detention facilities.

EXISTING DRAINAGE CONDITIONS

The existing site is only minimally developed with some gravel roads and two existing structures. The site is covered with Rangeland grasses and generally drains to the southeast at an average slope of three percent. An existing channel and a Zone A floodplain exist within the far northeastern corner of the project area. An existing, broad swale bisects the site and travels through an abandoned stock pond prior to exiting the site. All flows from Judge Orr Road are intercepted by a roadside ditch which continues past the site to the east.

There are currently two culvert crossings running under US 24. One crossing is a 24-inch CMP culvert located approximately 1,000 feet northeast of the US 24/Judge Orr Road intersection. This pipe is estimated to accommodate flows of 12.9 cfs for the five-year storm and 54.1 cfs for the 100-year storm. The second crossing consists of twin 54-inch CMP culverts. These pipes are located approximately 2,900 ft northeast of the intersection. The twin culverts carry offsite flows of 44.2 cfs for the five-year storm and 192.7 cfs for the 100-year storm and enter the project in the northeast corner, enter the existing channel located in the far northeast corner of the site and cross the property north of the project site.

The existing area located northwest of the parcel is designated as Sub-Basin OS1. This sub-basin drains existing pasture land and produces flows of 1.7 cfs for the 5-year storm and 12.9cfs for the 100-year storm. These flows are intercepted by an existing ditch which carries the flows south along the property line to a low point from Sub-Basin OS2.

Sub-Basin OS2 drains the area just west of the parcel. This area is currently vacant and produces flows of 3.6 cfs and 27.1 cfs respectively. These flows combine with the flows from Sub-Basin OS1 at DP1 for total flows of 4.8 cfs for the 5-year storm and 36.7 cfs for the 100-year storm. These flows travel east through a broad swale located in Sub-Basin A2 and into an existing stock pond.

Sub-Basin A1 drains the northeastern portion of the site. It is currently vacant and covered with rangeland grasses. This sub-basin produces flows of 2.2 cfs for the 5-year storm and 16.5 cfs for the 100-year storm. These flows leave the site in a southeasterly direction approximately 600 ft north of the main channel. These flows eventually join the main channel about 500 ft east of the site.

Sub-Basin A2 drains the major portion of the site and contains the stock pond and farm residence. The site also contains an existing stock pond which has been breached and is covered with rangeland grasses. This sub-basin produces flows of 3.1 cfs and 24.0 cfs respectively. These flows combine with the flows from DP1 at DP2 to produce total flows of 6.6 cfs for the 5-

year storm and 50.1 cfs for the 100-year storm. These flows leave the site in the southeast area of the site.

Sub-Basin OS3 drains an area west of SH24 and drains to the east into Sub-Basin OS4 through a 24" CMP. This area is currently zoned A-35 and is primarily open range. This sub-basin produces flows of 17.8 cfs and 62.0 cfs respectively.

Sub-Basin OS4 drains an area west of the parcel. The area is vacant and covered with rangeland grasses. It slopes to the southeast and flows east along Judge Orr Road. It produces flows of 4.0 cfs and 30.4 cfs respectively. These flows combine with the flows from OS3 at DP3 to produce flows of 20.1 cfs for the 5-year storm and 86.7 cfs for the 100-year storm.

Sub-Basin A3 drains the southern area of the site and is mostly vacant with a barn and some gravel drives located in the western portion of the site. It produces flows of 1.1 cfs and 5.3 cfs respectively and drains into the roadside ditch. OS5 drains the area between the property line and the center line of Judge Orr Road. This area produces flows of 1.3 and 3.3 respectively, and combines with the flows from A3 at DP4 within the Judge Orr roadside ditch to produce total flows of 2.0 cfs for the 5-year storm and 7.6 cfs for the 100-year storm. These flows combine with the flows from DP3 at DP5 to produce total flows of 18.9 cfs for the 5-year storm and 80.7 cfs for the 100-year storm within the roadside ditch. These flows leave the site in a northeasterly direction and join with the main channel about 300 ft east of the property. These flows eventually combine with the flows from DP2 and Sub-Basin A1 at DP6 to produce total flows in the main channel of 27.1 cfs for the 5-year storm and 143.3 cfs for the 100-year storm.

Sub-Basin B drains a small portion of the site in the northern corner. It produces flows of 0.2 cfs for the 5-year storm and 1.6 cfs for the 100-year storm.

The estimated runoff amounts produced for the project under existing conditions are shown in Table 1 below.

TABLE 1 – EXISTING CONDITIONS		
Sub-Basin	Q₅CFS	Q₁₀₀ CFS
OS1	1.7	12.9
OS2	3.6	27.1
OS3	17.8	62.0
OS4	4.0	30.4
OS5	1.3	3.3
A1	2.2	16.5
A2	3.1	24.0
A3	1.1	5.3
B	0.2	1.6
DP1 (OS1 + OS2)	4.8	36.7
DP2 (DP1 + A2)	6.6	50.1
DP3 (OS3 + OS4)	20.1	86.7
DP4 (OS5 + A3)	2.0	7.6
DP5 (DP3 + DP4)	18.9	80.7
DP6 (DP2 + DP4 + A1)	27.1	143.3

State in the narrative who own/maintain this stormline.

8/8/18 - Unresolved. This is to avoid confusion in the future since it is for conveying offsite flow across the property. When this property is platted, then this stormline must be located in a drainage easement.

12/4/18 Unresolved.

DEVELOPED DRAINAGE CONDITIONS

The development of the site will include an RV storage area in the northern portion of the site with RV pads located in the southern portion of the site. The northern area will be covered by 4 inches of loose gravel. The southern area will have 120 gravel RV pad sites with asphalt roads connecting the sites and vegetated areas between the pads.

Flows from the off-site area will remain the same as delineated in the existing conditions portion of the report.

Existing historic flows from the property to the west will be transported through the site by way of a 36" HDPE storm sewer. The proposed 36" HDPE storm sewer will be located near the west property line to facilitate the connection from a future detention facility once the property to the west has been developed. This design has been coordinated with the current property owner, as has the proposed swale within the west property. OS1 will flow down the existing swale on the west property and into a 4' wide swale which connects into a 36" private HDPE storm sewer that flows into the detention basin. In the future a new detention pond will replace the swale and will tie directly into the 36" private HDPE storm sewer. A conceptual 4.6 acre foot pond (Pond 1) was calculated for the future neighborhood commercial site with an estimated outflow of 0.1 cfs for the 5-year storm and 57.3 cfs for the 100-year storm.

Sub-Basin A1 will drain the northern part of the site. This area will be used for RV storage and will be covered by 4 inches of loose gravel. This area will produce flows of 13.8 cfs and 35.3 cfs for the five- and 100-year storms. A 12" berm will keep the flows within the sub-basin. The flows will travel along the berm, cross the drive in a concrete pan and flow into a ditch which will take the flows into Pond 2.

Sub-Basin A2 drains the area between the west property line and the RV storage and will contain the future public road. It will produce flows of 0.8 cfs and 1.5 cfs respectively. These flows will be intercepted in the interim by a flared end section on the west and a type C inlet placed on the proposed 36" HDPE private storm sewer on the east. In the future, when the roadway is extended, these flows will be intercepted by the two (2) 6'D10R inlets. The flows from Sub-basin A2 will combine with the flows from DP1 at DP2 to produce total flows of 7.7 cfs for the 5-year storm and 55.8 cfs for the 100-year storm which will flow directly into Pond 2.

Sub-basin A3 drains the central area of the site between the gravel parking area to the north and the storm sewer to the south. Flows from this RV park area will sheet flow toward a proposed swale above the proposed 36" private storm sewer. It will produce of 6.5 cfs and 17.3 cfs respectively. These flows will combine with the flows from DP2 at DP3 to produce flows of 12.5 cfs and 67.5 cfs for the five- and 100-year storms within the private storm sewer.

Sub-Basin A4 drains the western and southern part of the developed parcel. This area will be developed as an RV park with private streets and gravel parking areas for RV's as well a public roadway on the west side of the site. The project will be built in two phases, however this report is developed for final buildout. The RV Park area will have asphalt roads with natural grass areas between the parking pads. Flows will travel to the southeast and be intercepted by a main road and transported into the detention basin. It will produce flows of 13.8 cfs and 35.3 cfs respectively. These flows will combine with the flows from Sub-Basin A1 and DP3 to produce total flows into the detention basin at DP4 of 31.4 cfs and 110.1 cfs respectively. The proposed 2.82 AF detention basin will release these flows through an outlet structure with a 30 inch HDPE pipe at a rate of 0.7 cfs for the 5-year storm and 33.7 cfs for the 100-year storm.

A5

Sub-Basin A5 drains the western and southernmost area of the site. This area contains a proposed cinder trail and 75 ft future Judge Orr Road right-of-way. This area will produce flows of 0.4 cfs and 2.9 cfs respectively. OS5 drains the area between the property line and the centerline of Judge Orr Road. This area produces flows of 1.0 cfs and 2.6 cfs respectively and combines with the flows from A3 and DP5 at DP6 to produce total flows in this area of 18.3 cfs for the 5-year storm and 62.8 cfs for the 100-year storm. These flows will combine with the detained flows at DP7 to produce total flows of 19.0 cfs for the 5-year storm and 94.5 cfs for the 100-year storm.

Sub-Basin B in the northeastern portion of the site will contain a landscaped area and produce flows of 0.2 cfs for the 5-year storm and 1.6 cfs for the 100-year storm.

Table 2 shows the estimated runoff which will be produced for the project under developed conditions.

TABLE 2 – PHASE I DEVELOPED CONDITIONS		
Sub-Basin	Q ₅ CFS	Q ₁₀₀ CFS
OS1	3.3	15.3
OS2	7.2	54.9
OS3	17.8	62.0
OS4	3.7	10.1
OS5	1.0	2.6
A1	12.3	26.0
A2	0.8	1.5
A3	6.5	17.3
A4	13.8	35.3
A5	0.4	2.9
B	0.2	1.6
DP1 (OS1+OS2)	9.7	66.4
DPD1 (Detained DP1)	0.1	57.3
DP2 (DPD1 + A2)	7.7	55.8
DP3 (DP2 + A3)	12.5	67.5
DP4 (A1+A4+DP3)	31.4	110.1
DPD2 (Detained DP2)	0.7	33.7
DP5 (OS3+OS4)	18.5	62.4
DP6 (A3+OS5+DP5)	18.3	62.8
DP7 (DP6+DPD2)	19.0	94.5

WATER QUALITY

The water quality basin for this project is incorporated with the detention basin for this project and is designed with current NPDES requirements as provided by the El Paso County Drainage Criteria Manual as amended for an EDB. The required water quality capture volume is 0.501 AC-FT. The basin will be constructed with a 2.5-foot permanent micro-pool and a forebay. Design forms for this basin can be found in Appendix B. The design summary is below.

TABLE 3 – WATER QUALITY DESIGN SUMMARY				
Location	Depth	Size (CF)	Depth (FT)	Size (IN)
Pond 2	3.42	22,608	0,1.88,3.76	1.75,1.75,1.75

DETENTION

Developed flows from this project will be reduced to historic levels by using a privately owned and maintained detention facility. The *UDFCD Design for Full Spectrum Detention Basins* is used for the basin. Since a neighborhood commercial development is proposed for the property to the west, a conceptual detention basin was designed for the area and routed through the on-site detention basin for the RV development with the ponds designed in series. The outflow hydrograph from the commercial site (Pond 1) which was designed to produce flows that matched the current historic rates was manually added to the inflow hydrograph for the RV development (Pond 2) and routed through a third spreadsheet (Pond 1 + 2) to produce new detention basin design.

TABLE 4 DETENTION BASIN DETAILS				
Location	Size (AF)	Pipe Outlet	Outlet Structure	Riprap Weir Width
2	2.822	30"	Typical Outlet Structure OS-2	40'

Flows from the detention basin drain into a broad grasses swale. The swale is located within an existing pasture area with an existing slope of approximately 1.7%. It has an average bottom width of 8 ft. with 8:1 side slopes. The detention basin outflow of 33.7 cfs will only produce a flow depth of 0.8 ft. and a velocity of 3.2 fps. Once the Judge Orr ditch flows combine with the detained flows, the 91.5 cfs, approximately 300 ft. east of the project, will produce a flow depth of 1.2 ft and a velocity of 4.10 fps. There are no downstream manmade drainage systems in the area to tie into.

Categorically state whether the channel where D2 and DP 6 merge is hydraulically adequate or not.

Should a 20 ft. breach occur in the detention embankment, the outflow would be approximately 500 cfs and would produce an initial wave of approximately 2.7 ft. and a velocity of 6.8 fps. This wave would dissipate within the 850 ft. prior to flows crossing Judge Orr Road. No structures exist prior to this crossing.

PRIVATE DRAINAGE FACILITIES

Item	Unit	Quantity	Unit Cost	Total Cost
30" RCP FES	EA	1	\$750	\$ 750.00
36" HDPE FES	EA	2	\$800	\$ 1,600.00
38" x 24" RCEP FES	EA	4	\$700	\$ 2,800.00
30" RCP	LF	20	\$101	\$ 2,020.00
36" HDPE	LF	1,250	\$124	\$155,000.00
38" x 24" RCEP	LF	120	\$94	\$ 11,280.00
Detention Outlet Structure	EA	1	\$5,000	\$ 5,000.00
Emergency Spillway	EA	1	\$1,500	\$ 1,500.00
Storm Manhole	EA	2	\$4,575	\$ 9,150.00
			Sub-Total	\$189,100.00
			15% Contingency & Engineering	\$ 28,365.00
			TOTAL	\$217,465.00

DRAINAGE BASIN FEES

The entire project lies within the Haegler Ranch Drainage Basin. However, the parcel is not being platted at this time, so no fees are due. In the future when this site is platted the drainage

and bridge fees will be determined based on the percent of imperviousness of the platted subdivision.

CONCLUSION

The proposed development and subsequent lot developments follow the “Four Step Process” as mandated by the EPA as follows:

Step 1: Runoff Reduction Practices

Runoff has been reduced by disconnecting impervious areas where possible, eliminating “unnecessary” impervious areas and encouraging infiltration into suitable soils.

Step 2: Stabilize drainage ways

All drainageways, ditches and channels have been stabilized by the following methods:

- Tributaries have been left in their relatively natural state where possible.
- New drainageways and swales have been stabilized with either riprap or erosion control fabric depending on the erosion potential.
- No new roadside ditches are proposed for the development.

Step 3: Estimate of disturbed area

The proposed development will disturb approximately 35 acres.

Step 4: Sites tributary to sensitive waters

The development of this project will not affect sensitive waters. The site is tributary to a grassland swale with no constant flow.

The development of this site will not impact the downstream properties due to the construction of the water quality/detention basin which reduces tributary flows below historic levels.

Type the headers for each step. (See ECM Appendix I page I-21). The explanation for how step 3 & 4 were considered does not match the Counties criteria.

8/8/18

Step 3: Provide Water Quality Capture Volume (WQCV)

Step 4: Consider Need for Industrial and Commercial BMPs


12/4/18 Unresolved

REFERENCES

1. City of Colorado Springs and El Paso County (1994). *Drainage Criteria Manual Volume 1* (DCM).
2. City of Colorado Springs and El Paso County (1994). *Drainage Criteria Manual Volume II* (DCM).
3. Soil Survey of El Paso County Area, Colorado by USDA, NRCS.
4. *El Paso County (January 2006) Engineering Criteria Manual*.
5. Urban Drainage and Flood Control District (June 2011). *Urban Storm Drainage Criteria Manual, Volume 1-3*.
6. Meadowlake Commons MDDP by Springs Engineering, dated July, 2008.
7. Heagler DBPS by URS Corporation dated July, 2007.

APPENDIX A

MAPS


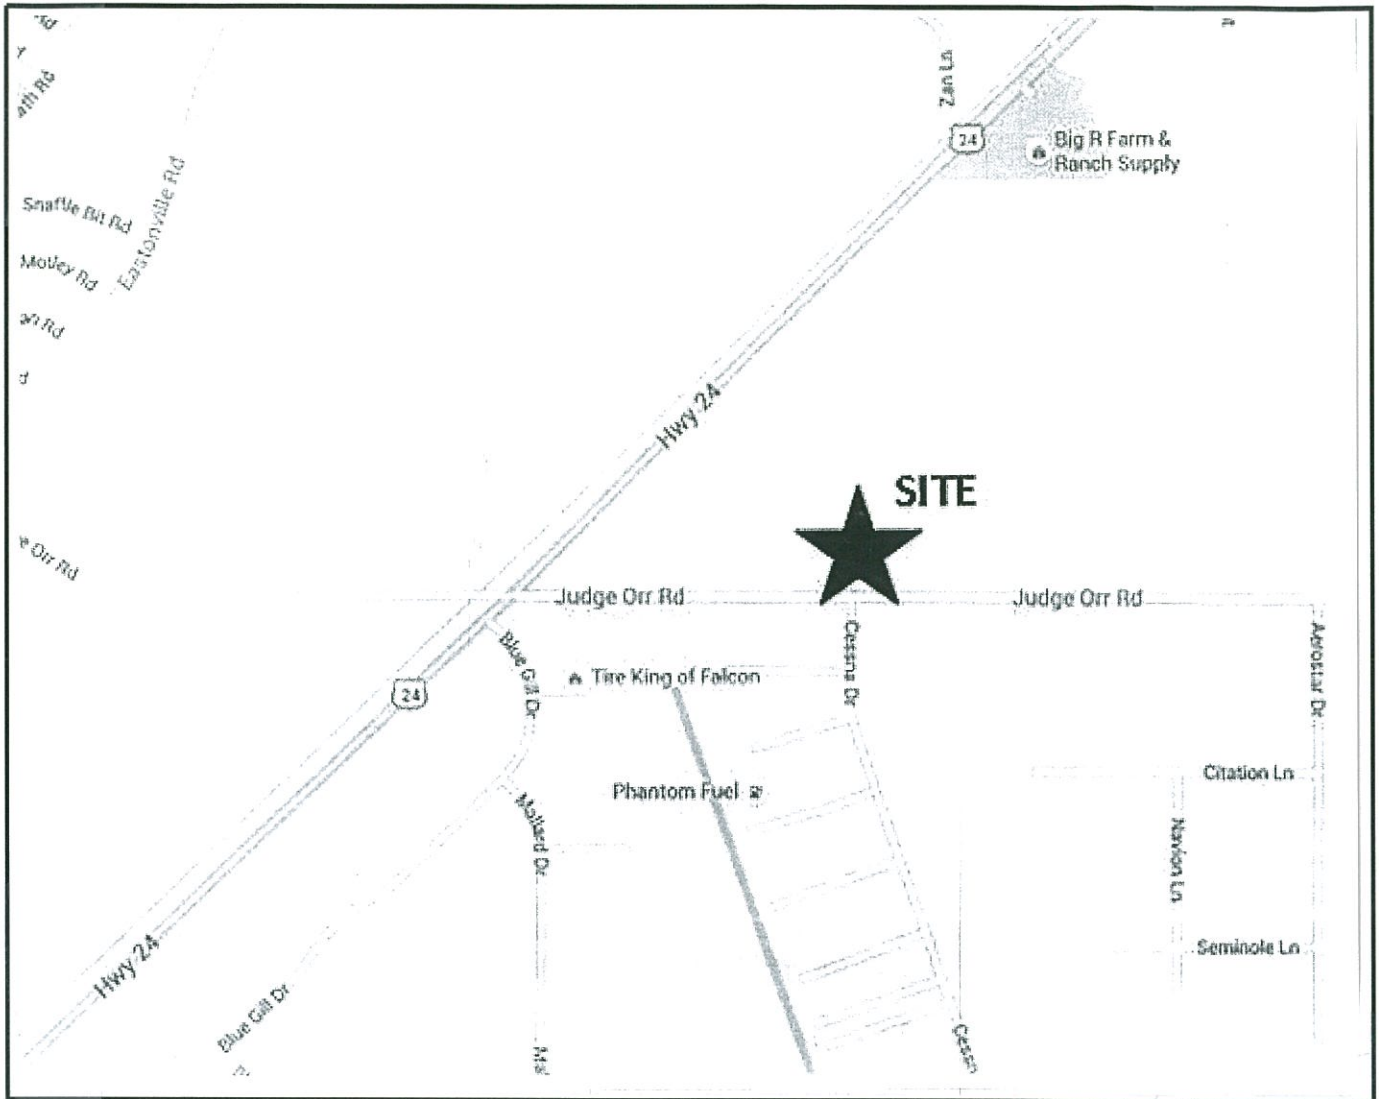


VICINITY MAP

N.T.S.



3520 Austin Bluffs Pkwy, Suite 102
 Colorado Springs, CO 80918
 (719) 266-5212
 fax: (719) 266-5341

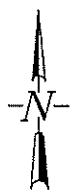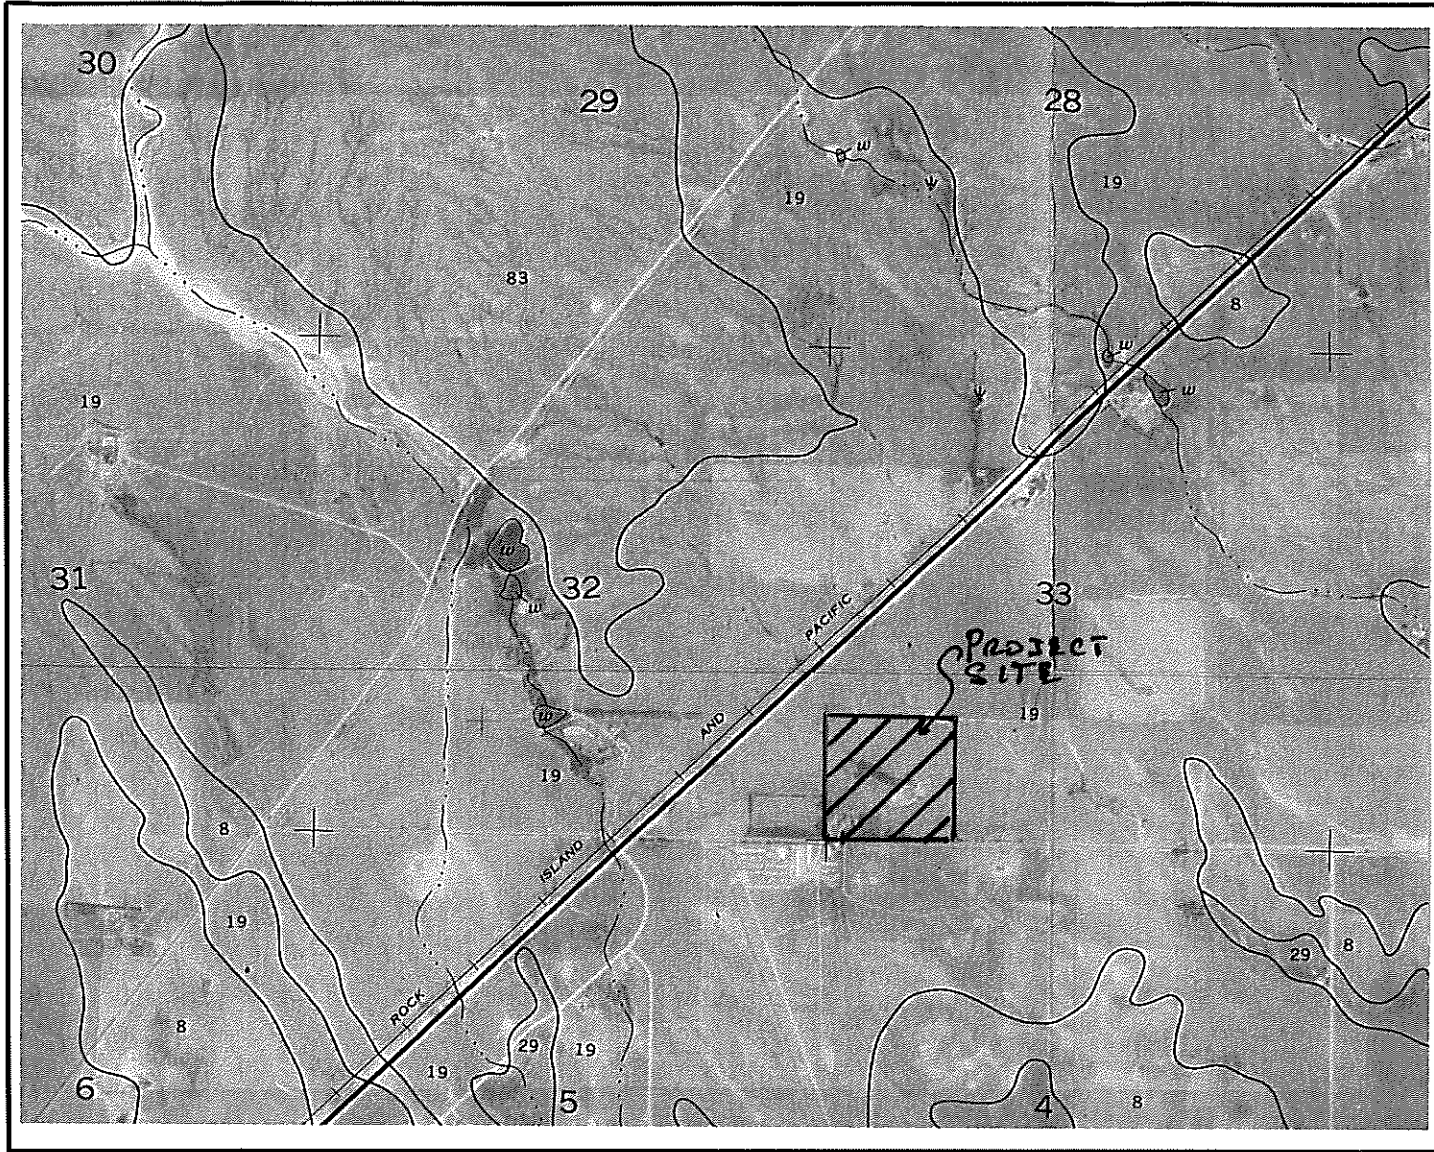

SOILS MAP

N.T.S.

ADPcIVIL

ENGINEERING FOR THE FUTURE

3520 Austin Bluffs Pkwy, Suite 200
Colorado Springs, CO 80918
(719) 266-5212
fax: (719) 266-5341



APPROXIMATE SCALE IN FEET
2000
0
2000

NATIONAL FLOOD INSURANCE PROGRAM

FIRM
FLOOD INSURANCE RATE MAP
EL PASO COUNTY,
COLORADO AND
INCORPORATED AREAS

PANEL 575 OF 1300
(SEE MAP INDEX FOR PANELS NOT PRINTED)

CONTAINS:
COMMUNITY

NUMBER PANEL SUPPL.
00000 0075 F
36030 0075 F

COLORADO SPRINGS, CITY OF
UNINCORPORATED AREAS


MAP NUMBER
08041C0575 F

EFFECTIVE DATE:
MARCH 17, 1997




Federal Emergency Management Agency

This is an official copy of a portion of the above referenced flood map. It was extracted using F-MIT On-Line. This map does not reflect changes or amendments which may have been made subsequent to the date on the title block. For the latest product information about National Flood Insurance Program flood maps check the FEMA Flood Map Store at www.msc.fema.gov

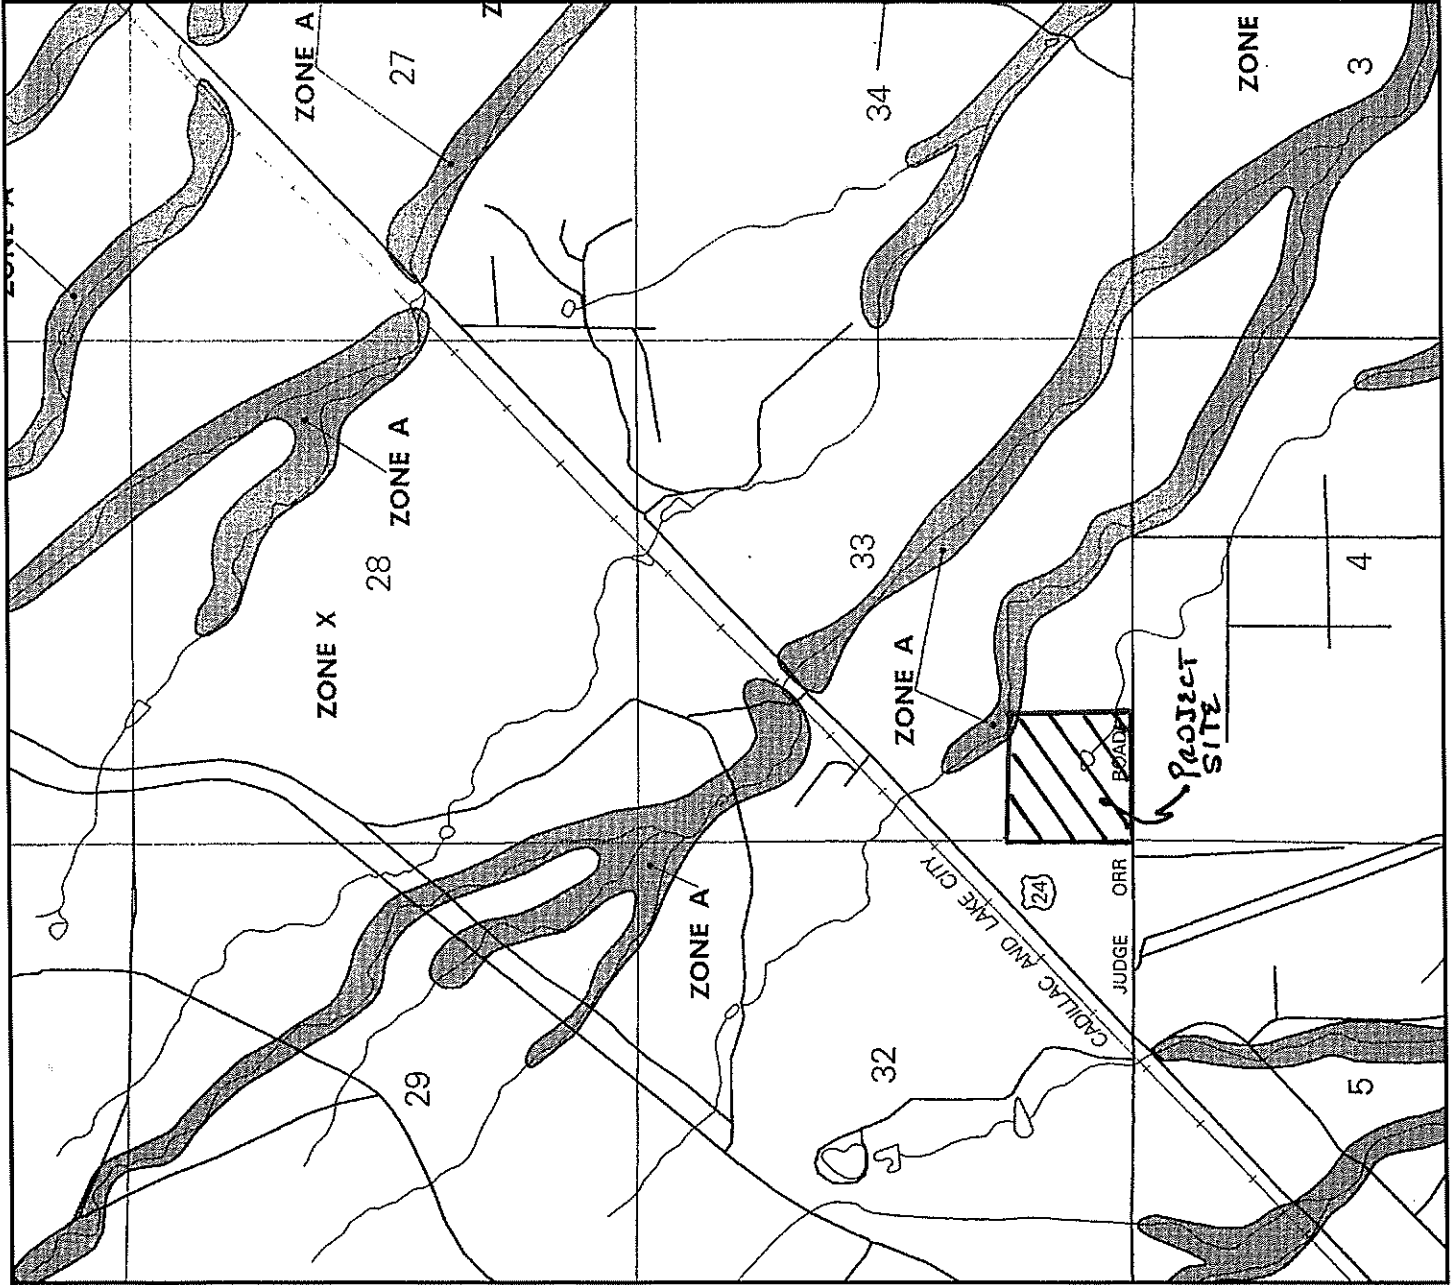

APPENDIX B

DESIGN CALCULATIONS

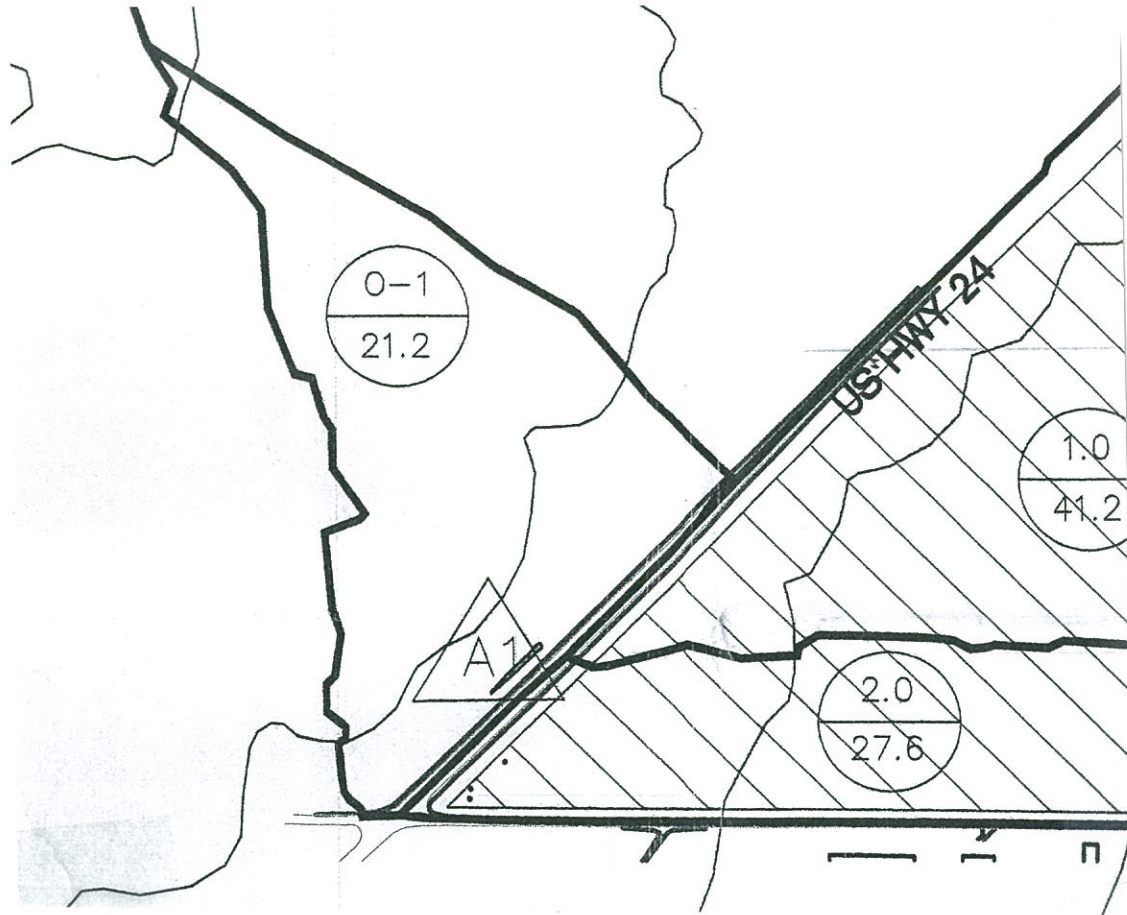

NOTE: SUBBASIN O-1* RENAMED AS SUBBASIN OS3 IN THIS REPORT

* FROM MEADOWLAKE COMMONS MDDP BY SPRINGS ENGINEERING, DATED JULY 2008




OFFSITE
DRAINAGE MAP

SCALE: 1" = 500'



3520 Austin Bluffs Pkwy, Suite 102
 Colorado Springs, CO 80918
 (719) 266-5212
 fax: (719) 266-5341

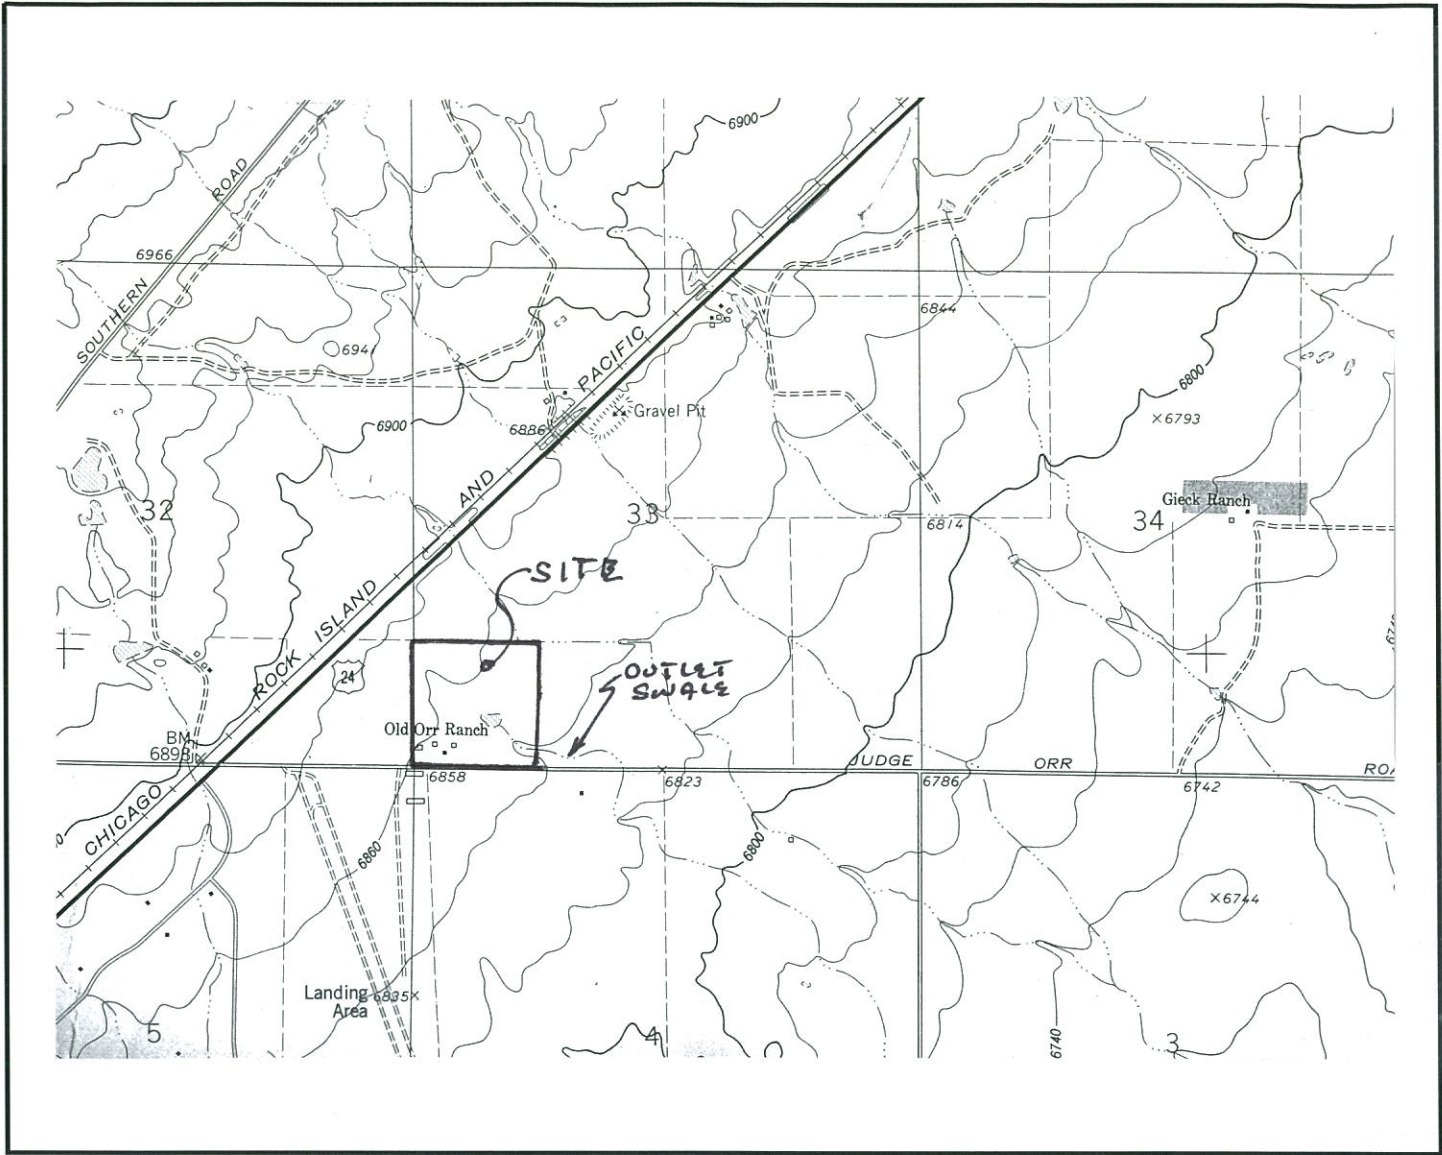

OFFSITE
DRAINAGE MAP

SCALE: 1"=2000'



3520 Austin Bluffs Pkwy, Suite 102
 Colorado Springs, CO 80918
 (719) 266-5212
 fax: (719) 266-5341

JUDGE ORR ROAD RV PARK & STORAGE DEVELOPMENT

C FACTOR CALCULATION SHEET

RUNOFF COEFFICIENT

TYPE A/B SOILS

LAND USE	5 YR	100 YR	IMPERV. %
UNDEV	0.08	0.35	0
LOOSE GRAVEL	0.59	0.7	80
GRAVEL ROADS	0.59	0.7	80
GRAVEL RV PARKING PAD	0.59	0.7	80
PAVED ROADS/BUILDINGS	0.9	0.96	100

Historic Conditions

AREA	TOTAL AREA	SURFACE CONDITION AREAS				CALCULATED C	
		GRASSED SURFACE	LOOSE GRAVEL	GRAVEL ROADS	BUILDINGS OR PAVED ROADS	5 YR	100 YR
DESIG.	(acre)					YR	YR
A1	11.75	11.75	0.00	0.00	0.00	0.08	0.35
A2	20.75	20.60	0.00	0.10	0.05	0.08	0.35
A3	4.36	3.91	0.00	0.35	0.10	0.14	0.39
	36.86	36.26	0.00	0.45	0.15	0.09	0.36
<i>20-5-2</i>							
% Impervious		0%	80%	80%	100%		
Imp x A		0	0	0.36	0.15		
Total I x A	0.51						
Total Imp	0.51/36.86 = 1.4%						
B	0.87	0.87	0.00	0.00	0.00	0.08	0.35
OS1	7.81	7.19	0.00	0.00	0.62	0.15	0.40
OS2	36.41	35.96	0.00	0.00	0.45	0.09	0.36
OS3	27.21	From Heagler DBPS				0.30	0.60
OS4	13.73	12.37	0.00	0.00	1.36	0.16	0.41
OS5	0.71	0.42	0.00	0.00	0.29	0.41	0.60

Revise. Weighted C for basins A2 is low.

Developed Conditions		SURFACE CONDITION AREAS				CALCULATED C	
AREA	TOTAL AREA	GRASSED SURFACE	LOOSE GRAVEL	GRAVEL RV	PAVED ROADS	5	100
DESIG.	(acre)	PARKING				YR	YR
A1	8.30	0.45	7.85	0.00	0.00	0.56	0.68
A2	1.20	0.40	0.00	0.00	0.80	0.20	0.23
A3	6.85	4.24	0.00	0.73	1.88	0.36	0.55
A4	14.00	8.18	0.00	1.62	4.20	0.39	0.57
Total @Pond	30.35	13.27	7.85	2.35	6.88		
A5	1.80	1.72	0.00	0.00	0.08	0.08	0.38
<i>Pond 2</i>							
% Impervious		0%	80%	80%	100%		
Imp x A		0	6.28	1.88	6.88		
Total I x A	15.04						
Total Imp	15.04/30.35 = 49.6%						
B	0.87	0.87	0.00	0.00	0.00	0.08	0.35
OS1	7.81	7.19	0.00	0.00	0.62	0.15	0.40
OS2	42.70	19.20	0.00	0.00	23.50	0.53	0.69
OS3	27.21	From Heagler DBPS				0.30	0.60
OS4	4.18	2.82	0.00	0.00	1.36	0.35	0.55
OS5	0.70	0.42	0.00	0.00	0.28	0.41	0.59
<i>Pond 1</i>							
% Impervious							
	TOTAL AREA	GRASSED SURFACE	NEIGHBORHOOD COMMERCIAL				
OS1	7.81	7.81					
OS2	42.70	1.65	41.05				
	50.51	9.46	41.05				
% Impervious		0%	70%				
Imp x A		0	28.74				
Total I x A	28.74						
Total Imp	28.74/50.51 = 56.9%						

JUDGE ORR ROAD RV PARK & STORAGE DEVELOPMENT																					
PROJ. #160301																					
DRAINAGE CALCULATION SHEET																					
file:judge orr rvl dr																					
11/07/18																					
AREA DESIG.	AREA (acre)	CS (5 yr)	C100 (100 yr)	C5 X A	C100 X A	Initial Tci			Travel Time			TC (min)	IS (in/hr)	I5 (in/hr)	Q5 (cfs)	Q100 (cfs)	length L (feet)	vel. V (fps)	AREA DESIG.		
						L (ft)	Slope (%)	ti (min)	L (ft)	Slope (%)	V (fps)									TC (min)	TC (min)
EXISTING CONDITIONS																					
A1	11.75	0.08	0.35	0.94	4.11	200	2.00	21.46	1150	1.90	2.10	9.13	30.59	2.29	4.00	2.15	16.47		A1		
OS1	7.81	0.15	0.40	1.17	3.12	150	2.00	17.31	600	1.18	2.35	4.26	21.56	2.80	4.89	3.28	15.27	450	4.50	1.67	OS1
OS2	22.10	0.09	0.36	1.99	7.96	150	2.00	18.40	1400	1.20	1.20	19.44	37.85	2.01	3.52	4.00	27.97				OS2
DP1	29.91			3.16	11.08								37.85	2.01	3.52	6.36	38.95	1250	2.10	9.92	DP1
A2	17.47	0.08	0.35	1.40	6.11	250	3.20	20.55	1400	1.90	2.10	11.11	31.66	2.25	3.92	3.14	23.98				A2
DP2	47.38			4.56	17.19								47.77	1.73	3.03	7.91	52.10				DP2
OS3	27.21	0.30	0.60	8.16	16.33	250	2.00	18.82	1570	2.90	1.80	14.54	33.35	2.18	3.80	17.76	62.04	1800	4.00	7.50	OS3
OS4	25.14	0.16	0.41	4.02	10.31	250	2.00	22.11	1800	1.00	2.00	15.00	37.11	2.04	3.56	8.20	36.68				OS4
DP3	52.35			12.19	26.63								37.11	2.04	3.56	24.83	94.79	1050	2.25	7.78	DP3
A3	2.80	0.14	0.39	0.39	1.09	100	2.00	14.28	1050	1.23	2.25	7.78	22.06	2.76	4.83	1.08	5.27				A3
OS5	0.82	0.41	0.60	0.34	0.49	10	2.00	3.25	1050	1.23	2.25	7.78	11.02	3.89	6.79	1.31	3.34				OS5
DP4	55.97			12.91	28.22								44.89	1.81	3.15	23.32	89.02				DP4
DP5	115.10			18.41	49.52								44.89	1.81	3.15	33.25	156.23				DP5
B	0.87	0.08	0.35	0.07	0.30	80	2.00	13.57	650	1.30	2.30	4.71	18.28	3.05	5.34	0.21	1.62				B
DEVELOPED CONDITIONS																					
OS1	7.81	0.15	0.40	1.17	3.12	150	2.00	17.31	600	1.18	2.35	4.26	21.56	2.80	4.89	3.28	15.27	450	4.50	1.67	OS1
OS2	42.70	0.08	0.35	3.42	14.95	150	2.00	18.58	1200	1.20	1.20	16.67	35.25	2.10	3.67	7.19	54.91				OS2
DP1	50.51			4.59	18.07								35.25	2.10	3.67	9.65	66.39				DP1
DPD1	50.51			0.03	15.61	35	2.00	7.92	700	1.50	1.20	9.72	17.64	3.11	5.43	0.75	1.50	70	10.00	0.12	DPD1
A2	1.20	0.20	0.23	0.24	0.28								35.37	2.10	3.67	7.67	55.81	1080	10.00	1.80	DP2
DP2	43.90			3.66	15.22								24.20	2.62	4.58	6.47	17.27				A3
A3	6.85	0.36	0.55	2.47	3.77	100	2.00	11.01	950	1.50	1.20	13.19	37.17	2.04	3.56	12.46	67.52	230	1.20	3.19	DP3
DP3	50.75			6.12	18.99																
A1	8.30	0.56	0.68	4.65	5.64	100	2.00	8.03	1150	1.50	1.20	15.97	24.01	2.64	4.61	12.26	26.00	650	1.20	9.03	A1
A4	14.00	0.39	0.57	5.46	7.98	100	2.00	10.56	1100	1.50	1.20	15.28	25.84	2.53	4.42	13.81	35.26				A4
DP4	73.05			16.23	32.61								40.36	1.93	3.38	31.37	110.11	150	5.00	0.50	DP4
DPD2	73.05			0.36	9.97								40.36	1.93	3.38	0.70	33.70				DPD2
OS3	27.21	0.30	0.60	8.16	16.33	250	2.00	18.82	1570	2.90	1.80	14.54	33.35	2.18	3.80	17.76	62.04	1800	4.00	7.50	OS3
OS4	4.18	0.35	0.55	1.46	2.30	100	2.00	11.16	1860	1.00	2.00	15.00	26.16	2.51	4.39	3.67	10.09				OS4
DP5	31.39			9.63	18.63								40.85	1.92	3.35	18.47	62.40	1020	5.00	3.40	DP5
A5	1.80	0.08	0.38	0.14	0.68	180	2.00	20.36	1050	1.23	2.25	7.78	28.14	2.41	4.21	0.35	2.88				A5
OS5	0.70	0.41	0.59	0.29	0.42	10	2.00	3.26	1300	1.23	2.25	9.63	12.89	3.62	6.33	1.04	2.63				OS5
DP6	33.89			10.06	19.72								44.25	1.82	3.18	18.33	62.80				DP6
DP7	106.94			10.42	29.69								44.25	1.82	3.18	18.98	94.54				DP7
B	0.87	0.08	0.35	0.07	0.30	80	2.00	13.57	650	1.30	2.30	4.71	18.28	3.05	5.34	0.21	1.62				B

* C Factor Adjusted to Model Flows from Detention Model into Rational Method Design

Per DCM 6.5.2, grass lined channel shall not be used where the Froude number is greater than 0.9. Unresolved. See comment in the proposed drainage map for additional detail.

100yr depth exceeds the swale design depth

Swale F & G is missing

DITCH CAPACITY CALCULATION SHEET

Swale Location	Q5 cfs @ 100 cfs	S %	B ft	n	Z	D ft @ 100 ft	V fps	Froude #	Riprap Size in
Swale A	4.8	1.00	4.00	0.035	3:1	3.00	1.30	3.70	0.71
Swale B	3.0	1.00	0.00	0.035	3:1	1.50	1.10	2.75	0.65
Swale C	17.2	1.40	0.00	0.035	3:1	1.00	1.00	2.75	0.65
Swale D	17.2	1.50	0.00	0.035	3:1	2.00	1.70	4.40	0.86
Swale E	9.1	1.40	0.00	0.015	56:1	0.25	0.24	2.80	1.45
Judge Cr Rd Ditch	16.3	1.80	2.00	0.035	3:1	2.00	1.60	5.40	0.97
Spillway	27.5	5.00	40.00	0.040	3:1	2.00	0.50	5.30	1.31
Exist Swale At Prop Line	0.5	1.70	8.00	0.040	8:1	6.00	0.80	3.20	0.77
*Swale 300' East of PL	16.6	1.70	8.00	0.040	8:1	6.00	1.20	4.10	0.82
*Det Breach FLOW	---	500.0	8.00	0.040	8:1	6.00	2.70	6.40	

*Flows from the development travel within a natural swale covered with rangeland grasses

STORM SEWER HYDRAULIC GRADELINE CALCULATION SHEET

Location	Pipe Size	Slope %	Q5	Q100	Cap	Invert	Critical
DDP1	36"	1.3	1.3	8.6	57.3	88.6	2.6
DDP2	36"	1.3	5.1	69.1	88.6	2.6	6855.5
DDP1 @ GB	36"	4.0	8.6	57.3	155.5	2.6	6836.0
DDP4	38"x24"	1.0	16.3	59.6	44	1.36	6856.0
DDP6	38"x24"	1.0	16.3	60.1	44	1.36	6841.6

SPILLWAY CALCULATIONS



b = 40'
d = 1.0'
C = 3.0
FOREBAY CALCULATIONS
2% OF WQV
0.02 X 0.501 = 0.010 AF = 436 CF
FOREBAY NOTCH CALCULATIONS
Q = d^{1.5}bx C
Q100 = 117.6 cfs
QMAX=120.0 cfs
W=2.35/(1X3.0)=0.78 FT

OUTLET PIPE RIPRAP SIZE CALCULATIONS

Q100 = 77.5 cfs
30" RCP @ 3.0%
YE=downstream tailwater
YI=1.4'
XE/D=1.4/2.5=0.56
Q/D^{1.5}=77.5/(2.5^{1.5})=19.6
Use Type M Riprap per Table 5-7, 5'x10'

DETENTION BASIN STAGE-STORAGE TABLE BUILDER


UD-Detention, Version 3.07 (February 2017)

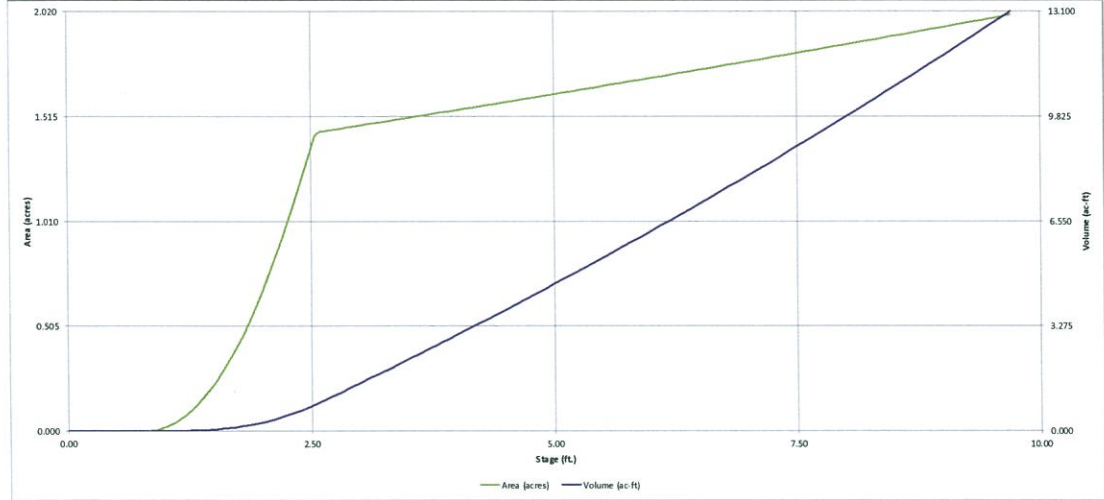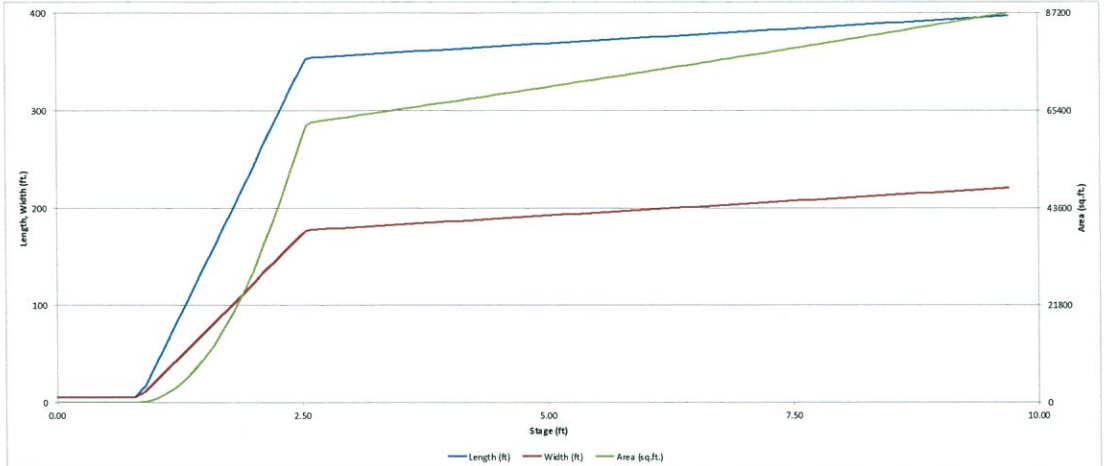

Detention Basin Outlet Structure Design

UD-Detention, Version 3.07 (February 2017)

Project: Judge Orr Rd PUD
Basin ID: Pond 1 (Basins OS1+OS2)

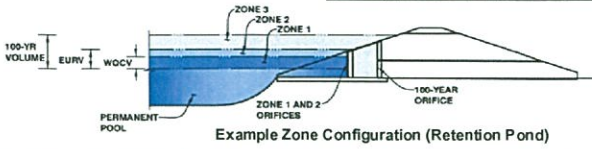

	Stage (ft)	Zone Volume (ac-ft)	Outlet Type
Zone 1 (WQCV)	2.63	0.952	Orifice Plate
Zone 2 (EURV)	3.84	1.795	Orifice Plate
Zone 3 (100-year)	5.00	1.838	Weir&Pipe (Restrict)
		4.585	Total

User Input: Orifice at Underdrain Outlet (typically used to drain WQCV in a Filtration BMP)

Underdrain Orifice Invert Depth = ft (distance below the filtration media surface)
Underdrain Orifice Diameter = inches

Calculated Parameters for Underdrain

Underdrain Orifice Area = ft²
Underdrain Orifice Centroid = feet

User Input: Orifice Plate with one or more orifices or Elliptical Slot Weir (typically used to drain WQCV and/or EURV in a sedimentation BMP)

Invert of Lowest Orifice = ft (relative to basin bottom at Stage = 0 ft)
Depth at top of Zone using Orifice Plate = ft (relative to basin bottom at Stage = 0 ft)
Orifice Plate: Orifice Vertical Spacing = inches
Orifice Plate: Orifice Area per Row = sq. inches (use rectangular openings)

Calculated Parameters for Plate

WQ Orifice Area per Row = ft²
Elliptical Half-Width = feet
Elliptical Slot Centroid = feet
Elliptical Slot Area = ft²

User Input: Stage and Total Area of Each Orifice Row (numbered from lowest to highest)

	Row 1 (required)	Row 2 (optional)	Row 3 (optional)	Row 4 (optional)	Row 5 (optional)	Row 6 (optional)	Row 7 (optional)	Row 8 (optional)
Stage of Orifice Centroid (ft)	0.00	1.30	2.60					
Orifice Area (sq. inches)	3.76	3.76	3.76					

	Row 9 (optional)	Row 10 (optional)	Row 11 (optional)	Row 12 (optional)	Row 13 (optional)	Row 14 (optional)	Row 15 (optional)	Row 16 (optional)
Stage of Orifice Centroid (ft)								
Orifice Area (sq. inches)								

User Input: Vertical Orifice (Circular or Rectangular)

	Not Selected	Not Selected	
Invert of Vertical Orifice =	N/A	N/A	ft (relative to basin bottom at Stage = 0 ft)
Depth at top of Zone using Vertical Orifice =	N/A	N/A	ft (relative to basin bottom at Stage = 0 ft)
Vertical Orifice Diameter =	N/A	N/A	inches

Calculated Parameters for Vertical Orifice

	Not Selected	Not Selected	
Vertical Orifice Area =	N/A	N/A	ft ²
Vertical Orifice Centroid =	N/A	N/A	feet

User Input: Overflow Weir (Dropbox) and Grate (Flat or Sloped)

	Zone 3 Weir	Not Selected	
Overflow Weir Front Edge Height, H _o =	3.90	N/A	ft (relative to basin bottom at Stage = 0 ft)
Overflow Weir Front Edge Length =	7.00	N/A	feet
Overflow Weir Slope =	0.00	N/A	H:V (enter zero for flat grate)
Horiz. Length of Weir Sides =	7.00	N/A	feet
Overflow Grate Open Area % =	70%	N/A	%, grate open area/total area
Debris Clogging % =	50%	N/A	%

Calculated Parameters for Overflow Weir

	Zone 3 Weir	Not Selected	
Height of Grate Upper Edge, H ₁ =	3.90	N/A	feet
Over Flow Weir Slope Length =	7.00	N/A	feet
Grate Open Area / 100-yr Orifice Area =	5.81	N/A	should be ≥ 4
Overflow Grate Open Area w/o Debris =	34.30	N/A	ft ²
Overflow Grate Open Area w/ Debris =	17.15	N/A	ft ²

User Input: Outlet Pipe w/ Flow Restriction Plate (Circular Orifice, Restrictor Plate, or Rectangular Orifice)

	Zone 3 Restrictor	Not Selected	
Depth to Invert of Outlet Pipe =	0.33	N/A	ft (distance below basin bottom at Stage = 0 ft)
Outlet Pipe Diameter =	36.00	N/A	inches
Restrictor Plate Height Above Pipe Invert =	28.00		inches

Calculated Parameters for Outlet Pipe w/ Flow Restriction Plate

	Zone 3 Restrictor	Not Selected	
Outlet Orifice Area =	5.90	N/A	ft ²
Outlet Orifice Centroid =	1.28	N/A	feet
Half-Central Angle of Restrictor Plate on Pipe =	2.16	N/A	radians

User Input: Emergency Spillway (Rectangular or Trapezoidal)

Spillway Invert Stage =	5.10	ft (relative to basin bottom at Stage = 0 ft)
Spillway Crest Length =	47.00	feet
Spillway End Slopes =	4.00	H:V
Freeboard above Max Water Surface =	1.00	feet

Calculated Parameters for Spillway

Spillway Design Flow Depth =	0.90	feet
Stage at Top of Freeboard =	7.00	feet
Basin Area at Top of Freeboard =	1.78	acres




FYI: Pond design for the PUD must ensure this meets state statute criteria.

Routed Hydrograph Results

	WQCV	EURV	2 Year	5 Year	10 Year	25 Year	50 Year	100 Year	500 Year
Design Storm Return Period =									
One-Hour Rainfall Depth (in) =	0.53	1.07	0.83	1.09	1.33	1.69	1.99	2.31	3.14
Calculated Runoff Volume (acre-ft) =	0.952	2.747	1.805	2.734	3.597	5.281	6.565	8.139	11.838
OPTIONAL Override Runoff Volume (acre-ft) =									
Inflow Hydrograph Volume (acre-ft) =	0.952	2.748	1.805	2.735	3.597	5.273	6.564	8.141	11.839
Predevelopment Unit Peak Flow, q (cfs/acre) =	0.00	0.00	0.01	0.09	0.25	0.65	0.89	1.21	1.91
Predevelopment Peak Q (cfs) =	0.0	0.0	0.5	4.4	12.6	32.7	45.1	61.0	96.5
Peak Inflow Q (cfs) =	15.3	43.6	28.8	43.4	56.8	82.7	102.4	126.2	181.5
Peak Outflow Q (cfs) =	0.3	0.6	0.5	0.6	6.5	28.3	45.2	57.3	110.7
Ratio Peak Outflow to Predevelopment Q =	N/A	N/A	N/A	0.1	0.5	0.9	1.0	0.9	1.1
Structure Controlling Flow =	Plate	Plate	Plate	Plate	Overflow Grate 1	Overflow Grate 1	Overflow Grate 1	Outlet Plate 1	Spillway
Max Velocity through Grate 1 (fps) =	N/A	N/A	N/A	N/A	0.2	0.8	1.3	1.6	1.8
Max Velocity through Grate 2 (fps) =	N/A	N/A	N/A	N/A	N/A	N/A	N/A	N/A	N/A
Time to Drain 97% of Inflow Volume (hours) =	38	80	60	79	84	82	80	78	74
Time to Drain 99% of Inflow Volume (hours) =	40	83	63	83	88	87	87	86	84
Maximum Ponding Depth (ft) =	2.58	3.77	3.15	3.76	4.11	4.49	4.72	5.02	5.59
Area at Maximum Ponding Depth (acres) =	1.44	1.53	1.48	1.53	1.55	1.58	1.60	1.62	1.67
Maximum Volume Stored (acre-ft) =	0.887	2.636	1.719	2.621	3.175	3.770	4.120	4.619	5.539

Detention Basin Outlet Structure Design

UD-Detention, Version 3.07 (February 2017)

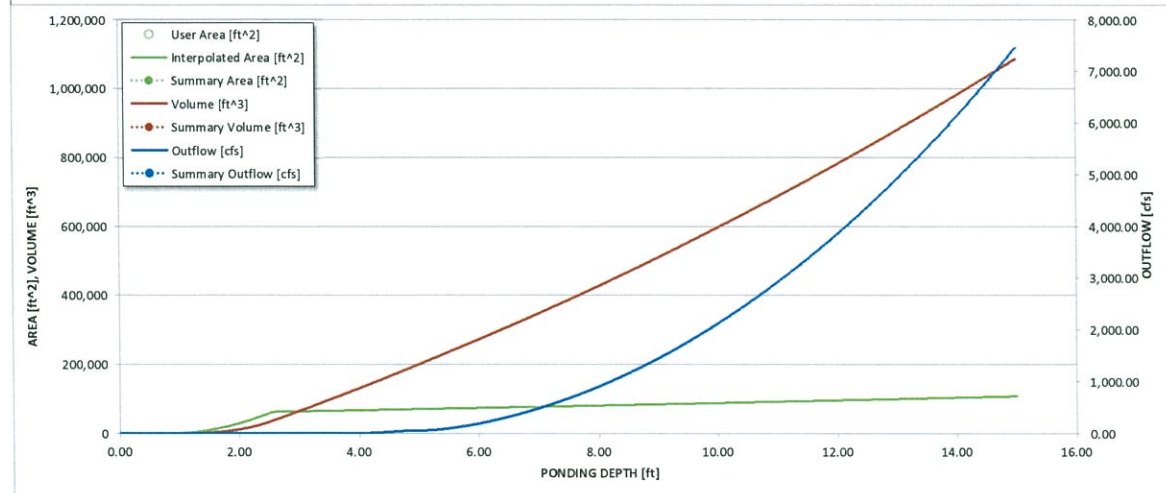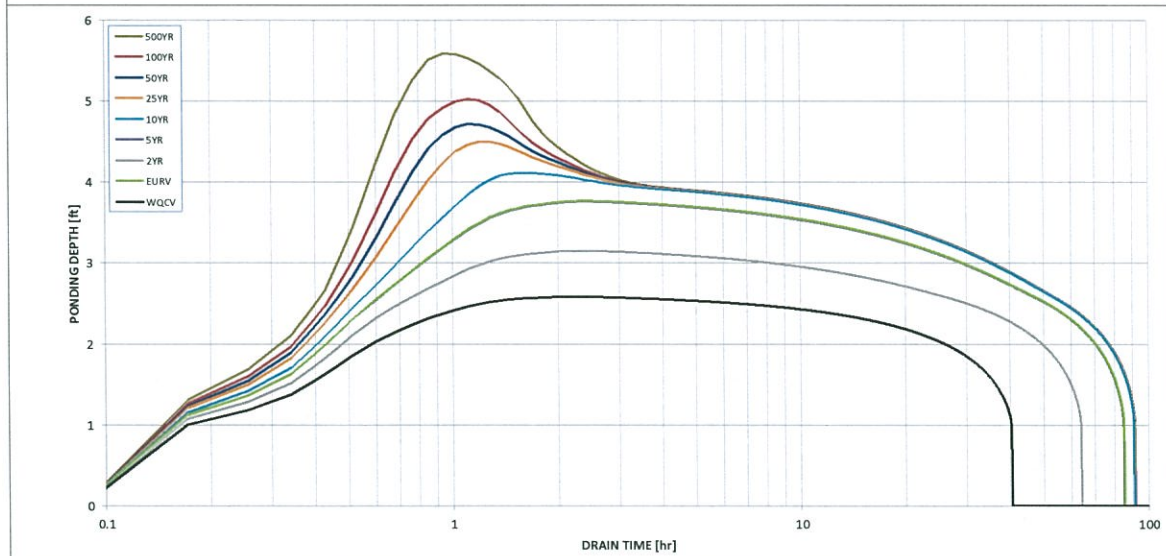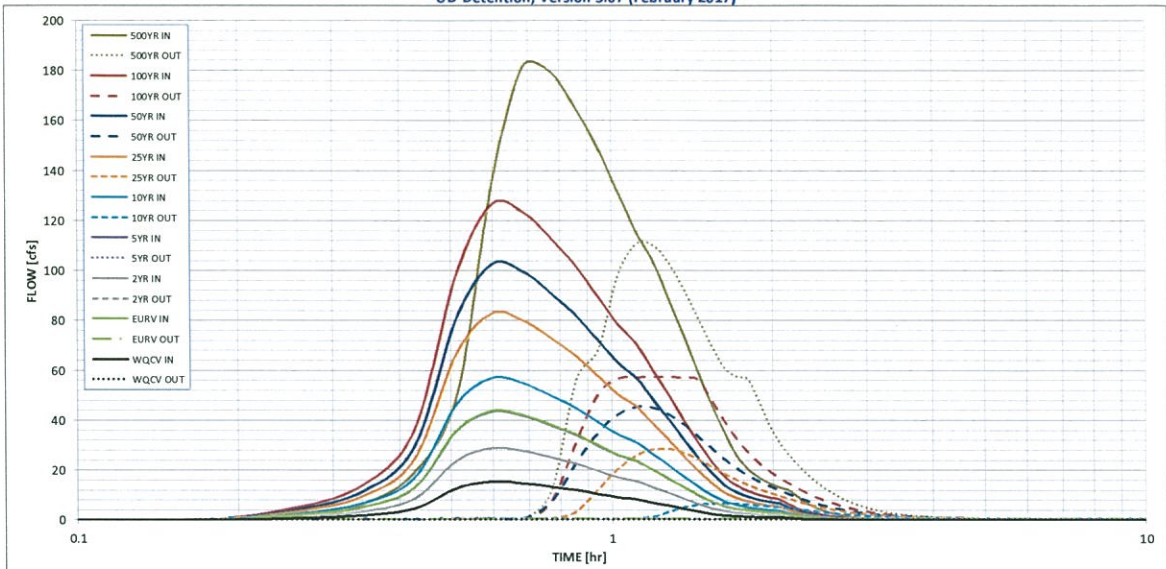

S-A-V-D Chart Axis Override	X-axis	Left Y-Axis	Right Y-Axis
minimum bound			
maximum bound			

Detention Basin Outlet Structure Design

UD-Detention, Version 3.07 (February 2017)

Summary Stage-Area-Volume-Discharge Relationships

The user can create a summary S-A-V-D by entering the desired stage increments and the remainder of the table will populate automatically.

The user should graphically compare the summary S-A-V-D table to the full S-A-V-D table in the chart to confirm it captures all key transition points.


Stage - Storage Description	Stage [ft]	Area [ft ²]	Area [acres]	Volume [ft ³]	Volume [ac-ft]	Total Outflow [cfs]

For best results, include the stages of all grade slope changes (e.g. ISV and Floor) from the S-A-V table on Sheet 'Basin'.

Also include the inverts of all outlets (e.g. vertical orifice, overflow grate, and spillway, where applicable).

DETENTION BASIN STAGE-STORAGE TABLE BUILDER

UD-Detention, Version 3.07 (February 2017)

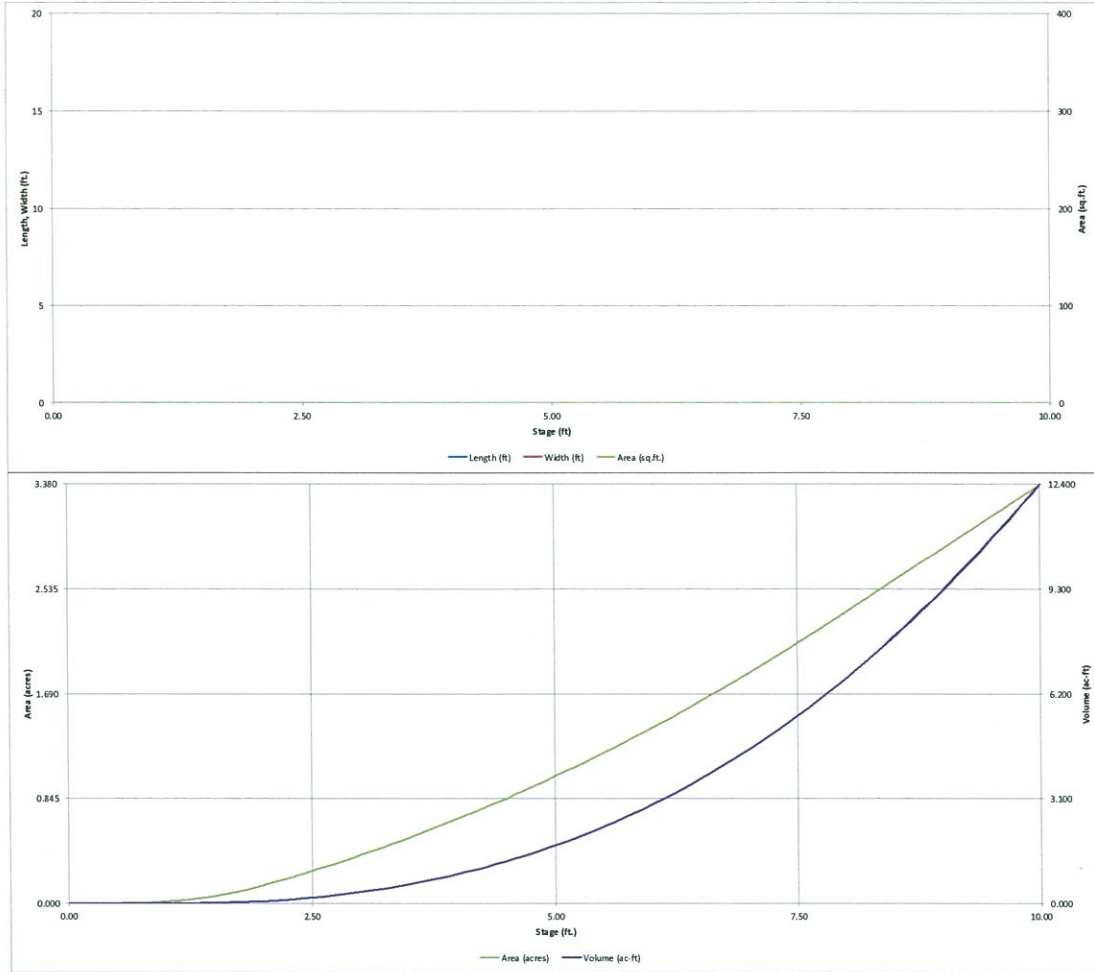

Revise the Pond 2 stage-storage based on the constructed pond shape shown on the GEC plan and not the computer generated values. Input the values in the "optional override stage/area".


The auto-generate for Pond 1 is okay since it was mainly for modeling the pond in a series based on an assumed condition for Pond 1.

However, add a statement that with development of pond 1, that drainage report will have to provide the same pond in a series analysis to verify release rates still meet Senate Bill 15-212.

12/4/18 Unresolved.

DETENTION BASIN STAGE-STORAGE TABLE BUILDER

UD- Detention, Version 3.07 (February 2017)

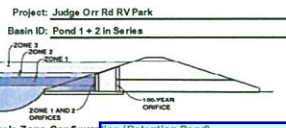

MP @ 6834.2

EL 6835 @ 0.80
Area in GEC is approximately 1,800sf


EL 6836 @ 1.80
Area in GEC is approximately 9,410 sf

EL 6840 @ 5.80
Area in GEC is approximately 17,647 sf

Depth Increment = 0.1 ft	Optional Override Stage (ft)	Length (ft)	Width (ft)	Area (ft ²)	Optional Override Area (ft ²)	Area (acre)	Volume (ft ³)	Volume (ac-ft)
Top of Micropool	0.00	--	--	--	30	0.001	--	--
ISV	0.33	--	--	--	30	0.001	10	0.000
Floor	0.40	--	--	--	46	0.001	12	0.000
	0.50	--	--	--	66	0.002	18	0.000
	0.60	--	--	--	158	0.004	30	0.001
	0.70	--	--	--	254	0.006	50	0.001
	0.80	--	--	--	376	0.009	80	0.002
	0.90	--	--	--	625	0.012	124	0.003
	1.00	--	--	--	698	0.016	183	0.004
	1.10	--	--	--	921	0.021	262	0.006
	1.20	--	--	--	1220	0.028	366	0.008
	1.30	--	--	--	1596	0.037	503	0.012
	1.40	--	--	--	2048	0.047	681	0.016
	1.50	--	--	--	2577	0.059	807	0.021
	1.60	--	--	--	3182	0.073	1189	0.027
	1.70	--	--	--	3864	0.089	1534	0.035
	1.80	--	--	--	4622	0.106	1951	0.045
	1.90	--	--	--	5457	0.125	2447	0.058
	2.00	--	--	--	6368	0.146	3029	0.070
	2.10	--	--	--	7328	0.168	3777	0.087
	2.20	--	--	--	8311	0.191	4599	0.105
	2.30	--	--	--	9314	0.214	5440	0.125
	2.40	--	--	--	10340	0.237	6423	0.147
	2.50	--	--	--	11387	0.261	7509	0.172
	2.60	--	--	--	12456	0.286	8701	0.200
	2.70	--	--	--	13546	0.311	10001	0.230
	2.80	--	--	--	14659	0.337	11412	0.262
	2.90	--	--	--	15793	0.363	12934	0.297
	3.00	--	--	--	16948	0.389	14571	0.335
	3.10	--	--	--	18126	0.416	16325	0.375
	3.20	--	--	--	19325	0.444	18198	0.418
	3.30	--	--	--	20545	0.472	20191	0.464
	3.40	--	--	--	21788	0.500	22308	0.512
	3.50	--	--	--	23052	0.529	24550	0.564
	3.60	--	--	--	24338	0.559	26919	0.618
	3.70	--	--	--	25645	0.589	29418	0.675
	3.80	--	--	--	26975	0.619	32049	0.736
	3.90	--	--	--	28329	0.650	34814	0.799
	4.00	--	--	--	29708	0.682	37716	0.866
	4.10	--	--	--	31093	0.714	40755	0.936
	4.20	--	--	--	32500	0.746	43935	1.009
	4.30	--	--	--	33946	0.779	47258	1.085
	4.40	--	--	--	35406	0.813	50725	1.164
	4.50	--	--	--	36887	0.847	54340	1.247
	4.60	--	--	--	38390	0.881	58104	1.334
	4.70	--	--	--	39914	0.916	62019	1.424
	4.80	--	--	--	41461	0.952	66088	1.517
	4.90	--	--	--	43029	0.988	70312	1.614
	5.00	--	--	--	44618	1.024	74695	1.715
	5.10	--	--	--	46230	1.061	79237	1.819
	5.20	--	--	--	47863	1.099	83942	1.927
	5.30	--	--	--	49517	1.137	88811	2.039
	5.40	--	--	--	51194	1.175	93846	2.154
	5.50	--	--	--	52892	1.214	99051	2.274
	5.60	--	--	--	54612	1.254	104428	2.397
	5.70	--	--	--	56353	1.294	109974	2.525
	5.80	--	--	--	58117	1.334	115698	2.656
	5.90	--	--	--	59902	1.375	121598	2.792
	6.00	--	--	--	61708	1.417	127679	2.931
	6.10	--	--	--	63537	1.459	133941	3.075
	6.20	--	--	--	65387	1.501	140387	3.223
	6.30	--	--	--	67258	1.544	147020	3.375
	6.40	--	--	--	69152	1.588	153940	3.532
	6.50	--	--	--	71067	1.631	160951	3.693
	6.60	--	--	--	73004	1.676	168055	3.858
	6.70	--	--	--	74962	1.721	175353	4.028
	6.80	--	--	--	76943	1.766	182848	4.202
	6.90	--	--	--	78945	1.812	190543	4.381
	7.00	--	--	--	80968	1.859	198438	4.565
	7.10	--	--	--	83014	1.906	206537	4.753
	7.20	--	--	--	85081	1.953	214842	4.946
	7.30	--	--	--	87169	2.001	223355	5.144
	7.40	--	--	--	89280	2.050	232077	5.346
	7.50	--	--	--	91412	2.099	240912	5.554
	7.60	--	--	--	93566	2.148	250050	5.766
	7.70	--	--	--	95741	2.198	259393	5.983
	7.80	--	--	--	97939	2.248	270030	6.205
	7.90	--	--	--	100158	2.299	280875	6.433
	8.00	--	--	--	102398	2.350	292031	6.665
	8.10	--	--	--	104658	2.401	303496	6.903
	8.20	--	--	--	106938	2.452	315261	7.146
	8.30	--	--	--	109238	2.503	327324	7.393
	8.40	--	--	--	111558	2.554	339698	7.646
	8.50	--	--	--	113898	2.605	352385	7.904
	8.60	--	--	--	116258	2.656	365384	8.167
	8.70	--	--	--	118638	2.707	378695	8.435
	8.80	--	--	--	121038	2.758	392324	8.709
	8.90	--	--	--	123458	2.809	406277	8.987
	9.00	--	--	--	125898	2.860	420549	9.270
	9.10	--	--	--	128358	2.911	435148	9.559
	9.20	--	--	--	130838	2.962	450078	9.853
	9.30	--	--	--	133338	3.013	465334	10.151
	9.40	--	--	--	135858	3.064	480920	10.455
	9.50	--	--	--	138398	3.115	496843	10.764
	9.60	--	--	--	140958	3.166	513107	11.078
	9.70	--	--	--	143538	3.217	529717	11.397
	9.80	--	--	--	146138	3.268	546678	11.721
	9.90	--	--	--	148758	3.319	563995	12.051
	10.00	--	--	--	146578	3.370	539497	12.385

DETENTION BASIN STAGE-STORAGE TABLE BUILDER

UD-Detention, Version 3.07 (February 2017)

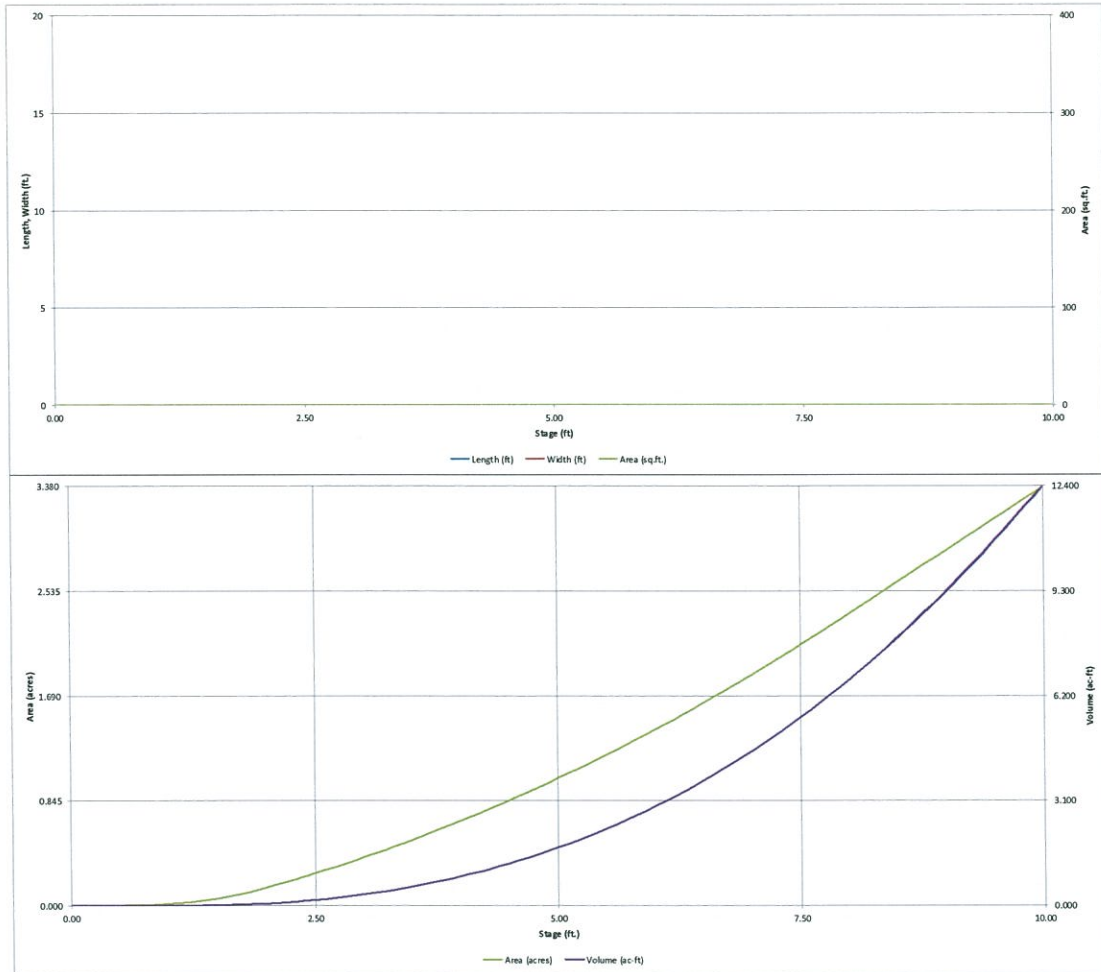


Update title. Staff assumes this is Pond 2 design (w/ Pond 1 & 2 in a series).

12/4/18 Unresolved

Detention Basin Outlet Structure Design

UD-Detention, Version 3.07 (February 2017)

Project: Judge Orr Rd RV Park
Basin ID: Pond 1 + 2 in Series

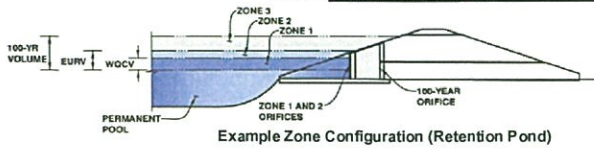

	Stage (ft)	Zone Volume (ac-ft)	Outlet Type
Zone 1 (WQCV)	3.42	0.519	Orifice Plate
Zone 2 (EURV)	4.90	1.089	Orifice Plate
Zone 3 (100-year)	5.93	1.214	Weir & Pipe (Restrict)
		2.822	Total

User Input: Orifice at Underdrain Outlet (typically used to drain WQCV in a Filtration BMP)

Underdrain Orifice Invert Depth =	N/A	ft (distance below the filtration media surface)
Underdrain Orifice Diameter =	N/A	inches

Calculated Parameters for Underdrain

Underdrain Orifice Area =	N/A	ft ²
Underdrain Orifice Centroid =	N/A	feet

User Input: Orifice Plate with one or more orifices or Elliptical Slot Weir (typically used to drain WQCV and/or EURV in a sedimentation BMP)

Invert of Lowest Orifice =	0.00	ft (relative to basin bottom at Stage = 0 ft)
Depth at top of Zone using Orifice Plate =	5.64	ft (relative to basin bottom at Stage = 0 ft)
Orifice Plate: Orifice Vertical Spacing =	22.60	inches
Orifice Plate: Orifice Area per Row =	N/A	inches

Calculated Parameters for Plate

WQ Orifice Area per Row =	N/A	ft ²
Elliptical Half-Width =	N/A	feet
Elliptical Slot Centroid =	N/A	feet
Elliptical Slot Area =	N/A	ft ²

User Input: Stage and Total Area of Each Orifice Row (numbered from lowest to highest)

	Row 1 (required)	Row 2 (optional)	Row 3 (optional)	Row 4 (optional)	Row 5 (optional)	Row 6 (optional)	Row 7 (optional)	Row 8 (optional)
Stage of Orifice Centroid (ft)	0.00	1.88	3.76					
Orifice Area (sq. inches)	2.40	2.40	4.50					

	Row 9 (optional)	Row 10 (optional)	Row 11 (optional)	Row 12 (optional)	Row 13 (optional)	Row 14 (optional)	Row 15 (optional)	Row 16 (optional)
Stage of Orifice Centroid (ft)								
Orifice Area (sq. inches)								

User Input: Vertical Orifice (Circular or Rectangular)

	Not Selected	Not Selected	
Invert of Vertical Orifice =	N/A	N/A	ft (relative to basin bottom at Stage = 0 ft)
Depth at top of Zone using Vertical Orifice =	N/A	N/A	ft (relative to basin bottom at Stage = 0 ft)
Vertical Orifice Diameter =	N/A	N/A	inches

Calculated Parameters for Vertical Orifice

	Not Selected	Not Selected	
Vertical Orifice Area =	N/A	N/A	ft ²
Vertical Orifice Centroid =	N/A	N/A	feet

User Input: Overflow Weir (Dropbox) and Grate (Flat or Sloped)

	Zone 3 Weir	Not Selected	
Overflow Weir Front Edge Height, H _o =	5.00	N/A	ft (relative to basin bottom at Stage = 0 ft)
Overflow Weir Front Edge Length =	4.00	N/A	feet
Overflow Weir Slope =	3.00	N/A	H:V (enter zero for flat grate)
Horiz. Length of Weir Sides =	6.00	N/A	feet
Overflow Grate Open Area % =	70%	N/A	% grate open area/total area
Debris Clogging % =	50%	N/A	%

Calculated Parameters for Overflow Weir

	Zone 3 Weir	Not Selected	
Height of Grate Upper Edge, H _g =	7.00	N/A	feet
Over Flow Weir Slope Length =	6.32	N/A	feet
Grate Open Area / 100-yr Orifice Area =	6.92	N/A	should be ≥ 4
Overflow Grate Open Area w/o Debris =	17.71	N/A	ft ²
Overflow Grate Open Area w/ Debris =	8.85	N/A	ft ²

User Input: Outlet Pipe w/ Flow Restriction Plate (Circular Orifice, Restrictor Plate, or Rectangular Orifice)

	Zone 3 Restrictor	Not Selected	
Depth to Invert of Outlet Pipe =	0.33	N/A	ft (distance below basin bottom at Stage = 0 ft)
Outlet Pipe Diameter =	30.00	N/A	inches
Restrictor Plate Height Above Pipe Invert =	15.50		inches

Calculated Parameters for Outlet Pipe w/ Flow Restriction Plate

	Zone 3 Restrictor	Not Selected	
Outlet Orifice Area =	2.56	N/A	ft ²
Outlet Orifice Centroid =	0.74	N/A	feet
Half-Central Angle of Restrictor Plate on Pipe =	1.60	N/A	radians

User Input: Emergency Spillway (Rectangular or Trapezoidal)

Spillway Invert Stage =	7.92	ft (relative to basin bottom at Stage = 0 ft)
Spillway Crest Length =	40.00	feet
Spillway End Slopes =	3.00	H:V
Freeboard above Max Water Surface =	2.00	feet

Calculated Parameters for Spillway




Spillway Design Flow Depth =	0.92	feet
Stage at Top of Freeboard =	10.84	feet
Basin Area at Top of Freeboard =	3.37	acres

Routed Hydrograph Results

	WQCV	EURV	2 Year	5 Year	10 Year	25 Year	50 Year	100 Year	500 Year
Design Storm Return Period =	0.53	1.07	1.19	1.50	1.75	2.00	2.25	2.52	3.01
One-Hour Rainfall Depth (in) =	0.519	1.608	1.296	1.771	2.399	3.354	4.014	4.881	6.382
Calculated Runoff Volume (acre-ft) =									
OPTIONAL Override Runoff Volume (acre-ft) =									
Inflow Hydrograph Volume (acre-ft) =	0.639	1.820	1.474	1.984	3.195	5.824	7.712	10.251	15.293
Predevelopment Unit Peak Flow, q (cfs/acre) =	0.00	0.00	0.01	0.02	0.20	0.66	0.91	1.23	1.74
Predevelopment Peak Q (cfs) =	0.0	0.0	0.4	0.6	6.1	20.0	27.7	37.3	52.8
Peak Inflow Q (cfs) =	8.9	26.6	21.5	29.2	39.3	55.1	81.1	112.2	181.9
Peak Outflow Q (cfs) =	0.3	0.5	0.4	0.7	5.9	24.4	31.8	33.7	102.8
Ratio Peak Outflow to Predevelopment Q =	N/A	N/A	N/A	1.1	1.0	1.2	1.1	0.9	1.9
Structure Controlling Flow =	Plate	Plate	Plate	Overflow Grate 1	Overflow Grate 1	Overflow Grate 1	Outlet Plate 1	Spillway	Spillway
Max Velocity through Grate 1 (fps) =	N/A	N/A	N/A	0.0	0.3	1.3	1.8	1.9	1.9
Max Velocity through Grate 2 (fps) =	N/A	N/A	N/A	N/A	N/A	N/A	N/A	N/A	N/A
Time to Drain 97% of Inflow Volume (hours) =	38	70	62	72	72	68	64	61	53
Time to Drain 99% of Inflow Volume (hours) =	40	74	66	77	78	76	75	73	70
Maximum Ponding Depth (ft) =	3.49	4.96	4.61	5.09	5.69	6.52	7.10	7.92	8.58
Area at Maximum Ponding Depth (acres) =	0.53	1.01	0.88	1.06	1.29	1.64	1.90	2.30	2.65
Maximum Volume Stored (acre-ft) =	0.558	1.674	1.334	1.808	2.499	3.709	4.734	6.456	8.114

Detention Basin Outlet Structure Design

UD-Detention, Version 3.07 (February 2017)

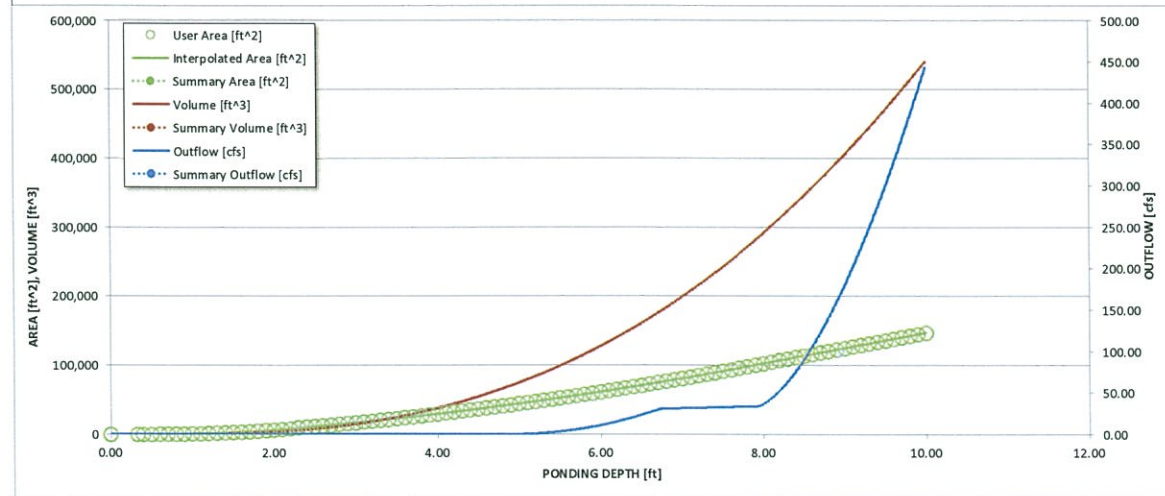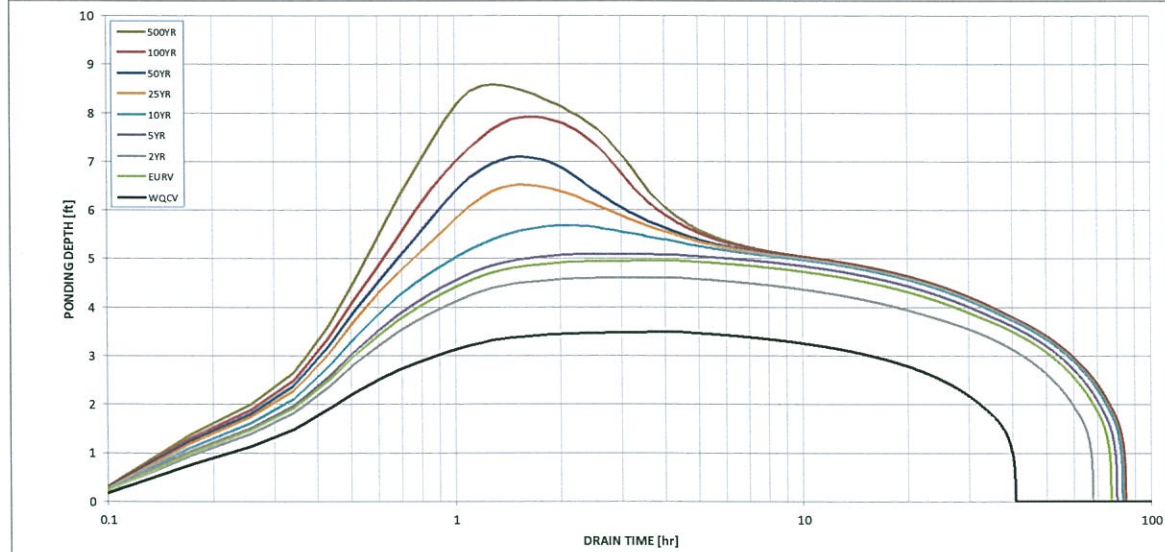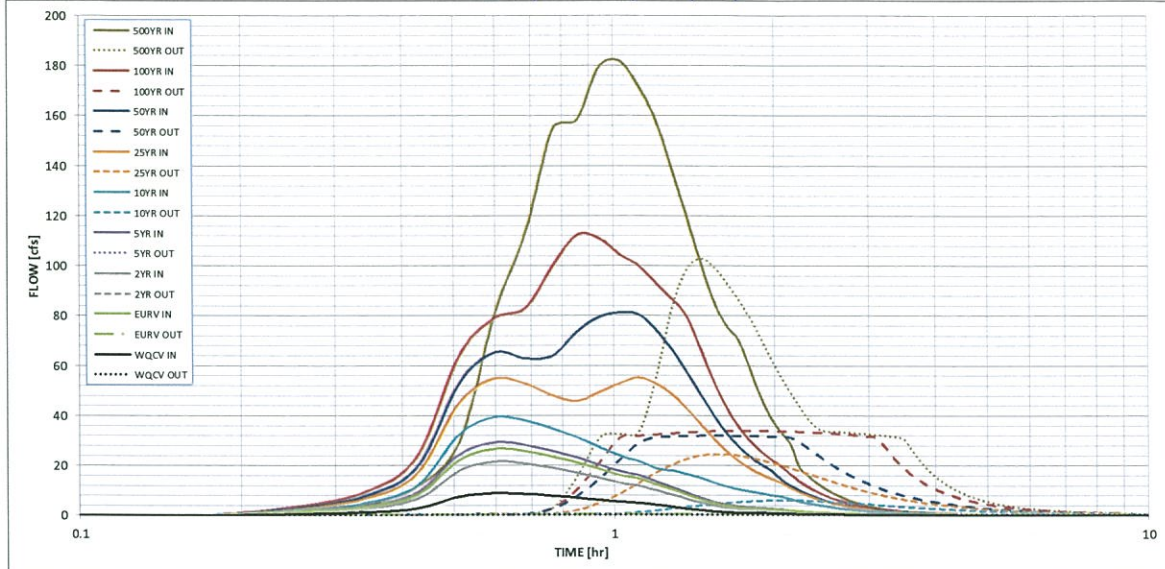


S-A-V-D Chart Axis Override

	X-axis	Left Y-Axis	Right Y-Axis
minimum bound			
maximum bound			

Detention Basin Outlet Structure Design

UD-Detention, Version 3.07 (February 2017)

Project: Judge Orr Rd RV Park
Basin ID: Pond 1 + 2 in Series

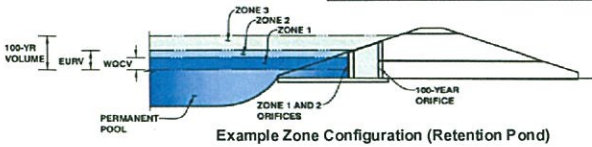

	Stage (ft)	Zone Volume (ac-ft)	Outlet Type
Zone 1 (WQCV)	3.42	0.519	Orifice Plate
Zone 2 (EURV)	4.90	1.089	Orifice Plate
Zone 3 (100-yr)	5.93	1.214	Weir&Pipe (Restrict)
		2.822	Total

User Input: Orifice at Underdrain Outlet (typically used to drain WQCV in a Filtration BMP)

Underdrain Orifice Invert Depth =	N/A	ft (distance below the filtration media surface)
Underdrain Orifice Diameter =	N/A	inches

Calculated Parameters for Underdrain

Underdrain Orifice Area =	N/A	ft ²
Underdrain Orifice Centroid =	N/A	feet

User Input: Orifice Plate with one or more orifices or Elliptical Slot Weir (typically used to drain WQCV and/or EURV in a sedimentation BMP)

Invert of Lowest Orifice =	0.00	ft (relative to basin bottom at Stage = 0 ft)
Depth at top of Zone using Orifice Plate =	5.64	ft (relative to basin bottom at Stage = 0 ft)
Orifice Plate: Orifice Vertical Spacing =	22.60	inches
Orifice Plate: Orifice Area per Row =	N/A	inches

Calculated Parameters for Plate

WQ Orifice Area per Row =	N/A	ft ²
Elliptical Half-Width =	N/A	feet
Elliptical Slot Centroid =	N/A	feet
Elliptical Slot Area =	N/A	ft ²

User Input: Stage and Total Area of Each Orifice Row (numbered from lowest to highest)

	Row 1 (required)	Row 2 (optional)	Row 3 (optional)	Row 4 (optional)	Row 5 (optional)	Row 6 (optional)	Row 7 (optional)	Row 8 (optional)
Stage of Orifice Centroid (ft)	0.00	1.88	3.76					
Orifice Area (sq. inches)	2.40	2.40	4.50					

	Row 9 (optional)	Row 10 (optional)	Row 11 (optional)	Row 12 (optional)	Row 13 (optional)	Row 14 (optional)	Row 15 (optional)	Row 16 (optional)
Stage of Orifice Centroid (ft)								
Orifice Area (sq. inches)								

User Input: Vertical Orifice (Circular or Rectangular)

	Not Selected	Not Selected	
Invert of Vertical Orifice =	N/A	N/A	ft (relative to basin bottom at Stage = 0 ft)
Depth at top of Zone using Vertical Orifice =	N/A	N/A	ft (relative to basin bottom at Stage = 0 ft)
Vertical Orifice Diameter =	N/A	N/A	inches

Calculated Parameters for Vertical Orifice

	Not Selected	Not Selected	
Vertical Orifice Area =	N/A	N/A	ft ²
Vertical Orifice Centroid =	N/A	N/A	feet

User Input: Overflow Weir (Dropbox) and Grate (Flat or Sloped)

	Zone 3 Weir	Not Selected	
Overflow Weir Front Edge Height, H _o =	5.00	N/A	ft (relative to basin bottom at Stage = 0 ft)
Overflow Weir Front Edge Length =	4.00	N/A	feet
Overflow Weir Slope =	3.00	N/A	H:V (enter zero for flat grate)
Horiz. Length of Weir Sides =	6.00	N/A	feet
Overflow Grate Open Area % =	70%	N/A	% grate open area/total area
Debris Clogging % =	50%	N/A	%

Calculated Parameters for Overflow Weir

	Zone 3 Weir	Not Selected	
Height of Grate Upper Edge, H _t =	7.00	N/A	feet
Overflow Weir Slope Length =	6.32	N/A	feet
Grate Open Area / 100-yr Orifice Area =	6.92	N/A	should be ≥ 4
Overflow Grate Open Area w/o Debris =	17.71	N/A	ft ²
Overflow Grate Open Area w/ Debris =	8.85	N/A	ft ²

User Input: Outlet Pipe w/ Flow Restriction Plate (Circular Orifice, Restrictor Plate, or Rectangular Orifice)

	Zone 3 Restrictor	Not Selected	
Depth to Invert of Outlet Pipe =	0.33	N/A	ft (distance below basin bottom at Stage = 0 ft)
Outlet Pipe Diameter =	30.00	N/A	inches
Restrictor Plate Height Above Pipe Invert =	15.50		inches

Calculated Parameters for Outlet Pipe w/ Flow Restriction Plate

	Zone 3 Restrictor	Not Selected	
Outlet Orifice Area =	2.56	N/A	ft ²
Outlet Orifice Centroid =	0.74	N/A	feet
Half-Central Angle of Restrictor Plate on Pipe =	1.60	N/A	radians

User Input: Emergency Spillway (Rectangular or Trapezoidal)

Spillway Invert Stage =	7.92	ft (relative to basin bottom at Stage = 0 ft)
Spillway Crest Length =	40.00	feet
Spillway End Slopes =	3.00	H:V
Freeboard above Max Water Surface =	2.00	feet

Calculated Parameters for Spillway

Spillway Design Flow Depth =	0.92	feet
Stage at Top of Freeboard =	10.84	feet
Basin Area at Top of Freeboard =	3.37	acres

Routed Hydrograph Results




	WQCV	EURV	2 Year	5 Year	10 Year	25 Year	50 Year	100 Year	500 Year
Design Storm Return Period =									
One-Hour Rainfall Depth (in) =	0.53	1.07	1.19	1.50	1.75	2.00	2.25	2.52	3.01
Calculated Runoff Volume (acre-ft) =	0.519	1.608	1.296	1.771	2.399	3.354	4.014	4.881	6.382
OPTIONAL Override Runoff Volume (acre-ft) =									
Inflow Hydrograph Volume (acre-ft) =	0.639	1.820	1.474	1.984	3.195	5.824	7.712	10.251	15.293
Predevelopment Unit Peak Flow, q (cfs/acre) =	0.00	0.00	0.01	0.02	0.20	0.66	0.91	1.23	1.74
Predevelopment Peak Q (cfs) =	0.0	0.0	0.4	0.6	6.1	20.0	27.7	37.3	52.8
Peak Inflow Q (cfs) =	8.9	26.6	21.5	29.2	39.3	55.1	81.1	112.2	181.9
Peak Outflow Q (cfs) =	0.3	0.5	0.4	0.7	5.9	24.4	31.8	33.7	102.8
Ratio Peak Outflow to Predevelopment Q =	N/A	N/A	N/A	1.1	1.0	1.2	1.1	0.9	1.9
Structure Controlling Flow =	Plate	Plate	Plate	Overflow Grate 1	Overflow Grate 1	Overflow Grate 1	Outlet Plate 1	Spillway	Spillway
Max Velocity through Grate 1 (fps) =	N/A	N/A	N/A	0.0	0.3	1.3	1.8	1.9	1.9
Max Velocity through Grate 2 (fps) =	N/A	N/A	N/A	N/A	N/A	N/A	N/A	N/A	N/A
Time to Drain 97% of Inflow Volume (hours) =	38	70	62	72	72	68	64	61	53
Time to Drain 99% of Inflow Volume (hours) =	40	74	66	77	78	76	75	73	70
Maximum Ponding Depth (ft) =	3.49	4.96	4.61	5.09	5.69	6.52	7.10	7.92	8.58
Area at Maximum Ponding Depth (acres) =	0.53	1.01	0.88	1.06	1.29	1.64	1.80	2.30	2.65
Maximum Volume Stored (acre-ft) =	0.558	1.674	1.334	1.808	2.499	3.709	4.734	6.456	8.114

Unresolved. Update to release at or below historic for the full spectrum detention. As the outlet structure is modified for the release ensure the drain time does not exceed the state statute criteria (5yr to release 97% w/in 72hrs).


should fully release in the outlet structure.

Detention Basin Outlet Structure Design

UD-Detention, Version 3.07 (February 2017)

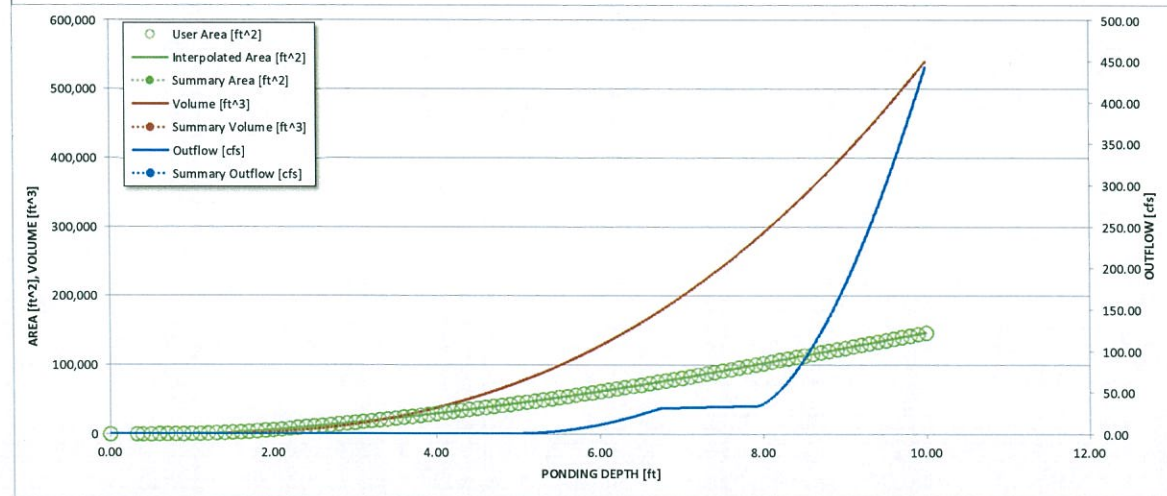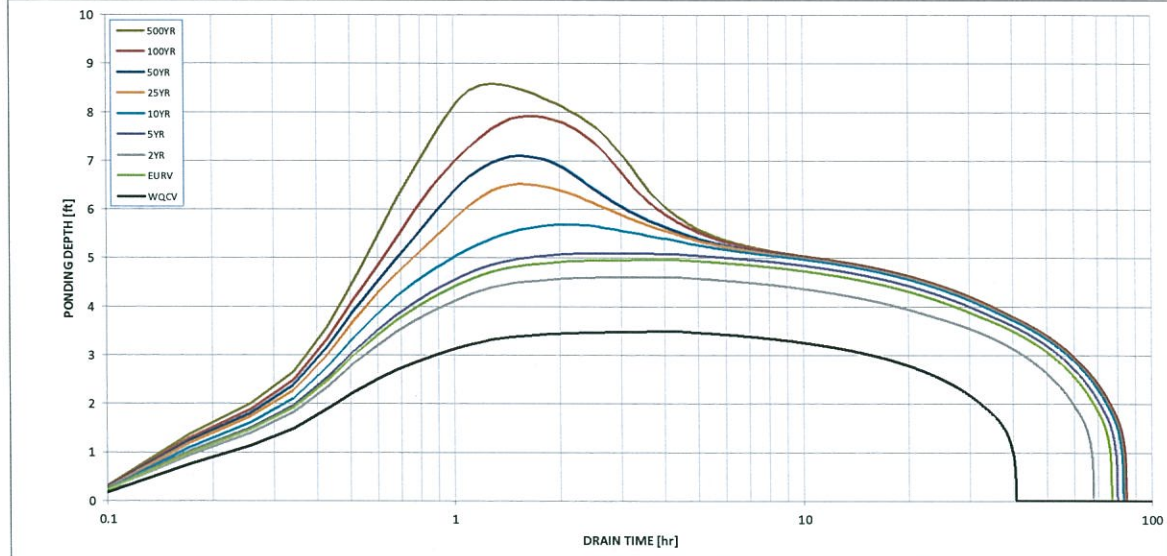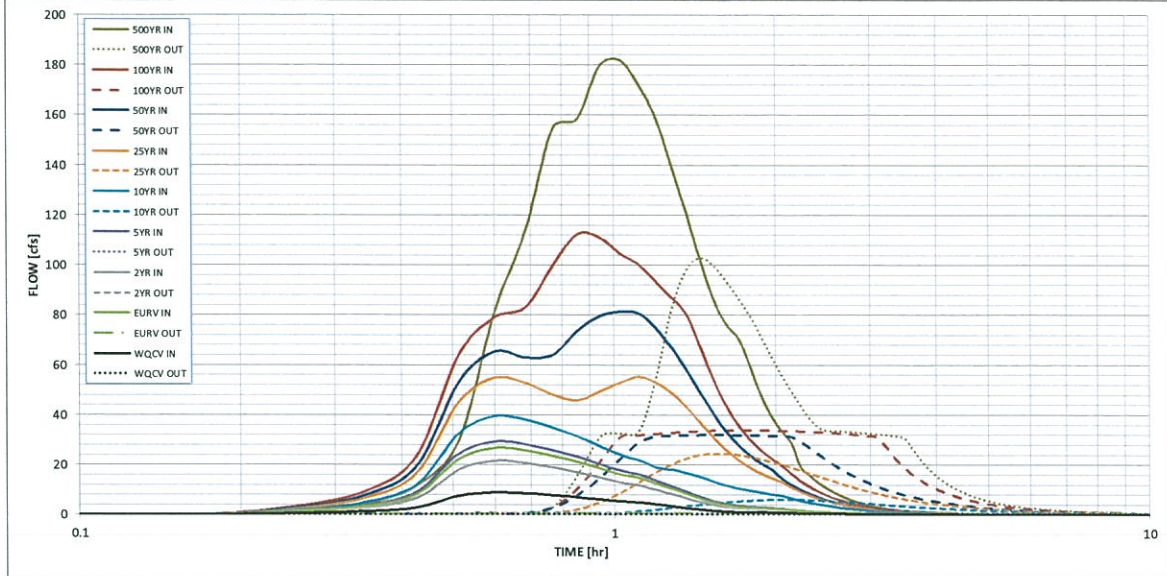

S-A-V-D Chart Axis Override	X-axis	Left Y-Axis	Right Y-Axis
minimum bound			
maximum bound			

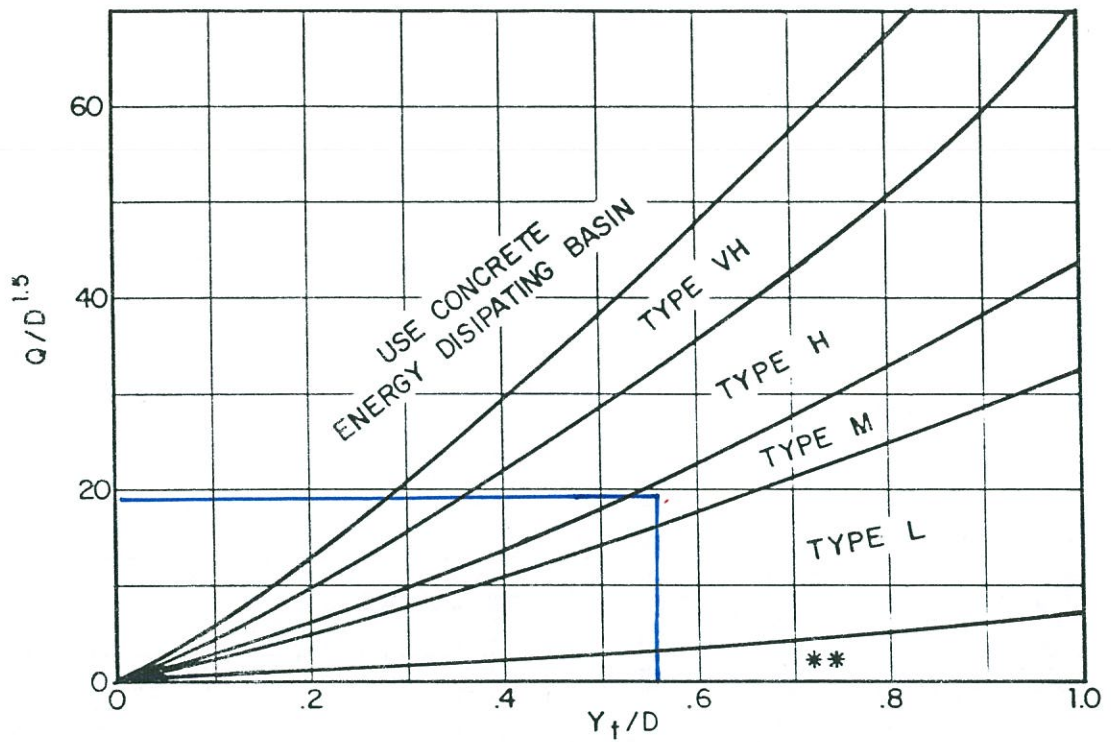

Use D_a instead of D whenever flow is supercritical in the barrel.
 ** Use Type L for a distance of $3D$ downstream.

FOR POND 2 OUTLET PIPE


FIGURE 5-7. RIPRAP EROSION PROTECTION AT CIRCULAR CONDUIT OUTLET.

PROJECT: Judge On. Rd. In Paso
 Culvert At DP 1

STATION: _____ OF _____ SHEET _____

CULVERT DESIGN FORM
 DESIGNER/DATE: ASB / 5/21/18
 REVIEWER/DATE: _____ / _____

Provide the analysis for overtopping on a Major Storm. Must meet the criteria per Table 6-1 & Table 6-4: Where cross pans are allowed, the depth of flow shall not exceed 12 inches at the flowline.

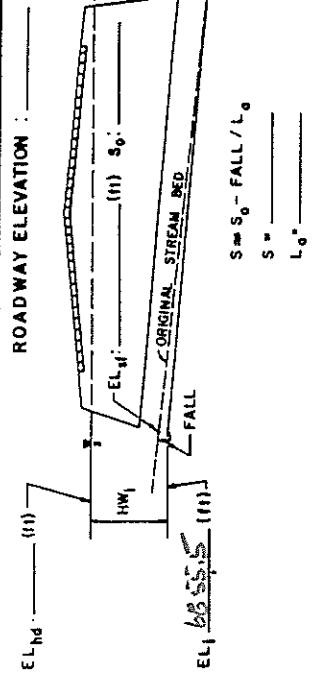

Update. Drainage map notes 57.3 cfs

HYDROLOGICAL DATA
 METHOD: RATIONAL
 DRAINAGE AREA: 4.22 STREAM SLOPE: _____
 CHANNEL SHAPE: Trapezoidal
 ROUTING: OTHER:
 DESIGN FLOWS/TAIWATER
 R.L. (YEARS) FLOW (cfs) TW (ft)
100 54.3 _____

CULVERT DESCRIPTION: MATERIAL - SHAPE - SIZE - ENTRANCE	TOTAL FLOW PER BARREL Q (cfs)	INLET CONTROL		HEADWATER CALCULATIONS				OUTLET CONTROL		CONTROL HEADWATER ELEVATION	OUTLET VELOCITY
		HW ₁ (ft)	HW ₁ /D (2)	W (ft)	d _c	d _c +D/2 (ft)	h ₀ (ft)	H (ft)	EL _{hd} (ft)		
HDPE 30" W/PES	54.3	2.5	2.5	6.25						61.75	

Per DCM Table 6-5, Hw/D must be less than 1.5

TECHNICAL FOOTNOTES:
 (1) USE Q/NB FOR BOX CULVERTS
 (2) HW₁/D OR HW₁/D FROM DESIGN CHARTS
 (3) FALL = HW₁ - (EL_{hd} - EL₁); FALL IS ZERO FOR CULVERTS ON GRADE
 (4) EL_{hd} HW₁ EL₁ INVERT OF INLET CONTROL SECTION
 (5) TW BASED ON DOWNSTREAM CONTROL OR FLOW DEPTH IN CHANNEL.
 (6) h₀ = TW or (d_c + D/2) (WHICHEVER IS GREATER)
 (7) H = [1 + h₀ (29m² L) / R₁₃₃] v² / 2g
 (8) EL_{hd} = EL₀ + H + h₀

COMMENTS / DISCUSSION:
 SUBSCRIPT DEFINITIONS:
 1. APPROXIMATE
 2. CULVERT FACE
 3. DESIGNED FOR WATER
 4. HEADWATER IN INLET CONTROL
 5. HEADWATER IN OUTLET CONTROL
 6. INLET CONTROL SECTION
 7. OUTLET CONTROL SECTION
 8. STREAMBED AT CULVERT FACE
 9. TAILWATER

CULVERT BARREL SELECTED:
 SIZE: _____
 SHAPE: _____
 MATERIAL: _____
 ENTRANCE: _____

Date: **OCT. 1987**
 Figure: 9-44

The City of Colorado Springs / El Paso County
 Drainage Criteria Manual



REFERENCE: Federal Highway Administration, Hydraulic Design of


Hydraulic Design Series No. 5 1985

Unresolved - dsdlaforce
 12/04/2018 2:34:11 PM

PROJECT: JUDGES CREEK RD PAVEMENT
WEST CULVERT

STATION: _____ OF _____
 SHEET _____ OF _____

CULVERT DESIGN FORM
 DESIGNER/DATE: MAE / 5/21/88
 REVIEWER/DATE: _____ / _____

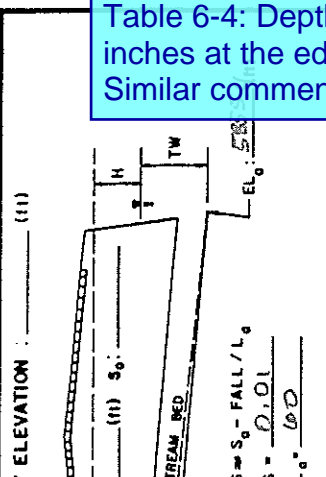

ROADWAY ELEVATION: (11)
 $S = S_0 - \text{FALL} / L_0$
 $S = 0.01$
 $L_0 = 60$

HYDROLOGICAL DATA
 METHOD: RATIONAL
 DRAINAGE AREA: 31.39 □ STREAM SLOPE: 1.8%
 CHANNEL SHAPE: TRAP.
 ROUTING: _____ □ OTHER: _____
 SEE ADD'L SHEETS

DESIGN FLOWS/TAILWATER
 R.I. (YEARS) 5 FLOW (cfs) 16.3 TW (ft) 0.9

Provide the analysis for overtopping on a Major Storm (per drainage map Q=62.4 cfs). Must meet the criteria per Table 6-1 & Table 6-4: Depth of flow shall not exceed 6 inches at the edge of the road shoulder. Similar comment for the east culvert.

CULVERT DESCRIPTION: MATERIAL - SHAPE - SIZE - ENTRANCE	TOTAL FLOW PER BARREL Q (cfs)	INLET CONTROL		OUTLET CONTROL				CONTROL HEADWATER ELEVATION	OUTLET VELOCITY	COM	
		HW/D (2)	ELhd (4)	TW (5)	dc (6)	h0 (8)	H (7)				ELhd (8)
RECP - 36" x 24" / FES	16.3	0.81	56.0	0.9	1.36	1.68	0.2	0.4	57.68	57.68	6.0

existing contour shows a flatter slope.

Drainage map notes 18.5 cfs @ DP5

TECHNICAL FOOTNOTES:
 (1) USE Q/NB FOR BOX CULVERTS
 (2) HW₁/D = HW/D OR HW₁/D FROM DESIGN CURVE
 (3) FALL = HW₁ - (EL_{hd} - EL_{st}); FALL IS ZERO FOR CULVERTS ON GRADE

INLET CONTROL (INVERT OF INLET CONTROL SECTION)
 $h_0 = TW \text{ or } (d_c + D/2) \text{ WHICH EVER IS GREATER}$
 $H = [1 + h_0^3 (29n^2 L) / R^{1.33}]^{1/3} v^2 / 2g$
 $EL_{hd} = EL_0 + H + h_0$

EVENTS / DISCUSSION:


CULVERT BARREL SELECTED:
 SIZE: _____
 SHAPE: _____
 MATERIAL: _____
 ENTRANCE: _____



PROJECT: JUDEE ONE RD BY CANY
EAST CULVERT

STATION: _____ OF _____
 SHEET _____ OF _____

CULVERT DESIGN FORM
 DESIGNER/DATE: AB / 5/2/87
 REVIEWER/DATE: _____ / _____

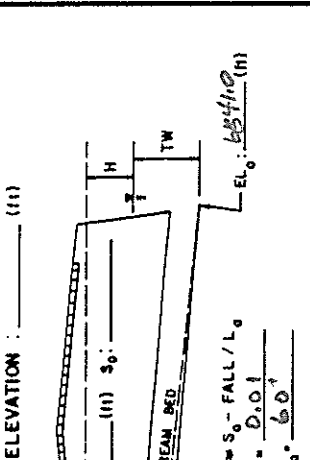

HYDROLOGICAL DATA
 METHOD: NATIONAL
 DRAINAGE AREA: 33.89 □ STREAM SLOPE: 1.8%
 CHANNEL SHAPE: TWO
 ROUTING: _____ □ OTHER: _____
 DESIGN FLOWS/TAILWATER
 R.L. (YEARS) FLOW (cfs) TW (ft)
5 16.3 0.9

CULVERT DESCRIPTION:
 MATERIAL - SHAPE - SIZE - ENTRANCE
RC-CP - 35" X 24" W/F/S

HEADWATER CALCULATIONS										COMMENTS
TOTAL FLOW PER CHANNEL (cfs) (1)	HW ₁ /D (2)	HW ₁ (3)	TW (4)	d _c (5)	d _c /D (6)	h ₀ (7)	H (8)	EL _{hd} (9)	OUTLET VELOCITY (10)	
16.3	0.51	16.2	0.9	1.36	1.68	1.00	0.14	73.08	6.0	

TECHNICAL FOOTNOTES:
 (1) USE Q/NB FOR BOX CULVERTS
 (2) HW₁/D = HW / D OR HW₁/D FROM DESIGN CHARTS
 (3) FALL = HW₁ - (EL_{hd} - EL_{st}); FALL IS ZERO FOR CULVERTS ON GRADE
 (4) EL_{hd} = HW₁ + EL₁ (INLET CONTROL)
 (5) TW BASED ON DOWNSTREAM CONTROL OR FLOW IN CHANNEL
 (6) h₀ = TW OR (d_c + D/2) WHICH EVER IS GREATER
 (7) H = [1 + h₀ + (29n² L) / R^{1.33}] V² / 2g
 (8) EL_{hd} = EL₀ + H + h₀

SUBSCRIPT DEFINITIONS:
 0 - APPROXIMATE
 1 - CULVERT FACE
 2 - DESIGN HEADWATER
 3 - HEADWATER IN INLET CONTROL
 4 - HEADWATER IN OUTLET CONTROL
 5 - INLET CONTROL SECTION
 6 - OUTLET
 7 - STREAMBED AT CULVERT FACE
 8 - TAILWATER

This velocity is at the upper limit for permissible velocity. Place erosion protection at the outlet.

Existing contours indicate less than 1.8%

18.3 per drainage map

REFERENCE: Federal Highway Administration, Hydraulic Design of Highway Culverts; Hydraulic Design Series No. 5 1985

Date **OCT. 1987**
 Figure **9-44**

The City of Colorado Springs / El Paso County
 Drainage Criteria Manual



HDR Infrastructure, Inc.
 A Centerra Company

APPENDIX C

DETENTION POND

GEOTECHNICAL RECOMMENDATIONS

July 25, 2018



ENTECH
ENGINEERING, INC.

505 ELKTON DRIVE
COLORADO SPRINGS, CO 80907
PHONE (719) 531-5599
FAX (719) 531-5238

William Guman & Associates, Ltd.
731 North Weber Street, Suite 10
Colorado Springs, Colorado 80903

Attn: Bill Guman

Re: Detention Pond
Judge Orr RV Park and Storage
PCD File No. PPR-18-040
El Paso County, Colorado

Dear Mr. Guman:

The detention pond referenced above will be constructed within the Judge Orr RV Park and Storage property at the southeastern corner of the proposed facility, north of the intersection of Judge Orr Road and Cessna Drive. Two soil investigations have been conducted on the property in the vicinity of the detention pond; a Soil, Geology, Geologic Hazard, and Wastewater Study dated December 12, 2016, revised July 25, 2018, Job No. 160533 and a Tactile Test Pit Observation & Septic Design Letter dated August 16, 2017, Job No. 160533. The findings and development recommendations are reported under separate covers. This letter should be used in conjunction with our Soil, Geology, Geologic Hazard, and Wastewater Study and Tactile Test Pit Observation & Septic Design Letter. This document provides recommendations for constructing a detention pond based on our investigations, laboratory testing, and requirements specified in the El Paso County Engineering Criteria Manual and the El Paso County Drainage Criteria Manual.

The soils in the vicinity of the pond were recovered from test pits and a profile hole prepared nearby. The location of the test boring/pits and the test boring/pit logs are included in the Soil, Geology, Geologic Hazard, and Wastewater Study and Tactile Test Pit Observation & Septic Design Letter. The soils recovered north of the pond were described as fine to coarse grained clayey sand loam, fine to coarse grained sand loam, and sandy clay loam to depths of 8 to 10 feet. The soils south and west of the pond were described as fine to coarse grained clayey sand loam, fine to coarse grained sand loam, and sandy clay loam to depths of 5.5 to 6 feet with underlying sandy claystone. A test boring drilled west of the pond to a depth of 20-feet encountered clayey sand to a 9-foot depth overlying very clayey sandstone. Groundwater was not encountered in the test pits and encountered at a depth of 17-feet in the test boring.

Grading Plans were not finalized, however discussions pertaining to the pond indicate that the pond embankments will be less than 10-feet with significant cuts likely. Based on the existing site topography, cuts of 6 to 9 feet are likely exposing the underlying sandstone and claystone on the western and southern portions of the pond. Laboratory testing on a sample of sandstone obtained from the test boring determined the soil to contain between approximately 9 and 98 percent of the materials passing a No. 200 sieve (SC and CL) and the bedrock to contain 46.3 percent on one sample.

William Guman and Associates, Ltd.
Judge Orr RV Park and Storage
PCD File No. PPR-18-040
El Paso County, Colorado
Page 2

The detention pond design parameters and geometry shall conform to the requirements specified in the El Paso County Engineering Criteria Manual and the El Paso County Drainage Criteria Manual. Sandstone/Claystone will likely be exposed in the southern portion of the supporting the pond embankment based on the soil investigations referenced herein. The undisturbed sandstone/claystone will provide a soil bearing capacity of 3,500 psf, and soil mitigation will likely not be required. The embankment foundation shall be fully exposed and observed by personnel of Entech to determine mitigation requirements, if any, prior to constructing the embankment. Overexcavation of expansive material may be required for the outlet works which should be field determined. Groundwater is not expected at the proposed excavated depth depending on the time of year the pond is constructed. Seasonally perched groundwater is known to exist in the area and dewatering in conjunction with soil stabilization will likely be required if groundwater is encountered during construction.

The embankment soils shall be compacted to a minimum of 95 percent of the soils maximum dry density as determined by ASTM D-1557 at ± 2 percent of the soils optimum moisture content. Periodic observation and density testing will be performed during construction. Based on the suggested compaction efforts for the embankment soils and the expected foundation soils, it is likely that embankment settlement will be less than 3 percent of the embankment height.

We trust this letter has provided you with the information required to construct the proposed detention pond. If you have any questions or need additional information, please do not hesitate to contact us.

Respectfully Submitted,

ENTECH ENGINEERING, INC.


Stan C. Culp, P.E.
Senior Engineer

SCC/sc
Entech Job No. 181205
F:\AA projects\2018\181205\180205 dp



Reviewed By:


Joseph C. Goede, Jr., P.E.
President

APPENDIX D

DESIGN CHARTS

Table 6-6. Runoff Coefficients for Rational Method
(Source: UDFCD 2001)

Land Use or Surface Characteristics	Percent Impervious	Runoff Coefficients											
		2-year		5-year		10-year		25-year		50-year		100-year	
		HSG A&B	HSG C&D	HSG A&B	HSG C&D	HSG A&B	HSG C&D	HSG A&B	HSG C&D	HSG A&B	HSG C&D	HSG A&B	HSG C&D
Business													
Commercial Areas	95	0.79	0.80	0.81	0.82	0.83	0.84	0.85	0.87	0.87	0.88	0.88	0.89
Neighborhood Areas	70	0.45	0.49	0.49	0.53	0.53	0.57	0.58	0.62	0.60	0.65	0.62	0.66
Residential													
1/8 Acre or less	65	0.41	0.45	0.45	0.49	0.49	0.54	0.54	0.59	0.57	0.62	0.59	0.65
1/4 Acre	40	0.23	0.28	0.30	0.35	0.36	0.42	0.42	0.50	0.46	0.54	0.50	0.58
1/3 Acre	30	0.18	0.22	0.25	0.30	0.32	0.38	0.39	0.47	0.43	0.52	0.47	0.57
1/2 Acre	25	0.15	0.20	0.22	0.28	0.30	0.36	0.37	0.46	0.41	0.51	0.46	0.56
1 Acre	20	0.12	0.17	0.20	0.26	0.27	0.34	0.35	0.44	0.40	0.50	0.44	0.55
Industrial													
Light Areas	80	0.57	0.60	0.59	0.63	0.63	0.66	0.66	0.70	0.68	0.72	0.70	0.74
Heavy Areas	90	0.71	0.73	0.73	0.75	0.75	0.77	0.78	0.80	0.80	0.82	0.81	0.83
Parks and Cemeteries													
Parks and Cemeteries	7	0.05	0.09	0.12	0.19	0.20	0.29	0.30	0.40	0.34	0.46	0.39	0.52
Playgrounds													
Playgrounds	13	0.07	0.13	0.16	0.23	0.24	0.31	0.32	0.42	0.37	0.48	0.41	0.54
Railroad Yard Areas													
Railroad Yard Areas	40	0.23	0.28	0.30	0.35	0.36	0.42	0.42	0.50	0.46	0.54	0.50	0.58
Undeveloped Areas													
Historic Flow Analysis-- Greenbelts, Agriculture	2	0.03	0.05	0.09	0.16	0.17	0.26	0.26	0.38	0.31	0.45	0.36	0.51
Pasture/Meadow	0	0.02	0.04	0.08	0.15	0.15	0.25	0.25	0.37	0.30	0.44	0.35	0.50
Forest	0	0.02	0.04	0.08	0.15	0.15	0.25	0.25	0.37	0.30	0.44	0.35	0.50
Exposed Rock	100	0.89	0.89	0.90	0.90	0.92	0.92	0.94	0.94	0.95	0.95	0.96	0.96
Offsite Flow Analysis (when landuse is undefined)	45	0.26	0.31	0.32	0.37	0.38	0.44	0.44	0.51	0.48	0.55	0.51	0.59
Streets													
Paved	100	0.89	0.89	0.90	0.90	0.92	0.92	0.94	0.94	0.95	0.95	0.96	0.96
Gravel	80	0.57	0.60	0.59	0.63	0.63	0.66	0.66	0.70	0.68	0.72	0.70	0.74
Drive and Walks													
Drive and Walks	100	0.89	0.89	0.90	0.90	0.92	0.92	0.94	0.94	0.95	0.95	0.96	0.96
Roofs													
Roofs	90	0.71	0.73	0.73	0.75	0.75	0.77	0.78	0.80	0.80	0.82	0.81	0.83
Lawns													
Lawns	0	0.02	0.04	0.08	0.15	0.15	0.25	0.25	0.37	0.30	0.44	0.35	0.50

Figure 6-25. Estimate of Average Concentrated Shallow Flow


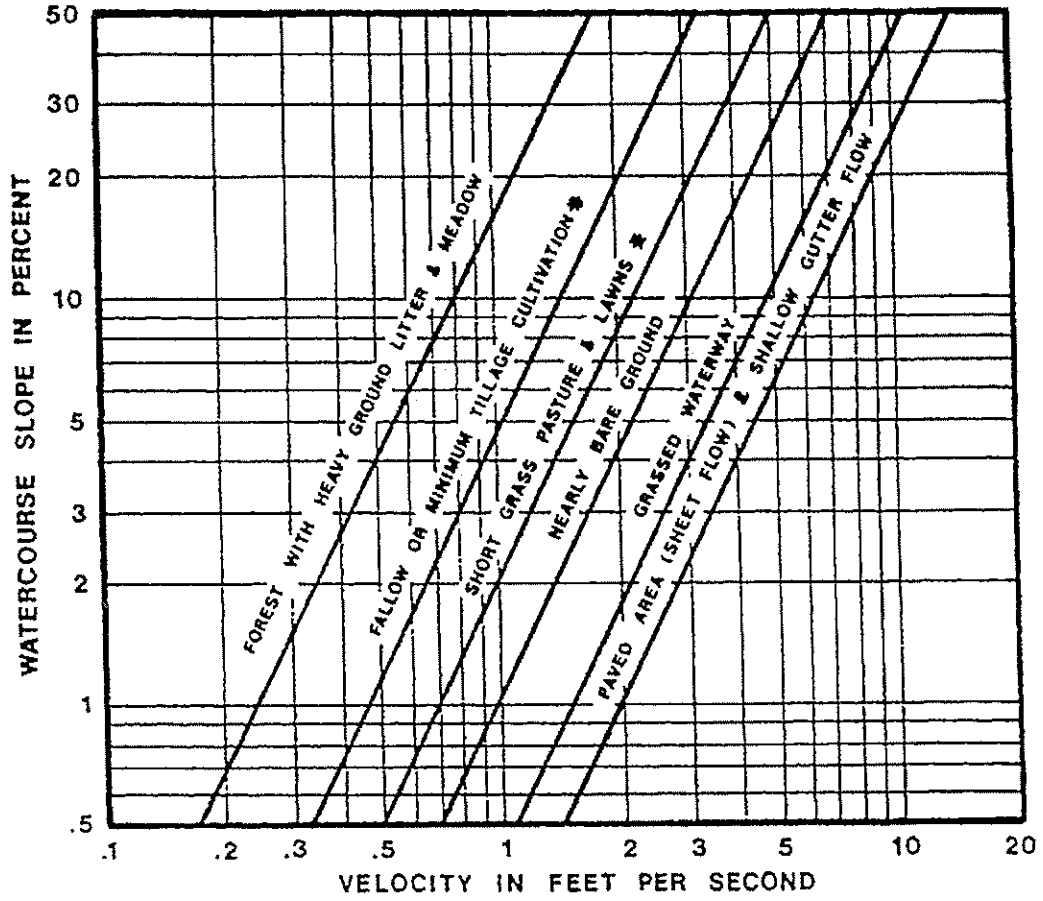


Figure 6-5. Colorado Springs Rainfall Intensity Duration Frequency

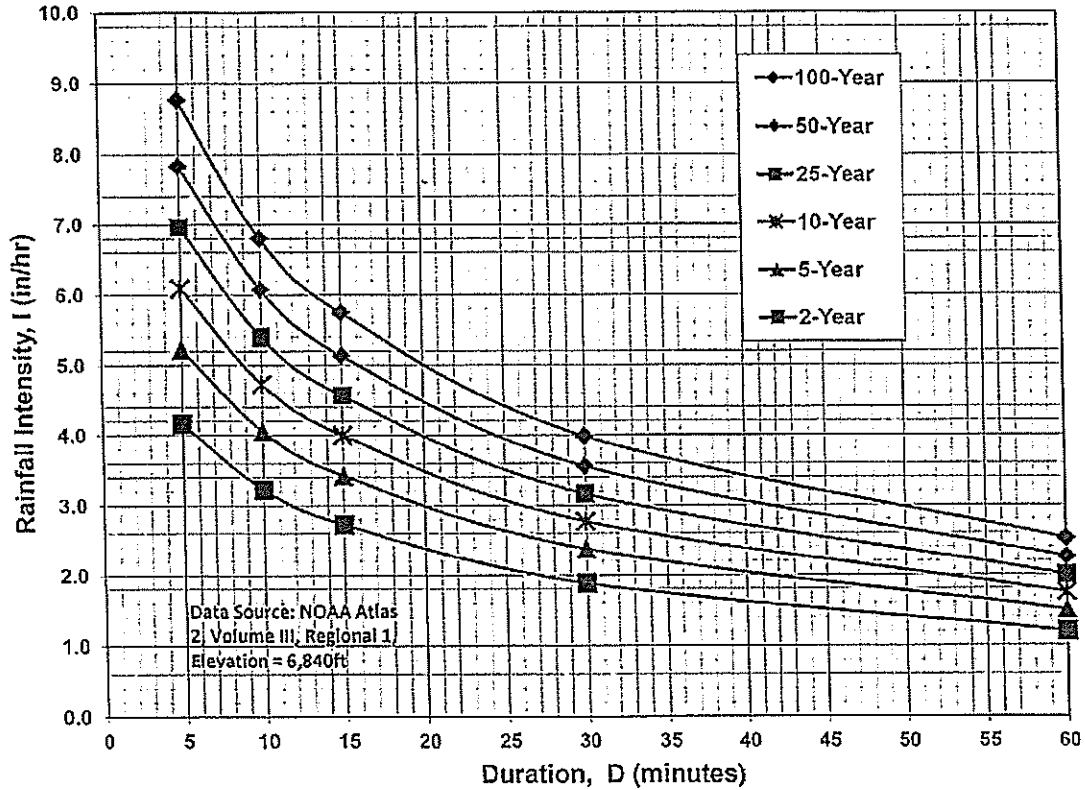

IDF Equations

$$I_{100} = -2.52 \ln(D) + 12.735$$

$$I_{50} = -2.25 \ln(D) + 11.375$$


$$I_{25} = -2.00 \ln(D) + 10.111$$

$$I_{10} = -1.75 \ln(D) + 8.847$$

$$I_5 = -1.50 \ln(D) + 7.583$$

$$I_2 = -1.19 \ln(D) + 6.035$$

Note: Values calculated by equations may not precisely duplicate values read from figure.

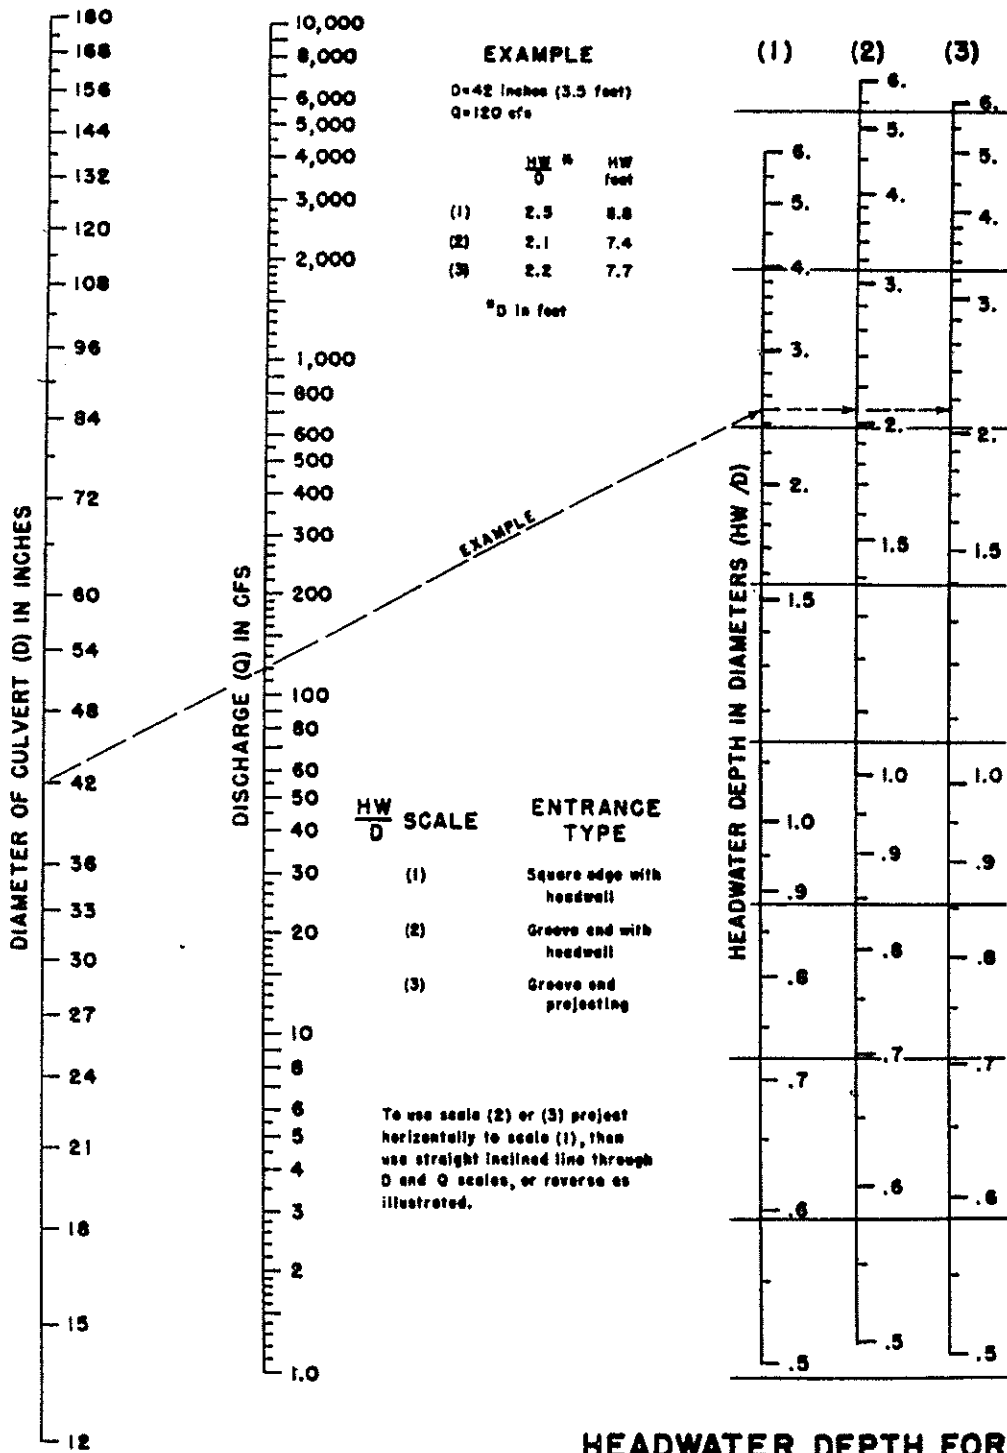

**HEADWATER DEPTH FOR
 CONCRETE PIPE CULVERTS
 WITH INLET CONTROL**

HEADWATER SCALES 283
 REVISED MAY 1964

BUREAU OF PUBLIC ROADS JAN. 1963



HDR Infrastructure, Inc.
 A Centerra Company

The City of Colorado Springs / El Paso County
 Drainage Criteria Manual


9-62

Date

OCT. 1987

Figure

9-34

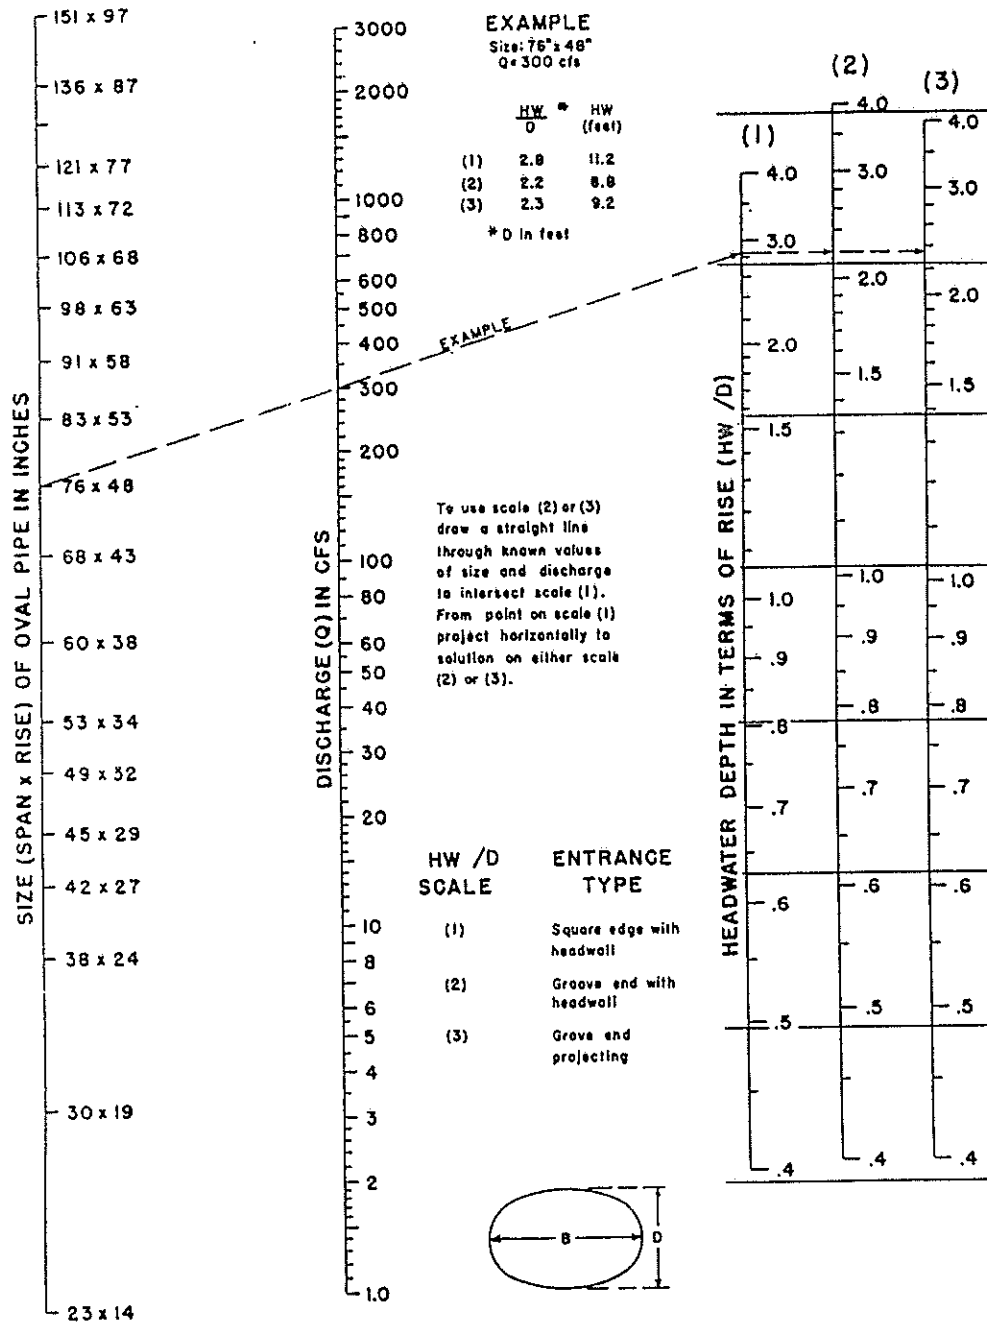

**HEADWATER DEPTH FOR
 OVAL CONCRETE PIPE CULVERTS
 LONG AXIS HORIZONTAL
 WITH INLET CONTROL**

BUREAU OF PUBLIC ROADS JAN. 1963

The City of Colorado Springs / El Paso County
 Drainage Criteria Manual

Date
 9-30-90



Figure
 9-36

M:\LAND PROJECTS\2016\160301-Judge Orr Road RV Park\DWG\160301-Existing Conditions.dwg Mike Wed, 11/07/18 6:03 AM


LEGEND

- A1A BASIN DESIGNATION
- XX BASIN AREA, ACRES
- XX 5 YEAR STORM, CFS
- XX 100 YEAR STORM, CFS
- DESIGN POINT
- XX.X 5 YEAR ACCUMULATED FLOW, CFS
- XX.X 100 YEAR ACCUMULATED FLOW, CFS
- SUB-BASIN BOUNDARY
- DIRECTION OF DRAINAGE FLOW

TABLE 1 - EXISTING CONDITIONS		
Sub-Basin	Q5CFS	Q100 CFS
OS1	3.3	15.3
OS2	4	28
OS3	17.8	62
OS4	8.2	36.7
OS5	1.3	3.3
A1	2.2	16.5
A2	3.1	24
A3	1.1	5.3
B	0.2	1.6
DP1 (OS1 + OS2)	6.4	39
DP2 (DP1 + A2)	7.9	52.1
DP3 (OS3 + OS4)	24.8	94.8
DP4 (DP3+OS5 + A3)	23.3	89
DP5 (DP2 + DP4 + A1)	33.3	156.2

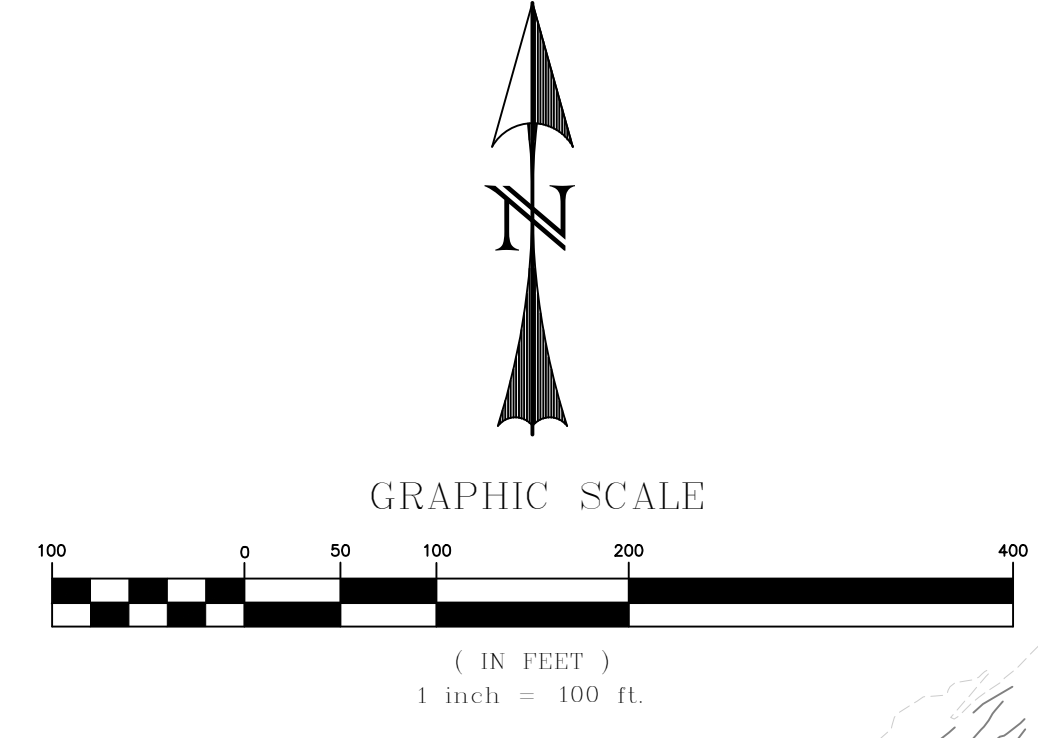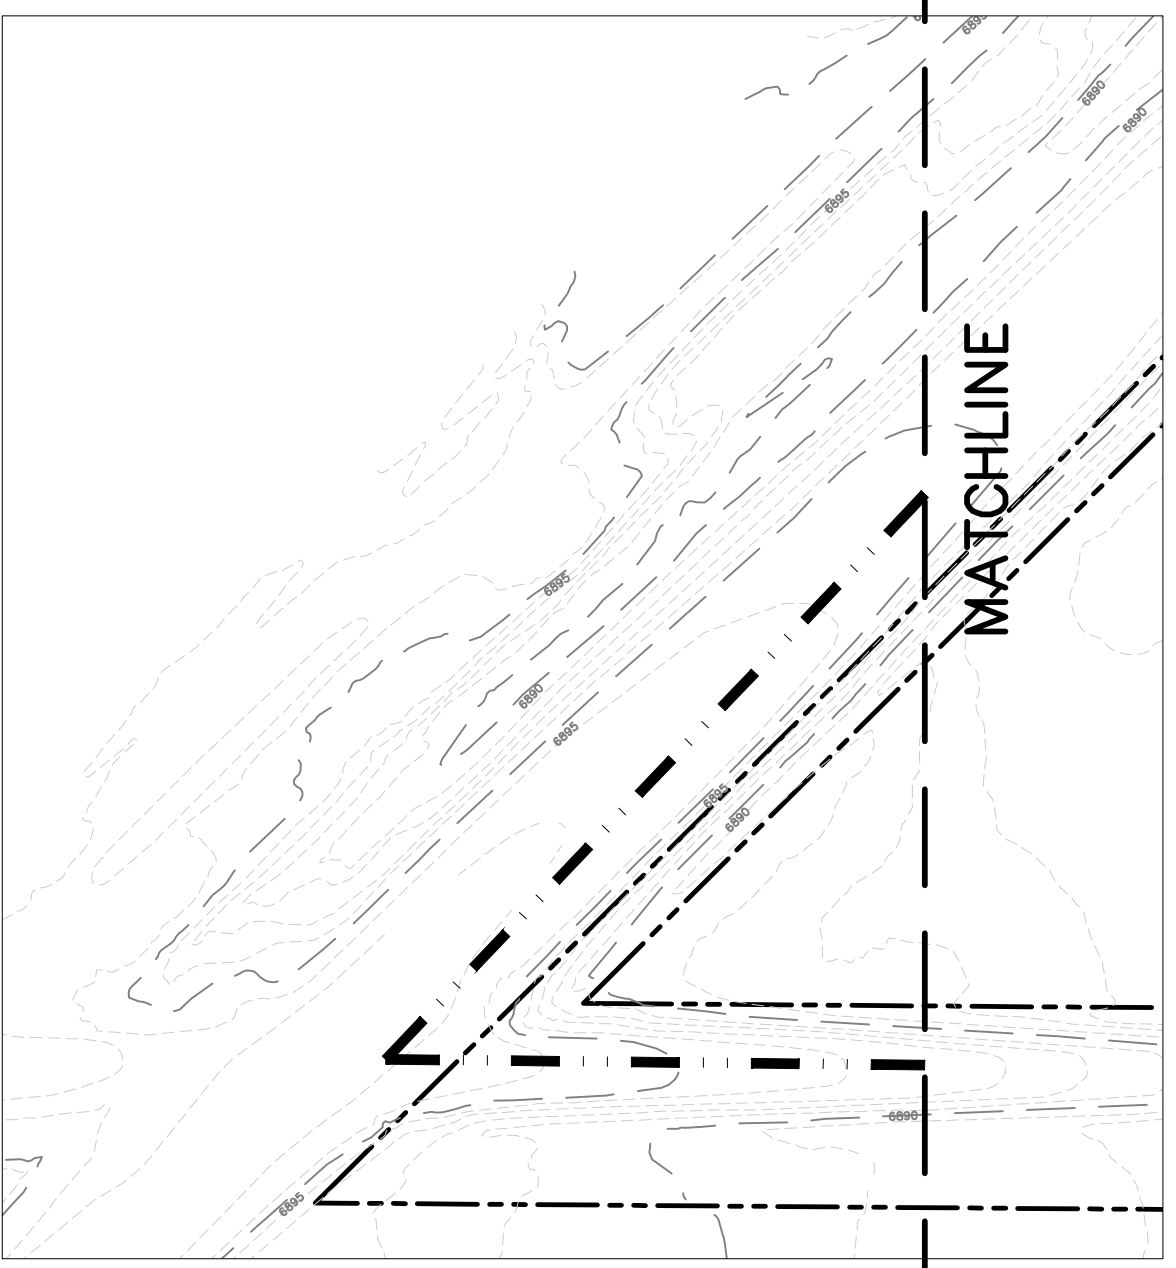

FOR CONTINUATION OF BASIN
SEE OFF-SITE MAP FOR O-1 IN
APPENDIX B

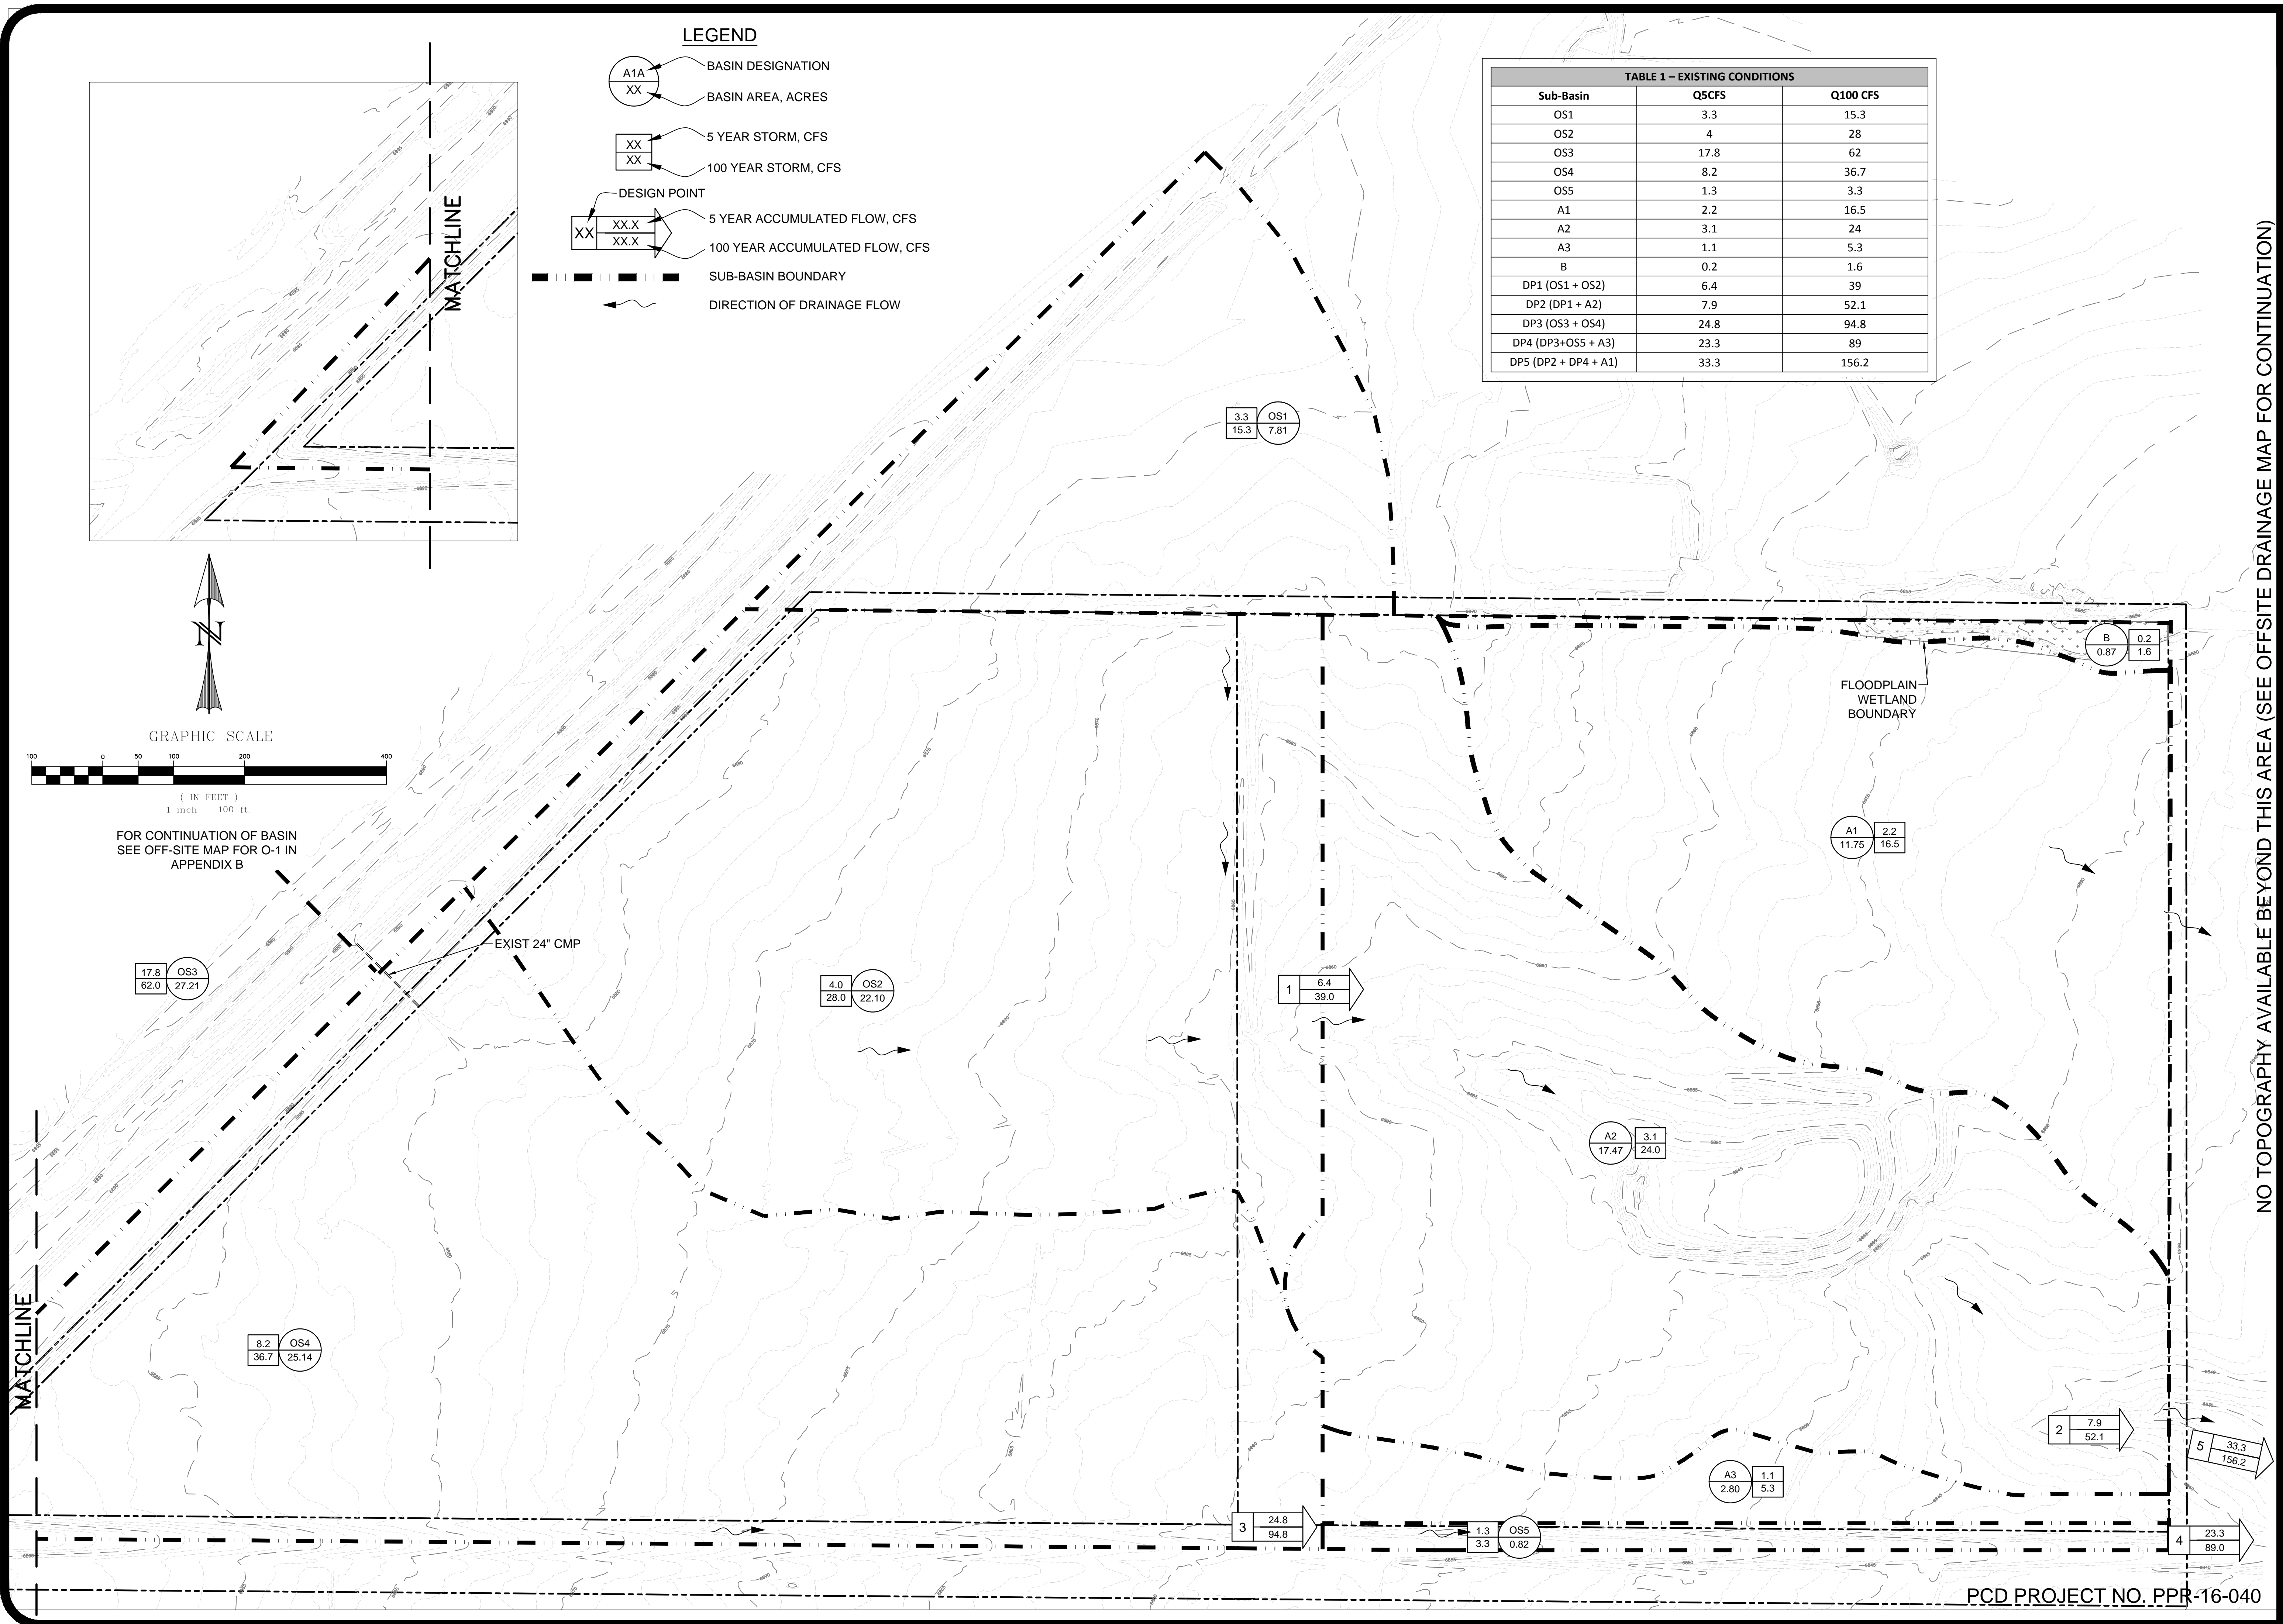

NO TOPOGRAPHY AVAILABLE BEYOND THIS AREA (SEE OFFSITE DRAINAGE MAP FOR CONTINUATION)

DESIGNED BY: MAB
PROJECT ENGINEER: MAB
JOB NO.: 160301
DATE: 9/20/18
PROJECT MANAGER: MAB
CAD FILE NO.: 160301-Existing Conditions.dwg
SCALE: 1" = 100'
DRAWN BY: HUG
VERT.:

PREPARED BY:
ADPCIVIL
ENGINEERING FOR THE FUTURE
3520 Austin Bluffs Parkway Suite 102
Colorado Springs, CO 80918
(719) 266-5212
fax: (719) 266-5341

NO.	DATE	REVISION

JUDGE ORR ROAD RV PARK & STORAGE
COLORADO SPRINGS, COLORADO
DRAINAGE - EXIST OVERALL CONDITIONS


SHEET
1 of 3

LEGEND

- BASIN DESIGNATION
- BASIN AREA, ACRES
- 5 YEAR STORM, CFS
- 100 YEAR STORM, CFS
- DESIGN POINT
- 5 YEAR ACCUMULATED FLOW, CFS
- 100 YEAR ACCUMULATED FLOW, CFS
- SUB-BASIN BOUNDARY
- DIRECTION OF DRAINAGE FLOW

TABLE 2 - DEVELOPED CONDITIONS

Sub-Basin	Q5CFS	Q100 CFS
OS1	3.3	15.3
OS2	7.2	54.9
OS3	17.8	62.0
OS4	3.7	10.1
OS5	1	2.6
A1	12.3	26
A2	0.8	1.5
A3	6.5	17.3
A4	13.8	35.3
A5	0.4	2.9
B	0.2	1.6
DP1 (OS1+OS2)	9.7	66.4
DPD1 (Detained DP1)	0.1	57.3
DP2 (DPD1 + A2)	7.7	55.8
DP3 (DP2 + A3)	12.5	67.5
DP4 (A1+A4+DP3)	31.4	110.1
DPD2 (Detained DP2)	0.7	33.7
DP5 (OS3+OS4)	18.5	62.4
DP6 (A3+OS5+DP5)	18.3	62.8
DP7 (DP6+DPD2)	19	94.5

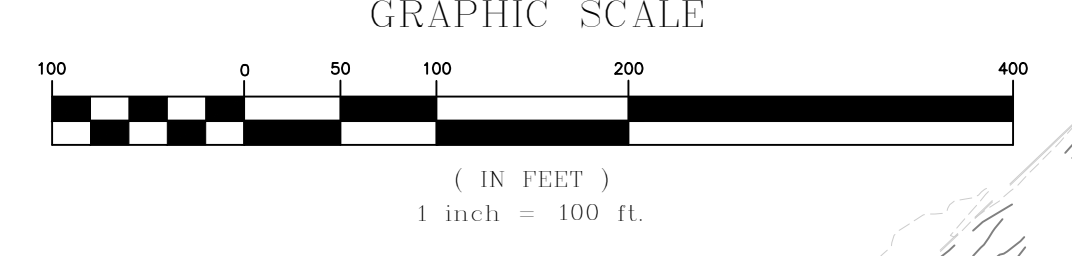

FOR CONTINUATION OF BASIN
SEE OFF-SITE MAP FOR O-1 IN
APPENDIX B

MATCHLINE

MATCHLINE

NO TOPOGRAPHY AVAILABLE BEYOND THIS AREA (SEE OFFSITE DRAINAGE MAP FOR CONTINUATION)

M:\LAND PROJECTS\2016\160301-Judge Orr Road RV Park\DWG\160301-Developed Conditions.dwg, Mike Wed., 11/07/18 6:00 AM

In the developed condition (pg 4) it noted off-site area remains the same. The design engineer noted on the 8/8/18 meeting that the intent was to pipe OS3 through basin OS2 and discharge to the Judge Orr ditch and not flow within the revised OS2 basin boundary shown on the proposed drainage map.

Update the narrative to discuss and provide analysis for the diversion. Is the ditch still hydraulically adequate with the reroute?

8/8/18 Unresolved
12/4/18 Unresolved

Provide analysis and narrative regarding emergency spillway when Pond 1 is constructed. Based on current design, it appears that the emergency spillway path will be diverted south and into the existing ditch along Judge Orr road. What impact will this have.

8/8/18 Unresolved
12/4/18 Unresolved

1. Extend the drainage map to show the location of DP7

8/8/2018 Unresolved
12/4/18 Unresolved

Analysis needs to extend to the swale. Looking at the contours the section highlighted in yellow does not appear to be hydraulically adequate and may need additional improvements.

8/8/18 Unresolved
12/4/18 Unresolved

JUDGE ORR ROAD RV PARK & STORAGE
COLORADO SPRINGS, COLORADO
DRAINAGE - DEV OVERALL CONDITIONS


NO.	DATE	REVISION	BY

DESIGNED BY: MAB
PROJECT ENGINEER: MAB
JOB NO.: 160301
DATE: 6/20/18


PROJECT MANAGER: HUG
CAD FILE NO.: 160301-Developed Conditions
JOB NO.: 160301
SCALE: 1" = 100'

PREPARED BY: **ADPCIVIL**
ENGINEERING FOR THE FUTURE


3520 Austin Bluffs Parkway Suite 102
Colorado Springs, CO 80918
(719) 266-5212
fax: (719) 266-5341

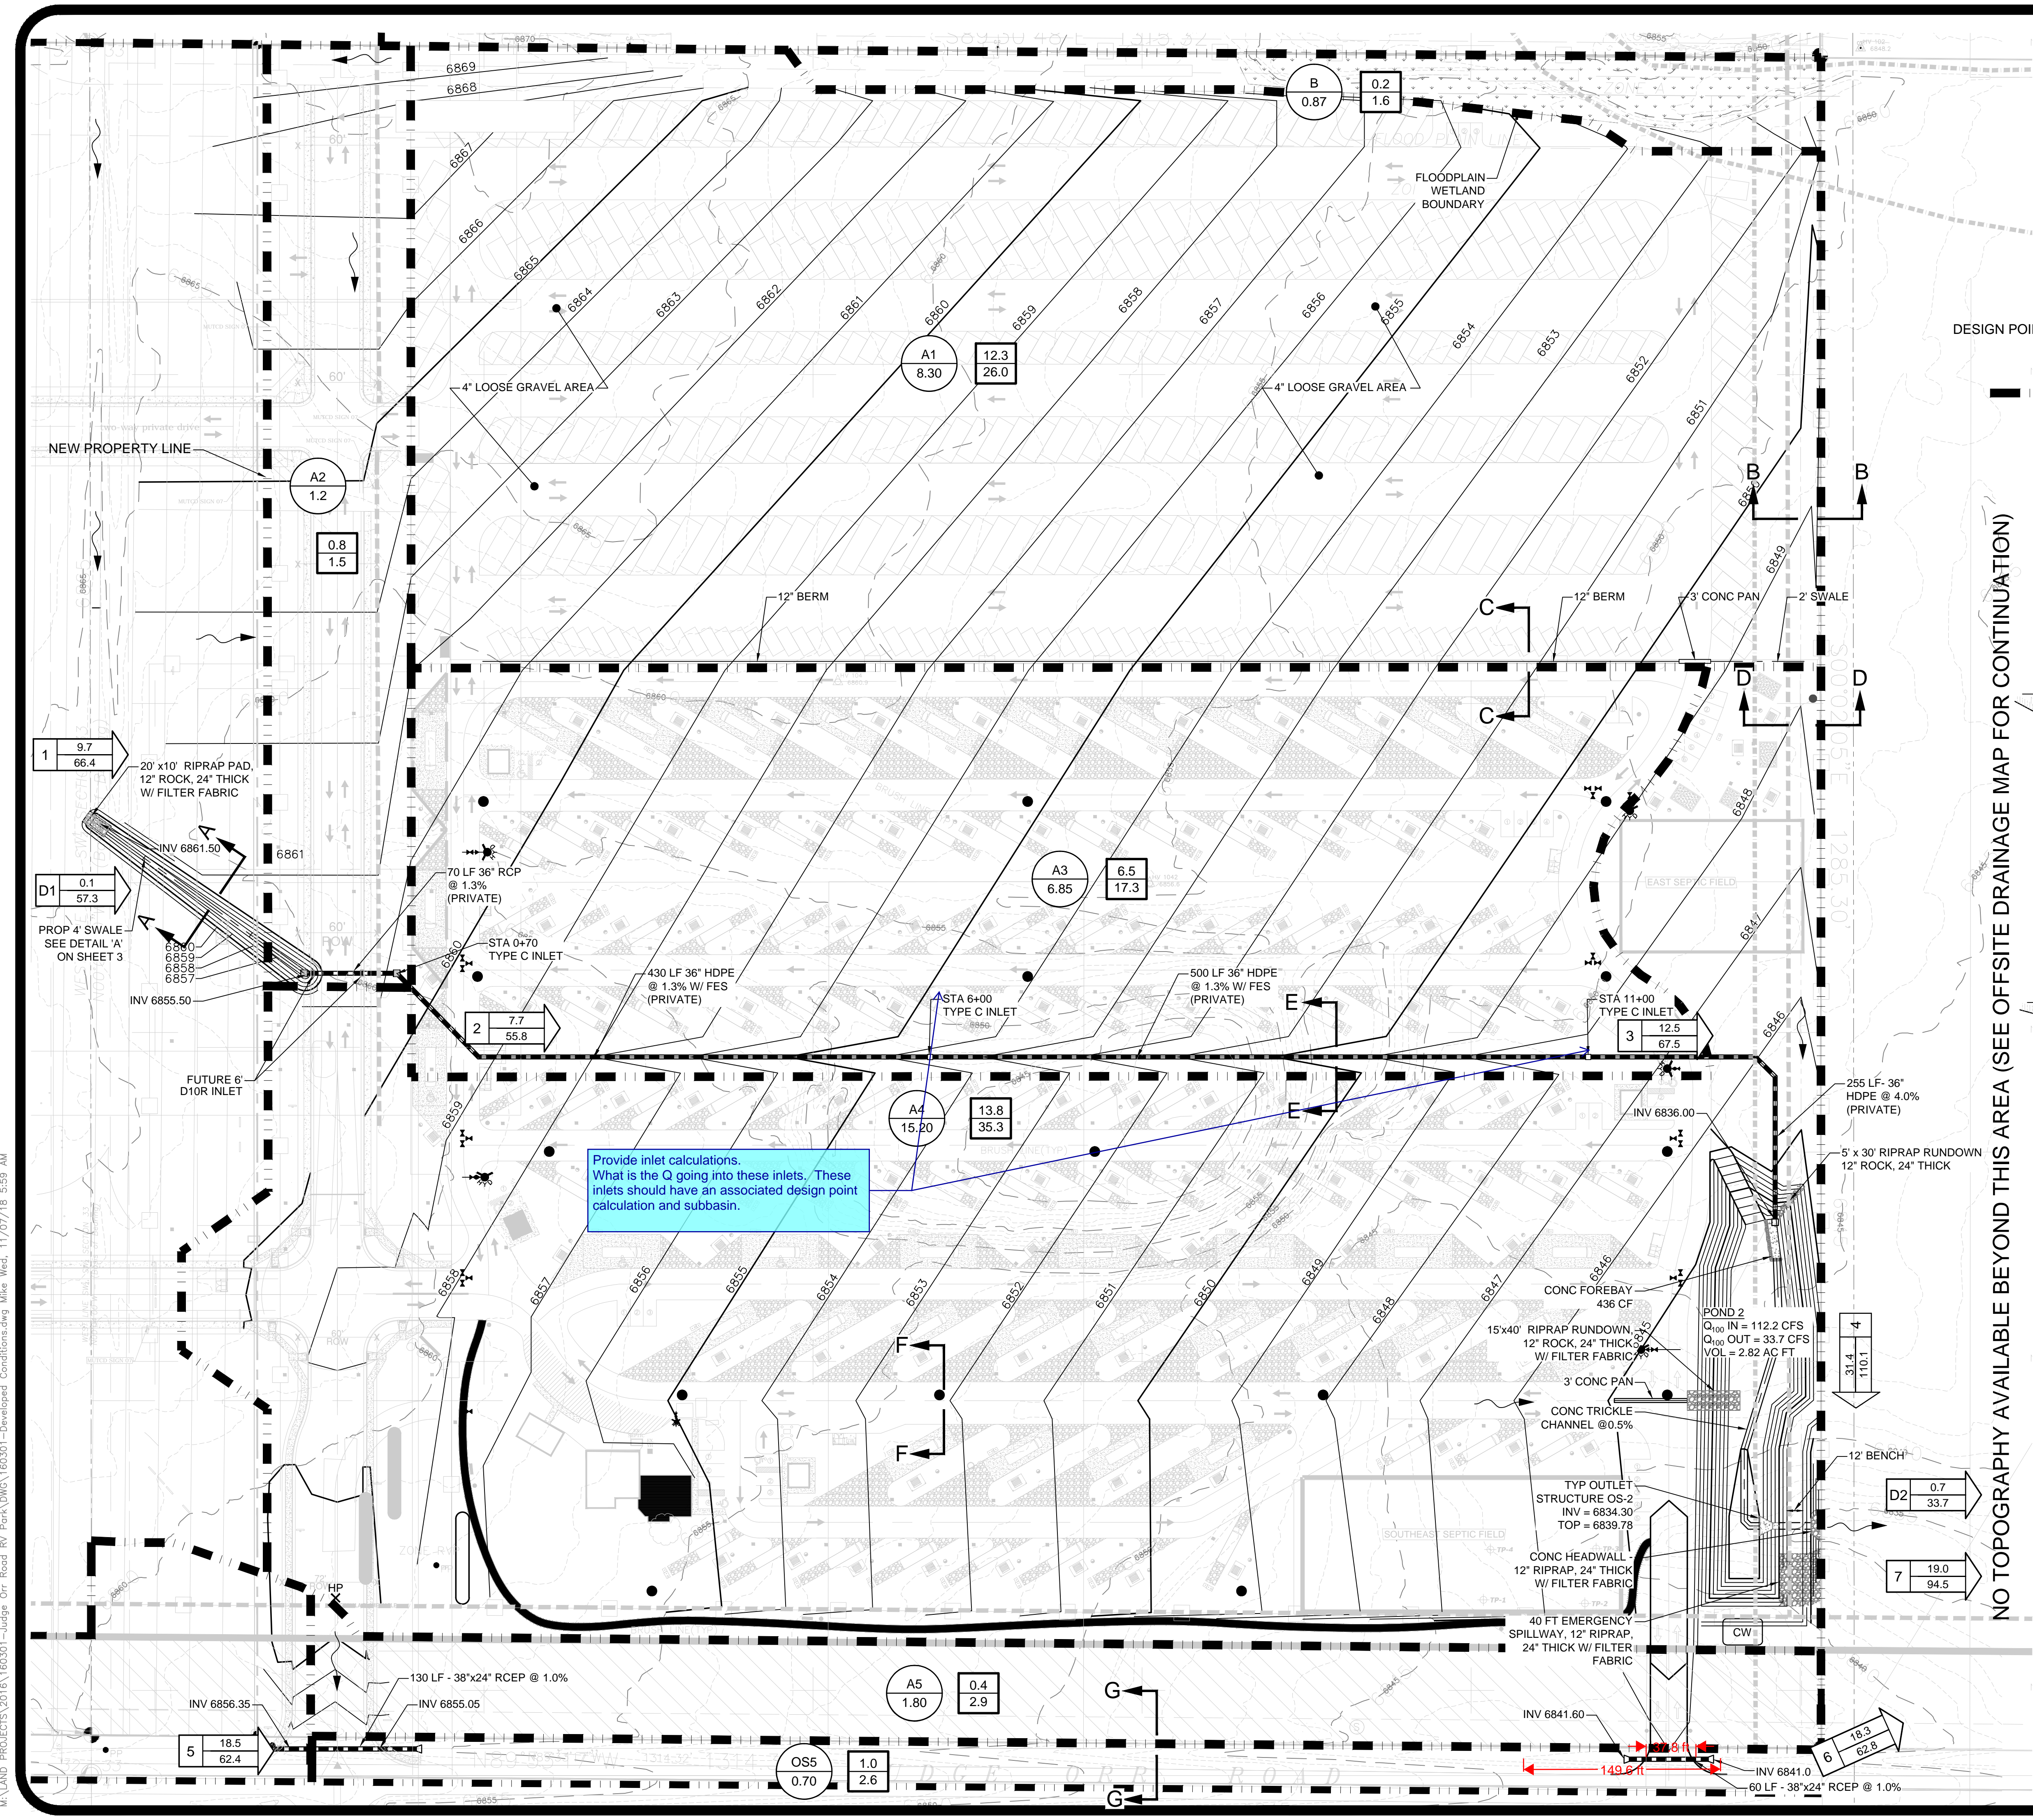


LEGEND

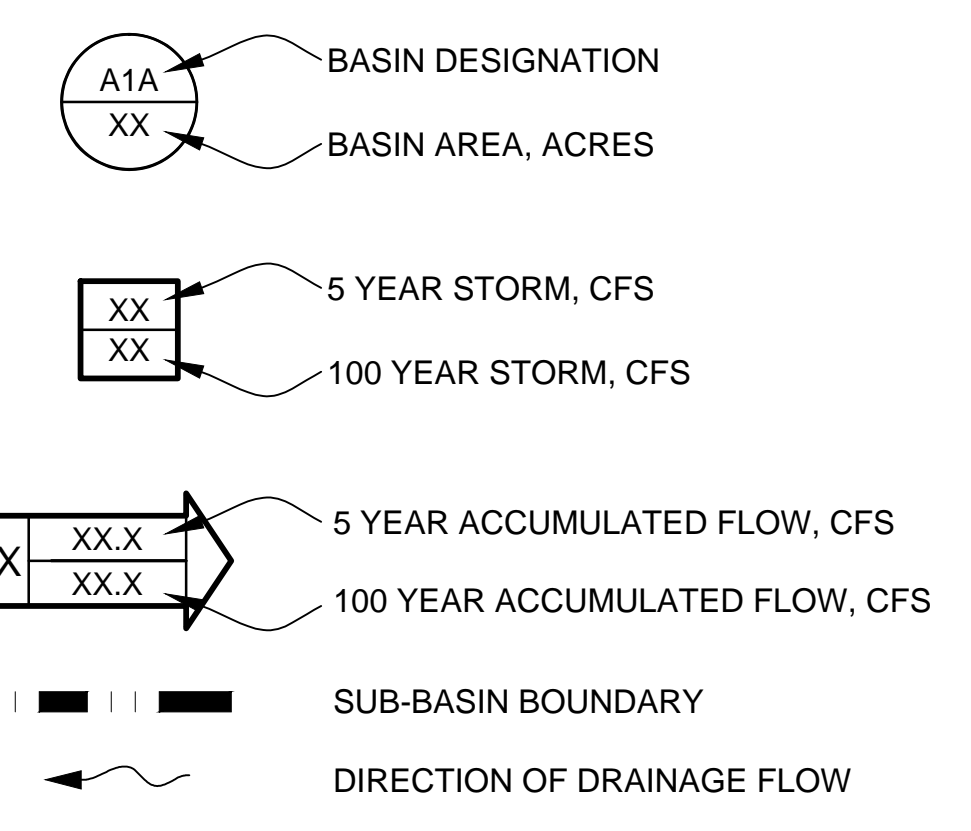

NO TOPOGRAPHY AVAILABLE BEYOND THIS AREA (SEE OFFSITE DRAINAGE MAP FOR CONTINUATION)

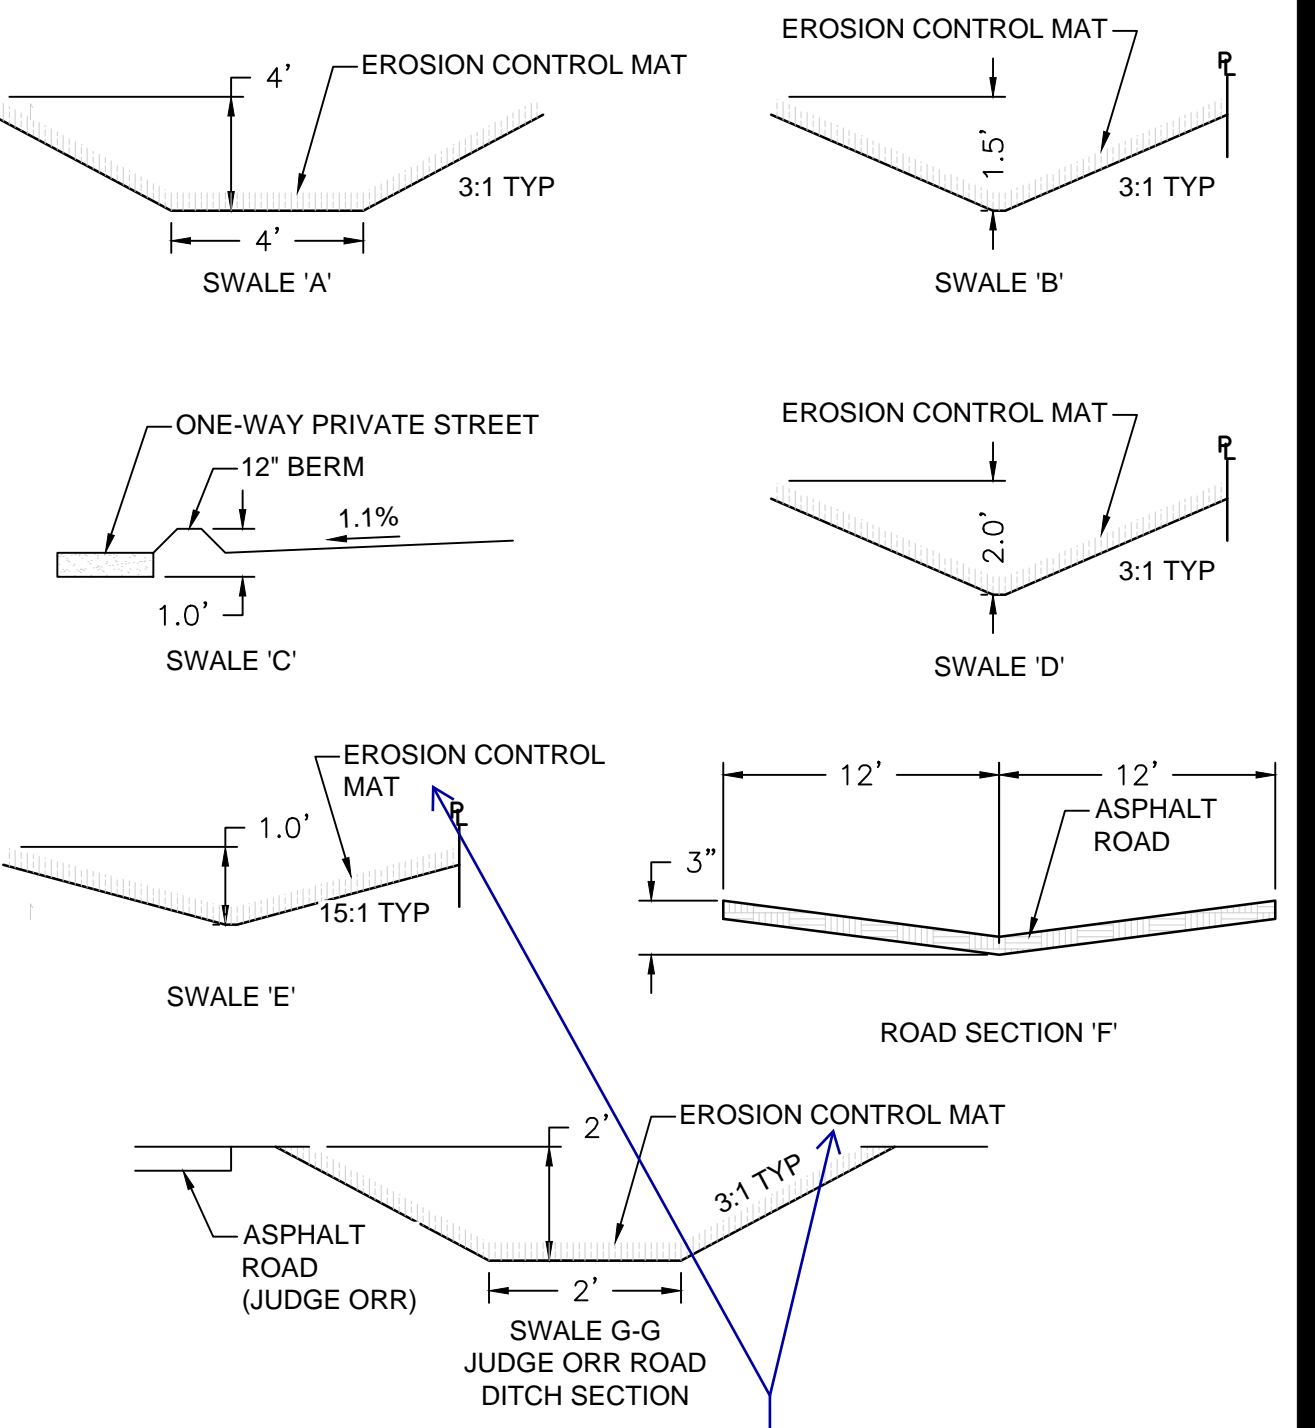

Callout the specific product to be used and in the appendix include the product specification that shows it is designed to handle the specific Froude number calculated.
Typ. all

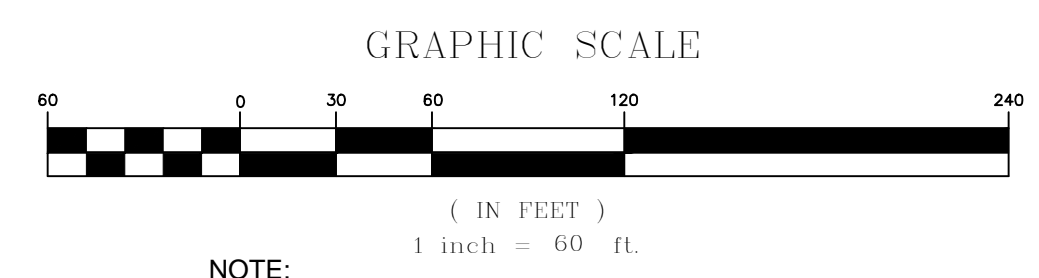

NOTE:
DETENTION POND AREA TO BE UTILIZED AS A SEDIMENTATION BASIN UNTIL EARTH MOVING IS COMPLETED AND THE GROUND STABILIZED AT WHICH TIME IT WILL BE CLEANED OUT AND THE DETENTION POND STRUCTURES ADDED.

PCD PROJECT NO. PPR-16-040

DESIGNED BY: MAB
PROJECT ENGINEER: MAB
PROJECT MANAGER: MAB
DATE: 9/20/16
JOB NO.: 160301
CAD FILE NO.: 160301-Dev Cond
SCALE: 1" = 60'
HORIZ.:
VERT.: N/A


PREPARED BY:
ADPCIVIL
ENGINEERING FOR THE FUTURE
3520 Austin Bluffs Parkway
Suite 102
Colorado Springs, CO 80918
(719) 266-5212
fax: (719) 266-5341

NO.	DATE	REVISION	BY

JUDGE ORR ROAD RV PARK & STORAGE
COLORADO SPRINGS, COLORADO
DRAINAGE - DEVELOPED CONDITIONS

Markup Summary

dsdlaforce (52)

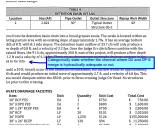

Subject: Callout
Page Label: 9
Author: dsdlaforce
Date: 12/4/2018 1:03:36 PM
Color: ■

Categorically state whether the channel where D2 and DP 6 merge is hydraulically adequate or not.




Subject: Callout
Page Label: 10
Author: dsdlaforce
Date: 12/4/2018 1:07:07 PM
Color: ■

Type the headers for each step. (See ECM Appendix I page I-21). The explanation for how step 3 & 4 were considered does not match the Counties criteria.

8/8/18
 Step 3: Provide Water Quality Capture Volume (WQCV)
 Step 4: Consider Need for Industrial and Commercial BMPs

12/4/18 Unresolved

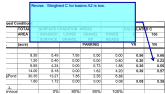

Subject: Callout
Page Label: 20
Author: dsdlaforce
Date: 12/4/2018 1:34:21 PM
Color: ■


Revise. Weighted C for basins A2 is low.

40	0.86
80	1.45
10	0.97
30	1.31
10	0.97

Subject: Highlight
Page Label: 22
Author: dsdlaforce
Date: 12/4/2018 1:40:59 PM
Color: ■


70	0.71
75	0.65
10	0.97
30	1.45
10	0.97

Subject: Highlight
Page Label: 22
Author: dsdlaforce
Date: 12/4/2018 1:40:59 PM
Color: ■

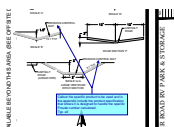


Subject: Callout
Page Label: 57
Author: dsdlaforce
Date: 12/4/2018 1:42:40 PM
Color: ■

Callout the specific product to be used and in the appendix include the product specification that shows it is designed to handle the specific Froude number calculated.
 Typ. all

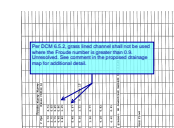

Subject: Callout
Page Label: 22
Author: dsdlaforce
Date: 12/4/2018 1:43:33 PM
Color: ■

Per DCM 6.5.2, grass lined channel shall not be used where the Froude number is greater than 0.9. Unresolved. See comment in the proposed drainage map for additional detail.

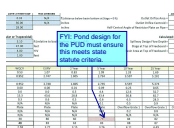

Subject: Callout
Page Label: 25
Author: dsdlaforce
Date: 12/4/2018 1:45:14 PM
Color: ■

FYI: Pond design for the PUD must ensure this meets state statute criteria.

Subject: Callout
Page Label: 8
Author: dsdlaforce
Date: 12/4/2018 12:51:12 PM
Color: ■

A5

Subject: Text Box
Page Label: 29
Author: dsdlaforce
Date: 12/4/2018 2:01:22 PM
Color: ■

EL 6835 @ 0.80
Area in GEC is approximately 1,800sf

Subject: Text Box
Page Label: 29
Author: dsdlaforce
Date: 12/4/2018 2:01:35 PM
Color: ■

EL 6836 @ 1.80
Area in GEC is approximately 9,410 sf

Subject: Text Box
Page Label: 29
Author: dsdlaforce
Date: 12/4/2018 2:02:12 PM
Color: ■

EL 6840 @ 5.80
Area in GEC is approximately 17,647 sf

Subject: Highlight
Page Label: 29
Author: dsdlaforce
Date: 12/4/2018 2:02:28 PM
Color: ■


Subject: Highlight
Page Label: 29
Author: dsdlaforce
Date: 12/4/2018 2:02:39 PM
Color: ■

Subject: Highlight
Page Label: 29
Author: dsdlaforce
Date: 12/4/2018 2:02:58 PM
Color: ■

Subject: Text Box
Page Label: 29
Author: dsdlaforce
Date: 12/4/2018 2:03:38 PM
Color: ■


MP @ 6834.2

Subject: Highlight
Page Label: 31
Author: dsdlaforce
Date: 12/4/2018 2:06:39 PM
Color: ■

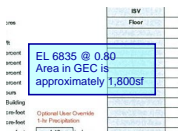


Subject: Text Box
Page Label: 31
Author: dsdlaforce
Date: 12/4/2018 2:06:39 PM
Color: ■

EL 6835 @ 0.80
 Area in GEC is approximately 1,800sf

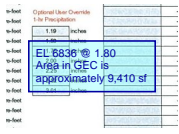


Subject: Text Box
Page Label: 31
Author: dsdlaforce
Date: 12/4/2018 2:06:39 PM
Color: ■

EL 6836 @ 1.80
 Area in GEC is approximately 9,410 sf

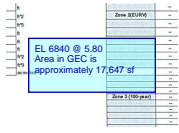

Subject: Text Box
Page Label: 31
Author: dsdlaforce
Date: 12/4/2018 2:06:39 PM
Color: ■

EL 6840 @ 5.80
 Area in GEC is approximately 17,647 sf

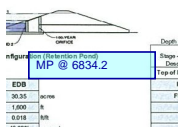


Subject: Text Box
Page Label: 31
Author: dsdlaforce
Date: 12/4/2018 2:06:39 PM
Color: ■

MP @ 6834.2


Subject: Highlight
Page Label: 31
Author: dsdlaforce
Date: 12/4/2018 2:06:39 PM
Color: ■

Subject: Highlight
Page Label: 31
Author: dsdlaforce
Date: 12/4/2018 2:06:39 PM
Color: ■

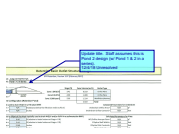


Subject: Callout
Page Label: 33
Author: dsdlaforce
Date: 12/4/2018 2:32:04 PM
Color: ■

Update title. Staff assumes this is Pond 2 design (w/ Pond 1 & 2 in a series).
 12/4/18 Unresolved

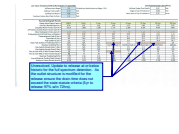


Subject: Callout
Page Label: 38
Author: dsdlaforce
Date: 12/4/2018 2:32:44 PM
Color: ■

Unresolved. Update to release at or below historic for the full spectrum detention. As the outlet structure is modified for the release ensure the drain time does not exceed the state statute criteria (5yr to release 97% w/in 72hrs).

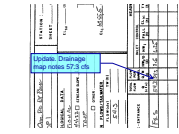


Subject: Callout
Page Label: 43
Author: dsdlaforce
Date: 12/4/2018 2:33:58 PM
Color: ■

Update. Drainage map notes 57.3 cfs

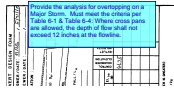

Subject: Text Box
Page Label: 43
Author: dsdlaforce
Date: 12/4/2018 2:33:58 PM
Color: ■

Provide the analysis for overtopping on a Major Storm. Must meet the criteria per Table 6-1 & Table 6-4: Where cross pans are allowed, the depth of flow shall not exceed 12 inches at the flowline.

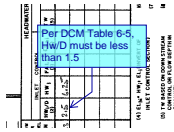


Subject: Callout
Page Label: 43
Author: dsdlaforce
Date: 12/4/2018 2:33:58 PM
Color: ■

Per DCM Table 6-5, Hw/D must be less than 1.5




Subject: Unresolved
Page Label: 43
Author: dsdlaforce
Date: 12/4/2018 2:35:15 PM
Color: ■

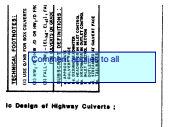


Subject: Text Box
Page Label: 43
Author: dsdlaforce
Date: 12/4/2018 2:36:30 PM
Color: ■

Comment applies to all

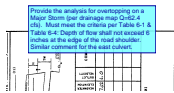

Subject: Text Box
Page Label: 44
Author: dsdlaforce
Date: 12/4/2018 2:40:42 PM
Color: ■

Provide the analysis for overtopping on a Major Storm (per drainage map Q=62.4 cfs). Must meet the criteria per Table 6-1 & Table 6-4: Depth of flow shall not exceed 6 inches at the edge of the road shoulder. Similar comment for the east culvert.

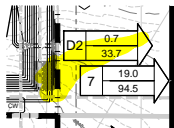

Subject: Highlight
Page Label: 56
Author: dsdlaforce
Date: 12/4/2018 2:48:21 PM
Color: ■




Subject: Callout
Page Label: 56
Author: dsdlaforce
Date: 12/4/2018 2:48:44 PM
Color: ■

1. Extend the drainage map to show the location of DP7
8/8/2018 Unresolved
12/4/18 Unresolved




Subject: Callout
Page Label: 56
Author: dsdlaforce
Date: 12/4/2018 2:49:20 PM
Color: ■

Analysis needs to extend to the swale. Looking at the contours the section highlighted in yellow does not appear to be hydraulically adequate and may need additional improvements.
8/8/18 Unresolved
12/4/18 Unresolved

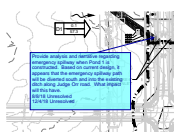


Subject: Callout
Page Label: 56
Author: dsdlaforce
Date: 12/4/2018 2:50:11 PM
Color: ■

Provide analysis and narrative regarding emergency spillway when Pond 1 is constructed. Based on current design, it appears that the emergency spillway path will be diverted south and into the existing ditch along Judge Orr road. What impact will this have.
8/8/18 Unresolved
12/4/18 Unresolved

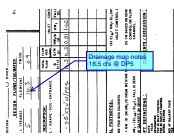

Subject: Callout
Page Label: 44
Author: dsdlaforce
Date: 12/4/2018 2:54:50 PM
Color: ■

Drainage map notes 18.5 cfs @ DP5

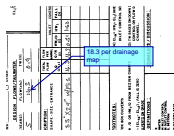

Subject: Callout
Page Label: 45
Author: dsdlaforce
Date: 12/4/2018 2:55:31 PM
Color: ■

18.3 per drainage map




Subject: Callout
Page Label: 56
Author: dsdlaforce
Date: 12/4/2018 4:40:16 PM
Color: ■

In the developed condition (pg 4) it noted off-site area remains the same. The design engineer noted on the 8/8/18 meeting that the intent was to pipe OS3 through basin OS2 and discharge to the Judge Orr ditch and not flow within the revised OS2 basin boundary shown on the proposed drainage map.

Update the narrative to discuss and provide analysis for the diversion. Is the ditch still hydraulically adequate with the reroute?

8/8/18 Unresolved
 12/4/18 Unresolved

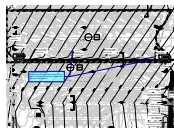

Subject: Callout
Page Label: 57
Author: dsdlaforce
Date: 12/4/2018 4:53:52 PM
Color: ■

Provide inlet calculations. What is the Q going into these inlets. These inlets should have an associated design point calculation and subbasin.

DP 05	0.005	4.0	1.30	2
	1.50	1.30	2	
	3.00	1.30	2	
	0.25	0.24*	2	
	2.00	1.60	2	

Subject: Highlight
Page Label: 22
Author: dsdlaforce
Date: 12/4/2018 4:58:55 PM
Color: ■



Subject: Callout
Page Label: 22
Author: dsdlaforce
Date: 12/4/2018 5:00:06 PM
Color: ■

100yr depth exceeds the swale design depth




Subject: Callout
Page Label: 22
Author: dsdlaforce
Date: 12/4/2018 5:01:21 PM
Color: ■

Swale F & G is missing

	3/3
	112.2
	33.7
	0.9
te 1	Spillway
	1.9
	N/A
	61

Subject: Highlight
Page Label: 38
Author: dsdlaforce
Date: 12/4/2018 5:15:23 PM
Color: ■

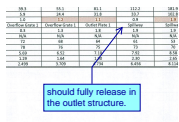

Subject: Callout
Page Label: 38
Author: dsdlaforce
Date: 12/4/2018 5:16:24 PM
Color: ■

should fully release in the outlet structure.



Subject: Callout
Page Label: 7
Author: dsdlaforce
Date: 12/4/2018 8:56:24 AM
Color: ■

State in the narrative who own/maintain this stormline.
 8/8/18 - Unresolved. This is to avoid confusion in the future since it is for conveying offsite flow across the property. When this property is platted, then this stormline must be located in a drainage easement.
 12/4/18 Unresolved.



Subject: Callout
Page Label: 29
Author: dsdlaforce
Date: 12/5/2018 7:44:58 AM
Color: ■

Revise the Pond 2 stage-storage based on the constructed pond shape shown on the GEC plan and not the computer generated values. Input the values in the "optional override stage/area".

The auto-generate for Pond 1 is okay since it was mainly for modeling the pond in a series based on an assumed condition for Pond 1.

However, add a statement that with development of pond 1, that drainage report will have to provide the same pond in a series analysis to verify release rates still meet Senate Bill 15-212.

12/4/18 Unresolved.




Subject: Callout
Page Label: 31
Author: dsdlaforce
Date: 12/5/2018 7:46:13 AM
Color: ■

Revise the Pond 2 stage-storage based on the constructed pond shape shown on the GEC plan and not the computer generated values. Input the values in the "optional override stage/area".

The auto-generate for Pond 1 is okay since it was mainly for modeling the pond in a series based on an assumed condition for Pond 1.


However, add a statement that with development of pond 1, that drainage report will have to provide the same pond in a series analysis to verify release rates still meet Senate Bill 15-212.

12/4/18 Unresolved.

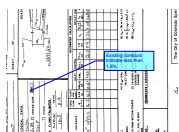


Subject: Callout
Page Label: 45
Author: dsdlaforce
Date: 12/6/2018 8:43:07 AM
Color: ■

Existing contours indicate less than 1.8%

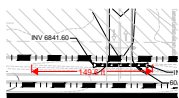


Subject: Length Measurement
Page Label: 57
Author: dsdlaforce
Date: 12/6/2018 8:43:15 AM
Color: ■

149.6 ft

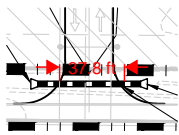


Subject: Length Measurement
Page Label: 57
Author: dsdlaforce
Date: 12/6/2018 8:45:46 AM
Color: ■

37.8 ft

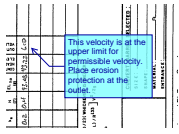

Subject: Callout
Page Label: 45
Author: dsdlaforce
Date: 12/6/2018 8:48:18 AM
Color: ■

This velocity is at the upper limit for permissible velocity. Place erosion protection at the outlet.

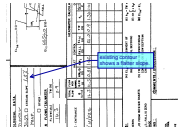

Subject: Callout
Page Label: 44
Author: dsdlaforce
Date: 12/6/2018 9:06:55 AM
Color: ■

existing contour shows a flatter slope.

dsdruiz (1)

Per GL, this is a spot check and he did not review each elevation. Please revise the entire table so that it matches the GEC plan.

Subject: Text Box
Page Label: 29
Author: dsdruiz
Date: 12/5/2018 11:49:27 AM
Color: ■

Per GL, this is a spot check and he did not review each elevation. Please revise the entire table so that it matches the GEC plan.