


PROPERTY SURVEY

Proposed changes to site:

- A. Remove this cabin 66.4' S.B.
- B. This cabin becomes shed for storage 34.0' S.B.
- C. Finish rehabilitating this cabin 8.8' S.B.
- D. Site of new cabin - Approximately 34' x 34'
- E. Site of new cabin Approximately 34' x 34'

S.B. = Existing Set-Backs

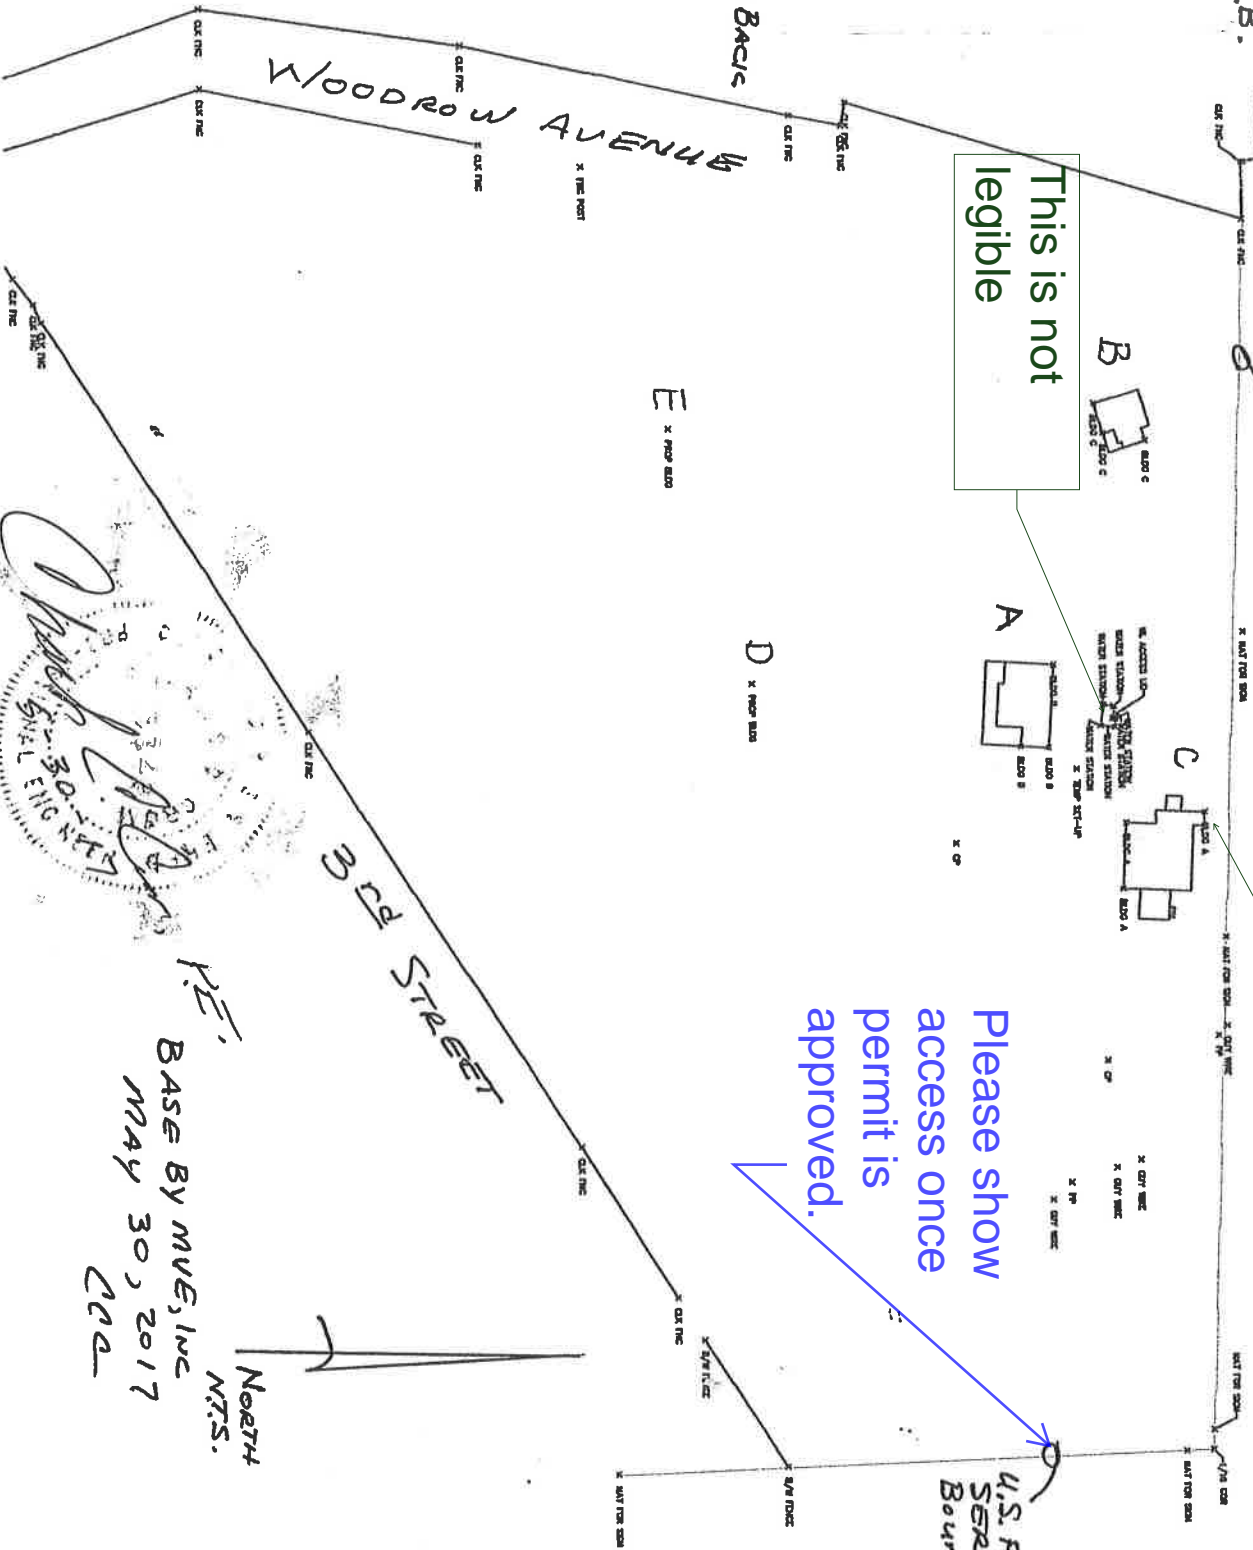

This is not legible

Show setback encroachment

Please show access once permit is approved.

Charles E. [Signature]
ENGINEER
No. 30,000

P.E.
BASE BY MVE, INC
MAY 30, 2017
CDD
NORTH

Markup Summary

1 (3)



Subject: Callout
Page Label: 1
Lock: Locked
Status:
Checkmark: Unchecked
Author: dsdkendall
Date: 6/19/2017 3:57:14 PM
Color: ■

This is not legible



Subject: Callout
Page Label: 1
Lock: Locked
Status:
Checkmark: Unchecked
Author: dsdhoff
Date: 6/19/2017 3:58:06 PM
Color: ■

Please show access once permit is approved.



Subject: Callout
Page Label: 1
Lock: Locked
Status:
Checkmark: Unchecked
Author: dsdkendall
Date: 6/19/2017 3:57:13 PM
Color: ■

Show setback encroachment