



Copyright : These Drawings are the property of DP3 Architects, Ltd., and reuse on any other project without written permission will result in legal action.

site plan shows 71x60.
please revise whichever
document is incorrect

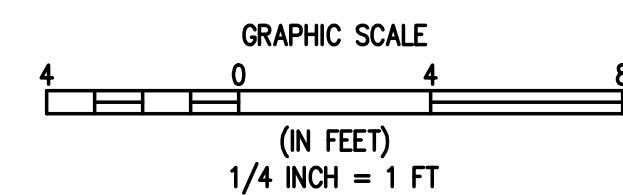

Seal

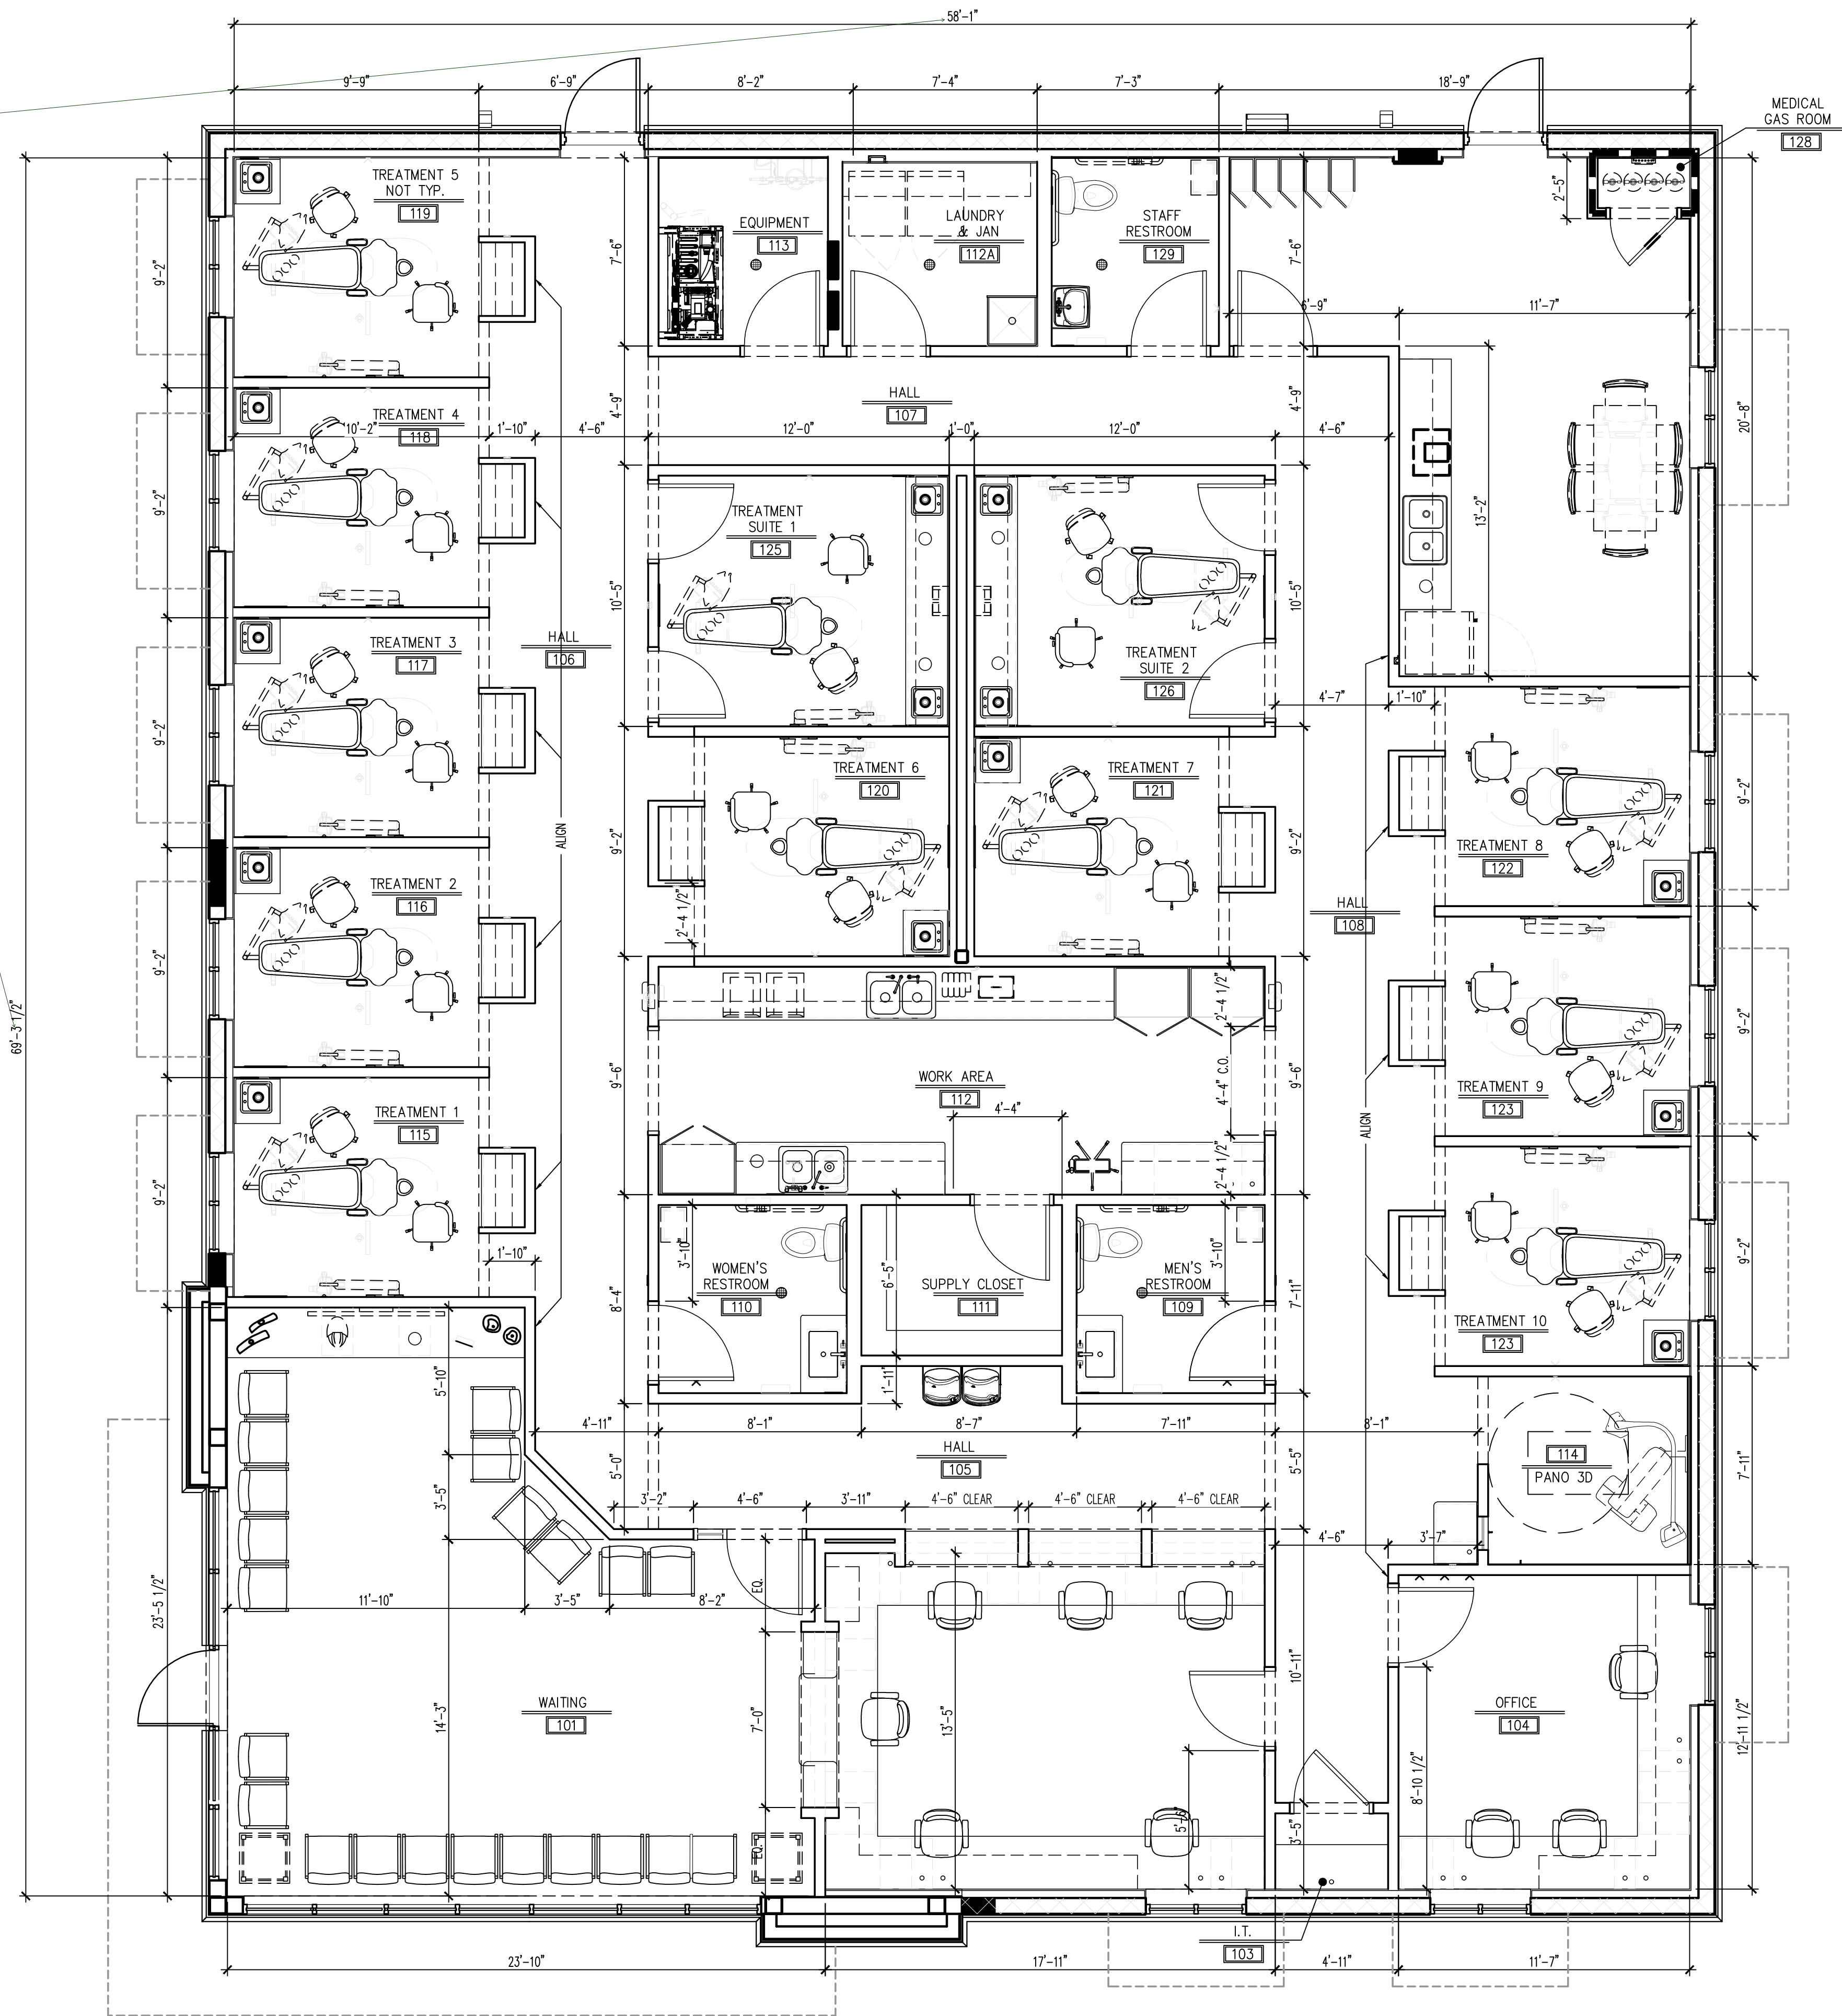

DP3 Architects, LTD.
15 South Main Street, Suite 400
Greenville, SC 29601
864.232.8200
www.DP3architects.com

Project



Dental Shell
Building
Falcon, CO

Project Number 21256
Drawn By
Checked By KMW
Date 01 JUL 2021

A1