


ACADEMY VILLAGE FILING NO. 3

LOT 4, "ACADEMY VILLAGE FILING NO. 2" BEING A PORTION
OF THE SOUTHEAST QUARTER OF SECTION 1, TOWNSHIP 12 SOUTH, RANGE 67 WEST OF THE 6TH P.M.,
COUNTY OF EL PASO, STATE OF COLORADO

GRADING AND EROSION CONTROL PLAN

GRADING AND EROSION CONTROL STANDARD NOTES

- CONSTRUCTION MAY NOT COMMENCE UNTIL A CONSTRUCTION PERMIT IS OBTAINED FROM PLANNING AND COMMUNITY DEVELOPMENT AND A PRECONSTRUCTION CONFERENCE IS HELD WITH PLANNING AND COMMUNITY DEVELOPMENT INSPECTIONS.
- STORMWATER DISCHARGES FROM CONSTRUCTION SITES SHALL NOT CAUSE OR THREATEN TO CAUSE POLLUTION, CONTAMINATION, OR DEGRADATION OF STATE WATERS. ALL WORK AND EARTH DISTURBANCE SHALL BE DONE IN A MANNER THAT MINIMIZES POLLUTION OF ANY ON-SITE OR OFF-SITE WATERS, INCLUDING WETLANDS.
- NOTWITHSTANDING ANYTHING DEPICTED IN THESE PLANS IN WORDS OR GRAPHIC REPRESENTATION, ALL DESIGN AND CONSTRUCTION RELATED TO ROADS, STORM DRAINAGE AND EROSION CONTROL SHALL CONFORM TO THE STANDARDS AND REQUIREMENTS OF THE MOST RECENT VERSION OF THE RELEVANT ADOPTED EL PASO COUNTY STANDARDS, INCLUDING THE LAND DEVELOPMENT CODE, THE ENGINEERING CRITERIA MANUAL, THE DRAINAGE CRITERIA MANUAL, AND THE DRAINAGE CRITERIA MANUAL VOLUME 2. ANY DEVIATIONS TO REGULATIONS AND STANDARDS MUST BE REQUESTED, AND APPROVED, IN WRITING.
- A SEPARATE STORMWATER MANAGEMENT PLAN (SWMP) FOR THIS PROJECT SHALL BE COMPLETED AND AN EROSION AND STORMWATER QUALITY CONTROL PERMIT (ESQCP) ISSUED PRIOR TO COMMENCING CONSTRUCTION. DURING CONSTRUCTION THE SWMP IS THE RESPONSIBILITY OF THE DESIGNATED STORMWATER MANAGER, SHALL BE LOCATED ON-SITE AT ALL TIMES AND SHALL BE KEPT UP TO DATE WITH WORK PROGRESS AND CHANGES IN THE FIELD.
- ONCE THE ESQCP HAS BEEN ISSUED, THE CONTRACTOR MAY INSTALL THE INITIAL STAGE EROSION AND SEDIMENT CONTROL BMPs AS INDICATED ON THE GEC. A PRECONSTRUCTION MEETING BETWEEN THE CONTRACTOR, ENGINEER, AND EL PASO COUNTY WILL BE HELD PRIOR TO ANY CONSTRUCTION. IT IS THE RESPONSIBILITY OF THE APPLICANT TO COORDINATE THE MEETING TIME AND PLACE WITH COUNTY PCD INSPECTIONS STAFF.
- SOIL EROSION CONTROL MEASURES FOR ALL SLOPES, CHANNELS, DITCHES, OR ANY DISTURBED LAND AREA SHALL BE COMPLETED WITHIN 21 CALENDAR DAYS AFTER FINAL GRADING, OR FINAL EARTH DISTURBANCE, HAS BEEN COMPLETED. DISTURBED AREAS AND STOCKPILES WHICH ARE NOT AT FINAL GRADE BUT WILL REMAIN DORMANT FOR LONGER THAN 30 DAYS SHALL ALSO BE MULCHED WITHIN 21 DAYS AFTER INTERIM GRADING. AN AREA THAT IS GOING TO REMAIN IN AN INTERIM STATE FOR MORE THAN 60 DAYS SHALL ALSO BE SEEDED. ALL TEMPORARY SOIL EROSION CONTROL MEASURES AND BMPs SHALL BE MAINTAINED UNTIL PERMANENT SOIL EROSION CONTROL MEASURES ARE IMPLEMENTED AND ESTABLISHED.
- TEMPORARY SOIL EROSION CONTROL FACILITIES SHALL BE REMOVED AND EARTH DISTURBANCE AREAS GRADED AND STABILIZED WITH PERMANENT SOIL EROSION CONTROL MEASURES PURSUANT TO STANDARDS AND SPECIFICATION PRESCRIBED IN THE DCM VOLUME II AND THE ENGINEERING CRITERIA MANUAL (ECM) APPENDIX I.
- ALL PERSONS ENGAGED IN EARTH DISTURBANCE SHALL IMPLEMENT AND MAINTAIN ACCEPTABLE SOIL EROSION AND SEDIMENT CONTROL MEASURES INCLUDING BMPs IN CONFORMANCE WITH THE EROSION CONTROL TECHNICAL STANDARDS OF THE DRAINAGE CRITERIA MANUAL (DCM) VOLUME II AND IN ACCORDANCE WITH THE STORMWATER MANAGEMENT PLAN (SWMP).
- ALL TEMPORARY EROSION CONTROL FACILITIES INCLUDING BMPs AND ALL PERMANENT FACILITIES INTENDED TO CONTROL EROSION OF ANY EARTH DISTURBANCE OPERATIONS, SHALL BE INSTALLED AS DEFINED IN THE APPROVED PLANS, THE SWMP AND THE DCM VOLUME II AND MAINTAINED THROUGHOUT THE DURATION OF THE EARTH DISTURBANCE OPERATION.
- ANY EARTH DISTURBANCE SHALL BE CONDUCTED IN SUCH A MANNER SO AS TO EFFECTIVELY REDUCE ACCELERATED SOIL EROSION AND RESULTING SEDIMENTATION. ALL DISTURBANCES SHALL BE DESIGNED, CONSTRUCTED, AND COMPLETED SO THAT THE EXPOSED AREA OF ANY DISTURBED LAND SHALL BE LIMITED TO THE SHORTEST PRACTICAL PERIOD OF TIME.
- ANY TEMPORARY OR PERMANENT FACILITY DESIGNED AND CONSTRUCTED FOR THE CONVEYANCE OF STORMWATER AROUND, THROUGH, OR FROM THE EARTH DISTURBANCE AREA SHALL BE DESIGNED TO LIMIT THE DISCHARGE TO A NON-EROSIVE VELOCITY.
- CONCRETE WASH WATER SHALL BE CONTAINED AND DISPOSED OF IN ACCORDANCE WITH THE SWMP. NO WASH WATER SHALL BE DISCHARGED TO OR ALLOWED TO RUNOFF TO STATE WATERS, INCLUDING ANY SURFACE OR SUBSURFACE STORM DRAINAGE SYSTEM OR FACILITIES.
- EROSION CONTROL BLANKETING IS TO BE USED ON SLOPES STEEPER THAN 3:1.
- BUILDING, CONSTRUCTION, EXCAVATION, OR OTHER WASTE MATERIALS SHALL NOT BE TEMPORARILY PLACED OR STORED IN THE STREET, ALLEY, OR OTHER PUBLIC WAY, UNLESS IN ACCORDANCE WITH AN APPROVED TRAFFIC CONTROL PLAN. BMP'S MAY BE REQUIRED BY EL PASO COUNTY ENGINEERING IF DEEMED NECESSARY, BASED ON SPECIFIC CONDITIONS AND CIRCUMSTANCES.
- VEHICLE TRACKING OF SOILS AND CONSTRUCTION DEBRIS OFF-SITE SHALL BE MINIMIZED. MATERIALS TRACKED OFFSITE SHALL BE CLEANED UP AND PROPERLY DISPOSED OF IMMEDIATELY.
- CONTRACTOR SHALL BE RESPONSIBLE FOR THE REMOVAL OF ALL WASTES FROM THE CONSTRUCTION SITE FOR DISPOSAL IN ACCORDANCE WITH LOCAL AND STATE REGULATORY REQUIREMENTS. NO CONSTRUCTION DEBRIS, TREE SLASH, BUILDING MATERIAL WASTES OR UNUSED BUILDING MATERIALS SHALL BE BURIED, DUMPED, OR DISCHARGED AT THE SITE.
- THE OWNER, SITE DEVELOPER, CONTRACTOR, AND/OR THEIR AUTHORIZED AGENTS SHALL BE RESPONSIBLE FOR THE REMOVAL OF ALL CONSTRUCTION DEBRIS, DIRT, TRASH, ROCK, SEDIMENT, AND SAND THAT MAY ACCUMULATE IN THE STORM SEWER OR OTHER DRAINAGE CONVEYANCE SYSTEM AND STORMWATER APPURTENANCES AS A RESULT OF SITE DEVELOPMENT.
- THE QUANTITY OF MATERIALS STORED ON THE PROJECT SITE SHALL BE LIMITED, AS MUCH AS PRACTICAL, TO THAT QUANTITY REQUIRED TO PERFORM THE WORK IN AN ORDERLY SEQUENCE. ALL MATERIALS STORED ON-SITE SHALL BE STORED IN A NEAT, ORDERLY MANNER, IN THEIR ORIGINAL CONTAINERS, WITH ORIGINAL MANUFACTURER'S LABELS.
- NO CHEMICALS ARE TO BE USED BY THE CONTRACTOR, WHICH HAVE THE POTENTIAL TO BE RELEASED IN STORMWATER UNLESS PERMISSION FOR THE USE OF A SPECIFIC CHEMICAL IS GRANTED IN WRITING BY THE ECM ADMINISTRATOR. IN GRANTING THE USE OF SUCH CHEMICALS, SPECIAL CONDITIONS AND MONITORING MAY BE REQUIRED. NO PERSON SHALL CAUSE THE IMPEDIMENT OF STORMWATER FLOW IN THE FLOW LINE OF THE CURB AND GUTTER OR IN THE DITCHLINE.
- BULK STORAGE STRUCTURES FOR PETROLEUM PRODUCTS AND OTHER CHEMICALS SHALL HAVE ADEQUATE PROTECTION SO AS TO CONTAIN ALL SPILLS AND PREVENT ANY SPILLED MATERIAL FROM ENTERING STATE WATERS, INCLUDING ANY SURFACE OR SUBSURFACE STORM DRAINAGE SYSTEM OR FACILITIES.
- NO PERSON SHALL CAUSE THE IMPEDIMENT OF STORMWATER FLOW IN THE FLOW LINE OF THE CURB AND GUTTER OR IN THE DITCHLINE.
- INDIVIDUALS SHALL COMPLY WITH THE "COLORADO WATER QUALITY CONTROL ACT" (TITLE 25, ARTICLE 8, CRS), AND THE "CLEAN WATER ACT" (33 USC 1344), IN ADDITION TO THE REQUIREMENTS INCLUDED IN THE DCM VOLUME II AND THE ECM APPENDIX I. ALL APPROPRIATE PERMITS MUST BE OBTAINED BY THE CONTRACTOR PRIOR TO CONSTRUCTION (NPDES, FLOODPLAIN, 404, FUGITIVE DUST, ETC.) IN THE EVENT OF CONFLICTS BETWEEN THESE REQUIREMENTS AND LAWS, RULES, OR REGULATIONS OF OTHER FEDERAL, STATE, OR COUNTY AGENCIES, THE MORE RESTRICTIVE LAWS, RULES, OR REGULATIONS SHALL APPLY.
- ALL CONSTRUCTION TRAFFIC MUST ENTER/EXIT THE SITE AT APPROVED CONSTRUCTION ACCESS POINTS.
- PRIOR TO ACTUAL CONSTRUCTION THE PERMITEE SHALL VERIFY THE LOCATION OF EXISTING UTILITIES.
- A WATER SOURCE SHALL BE AVAILABLE ON-SITE DURING EARTHWORK OPERATIONS AND UTILIZED AS REQUIRED TO MINIMIZE DUST FROM EARTHWORK EQUIPMENT AND WIND.
- THE SOILS REPORT FOR THIS SITE HAS BEEN PREPARED BY ENTECH ENGINEERING, INC. AND SHALL BE CONSIDERED A PART OF THESE PLANS.
- AT LEAST TEN DAYS PRIOR TO THE ANTICIPATED START OF CONSTRUCTION, FOR PROJECTS THAT WILL DISTURB 1 ACRE OR MORE, THE OWNER OR OPERATOR OF CONSTRUCTION ACTIVITY SHALL SUBMIT A PERMIT APPLICATION FOR STORMWATER DISCHARGE TO THE COLORADO DEPARTMENT OF PUBLIC HEALTH AND ENVIRONMENT, WATER QUALITY DIVISION. THE APPLICATION CONTAINS CERTIFICATION OF COMPLETION OF A STORMWATER MANAGEMENT PLAN (SWMP), OF WHICH THIS GRADING AND EROSION CONTROL PLAN MAY BE A PART. FOR INFORMATION OR APPLICATION MATERIALS CONTACT:
Colorado Department of Public Health and Environment
Water Quality Control Division
WOOD - Permits
4300 Cherry Creek Drive South
Denver, CO 80246-1530
Attn: Permits Unit

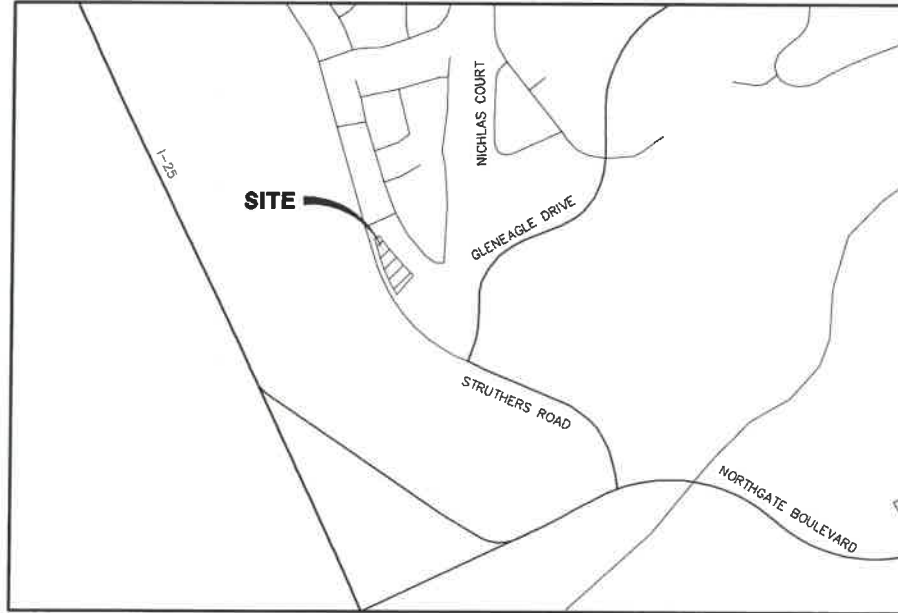

VICINITY MAP
SCALE: 1"=500'

SHEET INDEX

- COVER SHEET
- GEC PLAN
- DETAILS
- POND GRADING PLAN
- OUTLET STRUCTURE DETAILS

AS-BUILT



OWNER'S STATEMENT

THE OWNER WILL COMPLY WITH THE REQUIREMENTS OF THE GRADING AND EROSION CONTROL PLAN.

Ronald Blain 5-3-2018
NAME DATE

ENGINEER'S STATEMENT

THE GRADING AND EROSION CONTROL PLAN WAS PREPARED UNDER MY DIRECTION AND SUPERVISION AND IS CORRECT TO THE BEST OF MY KNOWLEDGE AND BELIEF. SAID PLAN HAS BEEN PREPARED ACCORDING TO THE CRITERIA ESTABLISHED BY THE COUNTY FOR GRADING AND EROSION CONTROL PLANS. I ACCEPT RESPONSIBILITY FOR ANY LIABILITY CAUSED BY ANY NEGLIGENT ACTS, ERRORS OR OMISSIONS ON MY PART IN PREPARING THIS PLAN.

Glenn D. Ellis
Glenn D. Ellis, P.E.
No. 38861
May 3, 2018
FOR AND ON BEHALF OF JR ENGINEERING

AGENCIES

- OWNER/DEVELOPER: RON COVINGTON HOMES
13725 STRUTHERS ROAD, SUITE 200
COLORADO SPRINGS, CO 80920
RON COVINGTON, 719-491-1220
- CIVIL ENGINEER: JR ENGINEERING, LLC
3730 SINTON ROAD, SUITE 219
COLORADO SPRINGS, COLORADO 80907
GLENN ELLIS, PE (303) 267-6241
- ENGINEERING DIVISION: EL PASO COUNTY PUBLIC SERVICES DEPARTMENT
BROWN TRANSPORTATION & ENVIRONMENTAL CONFERENCE
3255 AKERS DRIVE
COLORADO SPRINGS, COLORADO 80903
(719)-520-6460
- TRAFFIC ENGINEERING: EL PASO COUNTY PUBLIC SERVICES DEPARTMENT
BROWN TRANSPORTATION & ENVIRONMENTAL CONFERENCE
3255 AKERS DRIVE
COLORADO SPRINGS, COLORADO 80903
(719)-520-6460
- PLANNING & DEVELOPMENT: EL PASO COUNTY
PLANNING & COMMUNITY DEVELOPMENT:
2880 INTERNATIONAL CIRCLE, SUITE 110
COLORADO SPRINGS, COLORADO 80947
(719) 520-6300
- GAS DEPARTMENT: COLORADO SPRINGS UTILITIES
1521 HANCOCK EXPRESSWAY
COLORADO SPRINGS, COLORADO 80947
TONY COLVIN (719) 668-5768
- ELECTRIC DEPARTMENT: MOUNTAIN VIEW ELECTRIC ASSOCIATION
11140 E WOODMEN RD.
PEYTON, COLORADO 80831
(719) 495-2283
- TELEPHONE COMPANY: CENTURY LINK
(LOCATORS) (719) 597-8418
A.T.& T.
(LOCATORS) (719) 635-3674
- FIRE DEPARTMENT: DONALD WESCOTT FIRE PROTECTION DISTRICT ST#1
15415 GLENEAGLE DRIVE
COLORADO SPRINGS, CO 80921
VINNY BURNS (719) 488-8680
- WATER AND SANITARY: DONALD WATER & SANITATION DISTRICT
15850 HOLNEINE DRIVE
COLORADO SPRINGS, CO 80921
ROBERT HULL JR. (719) 488-3603

EL PASO COUNTY

COUNTY PLAN REVIEW IS PROVIDED ONLY FOR GENERAL CONFORMANCE WITH COUNTY DESIGN CRITERIA. THE COUNTY IS NOT RESPONSIBLE FOR THE ACCURACY AND ADEQUACY OF THE DESIGN, DIMENSIONS, AND/OR ELEVATIONS WHICH SHALL BE CONFIRMED AT THE JOB SITE. THE COUNTY THROUGH THE APPROVAL OF THIS DOCUMENTS ASSUMES NO RESPONSIBILITY FOR COMPLETENESS AND/OR ACCURACY OF THIS DOCUMENT.

FILED IN ACCORDANCE WITH THE REQUIREMENTS OF THE EL PASO COUNTY LAND DEVELOPMENT CODE, DRAINAGE CRITERIA, AND ENGINEERING CRITERIA MANUAL AS AMENDED.


Approved
El Paso County Planning and Community Development
an Equal Opportunity and Affirmative Action Office
JENNIFER IRVINE, P.E.
COUNTY ENGINEER/ECM ADMINISTRATOR
07/30/2018 12:37:15 PM



UNTIL SUCH TIME AS THESE DRAWINGS ARE APPROPRIATELY REVIEWED AND APPROVED FOR THEIR USE ONLY FOR THE PURPOSES DESIGNATED BY WRITTEN AUTHORIZATION.	
PREPARED FOR RON COVINGTON HOMES 13725 STRUTHERS ROAD, SUITE 200 COLORADO SPRINGS, CO 80920 CONTACT: RON COVINGTON 719-491-1220	
J.R. ENGINEERING A Wharton Company Central 303-740-9888 • Colorado Springs 719-500-2838 Fort Collins 970-491-9888 • www.jrengineering.com	
No.	REVISION
BY	DATE
H-SCALE	N/A
V-SCALE	N/A
DATE	05/03/18
DESIGNED BY	
DRAWN BY	
CHECKED BY	
ACADEMY VILLAGE FILING NO. 3	
GRADING AND EROSION CONTROL PLAN	
COVER SHEET	
SHEET	1 OF 5
JOB NO.	25123.00

VR-17-012

AS-BUILT

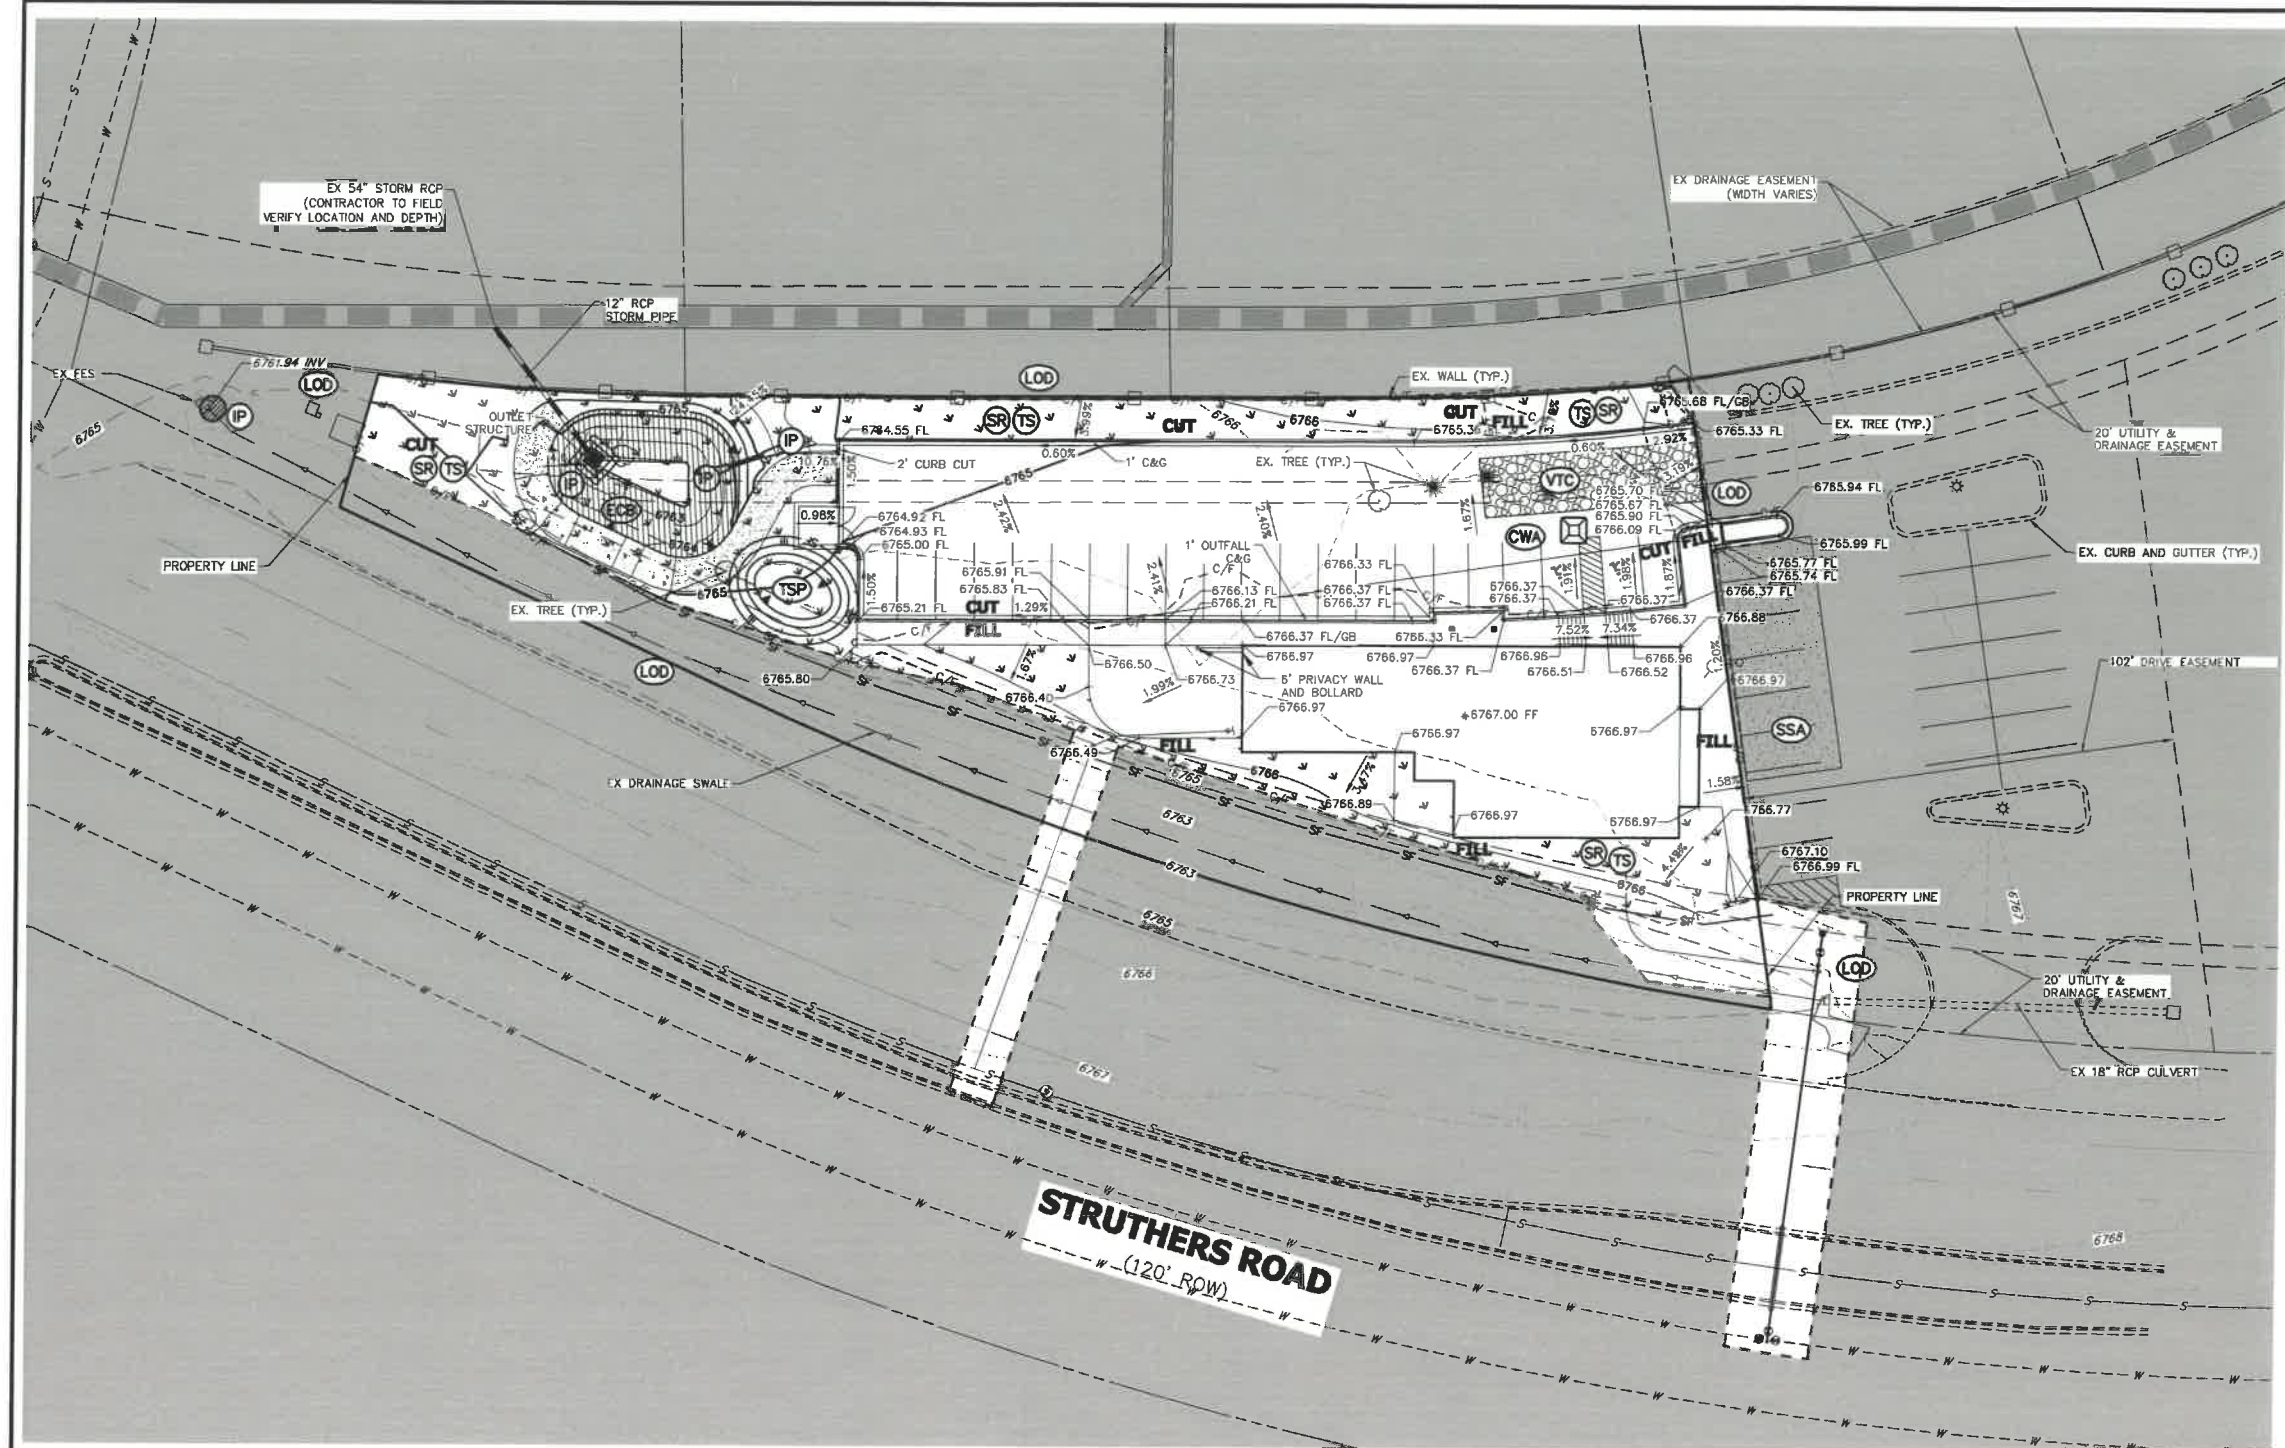

UNTIL SUCH TIME AS APPROVED BY THE AGENCIES, THE CONTRACTOR SHALL OBTAIN ALL NECESSARY PERMITS AND APPROVALS FOR THE PROJECT. THE CONTRACTOR SHALL BE RESPONSIBLE FOR OBTAINING ALL NECESSARY PERMITS AND APPROVALS FOR THE PROJECT.

PREPARED FOR
RON COVINGTON HOMES
 13725 STRUTHERS ROAD, SUITE 200
 COLORADO SPRINGS, CO 80920
 CONTACT: RON COVINGTON
 719-491-1220

J.R. ENGINEERING
 A Weidman Company
 Central 303-740-9883 • Colorado Springs 719-580-2883
 Fort Collins 970-491-9888 • www.jrengineering.com

NO.	REVISION	DATE
1	RAB	05/03/18
2	RAB	
3	RAB	

GESC PLAN LEGEND


SURFACE ROUGHENING/ TEMPORARY SEEDING		NON-IRRIGATED DROUGHT TOLERANT NATIVE GRASSES	
SILT FENCE			
VEHICLE TRACKING CONTROL			
STABILIZED STAGING AREA			
CONCRETE WASHOUT AREA			
INLET PROTECTION			
TEMPORARY STOCKPILE			
FLOW DIRECTION			
LIMITS OF DISTURBANCE			

LEGEND

EXISTING CONTOURS		6100
PROPOSED INDEX CONTOURS		6100
PROPOSED INTERMEDIATE CONTOURS		
PROPOSED STORM SEWER		
PROPOSED INLET		
FINISHED GRADE ELEVATION	XX.XX	
LOW POINT ELEVATION	XX.XX LP	
HIGH POINT ELEVATION	XX.XX HP	
RIGHT OF WAY ELEVATION	XX.XX ROW	
GRADE BREAK ELEVATION	XX.XX GB	
FLOW LINE ELEVATION	XX.XX FL	
PROPOSED RIDGELINE		
LIMITS OF DISTURBANCE		
EROSION CONTROL BLANKET		
CUT-FILL LIMITS		C/F

- ### GESC PLAN NOTES
- SEE COVER SHEET FOR EL PASO COUNTY GRADING AND EROSION CONTROL NOTES. THE PLAN SHALL NOT SUBSTANTIALLY CHANGE THE DEPTH OF COVER, OR ACCESS TO UTILITY FACILITIES. ADDITIONALLY, THE PLAN SHALL NOT INCREASE OR DIVERT WATER TOWARDS UTILITY FACILITIES. ANY CHANGES TO UTILITY FACILITIES TO ACCOMMODATE THE PLAN, MUST BE DISCUSSED AND AGREED TO BY THE AFFECTED UTILITY PRIOR TO IMPLEMENTING THE PLAN. THE RESULTING COST TO RELOCATE OR PROTECT UTILITIES, OR PROVIDE INTERIM ACCESS IS AT THE EXPENSE OF THE PLAN APPLICANT.
 - ENTIRE SITE IS OUTSIDE OF THE 100 YEAR FLOOD PLAIN.
 - CONTRACTOR RESPONSIBLE FOR OBTAINING ALL REQUIRED PERMITS INCLUDING A COUNTY R.O.W. PERMIT.
 - CONTRACTOR RESPONSIBLE FOR CONTROLLING ALL STORMWATER AND EROSION IMPACTED OR ORIGINATING FROM CONSTRUCTION ACTIVITIES ON SITE, IMPLEMENTING THIS GEC PLAN, MAINTAINING & REMOVING BMP'S, AND ESTABLISHING FINAL STABILIZATION OF THE SITE. CHANGES TO THIS PLAN AND ITS IMPLEMENTATION INCLUDING MODIFICATIONS, ADDITIONAL BMP'S OR REMOVAL OF PROPOSED BMP'S, SHALL BE BY THE CONTRACTOR IF NECESSARY TO CONTROL STORMWATER AND EROSION BASED ON ACTUAL SITE CONDITIONS AND PHASING.

LAND DISTURBANCE		
	VOLUME (CY)	AREA (AC)
CUT	315	0.34
FILL	222	0.22
NET	93 (CUT)	N/A

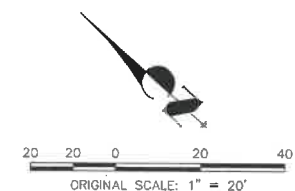

OWNER'S STATEMENT

THE OWNER WILL COMPLY WITH THE REQUIREMENTS OF THE GRADING AND EROSION CONTROL PLAN.

[Signature] 5-3-18
 NAME DATE

ENGINEER'S STATEMENT

THE GRADING AND EROSION CONTROL PLAN WAS PREPARED UNDER MY DIRECTION AND SUPERVISION AND IS CORRECT TO THE BEST OF MY KNOWLEDGE AND BELIEF. SAID PLAN HAS BEEN PREPARED ACCORDING TO THE CRITERIA ESTABLISHED BY THE COUNTY FOR GRADING AND EROSION CONTROL PLANS. I ACCEPT RESPONSIBILITY FOR ANY LIABILITY CAUSED BY ANY NEGLIGENT ACTS, ERRORS OR OMISSIONS ON MY PART IN PREPARING THIS PLAN.

[Signature] 38861 May 3, 2018
 GLENN D. ELLIS P.E. COLORADO P.E. 38861
 FOR AND ON BEHALF OF JR. ENGINEERING

ACADEMY VILLAGE FILING NO. 3
 GRADING AND EROSION CONTROL PLAN
 GEC PLAN
 SHEET 2 OF 5
 JOB NO. 25123.00

X:\25123.00\A\25123.00\Drawings\Sheet\GEC\GEC25123.00.dwg, 05/03/2018 05:56:42 AM, CS

Shallow Slope
On shallow slopes, strips of netting may be applied across the slope.

Where there is a berm at the top of the slope, bring the netting over the berm and anchor it behind the berm.

Steep Slope
On steep slopes, apply strips of netting parallel to the direction of flow and anchor securely.

Bring netting down to a level area before terminating the installation. Turn the end under 6" and staple at 12" intervals.

Ditch
In ditches, apply netting parallel to the direction of flow. Use check slots every 15 feet. Do not join strips in the center of the ditch.

City of Colorado Springs Storm Water Quality
Figure ECB-1 Erosion Control Blanket Application Examples

Anchor Slot Bury the up-channel end of the net in a 6" deep trench. Tamp the soil firmly. Staple at 12" intervals across the net.

Overlap Overlap edges of the strips at least 4". Staple every 3 feet down the center of the strip.

Joining Slope Insert the new roll of net in a trench, or with the Anchor Slot. Overlap the up-channel end of the net into a 6" trench and turn the end under 6". Staple the end of the previous roll just below the anchor slot and at the end of 12" intervals.

Check Slot On erodible soils or steep slopes, check slots should be made every 15 feet. Insert a fold of the net into a 6" trench and tamp firmly. Staple at 12" intervals across the net. Lay the net smoothly on the surface of the soil - do not stretch the net, and do not allow wrinkles.

Anchor Slot At Structure Place the end of the net in a 6" slot on the up-channel side of the structure. Fill the trench and tamp firmly. Roll the net up the channel. Place staples at 12" intervals along the anchor end of the net.

City of Colorado Springs Storm Water Quality
Figure ECB-2 Erosion Control Blanket Installation Requirements

FILTER FABRIC INLET PROTECTION

FILTER FABRIC INLET PROTECTION NOTES

INSTALLATION REQUIREMENTS

- INLET PROTECTION SHALL BE INSTALLED IMMEDIATELY AFTER CONSTRUCTION OF INLET.
- SEE Silt FENCE FIGURE SF-2 FOR INSTALLATION REQUIREMENTS.
- POSTS ARE TO BE PLACED AT EACH CORNER OF THE INLET AND AROUND THE EDGES AT A MAXIMUM SPACING OF 3 FEET.

MAINTENANCE REQUIREMENTS

- CONTRACTOR SHALL INSPECT INLET PROTECTION IMMEDIATELY AFTER EACH RAINFALL, AT LEAST DAILY DURING PROLONGED RAINFALL, AND WEEKLY DURING PERIODS OF NO RAINFALL.
- DAMAGED, COLLAPSED, UNINTRENCHED OR IMPROPERLY INSTALLED INLET PROTECTION SHALL BE PROMPTLY REPAIRED OR REPLACED.
- SEDIMENT SHALL BE REMOVED FROM BEHIND FILTER FABRIC WHEN IT ACCUMULATES TO HALF THE EXPOSED GEOTEXTILE HEIGHT.
- INLET PROTECTION SHALL BE REMOVED WHEN ADEQUATE VEGETATIVE COVER IS ATTAINED IN THE DRAINAGE AREA AS APPROVED BY THE CITY.

City of Colorado Springs Stormwater Quality
Figure IP-1 Filter Fabric Inlet Protection Construction Detail and Maintenance Requirements

RECOMMENDED ANNUAL GRASSES

SPECIES (COMMON NAME)	GROWTH SEASON	SEEDING DATE	POUNDS OF PURE LIVE SEED (PLS) (P/BAKETS)	PLANTING DEPTH (INCHES)
1. COATS	COOL	MARCH 15 - APRIL 30	25-50	1-2
2. SPRING WHEAT	COOL	MARCH 15 - APRIL 30	25-50	1-2
3. SPRING BARLEY	COOL	MARCH 15 - APRIL 30	25-50	1-2
4. ANNUAL RYEGRASS	COOL	MARCH 15 - JUNE 30	10-15	1/2
5. MILET	WARM	MAY 15 - JULY 15	3-15	1/2-3/4
6. BUDAKGRASS	WARM	MAY 15 - JULY 15	5-10	1/2-3/4
7. SCORPIM	WARM	MAY 15 - JULY 15	5-10	1/2-3/4
8. WINTER WHEAT	COOL	SEPTEMBER 1 - 30	20-25	1-2
9. WINTER BARLEY	COOL	SEPTEMBER 1 - 30	20-25	1-2
10. WINTER RYE	COOL	SEPTEMBER 1 - 30	20-25	1-2
11. TRITICALE	COOL	SEPTEMBER 1 - 30	20-40	1-2

THIS TABLE WAS TAKEN FROM LDCO FOR RECOMMENDED ANNUAL GRASSES FOR THE DENVER METROPOLITAN AREA. THIS TABLE MAY BE USED UNLESS A SITE-SPECIFIC SEED MIX IS REQUESTED AND APPROVED.

TABLES-1

TEMPORARY SEEDING NOTES

INSTALLATION REQUIREMENTS

- DISTURBED AREAS ARE TO BE SEEDDED WITHIN 21 DAYS AFTER CONSTRUCTION ACTIVITY OR GRADING ENDS IF SEASON ALLOWS.
- IF NECESSARY, SOIL IS TO BE CONDITIONED FOR PLANT GROWTH BY APPLYING TOPSOIL, FERTILIZER, OR LIMES.
- SOIL IS TO BE TILLED IMMEDIATELY PRIOR TO APPLYING SEED. COMPACT SOILS ESPECIALLY NEED TO BE LOOSENED.
- SEEDING DEPTHS IS TO BE 4 INCHES FOR SLOPES FLATTER THAN 2:1, AND 1 INCH FOR SLOPES STEEPER THAN 2:1.
- ANNUAL GRASSES LISTED IN TABLE TS-1 ARE TO BE USED FOR TEMPORARY SEEDING. SEED MIXES ARE NOT TO CONTAIN ANY NONBIODegradable SEEDS INCLUDING RUSSIAN OR CANADIAN THISTLE, KNAPWEED, PURPLE LOOSESTRIFE, EUROPEAN BIRCH, JOHNSON GRASS, AND LEAFY SPURGE.
- TABLE TS-1 ALSO PROVIDES REQUIREMENTS FOR SEEDING RATES, SEEDING DATES, AND PLANTING DEPTHS FOR THE APPROVED TYPES OF ANNUAL GRASSES.
- SEEDING IS TO BE APPLIED USING MECHANICAL TYPE DRILLS EXCEPT WHERE SLOPES ARE STEEP OR ACCESS IS LIMITED THEN HYDRAULIC SEEDING MAY BE USED.
- ALL SEEDING AREAS ARE TO BE MULCHED (SEE FACTSHEET ON MULCHING).
- IF HYDRAULIC SEEDING IS USED THEN HYDRAULIC MULCHING SHALL BE DONE SEPARATELY TO AVOID SEEDS BEING ENCAPSULATED IN THE MULCH.

MAINTENANCE REQUIREMENTS

- REGULAR INSPECTIONS ARE TO BE MADE OF ALL SEEDING AREAS TO ENSURE GROWTH.
- AREAS WHERE GROWTH IS NOT OCCURRING QUICKLY OR THE MULCH HAS BEEN REMOVED SHALL BE RE-SEED AS SOON AS POSSIBLE AND RE-MULCHED IF NEEDED.
- SEEDING AREAS ARE NOT TO BE DRIVEN OVER WITH CONSTRUCTION EQUIPMENT OR VEHICLES.

City of Colorado Springs Stormwater Quality
Figure TS-1 Temporary Seeding Construction Detail and Maintenance Requirements

MULCHING NOTES

INSTALLATION REQUIREMENTS

- ALL DISTURBED AREAS MUST BE MULCHED WITHIN 30 DAYS AFTER FINAL GRADE AND SEEDING AREAS ARE TO BE MULCHED WITHIN 24 HOURS AFTER SEEDING.
- MATERIAL USED FOR MULCH CAN BE CERTIFIED CLEAN, WEED- AND SEED-FREE LONG ITEMIZED FELD OR MASH, OR STRAW OF OATS, BARLEY, WHEAT, RYE, OR TRITICALE CERTIFIED BY THE COLORADO DEPARTMENT OF AGRICULTURE WEED FREE FORAGE CERTIFICATION PROGRAM.
- HYDRAULIC MULCHING MATERIAL SHALL CONSIST OF VIRGIN WOOD FIBER MANUFACTURED FROM CLEAN WHOLE WOOD CHIPS. WOOD CHIPS CANNOT CONTAIN ANY GROWTH OR GERMINATION INHIBITORS OR BE PRODUCED FROM RECYCLED MATERIAL. GRAVEL CAN ALSO BE USED.
- MULCH IS TO BE APPLIED EVENLY AT A RATE OF 2 TONS PER ACRE.
- MULCH IS TO BE ANCHORED EITHER BY COMBINING TUCKING MULCH STRIPS 4 INCHES INTO THE SOIL USING NETTING (USED ON SMALL AREAS WITH STEEP SLOPES), OR WITH A TACKIFIER.
- HYDRAULIC MULCHING AND TACKIFIERS ARE NOT TO BE USED IN THE PRESENCE OF FREE SURFACE WATER.

MAINTENANCE REQUIREMENTS

- REGULAR INSPECTIONS ARE TO BE MADE OF ALL MULCHED AREAS.
- MULCH IS TO BE REPLACED IMMEDIATELY IN THOSE AREAS IT HAS BEEN REMOVED, AND IF NECESSARY THE AREA SHOULD BE RE-SEED.

City of Colorado Springs Stormwater Quality
Figure MU-1 Mulching Construction Detail and Maintenance Requirements

SILT FENCE

SILT FENCE NOTES

INSTALLATION REQUIREMENTS

- SILT FENCES SHALL BE INSTALLED PRIOR TO ANY LAND DISTURBING ACTIVITIES.
- WHEN JOINTS ARE NECESSARY, SILT FENCE GEOTEXTILE SHALL BE SPliced TOGETHER ONLY AT SUPPORT POST AND SECURELY SEALED.
- METAL POSTS SHALL BE "STUDDED" TYPE OR "I" TYPE WITH MINIMUM WEIGHT OF 1.33 POUNDS PER LINEAL FOOT. WOOD POSTS SHALL HAVE A MINIMUM DIAMETER OR CROSS SECTION DIMENSION OF 2 INCHES.
- THE FILTER MATERIAL SHALL BE FASTENED SECURELY TO METAL OR WOOD POSTS USING WIRE TIES, OR TO WOOD POSTS WITH 3/4" LONG HEAVY-DUTY STAPLES. THE SILT FENCE GEOTEXTILE SHALL NOT BE STAPLED TO EXISTING TREES.
- WHILE NOT REQUIRED, WIRE MESH FENCE MAY BE USED TO SUPPORT THE GEOTEXTILE. WIRE FENCE SHALL BE FASTENED SECURELY TO THE UP-SLOPE SIDE OF THE POSTS USING HEAVY-DUTY WIRE STAPLES AT LEAST 3/4" LONG. THE WIRE OR HOOD RINGS. THE WIRE SHALL EXTEND INTO THE TRENCH A MINIMUM OF 6" AND SHALL NOT EXTEND MORE THAN 7" ABOVE THE ORIGINAL GROUND SURFACE.

MAINTENANCE REQUIREMENTS

- CONTRACTOR SHALL INSPECT SILT FENCES IMMEDIATELY AFTER EACH RAINFALL, AT LEAST DAILY DURING PROLONGED RAINFALL, AND WEEKLY DURING PERIODS OF NO RAINFALL. DAMAGED, COLLAPSED, UNINTRENCHED OR IMPROPERLY INSTALLED SILT FENCES SHALL BE PROMPTLY REPAIRED OR REPLACED.
- SEDIMENT SHALL BE REMOVED FROM BEHIND SILT FENCES WHEN IT ACCUMULATES TO HALF THE EXPOSED GEOTEXTILE HEIGHT.
- SILT FENCES SHALL BE REMOVED WHEN ADEQUATE VEGETATIVE COVER IS ATTAINED AS APPROVED BY THE CITY.

City of Colorado Springs Stormwater Quality
Figure SF-2 Silt Fence Construction Detail and Maintenance Requirements

Top View of Silt Fence Posts Detail

Refer to 'Top View of Silt Fence Posts Detail'

City of Colorado Springs Stormwater Quality
Figure SF-3 Silt Fence Joint Tying Construction Detail and Maintenance Requirements

SURFACE ROUGHENING NOTES

APPLICATION TECHNIQUES

- STAR STEP GRADING - USED ON SLOPES WITH GRADIENTS BETWEEN 3:1 AND 2:1 AND FOR SOIL CONTAINING A LARGE AMOUNT OF SMALL ROCKS. STARS ARE TO BE WIDE ENOUGH TO WORK WITH STANDARD EARTH MOVING EQUIPMENT.
- GROOVE CUTTING - USED ON SLOPES WITH GRADIENTS BETWEEN 3:1 AND 2:1. GROOVES ARE TO BE AT LEAST 3 INCHES DEEP AND NO MORE THAN 15 INCHES APART.
- TRACKING - USED ON BOLDS WITH HIGHER SAND CONTENT DUE TO COMPACTION BY HEAVY MACHINERY.

MAINTENANCE REQUIREMENTS

- REGULAR INSPECTIONS ARE TO BE MADE OF ALL SURFACE ROUGHENED AREAS.
- SURFACE ROUGHENING IS TO BE REPEATED AS OFTEN AS NECESSARY.
- VEHICLES OR EQUIPMENT IS NOT TO BE DRIVEN OVER AREAS THAT HAVE BEEN ROUGHENED.
- AS SURFACE ROUGHENING IS ONLY A TEMPORARY CONTROL, ADDITIONAL TREATMENTS MAY BE NECESSARY TO MAINTAIN THE SOIL SURFACE IN A ROUGHENED CONDITION.

City of Colorado Springs Stormwater Quality
Figure SR-1 Surface Roughening Construction Detail and Maintenance Requirements

AS-BUILT



ENGINEER'S STATEMENT

STANDARD DETAILS SHOWN WERE REVIEWED AND FOUND TO BE CORRECT FOR APPLICATION ON THIS PROJECT.

Glenn Ellis, P.E.
COLORADO P.E. 38861
FOR AND ON BEHALF OF JR ENGINEERING

May 3, 2018

PREPARED FOR

RON COVINGTON HOMES
13725 STRATHERS ROAD, SUITE 200
COLORADO SPRINGS, CO 80920
CONTACT: RON COVINGTON
719-491-1220

UNLESS SUCH TIME AS THESE DRAWINGS ARE APPLICABLE, THE REVIEWING AGENCIES, JR ENGINEERING APPROVES THEIR USE ONLY FOR THE PURPOSES DESIGNATED BY WRITTEN AUTHORIZATION.

J.R. ENGINEERING
A Weidman Company
Central 303-746-9888 • Olathe 781-500-2560
Fort Collins 970-491-8888 • www.jrengineering.com


ACADEMY VILLAGE FILING NO. 3

GRADING AND EROSION CONTROL DETAILS


SHEET 3 OF 5
JOB NO. 25123.00

NO. REVISION
RAB RAB

H-SCALE N/A
V-SCALE N/A
DATE 05/03/18
DESIGNED BY NJQ
DRAWN BY NJQ
CHECKED BY

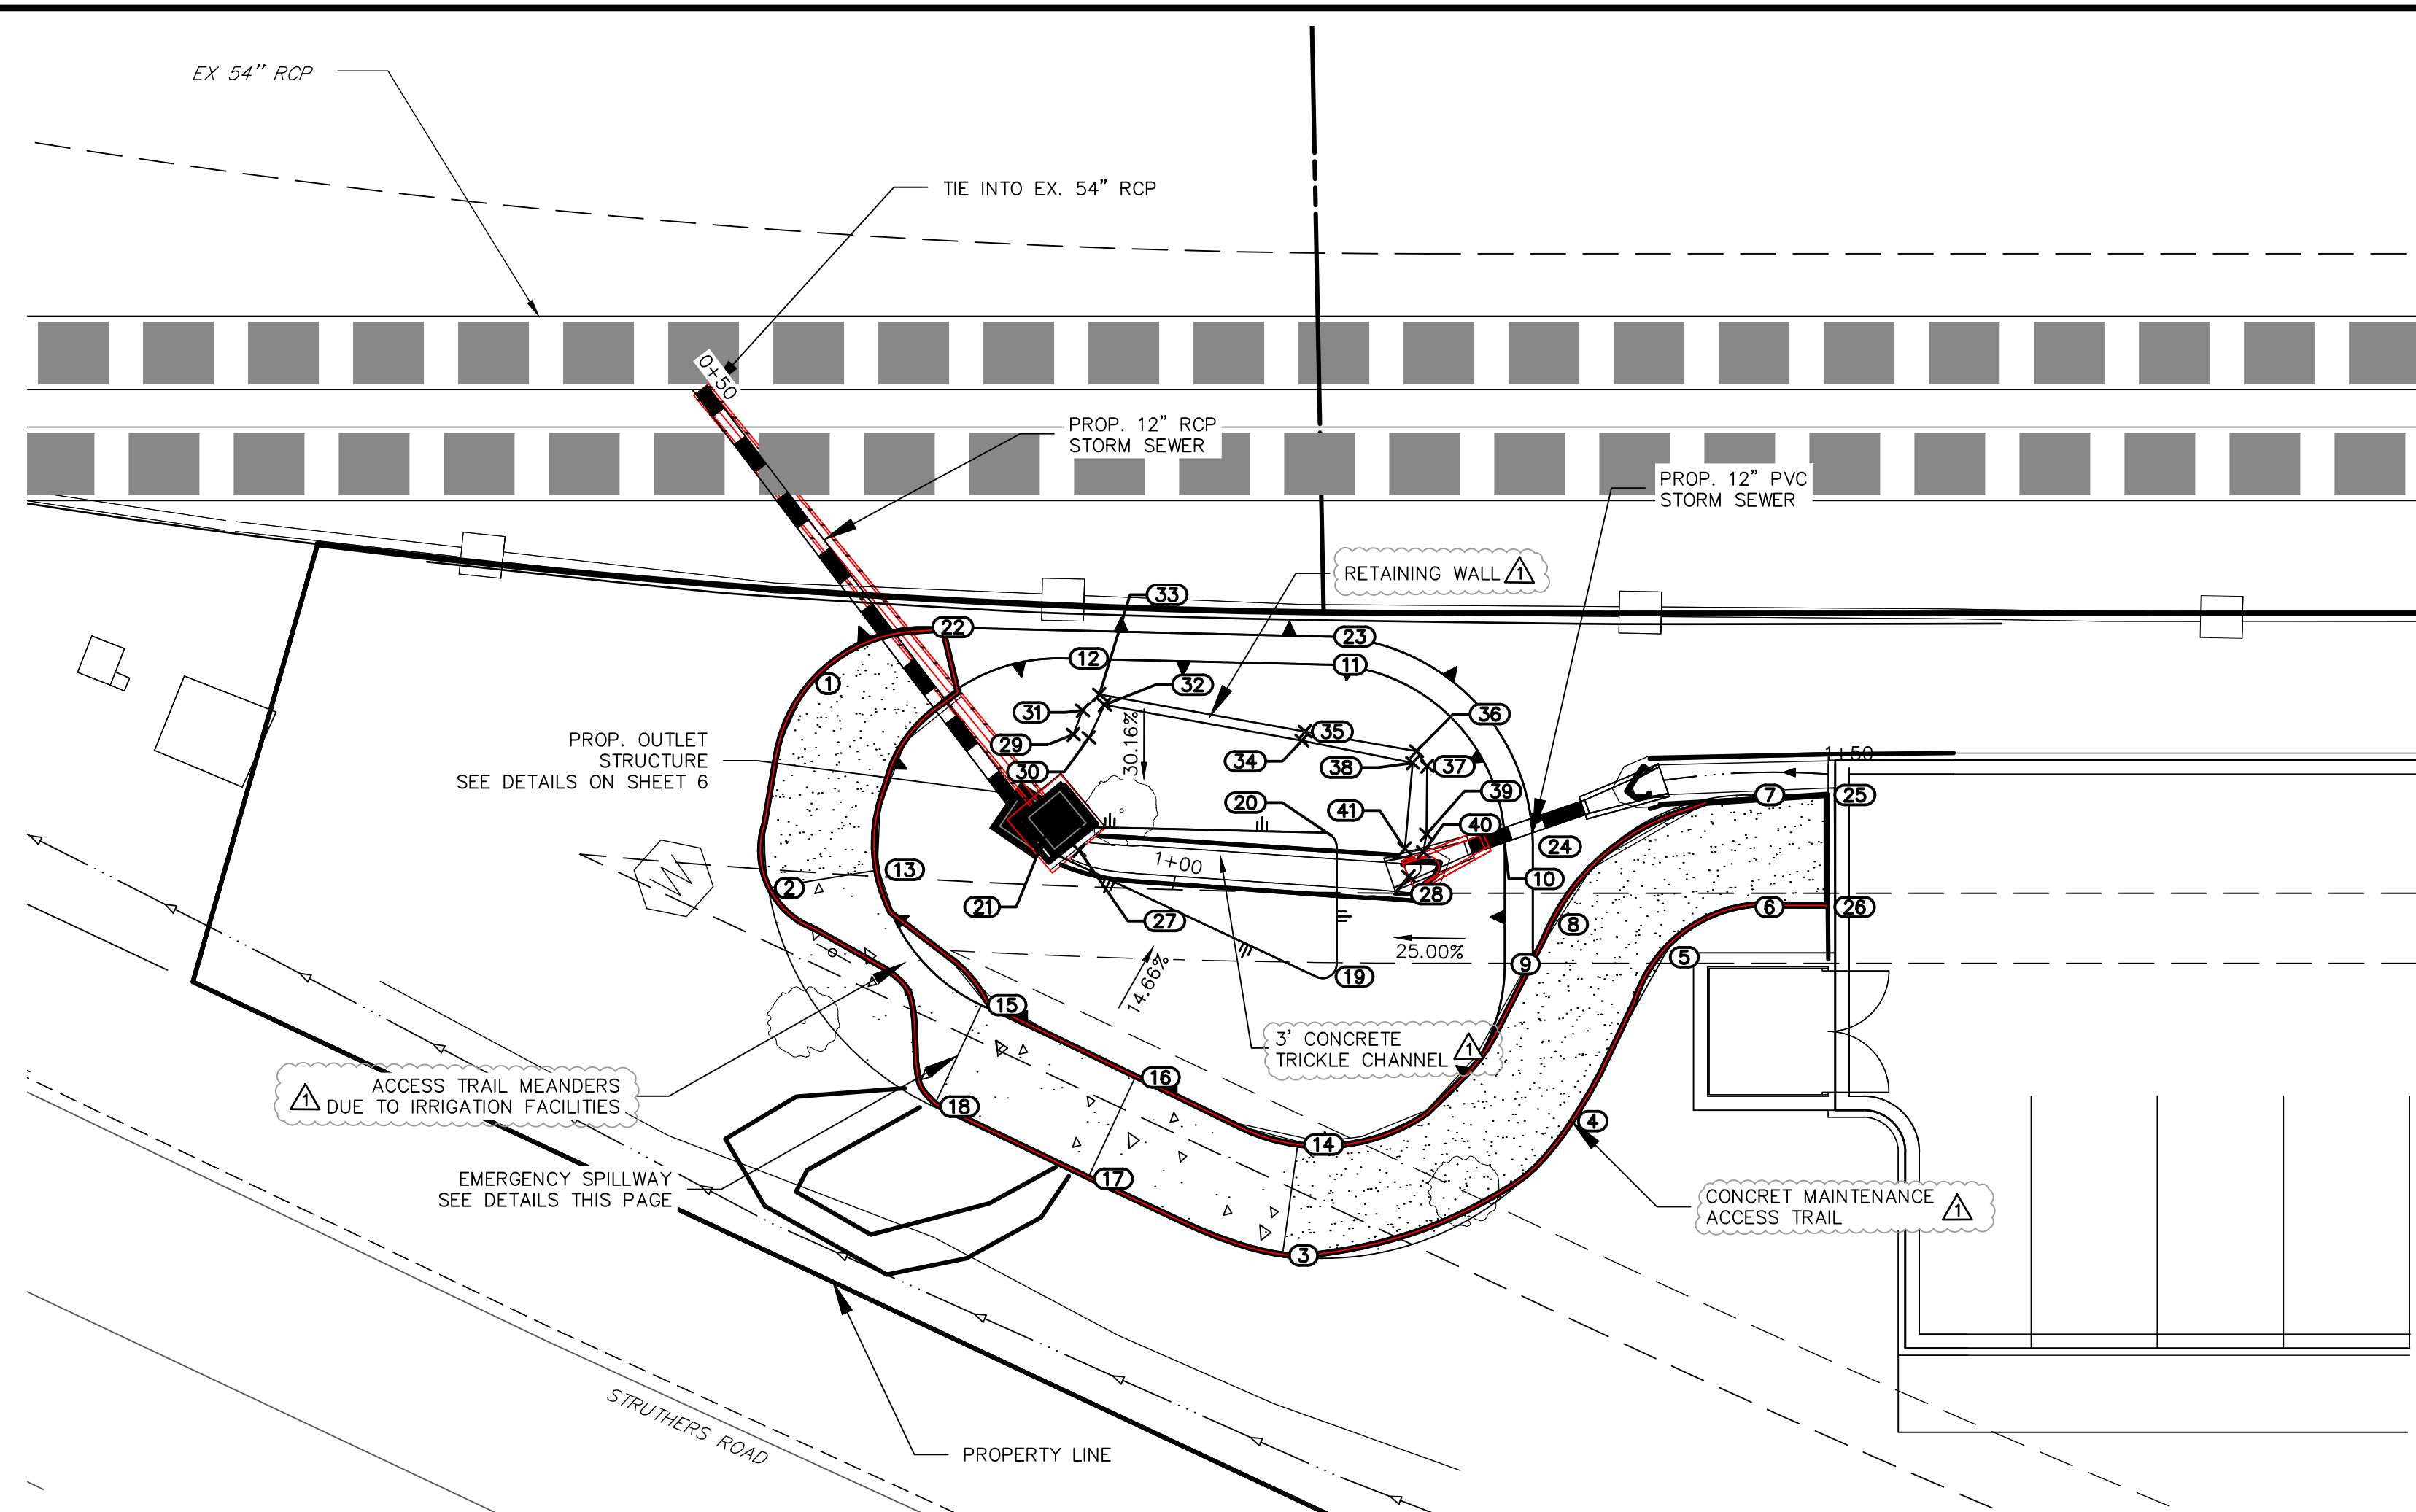



**DP01 PROFILE
STA 0+50.00 TO 1+50.00**

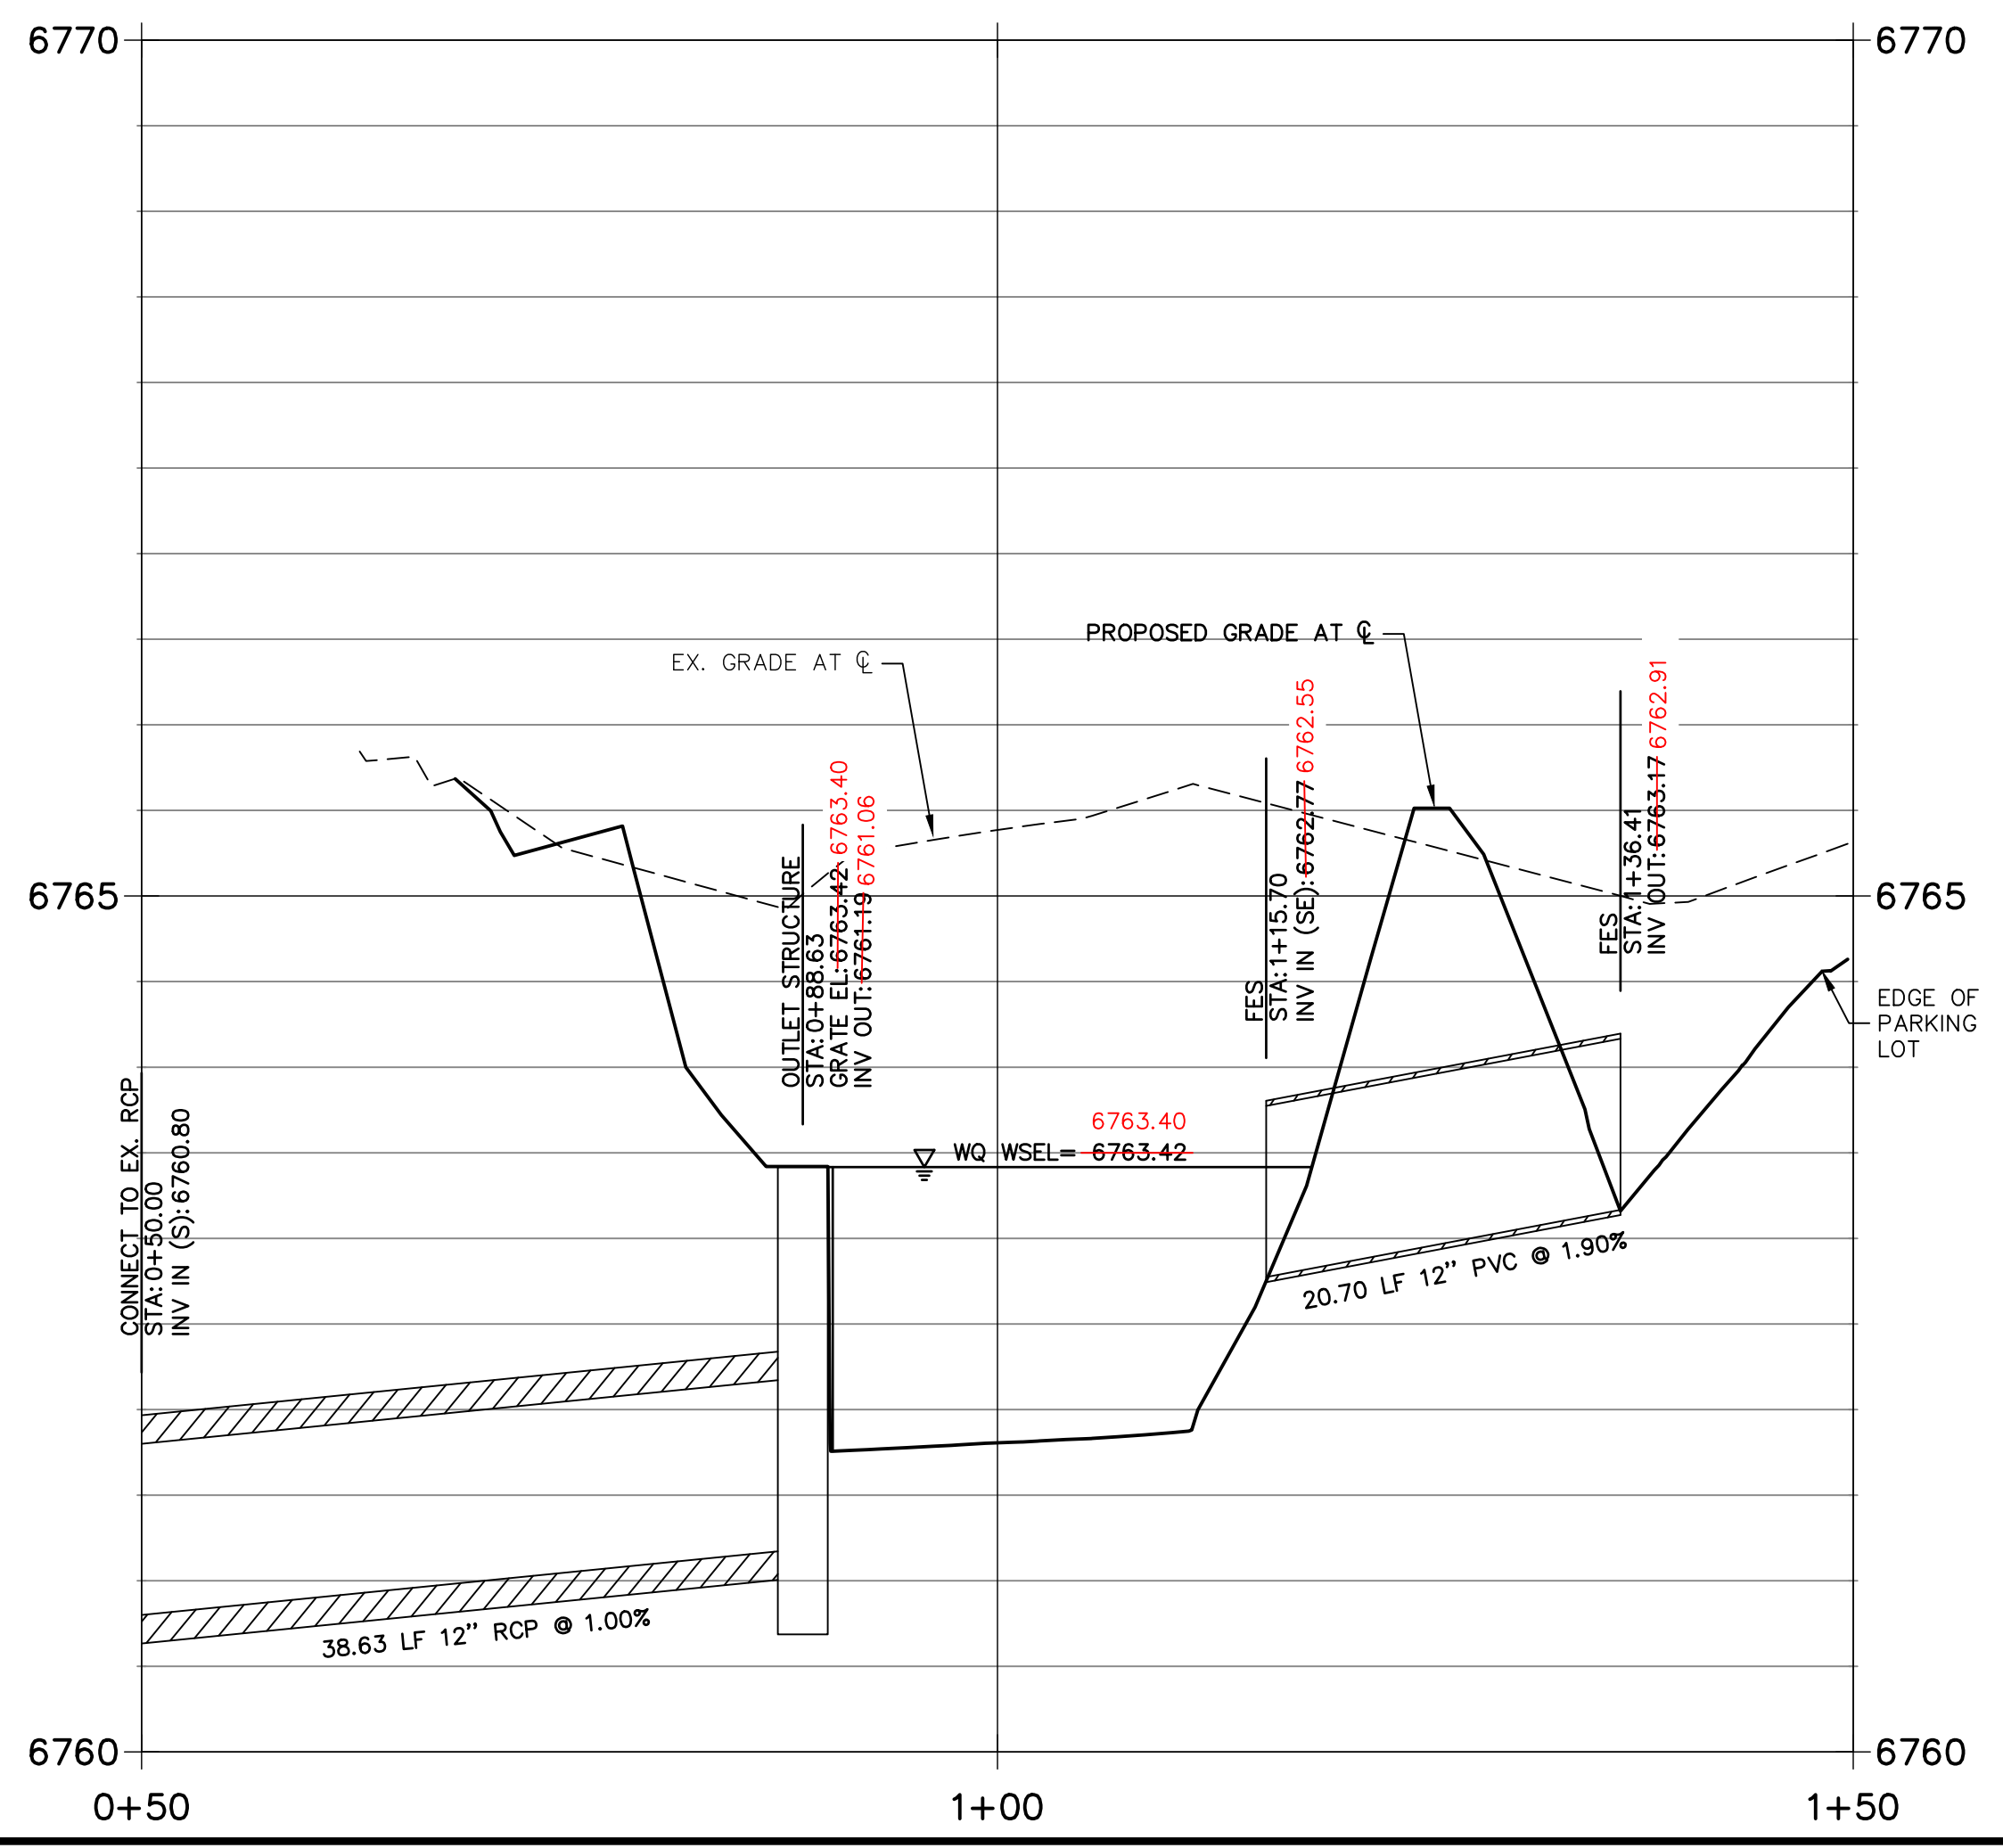

POINT TABULATION			
ID NO.	DESCRIPTION	NORTHING/EASTING	ELEVATION
1	MAINT. PATH	N:6455.12 E:9523.23	6765.15 6765.17
2	MAINT. PATH	N:6447.63 E:9510.37	6764.93 6764.84
3	MAINT. PATH	N:6402.76 E:9515.13	6764.84 6764.53
4	MAINT. PATH	N:6393.71 E:9536.01	6764.84 6764.86
5	MAINT. PATH	N:6396.59 E:9549.12	6764.84 6764.88
6	MAINT. PATH	N:6394.41 E:9555.86	6764.84 6764.93
7	MAINT. PATH	N:6399.72 E:9561.84	6764.83 6764.46
8	MAINT. PATH	N:6404.06 E:9545.61	6765.00 6764.80
9	TOP	N:6404.71 E:9541.23	6765.30 6764.56
10	TOP	N:6410.29 E:9547.50	6765.51 6764.52
11	TOP	N:6428.41 E:9548.79	6765.51 6765.31
12	TOP	N:6442.80 E:9536.60	6765.41 6764.99
13	TOP	N:6442.59 E:9516.58	6764.93 6764.59
14	TOP	N:6407.21 E:9521.78	6764.84 6764.61
15	OVERFLOW	N:6430.71 E:9514.21	6763.49 6763.58
16	OVERFLOW	N:6419.07 E:9517.66	6763.49 6763.48
17	OVERFLOW	N:6416.80 E:9509.99	6763.49 6763.50
18	OVERFLOW	N:6428.44 E:9506.54	6763.49 6763.50
19	TOE	N:6413.50 E:9532.23	6761.00
20	TOE	N:6420.02 E:9539.88	6761.96
21	TOE	N:6435.32 E:9526.24	6761.80
22	TOP	N:6451.61 E:9531.76	6765.28 6765.33
23	TOP	N:6429.71 E:9550.31	6765.51 6765.48
24	TOP	N:6408.80 E:9548.83	6765.51 6764.72
25	MAINT. PATH	N:6395.50 E:9565.59	6764.84 6765.00
26	MAINT. PATH	N:6390.18 E:9559.61	6764.84 6765.20

POINT TABULATION			
ID NO.	DESCRIPTION	NORTHING/EASTING	ELEVATION
27	TC	N:6432.83 E:9527.12	6761.82
28	TC	N:6413.99 E:9541.35	6762.72
29	TOW	N:6438.63 E:9533.02	6762.68
30	BOW	N:6437.64 E:9533.59	6762.44
31	TOW	N:6439.28 E:9534.75	6763.65
32	BOW	N:6438.37 E:9536.09	6762.40
33	TOW	N:6439.14 E:9536.41	6763.76
34	BOW	N:6426.15 E:9543.54	6762.71
35	TOW	N:6426.40 E:9544.18	6764.18
36	TOW	N:6419.53 E:9548.42	6764.15
37	TOW	N:6418.25 E:9548.12	6764.15
38	BOW	N:6419.18 E:9547.60	6763.01
39	TOW	N:6415.06 E:9544.45	6764.50
40	TOW	N:6414.38 E:9543.37	6763.86
41	BOW	N:6415.52 E:9542.65	6763.23

THE LOCATIONS OF EXISTING ABOVE GROUND AND UNDERGROUND UTILITIES ARE SHOWN IN AN APPROXIMATE WAY ONLY. THE CONTRACTOR SHALL DETERMINE THE EXACT LOCATION OF ALL EXISTING UTILITIES BEFORE COMMENCING WORK. THE CONTRACTOR SHALL BE FULLY RESPONSIBLE FOR ANY AND ALL DAMAGES WHICH MIGHT BE CAUSED BY HIS FAILURE TO EXACTLY LOCATE AND PRESERVE ANY AND ALL ABOVE GROUND AND UNDERGROUND UTILITIES.

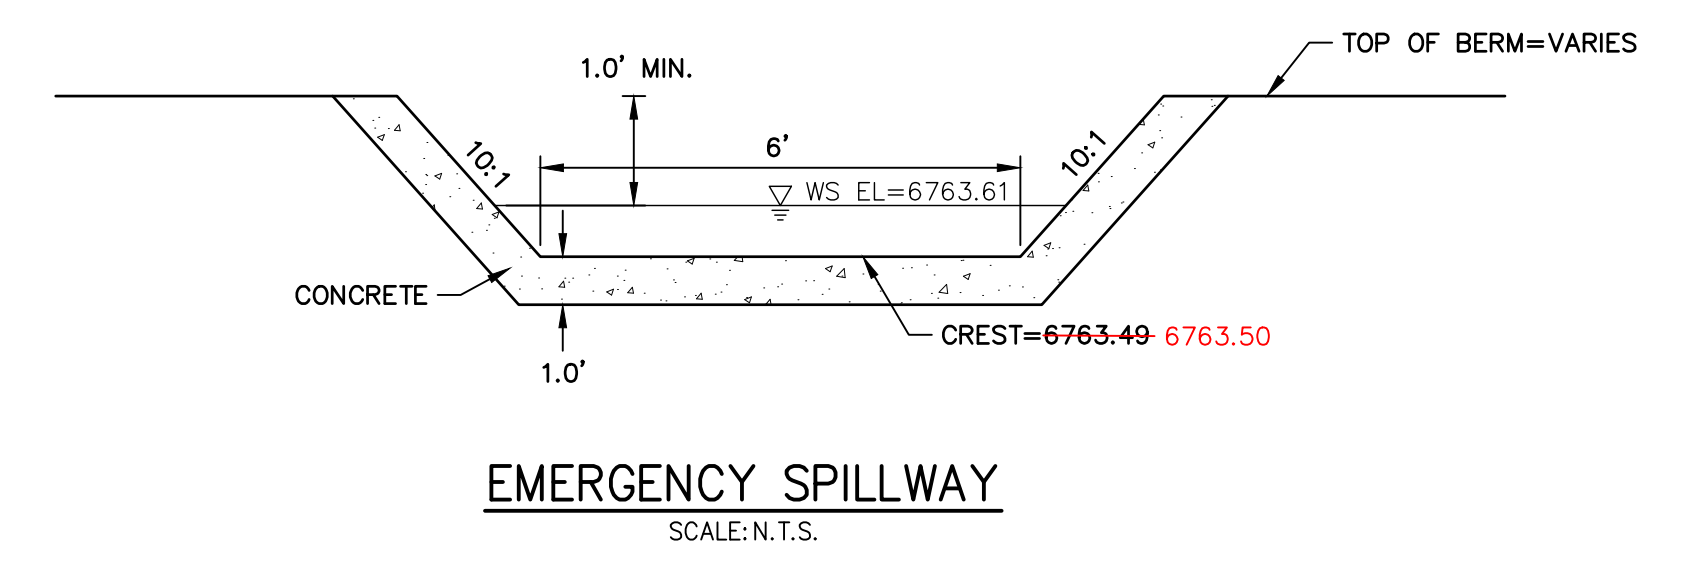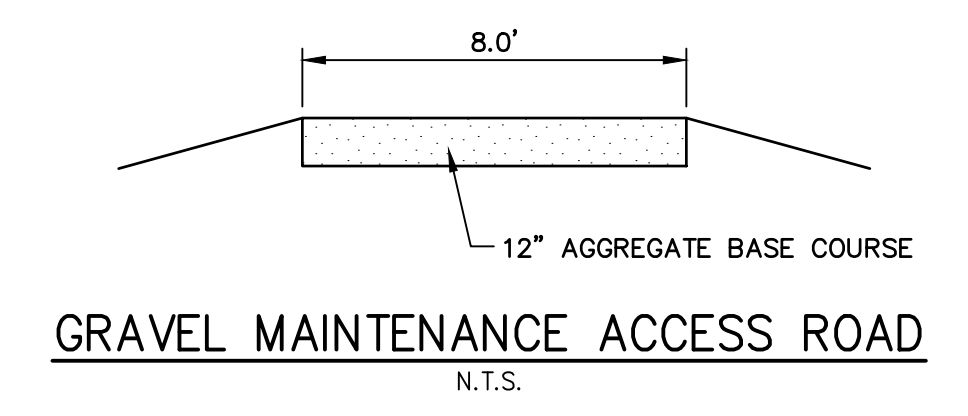


AS-BUILT

RECORD DRAWING STATEMENT

RECORD DRAWINGS HAVE BEEN PREPARED UNDER MY DIRECT SUPERVISION. AS-BUILT INFORMATION WAS SUPPLIED BY THE CONTRACTOR & SURVEYOR.

Glenn D. Ellis
 GLENN D. ELLIS, P.E.
 COLORADO P.E. 38861
 FOR AND ON BEHALF OF JR ENGINEERING, LLC

38861 10-5-21
 DATE

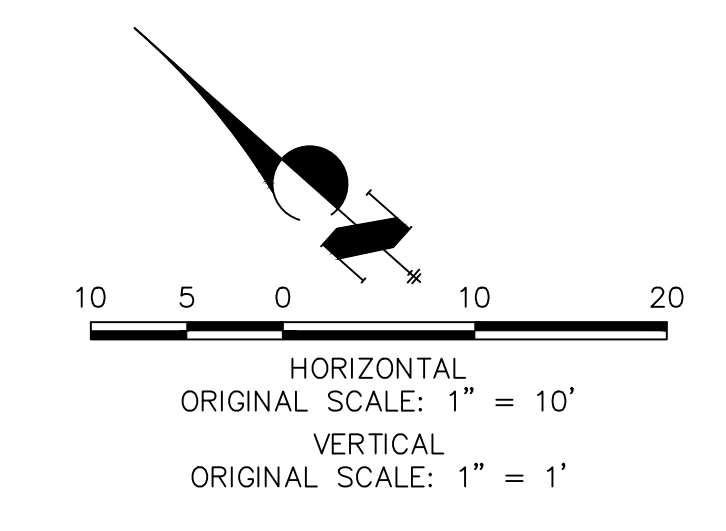

811
 Know what's below.
 Call before you dig.

UNTIL SUCH TIME AS THESE DRAWINGS ARE APPROVED BY THE APPROPRIATE REVIEWING AGENCIES, JR ENGINEERING APPROVES THEIR USES DESIGNATED BY WRITTEN AUTHORIZATION.

PREPARED FOR
RON COVINGTON HOMES
 13725 STRUTHERS ROAD, SUITE 200
 COLORADO SPRINGS, CO 80920
 RON COVINGTON
 719-491-1220
 RCOVINGTON@COVINGTONHOME.COM

J.R. ENGINEERING
 A Westman Company
 Centennial 303-740-9888 • Colorado Springs 719-583-2583
 Fort Collins 970-491-9888 • www.jrengineering.com







BY	DATE	REVISION
PL	07/18/22	RECORD DRAWING

H-SCALE: 1"=10'
 V-SCALE: 1"=1'

DESIGNED BY: AJH
 DRAWN BY: RAB
 CHECKED BY:

ACADEMY VILLAGE FILING NO. 3
 POND GRADING PLAN

SHEET 5 OF 6
 JOB NO. 25123.00

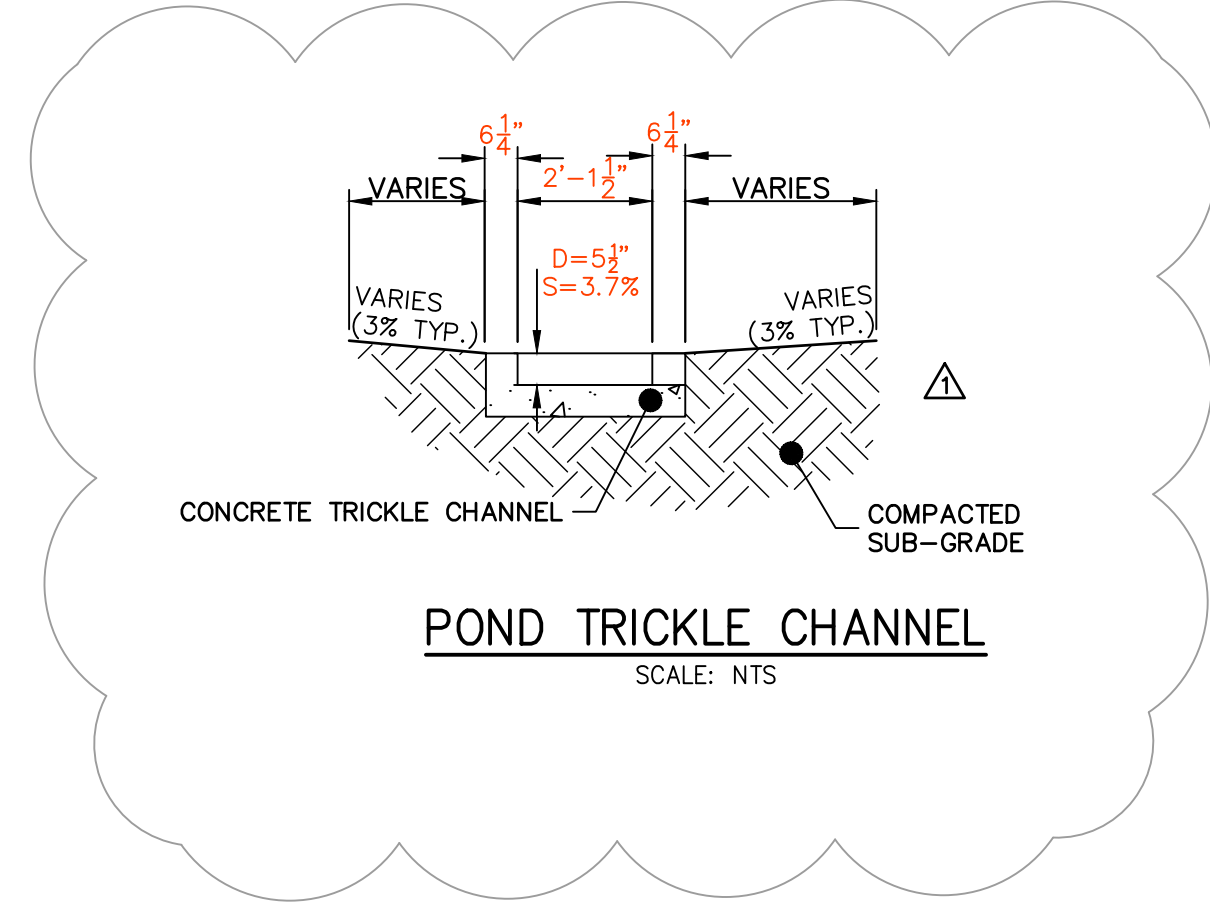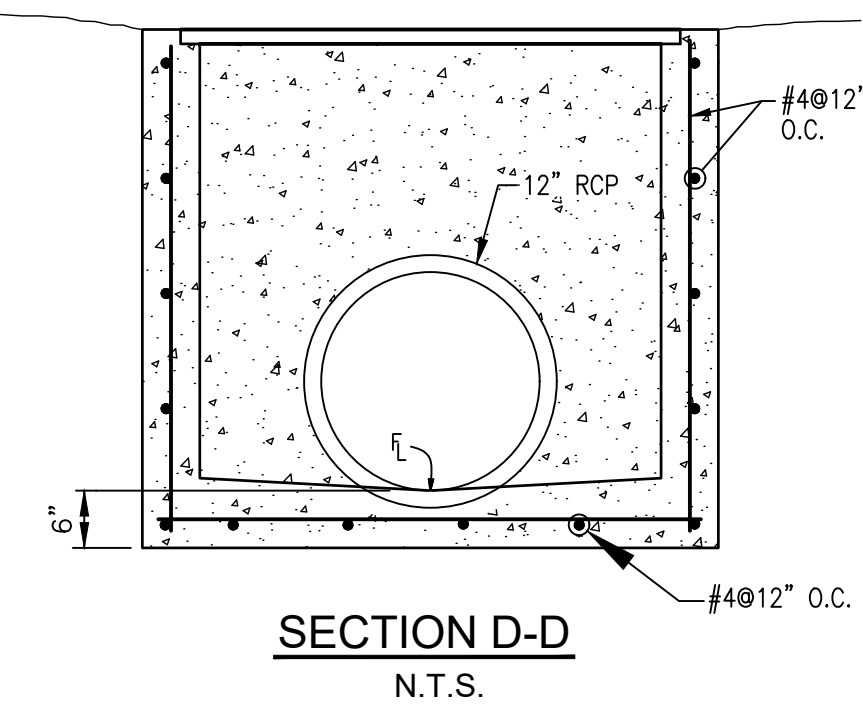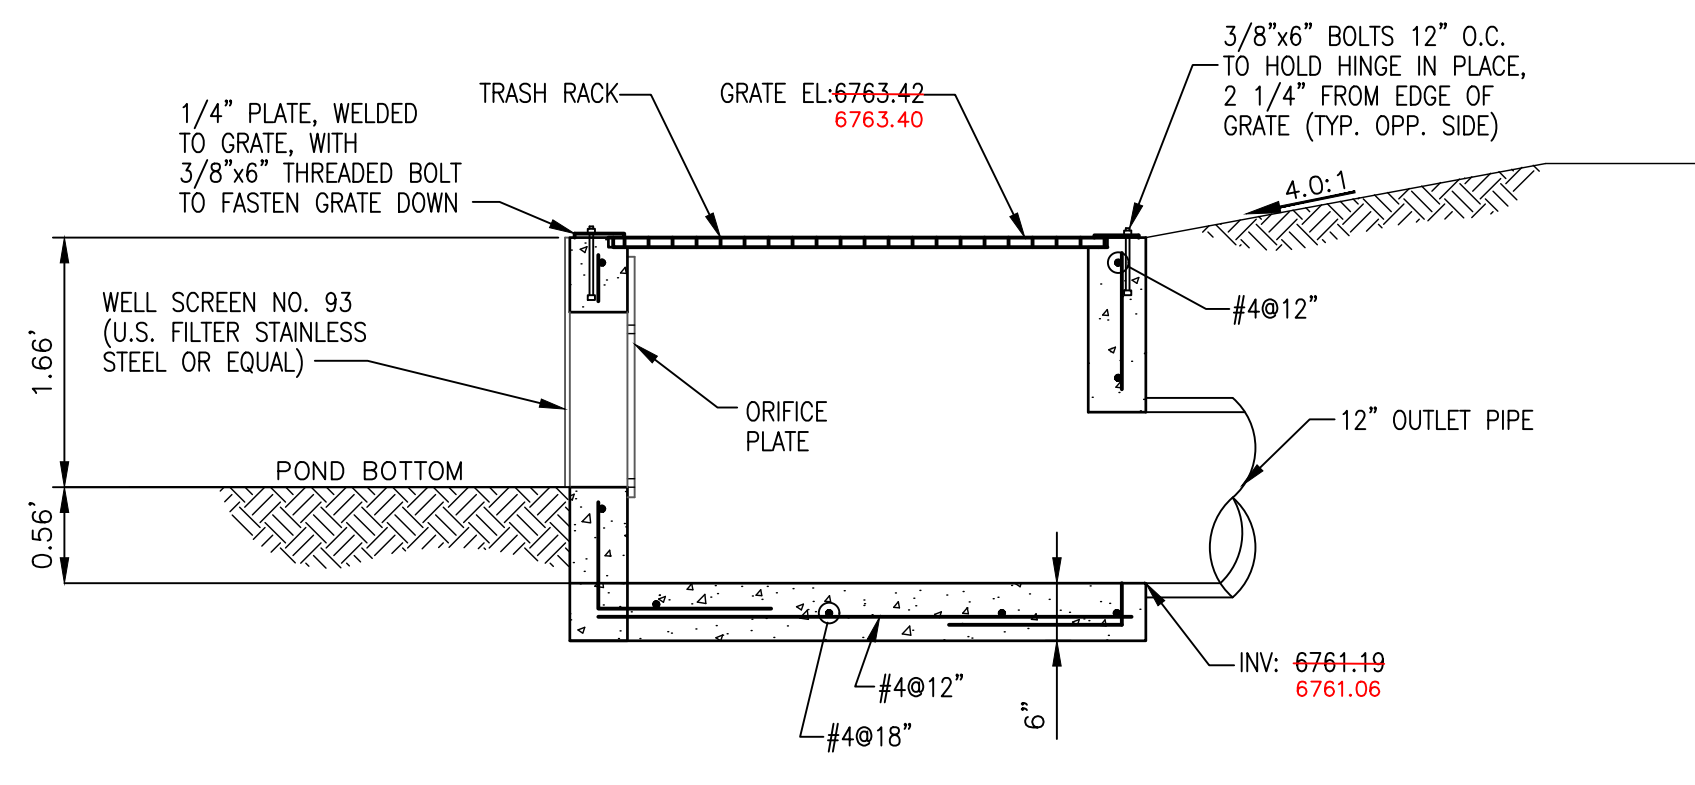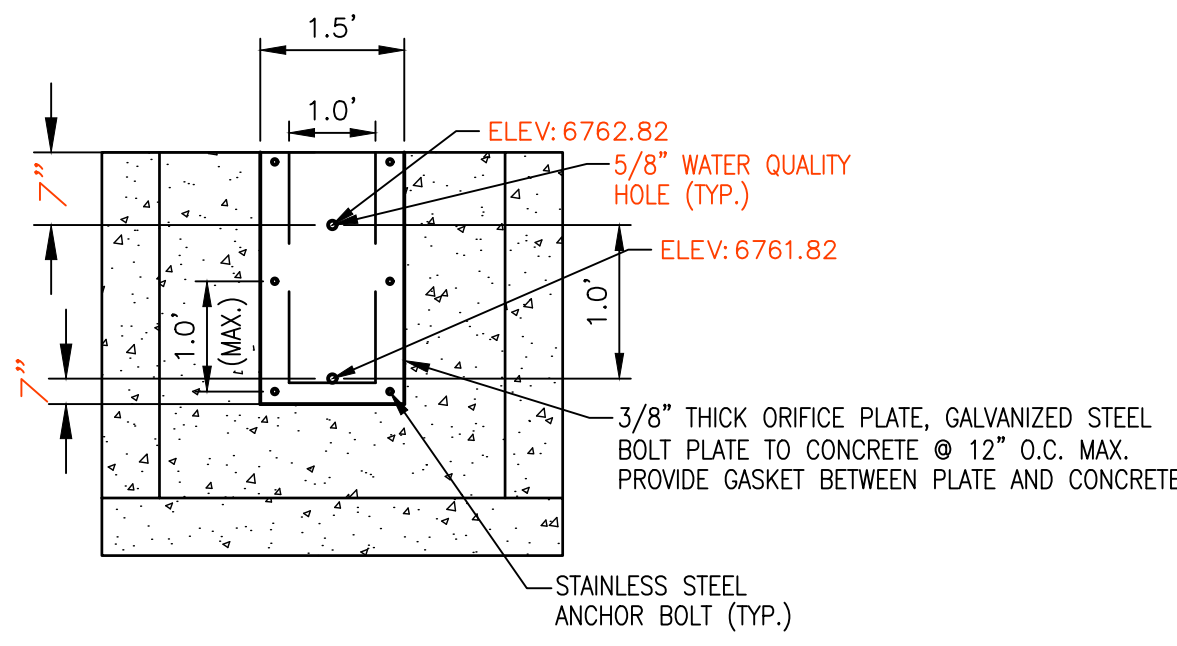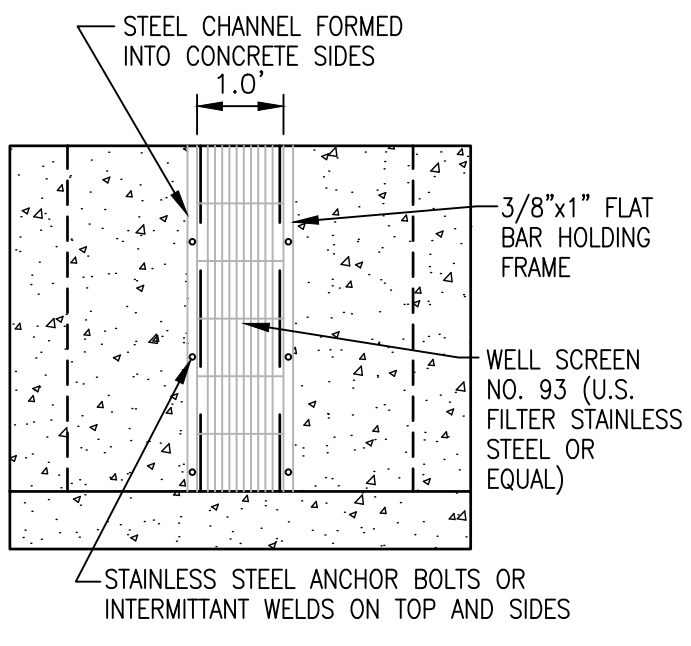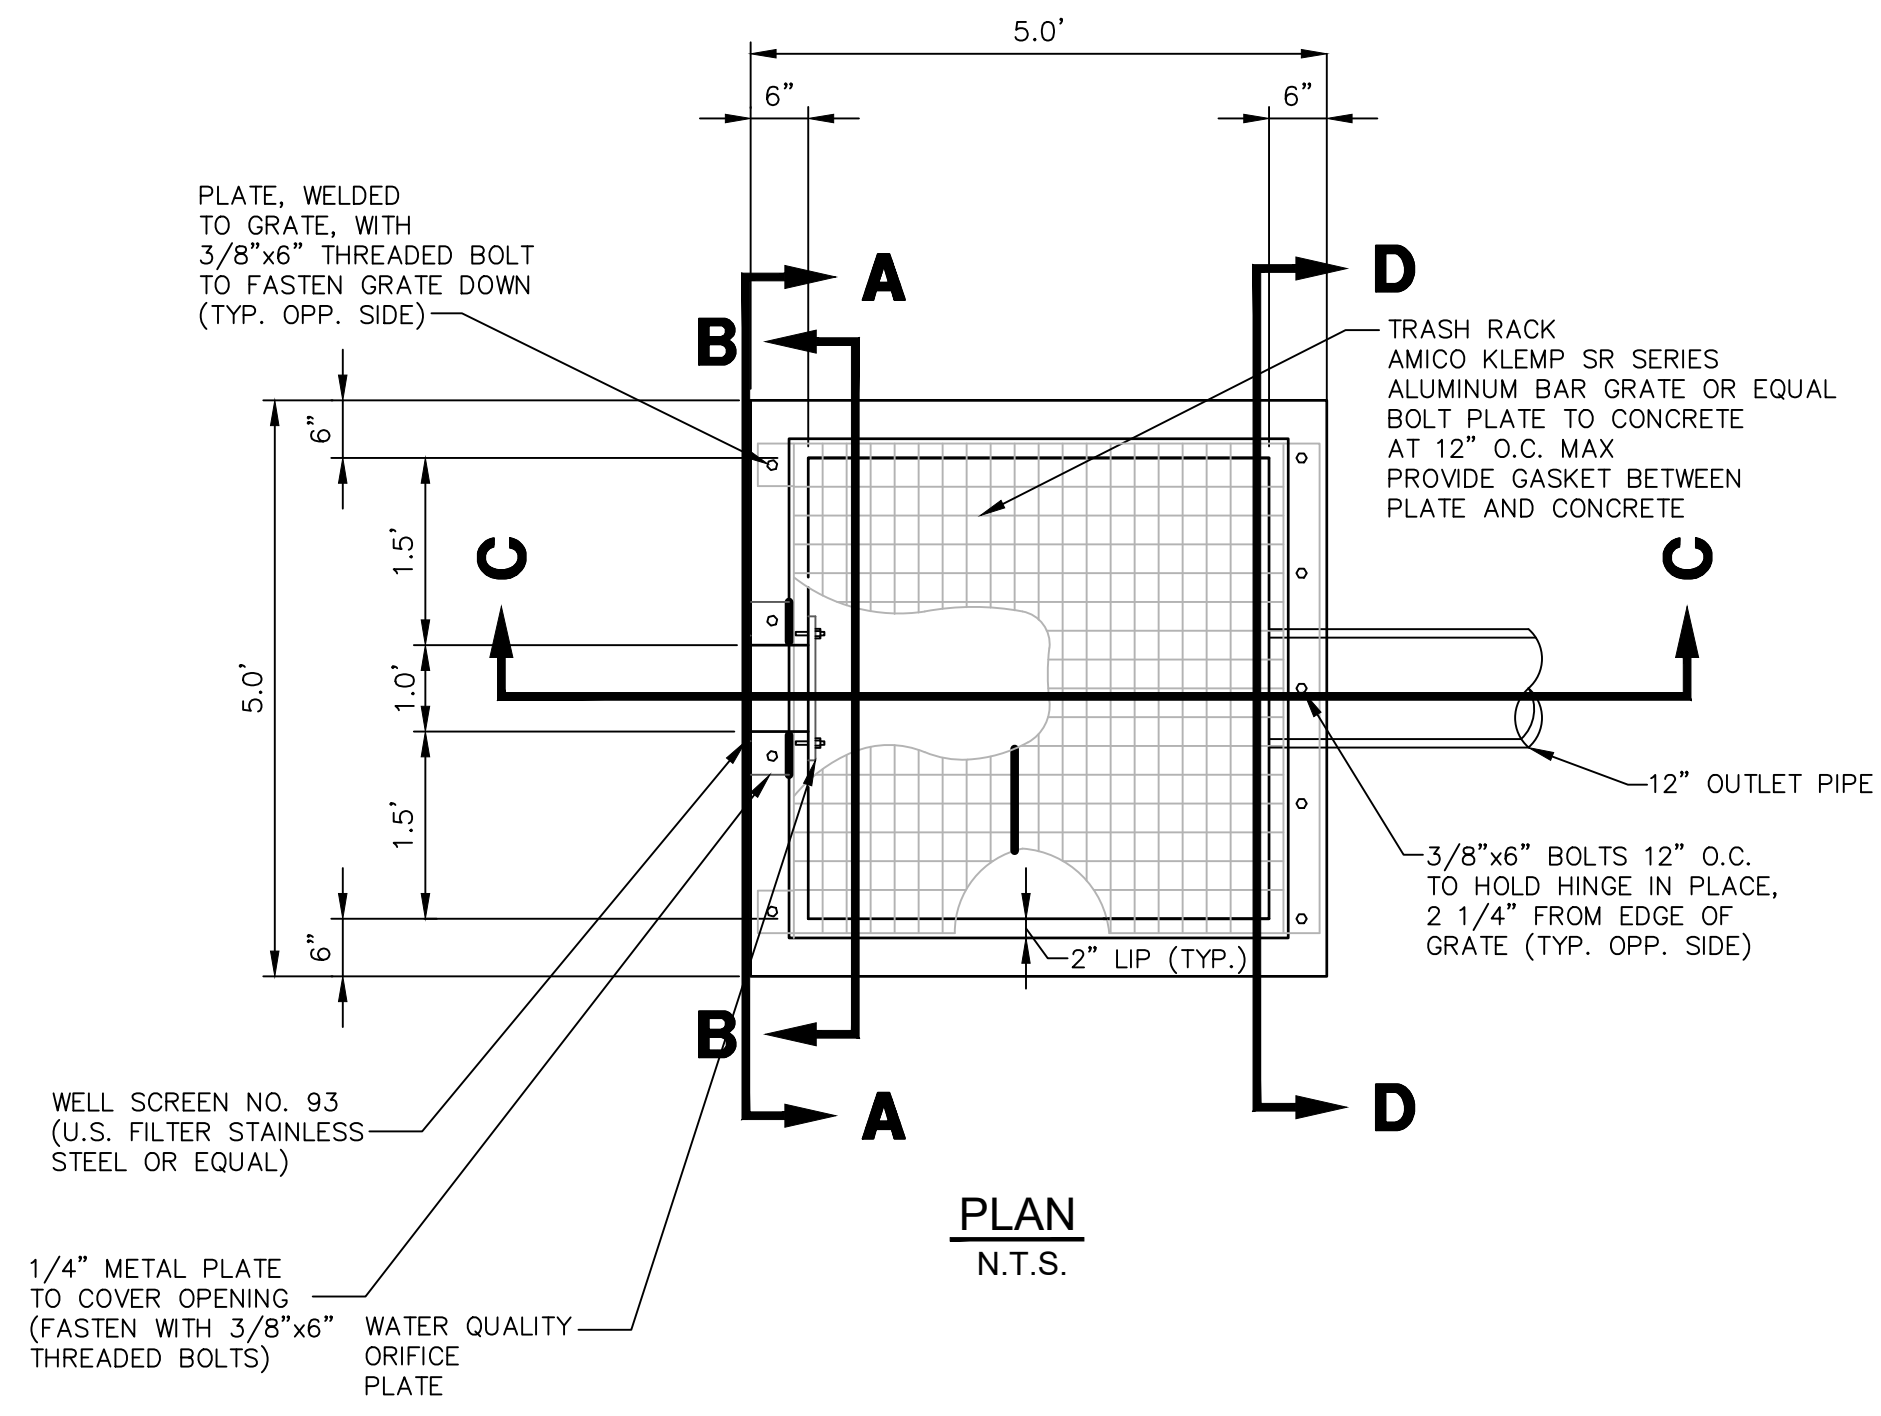

AS-BUILT

RECORD DRAWING STATEMENT


RECORD DRAWINGS HAVE BEEN PREPARED UNDER MY DIRECT SUPERVISION. AS-BUILT INFORMATION WAS SUPPLIED BY THE CONTRACTOR & SURVEYOR.

Glenn D. Ellis

GLENN D. ELLIS, P.E.
COLORADO P.E. 38861
FOR AND ON BEHALF OF JR ENGINEERING, L.L.C.

38861 10/25-21

DATE

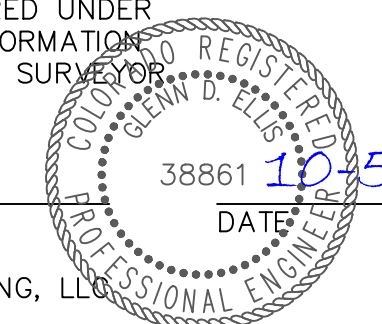

ACADEMY VILLAGE FILING NO. 3	OUTLET STRUCTURE DETAILS	BY	DATE
		PL	07/18/22
SHEET 6 OF 6	JOB NO. 25123.00	No. REVISION	
		RAB	1
		NTS	05/03/18
		DESIGNED BY	AJH
		DRAWN BY	RAB
		CHECKED BY	

UNTIL SUCH TIME AS THESE DRAWINGS ARE APPROVED BY THE APPROPRIATE REVIEWING AGENCIES, OR ENGINEERING APPROVES, THEIR USE IS DESIGNATED BY WRITTEN AUTHORIZATION.

PREPARED FOR
RON COVINGTON HOMES
13725 SIRUTHERS ROAD, SUITE 200
COLORADO SPRINGS, CO 80920
RON COVINGTON
719-491-1220
RCOVINGTON@COVINGTONHOME.COM

J.R. ENGINEERING
A Westman Company
Central 303-740-9888 • Colorado Springs 719-583-2583
Fort Collins 970-491-9888 • www.jrengineering.com

X:\2510000\25123000\Drawings\PP\Presentations\Pond\AcademyVillage\2022-07-18_25123000RPI.pond AB.dwg POND DETAILS (3) 7/18/2022 4:08:31 PM, CS