

ACADEMY VILLAGE FILING NO. 3

A VACATION AND RESUBDIVISION OF LOT 4, "ACADEMY VILLAGE FILING NO. 2", BEING A PORTION OF THE SOUTHEAST QUARTER OF SECTION 1, TOWNSHIP 12 SOUTH, RANGE 67 WEST OF THE 6TH P.M., COUNTY OF EL PASO, STATE OF COLORADO

Add traffic impact fee note and when it will be paid

NOTES:

- - Indicates survey monument set with a #4 rebar with Surveyor's Cap, PLS No. 20681.
 - - Indicates survey monument found as noted.
- This survey does not constitute a title search by LDC, Inc. to determine ownership or easements of record. For all information regarding easements, rights-of-way and title of record, LDC, Inc. relied upon a Commitment for Title Insurance, prepared by LAND TITLE GUARANTEE COMPANY on behalf of OLD REPUBLIC NATIONAL TITLE INSURANCE COMPANY, Order No. SC55062451 dated March 17, 2017 at 5:00 p.m.
- The approval of this Resubdivision Plat vacates all prior plats for the area described by this resubdivision plat.
- The El Paso County Development Services Department must be contacted prior to the establishment of any new driveway access to and from Lot 2 via the existing Struthers Road curb cut utilizing a Common Use, Access and Parking Easement as defined by document (Reception No. provide a copy of this easement El Paso County, Colorado records).


Incorrect name
- Water and wastewater service for this Resubdivision has been (Lot 1) and will be (Lot 2) provided by the DONALA WATER AND SANITATION DISTRICT subject to the District's rules and specifications.

The owner applied for a waiver of El Paso County's requirement that a 300-year supply of water be established, and such waiver was granted by the Board of County Commissioners with respect to a portion of the water supply provided by DONALA. Additional information can be found in the Resubdivision file in the records of El Paso County Planning and Community Development.
- Basis of Bearings: All bearings are based on that portion of the Easterly line of Lot 1 of this Resubdivision, monumented as shown and assumed to bear S00°21'33"E, a distance of 120.00 feet.
- Easements are as shown hereon with the sole responsibility for maintenance being vested with the individual property owners.
- All structural foundations shall be located and designed by a Professional Engineer, currently registered in the State of Colorado.
- FEDERAL EMERGENCY MANAGEMENT AGENCY, Flood Insurance Rate Map Numbers 08041C0287 F and 08041C0290 F, effective date March 17, 1997, indicates the area in the vicinity of this parcel of land to be a Zone X (area determined to be out of the 500 year flood plain).
- (13725) - Indicates property address. The addresses exhibited on this plat are for informational purposes only. They are not the legal description and are subject to change.
- All property owners are responsible for maintaining proper storm water drainage in and through their property.
- The following reports have been submitted and are on file at the El Paso County Development Services Department:

COMPLETE NOTE
- Correct Name

Services Department:
- Mailboxes shall be installed in accordance with all El Paso County Department of Transportation and United States Postal Service regulations.
- NOTICE: This property may be impacted by noise and other effects of flight by aircraft used in the United States Air Force Academy's Airmanship Program. In conjunction with this notice, the Grantor agrees to waive and release any right or cause of action which it now has or may have in the future against Grantee, the United States Air Force Academy, its successors and assigns, due to noise and other effects by operation of such aircraft. This notice shall be in effect until the Air Force Academy shall cease to be used for training purposes, or all airports on the Air Force Academy shall cease to be actively used. This notice shall run with the land.
- This property is subject to a Private Detention Pond Maintenance Agreement recorded at Reception No. _____, El Paso County, Colorado records.

No lot or interest therein, shall be sold, conveyed, or transferred whether by deed or by contract, nor shall building permits be issued, until and unless either the required public and common development improvements have been constructed and completed and preliminarily accepted in accordance with the Subdivision Improvements Agreement between the applicant/owner and El Paso County as recorded under Reception Number _____ in the Office of the Clerk and Recorder of El Paso County, Colorado or, in the alternative, other collateral is provided to make provision for the completion of said improvements in accordance with the El Paso County Land Development Code and Engineering Criteria Manual. Any such alternative collateral must be approved by the Board of County Commissioners or, if permitted by the Subdivision Improvements Agreement, by the Development Services Department Director and meet the policy and procedure requirements of El Paso County prior to the release by the County of any lots for sale, conveyance or transfer. This plat restriction may be removed or rescinded by the Board of County Commissioners or, if permitted by the Subdivision Improvements Agreement, by the Development Services Department Director upon either approval of an alternative form of collateral or completion and preliminary acceptance by the El Paso Board of County Commissioners of all improvements required to be constructed and completed in accordance with said Subdivision Improvements Agreement. The partial release of lots for sale, conveyance or transfer may only be granted in accordance with any planned partial release of lots authorized by the Subdivision Improvements Agreement.

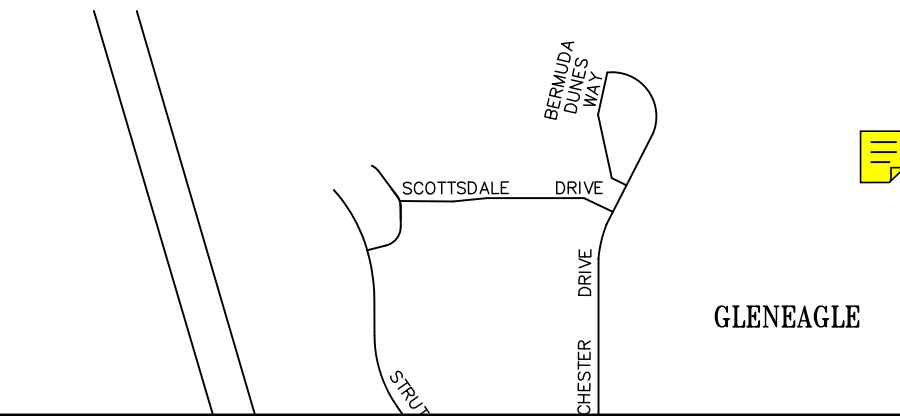

VICINITY MAP N.T.S.

Add the standard SIA note

Are there CCR's? If so add note.

KNOW ALL MEN BY THESE PRESENTS:

That PEOPLES NATIONAL BANK COLORADO, being the owner of the following described tract of land to wit:
A portion of the Southeast Quarter of Section 1, Township 12 South, Range 67 West of the 6th P.M., situate in El Paso County, Colorado, described as follows:
Lot 4, ACADEMY VILLAGE FILING NO. 2 (Reception No. 99133453, El Paso County, Colorado records);
Containing 2.935 acres, more or less.

DEDICATION:

The above owner has caused said tract of land to be surveyed, vacated and resubdivided into lots and easements as shown on the accompanying plat, which plat is drawn to a fixed scale as indicated thereon and accurately sets forth the boundaries and dimensions of said tract and the locations of said lots and easements, and which tract as resubdivided shall be known as ACADEMY VILLAGE FILING NO. 3, El Paso County, Colorado.

IN WITNESS WHEREOF:

The aforementioned, PEOPLES NATIONAL BANK COLORADO, has executed this instrument this _____ day of _____ 20____ A.D.

PEOPLES NATIONAL BANK COLORADO

By: _____
Title: Chief Executive Officer

NOTARIAL:

STATE OF COLORADO }
COUNTY OF EL PASO }
The above and aforementioned was acknowledged before me this _____ day of _____ 20____ A.D., by Brendan Zahl, Chief Executive Officer of PEOPLES NATIONAL BANK COLORADO.

Witness my hand and seal _____
My commission expires _____

President Add Director, Planning and Community Development Department to the signature block. Both signatures are required.

BOARD OF COUNTY COMMISSIONERS CERTIFICATE:

This plat for J. T. RANCH was approved for filing by the El Paso County, Colorado Board of County Commissioners on the _____ day of _____, 20____, subject to any notes specified hereon and any conditions included in the resolution of approval. The dedications of land to the public streets and easements are accepted, but the public improvements thereon will not become the maintenance responsibility of El Paso County until preliminary acceptance of the public improvements in accordance with the requirements of the Land Development Code and Engineering Criteria Manual, and the Subdivision Improvements Agreement.


RECORDING:

STATE OF COLORADO }
COUNTY OF EL PASO }
I hereby certify that this instrument was filed for record in my office at _____ o'clock _____ M., this _____ day of _____, 20____ A.D., and is duly recorded under Reception No. _____ of the records of El Paso County, Colorado.
Chuck Broerman, Recorder

SURCHARGE: _____ BY: _____ Deputy
FEE: _____


FEEES:

Park Fee: _____ Drainage Fee: _____
School Fee: _____ Bridge Fee: _____

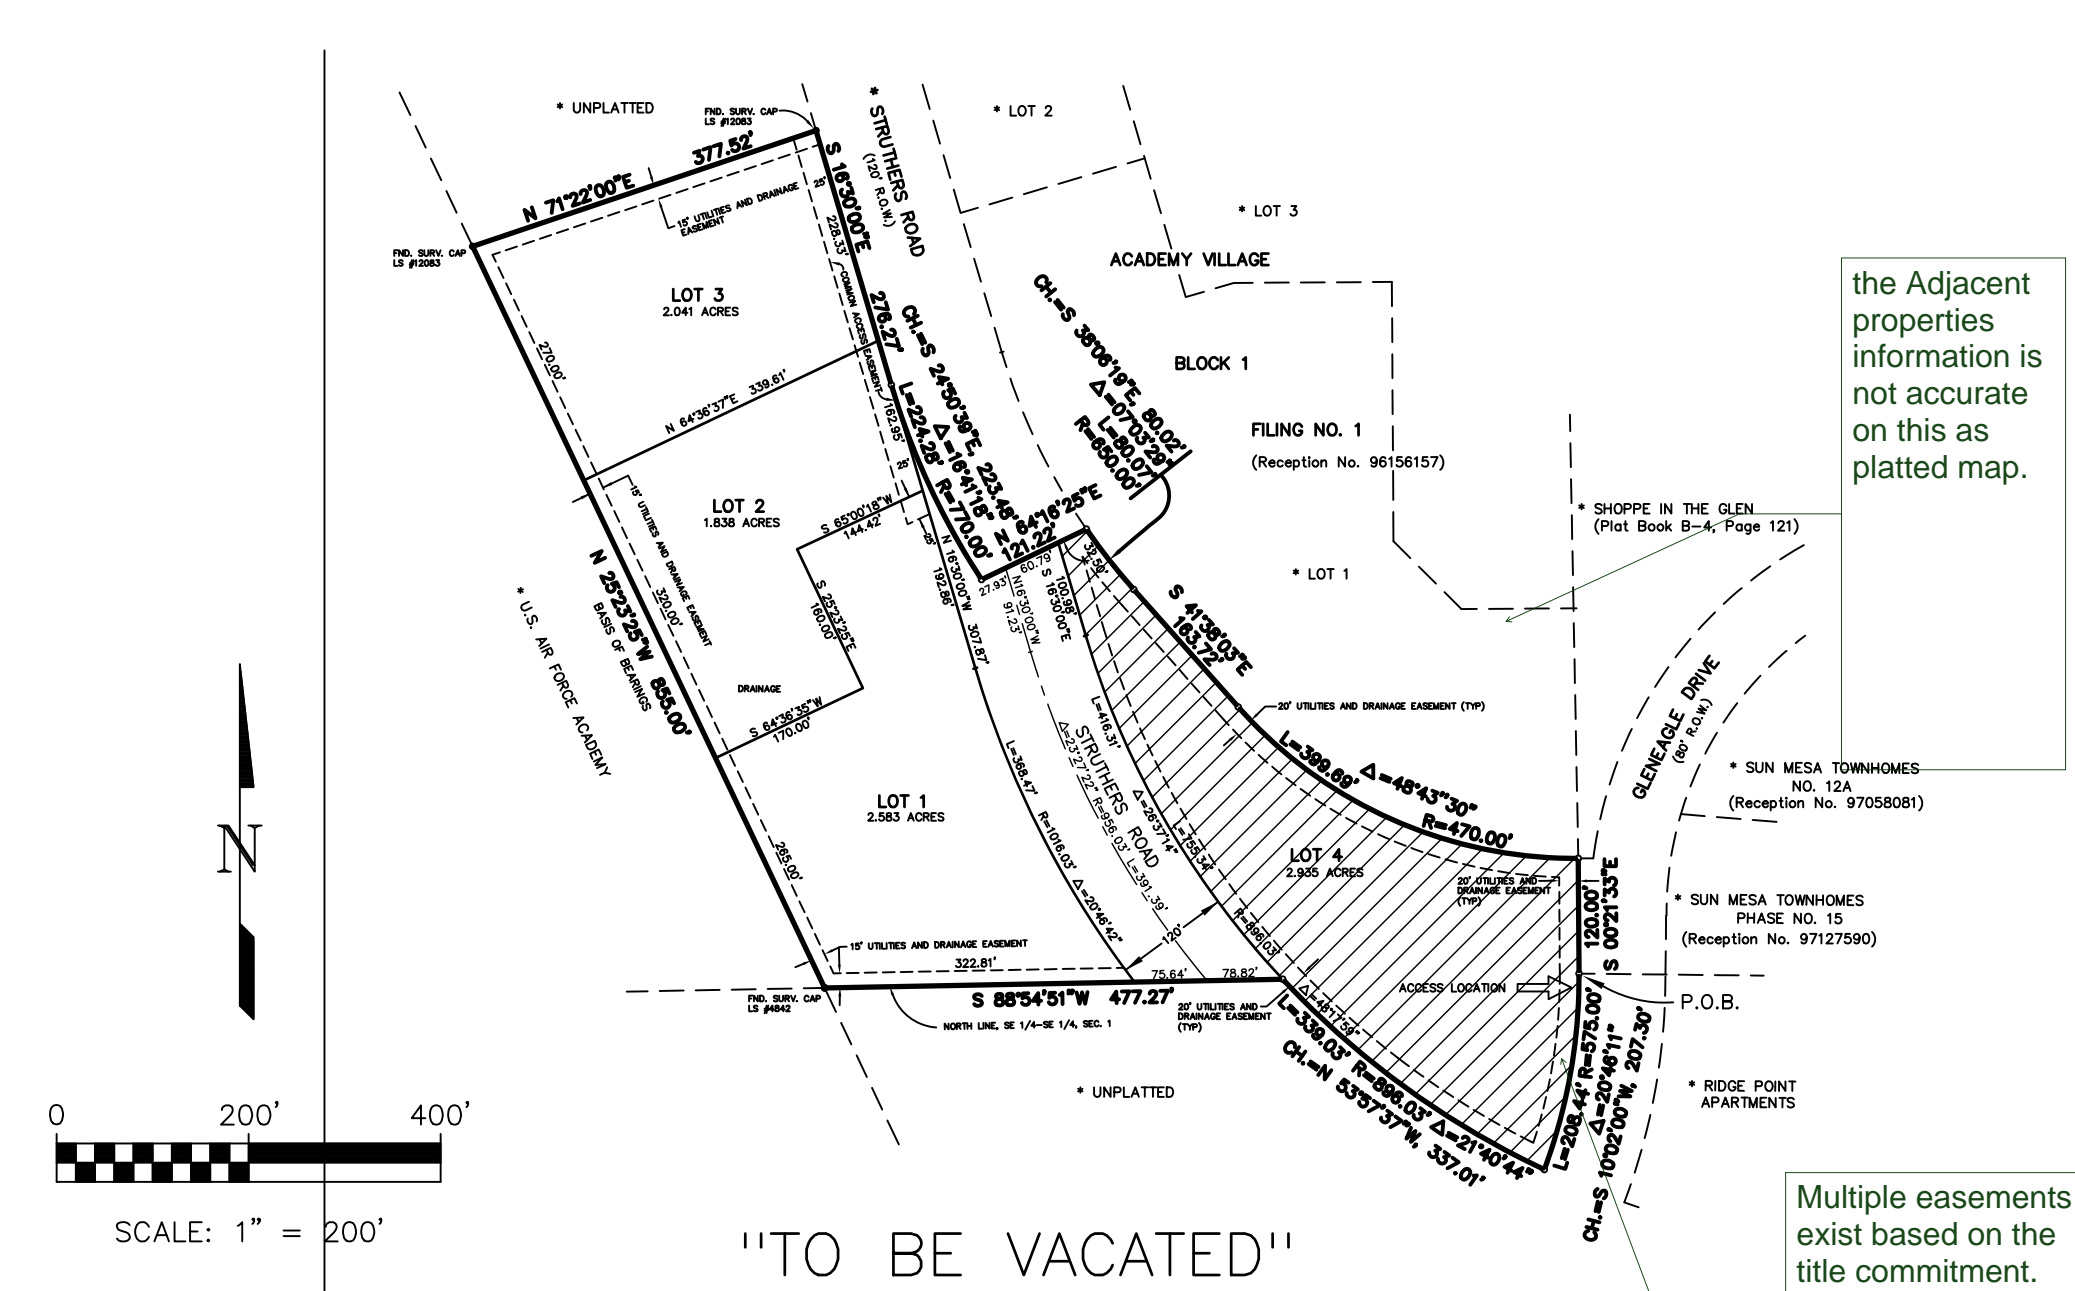

"TO BE VACATED"

Multiple easements exist based on the title commitment. Identify and show reception numbers or book and page of easements per the title commitment. If some are to be vacated identify on the plat.

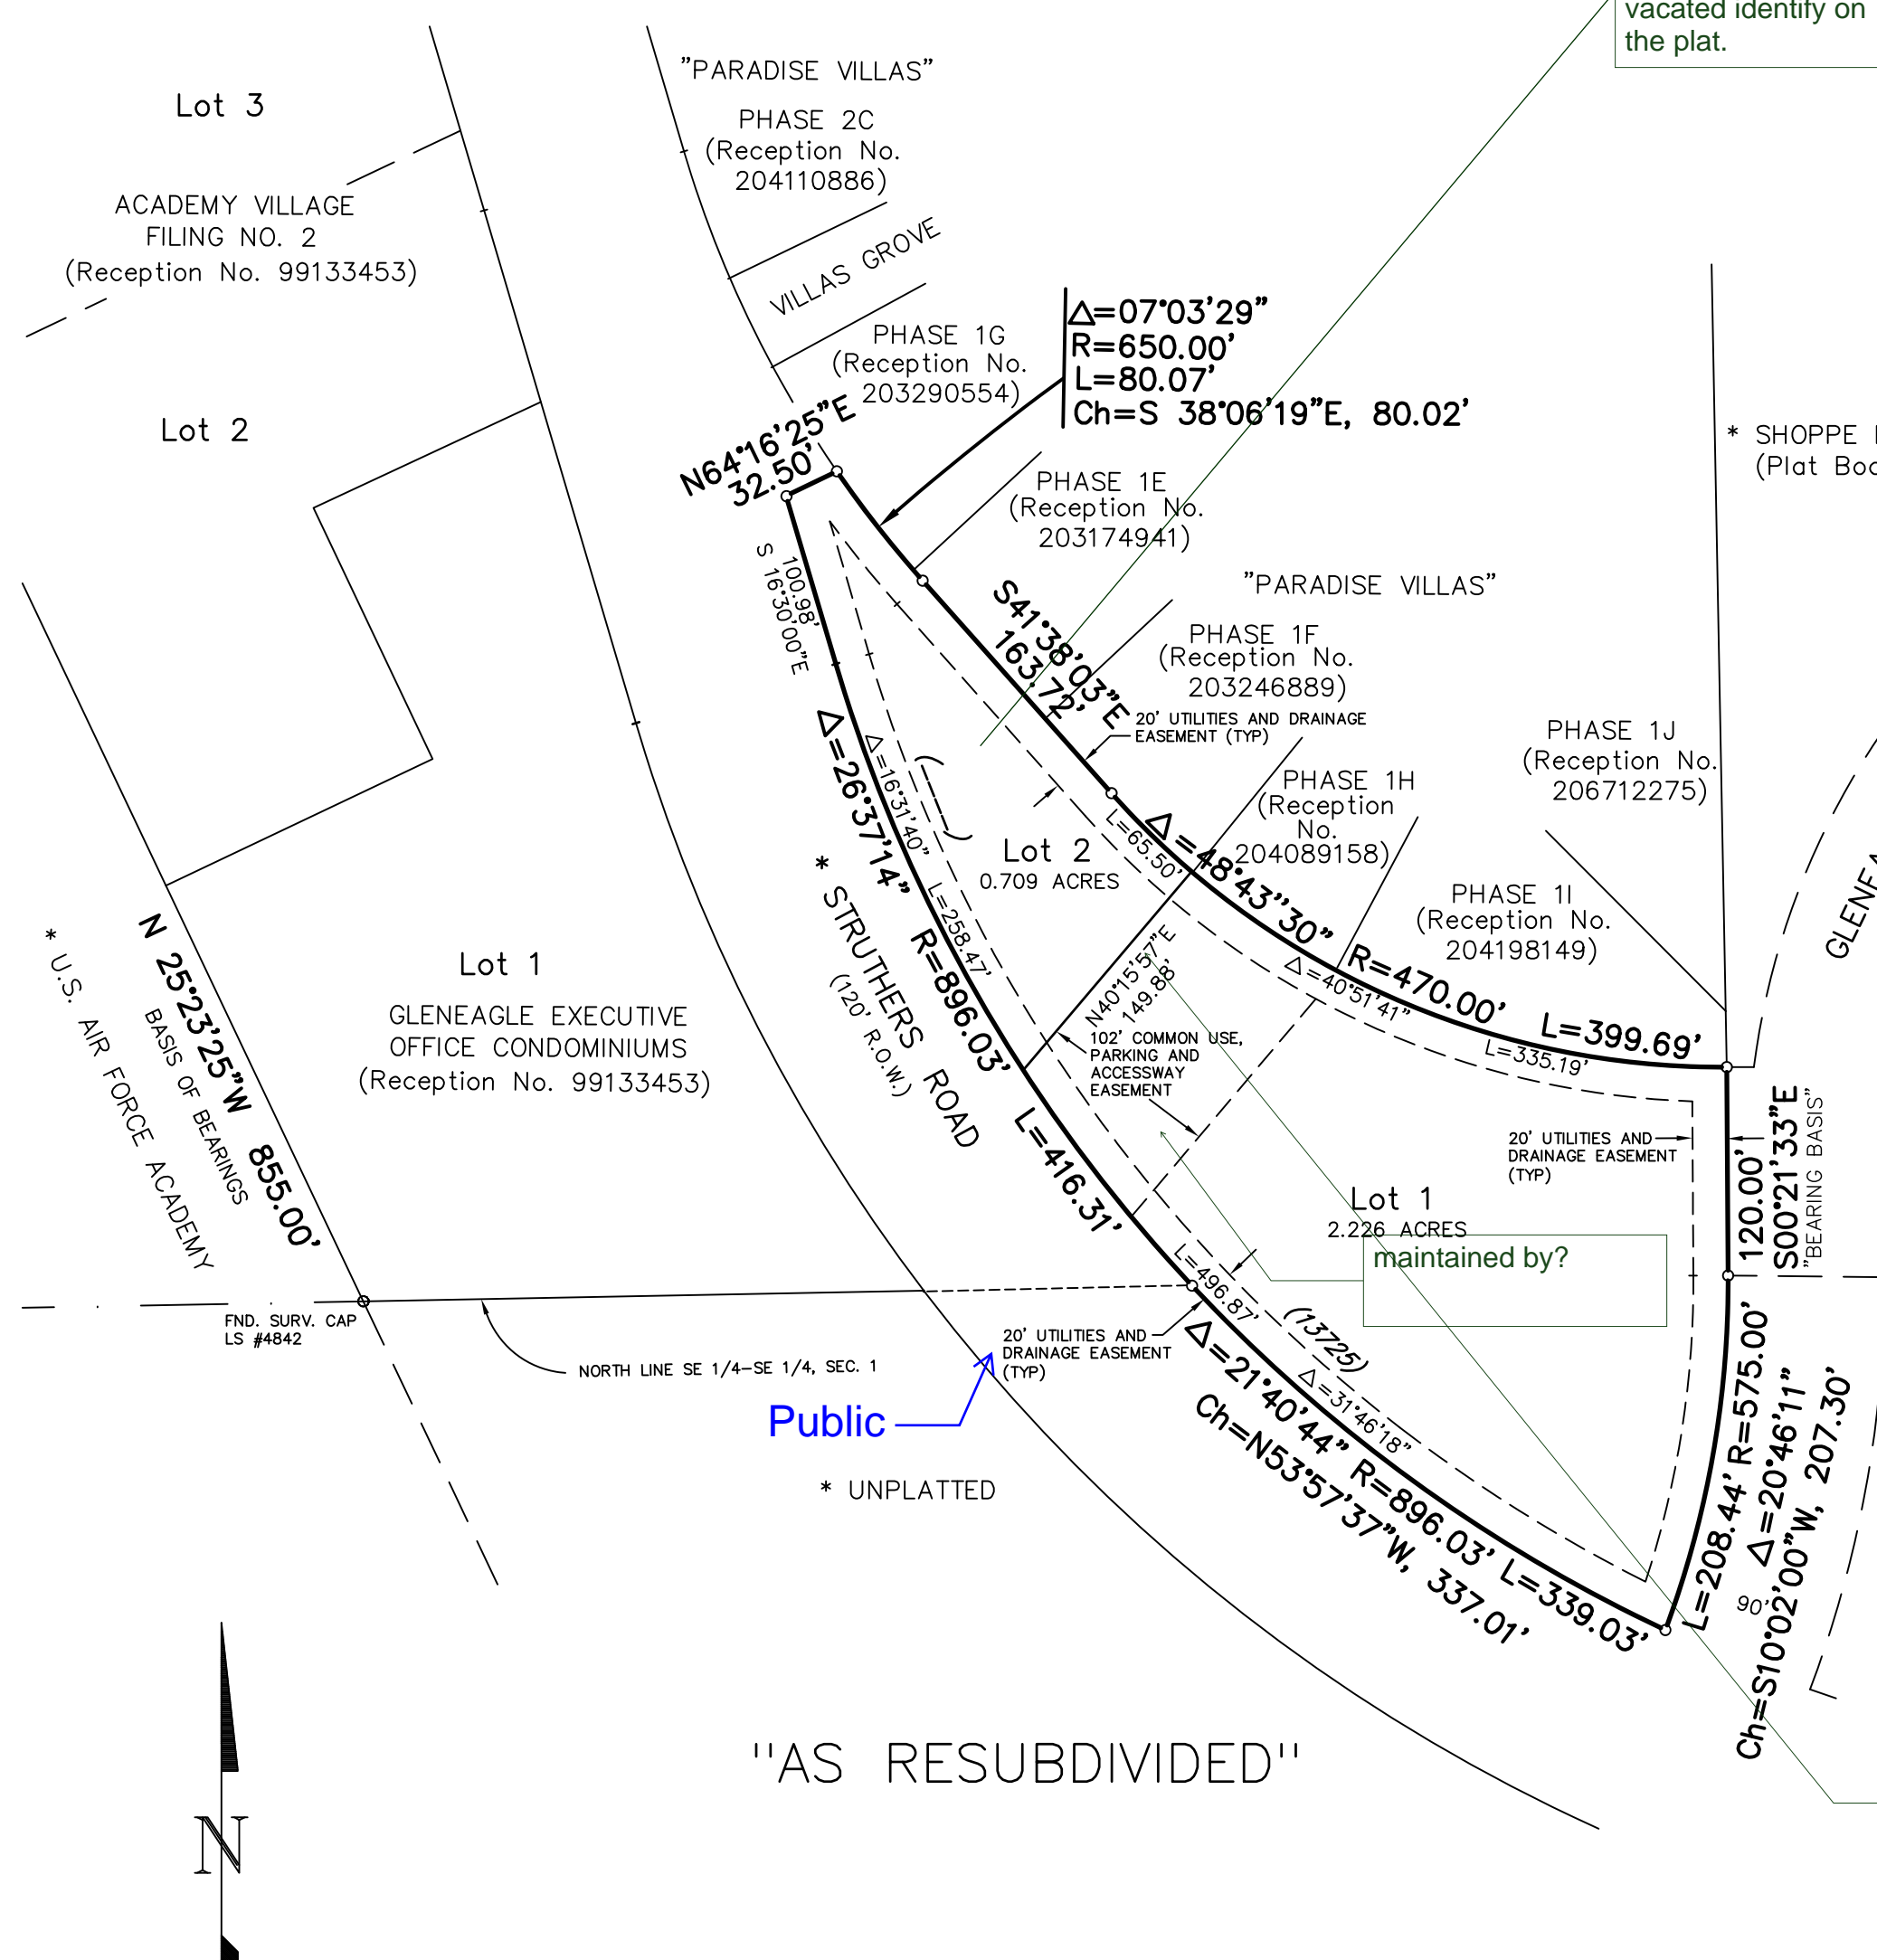

"AS RESUBDIVIDED"

Is this a proposed lot line? Please thicken so it is clear and increase the distance and bearings to represent the legal description of the 2 lots being platted.

CALL BEFORE YOU DIG... 811 DIAL 811

Table with columns: No., Description, Date, By

Scale information: H Scale: 1" = 100', V Scale: N/A, Designed By: N/A, Drawn By: DVH, Checked By: DVH, Date: 03/23/17

Land Development Consultants, Inc. logo and contact information.

FINAL PLAT ACADEMY VILLAGE FILING NO. 3

Project No.: 08013, Sheet: 1 of 1


Markup Summary

dspdparsons (20)



Subject: Cloud+
Page Label: 1
Lock: Unlocked
Status:
Checkmark: Unchecked
Author: dsdparsons
Date: 12/4/2017 1:36:01 PM
Color: ■

Wrong name

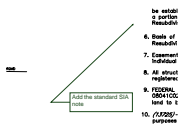


Subject: Callout
Page Label: 1
Lock: Unlocked
Status:
Checkmark: Unchecked
Author: dsdparsons
Date: 12/4/2017 2:31:06 PM
Color: ■

Add the standard SIA note




Subject: Text Box
Page Label: 1
Lock: Unlocked
Status:
Checkmark: Unchecked
Author: dsdparsons
Date: 12/4/2017 2:33:27 PM
Color: ■

No lot or interest therein, shall be sold, conveyed, or transferred whether by deed or by contract, nor shall building permits be issued, until and unless either the required public and common development improvements have been constructed and completed and preliminarily accepted in accordance with the Subdivision Improvements Agreement between the applicant/owner and El Paso County as recorded under Reception Number _____ in the Office of the Clerk and Recorder of El Paso County, Colorado or, in the alternative, other collateral is provided to make provision for the completion of said improvements in accordance with the El Paso County Land Development Code and Engineering Criteria Manual. Any such alternative collateral must be approved by the Board of County Commissioners or, if permitted by the Subdivision Improvements Agreement, by the Development Services Department Director and meet the policy and procedure requirements of El Paso County prior to the release by the County of any lots for sale, conveyance or transfer. This plat restriction may be removed or rescinded by the Board of County Commissioners or, if permitted by the Subdivision Improvements Agreement, by the Development Services Department Director upon either approval of an alternative form of collateral or completion and preliminary acceptance by the El Paso Board of County Commissioners of all improvements required to be constructed and completed in accordance with said Subdivision Improvements Agreement. The partial release of lots for sale, conveyance or transfer may only be granted in accordance with any planned partial release of lots authorized by the Subdivision Improvements Agreement.

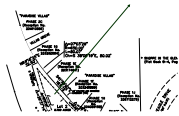

Subject: Arrow
Page Label: 1
Lock: Unlocked
Status:
Checkmark: Unchecked
Author: dsdparsons
Date: 12/4/2017 1:33:24 PM
Color: ■

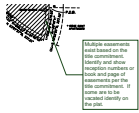


Subject: Callout
Page Label: 1
Lock: Unlocked
Status:
Checkmark: Unchecked
Author: dsdparsons
Date: 12/4/2017 1:30:49 PM
Color: ■

Multiple easements exist based on the title commitment. Identify and show reception numbers or book and page of easements per the title commitment. If some are to be vacated identify on the plat.



Subject: Callout
Page Label: 1
Lock: Unlocked
Status:
Checkmark: Unchecked
Author: dsdparsons
Date: 12/4/2017 1:32:57 PM
Color: ■

Is this a proposed lot line? Please thicken so it is clear and increase the distance and bearings to represent the legal description of the 2 lots being platted.

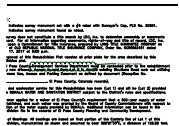


Subject: Cloud+
Page Label: 1
Lock: Unlocked
Status:
Checkmark: Unchecked
Author: dsdparsons
Date: 12/4/2017 1:38:58 PM
Color: ■

Incorrect name




Subject: Text Box
Page Label: 1
Lock: Unlocked
Status:
Checkmark: Unchecked
Author: dsdparsons
Date: 12/4/2017 2:42:48 PM
Color: ■

Property within this subdivision is subject to the terms and provisions of the El Paso County Road Impact Fee Program (Resolution 16-454) and any subsequent amendments. Fees for each lot within this subdivision shall be paid in full at the time of building permit issuance.

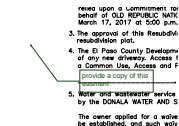


Subject: Callout
Page Label: 1
Lock: Unlocked
Status:
Checkmark: Unchecked
Author: dsdparsons
Date: 12/4/2017 1:39:13 PM
Color: ■

provide a copy of this easment

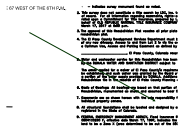


Subject: Arrow
Page Label: 1
Lock: Unlocked
Status:
Checkmark: Unchecked
Author: dsdparsons
Date: 12/4/2017 2:34:07 PM
Color: ■

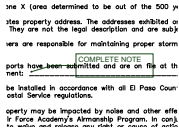

Subject: Callout
Page Label: 1
Lock: Unlocked
Status:
Checkmark: Unchecked
Author: dsdparsons
Date: 12/4/2017 1:38:09 PM
Color: ■

COMPLETE NOTE

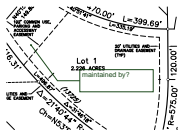

Subject: Callout
Page Label: 1
Lock: Unlocked
Status:
Checkmark: Unchecked
Author: dsdparsons
Date: 12/4/2017 2:37:19 PM
Color: ■

maintained by?




Subject: Note
Page Label: 1
Lock: Unlocked
Status:
Checkmark: Unchecked
Author: dsdparsons
Date: 12/4/2017 2:33:57 PM
Color: ■

Unless otherwise indicated, all side, front, and rear lot lines are hereby platted on either side with a 10 foot (use 5 feet for lots smaller than 2.5 acres) public utility and drainage easement unless otherwise indicated. All exterior subdivision boundaries are hereby platted with a 20 foot (use 7 feet for lots smaller than 2.5 acres) public utility and drainage easement. The sole responsibility for maintenance of these easements is hereby vested with the individual property owners.




Subject: Callout
Page Label: 1
Lock: Unlocked
Status:
Checkmark: Unchecked
Author: dsdparsons
Date: 12/4/2017 2:37:56 PM
Color: ■

Are there CCR's? If so add note.

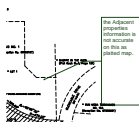

Subject: Callout
Page Label: 1
Lock: Unlocked
Status:
Checkmark: Unchecked
Author: dsdparsons
Date: 12/4/2017 1:28:48 PM
Color: ■

the Adjacent properties information is not accurate on this as platted map.

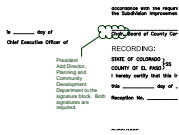

Subject: Cloud+
Page Label: 1
Lock: Unlocked
Status:
Checkmark: Unchecked
Author: dsdparsons
Date: 12/4/2017 1:37:20 PM
Color: ■

President
 Add Director, Planning and Community
 Development Department to the signature block.
 Both signatures are required.




Subject: Cloud+
Page Label: 1
Lock: Unlocked
Status:
Checkmark: Unchecked
Author: dsdparsons
Date: 12/4/2017 2:35:53 PM
Color: ■

Correct Name




Subject: Callout
Page Label: 1
Lock: Unlocked
Status:
Checkmark: Unchecked
Author: dsdparsons
Date: 12/4/2017 2:26:38 PM
Color: ■

Identify the tract or easement on the plat

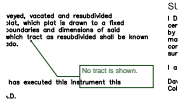

Subject: Callout
Page Label: 1
Lock: Unlocked
Status:
Checkmark: Unchecked
Author: dsdparsons
Date: 12/4/2017 1:34:44 PM
Color: ■


No tract is shown.

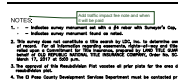

Subject: Callout
Page Label: 1
Lock: Unlocked
Status:
Checkmark: Unchecked
Author: dsdparsons
Date: 12/4/2017 2:41:33 PM
Color: ■

Add traffic impact fee note and when it will be paid

dsdrice (1)

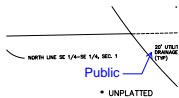

Subject: Callout
Page Label: 1
Lock: Unlocked
Status:
Checkmark: Unchecked
Author: dsdrice
Date: 12/8/2017 12:46:26 PM
Color: ■

Public