

CLIENT: ASPEN VIEW HOMES
FILE NAME: TG 4X8 (MARKSHEFFEL & MESA RIDGE)
DESIGNER: MICHAEL M.

PROJECT NAME: THE GLEN
ACCOUNT MANAGER: JEAN WHITE
DATE: 9/26/17

REVISIONS:
10/9/17 | 49557 | RVSN: ADD BACK PANEL

LIABILITY: IF ANY INFORMATION IS INCORRECT OR CHANGES ARE MADE AFTER APPROVAL, THE AD DISCLAIMER REGARDING COLOR ACCURACY.

APPROVAL (AS IS) APPROVAL (WITH CHANGES)

USERS MAY VARY DEPENDING ON DISPLAY, PRESENTATION, ETC. BEFORE THIS SIGN IS MADE A BEST EFFORT TO OBTAIN COLOR ACCURACY. IF COLORS ARE A CONCERN PLEASE REQUEST COLOR MATERIAL SAMPLES FROM YOUR FUSION SALES REPRESENTATIVE BEFORE ORDERING. THIS ORIGINAL CONCEPT HAS BEEN REFINED BY FUSION SIGN AND DESIGN. REVISIONS IN WHICH OUR DESIGN REMAINS THE EXCLUSIVE RIGHT OF FUSION SIGN & DESIGN.

Sign 960.00
Install 213.75

SIGN FACE
1/2" MDO WITH DVP GRAPHICS
Vinyl: CF CAL Laminate: MATTE CAL

POSTS/STRUCTURE
4X4 WOOD POSTS PAINTED WHITE


SCALE: 1/2" = 1'



POSTS SET 3/8" DEEP IN CONCRETE FOOTERS

Qty: SEE ORDER

3.00 3.00
49263 00000

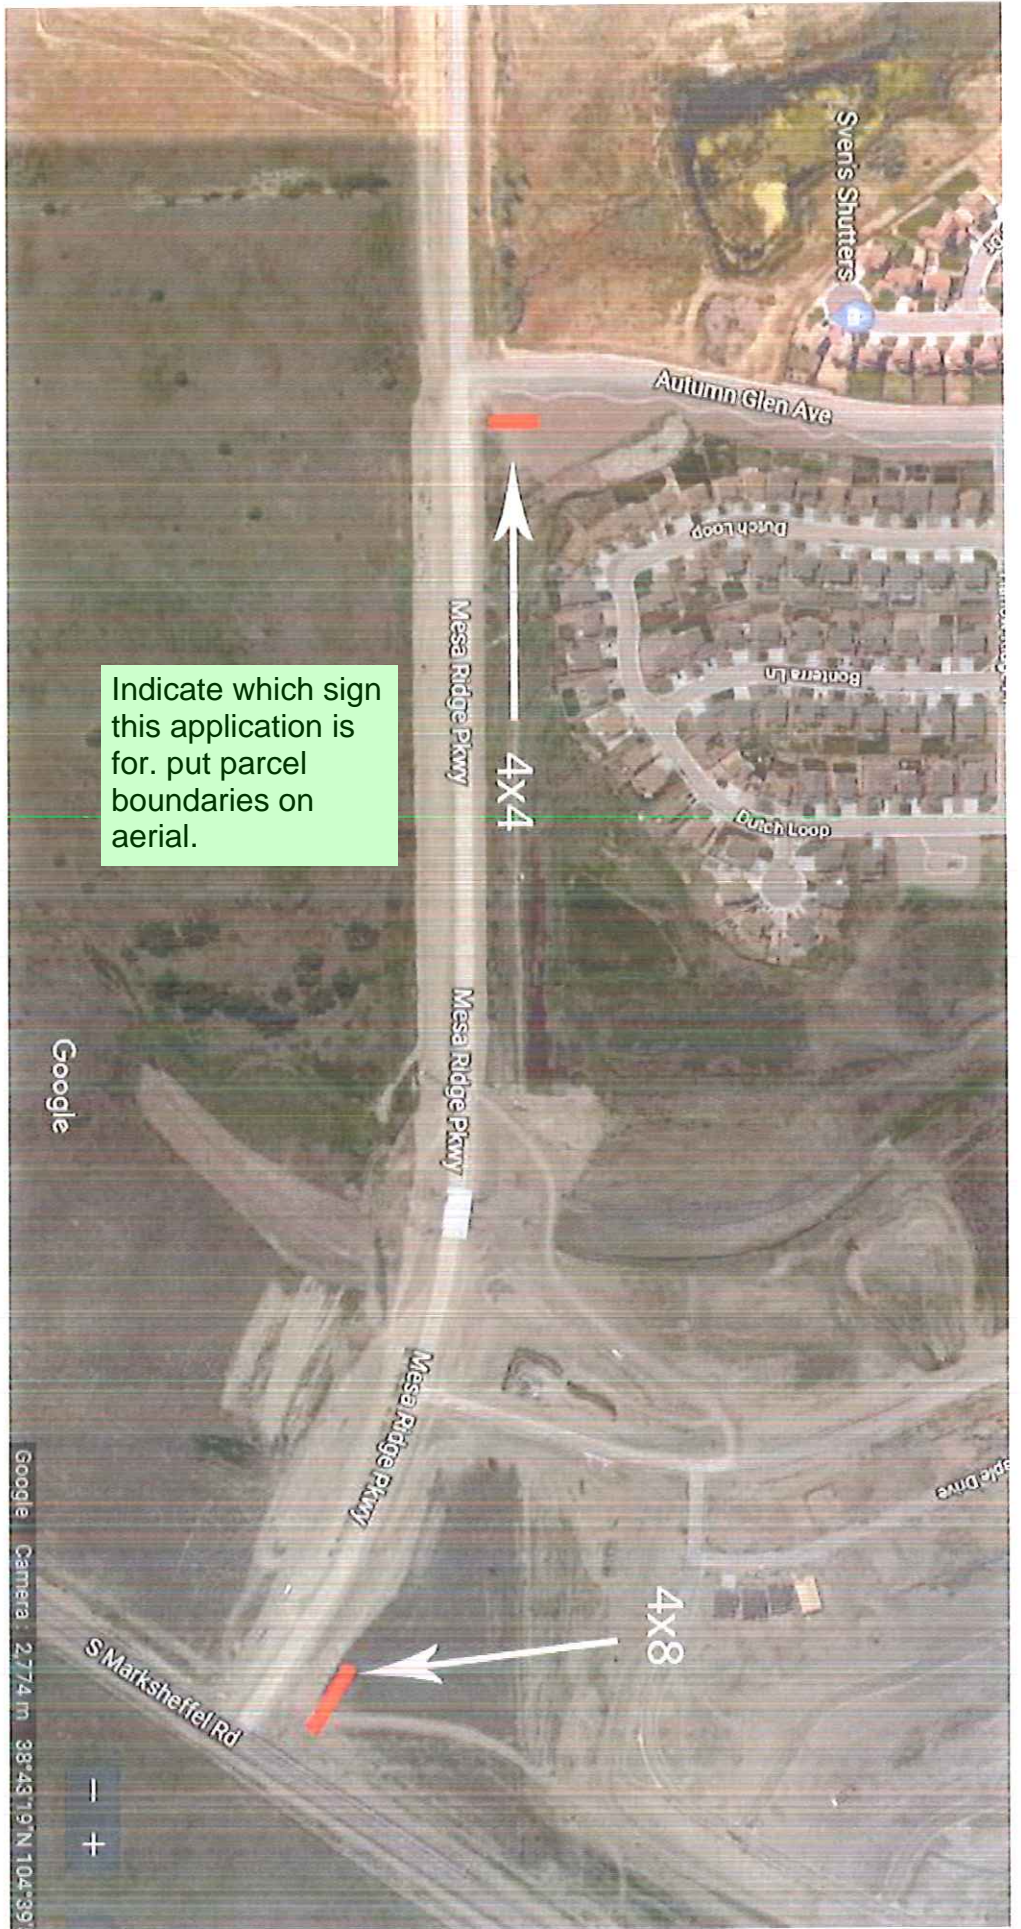

Indicate which sign this application is for. put parcel boundaries on aerial.

4x4

4x8


Google

Google Camera: 2.774 m 38°43'19"N 104°39'E

— +

Markup Summary

dsdkendall (1)

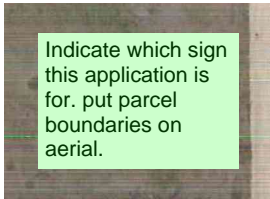

Subject: Text Box
Page Label: 2
Author: dsdkendall
Date: 8/23/2018 1:06:57 PM
Color: ■

Indicate which sign this application is for.
put parcel boundaries on aerial.