



**EL PASO COUNTY PLANNING & COMMUNITY DEVELOPMENT
SIGN APPLICATION**

DATE: _____

Business

Name: Aspen View Homes
 Address: 555 Middle Creek
Pkwy, Ste 380
CO Springs, CO 80921
 Zone: _____
 Legal Description: _____

Type of Sign


Illuminated: _____
 Non-Illuminated: X
 Valuation: _____
 Storefront Length &/or
 Width: _____
 Proposed Sign Sq. Ft. 4x8
 Existing Sign Sq. Ft. _____
 Total Sign Sq. Ft. _____

Contractor Information

Name: Fusion Sign & Design
 Address: 4165 Sinton Rd
CO Springs, CO 80907
 Phone: 719-302-5144
 Type of License: BLDG DSA
 Contractor ID# 19271

Vicinity Map

Tax Schedule # 5406203001
 Please show major intersections.

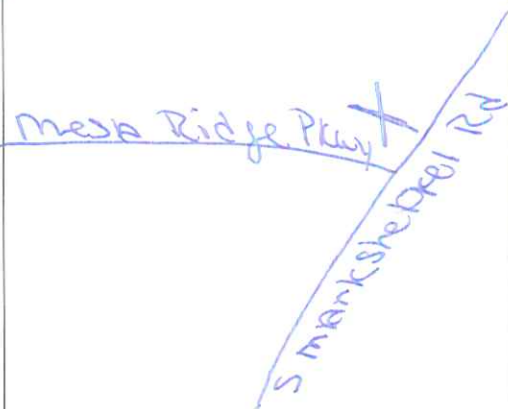

Incorrect schedule number

Sign Plan

(Please indicate dimensions and sign copy)

See Attachment

Elevation Drawing

Indicate storefront length & placement of sign.


Fill this out - 32 sf

For Planning & Community Development Use Only

Approved Date: _____ Resubmittal? Yes _____ No _____
 Denied Date: _____
 Comments: _____

Markup Summary


dskendall (2)

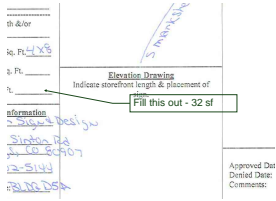

Subject: Callout
Page Label: 1
Author: dskendall
Date: 8/23/2018 1:10:08 PM
Color: ■

Fill this out - 32 sf

CITY PLANNING & COMMUNITY
SIGN APPLICATION

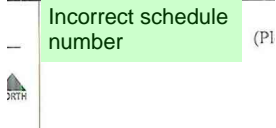

Subject: Text Box
Page Label: 1
Author: dskendall
Date: 8/23/2018 12:51:57 PM
Color: ■

Incorrect schedule number