



PROJECT INFORMATION:

SITE NAME:
 FOUNTAIN VALLEY
 SITE ID:
 COUG000-RELO
 COLOG000
 13250 RAY NIXON RD.
 FOUNTAIN, CO 80817
 EL PASO

Rev:	Date:	Description:	By:
1	05/31/16	PRELIM. CONST.	GW
2	06/20/16	CLIENT COMMENTS	GW
3	10/17/16	RF. DESIGN UPDATE	AM
4	02/22/17	RF DESIGN UPDATE	AM
5	03/09/17	CONSTRUCTION	AM

PLANS PREPARED BY:

CENTERLINE SOLUTIONS
Advancing Wireless Networks
 16035 TABLE MOUNTAIN PARKWAY
 Golden, CO 80403
 303-993-3293
 WWW.CENTERLINESOLUTIONS.COM

LICENSURE NO.:



ALL SCALES ARE SET FOR 24"x36" SHEET

DRAWN BY: CHK BY: APV BY:

GW	AM	KS
----	----	----


Sheet Title:

NEW NORTHEAST
 ELEVATION

Sheet Number:


A3.1

NOTE:
 THE PROPOSED MONOPOLE, ASSOCIATED MOUNTING HARDWARE, AND FOUNDATION ARE BEING DESIGNED BY OTHERS. REVIEW STRUCTURAL DOCUMENTS PRIOR TO INSTALLATION OF PROPOSED TOWER EQUIPMENT TO ENSURE ADEQUATE STRUCTURAL CAPACITY FOR THE LOADS.

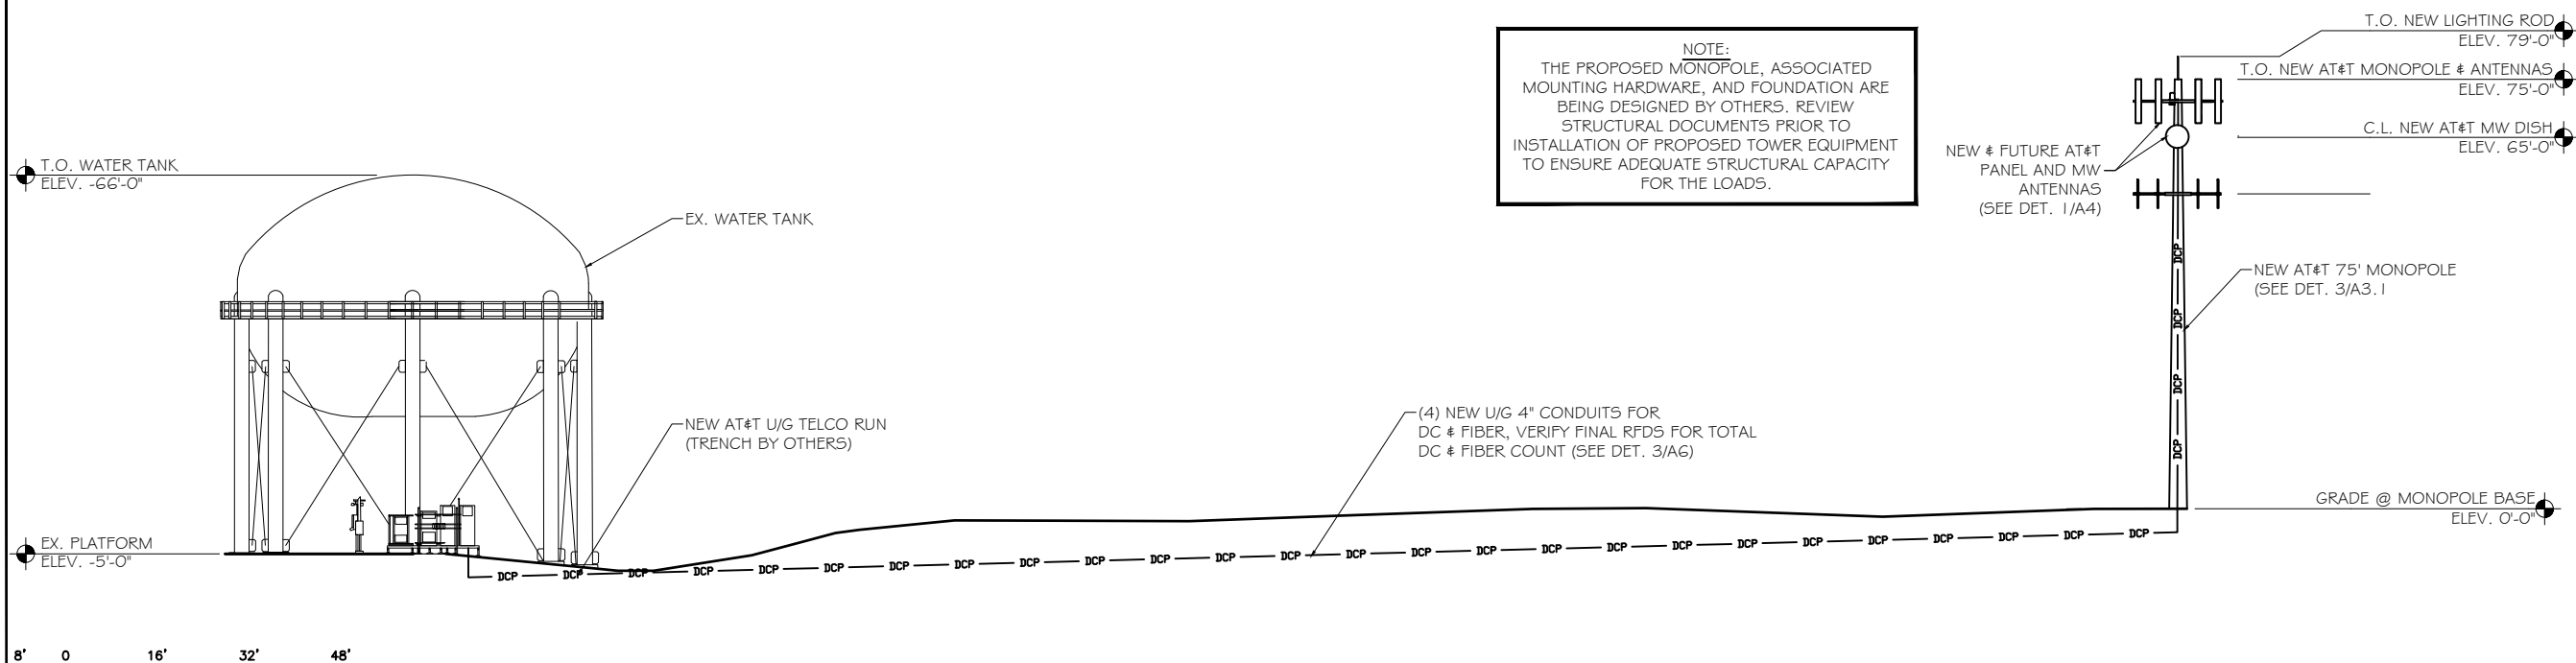

1 NEW NORTHEAST SITE ELEVATION


SCALE: 1/16" = 1'-0"

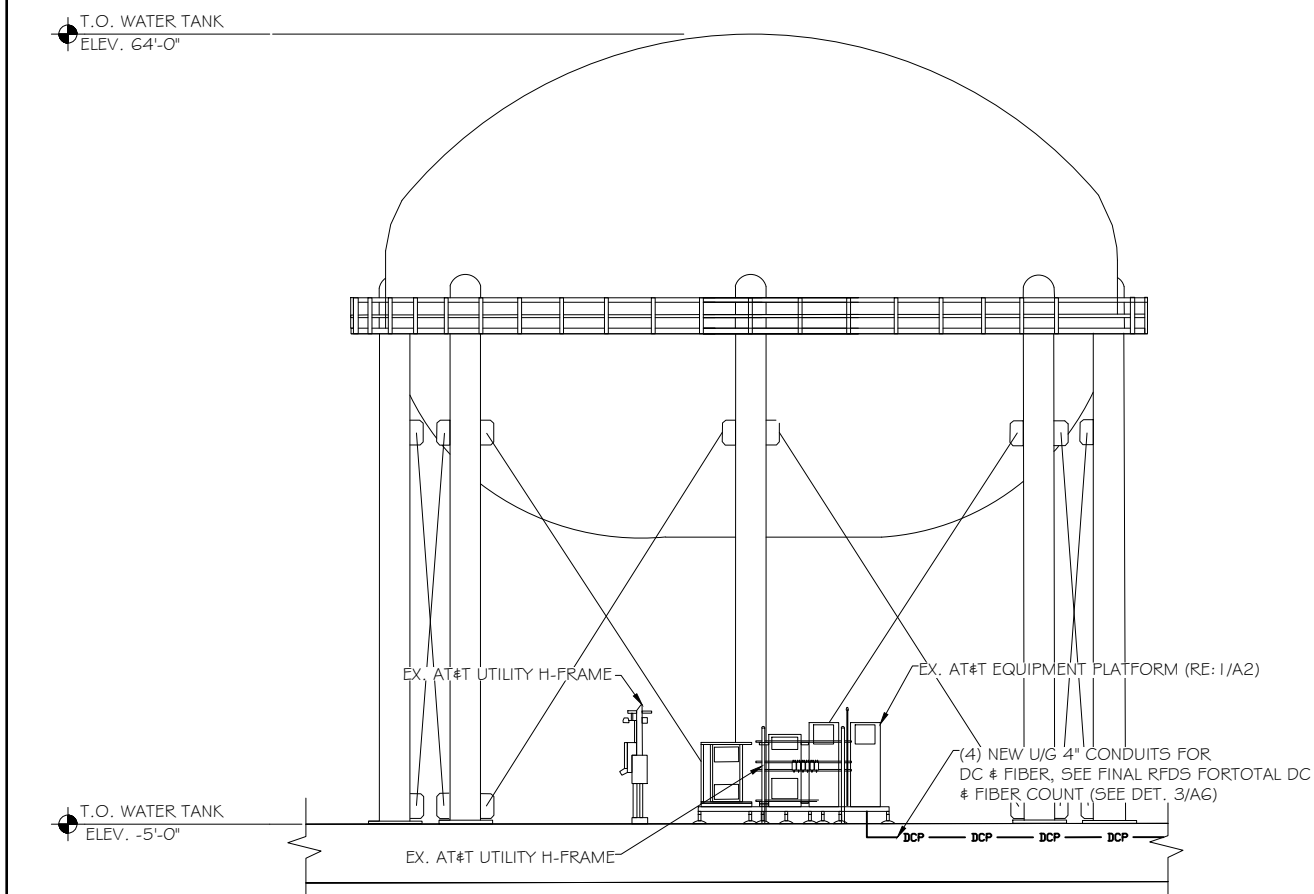

2 NEW PARTIAL NORTHEAST ELEVATION

SCALE: 1/8" = 1'-0"

Maximum height for zoning district is 30 feet, please address issue in Letter of Intent.

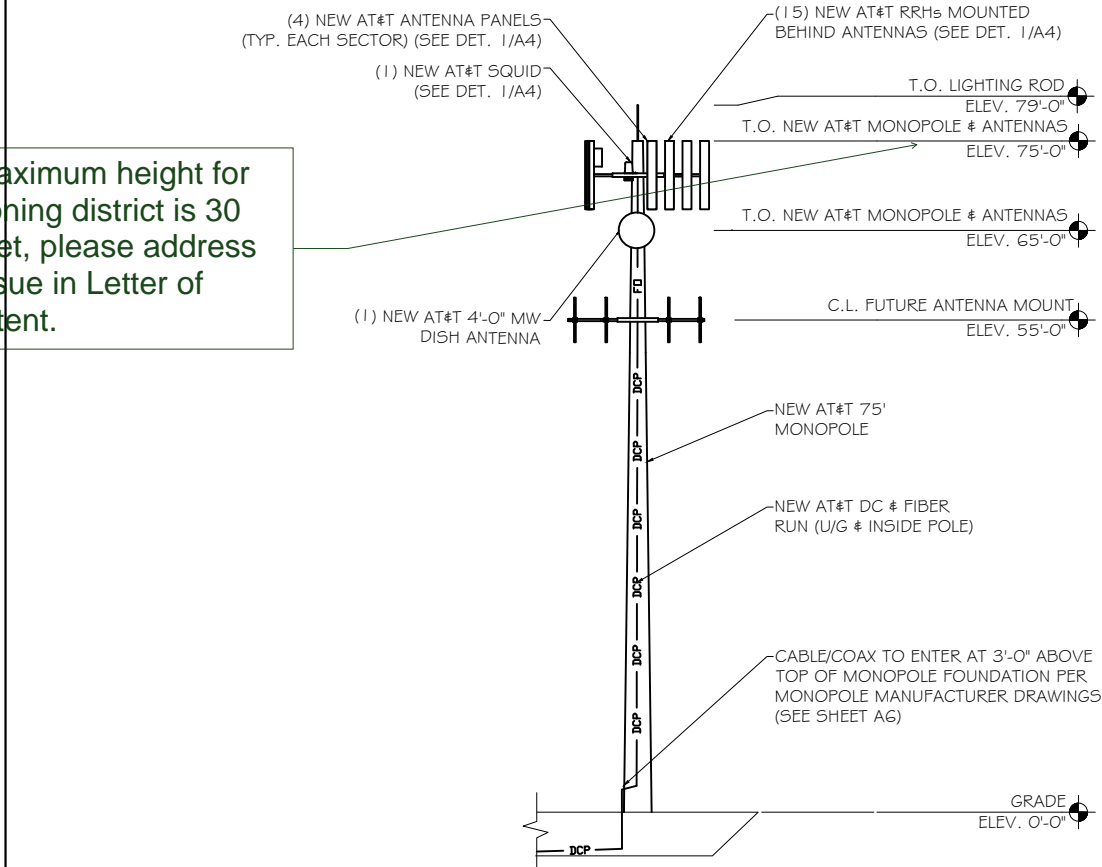

3 NEW NORTHEAST ELEVATION (NEW RELO SITE AT MONOPOLE)

SCALE: 3/32" = 1'-0"



PROJECT INFORMATION:


SITE NAME:
FOUNTAIN VALLEY
SITE ID:
COUG000-RELO
COLOG000
13250 RAY NIXON RD.
FOUNTAIN, CO 80817
EL PASO

Rev:	Date:	Description:	By:
1	05/31/16	PRELIM. CONST.	GW
2	06/20/16	CLIENT COMMENTS	GW
3	10/17/16	RF. DESIGN UPDATE	AM
4	02/22/17	RF DESIGN UPDATE	AM
5	03/09/17	CONSTRUCTION	AM

PLANS PREPARED BY:

CENTERLINE SOLUTIONS
Advancing Wireless Networks
16035 TABLE MOUNTAIN PARKWAY
Golden, CO 80403
303-993-3293
WWW.CENTERLINESOLUTIONS.COM

LICENSURE NO:

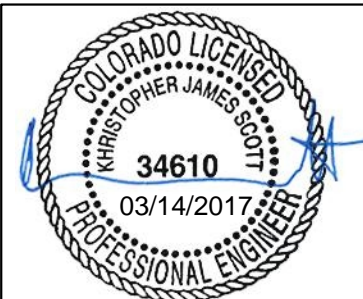

ALL SCALES ARE SET FOR 24"x36" SHEET

DRAWN BY: CHK BY: APV BY:



GW	AM	KS
----	----	----

Sheet Title:

EX. NORTHEAST
ELEVATION

Sheet Number:

A3

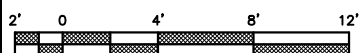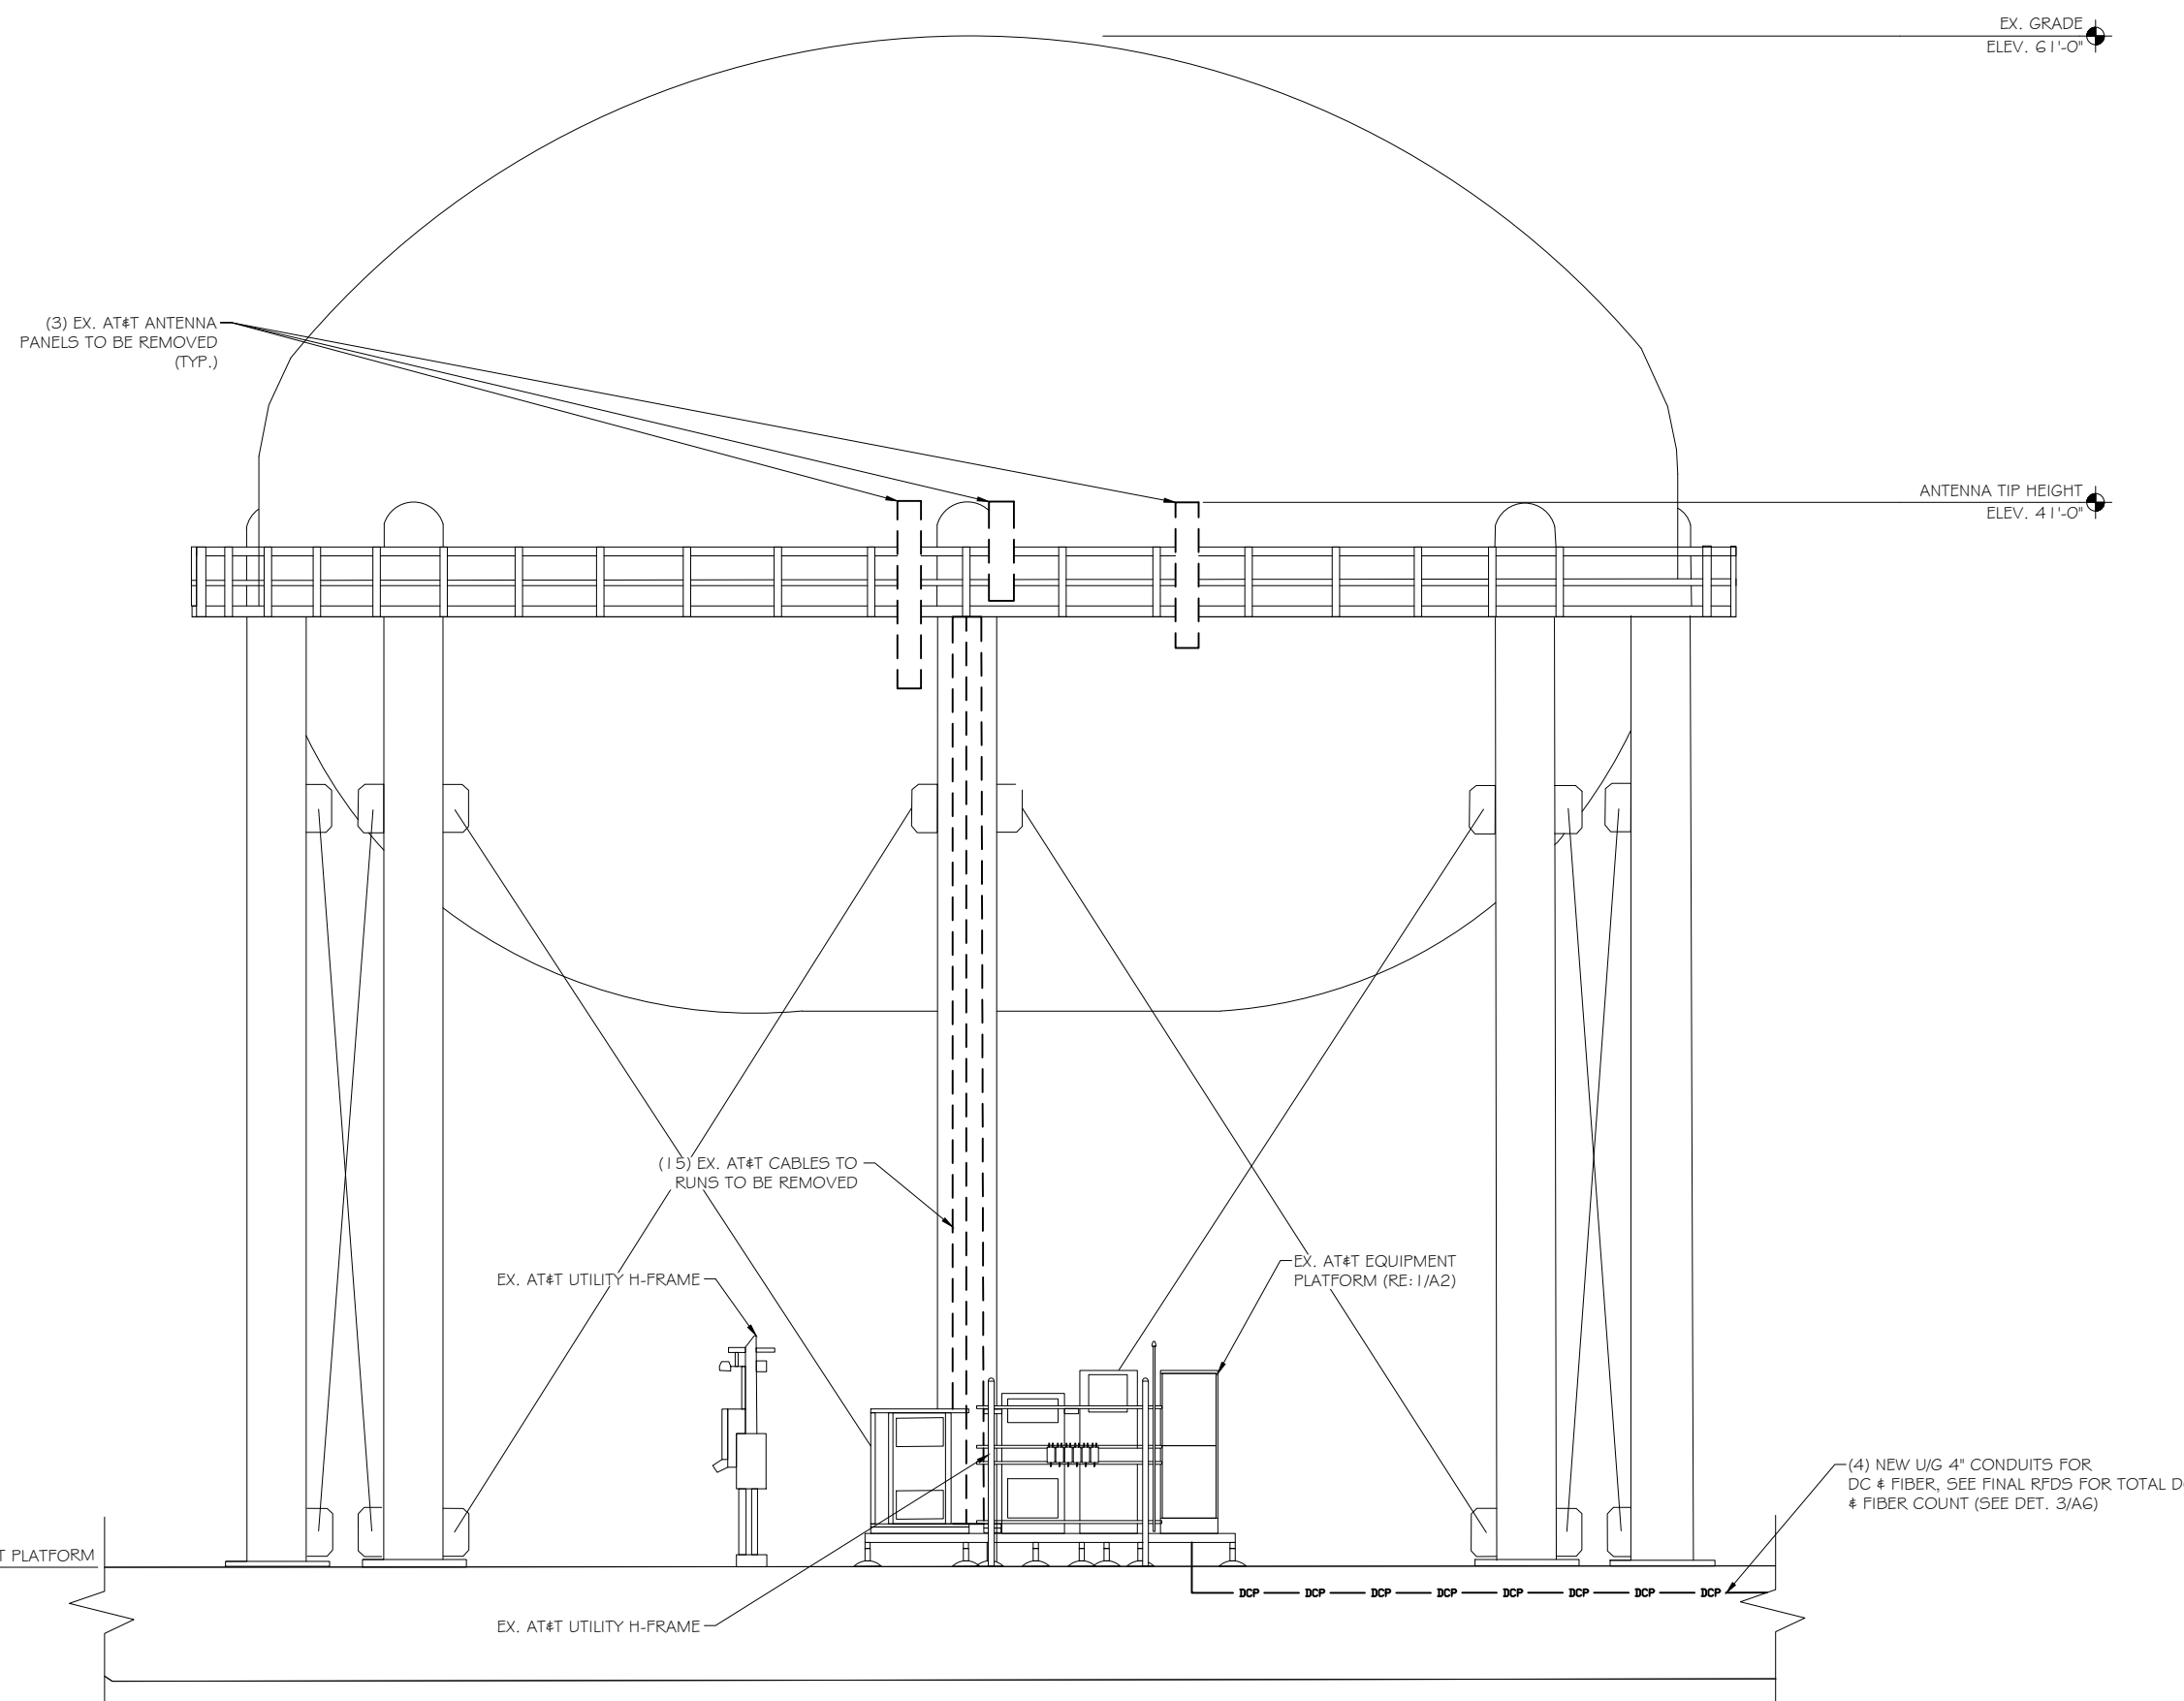


SCALE: 1/4" = 1'-0"

1 | NORTHEAST ELEVATION (EX. WATER TANK)

SCALE: 1/4" = 1'-0"

Markup Summary

dsdsevigny (1)

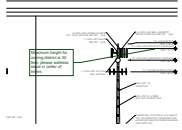

Subject: Callout
Page Label: [7] COU6000 CDs.dwg COPY-A3.1
Lock: Locked
Status:
Checkmark: Unchecked
Author: dsdsevigny
Date: 11/16/2017 9:53:04 AM
Color: ■

Maximum height for zoning district is 30 feet, please address issue in Letter of Intent.