

SHEET INDEX

GENERAL
G000 COVER SHEET
G001 ABBREVIATIONS

CIVIL
C100 CIVIL LEGENDS
C101 SITE PLAN
C102 SITE GRADING PLAN
C103 SITE DRIVEWAY PLAN
C104 YARD PIPING PLAN
C105 WELL TO WTP YARD PLAN
C106 WTP TO OFF-SITE YARD PIPING PLAN
C107 LANDSCAPING PLAN
C108 INITIAL EROSION CONTROL
C109 FINAL EROSION CONTROL
C500 CIVIL DETAILS
C501 CIVIL DETAILS
C502 CIVIL DETAILS

STRUCTURAL
S000 STRUCTURAL COVER SHEET
S100 FIRST LEVEL FOUNDATION PLAN
S101 MEZZANINE FRAMING PLAN
S102 ROOF FRAMING PLAN
S200 FOUNDATION DETAILS
S201 FRAMING DETAILS
S300 BUILDING SECTIONS
S500 TYPICAL CONCRETE DETAILS
S501 TYPICAL CONCRETE WALL / SLAB DETAILS
S502 TYPICAL CONCRETE MISC (MEP & PROCESS) DETAILS
S503 TYPICAL CONCRETE DETAILS
S504 TYPICAL MASONRY DETAILS
S505 TYPICAL MASONRY DETAILS
S506 TYPICAL PRECAST DETAILS
S507 TYPICAL BAR GRATE AND PLATFORM DETAILS

ARCHITECTURAL
A000 ARCHITECTURAL LEGENDS AND NOTES
A100 ARCHITECTURAL PLANS
A200 ARCHITECTURAL ELEVATIONS
A300 ARCHITECTURAL SECTIONS
A400 ARCHITECTURAL ENLARGED PLANS
A500 ARCHITECTURAL DETAILS
A600 ARCHITECTURAL SCHEDULES

PLUMBING
PL100 UNDERFLOOR PLUMBING PLAN
PL101 FIRST FLOOR PLUMBING PLAN
PL300 PLUMBING ISOMETRICS
PL500 PLUMBING DETAILS & SCHEDULES

PROCESS
P000 PROCESS LEGEND
P101 FIRST FLOOR PROCESS PLAN
P300 PROCESS HIGH SERVICE AND FEED PUMP SECTIONS
P301 PROCESS HYDROPNEUMATIC TANK SECTIONS
P302 DUALATOR SECTIONS 1 OF 2
P303 DUALATOR SECTIONS 2 OF 2
P400 ENLARGED PROCESS PLAN 1 OF 2
P401 ENLARGED PROCESS PLAN 2 OF 2
P500 PROCESS DETAILS
P600 PROCESS SCHEDULES

MECHANICAL
M000 MECHANICAL LEGEND
M101 FIRST FLOOR HVAC PLAN
M300 HVAC SECTIONS
M500 MECHANICAL DETAILS & SCHEDULES

ELECTRICAL
E000 ELECTRICAL LEGEND
E100 ELECTRICAL SITE PLAN
E101 FIRST FLOOR POWER PLAN
E102 FIRST FLOOR LIGHTING PLAN
E500 ELECTRICAL DETAILS
E501 ELECTRICAL ONE-LINE DIAGRAM
E600 ELECTRICAL SCHEDULES
E601 ELECTRICAL SCHEDULES

INSTRUMENTATION & CONTROL
IC000 P&ID LEGEND
IC500 P&ID - WELLS AND FILTRATION SYSTEM
IC501 P&ID - TOWER & GROUND STORAGE RESERVOIR
IC502 P&ID - LEGEND (TONKA)
IC503 P&ID - WTP (TONKA)
IC600 I&C - DETAILS & SCHEDULES

TOTAL SHEETS: 69


EL PASO COUNTY, COLORADO GRANDVIEW RESERVE DISTRICT WTP WELL WATER COLLECTION

D.R. HORTON
COLORADO
2024

LOCATION MAP

Plan and profile sheets can be removed from this plan set as they are located within the Construction drawing plan set.

Please include:
-Zoning
-Parcel number
-Legal description
-Parcel size
-Lot area coverage calculation
-Existing/proposed land use and zoning
-Total gross building square footage
-Open space, landscaping, and impermeable surface percentage
-A note stating: The owner agrees on behalf of him/herself and any developer or builder successors and assignees that Subdivider and/or said successors and assigns shall be required to pay traffic impact fees in accordance with the El Paso County Road Impact Fee Program Resolution (Resolution No. 19-471), or any amendments thereto, at or prior to the time of building permit submittals. The fee obligation, if not paid at final plat recording, shall be documented on all sales documents and on plat notes to ensure that a title search would find the fee obligation before sale of the property.
-Parking computations

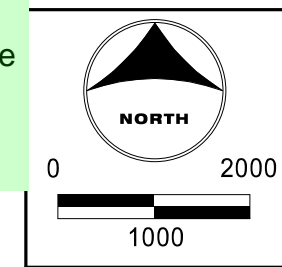

VICINITY MAP
1"=2000'

HORIZONTAL CONTROL
MODIFIED COORDINATE SYSTEM -
SEE SHEETS IN DRAWINGS

VERTICAL DATUM
NAVD88

Based on the landscape plan, it appears significant offsite improvements are being included as part of this application, including paths and park amenities. If so, please include and provide details. If not, please clarify limits of improvements. See landscape plan comments.



1975 RESEARCH PARKWAY, SUITE 230 | COLORADO SPRINGS, CO 80920
Phone: 719.300.4140 | Toll Free: 800.728.7805 | Fax: 713.965.0044 | HRGreen.com

EL PASO COUNTY:

COUNTY PLAN REVIEW IS PROVIDED ONLY FOR GENERAL CONFORMANCE WITH COUNTY DESIGN CRITERIA. THE COUNTY IS NOT RESPONSIBLE FOR THE ACCURACY AND ADEQUACY OF THE DESIGN, DIMENSIONS, AND/OR ELEVATIONS WHICH SHALL BE CONFIRMED AT THE JOB SITE. THE COUNTY THROUGH THE APPROVAL OF THIS DOCUMENT ASSUMES NO RESPONSIBILITY FOR COMPLETENESS AND/OR ACCURACY OF THIS DOCUMENT.

FILED IN ACCORDANCE WITH THE REQUIREMENTS OF THE EL PASO COUNTY LAND DEVELOPMENT CODE, DRAINAGE CRITERIA MANUAL, VOLUMES 1 AND 2, AND ENGINEERING CRITERIA MANUAL AS AMENDED.

IN ACCORDANCE WITH ECM SECTION 1.12, THESE CONSTRUCTION DOCUMENTS WILL BE VALID FOR CONSTRUCTION FOR A PERIOD OF 2 YEARS FROM THE DATE SIGNED BY THE EL PASO COUNTY ENGINEER. IF CONSTRUCTION HAS NOT STARTED WITHIN THOSE 2 YEARS, THE PLANS WILL NEED TO BE RESUBMITTED FOR APPROVAL, INCLUDING PAYMENT OF REVIEW FEES AT THE PLANNING AND COMMUNITY DEVELOPMENT DIRECTORS DISCRETION.

JENNIFER IRVINE, P.E. _____ DATE _____
COUNTY ENGINEER / ECM ADMINISTRATOR

ENGINEER'S STATEMENT (FOR GEC PLAN WITHIN CONSTRUCTION DRAWING SET):

THESE DETAILED PLANS AND SPECIFICATIONS WERE PREPARED UNDER MY DIRECTION AND SUPERVISION. SAID PLANS AND SPECIFICATIONS HAVE BEEN PREPARED ACCORDING TO THE CRITERIA ESTABLISHED BY THE COUNTY FOR DETAILED ROADWAY, DRAINAGE, GRADING AND EROSION CONTROL PLANS AND SPECIFICATIONS, AND SAID PLANS AND SPECIFICATIONS ARE IN CONFORMITY WITH APPLICABLE MASTER DRAINAGE PLANS AND MASTER TRANSPORTATION PLANS. SAID PLANS AND SPECIFICATIONS MEET THE PURPOSES FOR WHICH THE PARTICULAR ROADWAY AND DRAINAGE FACILITIES ARE DESIGNED AND ARE CORRECT TO THE BEST OF MY KNOWLEDGE AND BELIEF. I ACCEPT RESPONSIBILITY FOR ANY LIABILITY CAUSED BY ANY NEGLIGENT ACTS, ERRORS OR OMISSIONS ON MY PART IN PREPARATION OF THESE DETAILED PLANS AND SPECIFICATIONS.

GREG PANZA, P.E. #37081 _____ DATE _____
FOR AND ON BEHALF OF HR GREEN, INC.

OWNER'S STATEMENT (FOR GEC PLAN WITHIN CONSTRUCTION DRAWING SET):

I, THE OWNER/DEVELOPER, HAVE READ AND WILL COMPLY WITH THE REQUIREMENTS OF THE GRADING AND EROSION CONTROL PLAN AND ALL OF THE REQUIREMENTS SPECIFIED IN THESE DETAILED PLANS AND SPECIFICATIONS.

OWNER'S SIGNATURE _____ DATE _____

ENGINEERS STATEMENT:

THE DETAILED PLANS AND SPECIFICATIONS WERE PREPARED UNDER MY DIRECTION AND SUPERVISION. SAID DETAILS AND SPECIFICATIONS HAVE BEEN PREPARED ACCORDING TO THE CRITERIA ESTABLISHED BY THE STATE OF COLORADO.

GREG PANZA, P.E. #37081 _____ DATE _____
FOR AND ON BEHALF OF HR GREEN, INC.

PROJECT CONTACTS:

OWNER/DEVELOPER
D.R. HORTON
9555 S. KINGSTON COURT, SUITE 200
ENGELWOOD, CO 80112
TELE: (303) 488-0081
ATTN: RILEY HILLEN, PE AND BRYAN REID, PE
EMAIL: RHILLEN@DRHORTON.COM AND BAREID1@DRHORTON.COM

APPLICANT
HR GREEN
5613 DTC PARKWAY | SUITE 950
GREENWOOD VILLAGE, CO 80111
TELE: (720) 602-4999
ATTN: GREGORY PANZA P.E.
EMAIL: GPANZA@HRGREEN.COM

CIVIL ENGINEER
HR GREEN
5613 DTC PARKWAY | SUITE 950
GREENWOOD VILLAGE, CO 80111
TELE: (720) 602-4999
ATTN: GREGORY PANZA P.E.
EMAIL: GPANZA@HRGREEN.COM

GEOTECHNICAL ENGINEER
COMPANY: CTL | THOMPSON
ADDRESS: 5170 MARK DABLING BLVD
COLORADO SPRINGS, CO 80918
TELE: (719) 528-8300
ATTN: JEFF JONES
EMAIL: COLORADOSPRINGS@CTLTHOMPSON.COM

TRAFFIC ENGINEER
LSC TRANSPORTATION CONSULTANTS INC.
2504 EAST PIKES PEAK AVENUE, SUITE 304
COLORADO SPRINGS, CO 80909
TELE: &719) 633-2868
ATTN: JEFFREY C. HODSON, P.E.
EMAIL: LSC@LSCTRANS.COM

SURVEYOR
EDWARD-JAMES SURVEYING, INC.
926 ELKTON DRIVE
COLORADO SPRINGS, CO 80907
TELE: (719) 576-1216
ATTN: JONATHAN W. TESSIN
EMAIL: JTessin@EJSURVEYING.COM

UTILITY CONTACTS:

WATER
GRANDVIEW RESERVE METROPOLITAN DISTRICT
1272 KELLY JOHNSON BLVD, SUITE 100
COLORADO SPRINGS, CO 80921
TELE: (719) 499-8416
ATTN: PAUL HOWARD
EMAIL: PAULINFINITY1@MSN.COM

WASTEWATER / WATER
WOODMEN HILLS METRO DISTRICT
8046 EASTONVILLE ROAD
FALCON, CO 80831
TELE: (719) 495-2500
CONTACT: CODY RITTER
EMAIL: CODY@WHMD.ORG

ELECTRIC / FIBER
MOUNTAIN VIEW ELECTRIC ASSOCIATION
1140 E. WOODMEN RD.
FALCON, CO 80831
TELE: (800) 388-9881
ATTN: GINA PERRY
EMAIL: GINA.P@MVEA.COOP

NATURAL GAS
BLACK HILLS ENERGY
198 COUNTY LINE RD.
PALMER LAKE, CO 80133
TELE: (719) 332-5856
ATTN: BOB SWATEK
EMAIL: BOB.SWATEK@BLACKHILLSCORP.COM

FIRE
FALCON FIRE PROTECTION DISTRICT
7030 OLD MERIDIAN RD.
FALCON, CO 80831
TELE: (719) 495-4050
ATTN: TRENT HARWIG
EMAIL: THARWIG@FALCONFIREPD.ORG

COMMUNICATIONS
CENTURY LINK
ZAYO
USWEST

<p>I HEARBY CERTIFY THAT THIS ENGINEERING DOCUMENT WAS PREPARED BY ME OR UNDER MY DIRECT PERSONAL SUPERVISION AND THAT I AM A DULY LICENSED PROFESSIONAL ENGINEER UNDER THE LAWS OF THE STATE OF COLORADO.</p> <p>GREGORY LOUIS PANZA, P.E. _____ DATE: 00/00/0000 LICENSE NUMBER: 37081 MY LICENSE RENEWAL DATE IS OCTOBER 31, 2025. PAGES OR SHEETS COVERED BY THIS SEAL: - _____ - _____ - _____</p>
<p>I HEARBY CERTIFY THAT THIS ENGINEERING DOCUMENT WAS PREPARED BY ME OR UNDER MY DIRECT PERSONAL SUPERVISION AND THAT I AM A DULY LICENSED PROFESSIONAL ENGINEER UNDER THE LAWS OF THE STATE OF COLORADO.</p> <p>JEREMY D. MIRONAS, P.E. _____ DATE: 00/00/0000 LICENSE NUMBER: 47175 MY LICENSE RENEWAL DATE IS OCTOBER 31, 2025. PAGES OR SHEETS COVERED BY THIS SEAL: - _____ - _____ - _____</p>
<p>I HEARBY CERTIFY THAT THIS ENGINEERING DOCUMENT WAS PREPARED BY ME OR UNDER MY DIRECT PERSONAL SUPERVISION AND THAT I AM A DULY LICENSED PROFESSIONAL ENGINEER UNDER THE LAWS OF THE STATE OF COLORADO.</p> <p>DOUGLAS A. SULLIVAN, P.E. _____ DATE: 00/00/0000 LICENSE NUMBER: 57977 MY LICENSE RENEWAL DATE IS OCTOBER 31, 2025. PAGES OR SHEETS COVERED BY THIS SEAL: - _____ - _____ - _____</p>

<p>I HEARBY CERTIFY THAT THIS ENGINEERING DOCUMENT WAS PREPARED BY ME OR UNDER MY DIRECT PERSONAL SUPERVISION AND THAT I AM A DULY LICENSED PROFESSIONAL ENGINEER UNDER THE LAWS OF THE STATE OF COLORADO.</p> <p>KEVIN S. SPARROW, P.E. _____ DATE: 00/00/0000 LICENSE NUMBER: 47762 MY LICENSE RENEWAL DATE IS OCTOBER 31, 2025. PAGES OR SHEETS COVERED BY THIS SEAL: - _____ - _____ - _____</p>
<p>I HEARBY CERTIFY THAT THIS ENGINEERING DOCUMENT WAS PREPARED BY ME OR UNDER MY DIRECT PERSONAL SUPERVISION AND THAT I AM A DULY LICENSED PROFESSIONAL ENGINEER UNDER THE LAWS OF THE STATE OF COLORADO.</p> <p>NAME, P.E. _____ DATE: 00/00/0000 LICENSE NUMBER: 12345 MY LICENSE RENEWAL DATE IS DECEMBER 31, 2023. PAGES OR SHEETS COVERED BY THIS SEAL: - _____ - _____ - _____</p>
<p>I HEARBY CERTIFY THAT THIS ENGINEERING DOCUMENT WAS PREPARED BY ME OR UNDER MY DIRECT PERSONAL SUPERVISION AND THAT I AM A DULY LICENSED PROFESSIONAL ENGINEER UNDER THE LAWS OF THE STATE OF COLORADO.</p> <p>NAME, P.E. _____ DATE: 00/00/0000 LICENSE NUMBER: 12345 MY LICENSE RENEWAL DATE IS DECEMBER 31, 2023. PAGES OR SHEETS COVERED BY THIS SEAL: - _____ - _____ - _____</p>

DRAWN BY: Author	JOB DATE: 2024	BAR IS ONE INCH ON OFFICIAL DRAWINGS
APPROVED: Approver	JOB NUMBER: 201662.06	0 _____ 1"
CAD DATE: 7/8/2024 5:10:56 PM		IF NOT ONE INCH, ADJUST SCALE ACCORDINGLY
CAD FILE: C:\Users\kbargender\Documents\201662.06_MEP_v21_kbarg.rvt		

NO.	DATE	BY	REVISION DESCRIPTION

HRGreen
HR GREEN - COLORADO SPRINGS
1975 RESEARCH PARKWAY | SUITE 230
COLORADO SPRINGS, CO 80920
PHONE: 719.300.4140
FAX: 713.965.0044

EL PASO COUNTY, COLORADO
GRANDVIEW RESERVE DISTRICT
D.R. HORTON
COLORADO

D-R-HORTON
America's Builder

GENERAL
COVER SHEET

SHEET
G000

PCD #: PPR-24-30

LEGEND

	EXISTING	PROPOSED
MATCH LINE	---	---
PHASE LINE	---	---
SECTION LINE	---	---
PROPERTY LINE	---	---
EASEMENT LINE	---	---
RIGHT OF WAY	---	---
CENTERLINE	---	---
CHAIN LINK FENCE	---	---
WOODEN FENCE	---	---
ROD IRON FENCE	---	---
GUARDRAIL	---	---
CABLE TV	---	---
U.G. ELECTRIC	---	---
OVERHEAD ELECTRIC	---	---
FIBER OPTIC	---	---
GAS MAIN	---	---
SANITARY SEWER	---	---
STORM DRAIN	---	---
TELEPHONE	---	---
WATER MAIN	---	---
SWALE	---	---
TRAIL	---	---
CURB & GUTTER	---	---
DRAINAGE BASIN	---	---
INDEX CONTOUR	---	---
INTER. CONTOUR	---	---
100-YR FLOODPLAIN	---	---
FLOODWAY	---	---
EDGE OF WETLANDS	---	---
DRAINAGE	---	---
DRAINAGE BASIN	---	---
BASIN TAG		I.D. AREA
DESIGN POINT		▲

	EXISTING	PROPOSED
STORM SEWER		
MANHOLE	⊕	⊕
STORM INLET	⊕	⊕
FLARED END SECTION	⊕	⊕
RIPRAP	⊕	⊕
SANITARY SEWER		
CLEAN OUT	⊕	⊕
MANHOLE	⊕	⊕
PLUG	⊕	⊕
WATER		
FIRE HYDRANT	⊕	⊕
FIRE DEPT. CONNECTION	⊕	⊕
GATE VALVE	⊕	⊕
MANHOLE	⊕	⊕
METER	⊕	⊕
TEE	⊕	⊕
REDUCER	⊕	⊕
DRY UTILITIES		
ELECTRIC METER	⊕	⊕
ELECTRIC PEDESTAL	⊕	⊕
ELECTRICAL CABINET	⊕	⊕
ELECTRIC VAULT	⊕	⊕
FIBER OPTIC PULL BOX	⊕	⊕
FIBER OPTIC MANHOLE	⊕	⊕
FIBER OPTIC PEDESTAL	⊕	⊕
FIBER OPTIC SIGN	⊕	⊕
FIBER OPTIC VAULT	⊕	⊕
GAS METER	⊕	⊕
GAS SIGN	⊕	⊕
GAS VAULT	⊕	⊕
TELEPHONE CABINET	⊕	⊕
TELEPHONE MANHOLE	⊕	⊕
TELEPHONE SIGNAL/MAST	⊕	⊕
TELEPHONE SIGN	⊕	⊕
TELEPHONE PEDESTAL	⊕	⊕
TRANSFORMER	⊕	⊕
LIGHT POLE	⊕	⊕
FIBER OPTIC VAULT	⊕	⊕
MISCELLANEOUS		
SIGN	⊕	⊕
BOLLARD	⊕	⊕
ACCESSIBLE PARKING	⊕	⊕

BMP LEGEND:

⊕	CWA	CONCRETE WASHOUT AREA
---	CF	CONSTRUCTION FENCE
---	DD	DIVERSION DITCH
⊕	IP	INLET PROTECTION
⊕	OP	OUTLET PROTECTION
---	SF	SILT FENCE
---	VTC	VEHICLE TRACKING CONTR
---	SSA	STABILIZED STAGING AREA
---	LOC	LIMITS OF CONSTRUCTION
---	CD	CHECK DAM
---	SM	SEEDING AND MULCHING
⊕	SB	SEDIMENT BASIN
---	SR	SURFACE ROUGHENING
---	ECB	EROSION CONTROL BLANKE
⊕	CIP	CULVERT INLET PROTECTIO
---	RS	ROCK SOCK
---	SBB	STRAW BALE BARRIER

This legend is not needed as GEC is a standalone & separate plan set

6/2024

Xrefs: xref-1-dh01: Legend: Erosion_Control_Key

DRAWN BY: TAK	JOB DATE:	BAR IS ONE INCH ON OFFICIAL DRAWINGS.
APPROVED: JAS	JOB NUMBER:	0" = 1"
CAD DATE: 7/18/2024 1:35:39 PM		IF NOT ONE INCH, ADJUST SCALE ACCORDINGLY.
CAD FILE: J:\2020\201662.06\CAD\Dwgs\G\G003.dwg		

NO.	DATE	BY	REVISION DESCRIPTION

HRGreen
 HR GREEN - COLORADO SPRINGS
 1975 RESEARCH PARKWAY | SUITE 230
 COLORADO SPRINGS CO 80920
 PHONE: 719.300.4140
 FAX: 713.965.0044

EL PASO COUNTY, COLORADO
 GRANDVIEW RESERVE DISTRICT
 WTP WELL WATER COLLECTION
 D.R. HORTON
 COLORADO

D-R-HORTON
America's Builder

CIVIL
CIVIL LEGENDS

SHEET
C100

Xrefs: xgt-1-dh01; xc-design; OUP MEY; xv-dsgn_662; xv-row-662; xv-uti_662; xc-uti-F1-662.10; xc-dsgn-F1-662.10; xc-dgn-662.08_Eastonville; xc-design-uti; REVIT EXPORT FIRST FLOOR PROCESS PLAN

BENCHMARK:

NGS BENCHMARK F 24
A STAMPED DISK, STAMPED F 24 1929 AND SET IN TOP OF A CONCRETE POST PROJECTING ABOUT 6 INCHES ABOVE GROUND. ALONG THE CHICAGO, ROCK ISLAND AND PACIFIC RAILROAD, 52 NORTHWEST OF THE CENTERLINE OF U.S. HIGHWAY 24, 48 FEET SOUTHEAST OF THE CENTERLINE OF THE TRACK. NAVD88 ELEVATION 6866.33.


BASIS OF BEARING:

THE NORTH LINE OF SECTION 28, TOWNSHIP 12 SOUTH, RANGE 64 WEST OF THE 6TH PRINCIPAL MERIDIAN, EL PASO COUNTY, COLORADO, BEING MONUMENTED AT EACH END BY A 3-1/4" ALUMINUM SURVEYORS CAP STAMPED "PSINC 30087" AND ASSUMED TO BEAR S89°47'04"E, A DISTANCE OF 5285.07 FEET.



GENERAL NOTES:

1. "SCREENED" (LIGHT) DELINEATION SHOWN IN THIS SHEET DENOTES EXISTING CONDITIONS. "SCREENED" INFORMATION WAS TAKEN FROM PREVIOUS CONSTRUCTION DRAWINGS AND FIELD SURVEY, IS FOR REFERENCE ONLY, AND SHALL BE FIELD VERIFIED BY THE CONTRACTOR PRIOR TO ORDERING OF MATERIALS AND BEGINNING CONSTRUCTION. "BOLD" DELINEATION IS NEW WORK TO BE CONSTRUCTED UNDER THIS CONTRACT.
2. ALL INFORMATION PROVIDED WAS TAKEN FROM SURVEYS AND/OR EXISTING PLANS. IT SHALL BE THE CONTRACTOR'S RESPONSIBILITY TO FIELD VERIFY ALL HORIZONTAL AND VERTICAL INFORMATION BEFORE BEGINNING ANY WORK.
3. CONTRACTOR SHALL MAKE PROVISIONS TO MAINTAIN EXISTING LEVEL OF SECURITY AT SITE AT ALL TIMES.
4. OWNER IS NOT RESPONSIBLE FOR SECURED/UNSECURED STORED MATERIALS STORED ON SITE.
5. ALL WORK INVOLVED IN THIS PROJECT SHALL BE CONSTRUCTED ON DEVELOPER OWNED LAND, EL PASO COUNTY OWNED RIGHT-OF-WAY, OR ON EASEMENTS OBTAINED BY THE DEVELOPER. CONTRACTOR SHALL RESTRICT CONSTRUCTION OPERATIONS TO WITHIN THE DESIGNATED RIGHT-OF-WAY OR CONSTRUCTION EASEMENTS. ACCESS TO ALL WORK AREAS SHALL BE BY ACCESS EASEMENTS DEFINED ON DRAWINGS. NO MATERIALS, EXCAVATED MATERIAL, OR MATERIAL, OR EQUIPMENT SHALL BE STORED ON, PARKED ON, DEPOSITED ON, OR DRIVEN OVER ANY PRIVATE PROPERTY UNLESS WRITTEN AUTHORIZATION IS OBTAINED FROM THE PROPERTY OWNER BY THE CONTRACTOR. A COPY OF SUCH WRITTEN AGREEMENT SHALL BE PROVIDED TO THE CITY AND THE ENGINEER. UPON COMPLETION, CONTRACTOR SHALL PROVIDE TO THE CITY AND THE ENGINEER A WRITTEN RELEASE SIGNED BY THE PROPERTY OWNER.
6. CONTRACTOR SHALL MEASURE, RECORD, AND SUBMIT RECORD DRAWINGS AS REQUIRED IN CLOSEOUT SUBMITTALS SPECIFICATION SECTION. ADDITIONALLY, THE CONTRACTOR IS RESPONSIBLE FOR COORDINATING WITH THE ENGINEER DURING CONSTRUCTION AND SHALL PROVIDE ACCESS TO ALL UTILITIES PRIOR TO BEING BURIED, ALLOWING ACCURATE HORIZONTAL AND VERTICAL MEASUREMENTS TO BE ACQUIRED BY THE ENGINEER OR OWNER'S SURVEYOR. IN THE EVENT OF ANY DISCREPANCIES IDENTIFIED BY WOODMENHILLS METROPOLITAN DISTRICT (WHMD) AND AT NO COST TO WHMD, THE CONTRACTOR SHALL VERIFY THE LOCATION AND MEASUREMENTS OF ANY BURIED UTILITIES.
7. THE CONTRACTOR SHALL VIDEO RECORD THE ENTIRE PROJECT PRIOR TO BEGINNING CONSTRUCTION ACTIVITIES FOR THE PURPOSE OF DOCUMENTING EXISTING CONDITIONS. THE CONTRACTOR SHALL PROVIDE ONE COPY TO THE OWNER AND ONE COPY TO THE ENGINEER PRIOR TO PROCEEDING WITH ANY FIELD WORK.
8. TYPICAL WHMD STANDARDS AND SPECIFICATIONS ARE CALLED OUT PERIODICALLY THROUGHOUT PROJECT DOCUMENTS TO PROVIDE CLARIFICATION TO THE WHMD STANDARD SPECIFICATIONS OR FOR CONTRACTOR REFERENCE. CONTRACTOR SHALL COMPLY WITH ALL APPLICABLE WHMD STANDARD SPECIFICATIONS. WHMD REFERENCE CALLOUTS DO NOT NEGATE CONTRACTOR FROM FOLLOWING ANY WHMD SPECIFICATIONS NOT EXPLICITLY CALLED OUT IN PROJECT DRAWINGS.
9. CONTRACTOR SHALL CONTACT THE PRINCIPAL INSPECTOR 24 HOURS BEFORE BEGINNING CONSTRUCTION. CONTACT INFORMATION WILL BE PROVIDED AT THE PRECONSTRUCTION MEETING.
10. TEMPORARY FENCING: CONTRACTOR SHALL INSTALL AND MAINTAIN CONSTRUCTION FENCE AND PEDESTRIAN PROTECTION IN CONFORMANCE WITH THE INTERNATIONAL BUILDING CODE FOR THE DURATION OF THE PROJECT. PROVIDE TEMPORARY FENCING AROUND ANY OPEN EXCAVATION DURING CONSTRUCTION TO PROHIBIT UNAUTHORIZED ENTRANCE. FENCES SHALL BE CLOSED AT NIGHT. TEMPORARY FENCE MINIMUM 6' TALL CHAIN LINK.
11. DURING REMOVAL AND CONSTRUCTION THE CONTRACTOR SHALL USE ALL MEANS NECESSARY TO CONTROL DUST SPREADING FROM ALL WORK AND STAGING AREAS. DUST CONTROL MEASURES SHALL BE IN ACCORDANCE WITH COLORADO SPRINGS STORMWATER ENTERPRISE (SWENT) STORMWATER CONSTRUCTION MANUAL, BE APPROVED BY THE ENGINEER AND SHALL BE CONSIDERED INCIDENTAL TO THE PROJECT.
12. CONTRACTOR RESPONSIBLE TO CLEAN ALL TRACKED DIRT FROM PAVED SURFACES AT END OF EACH WORK DAY. CONTRACTOR RESPONSIBLE TO SWEEP HAUL AND STAGING ROUTE AS NECESSARY TO KEEP CLEAR OF DIRT AND DEBRIS. WATER SHALL BE USED DURING STREET SWEEPING EXCEPT DURING FREEZING CONDITIONS.
13. THE EXISTING CONDITION FOR THE PROPOSED PROJECT SITE WAS NATIVE GRASS WITH NO EXISTING BUILDINGS.
14. TRAFFIC PATTERNS FOR PROJECT SITE WILL BE MAINTENANCE AS REQUIRED.
15. NO SIGNS ARE ANTICIPATED FOR THE PROPOSED PROJECT SITE.
16. ADA PARKING SPACES WILL NOT BE LOCATED AT THE WATER TREATMENT PLANT AS IT WILL NOT BE ACCESSIBLE TO THE PUBLIC.

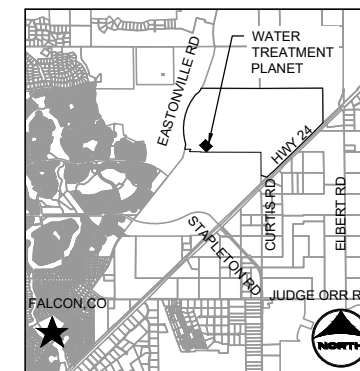


KEYMAP

PROJECT LEGEND:

--- (dashed line)	PROPERTY LINE
--- (dashed line)	RIGHT-OF-WAY LINE
--- (dashed line)	SECTION LINE
--- (dashed line)	EDGE OF PAVEMENT
--- (dashed line)	EXISTING FENCE
--- (dashed line)	EXISTING ELECTRIC LINE
--- (dashed line)	GAS
--- (dashed line)	EXISTING GAS LINE
--- (dashed line)	EXISTING STORM DRAIN
--- (dashed line)	EXISTING WATERMAIN
--- (dashed line)	EXISTING WATER VALVE
--- (dashed line)	PROPOSED WATER SERVICE
--- (dashed line)	PROPOSED SANITARY SEWER
--- (dashed line)	PROPOSED SANITARY MANHOLE
--- (dashed line)	EXISTING MAJOR CONTOUR
--- (dashed line)	EXISTING MINOR CONTOUR
--- (dashed line)	PROPOSED MAJOR CONTOUR
--- (dashed line)	PROPOSED ELECT. EQUIPMENT
--- (dashed line)	PROPOSED DRIVEWAY
--- (dashed line)	PROPOSED CHEMICAL TANK
--- (dashed line)	PROPOSED EMERGENCY STORAGE
--- (dashed line)	FUTURE EMERGENCY STORAGE
--- (dashed line)	FUTURE PLUG VALVE
--- (dashed line)	LIMITS OF CONSTRUCTION

Provide location, acreage and legal descriptions of the water lines also. Answer should identify all the parcels or roadways the lines will cross over.

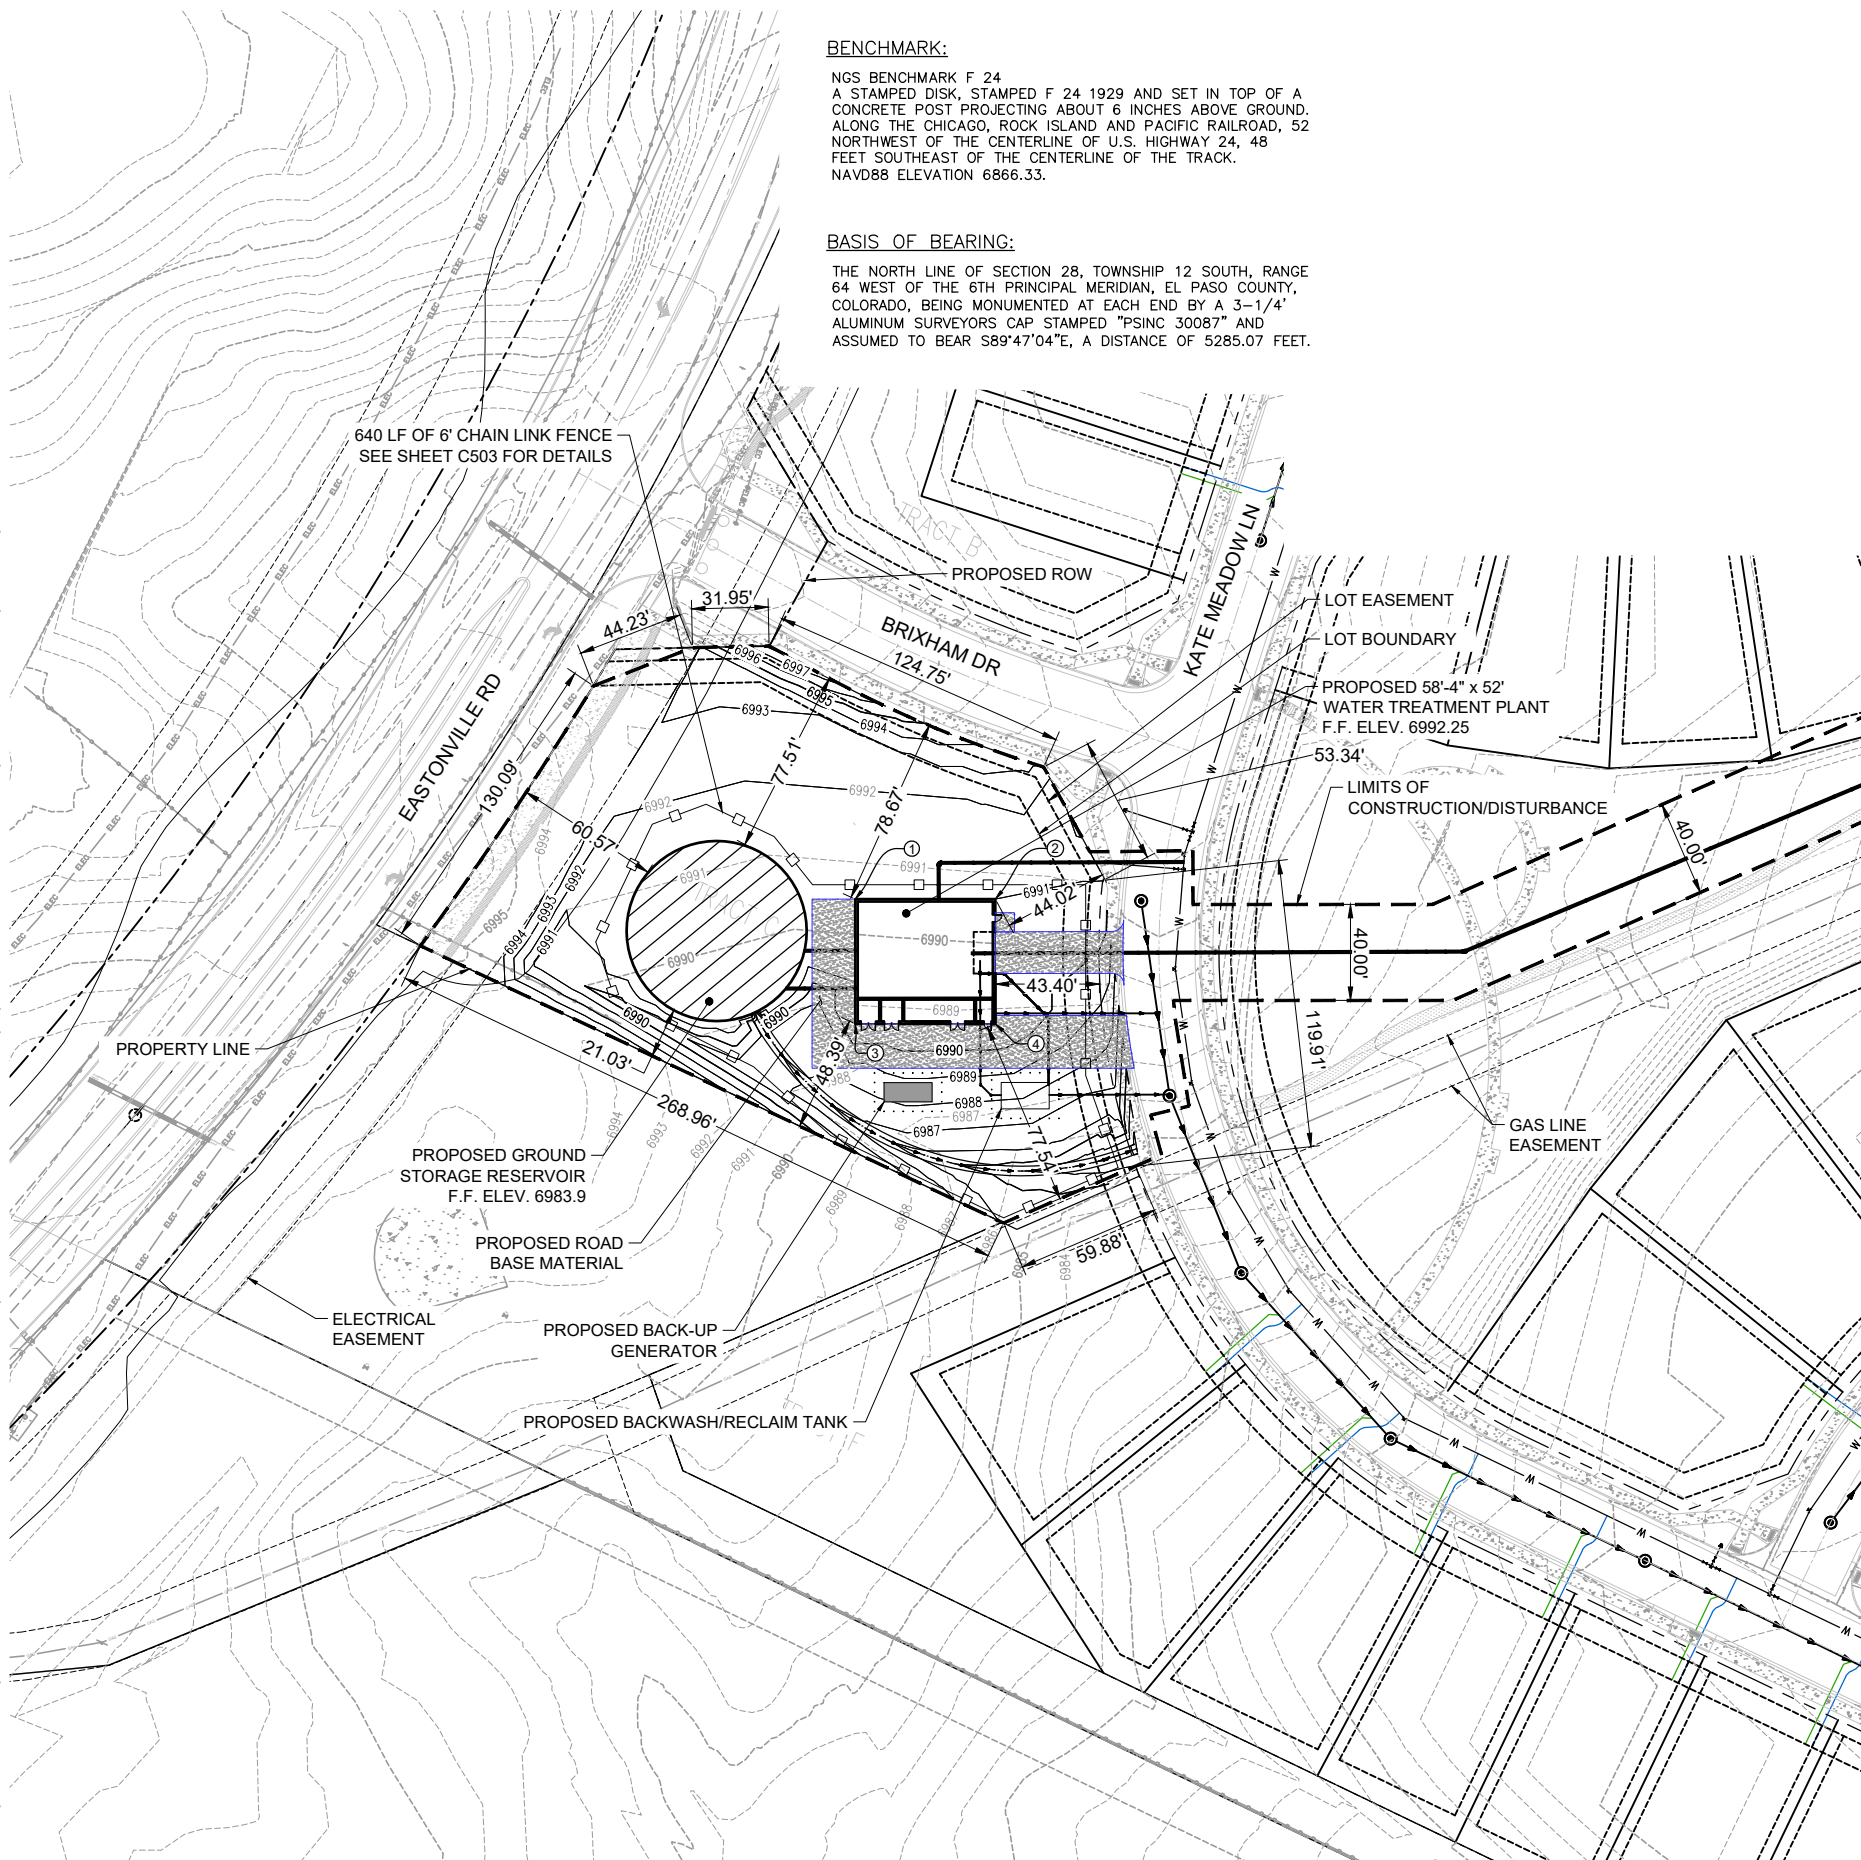

STRUCTURE LOCATES			
Point #	Northing	Easting	Description
1	1419448.07	3295044.01	GRID LINE 1C
2	1419473.15	3295096.67	GRID LINE 5C
3	1419401.12	3295096.36	GRID LINE 1A
4	1419426.20	3295119.03	GRID LINE 5A



JES
JAS
8/16/2024 12:13:20 PM
J:\2020\201662.06\CAD\Dwgs\C\C101-SITE PLAN.dwg

Sheet border is missing

CIVIL
SITE PLAN

C101



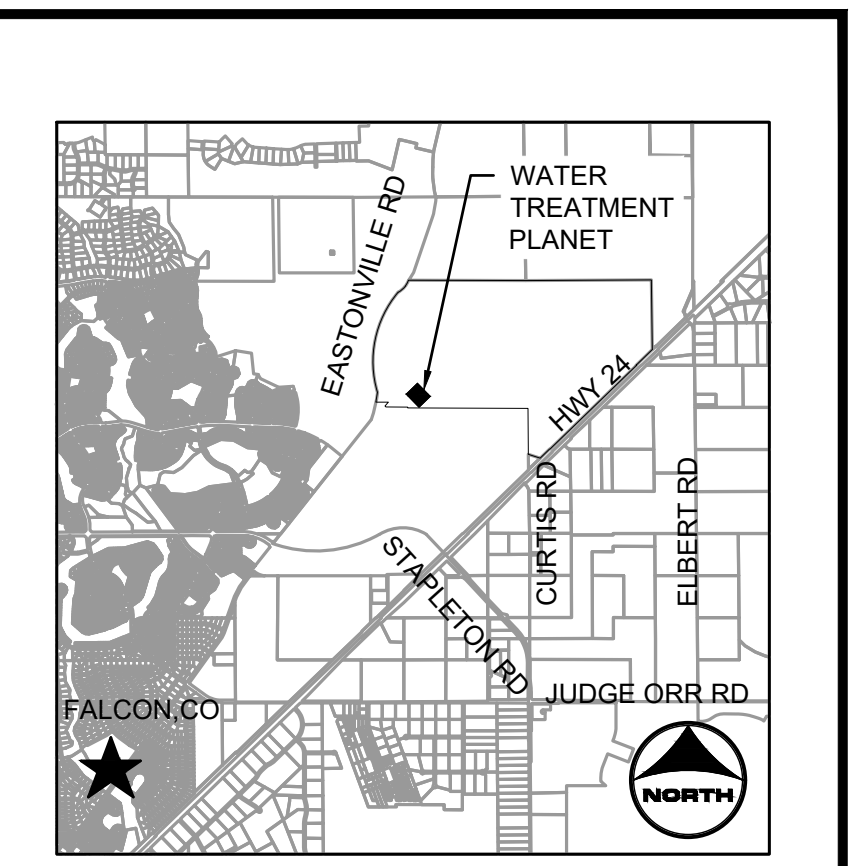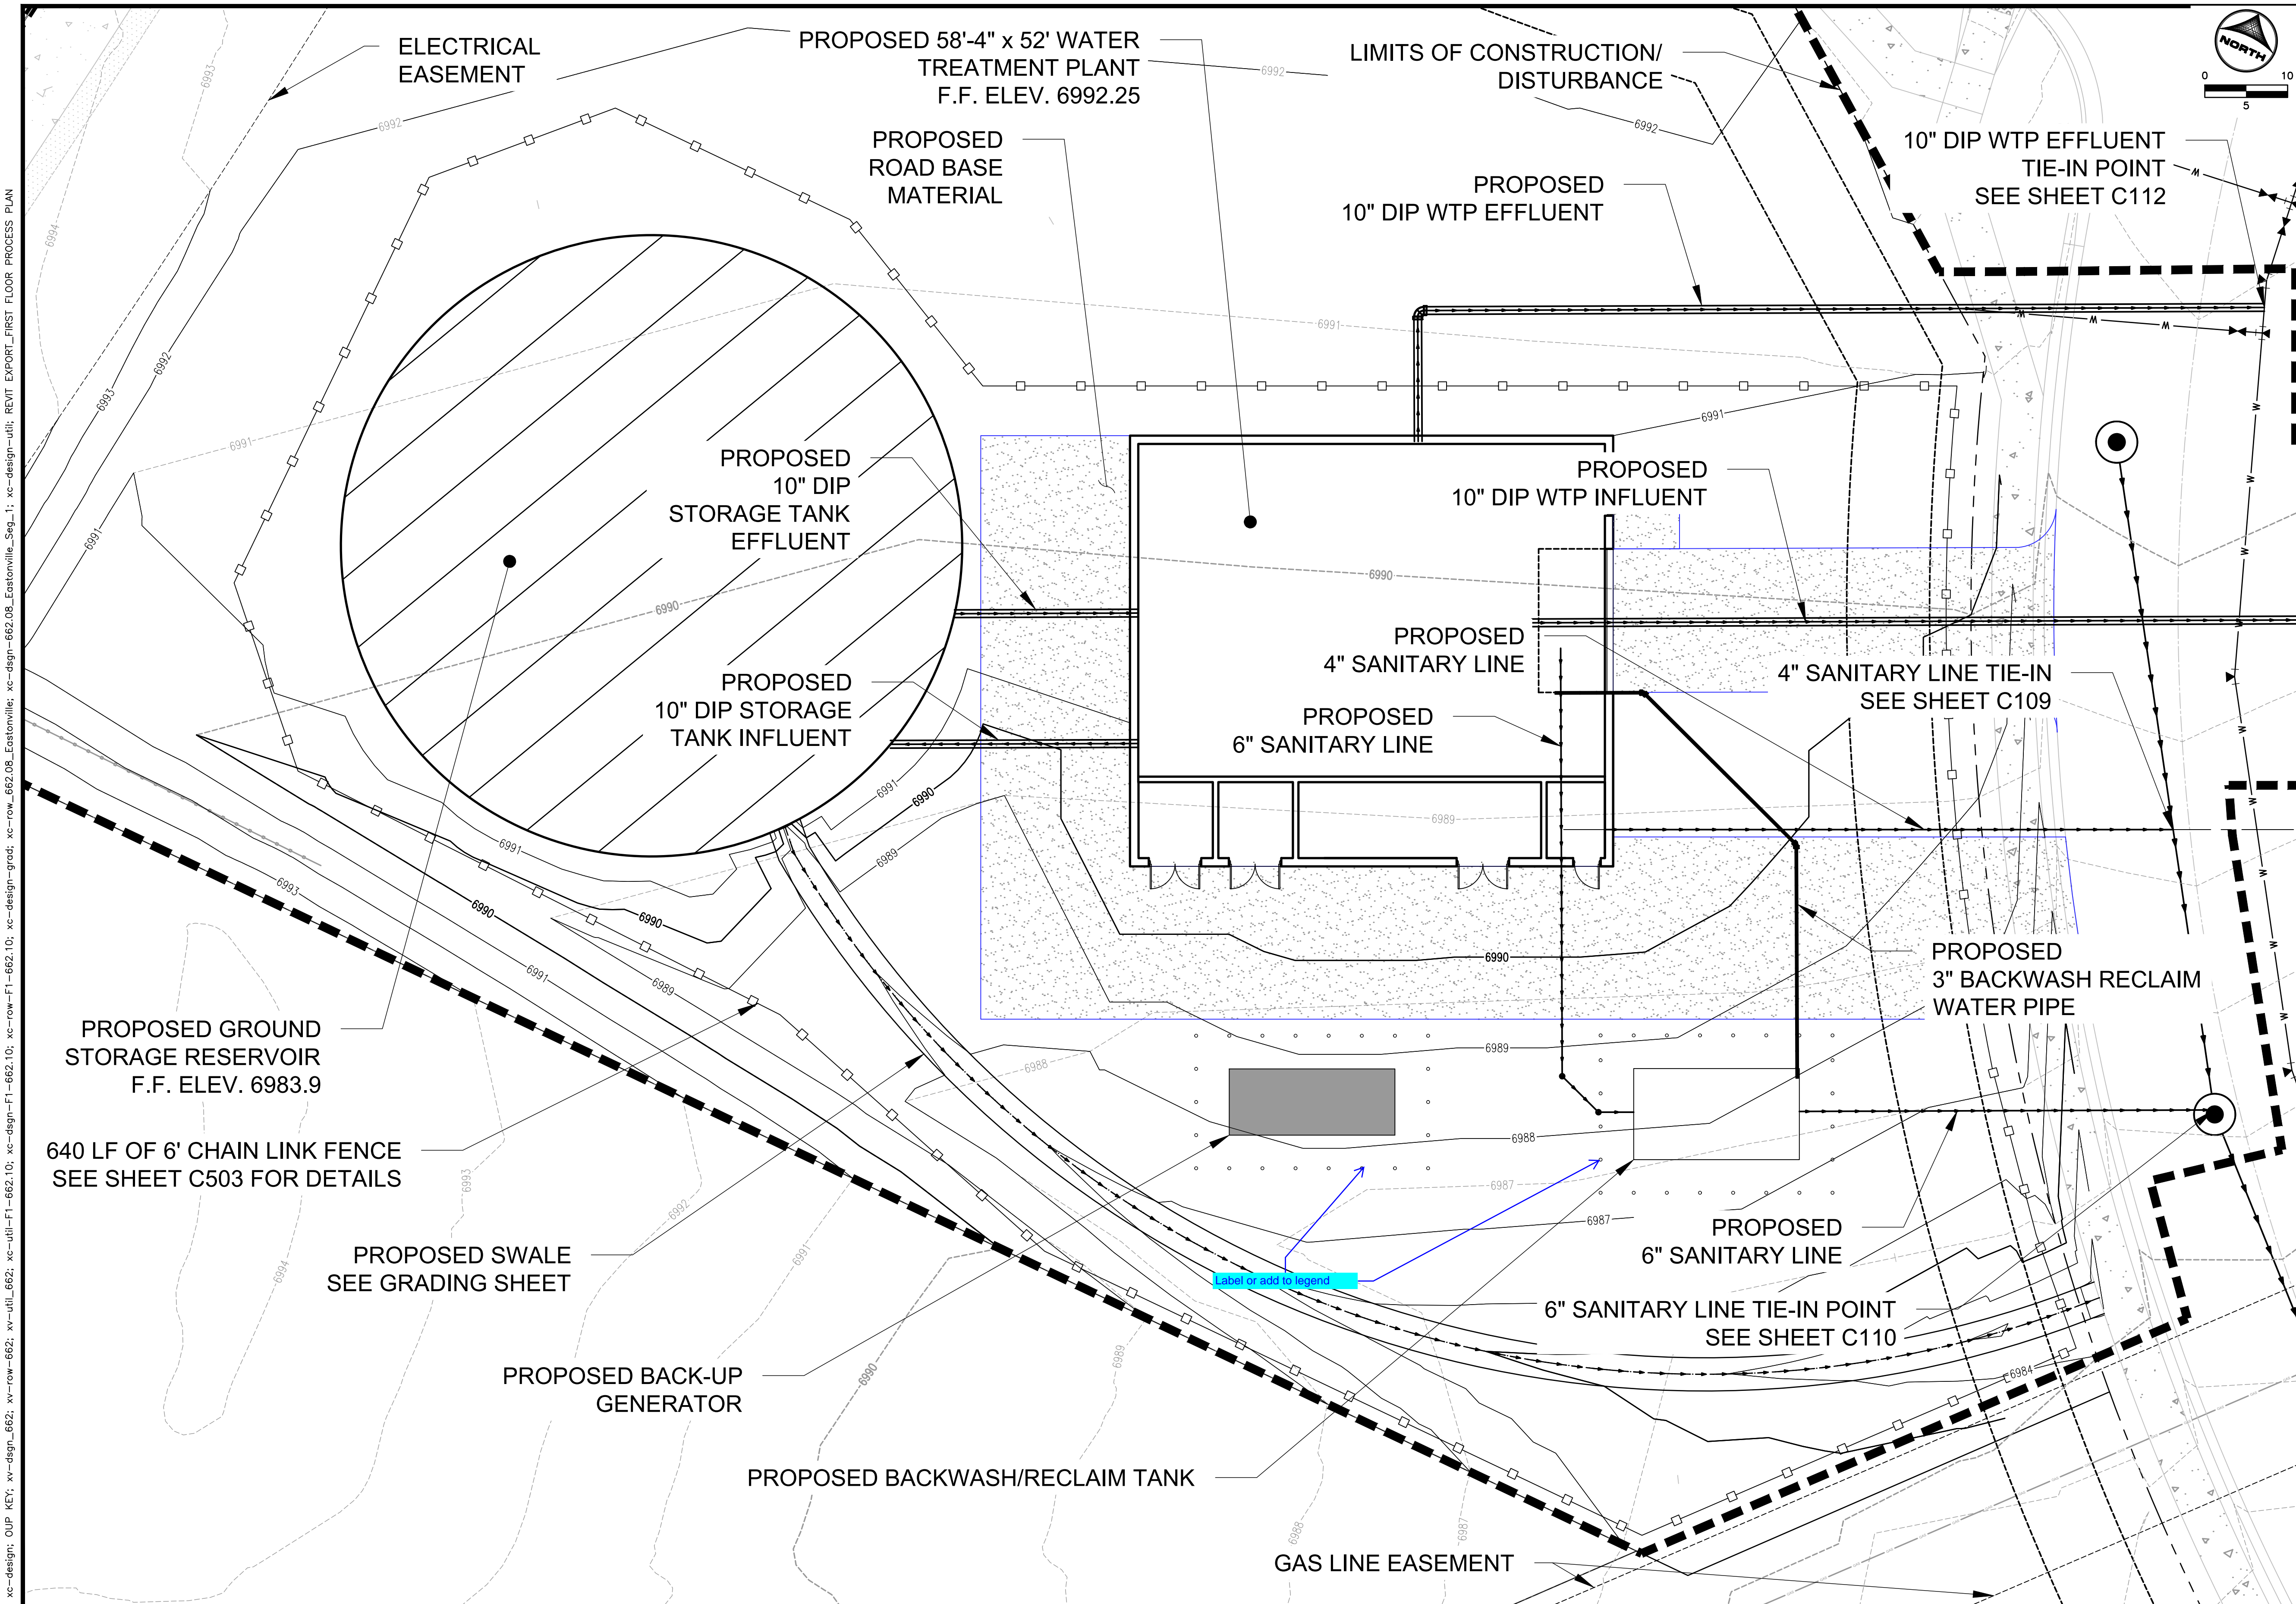

- PROJECT LEGEND:**
- PROPERTY LINE
 - - - RIGHT-OF-WAY LINE
 - - - SECTION LINE
 - - - EDGE OF PAVEMENT
 - - - EXISTING FENCE
 - - - EXISTING ELECTRIC LINE
 - - - EXISTING GAS LINE
 - - - EXISTING STORM DRAIN
 - - - EXISTING WATERMAIN
 - - - EXISTING WATER VALVE
 - - - PROPOSED WATER SERVICE
 - - - PROPOSED SANITARY SEWER
 - - - PROPOSED SANITARY MANHOLE
 - - - EXISTING MAJOR CONTOUR
 - - - EXISTING MINOR CONTOUR
 - - - PROPOSED MAJOR CONTOUR
 - - - PROPOSED ELECT. EQUIPMENT
 - - - PROPOSED DRIVEWAY
 - - - PROPOSED CHEMICAL TANK
 - - - PROPOSED EMERGENCY STORAGE
 - - - FUTURE EMERGENCY STORAGE
 - - - FUTURE PLUG VALVE
 - - - LIMITS OF CONSTRUCTION

811 UNCC
CALL BEFORE
YOU DIG
811
OR
1-800-922-1987
Utility Notification
Center of Colorado

DRAWN BY: TAK JOB DATE: _____
 APPROVED: JAS JOB NUMBER: _____
 CAD DATE: 8/9/2024 9:13:39 AM
 CAD FILE: J:\2020\201662.06\CAD\Drawings\C101-SITE PLAN - ZOOMED_IN.dwg

BAR IS ONE INCH ON OFFICIAL DRAWINGS.
 IF NOT ONE INCH, ADJUST SCALE ACCORDINGLY.
 ZOOMED IN.dwg


NO.	DATE	BY	REVISION DESCRIPTION

HRGreen
 HR GREEN - COLORADO SPRINGS
 1975 RESEARCH PARKWAY | SUITE 230
 COLORADO SPRINGS CO 80920
 PHONE: 719.300.4140
 FAX: 713.965.0044

EL PASO COUNTY, COLORADO
 GRANDVIEW RESERVE DISTRICT
 WTP WELL WATER COLLECTION
D.R. HORTON
America's Builder
 COLORADO

CIVIL
 SITE PLAN - CONSOLIDATED VIEW

SHEET
C103

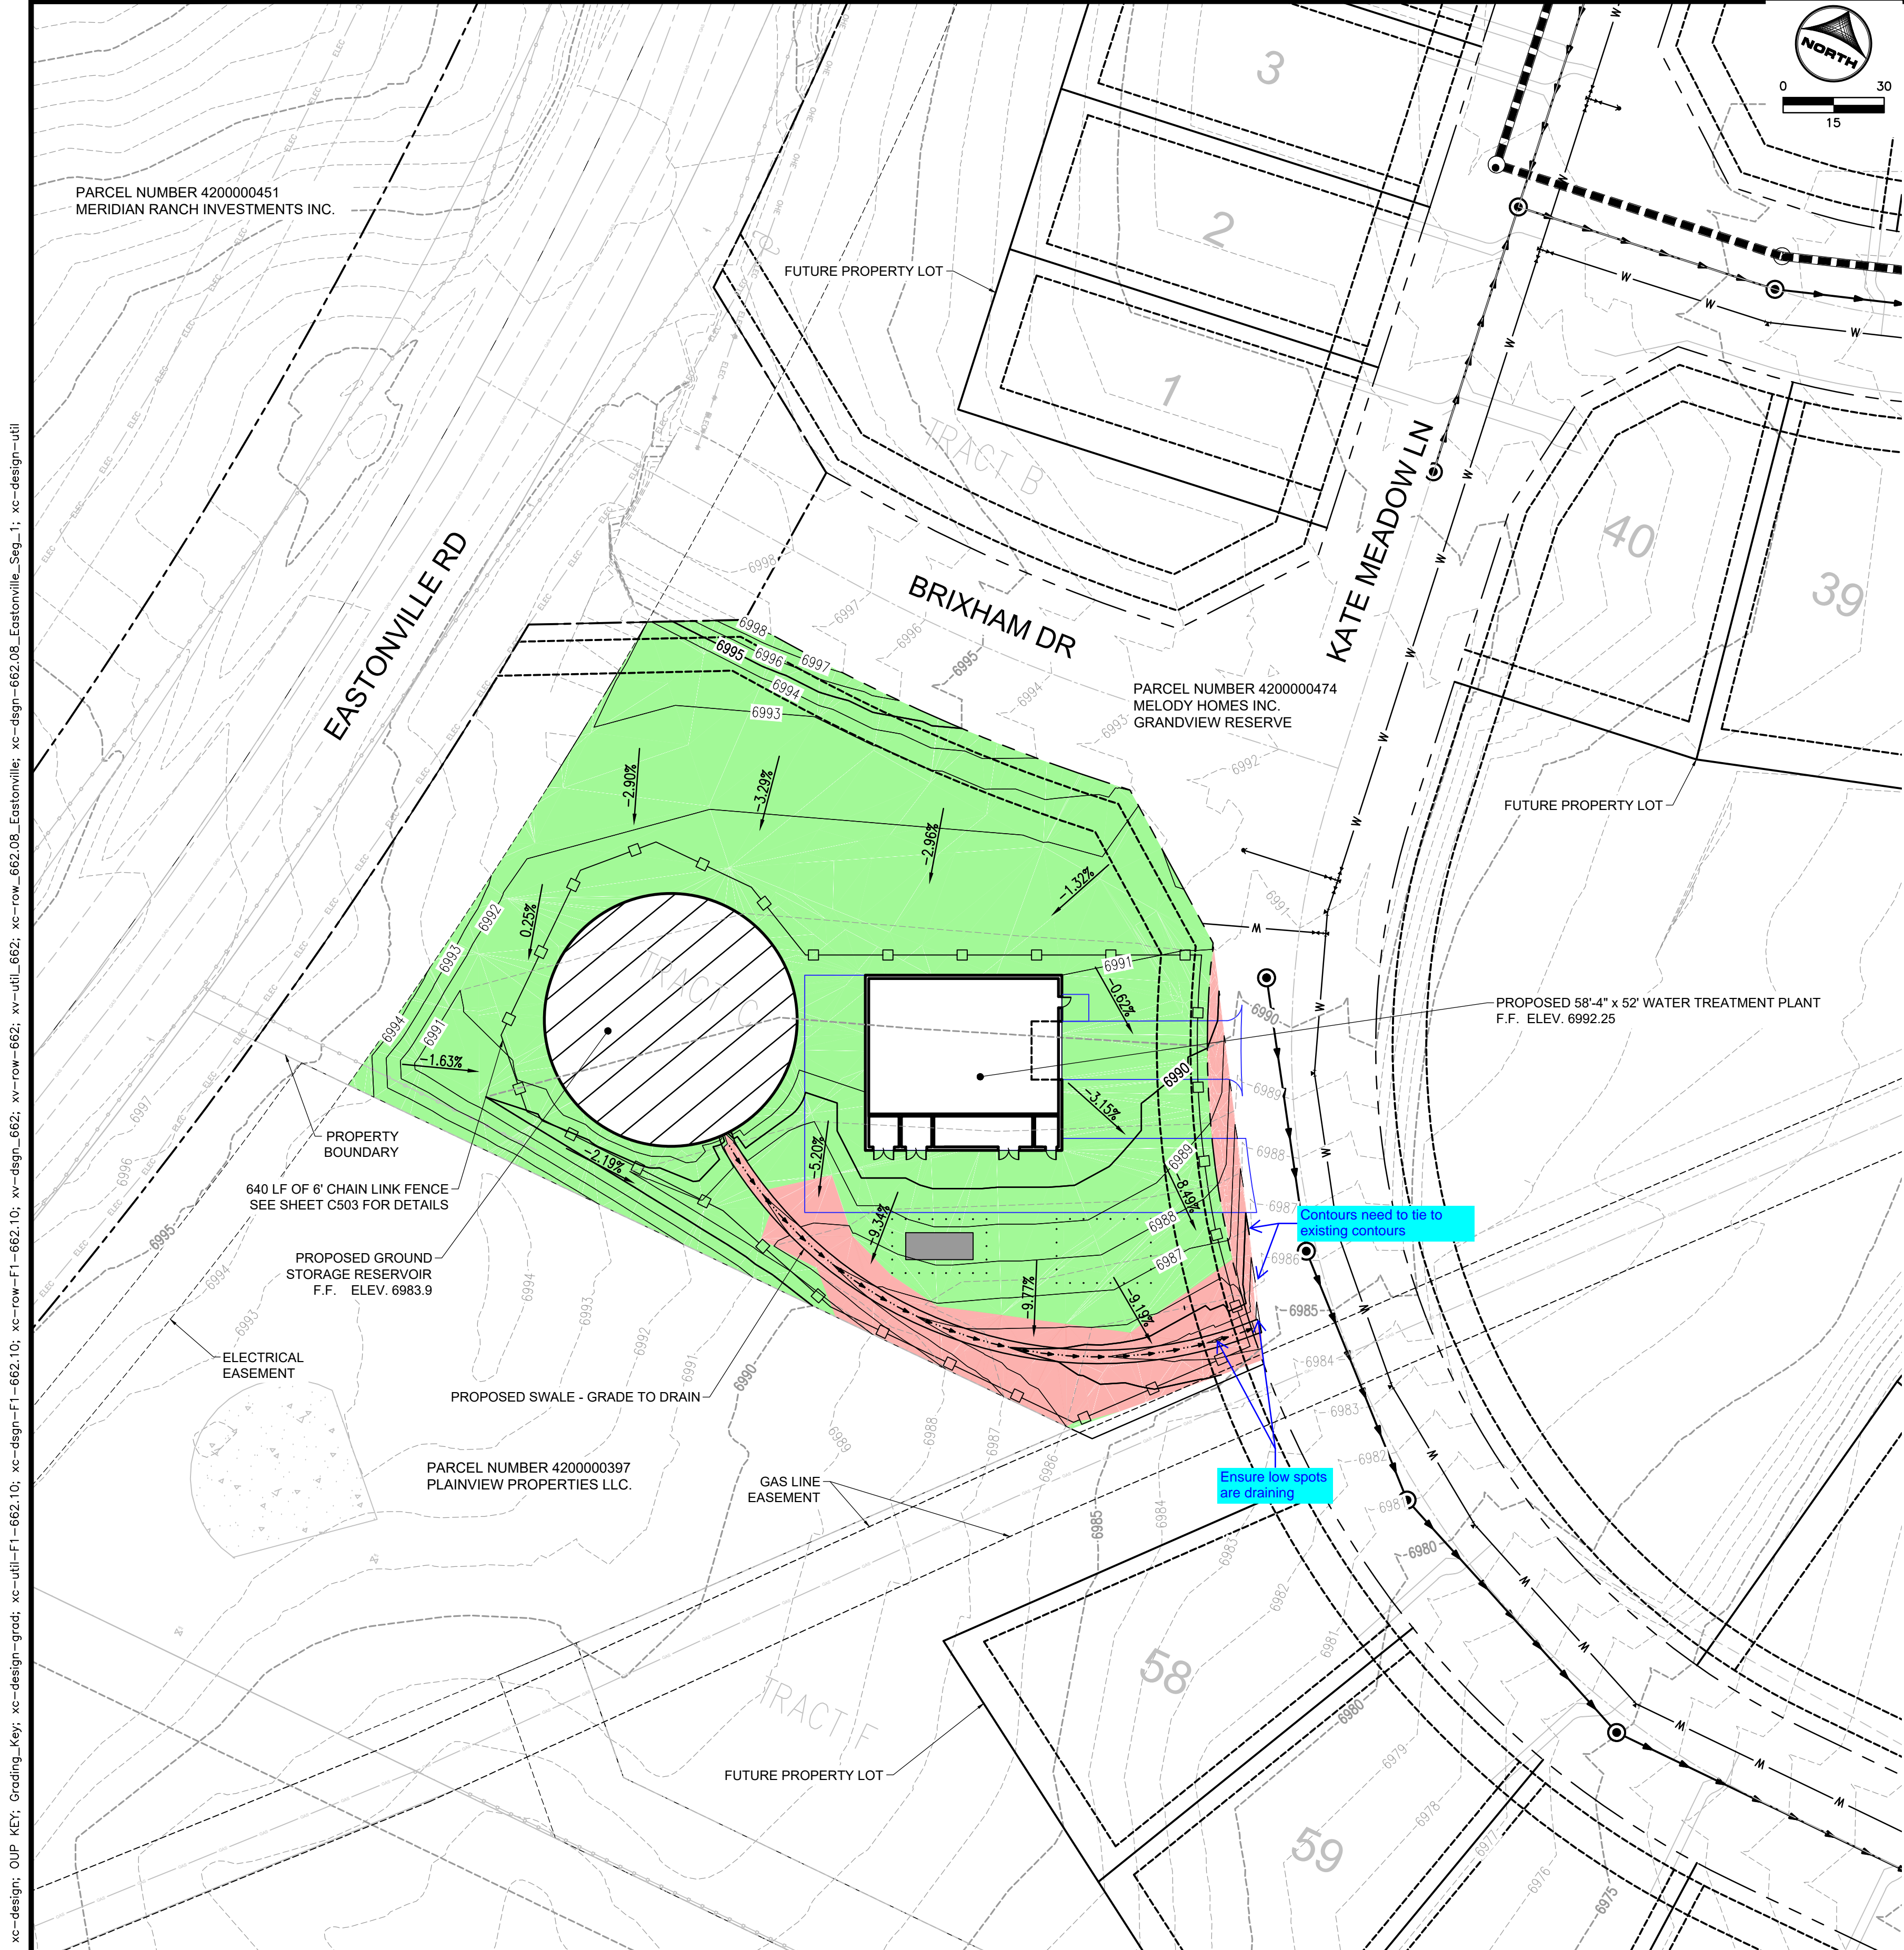



GENERAL NOTES:

(GENERAL NOTES CONTAIN EXCERPTS FROM THE GEOTECHNICAL REPORT THAT ARE IN NO WAY MEANT TO RELIEVE CONTRACTOR FROM INFORMATION CONTAINED IN THE GEOTECHNICAL REPORT.)

- REFER TO SHEET S.000 FOR ADDITIONAL GEOTECHNICAL REQUIREMENTS.
- CONTRACTOR SHALL COMPLY WITH SPECIFICATION SECTION 31 5000 FOR SUPPORTS AND PROTECTION.
- CONTRACTOR SHALL COMPLY WITH TECHNICAL SPECIFICATIONS AND WOODMENHILLS METROPOLITAN DISTRICT WATER AND WASTEWATER STANDARD SPECIFICATIONS FOR DEWATERING, GRADING, EXCAVATION, FILL AND BACKFILL, AND TRENCHING. SEE GEOTECHNICAL INVESTIGATION REPORT FOR EARTHWORK RECOMMENDATIONS. INSTALL EARTHWORK ACCORDING TO WOODMENHILLS METROPOLITAN DISTRICT WATER AND WASTEWATER STANDARD SPECIFICATIONS AND RECOMMENDATIONS FROM THE GEOTECHNICAL INVESTIGATION REPORT.
- WATER LEVELS WERE OBSERVED WITHIN THE DEPTHS OF PLANNED EXCAVATION FOR THE PROPOSED STRUCTURES. DEWATERING WILL BE REQUIRED WHERE SEEPAGE IS ENCOUNTERED. GROUNDWATER LEVELS SHOULD BE MAINTAINED AT LEAST TWO FEET BELOW BOTTOM OF EXCAVATION UNTIL FOUNDATION SLABS ARE COMPLETED. THE CONTRACTOR IS RESPONSIBLE FOR EMPLOYING APPROPRIATE DEWATERING METHODS TO CONTROL SEEPAGE INTO THE EXCAVATION. SEE GEOTECHNICAL REPORT AND SPECIFICATION SECTION 31 2319 FOR MORE INFORMATION ON DEWATERING.
- IN AREAS TO ACCEPT FILL, THE TOP 12 INCHES OF THE GROUND SURFACE SHALL BE SCARIFIED AND COMPACTED TO ELIMINATE A PLANE OF WEAKNESS ALONG THE CONTACT SURFACE. EACH LIFT PLACED ABOVE THE FOUNDATION LEVEL SHOULD BE COMPACTED TO AT LEAST 95 PERCENT OF THE SOIL'S STANDARD PROCTOR DENSITY (ASTM D698). THE MOISTURE CONTENT OF THE COHESIVE SOILS SHOULD BE MAINTAINED WITHIN A RANGE OF 0 PERCENT BELOW TO 4 PERCENT ABOVE THE MATERIALS STANDARD PROCTOR OPTIMUM MOISTURE CONTENT.
- GENERAL FILL MATERIAL TO COMPLY WITH WOODMENHILLS METROPOLITAN DISTRICT WATER AND WASTEWATER STANDARD SPECIFICATIONS AND SHALL BE FREE OF FOREIGN SUBSTANCE, DEBRIS, LARGE STONES, ROCKS, ROOTS, ORGANIC OR FROZEN MATERIAL, EXPANSIVE MATERIAL AND OTHER DELETERIOUS MATERIALS. UNSUITABLE SOILS SHALL BE DISPOSED OF BY THE CONTRACTORS.
- FILL SHALL NOT BE FROZEN AND SHALL NOT BE PLACED ON A FROZEN SURFACE. ALL COHESIVE SOILS USED AS FILL AT THIS SITE SHALL HAVE A MAXIMUM LIQUID LIMIT OF 45 AND A MAXIMUM PLASTICITY INDEX OF 20.
- ENSURE THAT PREVIOUSLY COMPACTED LIFTS ARE SCARIFIED 2 INCHES DEEP PRIOR TO COMPACTING THE NEXT LIFT.
- REMOVE, STOCKPILE, AND REPLACE NATIVE MATERIAL 8 INCHES (TOP SOIL) BELOW EXISTING SURFACE FOR ALL AREAS DISTURBED (NOT SURFACED WITH GRAVEL, RIPRAP, OR OTHER DESIGNATED MATERIALS) WITHIN THE LIMITS OF CONSTRUCTION. NO ADDITIONAL PAYMENT WILL BE MADE FOR TOPSOIL OR MATERIAL THAT THE CONTRACTOR NEEDS TO IMPORT FROM OFFSITE. SEE SHEET X.XXX FOR ADDITIONAL STOCKPILING NOTES.
- SITE GRADING SHALL PROVIDE FOR POSITIVE DRAINAGE AWAY FROM ALL STRUCTURES AND FOUNDATIONS UNLESS NOTED OTHERWISE.
- FENCING SHALL COMPLY WITH SPECIFICATION SECTION 32 3119. SEE TYPICAL DETAILS.

SITE DATA:

- PARCEL: 4200000474
 - PROPERTY ADDRESS: PLAT #SF2311 TRACT C
 - EXISTING ZONING: PUD, RR-2.5
 - PARCEL SIZE: 176.7 ACRES
 - LEGAL DESCRIPTION: A TRACT OF LAND BEING IN THE SOUTHWEST QUARTER OF SECTION 21, AND A PORTION OF THE NORTHWEST QUARTER OF SECTION 28, TOWNSHIP 12 SOUTH, RANGE 64 WEST OF THE 6TH PRINCIPAL MERIDIAN, COUNTY OF EL PASO, COLORADO
 - EXISTING LAND USE IS UNDEVELOPED/NATURAL CONDITIONS
 - WATER TREATMENT PLANT LOT AREA: 1.04 ACRES
 - BUILDING: 3033 SF (7451 SF WITH TANK)
 - PARKING WILL BE FOR MAINTENANCE ONLY
- OPEN SPACE/LANDSCAPING - 73.1%
IMPERMEABLE SURFACE - 26.1%

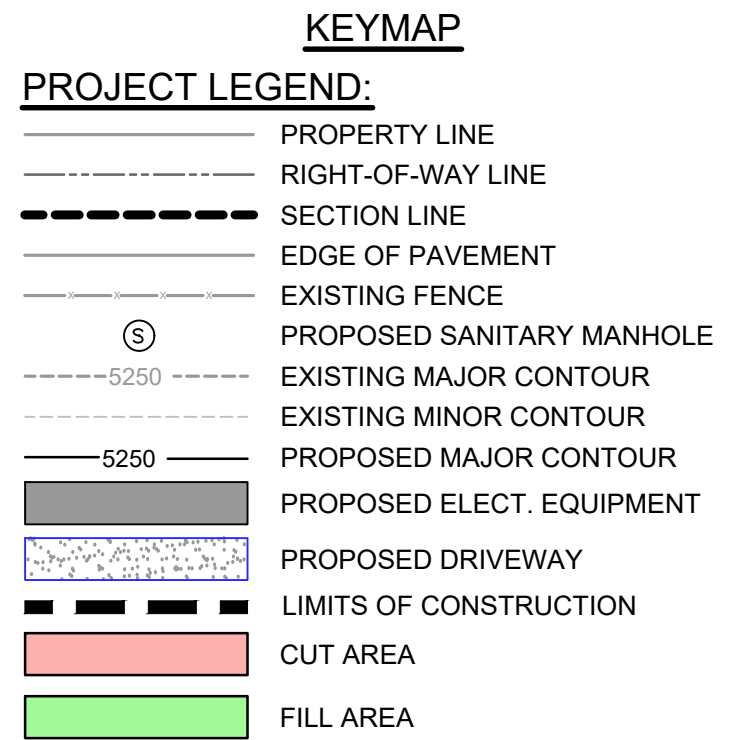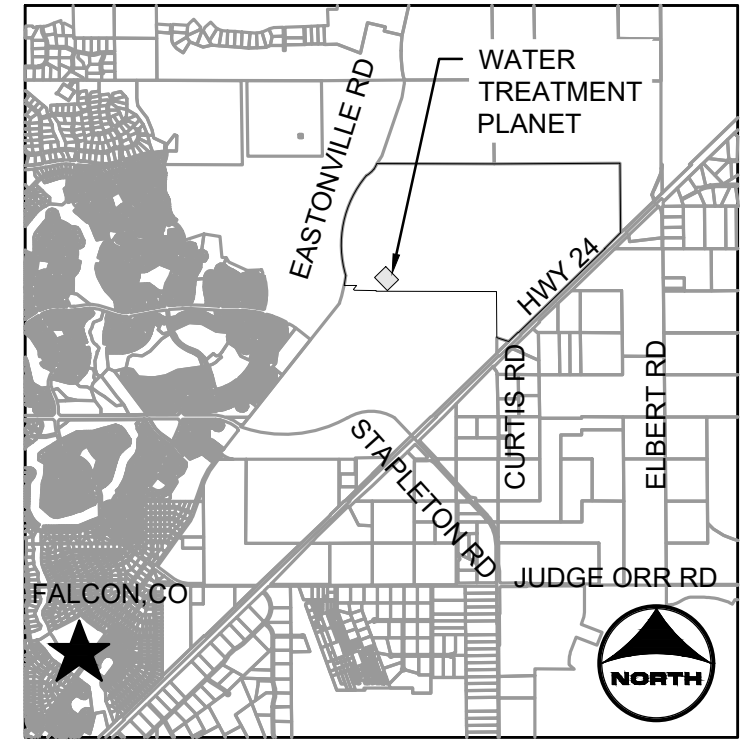

DRAWN BY: TAK JOB DATE: _____
 APPROVED: JAS JOB NUMBER: _____
 CAD DATE: 8/9/2024 10:33:59 AM
 CAD FILE: J:\2020\201662.06\CAD\Dwgs\C\104-SITE GRADING PLAN.dwg

BAR IS ONE INCH ON OFFICIAL DRAWINGS.
 IF NOT ONE INCH, ADJUST SCALE ACCORDINGLY.

NO.	DATE	BY	REVISION DESCRIPTION


HRGreen
 HR GREEN - COLORADO SPRINGS
 1975 RESEARCH PARKWAY | SUITE 230
 COLORADO SPRINGS CO 80920
 PHONE: 719.300.4140
 FAX: 713.965.0044

EL PASO COUNTY, COLORADO
 GRANDVIEW RESERVE DISTRICT
 WTP WELL WATER COLLECTION
 D.R. HORTON
 COLORADO

CIVIL
SITE GRADING PLAN

SHEET
C104

Xrefs: xgt-1-dt01: xc-design; DUP KEY: xv-dsgn-662; xv-row-662; xv-uti_662; xc-uti-F1-662.10; xc-dsgn-F1-662.10; xc-row-F1-662.10; xc-dsgn-grd: xc-dsgn-662.06_Eastonville; xc-dsgn-662.06_Eastonville_Seg_1; xc-design-uti: REVIT EXPORT_FIRST FLOOR PROCESS PLAN

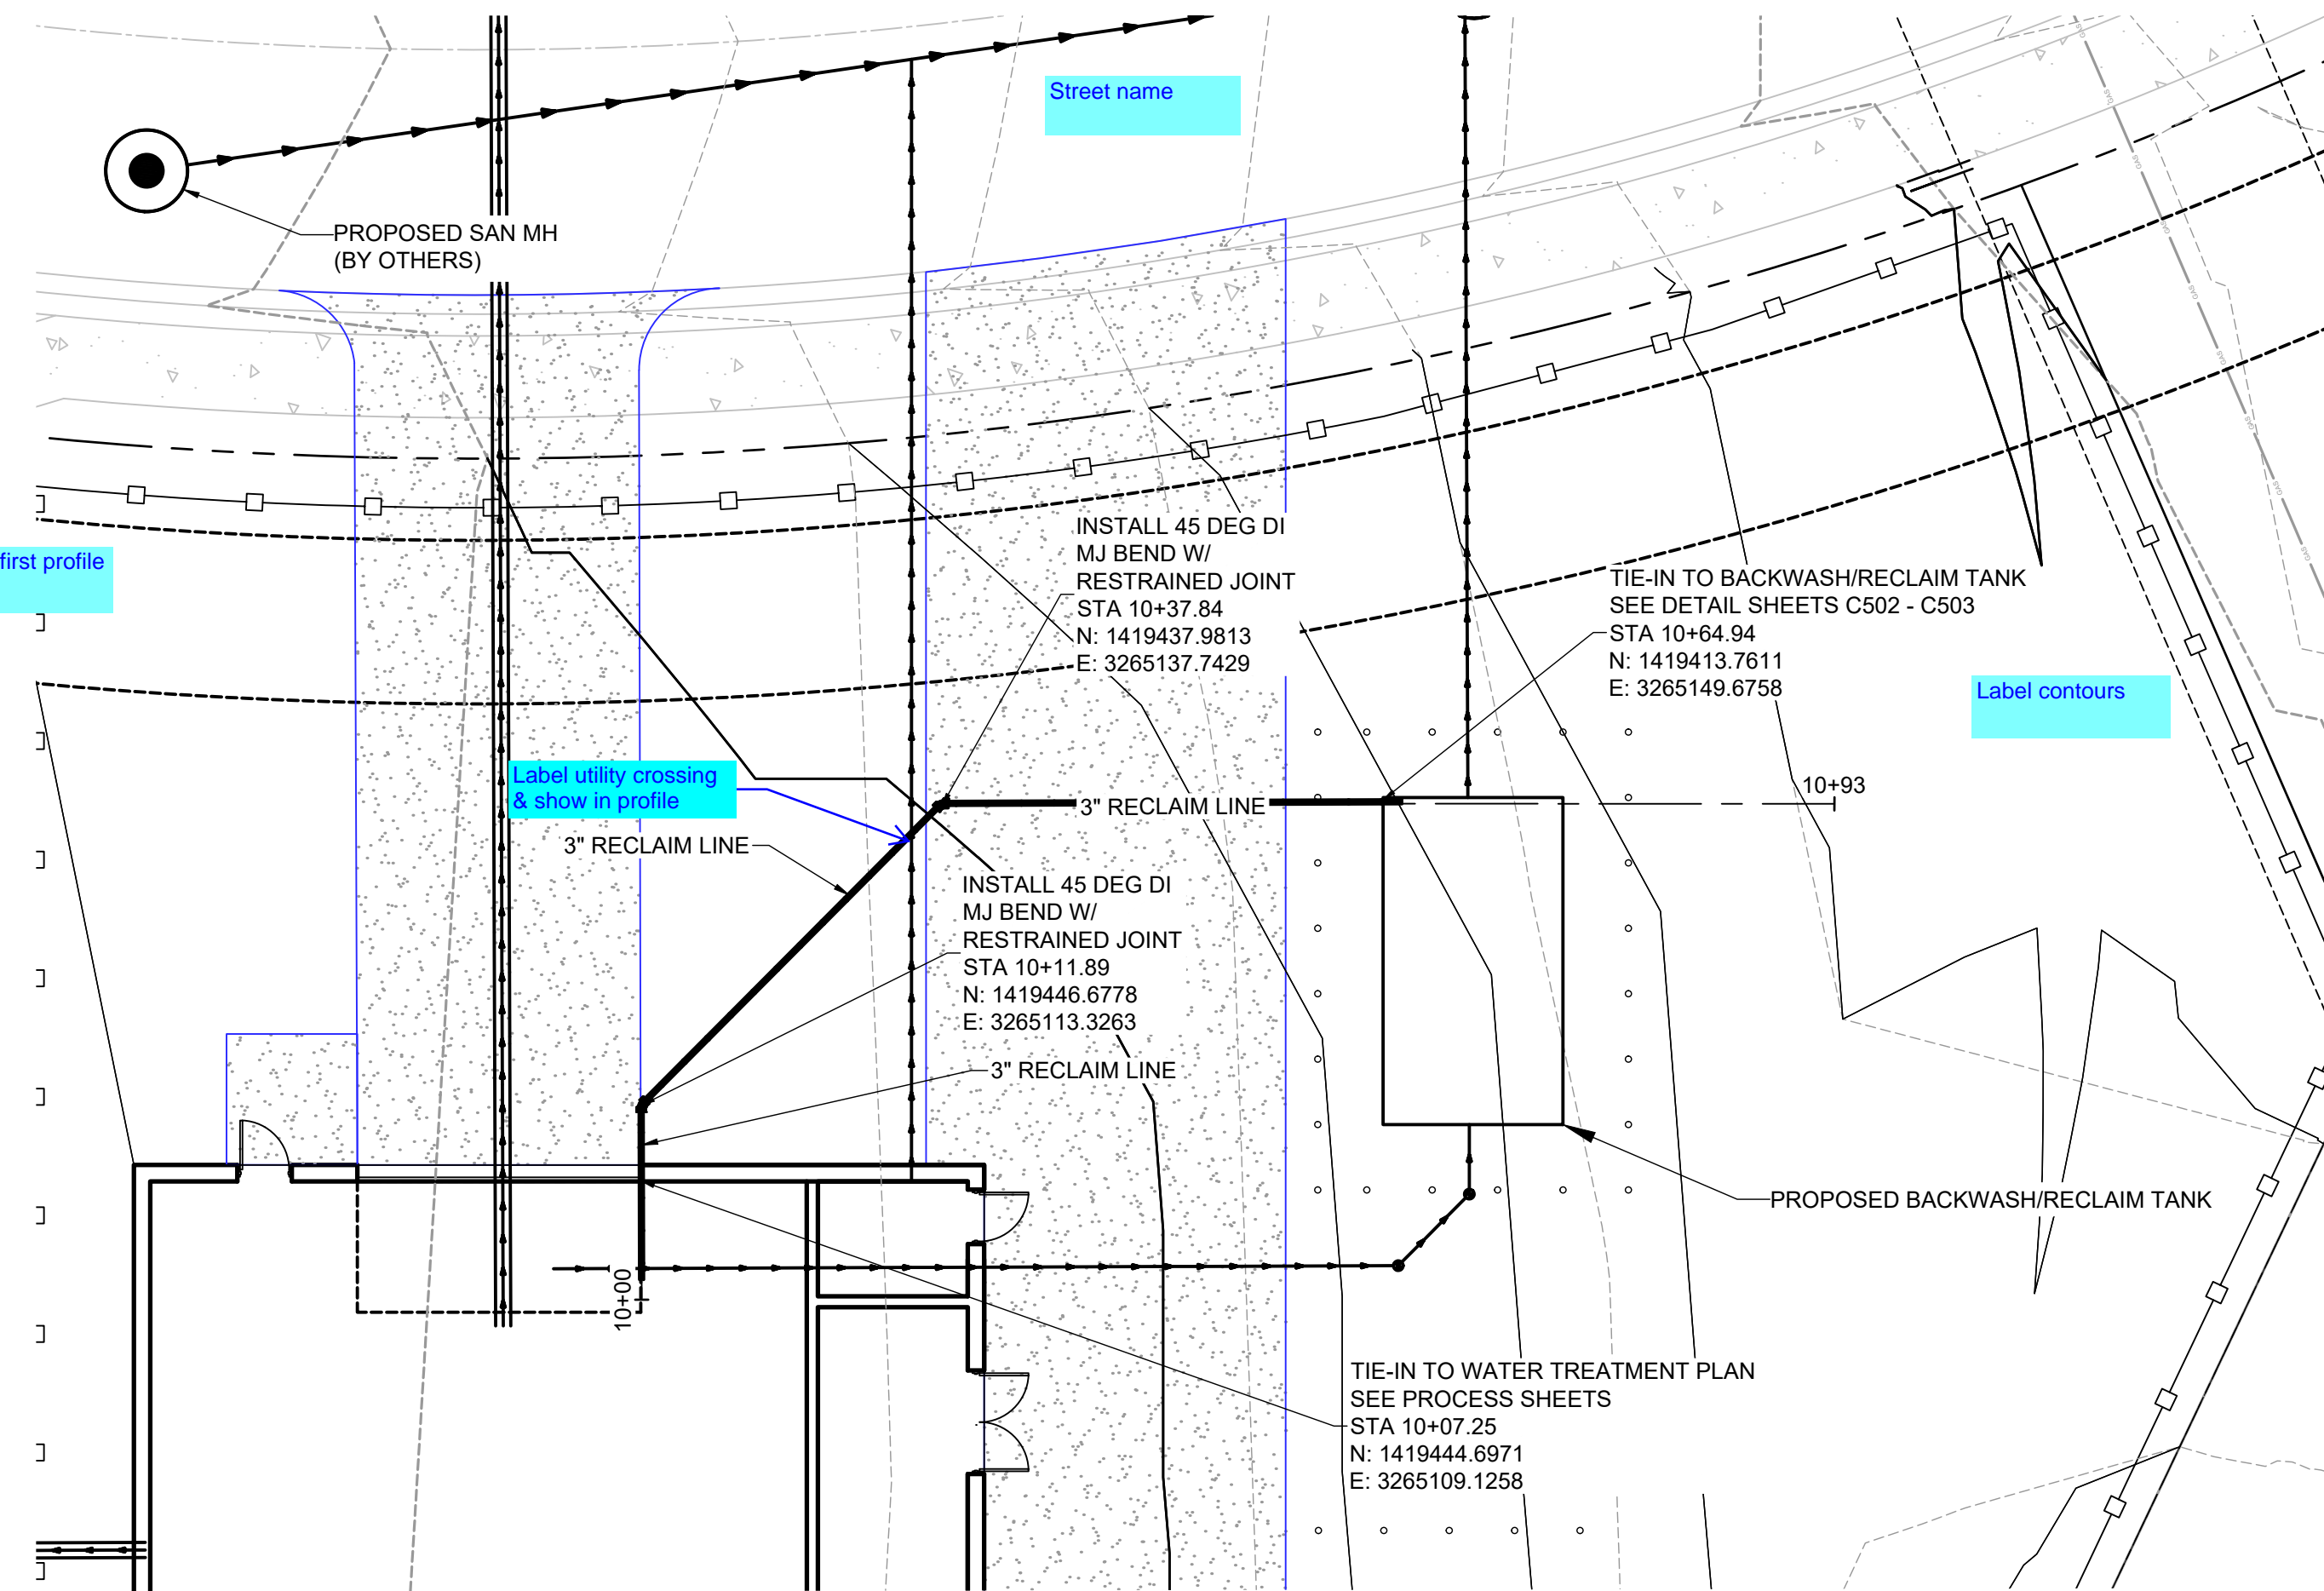


GENERAL NOTES:

1. SEE G.XXX FOR XXXX WATER AND WASTEWATER SYSTEM STANDARDS AND INSTALLATION NOTES.
2. SEE TECHNICAL SPECIFICATIONS FOR ADDITIONAL WATER AND WASTEWATER SPECIFICATIONS.

6/2024

1 PLAN

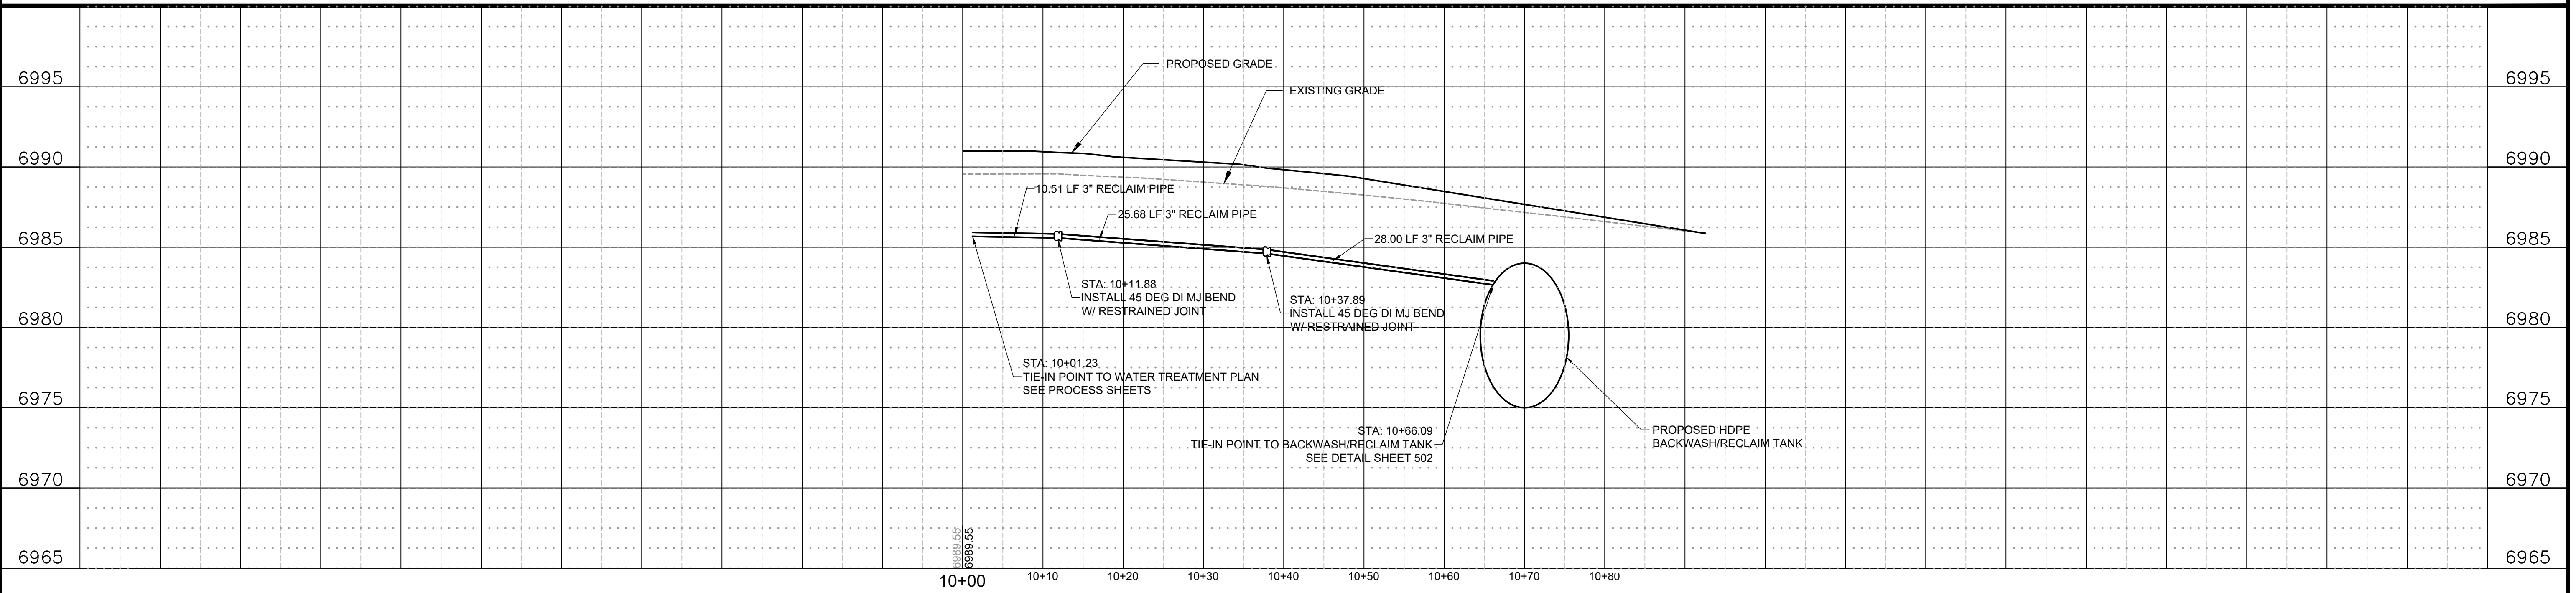

DRAWN BY: JAK	JOB DATE:	BAR IS ONE INCH ON OFFICIAL DRAWINGS.
APPROVED: JAS	JOB NUMBER:	0" = 1"
CAD DATE: 7/18/2024 2:36:50 PM		IF NOT ONE INCH, ADJUST SCALE ACCORDINGLY.
CAD FILE: J:\2020\201662.06\CAD\DWGS\C\C104A-BACKWASH RECLAIM WATER P&P.dwg		

NO.	DATE	BY	REVISION DESCRIPTION


HR GREEN - COLORADO SPRINGS
1975 RESEARCH PARKWAY | SUITE 230
COLORADO SPRINGS CO 80920
PHONE: 719.300.4140
FAX: 713.965.0044

EL PASO COUNTY, COLORADO
GRANDVIEW RESERVE DISTRICT
WTP WELL WATER COLLECTION
D.R. HORTON
COLORADO

CIVIL
3 INCH BACKWASH RECLAIM WATER P&P

SHEET
C108

Xref: xg-1-dr01: xc-design; DUP KEY; xv-dsgn_662; xv-row-662; xv-uti_662; xc-uti-F1-662; xc-dgn-F1-662; xc-rw-F1-662; xc-dgn-grad; xc-rw-662; xc-662; xc-662; xc-dsgn-uti; REVIT EXPORT_FLOOR_PROCESS_PLAN

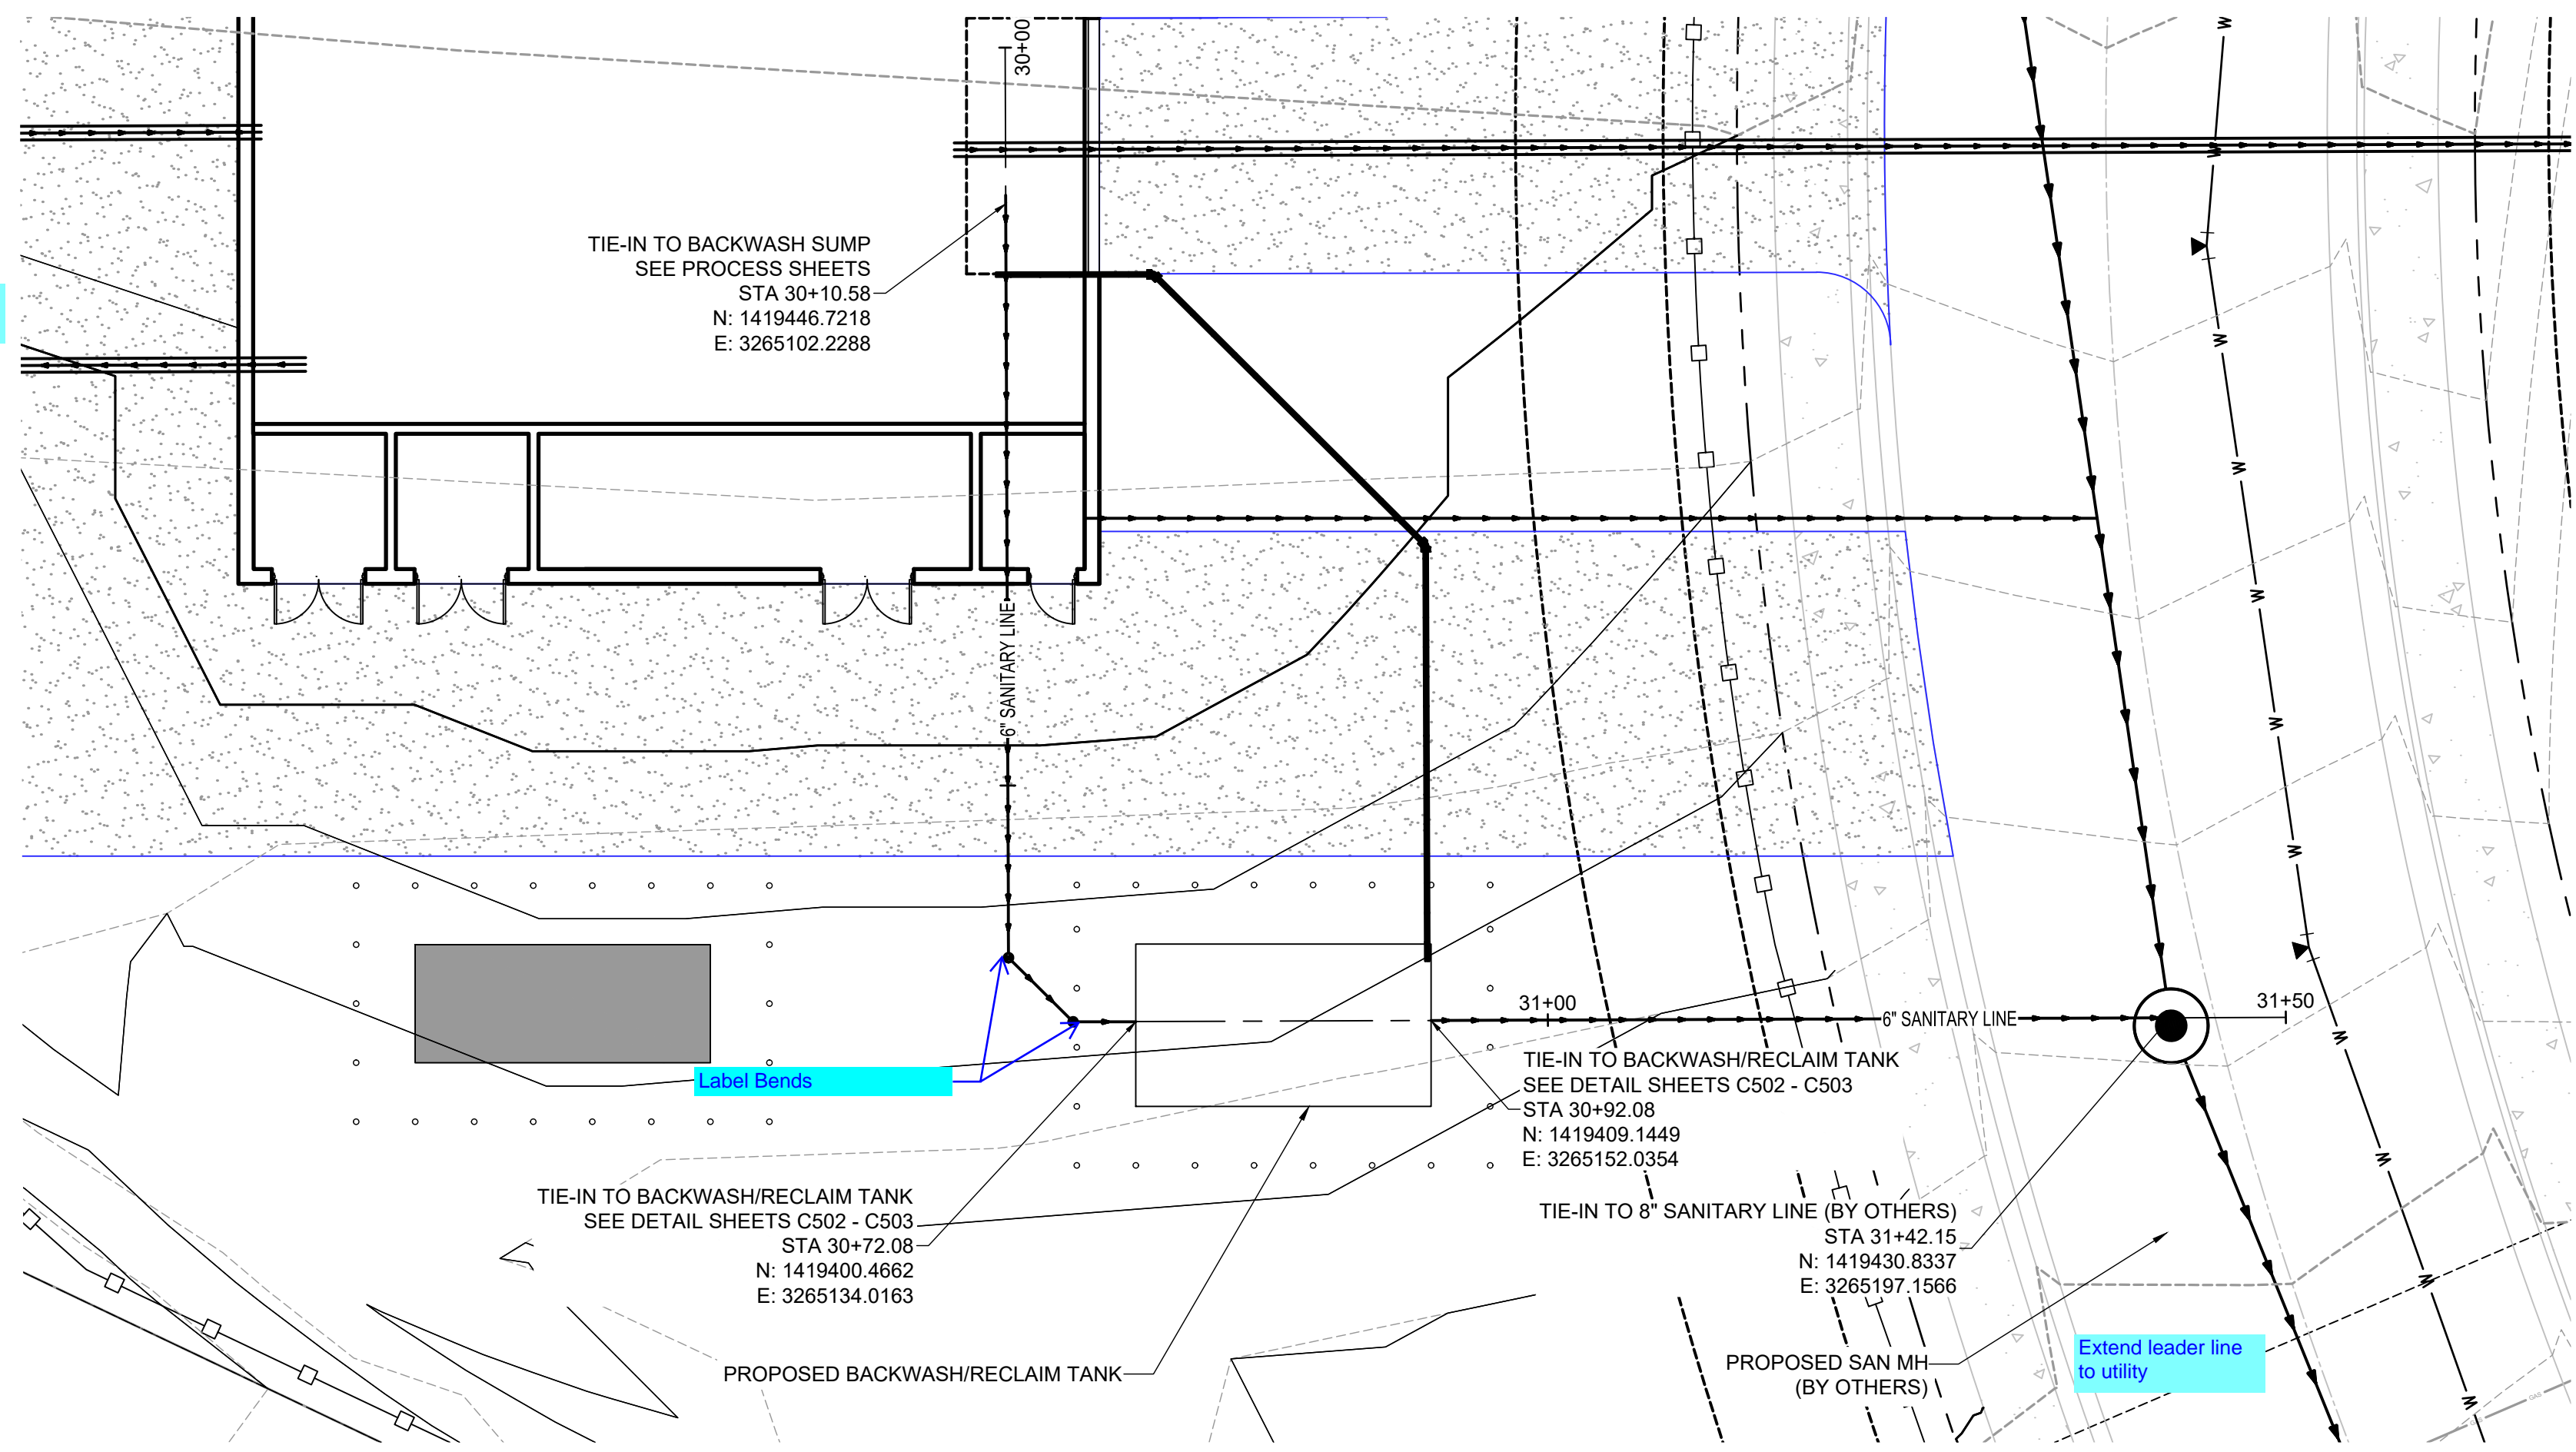

See comments on first profile sheet


Label Bends

Extend leader line to utility


GENERAL NOTES:

- 1. SEE G.XXX FOR XXXX WATER AND WASTEWATER SYSTEM STANDARDS AND INSTALLATION NOTES.
- 2. SEE TECHNICAL SPECIFICATIONS FOR ADDITIONAL WATER AND WASTEWATER SPECIFICATIONS.

PLAN

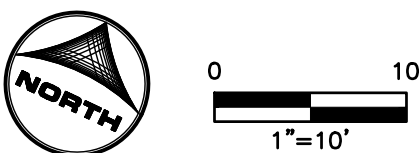

6/2024

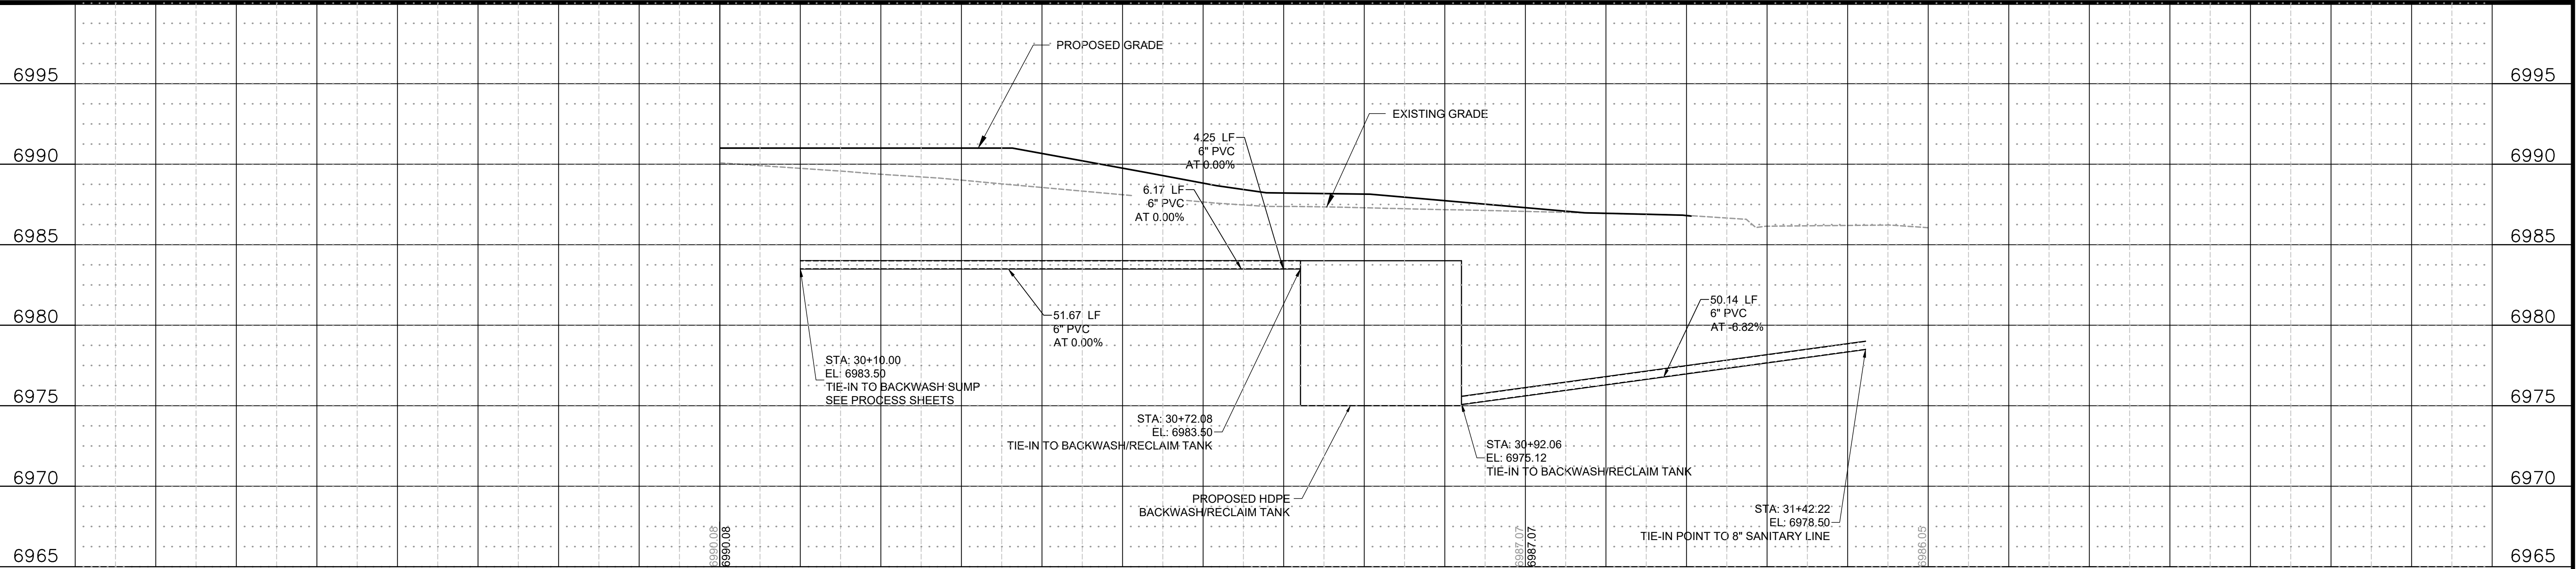

DRAWN BY: JAK JOB DATE:
 APPROVED: JAS JOB NUMBER:
 CAD DATE: 7/18/2024 2:44:04 PM
 CAD FILE: J:\2020\201662_06\CAD\Dwgs\C\104C-6 INCH SANITARY PIPE P&P.dwg

BAR IS ONE INCH ON OFFICIAL DRAWINGS.
 IF NOT ONE INCH, ADJUST SCALE ACCORDINGLY.

NO.	DATE	BY	REVISION DESCRIPTION

HRGreen HR GREEN - COLORADO SPRINGS
 1975 RESEARCH PARKWAY | SUITE 230
 COLORADO SPRINGS CO 80920
 PHONE: 719.300.4140
 FAX: 713.965.0044

EL PASO COUNTY, COLORADO
 GRANDVIEW RESERVE DISTRICT
 WTP WELL WATER COLLECTION
 D.R. HORTON
 COLORADO



CIVIL
6 INCH SANITARY PIPE P&P

SHEET
C110

