


MAJOR DEVELOPMENT PLAN AMENDMENT

PART W 1/2 SEC 1, T 13 S, R 65 W, 6th PM FALCON, COLORADO

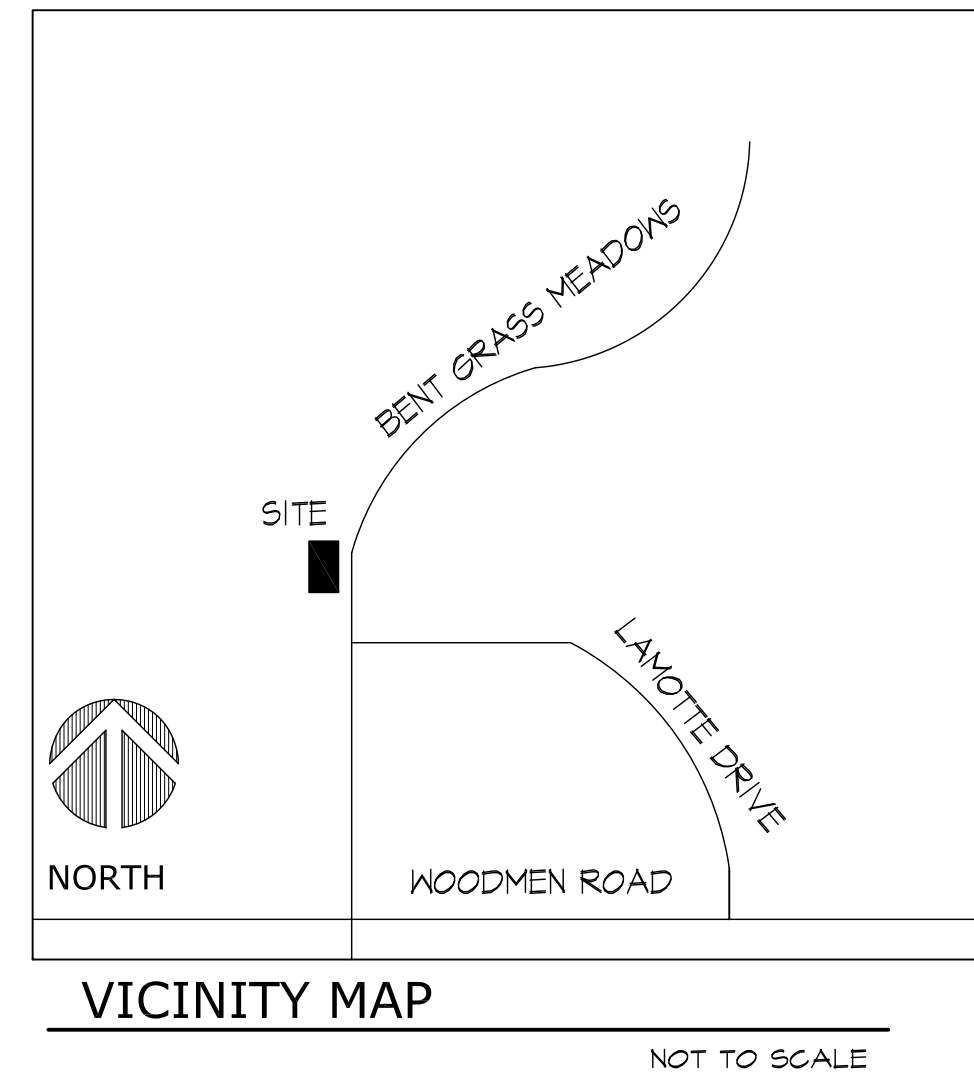

LEGAL DESCRIPTION

A parcel of land being a portion of the West one-half of Section 1, Township 13 South, Range 65 West of the 6th Principal Meridian, situate in El Paso County, Colorado, described as follows: Beginning at the Northwest corner of Laigo Business Center Filing No. 1 (Reception No. 205075726, El Paso County, Colorado records) (all bearings in this description are relative to the West line of the Southwest one-quarter of said Section 1, which bears North 00 degrees 16 minutes 02 seconds East, "assumed"); Thence North 00 degrees 16 minutes 02 seconds East along said Section 1's Southwest one-quarter's West line, said line also being coincident with the Northerly extension of the Westerly line of said Filing, 501.15 feet; Thence South 89 degrees 43 minutes 58 seconds East, 493.97 feet to a point on the Westerly right-of-way line of the proposed extension of Bent Grass Meadows Drive (80' r.o.w.), as platted in said Filing; The following three (3) courses are along said Drive's Westerly right-of-way line: 1.) South 24 degrees 14 minutes 14 seconds West, 53.65 feet; 2.) On a curve to the left, said curve having a central angle of 23 degrees 58 minutes 12 seconds, a radius of 605.00 feet, an arc length of 253.11 feet; 3.) South 00 degrees 16 minutes 02 seconds West, 206.48 feet to the Northeast corner of Lot 1, said Filing; Thence North 89 degrees 42 minutes 50 seconds West along the Northerly line of said Lot 1, 420.00 feet to the Point of Beginning, County of El Paso, State of Colorado. And containing 5.004 acres.

SETBACKS

BUILDING SETBACKS	LANDSCAPE SETBACKS
WOODMEN ROAD: 50 FEET	WOODMEN ROAD: 40 FEET
BENT GRASS MEADOWS DRIVE: 50 FEET	BENT GRASS MEADOWS DRIVE: 40 FEET
ANY OTHER PUBLIC STREET: 25 FEET	ANY OTHER PUBLIC STREET: 25 FEET
SIDE AND REAR: 5 FEET	SIDE AND REAR: 5 FEET

LOT COVERAGE

BUILDINGS: THERE ARE NO ADDITIONAL NEW BUILDINGS ON THE SITE
OPEN SPACE: 5.0036 ACRES

PARKING:

PARKING PROVIDED:
3 REGULAR SPACES
1 ADA ACCESSIBLE SPACE

current and proposed buildings still must depict total gross sq footage

ZONING

I-2

DEVELOPMENT SCHEDULE

FALL 2024

OWNER/DEVELOPER

FALCON STORAGE PARTNERS LLLC
4615 NORTH PARK DRIVE
COLORADO SPRINGS, COLORADO 80918-3857
RICHARD GRAHAM
PHONE: (719) 440-9414
EMAIL: grahaminvestments@gmail.com

APPLICANT

JOHN DAVIS DESIGN GROUP
176 TALAMINE COURT, SUITE 100
COLORADO SPRINGS, COLORADO 80907
JOHN DAVIS
PHONE: (719) 528-1177
EMAIL: john@jddg.info

PLAN PREPARER

JOHN DAVIS DESIGN GROUP
176 TALAMINE COURT, SUITE 100
COLORADO SPRINGS, COLORADO 80907
JOHN DAVIS
PHONE: (719) 528-1177
EMAIL: john@jddg.info

PROJECT ADDRESS: 7630 BENT GRASS MEADOWS DRIVE
TAX SCHEDULE NUMBER: 53010-00-018
EXISTING LAND USE: STORAGE
PROPOSED LAND USE: RV STORAGE
MAXIMUM BUILDING HEIGHT: 50 FEET
LOT AREA: 217,957 S.F. (5.0036 ACRES)

NOTE:
THERE IS NO ASPHALT PAVEMENT ASSOCIATED WITH THIS PROJECT.


Please also identify the amount of storage spaces, i.e. 92 per the TIS and site development plan

revise as note on the site plan indicates an asphalt driveway

UNRESOLVED V1 & V2 COMMENTS:
Please provide:
-total gross building square footage
-landscaping percentage

INDEX TO DRAWINGS

SDP 1.1	COVER SHEET
SDP 1.2	SITE DEVELOPMENT PLAN
SHEET 1 OF 4	GRADING AND EROSION CONTROL PLAN
SHEET 2 OF 4	GRADING AND EROSION CONTROL PLAN
SHEET 3 OF 4	EROSION CONTROL PLAN DETAILS
SHEET 3 OF 4	EROSION CONTROL PLAN DETAILS
L1.0	FINAL LANDSCAPE PLAN
L2.0	FINAL LANDSCAPE PLAN DETAILS
PP1.0	PHOTOMETRIC PLAN

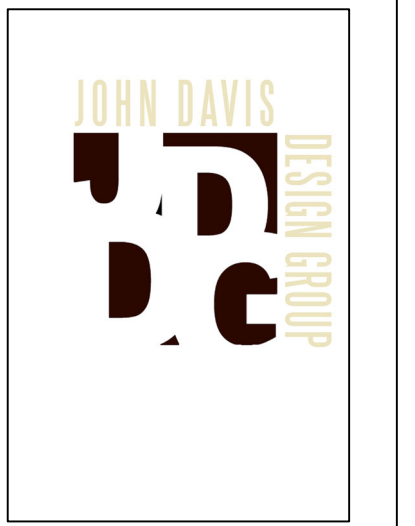

JOHN DAVIS
DESIGN GROUP

ARCHITECTS
INTERIORS
PLANNERS

176 TALAMINE COURT
SUITE 100
COLORADO SPRINGS,
COLORADO 80907
P 719/528-1177
F 719/444-8409

DO NOT SCALE
DRAWINGS FOR
CONSTRUCTION
PURPOSES

THESE DRAWINGS ARE THE PROPERTY OF
JDDG ARCHITECTS. THEY SHALL BE USED
FOR THE SOLE PURPOSE OF CONSTRUCTING
THIS PROJECT. THEY SHALL NOT BE
REPRODUCED AND USED FOR THE PURPOSE
OF CONSTRUCTION DOCUMENTS FOR ANY
OTHER PROJECTS.

COVER SHEET

**NEW RV STORAGE FOR:
FALCON STORAGE
PART W 1/2 SEC 1, T 13 S, R 65 W, 6th PM
PEYTON, COLORADO**


PROJECT NO.	202129
DATE	JUNE 21, 2021
DRAWN BY	JRD
CHECKED	JRD
APPROVED	JRD
REVISED	

REVISED PER EL PASO
COUNTY PLANNING
DEPARTMENT
COMMENTS
JULY 2, 2024

SHEET

SDP1.1

File number:
ppr2232

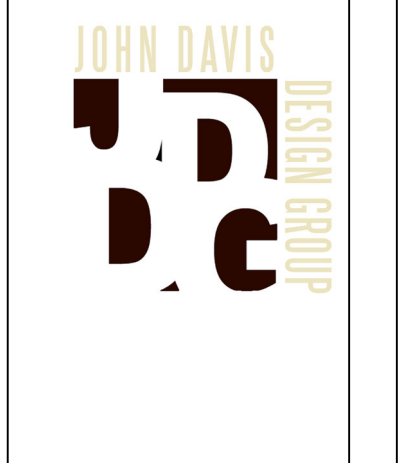

JOHN DAVIS DESIGN GROUP

ARCHITECTS INTERIORS PLANNERS

176 TALAMINE COURT SUITE 100 COLORADO SPRINGS, COLORADO 80907 P 719/528-1177 F 719/444-8409

DO NOT SCALE DRAWINGS FOR CONSTRUCTION PURPOSES

THESE DRAWINGS ARE THE PROPERTY OF JDD ARCHITECTS. THEY SHALL BE USED FOR THE SOLE PURPOSE OF CONSTRUCTING THIS PROJECT. THEY SHALL NOT BE REPRODUCED AND USED FOR THE PURPOSE OF CONSTRUCTION DOCUMENTS FOR ANY OTHER PROJECTS.


SITE DEVELOPMENT PLAN
NEW RV STORAGE FOR:
FALCON STORAGE
PART W 1/2 SEC 1, T 13 S, R 65 W, 6th PM
PEYTON, COLORADO

PROJECT NO. 202129
DATE JUNE 21, 2021
DRAWN BY JRD
CHECKED JRD
APPROVED JRD
REVISED

REVISED PER EL PASO COUNTY PLANNING DEPARTMENT COMMENTS JULY 2, 2024

SHEET

SDP1.2

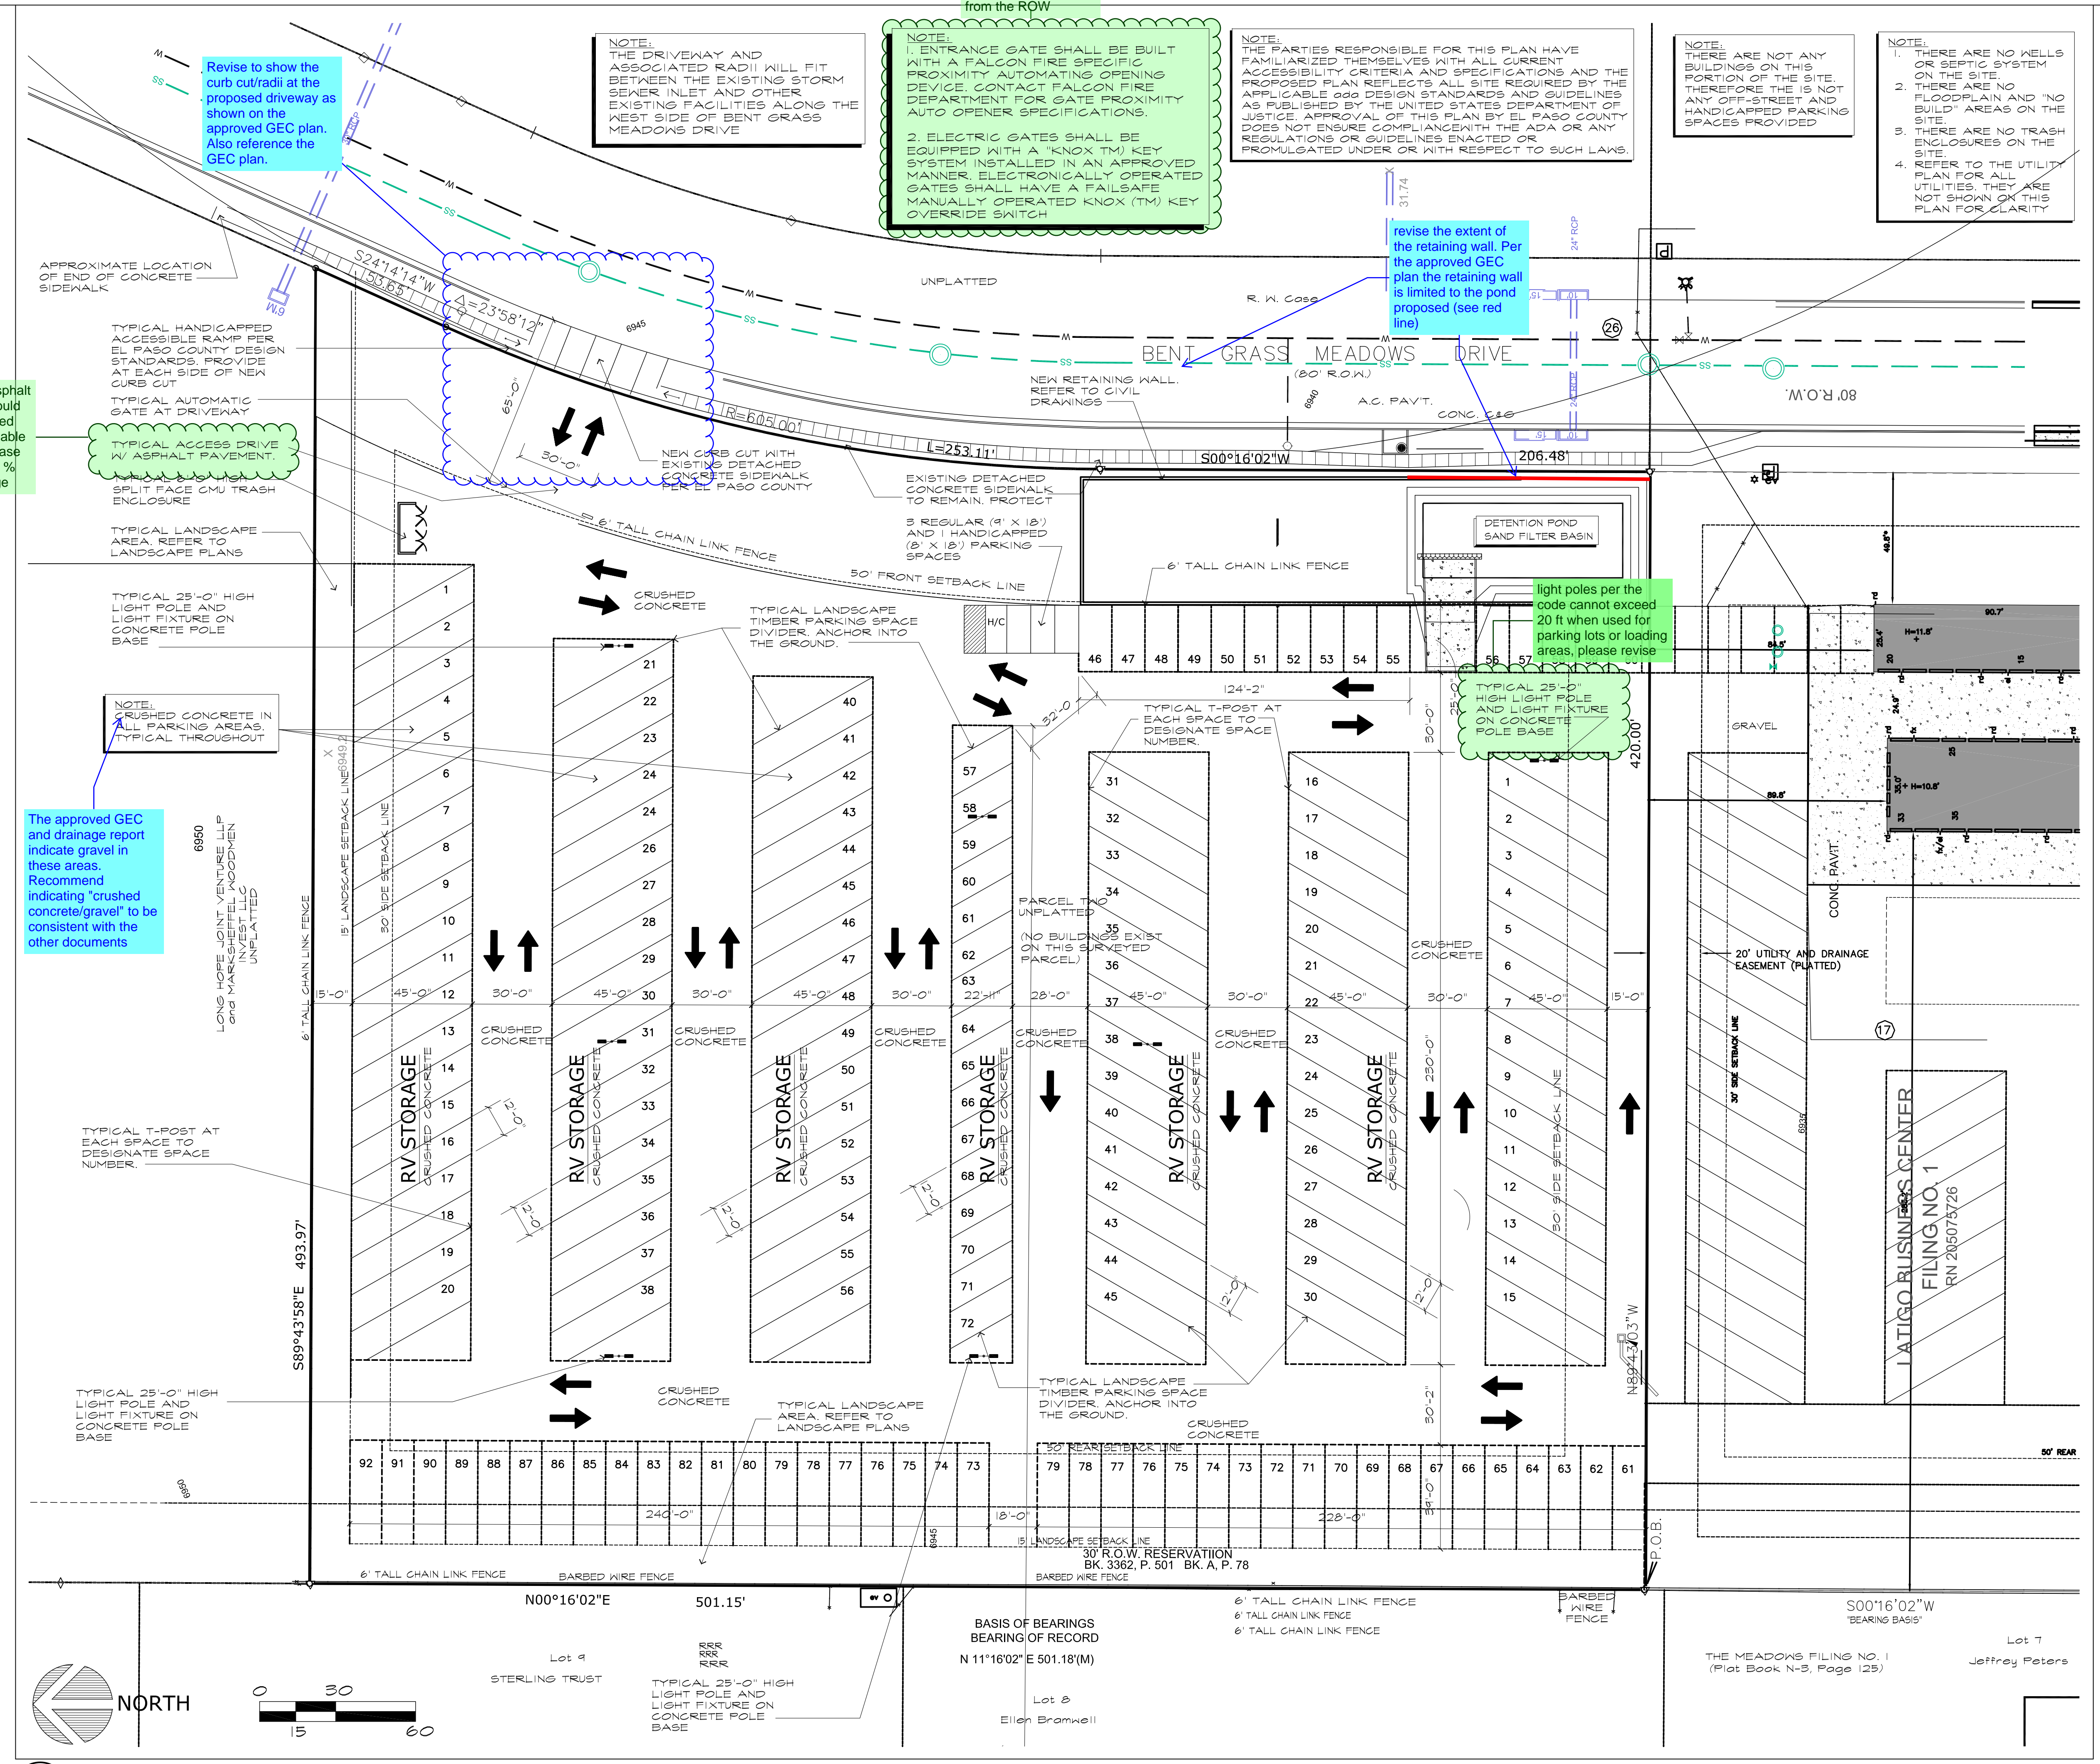

20 SDPI SITE DEVELOPMENT PLAN SCALE: 1"=30'-0"