


Include the units where the vehicle repair garages will take place. (attach the tenant map and mark the building where they take place).

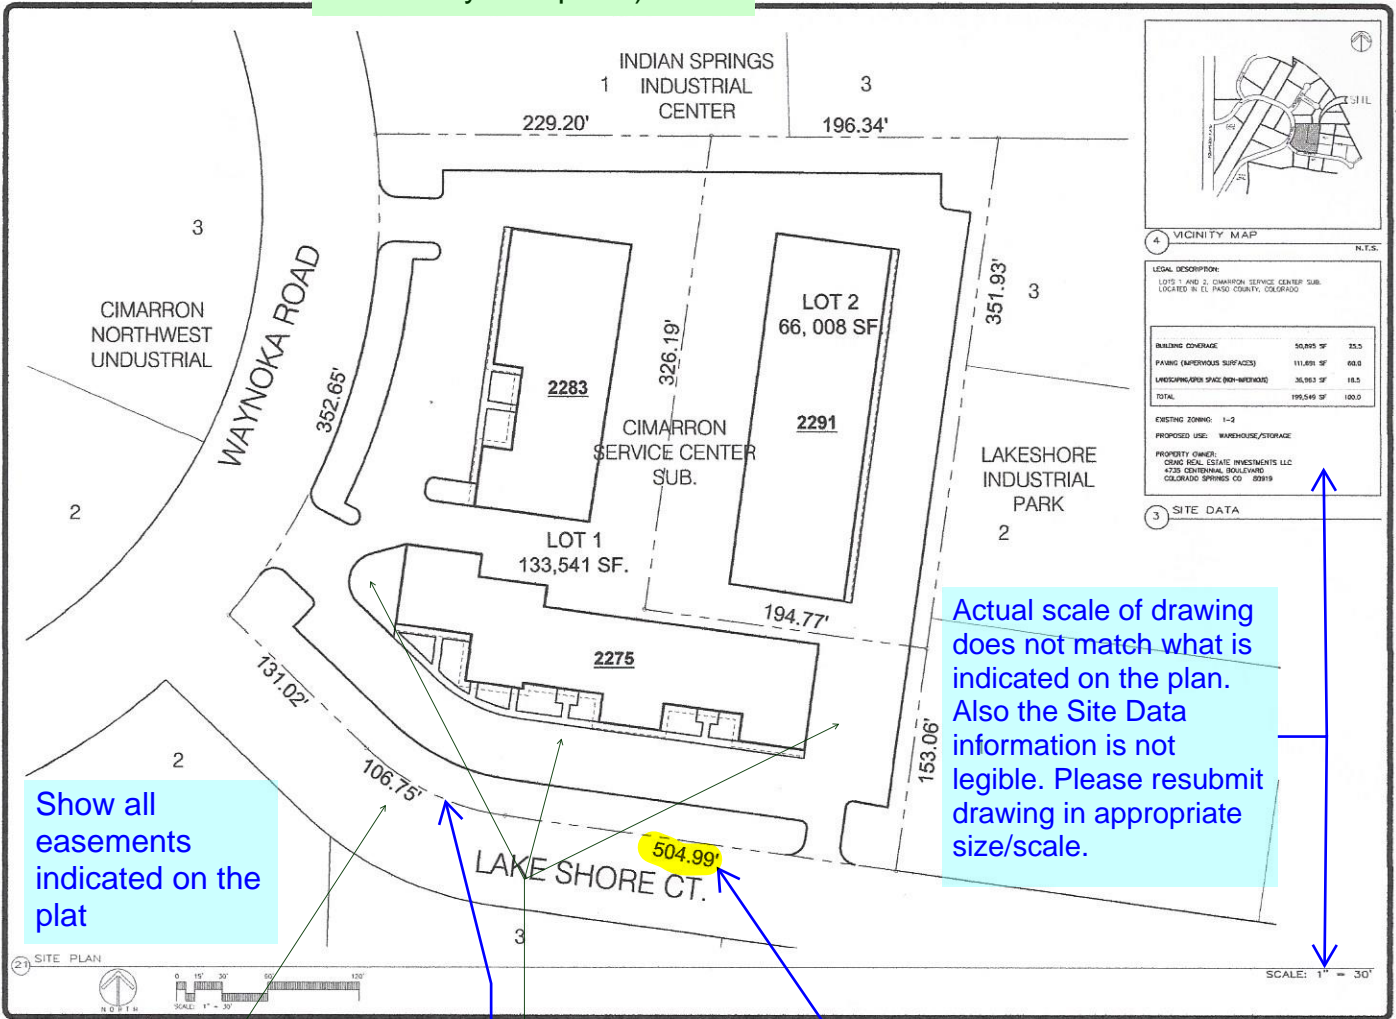

VERGENSEN, OBERING & WHITTAKER
A PROFESSIONAL CORPORATION ARCHITECTURE & PLANNING
115 S. Weber Colorado Springs, Colorado 475-9133

Project: Cimarron Service Center
2283 Waynoka Rd.
El Paso County, Colorado

SP1
SITE PLAN
Sheet 1 of 1

Show all easements indicated on the plat

Actual scale of drawing does not match what is indicated on the plan. Also the Site Data information is not legible. Please resubmit drawing in appropriate size/scale.

Add PCD File No. AL1826

Label property lines

Show existing setbacks.

Plat No. 8833 indicates this length as 270'. Revise accordingly.

Show all easements indicated in the title commitment.

Markup Summary

Daniel Torres (6)



Add PCD File No. AL1826

Subject: Text Box
Page Label: 1
Lock: Locked
Author: Daniel Torres
Date: 11/30/2018 4:18:27 PM
Color: ■

Add PCD File No. AL1826



Label property lines

Subject: Callout
Page Label: 1
Lock: Locked
Author: Daniel Torres
Date: 11/30/2018 4:18:30 PM
Color: ■


Label property lines




Plat No. 8833 indicates this length as 270'. Revise accordingly.

Subject: Callout
Page Label: 1
Lock: Locked
Author: Daniel Torres
Date: 11/30/2018 4:18:30 PM
Color: ■

Plat No. 8833 indicates this length as 270'. Revise accordingly.

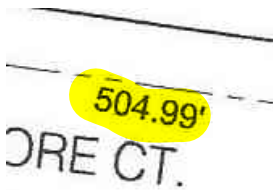


Subject: Highlight
Page Label: 1
Lock: Locked
Author: Daniel Torres
Date: 11/30/2018 4:18:31 PM
Color: ■

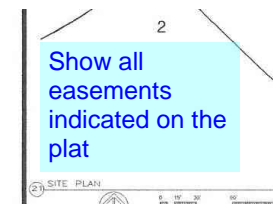

Show all easements indicated on the plat

Subject: Text Box
Page Label: 1
Lock: Locked
Author: Daniel Torres
Date: 11/30/2018 4:18:32 PM
Color: ■

Show all easements indicated on the plat

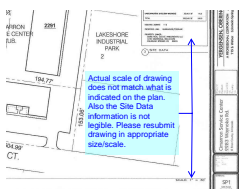

Actual scale of drawing does not match what is indicated on the plan. Also the Site Data information is not legible. Please resubmit drawing in appropriate size/scale.


Subject: Callout
Page Label: 1
Lock: Locked
Author: Daniel Torres
Date: 11/30/2018 4:18:32 PM
Color: ■

Actual scale of drawing does not match what is indicated on the plan. Also the Site Data information is not legible. Please resubmit drawing in appropriate size/scale.

Include the units where the vehicle repair garages will take place. (attach the tenant map and mark the building where they take place).


Include the units where the vehicle repair garages will take place. (attach the tenant map and mark the building where they take place).

Subject: Text Box
Page Label: 1
Lock: Locked
Author: dskendall
Date: 11/30/2018 4:18:24 PM
Color: ■

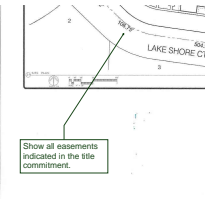

Subject: Callout
Page Label: 1
Lock: Locked
Author: dskendall
Date: 11/30/2018 4:18:24 PM
Color: ■

Show all easements indicated in the title commitment.

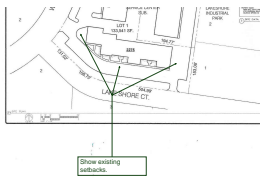

Subject: Callout
Page Label: 1
Lock: Locked
Author: dskendall
Date: 11/30/2018 4:18:26 PM
Color: ■

Show existing setbacks.