

2023 Financial Assurance Estimate Form (with pre-plat construction)

Updated: 12/8/2022

PROJECT INFORMATION		
Hwy. 105 / Jackson Creek Pkwy. Int. Imps. (East of Int. only)	7/5/2023	CDR-237
Project Name	Date	PCD File No.

Description	Quantity	Units	Unit Cost		Total	(with Pre-Plat Construction)	
						% Complete	Remaining
SECTION 1 - GRADING AND EROSION CONTROL (Construction and Permanent BMPs)							
Earthwork							
less than 1,000; \$5,300 min		CY	\$ 8.00	=	\$ -		\$ -
1,000-5,000; \$8,000 min	2,000	CY	\$ 6.00	=	\$ 12,000.00		\$ 12,000.00
5,001-20,000; \$30,000 min		CY	\$ 5.00	=	\$ -		\$ -
20,001-50,000; \$100,000 min		CY	\$ 3.50	=	\$ -		\$ -
50,001-200,000; \$175,000 min		CY	\$ 2.50	=	\$ -		\$ -
greater than 200,000; \$500,000 min		CY	\$ 2.00	=	\$ -		\$ -
Permanent Erosion Control Blanket	650.0	SY	\$ 8.00	=	\$ 5,200.00		\$ 5,200.00
Permanent Seeding (inc. noxious weed mgmnt.) & Mulching	0.2	AC	\$ 1,875.00	=	\$ 375.00		\$ 375.00
Permanent Pond/BMP (provide engineer's estimate)		EA		=	\$ -		\$ -
Concrete Washout Basin		EA	\$ 1,089.00	=	\$ -		\$ -
Inlet Protection	1	EA	\$ 202.00	=	\$ 202.00		\$ 202.00
Rock Check Dam		EA	\$ 605.00	=	\$ -		\$ -
Safety Fence		LF	\$ 3.00	=	\$ -		\$ -
Sediment Basin		EA	\$ 2,132.00	=	\$ -		\$ -
Sediment Trap		EA	\$ 500.00	=	\$ -		\$ -
Silt Fence	375	LF	\$ 3.00	=	\$ 1,125.00		\$ 1,125.00
Slope Drain		LF	\$ 40.00	=	\$ -		\$ -
Straw Bale		EA	\$ 31.00	=	\$ -		\$ -
Straw Wattle/Rock Sock	45	LF	\$ 7.00	=	\$ 315.00		\$ 315.00
Surface Roughening		AC	\$ 250.00	=	\$ -		\$ -
Temporary Erosion Control Blanket		SY	\$ 3.00	=	\$ -		\$ -
Temporary Seeding and Mulching		AC	\$ 1,666.00	=	\$ -		\$ -
Vehicle Tracking Control	1	EA	\$ 2,867.00	=	\$ 2,867.00		\$ 2,867.00
[insert items not listed but part of construction plans]				=	\$ -		\$ -
MAINTENANCE (35% of Construction BMPs)							\$ 1,578.15
Section 1 Subtotal					=	\$ 23,662.15	\$ 23,662.15

* - Subject to defect warranty financial assurance. A minimum of 20% shall be retained until final acceptance (MAXIMUM OF 80% COMPLETE ALLOWED)

SECTION 2 - PUBLIC IMPROVEMENTS *							
--	--	--	--	--	--	--	--

ROADWAY IMPROVEMENTS							
Construction Traffic Control	1.0	LS	\$ 5,000.00	=	\$ 5,000.00		\$ 5,000.00
Aggregate Base Course (135 lbs/cf)		Tons	\$ 34.00	=	\$ -		\$ -
Aggregate Base Course (135 lbs/cf)		CY	\$ 61.00	=	\$ -		\$ -
Asphalt Pavement (3" thick)		SY	\$ 17.00	=	\$ -		\$ -
Asphalt Pavement (4" thick)		SY	\$ 23.00	=	\$ -		\$ -
Asphalt Pavement (6" thick)		SY	\$ 35.00	=	\$ -		\$ -
Asphalt Pavement (147 lbs/cf) ___" thick		Tons	\$ 106.00	=	\$ -		\$ -
Raised Median, Paved		SF	\$ 10.00	=	\$ -		\$ -
Regulatory Sign/Advisory Sign			\$ 364.00	=	\$ -		\$ -
Guide/Street Name Sign				=	\$ -		\$ -
Epoxy Pavement Marking			\$ 16.00	=	\$ -		\$ -
Thermoplastic Pavement Marking			\$ 28.00	=	\$ -		\$ -
Barricade - Type 3			\$ 241.00	=	\$ -		\$ -
Delineator - Type I			\$ 29.00	=	\$ -		\$ -
Curb and Gutter, Type A (6" Vertical)			\$ 35.00	=	\$ -		\$ -
Curb and Gutter, Type B (Median)			\$ 35.00	=	\$ -		\$ -
Curb and Gutter, Type C (Ramp)		LF	\$ 35.00	=	\$ -		\$ -
4" Sidewalk (common areas only)		SY	\$ 58.00	=	\$ -		\$ -
5" Sidewalk		SY	\$ 72.00	=	\$ -		\$ -
6" Sidewalk		SY	\$ 87.00	=	\$ -		\$ -
8" Sidewalk		SY	\$ 116.00	=	\$ -		\$ -
Pedestrian Ramp		EA	\$ 1,390.00	=	\$ -		\$ -
Cross Pan, local (8" thick, 6' wide to include return)		LF	\$ 73.00	=	\$ -		\$ -
Cross Pan, collector (9" thick, 8' wide to include return)		LF	\$ 111.00	=	\$ -		\$ -
Curb Opening with Drainage Chase		EA	\$ 1,790.00	=	\$ -		\$ -
Guardrail Type 3 (W-Beam)		LF	\$ 60.00	=	\$ -		\$ -
Guardrail Type 7 (Concrete)		LF	\$ 87.00	=	\$ -		\$ -
Guardrail End Anchorage		EA	\$ 2,538.00	=	\$ -		\$ -
Guardrail Impact Attenuator		EA	\$ 4,556.00	=	\$ -		\$ -
Sound Barrier Fence (CMU block, 6' high)		LF	\$ 95.00	=	\$ -		\$ -
Sound Barrier Fence (panels, 6' high)		LF	\$ 97.00	=	\$ -		\$ -
Electrical Conduit, Size =		LF	\$ 20.00	=	\$ -		\$ -
Traffic Signal, (provide engineer's estimate)	Bond w/ CDOT	EA	\$ 470,666	=			

Include public improvements back into estimate that were provided on first review (ABC, pavement, signs, pavement markings, storm pipe, inlets, etc)

PROJECT INFORMATION

Hwy. 105 / Jackson Creek Pkwy. Int. Imps. (East of Int. only)
Project Name

7/5/2023
Date

CDR-237
PCD File No.

Description	Quantity	Units	Unit Cost		Total	(with Pre-Plat Construction)	
						% Complete	Remaining
				=	\$ -		\$ -
<i>[insert items not listed but part of construction plans]</i>				=	\$ -		\$ -
STORM DRAIN IMPROVEMENTS							
Concrete Box Culvert (M Standard), Size (W x H)		LF		=	\$ -		\$ -
18" Reinforced Concrete Pipe		LF	\$ 76.00	=	\$ -		\$ -
24" Reinforced Concrete Pipe	8	LF	\$ 91.00	=	\$ 728.00		\$ 728.00
30" Reinforced Concrete Pipe		LF	\$ 114.00	=	\$ -		\$ -
36" Reinforced Concrete Pipe		LF	\$ 140.00	=	\$ -		\$ -
42" Reinforced Concrete Pipe		LF	\$ 187.00	=	\$ -		\$ -
48" Reinforced Concrete Pipe		LF	\$ 228.00	=	\$ -		\$ -
54" Reinforced Concrete Pipe		LF	\$ 297.00	=	\$ -		\$ -
60" Reinforced Concrete Pipe		LF	\$ 348.00	=	\$ -		\$ -
66" Reinforced Concrete Pipe		LF	\$ 402.00	=	\$ -		\$ -
72" Reinforced Concrete Pipe		LF	\$ 460.00	=	\$ -		\$ -
18" Corrugated Steel Pipe		LF	\$ 98.00	=	\$ -		\$ -
24" Corrugated Steel Pipe		LF	\$ 112.00	=	\$ -		\$ -
30" Corrugated Steel Pipe		LF	\$ 143.00	=	\$ -		\$ -
36" Corrugated Steel Pipe		LF	\$ 171.00	=	\$ -		\$ -
42" Corrugated Steel Pipe		LF	\$ 197.00	=	\$ -		\$ -
48" Corrugated Steel Pipe		LF	\$ 207.00	=	\$ -		\$ -
54" Corrugated Steel Pipe		LF	\$ 304.00	=	\$ -		\$ -
60" Corrugated Steel Pipe		LF	\$ 328.00	=	\$ -		\$ -
66" Corrugated Steel Pipe		LF	\$ 397.00	=	\$ -		\$ -
72" Corrugated Steel Pipe		LF	\$ 467.00	=	\$ -		\$ -
78" Corrugated Steel Pipe		LF	\$ 537.00	=	\$ -		\$ -
84" Corrugated Steel Pipe		LF	\$ 642.00	=	\$ -		\$ -
Flared End Section (FES) RCP Size = <i>(unit cost = 6x pipe unit cost)</i>		EA		=	\$ -		\$ -
Flared End Section (FES) CSP Size = <i>(unit cost = 6x pipe unit cost)</i>		EA		=	\$ -		\$ -
End Treatment- Headwall		EA		=	\$ -		\$ -
End Treatment- Wingwall		EA		=	\$ -		\$ -
End Treatment - Cutoff Wall		EA		=	\$ -		\$ -
Curb Inlet (Type R) L=5', Depth < 5'		EA	\$ 6,703.00	=	\$ -		\$ -
Curb Inlet (Type R) L=5', 5' ≤ Depth < 10'		EA	\$ 8,715.00	=	\$ -		\$ -
Curb Inlet (Type R) L =5', 10' ≤ Depth < 15'		EA	\$ 10,092.00	=	\$ -		\$ -
Curb Inlet (Type R) L =10', Depth < 5'		EA	\$ 9,224.00	=	\$ -		\$ -
Curb Inlet (Type R) L =10', 5' ≤ Depth < 10'		EA	\$ 9,507.00	=	\$ -		\$ -
Curb Inlet (Type R) L =10', 10' ≤ Depth < 15'		EA	\$ 11,901.00	=	\$ -		\$ -
Curb Inlet (Type R) L =15', Depth < 5'		EA	\$ 11,995.00	=	\$ -		\$ -
Curb Inlet (Type R) L =15', 5' ≤ Depth < 10'		EA	\$ 12,858.00	=	\$ -		\$ -
Curb Inlet (Type R) L =15', 10' ≤ Depth < 15'		EA	\$ 14,061.00	=	\$ -		\$ -
Curb Inlet (Type R) L =20', Depth < 5'		EA	\$ 12,783.00	=	\$ -		\$ -
Curb Inlet (Type R) L =20', 5' ≤ Depth < 10'		EA	\$ 14,109.00	=	\$ -		\$ -
Grated Inlet (Type C), Depth < 5'		EA	\$ 5,611.00	=	\$ -		\$ -
Grated Inlet (Type D), Depth < 5'		EA	\$ 6,931.00	=	\$ -		\$ -
Storm Sewer Manhole, Box Base		EA	\$ 14,061.00	=	\$ -		\$ -
Storm Sewer Manhole, Slab Base	1	EA	\$ 7,734.00	=	\$ 7,734.00		\$ 7,734.00
Geotextile (Erosion Control)		SY	\$ 8.00	=	\$ -		\$ -
Rip Rap, d50 size from 6" to 24"		Tons	\$ 97.00	=	\$ -		\$ -
Rip Rap, Grouted		Tons	\$ 115.00	=	\$ -		\$ -
Drainage Channel Construction, Size (W x H)		LF	\$ -	=	\$ -		\$ -
Drainage Channel Lining, Concrete		CY	\$ 689.00	=	\$ -		\$ -
Drainage Channel Lining, Rip Rap		CY	\$ 135.00	=	\$ -		\$ -
Drainage Channel Lining, Grass		AC	\$ 1,776.00	=	\$ -		\$ -
Drainage Channel Lining, Other Stabilization				=	\$ -		\$ -
				=	\$ -		\$ -
<i>[insert items not listed but part of construction plans]</i>				=	\$ -		\$ -
				Section 2 Subtotal	= \$ 13,462.00		\$ 13,462.00

* - Subject to defect warranty financial assurance. A minimum of 20% shall be retained until final acceptance (MAXIMUM OF 80% COMPLETE ALLOWED)

PROJECT INFORMATION

Hwy. 105 / Jackson Creek Pkwy. Int. Imps. (East of Int. only)	7/5/2023	CDR-237
Project Name	Date	PCD File No.

Description	Quantity	Units	Unit Cost		Total	(with Pre-Plat Construction)		
						% Complete	Remaining	
SECTION 3 - COMMON DEVELOPMENT IMPROVEMENTS (Private or District and NOT Maintained by EPC)**								
ROADWAY IMPROVEMENTS								
Retaining Wall (Adjacent to Hwy. 105)	1	EA	\$ 200,000.00	=	\$ 200,000.00		\$ 200,000.00	
				=	\$ -		\$ -	
				=	\$ -		\$ -	
STORM DRAIN IMPROVEMENTS (Exception: Permanent Pond/BMP shall be itemized under Section 1)								
				=	\$ -		\$ -	
				=	\$ -		\$ -	
WATER SYSTEM IMPROVEMENTS								
Water Main Pipe (PVC), Size 8"		LF	\$ 78.00	=	\$ -		\$ -	
Water Main Pipe (Ductile Iron), Size 8"		LF	\$ 91.00	=	\$ -		\$ -	
Gate Valves, 8"		EA	\$ 2,247.00	=	\$ -		\$ -	
Fire Hydrant Assembly, w/ all valves		EA	\$ 7,978.00	=	\$ -		\$ -	
Water Service Line Installation, inc. tap and valves		EA	\$ 1,601.00	=	\$ -		\$ -	
Fire Cistern Installation, complete		EA		=	\$ -		\$ -	
				=	\$ -		\$ -	
<i>[insert items not listed but part of construction plans]</i>				=	\$ -		\$ -	
SANITARY SEWER IMPROVEMENTS								
Sewer Main Pipe (PVC), Size 8"		LF	\$ 78.00	=	\$ -		\$ -	
Sanitary Sewer Manhole, Depth < 15 feet		EA	\$ 5,305.00	=	\$ -		\$ -	
Sanitary Service Line Installation, complete		EA	\$ 1,696.00	=	\$ -		\$ -	
Sanitary Sewer Lift Station, complete		EA		=	\$ -		\$ -	
				=	\$ -		\$ -	
<i>[insert items not listed but part of construction plans]</i>				=	\$ -		\$ -	
LANDSCAPING IMPROVEMENTS (For subdivision specific condition of approval, or PUD)								
		EA		=	\$ -		\$ -	
		EA		=	\$ -		\$ -	
				=	\$ -		\$ -	
Section 3 Subtotal					=	\$ 200,000.00		\$ 200,000.00

** - Section 3 is not subject to defect warranty requirements

PROJECT INFORMATION

Hwy. 105 / Jackson Creek Pkwy. Int. Imps. (East of Int. only)	7/5/2023	CDR-237
Project Name	Date	PCD File No.

Description	Quantity	Units	Unit Cost	Total	(with Pre-Plat Construction)	
					% Complete	Remaining
AS-BUILT PLANS (Public Improvements inc. Permanent WQCV BMPs)		LS	=	\$ -		\$ -
POND/BMP CERTIFICATION (inc. elevations and volume calculations)		LS	=	\$ -		\$ -
Total Construction Financial Assurance						\$ 237,124.15
(Sum of all section subtotals plus as-builts and pond/BMP certification)						
Total Remaining Construction Financial Assurance (with Pre-Plat Construction)						\$ 237,124.15
(Sum of all section totals less credit for items complete plus as-builts and pond/BMP certification)						
Total Defect Warranty Financial Assurance						\$ 6,207.40
(20% of all items identified as (*). To be collateralized at time of preliminary acceptance)						

Approvals

I hereby certify that this is an accurate and complete estimate of costs for the work as shown on the Grading and Erosion Control Plan and Construction Drawings associated with the Project.

Engineer (P.E. Seal Required)

Approved by Owner / Applicant

Date

Approved by El Paso County Engineer / ECM Administrator

Date



INNOVATIVE DESIGN. CLASSIC RESULTS.

**FINAL DRAINAGE REPORT
FOR
MONUMENT JUNCTION DEVELOPMENT
HIGHWAY 105 CORRIDOR &
JACKSON CREEK PARKWAY
INTERSECTION IMPROVEMENTS**

July 2023

Prepared for:
ELITE PROPERTIES OF AMERICA, INC
2138 FLYING HORSE CLUB DR.
COLORADO SPRINGS, CO 80921

Prepared by:
CLASSIC CONSULTING
619 N. CASCADE AVE., SUITE 200
COLORADO SPRINGS CO 80903
(719) 785-0790

Job no. 1302.22



FINAL DRAINAGE REPORT FOR MONUMENT JUNCTION DEVELOPMENT – HIGHWAY 105 CORRIDOR & JACKSON CREEK PARKWAY INTERSECTION IMPROVEMENTS

DRAINAGE REPORT STATEMENT

ENGINEER'S STATEMENT:

The attached drainage plan and report were prepared under my direction and supervision and are correct to the best of my knowledge and belief. Said drainage report has been prepared according to the criteria established by the Town for drainage reports and said report is in conformity with the master plan of the drainage basin. I accept responsibility for any liability caused by any negligent acts, errors, or omissions on my part in preparing this report.

Marc A. Whorton, Colorado P.E. #37155

Date

DEVELOPER'S STATEMENT:

I, the developer, have read and will comply with all of the requirements specified in this drainage report and plan.

Business Name: ELITE PROPERTIES OF AMERICA, INC.

By: _____

Title: _____

Address: 2138 FLYING HORSE CLUB DR.

COLORADO SPRINGS, CO 80921

TOWN OF MONUMENT:

Filed in accordance with Sections 12.13.010 of the Subdivision Ordinance for the Town of Monument, revised 1997 and 13.11.160 of the Zoning Ordinance for the Town of Monument, revised 1997.

For Town of Monument

Date

EL PASO COUNTY:

Filed in accordance with the requirements of the Drainage Criteria Manual, Volumes 1 and 2, El Paso County Engineering Criteria Manual and Land Development Code as amended.

Joshua Palmer, P.E.

County Engineer, / ECM Administrator

(Review only for Hwy. 105 intersection design east of Jackson Creek Pkwy.)

Date



FINAL DRAINAGE REPORT FOR MONUMENT JUNCTION DEVELOPMENT – HIGHWAY 105 CORRIDOR & JACKSON CREEK PARKWAY INTERSECTION IMPROVEMENTS

TABLE OF CONTENTS:

PURPOSE	Page 1
GENERAL DESCRIPTION	Page 1
EXISTING DRAINAGE CONDITIONS	Page 1
PROPOSED DRAINAGE CHARACTERISTICS	Page 4
DRAINAGE CRITERIA	Page 8
FLOODPLAIN STATEMENT	Page 8
SUMMARY	Page 8
REFERENCES	Page 10

APPENDICES

VICINITY MAP
SOILS MAP (S.C.S. SURVEY)
F.E.M.A. MAP
JURISDICTIONAL DETERMINATION
HYDROLOGIC / HYDRAULIC CALCULATIONS
STORMWATER QUALITY / DETENTION CALCULATIONS
DRAINAGE MAPS



PURPOSE

This document is the Final Drainage Report for the Monument Junction Development and the associated adjacent off-site improvements to Highway 105 and the intersection with Jackson Creek Parkway. The purpose of this report is to identify the existing drainage patterns in this corridor, define and detail practical solutions for the conveyance and attenuation of developed flows to minimize drainage impacts further downstream resulting from these regional roadway improvements as required by Town of Monument, El Paso County and CDOT. **Two separate reports cover the on-site aspects of the Monument Junction Development. Please reference “Monument Junction East – Phase 1 PD Site Plan” and “Monument Junction West Filing No. 1”, both prepared by Classic Consulting. These reports have been approved by the Town of Monument and detail and describe all the on-site drainage design for the development.**

GENERAL DESCRIPTION

This report covers the Highway 105 corridor from the I-25 off-ramp to the Knollwood Drive intersection and the Jackson Creek Parkway improvements from Highway 105 to the high point in the road approximately 750 feet south of Highway 105. This area lies within Section 14, township 11 south, range 67 west of the 6th principal meridian, in El Paso County. This corridor is bounded on the north by CDOT property and private rural residential property, to the south by Monument Junction development and various commercial developments along Highway 105, to the east by existing Village Center at Woodmoor development and to the west by existing CDOT Right-of-way (Interstate-25).

The average soil condition reflects Hydrologic Group “D” (Alamosa Loam) as determined by the “Web Soil Survey of El Paso County Area,” prepared by the Soil Conservation Service (see map in Appendix).

EXISTING DRAINAGE CONDITIONS

This corridor is entirely within the Dirty Woman Creek drainage basin. Existing slopes range from 1% to 33% and ground cover is predominantly paved roadway with native grass sideroad ditches with some trees and wetlands within the corridor. The current drainage pattern flows generally in a westerly direction towards the intersection of Highway 105 and the I-25 off-ramp where an existing 36” RCP culvert crosses the I-25 off-ramp. This natural drainageway just upstream of this facility contains wetland area within the natural channel behind the sidewalk along the south side of Highway 105. Please reference the Jurisdictional Determination (JD) Action No. SPA-2022-00180 that finds these wetlands to be non-jurisdictional. (See Appendix) The corridor east of Jackson Creek



Parkway contains an existing storm system collecting the developed street flows and the adjacent property along the south side of Highway 105.

The following off-site basins (OS-10 thru OS-18) are all along this stretch of the Highway 105 corridor east to Knollwood Drive including the intersection with Jackson Creek Parkway:

Basin OS-10 ($Q_5= 3$ cfs, $Q_{100}= 10$ cfs) consists of the off-site property within the existing Right-of-Way for Highway 105 and the I-25 off-ramp. These flows travel as sheet flow in a northerly direction directly into the sideroad ditch along the south side of Highway 105 and the east side of the I-25 off-ramp. The flows then travel as ditch flow towards the intersection with the I-25 off-ramp. The total flows at this location are described later as Design Point H10.

Basin OS-16 ($Q_5= 2$ cfs, $Q_{100}= 5$ cfs) consists of the off-site fully developed properties east of Jackson Creek Parkway and south of Highway 105. This basin consists of existing buildings, parking lot, drive aisle and landscape area. These developed flows travel into a landscape sediment area adjacent to the buildings and then directly into Basin OS-11. **Basin OS-11 ($Q_5= 3$ cfs, $Q_{100}= 6$ cfs)** consists of the off-site partially developed property due east of Jackson Creek Parkway just south of Highway 105. This basin consists of an existing building, parking lot, driveway and native planted slope adjacent to Jackson Creek Parkway. The combined developed flows travel in a westerly direction and directly into the sideroad ditch along Jackson Creek Parkway. However, the ditch on the east side of the road seems to end and these flows appear to spillover to the westerly side of the roadway (Design Point H7) as the northbound approach to the intersection with Highway 105 is superelevated due to the grade on Highway 105. At **Design Point H7 ($Q_5= 5$ cfs, $Q_{100}= 10$ cfs)** these combined flows are partially collected by an existing 10' Type R at-grade inlet ($Q_5= 4.9$ cfs, $Q_{100}= 7.7$ cfs) with a flow-by of ($Q_5= 0.1$ cfs, $Q_{100}= 2.3$ cfs). This minor flow-by continues around the corner and then in a westerly direction down the street within Basin OS-17. The collected flows along with the upstream flows are conveyed in an existing 30" RCP storm pipe and daylight into the sideroad ditch along the south side of Highway 105.

Basin OS-12 ($Q_5= 1.2$ cfs, $Q_{100}= 3$ cfs) consists of the most easterly portion of Highway 105 at the Knollwood Drive intersection. Portions of this basin include the existing paved roadway and naturally landscaped area within the ROW. It has been assumed that the upstream facilities (east of Knollwood Dr.) capture 100% of the minor flows but approximately 0.85 cfs bypass those facilities in the major event. (*Information taken from recent "Preliminary Drainage Report Highway 105 Project A", prepared by HDR for El Paso County, dated November 2021*) Thus, the



total flows are conveyed via curb and gutter in a westerly direction towards **Design Point H4** ($Q_5= 1 \text{ cfs}$, $Q_{100}= 3.8 \text{ cfs}$). At this location, an existing 5' Type R at-grade inlet collects a portion of these flows ($Q_5= 1 \text{ cfs}$, $Q_{100}= 2.5 \text{ cfs}$) with a flow-by of ($Q_5= 0 \text{ cfs}$, $Q_{100}= 1.3 \text{ cfs}$). This minor flow-by continues in a westerly direction down the street within Basin OS-13. The collected flows are conveyed in an existing 15" RCP storm pipe in a westerly direction under Highway 105.

Basin OS-13 ($Q_5= 2 \text{ cfs}$, $Q_{100}= 4 \text{ cfs}$) consists of a portion of Highway 105 west of Knollwood Drive. Portions of this basin include the existing paved roadway and naturally landscaped area within the ROW. These flows along with the minor 100 yr. flow-by from Design Point H4 are conveyed via curb and gutter in a westerly direction towards **Design Point H5**. At this location, an existing 10' Type R at-grade inlet collects a portion of these flows ($Q_5= 2 \text{ cfs}$, $Q_{100}= 4.9 \text{ cfs}$) with a flow-by of ($Q_5= 0 \text{ cfs}$, $Q_{100}= 0.4 \text{ cfs}$). This minor flow-by continues in a westerly direction down the street within Basin OS-14. The collected flows combine with the upstream system and are conveyed in an existing 15" RCP storm pipe in a westerly direction.

Basin OS-14 ($Q_5= 0.8 \text{ cfs}$, $Q_{100}= 2 \text{ cfs}$) consists of a portion of Highway 105 just east of Jackson Creek Parkway. Portions of this basin include the existing paved roadway and naturally landscaped area within the ROW. These flows along with the 100 yr. flow-by from Design Point H5 are conveyed via curb and gutter in a westerly direction towards **Design Point H6**. At this location, an existing 10' Type R at-grade inlet completely collects these flows with no flow-by. The total collected flows are then conveyed in an existing 24" RCP storm pipe in a southwesterly direction.

Basin OS-15 ($Q_5= 4 \text{ cfs}$, $Q_{100}= 8 \text{ cfs}$) consists of the off-site partially developed property due east of Jackson Creek Parkway just south of Highway 105. This basin consists of existing buildings, parking lots, drive aisles and native undeveloped areas. These developed flows generally travel in a westerly direction towards a sediment basin up on top of the slope at the intersection with Jackson Creek Parkway. This facility does not seem to have any formal stormwater quality features but rather just a rip-rap basin with an existing 18" ADS storm outfall. This outfall conveys the flows directly into a grated inlet behind the curb along the east side of Jackson Creek Parkway. The flows are then conveyed under the roadway within an existing 30" RCP storm system. This system daylights into the sideroad ditch at the SW corner of Highway 105 and Jackson Creek Parkway.

Basin OS-17 ($Q_5= 2 \text{ cfs}$, $Q_{100}= 4 \text{ cfs}$) consists of a portion of Highway 105 within the intersection with Jackson Creek Parkway. The majority of this basin includes the existing paved roadway along with an area naturally landscaped



slope at the SE corner of the intersection. These flows along with the by-pass flows from Design Point H7 described above are conveyed via curb and gutter in a westerly direction towards **Design Point H8 (Q₅= 2.1 cfs, Q₁₀₀= 6.3 cfs)**. At this location, an existing 10' Type R at-grade inlet collects a portion of these flows (**Q₅= 2.1 cfs, Q₁₀₀= 5.5 cfs**) with a flow-by of (**Q₅= 0 cfs, Q₁₀₀= 0.8 cfs**). This minor flow-by continues in a westerly direction down the street within Basin OS-18. The collected flows are conveyed out of the back of the inlet via a 24" RCP directly into the sideroad ditch along the south side of Highway 105.

Basin OS-18 (Q₅= 1.3 cfs, Q₁₀₀= 2 cfs) consists of a portion of Highway 105 just east of the intersection with the I-25 off-ramp. All of this basin includes the existing paved roadway. These flows along with the by-pass flows from Design Point H8 described above are conveyed via curb and gutter in a westerly direction towards **Design Point H9 (Q₅= 1 cfs, Q₁₀₀= 3 cfs)**. At this location, an existing 10' Type R sump inlet completely collects these flows. The collected flows are conveyed out of the back of the inlet via a 24" RCP directly into the sideroad ditch along the south side of Highway 105.

Design Point H10 (Q₅= 14 cfs, Q₁₀₀= 36 cfs) consists of the total combined flows from all the tributary upstream basins described above. At this location, the natural ditch within CDOT ROW conveys the flows to an existing 36" RCP culvert under the I-25 off-ramp. This facility seems to adequately handle these current developed flows.

PROPOSED DRAINAGE CONDITIONS

Developed runoff from the proposed off-site public roadway improvements within the Highway 105 and Jackson Creek Parkway ROW corridors will be conveyed via surface drainage and public storm sewer systems to a proposed permanent storm water quality facility located at the SE corner of the intersection of the I-25 off-ramp and Highway 105. Given that these improvements span multiple jurisdictions, the proposed facilities will be designed and installed per the latest El Paso County ECM and Town of Monument drainage criteria and detailed in this report. See the following general descriptions of the anticipated developed design points and how all the developed flows will be mitigated:

Design Point D4 (Q₅= 1.4 cfs, Q₁₀₀= 3.9 cfs) consists of the most easterly portion of Highway 105 at the Knollwood Drive intersection within Basin OS12D. Portions of this basin include the existing paved roadway and naturally landscaped area within the ROW and new roadway improvements proposed by El Paso County. These developed flows include the minor 100 yr. flow-by of 0.85 cfs as described in the "Preliminary Drainage Report Highway 105



Project A", prepared by HDR for El Paso County, dated November 2021. The total flows are conveyed via curb and gutter in a westerly direction towards Design Point H4. At this location, a proposed 5' Type R at-grade inlet collects a portion of these flows (**$Q_5= 1.4$ cfs, $Q_{100}= 2.5$ cfs**) with a flow-by of (**$Q_5= 0$ cfs, $Q_{100}= 1.3$ cfs**). This minor flow-by continues in a westerly direction down the street within Basin OS13D. The collected flows are conveyed in a proposed 18" RCP storm pipe in a westerly direction under Highway 105. This proposed inlet and 18" RCP storm will be constructed as a part of the El Paso County Highway 105 Project A.

Design Point D5 ($Q_5= 2$ cfs, $Q_{100}= 5$ cfs) consists of a portion of the redeveloped Highway 105 by El Paso County. At this location, a proposed 10' Type R at-grade inlet collects a portion of these flows (**$Q_5= 2$ cfs, $Q_{100}= 4.9$ cfs**) with a flow-by of (**$Q_5= 0$ cfs, $Q_{100}= 0.4$ cfs**). This minor flow-by continues in a westerly direction down the street within Basin OS14D. The collected flows combine with the upstream system and are conveyed in a proposed 18" RCP storm pipe in a westerly direction. This proposed inlet and 24" RCP storm will be constructed as a part of the El Paso County Highway 105 Project A.

Design Point D6 ($Q_5= 4$ cfs, $Q_{100}= 8$ cfs) consists of the off-site partially developed property due east of Jackson Creek Parkway just south of Highway 105. Basin OS-15D is the upstream basin that consists of existing buildings, parking lots, drive aisles and native undeveloped areas. These developed flows generally travel in a westerly direction and will continue to be captured by a proposed CDOT Type C inlet within their property, located behind the proposed retaining wall. Appropriate easement documents and agreements will need to be granted prior to construction. The collected flows will then be routed via a proposed 18" RCP pipe routed towards the proposed storm system within Highway 105. These flows then combine with the upstream flows described earlier and are conveyed further downstream in a westerly direction.

Design Point D7 ($Q_5= 6$ cfs, $Q_{100}= 12$ cfs) consists of a portion of the proposed Jackson Creek Parkway road improvements and a few off-site basins to the east that are tributary to this location (Basins OS-16 and OS11D). Developed flows from these basins sheet flow towards Jackson Creek Parkway and enter the roadway. This portion of the road will remain superelevated and the flows sheet flow towards the median and a proposed 10' Type R at-grade inlet. This facility collects a portion of these flows (**$Q_5= 5.4$ cfs, $Q_{100}= 8.2$ cfs**) with a flow-by of (**$Q_5= 0.6$ cfs, $Q_{100}= 3.8$ cfs**). This flow-by continues in a northerly direction down the street within Basin OS14D. The collected flows are conveyed in a proposed 18" RCP storm pipe in a northerly direction.



Design Point D8 ($Q_5= 3$ cfs, $Q_{100}= 8$ cfs) consists of a portion of the intersection including both proposed Jackson Creek Parkway and Highway 105 road improvements. Developed flow from this basin along with the flow-by described above sheet flow towards the intersection and a proposed 10' Type R sump inlet within the median. This facility completely collects these flows with a maximum ponding elevation of 6". The collected flows combine with the routed upstream flows and are conveyed in a proposed 24" RCP storm pipe in a westerly direction.

Design Point D9 ($Q_5= 2$ cfs, $Q_{100}= 5$ cfs) consists of a portion of the proposed Jackson Creek Parkway road improvements (Basin JPC7) and the on-site basin G. Developed flows from these basins sheet flow towards Jackson Creek Parkway and enter the roadway as curb and gutter flow towards a proposed 10' Type R at-grade inlet. This facility collects a portion of these flows ($Q_5= 2$ cfs, $Q_{100}= 4.8$ cfs) with a flow-by of ($Q_5= 0$ cfs, $Q_{100}= 0.2$ cfs). This flow-by continues in a westerly direction down the street within Basin OS17D. The collected flows are conveyed in a proposed 18" RCP storm pipe in a northerly direction.

Design Point D10 ($Q_5= 3$ cfs, $Q_{100}= 6$ cfs) consists of a portion of the proposed Highway 105 road improvements within Basin OS17D. Developed flows from this basin along with the upstream flow-by sheet flow towards Highway 105. At this location a proposed 10' Type R at-grade inlet is proposed. This facility collects a portion of these flows ($Q_5= 3$ cfs, $Q_{100}= 5.4$ cfs) with a flow-by of ($Q_5= 0$ cfs, $Q_{100}= 0.8$ cfs). This flow-by continues in a westerly direction down the street within Basin OS18D. The collected flows are conveyed in a proposed 18" RCP storm pipe towards the proposed storm system behind the curb.

Design Point D11 ($Q_5= 2$ cfs, $Q_{100}= 4$ cfs) consists of a portion of the proposed Highway 105 road improvements within Basin OS18D. Developed flows from this basin along with the minor upstream flow-by sheet flow towards Highway 105. At this location, an existing 10' Type R sump inlet completely collects these flows. The collected flows are conveyed out of the back of the inlet via an existing 24" RCP directly into the proposed SWQ facility.

Basin H ($Q_5= 0.4$ cfs, $Q_{100}= 1.8$ cfs) consists of a small portion of the proposed commercial development that will likely be landscape area and continue to sheet flow directly into Basin OS10D. **Basin OS10D ($Q_5= 0.8$ cfs, $Q_{100}= 4$ cfs)** consists of the existing vegetated slope within CDOT ROW that sheet flows to the sideroad ditch along the east side of the I-25 off-ramp. The combined flows will continue to travel as ditch flow directly into the proposed SWQ facility.



Design Point 13 ($Q_5 = 18$ cfs, $Q_{100} = 40$ cfs) consists of the total combined developed flows from all the tributary upstream basins within the Highway 105 corridor and Jackson Creek Parkway intersection described above. These developed flows compare to the pre-development flows as follows:

Developed Flows at exist. 36" RCP at I-25 off-ramp: ($Q_5 = 18$ cfs, $Q_{100} = 40$ cfs)

Pre-developed flows at exist. 36" RCP at I-25 off-ramp: ($Q_5 = 14$ cfs, $Q_{100} = 36$ cfs)

A proposed SWQ/detention facility is planned within CDOT Right-of-way to help manage the additional impervious area introduced within this roadway corridor created by the public roadway improvements. This facility is designed as an Extended Detention Basin (EDB) storm water quality facility with a full spectrum outlet box and associated forebay, micro pool, well screen, orifice plate, and 100-year outlet conveyance per the current drainage criteria manual. An IGA between CDOT and the Town of Monument will describe the ownership and maintenance responsibilities. The pond design allows for the required Water Quality Capture Volume with release through an orifice plate (Top of Micropool = 7004.50) and then the other storm events up to the 100 yr. event will be handled through a 6'x3' concrete outlet box (Top of box = 7010.00).

The following represents the required design for this facility (See Appendix):

SWQ Pond

Total tributary area: 11.84 ac.

Effective Imperviousness: 53.6%

	<u>Estimated</u>	<u>Provided</u>
Zone 1 (WQCV)	0.21 Ac.-ft.	0.21 Ac.-ft.
Zone 2 (EURV)	0.39 Ac.-ft.	0.39 Ac.-ft.
Zone 3 (100-yr.)	0.52 Ac.-ft.	0.24 Ac.-ft.
Total	1.12 Ac.-ft.	0.84 Ac.-ft.

Top of Micropool elev: 7004.50

6'x3' Conc. Outlet box with top of box height of 5.5' and exist. 36" RCP outfall pipe

Orifice Plate design: Four holes = 1-3/16" dia. spaced 16.5"

Calculations per MHFD-Detention_v4.05 spreadsheet:

Pond Peak Design Release: ($Q_2 = 0.5$ cfs, $Q_5 = 4.6$ cfs, $Q_{100} = 25.2$ cfs)

Pre-developed Release: ($Q_2 = 10$ cfs, $Q_5 = 14$ cfs, $Q_{100} = 36$ cfs)

Please reference the IGA between CDOT and the Town of Monument for details on ownership and maintenance.



DRAINAGE CRITERIA

Hydrologic calculations were performed using the Town of Monument Standards, which follow the City of Colorado Springs/El Paso County Drainage Criteria Manual, as revised in May 2014. The Rational Method was used to estimate storm water runoff anticipated from design storms for the 5 year and 100-year recurrence interval for local storm inlet and pipe facility sizing. Runoff Coefficients are based on the imperviousness of the particular land use and the hydrologic soil type in accordance with Table 6-6. The average rainfall intensity, by recurrence interval found in the Intensity-Duration-Frequency (IDF) curves in Figure 6-5. (See Appendix)

The UD-BMP spreadsheet (ver. 3.07) along with the MHFD-Detention spreadsheet (ver. 4.05) were used to calculate the required volume for the EURV and 100-year release. User input 1-hour precipitation values in the UD-Detention spreadsheet were taken from Table 6-2 Volume 1 Colorado Springs Drainage Criteria Manual.

FLOODPLAIN STATEMENT

No portion of this site is located within a floodplain as determined by the Flood Insurance Rate Maps (F.I.R.M.) Map Number 08041C0278G effective date, December 7, 2018 (See Appendix).

SUMMARY

Construction of these proposed public roadway improvements will not adversely affect the surrounding developments. All drainage facilities were sized using the current Drainage Criteria and will safely discharge storm water runoff to adequate outfalls. Developed flows will be routed to the proposed SWQ/detention facility within CDOT ROW and slowly released at historic rates. All existing downstream facilities will not be significantly affected upon the construction of these public improvements.

PREPARED BY:

Classic Consulting Engineers & Surveyors, LLC



Marc A. Whorton, P.E.
Project Manager

maw/130222/Reports/FDR – MJ West Hwy 105-JCP.doc



REFERENCES

1. City of Colorado Springs/County of El Paso Drainage Criteria Manual dated May 2014.
2. "Drainage Analysis Addendum No. 2 Village Center at Woodmoor", Classic Consulting Engineers and Surveyors, dated June 2009.
3. "Drainage Letter Amendment for the Drainage Analysis Addendum Village Center at Woodmoor", Classic Consulting Engineers and Surveyors, dated October 2010.
4. "Village Center @ Woodmoor Filing No.1" Berge-Brewer and Associates, Inc., dated January 2005.
5. "Drainage Basin Planning Study Dirty Woman Creek and Crystal Creek El Paso County," Kiowa Engineering Corporation, dated September 1993.
6. "MDDP for The Village" Classic Consulting, dated February 2020
7. "Final Drainage Report for Monument Junction East (Phase 1 PD Site Plan)", Classic Consulting, dated January 2022.
8. "Final Drainage Report for Monument Junction West Filing No. 1", Classic Consulting, dated March 2022.
9. "Preliminary Drainage Report – Highway 105 Project A for El Paso County", HDR, Inc., dated November 2021.



APPENDIX



VICINITY MAP

MONUMENT JUNCTION DEVELOPMENT
HIGHWAY 105 / JACKSON CREEK PKWY.
INTERSECTION IMPROVEMENTS
VICINITY MAP



SITE

MONUMENT
JUNCTION WEST

MONUMENT
JUNCTION EAST

Ronald Reagan Hwy

Jackson Creek Pkwy

Villa Grove

Paula Cir

Red Mica Way

Quarry Way

Knollwood Dr

Water Flume Way



Bowstring Rd



SOILS MAP (S.C.S SURVEY)



Soil Map—El Paso County Area, Colorado

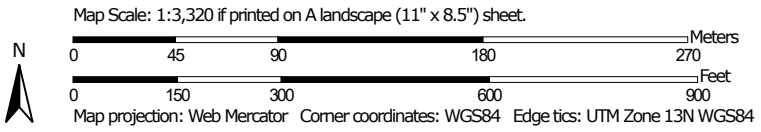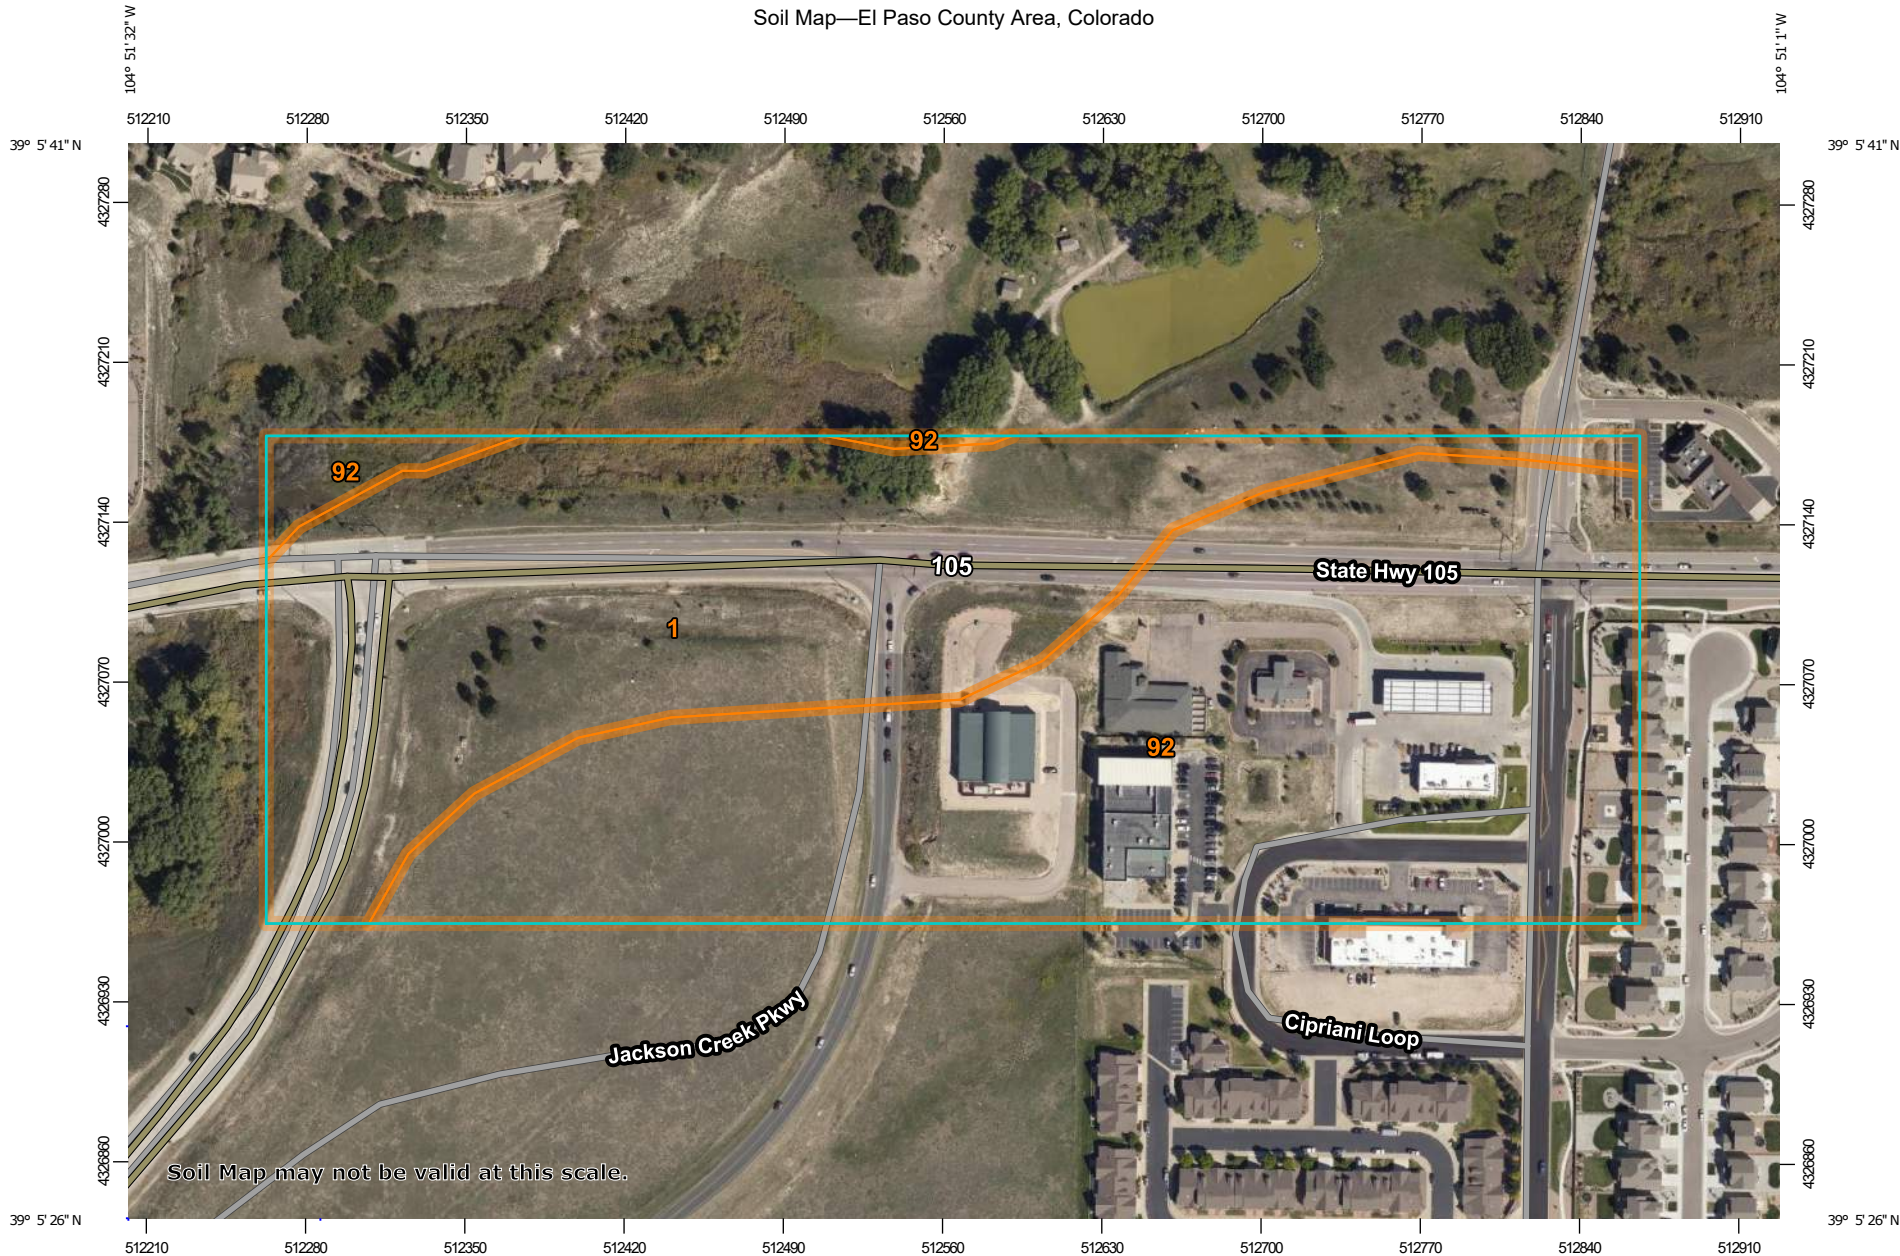

MAP LEGEND

Area of Interest (AOI)

Area of Interest (AOI)

Soils

 Soil Map Unit Polygons

 Soil Map Unit Lines

 Soil Map Unit Points

Special Point Features



Blowout



Borrow Pit



Clay Spot



Closed Depression



Gravel Pit



Gravelly Spot



Landfill



Lava Flow



Marsh or swamp



Mine or Quarry



Miscellaneous Water



Perennial Water



Rock Outcrop



Saline Spot



Sandy Spot



Severely Eroded Spot



Sinkhole



Slide or Slip



Sodic Spot



Spoil Area



Stony Spot



Very Stony Spot



Wet Spot



Other



Special Line Features

Water Features



Streams and Canals

Transportation



Rails



Interstate Highways



US Routes



Major Roads



Local Roads

Background



Aerial Photography

MAP INFORMATION

The soil surveys that comprise your AOI were mapped at 1:24,000.

Warning: Soil Map may not be valid at this scale.

Enlargement of maps beyond the scale of mapping can cause misunderstanding of the detail of mapping and accuracy of soil line placement. The maps do not show the small areas of contrasting soils that could have been shown at a more detailed scale.

Please rely on the bar scale on each map sheet for map measurements.

Source of Map: Natural Resources Conservation Service
 Web Soil Survey URL:
 Coordinate System: Web Mercator (EPSG:3857)

Maps from the Web Soil Survey are based on the Web Mercator projection, which preserves direction and shape but distorts distance and area. A projection that preserves area, such as the Albers equal-area conic projection, should be used if more accurate calculations of distance or area are required.

This product is generated from the USDA-NRCS certified data as of the version date(s) listed below.

Soil Survey Area: El Paso County Area, Colorado
 Survey Area Data: Version 19, Aug 31, 2021

Soil map units are labeled (as space allows) for map scales 1:50,000 or larger.

Date(s) aerial images were photographed: Aug 19, 2018—Sep 23, 2018

The orthophoto or other base map on which the soil lines were compiled and digitized probably differs from the background imagery displayed on these maps. As a result, some minor shifting of map unit boundaries may be evident.

Map Unit Legend

Map Unit Symbol	Map Unit Name	Acres in AOI	Percent of AOI
1	Alamosa loam, 1 to 3 percent slopes	13.3	41.7%
92	Tomah-Crowfoot loamy sands, 3 to 8 percent slopes	18.6	58.3%
Totals for Area of Interest		32.0	100.0%

El Paso County Area, Colorado

1—Alamosa loam, 1 to 3 percent slopes

Map Unit Setting

National map unit symbol: 3670

Elevation: 7,200 to 7,700 feet

Farmland classification: Prime farmland if irrigated and reclaimed of excess salts and sodium

Map Unit Composition

Alamosa and similar soils: 85 percent

Estimates are based on observations, descriptions, and transects of the mapunit.

Description of Alamosa

Setting

Landform: Flood plains, fans

Down-slope shape: Linear

Across-slope shape: Linear

Parent material: Alluvium

Typical profile

A - 0 to 6 inches: loam

Bt - 6 to 14 inches: clay loam

Btk - 14 to 33 inches: clay loam

Cg1 - 33 to 53 inches: sandy clay loam

Cg2 - 53 to 60 inches: sandy loam

Properties and qualities

Slope: 1 to 3 percent

Depth to restrictive feature: More than 80 inches

Drainage class: Poorly drained

Runoff class: Very high

Capacity of the most limiting layer to transmit water

(Ksat): Moderately high (0.20 to 0.60 in/hr)

Depth to water table: About 12 to 18 inches

Frequency of flooding: FrequentNone

Frequency of ponding: None

Calcium carbonate, maximum content: 5 percent

Maximum salinity: Very slightly saline to strongly saline (2.0 to 16.0 mmhos/cm)

Available water supply, 0 to 60 inches: High (about 10.2 inches)

Interpretive groups

Land capability classification (irrigated): None specified

Land capability classification (nonirrigated): 5w

Hydrologic Soil Group: D

Ecological site: R048AY241CO - Mountain Meadow

Hydric soil rating: Yes

Minor Components

Other soils

Percent of map unit:

Hydric soil rating: No

Data Source Information

Soil Survey Area: El Paso County Area, Colorado

Survey Area Data: Version 19, Aug 31, 2021

El Paso County Area, Colorado

92—Tomah-Crowfoot loamy sands, 3 to 8 percent slopes

Map Unit Setting

National map unit symbol: 36b9

Elevation: 7,300 to 7,600 feet

Farmland classification: Not prime farmland

Map Unit Composition

Tomah and similar soils: 50 percent

Crowfoot and similar soils: 30 percent

Estimates are based on observations, descriptions, and transects of the mapunit.

Description of Tomah

Setting

Landform: Hills, alluvial fans

Landform position (three-dimensional): Side slope, crest

Down-slope shape: Linear

Across-slope shape: Linear

Parent material: Alluvium derived from arkose and/or residuum weathered from arkose

Typical profile

A - 0 to 10 inches: loamy sand

E - 10 to 22 inches: coarse sand

Bt - 22 to 48 inches: stratified coarse sand to sandy clay loam

C - 48 to 60 inches: coarse sand

Properties and qualities

Slope: 3 to 8 percent

Depth to restrictive feature: More than 80 inches

Drainage class: Well drained

Runoff class: Medium

Capacity of the most limiting layer to transmit water

(Ksat): Moderately high to high (0.60 to 2.00 in/hr)

Depth to water table: More than 80 inches

Frequency of flooding: None

Frequency of ponding: None

Available water supply, 0 to 60 inches: Low (about 4.6 inches)

Interpretive groups

Land capability classification (irrigated): None specified

Land capability classification (nonirrigated): 4e

Hydrologic Soil Group: B

Ecological site: R049XY216CO - Sandy Divide

Hydric soil rating: No

Description of Crowfoot

Setting

Landform: Alluvial fans, hills
Landform position (three-dimensional): Side slope, crest
Down-slope shape: Linear
Across-slope shape: Linear
Parent material: Alluvium

Typical profile

A - 0 to 12 inches: loamy sand
E - 12 to 23 inches: sand
Bt - 23 to 36 inches: sandy clay loam
C - 36 to 60 inches: coarse sand

Properties and qualities

Slope: 3 to 8 percent
Depth to restrictive feature: More than 80 inches
Drainage class: Well drained
Runoff class: Medium
Capacity of the most limiting layer to transmit water (Ksat): Moderately high to high (0.60 to 2.00 in/hr)
Depth to water table: More than 80 inches
Frequency of flooding: None
Frequency of ponding: None
Available water supply, 0 to 60 inches: Low (about 4.7 inches)

Interpretive groups

Land capability classification (irrigated): None specified
Land capability classification (nonirrigated): 4e
Hydrologic Soil Group: B
Ecological site: R049XY216CO - Sandy Divide
Hydric soil rating: No

Minor Components

Other soils

Percent of map unit:
Hydric soil rating: No

Pleasant

Percent of map unit:
Landform: Depressions
Hydric soil rating: Yes

Data Source Information

Soil Survey Area: El Paso County Area, Colorado
Survey Area Data: Version 19, Aug 31, 2021

F.E.M.A. MAP



NOTES TO USERS

This map is for use in administering the National Flood Insurance Program. It does not necessarily identify all areas subject to flooding, particularly from local drainage sources of small size. The community map repository should be consulted for possible updated or additional flood hazard information.

To obtain more detailed information in areas where Base Flood Elevations (BFEs) and/or floodways have been determined, users are encouraged to consult the Flood Profiles and Floodway Data and/or Summary of Stillwater Elevations tables contained within the Flood Insurance Study (FIS) report that accompanies this FIRM. Users should be aware that BFEs shown on the FIRM represent rounded whole-foot elevations. These BFEs are intended for flood insurance rating purposes only and should not be used as the sole source of flood elevation information. Accordingly, flood elevation data presented in the FIS report should be utilized in conjunction with the FIRM for purposes of construction and/or floodplain management.

Coastal Base Flood Elevations shown on this map apply only landward of 0.0' North American Vertical Datum of 1988 (NAVD88). Users of this FIRM should be aware that coastal flood elevations are also provided in the Summary of Stillwater Elevations table in the Flood Insurance Study report for this jurisdiction. Elevations shown in the Summary of Stillwater Elevations table should be used for construction and/or floodplain management purposes when they are higher than the elevations shown on this FIRM.

Boundaries of the floodways were computed at cross sections and interpolated between cross sections. The floodways were based on hydraulic considerations with regard to requirements of the National Flood Insurance Program. Floodway widths and other pertinent floodway data are provided in the Flood Insurance Study report for this jurisdiction.

Certain areas not in Special Flood Hazard Areas may be protected by flood control structures. Refer to section 2.4 "Flood Protection Measures" of the Flood Insurance Study report for information on flood control structures for this jurisdiction.

The projection used in the preparation of this map was Universal Transverse Mercator (UTM) zone 13. The horizontal datum was NAD83, GRS80 spheroid. Differences in datum, spheroid, projection or UTM zones zones used in the production of FIRMs for adjacent jurisdictions may result in slight positional differences in map features across jurisdiction boundaries. These differences do not affect the accuracy of this FIRM.

Flood elevations on this map are referenced to the North American Vertical Datum of 1988 (NAVD88). These flood elevations must be compared to structure and ground elevations referenced to the same vertical datum. For information regarding conversion between the National Geodetic Vertical Datum of 1929 and the North American Vertical Datum of 1988, visit the National Geodetic Survey website at <http://www.ngs.noaa.gov/> or contact the National Geodetic Survey at the following address:

NGS Information Services
NOAA, NUNCS12
National Geodetic Survey
SSMC-3, #9202
1315 East-West Highway
Silver Spring, MD 20910-3282

To obtain current elevation, description, and/or location information for bench marks shown on this map, please contact the Information Services Branch of the National Geodetic Survey at (301) 713-3242 or visit its website at <http://www.ngs.noaa.gov/>.

Base Map information shown on this FIRM was provided in digital format by El Paso County, Colorado Springs Utilities, City of Fountain, Bureau of Land Management, National Oceanic and Atmospheric Administration, United States Geological Survey, and Anderson Consulting Engineers, Inc. These data are current as of 2006.

This map reflects more detailed and up-to-date stream channel configurations and floodplain delineations than those shown on the previous FIRM for this jurisdiction. The floodplains and floodways that were transferred from the previous FIRM may have been adjusted to conform to these new stream channel configurations. As a result, the Flood Profiles and Floodway Data tables in the Flood Insurance Study Report (which contains authoritative hydraulic data) may reflect stream channel distances that differ from what is shown on this map. The profile baselines depicted on this map represent the hydraulic modeling baselines that match the flood profiles and Floodway Data Tables if applicable, in the FIS report. As a result, the profile baselines may deviate significantly from the new base map channel representation and may appear outside of the floodplain.

Corporate limits shown on this map are based on the best data available at the time of publication. Because changes due to annexations or de-annexations may have occurred after this map was published, map users should contact appropriate community officials to verify current corporate limit locations.

Please refer to the separately printed Map Index for an overview map of the county showing the layout of map panels; community map repository addresses; and a Listing of Communities table containing National Flood Insurance Program dates for each community as well as a listing of the panels on which each community is located.


Contact FEMA Map Service Center (MSC) via the FEMA Map Information eXchange (FMIX) 1-877-336-2627 for information on available products associated with this FIRM. Available products may include previously issued Letters of Map Change, a Flood Insurance Study Report, and/or digital versions of this map. The MSC may also be reached by Fax at 1-800-358-9620 and its website at <http://www.msc.fema.gov/>.

If you have questions about this map or questions concerning the National Flood Insurance Program in general, please call 1-877-FEMA MAP (1-877-336-2627) or visit the FEMA website at <http://www.fema.gov/business/nfp>.


El Paso County Vertical Datum Offset Table

Flooding Source	Vertical Datum Offset (ft)
REFER TO SECTION 3.3 OF THE EL PASO COUNTY FLOOD INSURANCE STUDY FOR STREAM BY STREAM VERTICAL DATUM CONVERSION INFORMATION	


Panel Location Map

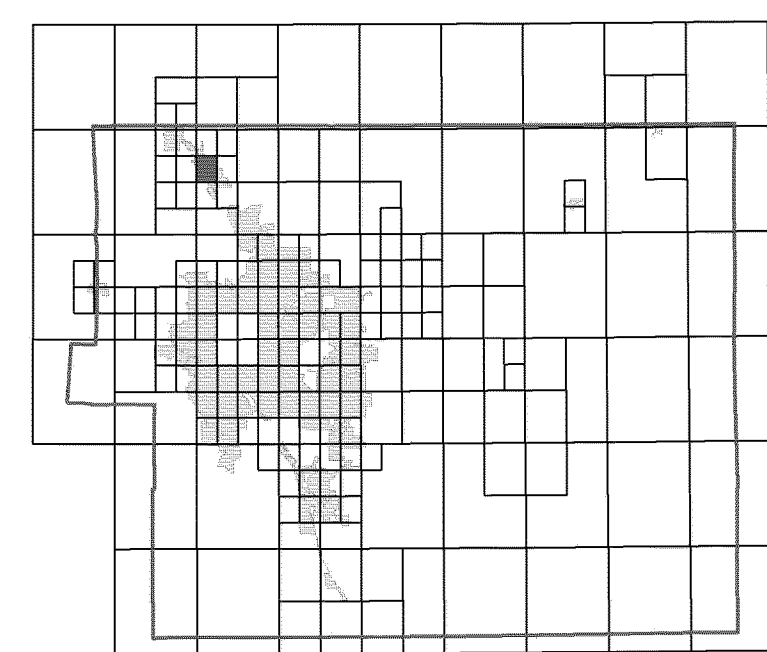

This Digital Flood Insurance Rate Map (DFIRM) was produced through a Cooperating Technical Partner (CTP) agreement between the State of Colorado Water Conservation Board (CWCB) and the Federal Emergency Management Agency (FEMA).

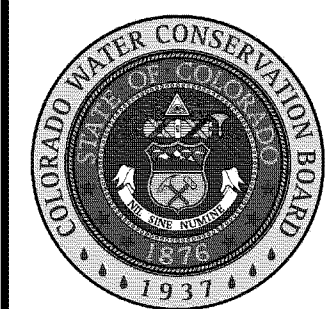

Additional Flood Hazard information and resources are available from local communities and the Colorado Water Conservation Board.

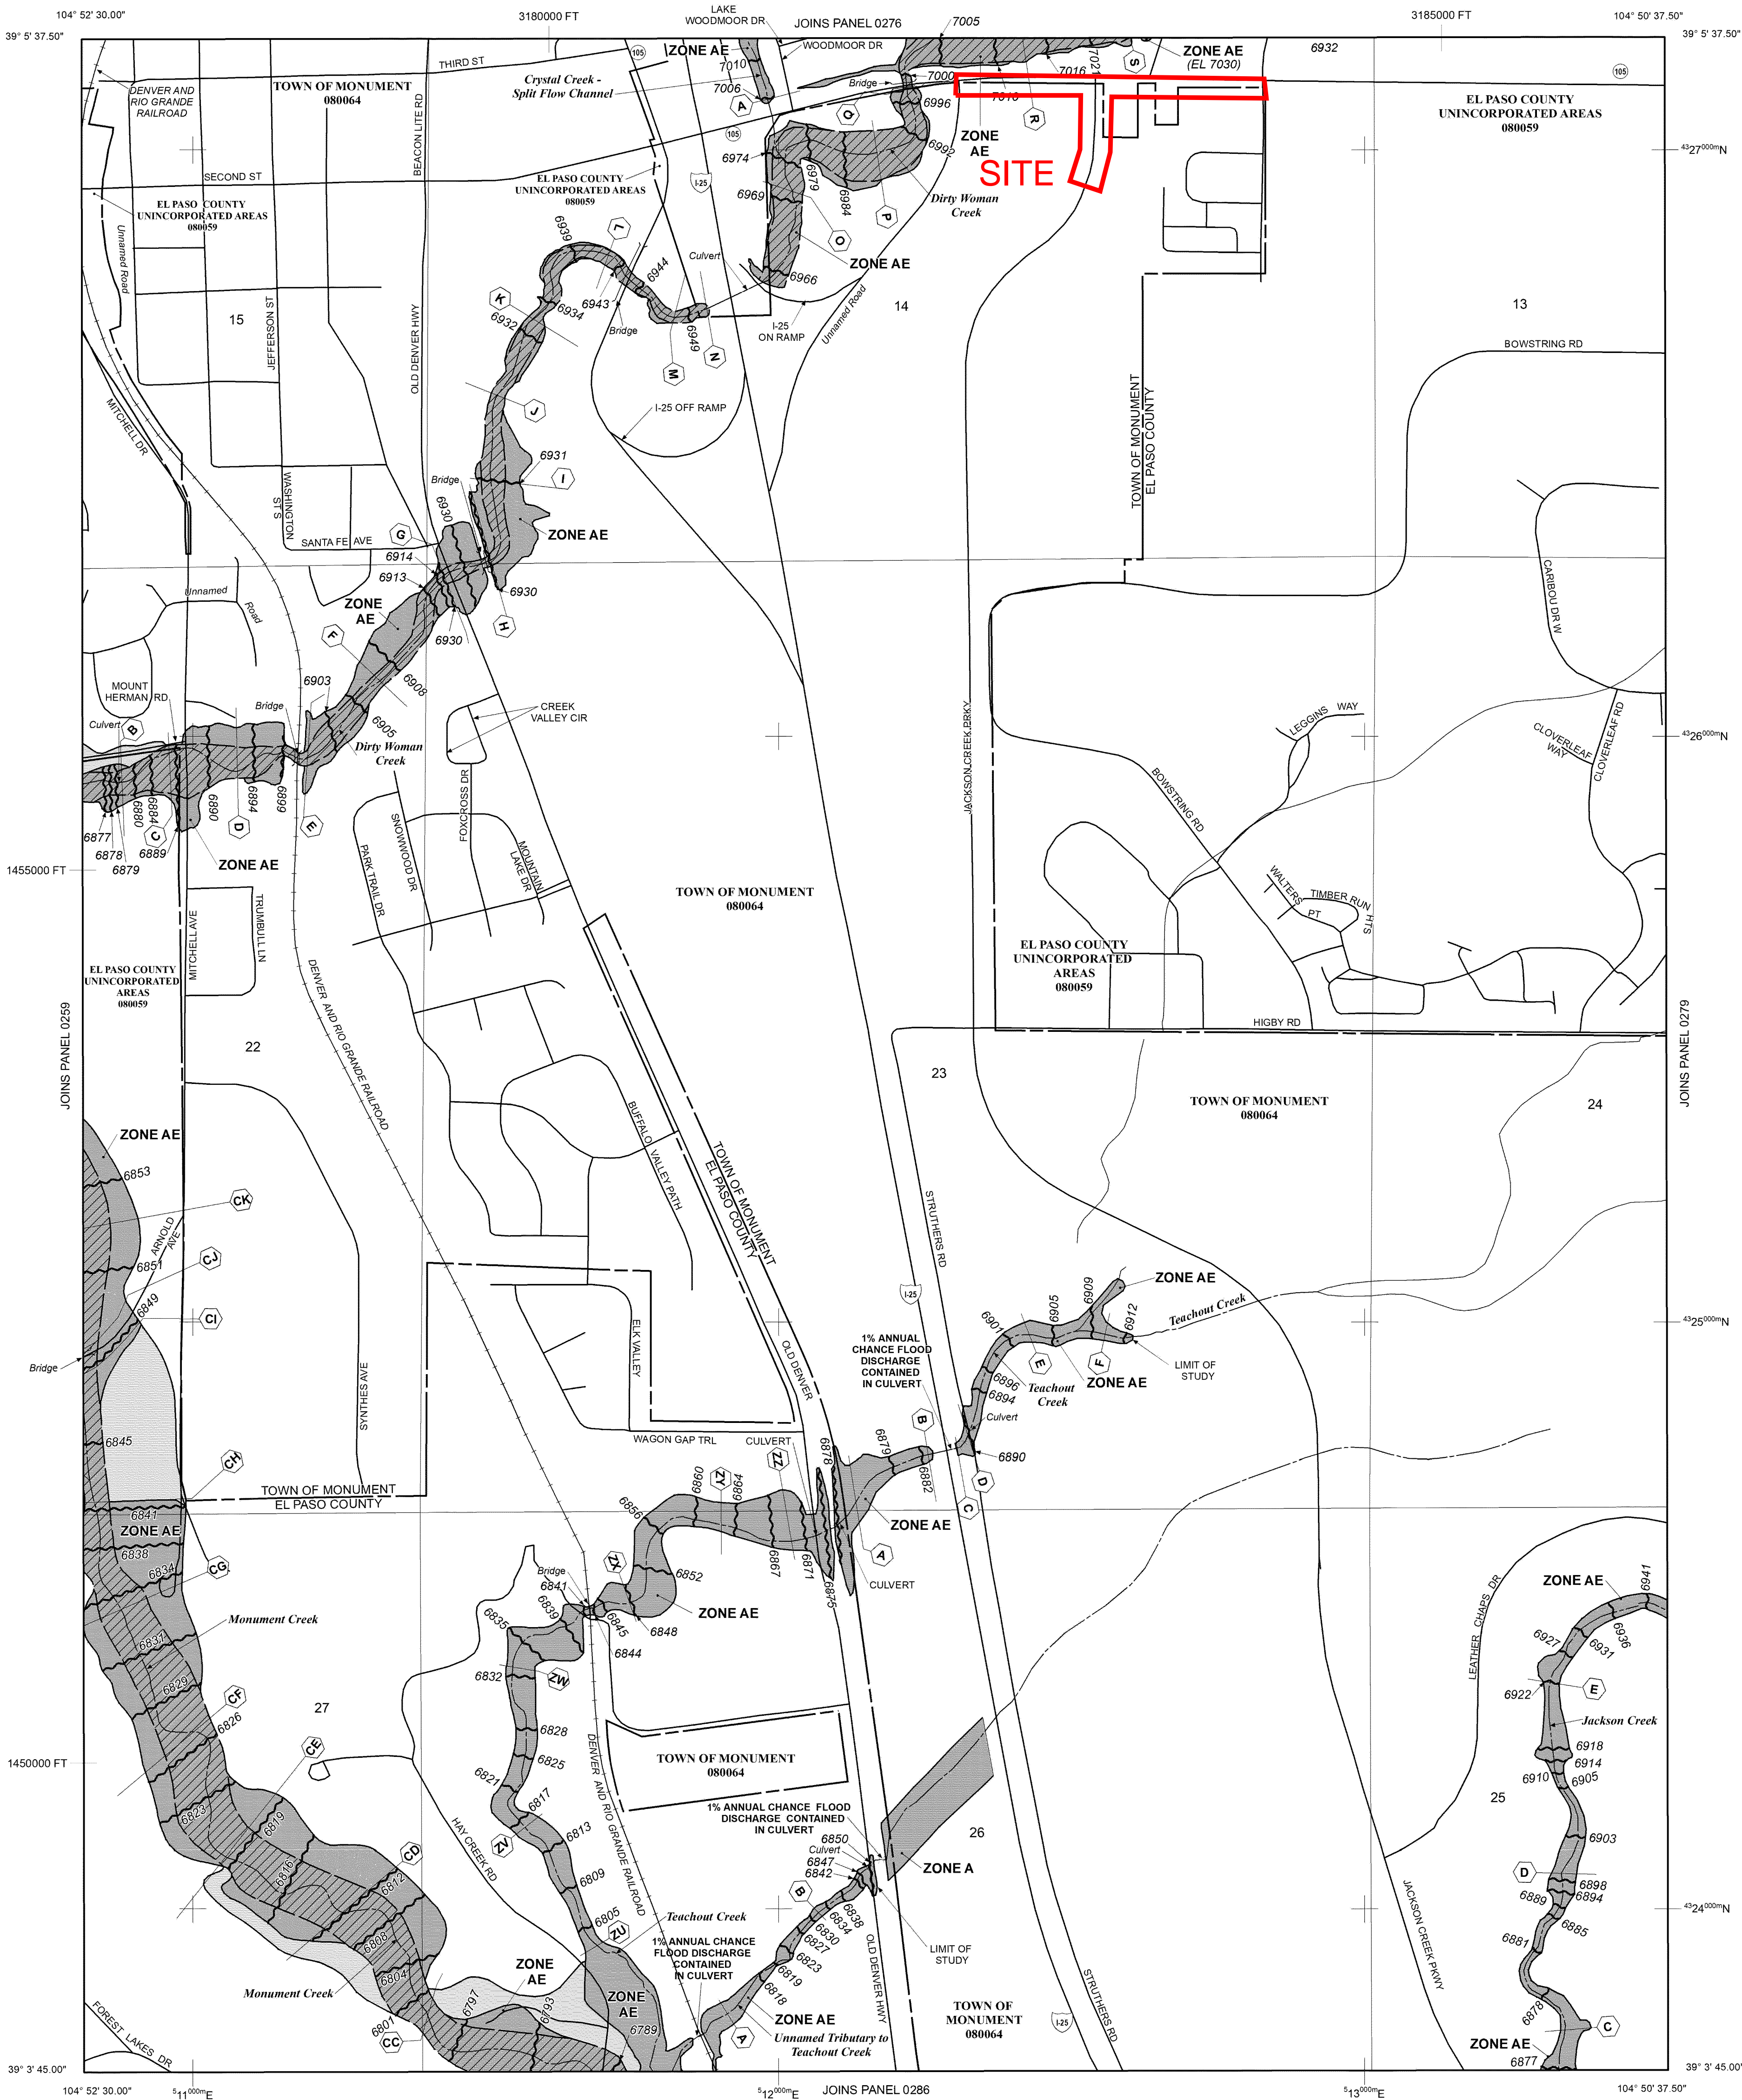

NOTE: MAP AREA SHOWN ON THIS PANEL IS LOCATED WITHIN TOWNSHIP 11 SOUTH, RANGE 67 WEST.

LEGEND

- SPECIAL FLOOD HAZARD AREAS (SFHAs) SUBJECT TO INUNDATION BY THE 1% ANNUAL CHANCE FLOOD
- ZONE A No Base Flood Elevations determined.
- ZONE AE Base Flood Elevations determined.
- ZONE AH Flood depths of 1 to 3 feet (usually areas of ponding); Base Flood Elevations determined.
- ZONE AO Flood depths of 1 to 3 feet (usually sheet flow on sloping terrain); average depths determined. For areas of alluvial fan flooding, velocities also determined.
- ZONE AR Special Flood Hazard Area Formerly protected from the 1% annual chance flood by a flood control system that was subsequently decertified. Zone AR indicates that the former flood control system is being restored to provide protection from the 1% annual chance or greater flood.
- ZONE A99 Area to be protected from 1% annual chance flood by a Federal flood protection system under construction; no Base Flood Elevations determined.
- ZONE V Coastal flood zone with velocity hazard (wave action); no Base Flood Elevations determined.
- ZONE VE Coastal flood zone with velocity hazard (wave action); Base Flood Elevations determined.
- FLOODWAY AREAS IN ZONE AE
- OTHER FLOOD AREAS
- ZONE X Areas of 0.2% annual chance flood; areas of 1% annual chance flood with average depths of less than 1 foot, or with drainage areas less than 1 square mile; and areas protected by levees from 1% annual chance flood.
- OTHER AREAS
- ZONE X Areas determined to be outside the 0.2% annual chance floodplain.
- ZONE D Areas in which flood hazards are undetermined, but possible.
- COASTAL BARRIER RESOURCES SYSTEM (CBRS) AREAS
- OTHERWISE PROTECTED AREAS (OPAs)

CBRS areas and OPAs are normally located within or adjacent to Special Flood Hazard Areas.

- Floodplain boundary
- Floodway boundary
- Zone D Boundary
- CBRS and OPA boundary
- Boundary dividing Special Flood Hazard Areas of different Base Flood Elevations, flood depths or flood velocities
- Base Flood Elevation line and value; elevation in feet* (EL 987)

* Referenced to the North American Vertical Datum of 1988 (NAVD 88)

- Cross section line
- Transect line
- Geographic coordinates referenced to the North American Datum of 1983 (NAD 83)
- 1000-meter Universal Transverse Mercator grid ticks, zone 13
- 5000-foot grid ticks; Colorado State Plane coordinate system, central zone (FIPS/CON 5002), Lambert Conformal Conic Projection
- Bench mark (see explanation in Notes to Users section of this FIRM panel)
- River Mile


MAP REPOSITORIES
Refer to Map Repositories list on Map Index

EFFECTIVE DATE OF COUNTYWIDE FLOOD INSURANCE RATE MAP
MARCH 17, 1997

EFFECTIVE DATE(S) OF REVISION(S) TO THIS PANEL
DECEMBER 7, 2018 - to update corporate limits, to change Base Flood Elevations and Special Flood Hazard Areas, to update map format, to add roads and road names, and to incorporate previously issued Letters of Map Revision

For community map revision history prior to countywide mapping, refer to the Community Map History Table located in the Flood Insurance Study report for this jurisdiction.

To determine if flood insurance is available in this community, contact your insurance agent or call the National Flood Insurance Program at 1-800-638-6620.

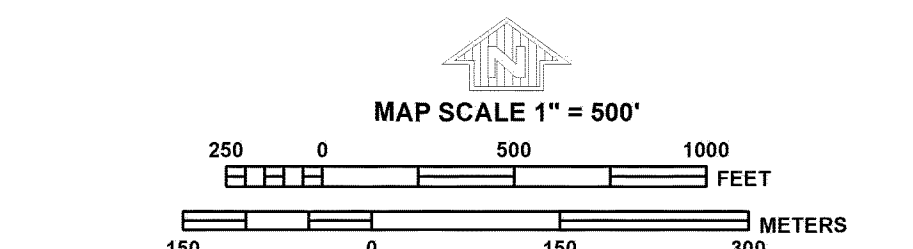

NFIP

PANEL 0278G

FIRM

FLOOD INSURANCE RATE MAP

EL PASO COUNTY, COLORADO AND INCORPORATED AREAS

PANEL 278 OF 1300

(SEE MAP INDEX FOR FIRM PANEL LAYOUT)

CONTAINS:

COMMUNITY	NUMBER	PANEL	SUFFIX
EL PASO COUNTY	08009	0278	G
MONUMENT, TOWN OF	08004	0278	G

Notice: This map was reissued on 05/15/2020 to make a correction. This version replaces any previous versions. See the Notice-to-User Letter that accompanied this correction for details.

Notice to User: The Map Number shown below should be used when placing map orders. The Community Number shown above should be used on insurance applications for the subject community.

MAP NUMBER
08041C0278G

MAP REVISED
DECEMBER 7, 2018

Federal Emergency Management Agency

JURISDICTIONAL DETERMINATION





DEPARTMENT OF THE ARMY
CORPS OF ENGINEERS, ALBUQUERQUE DISTRICT
SOUTHERN COLORADO REGULATORY BRANCH
201 WEST 8TH STREET, SUITE 350
PUEBLO, COLORADO 81003

June 23, 2022

Regulatory Division

SUBJECT: Jurisdictional Determination- Action No.SPA-2022-00180

Classic Communities
Attn: Steve Schlosser
2138 Flying Horse Club Drive
Colorado Springs, Colorado 80921
sschlosser@classichomes.com

Dear Mr. Schlosser:

This letter responds to your request for a jurisdictional determination (JD) for multiple aquatic resources associated with the Monument Junction-Highway 105 improvement Project. The project site is located near Dirty Woman Creek, centered at latitude 39.092991°, longitude -104.856431°, Colorado Springs, El Paso County, Colorado. We have assigned Action No. SPA-2022-00180 to your request. Please reference this number in all future correspondence concerning the site.

Based on the information provided, we concur with your aquatic resource delineation for the site, as depicted on the enclosed drawing labeled, *SPA-2022-00180, Figure 1*, prepared by Core Consultants, Inc. (enclosure 1). We have determined that the site does not contain waters of the United States that are subject to regulation under Section 404 of the Clean Water Act. The aquatic resources identified as *WT-A1 (0.169 acres)*, *WT-A2 (0.006 acre)*, *ST-A1 (0.003 acre)*, *ST-A2 (0.001 acre)*, *ST-A3 (0.001 acre)*, and *ST-A4 (0.001 acre)*, on the above drawing are man-made wetland and ditch features that were constructed in uplands, drain only uplands, and do not have relatively permanent flow. As such, these aquatic resources are not regulated by the U.S. Army Corps of Engineers. This disclaimer of jurisdiction is only for Section 404 of the Federal Clean Water Act.


We are enclosing a copy of the *Approved Jurisdictional Determination Form* for your site (enclosure 2). A copy of this JD is also available at <http://www.spa.usace.army.mil/req/JD>. This approved JD is valid for five years unless new information warrants revision of the determination before the expiration date.

You may accept or appeal this approved JD or provide new information in accordance with the attached Notification of Administration Appeal Options and Process and Request for Appeal (NAAOP-RFA) (enclosure 3). If you elect to appeal this approved JD, you must complete Section II of the form and return it to the Army Engineer Division, South Pacific, CESPDPDS-O, Attn: Tom Cavanaugh, Administrative

Appeal Review Officer, P.O. Box 36023, 450 Golden Gate Ave, San Francisco, CA 94102 within 60 days of the date of this notice. Failure to notify the Corps within 60 days of the date of this notice means that you accept the approved JD in its entirety and waive all rights to appeal the approved JD.

If you have any questions, please contact Senior Project Manager Kyle Zibung by email at kyle.d.zibung@usace.army.mil, or telephone at (651) 290-5877. For program information or to complete our Customer Survey, visit our website at <https://www.spa.usace.army.mil/Missions/Regulatory-Program-and-Permits/>.

Sincerely,

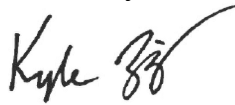A handwritten signature in black ink, appearing to read "Kyle Zibung". The signature is fluid and cursive, with a long horizontal stroke extending from the end.

Kyle Zibung
Senior Project Manager
Southern Colorado Branch

Enclosures

cc:

Natalie Graves, Core Consultants, Inc. (ngraves@liveyourcore.com)

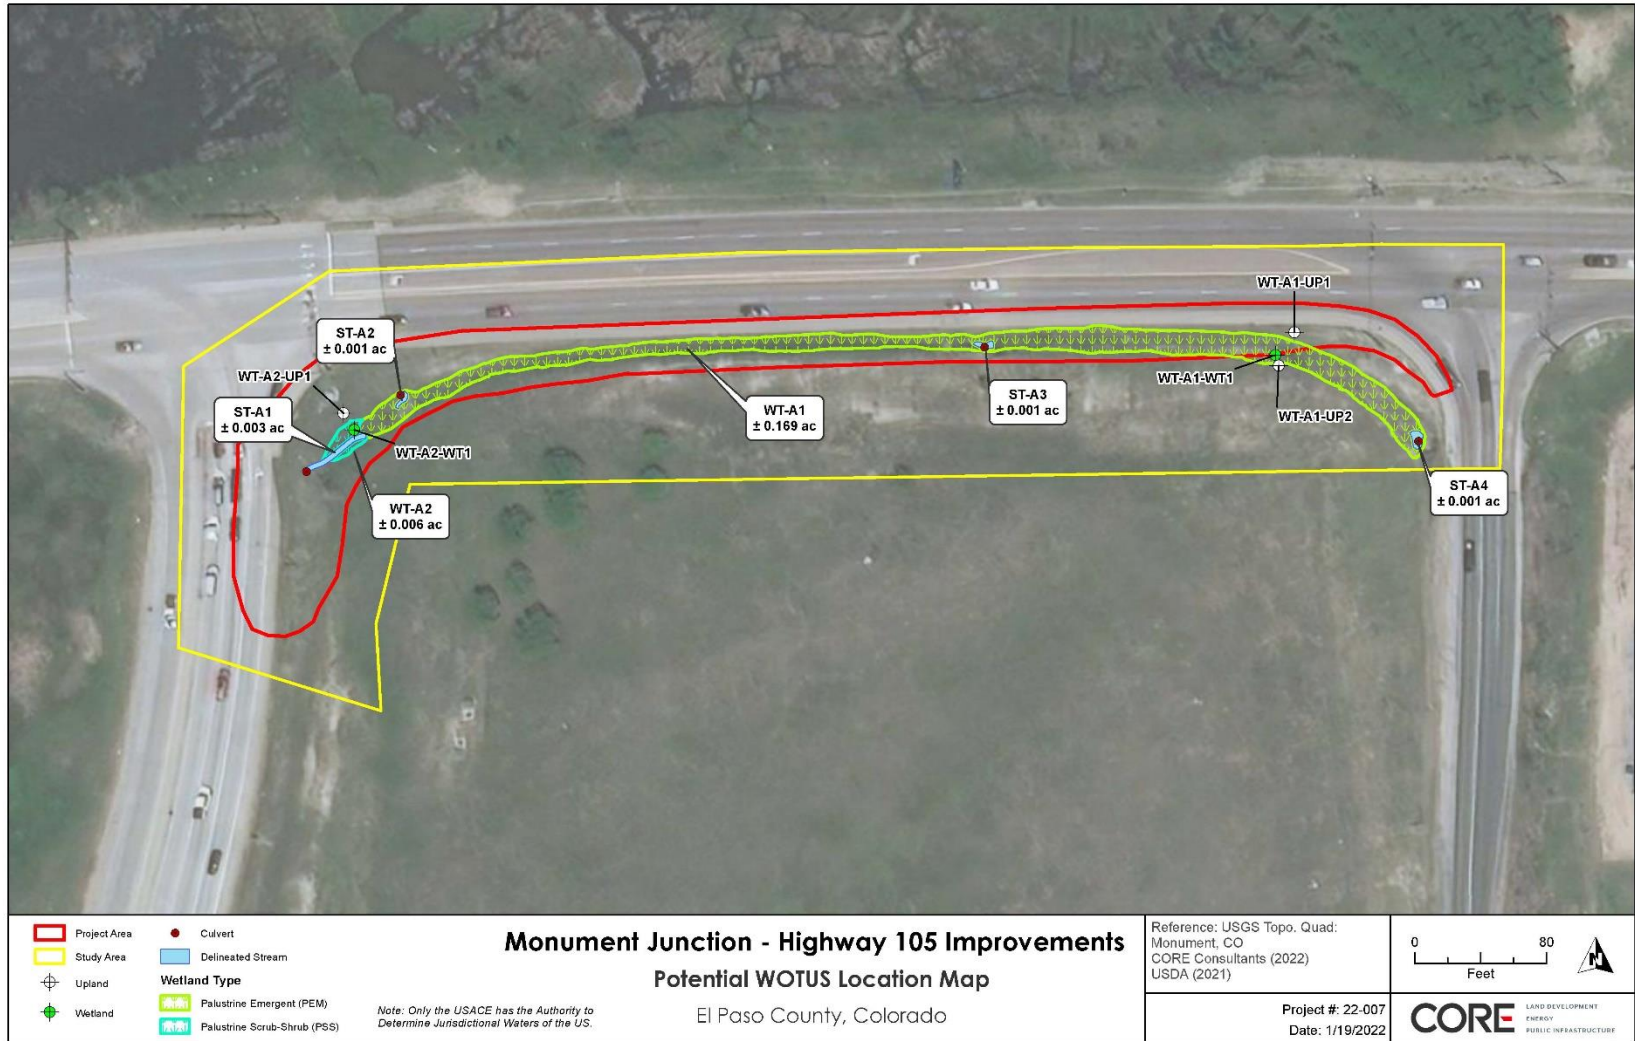


Figure 4.4 Potential WOTUS Location Map

NOTIFICATION OF ADMINISTRATIVE APPEAL OPTIONS AND PROCESS AND REQUEST FOR APPEAL

Applicant: Classic Communities c/o Steve Schlosser	File No.: SPA-2022-00180	Date: June 23, 2022
Attached is:		See Section below
	INITIAL PROFFERED PERMIT (Standard Permit or Letter of permission)	A
	PROFFERED PERMIT (Standard Permit or Letter of permission)	B
	PERMIT DENIAL	C
→	APPROVED JURISDICTIONAL DETERMINATION	D
	PRELIMINARY JURISDICTIONAL DETERMINATION	E

SECTION I - The following identifies your rights and options regarding an administrative appeal of the above decision. Additional information may be found at http://www.usace.army.mil/cecw/pages/reg_materials.aspx or Corps regulations at 33 CFR Part 331.

A: INITIAL PROFFERED PERMIT: You may accept or object to the permit.

- **ACCEPT:** If you received a Standard Permit, you may sign the permit document and return it to the district engineer for final authorization. If you received a Letter of Permission (LOP), you may accept the LOP and your work is authorized. Your signature on the Standard Permit or acceptance of the LOP means that you accept the permit in its entirety, and waive all rights to appeal the permit, including its terms and conditions, and approved jurisdictional determinations associated with the permit.
- **OBJECT:** If you object to the permit (Standard or LOP) because of certain terms and conditions therein, you may request that the permit be modified accordingly. You must complete Section II of this form and return the form to the district engineer. Your objections must be received by the district engineer within 60 days of the date of this notice, or you will forfeit your right to appeal the permit in the future. Upon receipt of your letter, the district engineer will evaluate your objections and may: (a) modify the permit to address all of your concerns, (b) modify the permit to address some of your objections, or (c) not modify the permit having determined that the permit should be issued as previously written. After evaluating your objections, the district engineer will send you a proffered permit for your reconsideration, as indicated in Section B below.

B: PROFFERED PERMIT: You may accept or appeal the permit

- **ACCEPT:** If you received a Standard Permit, you may sign the permit document and return it to the district engineer for final authorization. If you received a Letter of Permission (LOP), you may accept the LOP and your work is authorized. Your signature on the Standard Permit or acceptance of the LOP means that you accept the permit in its entirety, and waive all rights to appeal the permit, including its terms and conditions, and approved jurisdictional determinations associated with the permit.
- **APPEAL:** If you choose to decline the proffered permit (Standard or LOP) because of certain terms and conditions therein, you may appeal the declined permit under the Corps of Engineers Administrative Appeal Process by completing Section II of this form and sending the form to the division engineer (address on reverse). This form must be received by the division engineer within 60 days of the date of this notice.

C: PERMIT DENIAL: You may appeal the denial of a permit under the Corps of Engineers Administrative Appeal Process by completing Section II of this form and sending the form to the division engineer (address on reverse). This form must be received by the division engineer within 60 days of the date of this notice.

D: APPROVED JURISDICTIONAL DETERMINATION: You may accept or appeal the approved JD or provide new information.

- **ACCEPT:** You do not need to notify the Corps to accept an approved JD. Failure to notify the Corps within 60 days of the date of this notice, means that you accept the approved JD in its entirety, and waive all rights to appeal the approved JD.
- **APPEAL:** If you disagree with the approved JD, you may appeal the approved JD under the Corps of Engineers Administrative Appeal Process by completing Section II of this form and sending the form to the division engineer (address on reverse). This form must be received by the division engineer within 60 days of the date of this notice.

E: PRELIMINARY JURISDICTIONAL DETERMINATION: You do not need to respond to the Corps regarding the preliminary JD. The Preliminary JD is not appealable. If you wish, you may request an approved JD (which may be appealed), by contacting the Corps district for further instruction. Also you may provide new information for further consideration by the Corps to reevaluate the JD.

SECTION II - REQUEST FOR APPEAL or OBJECTIONS TO AN INITIAL PROFFERED PERMIT

REASONS FOR APPEAL OR OBJECTIONS: (Describe your reasons for appealing the decision or your objections to an initial proffered permit in clear concise statements. You may attach additional information to this form to clarify where your reasons or objections are addressed in the administrative record.)

ADDITIONAL INFORMATION: The appeal is limited to a review of the administrative record, the Corps memorandum for the record of the appeal conference or meeting, and any supplemental information that the review officer has determined is needed to clarify the administrative record. Neither the appellant nor the Corps may add new information or analyses to the record. However, you may provide additional information to clarify the location of information that is already in the administrative record.

POINT OF CONTACT FOR QUESTIONS OR INFORMATION:

If you have questions regarding this decision and/or the appeal process you may contact:

Kyle Zibung
U.S. Army Corps of Engineers
201 West 8th Street, Suite 350
Pueblo, Colorado 81003

Phone: 651-290-5877
Email: kyle.d.zibung@usace.army.mil

If you only have questions regarding the appeal process you may also contact:

Thomas J. Cavanaugh
Administrative Appeal Review Officer
U.S. Army Corps of Engineers
South Pacific Division
P.O. Box 36023, 450 Golden Gate Ave
San Francisco, California 94102
Phone: 415-503-6574, FAX:415-503-6646
Email: Thomas.J.Cavanaugh@usace.army.mil

RIGHT OF ENTRY: Your signature below grants the right of entry to Corps of Engineers personnel, and any government consultants, to conduct investigations of the project site during the course of the appeal process. You will be provided a 15 day notice of any site investigation and will have the opportunity to participate in all site investigations.

Signature of appellant or agent.

Date:

Telephone number:

APPROVED JURISDICTIONAL DETERMINATION FORM
U.S. Army Corps of Engineers

This form should be completed by following the instructions provided in Section IV of the JD Form Instructional Guidebook.

SECTION I: BACKGROUND INFORMATION

A. REPORT COMPLETION DATE FOR APPROVED JURISDICTIONAL DETERMINATION (JD): June 23, 2022

B. ST PAUL, MN DISTRICT OFFICE, FILE NAME, AND NUMBER: SPA-2022-00180, Classic Communities Highway 105 AJD

C. PROJECT LOCATION AND BACKGROUND INFORMATION:

State: Colorado County/parish/borough: El Paso County City: Monument

Center coordinates of site (lat/long in degree decimal format): Lat. 39.092991° N, Long. -104.856431° W.

Universal Transverse Mercator: 15

Name of nearest waterbody:

Name of watershed or Hydrologic Unit Code (HUC): 07020007

- Check if map/diagram of review area and/or potential jurisdictional areas is/are available upon request.
 Check if other sites (e.g., offsite mitigation sites, disposal sites, etc...) are associated with this action and are recorded on a different JD form.

D. REVIEW PERFORMED FOR SITE EVALUATION (CHECK ALL THAT APPLY):

- Office (Desk) Determination. Date: June 22, 2022
 Field Determination. Date(s): June 8, 2022

SECTION II: SUMMARY OF FINDINGS

A. RHA SECTION 10 DETERMINATION OF JURISDICTION.

There are no "navigable waters of the U.S." within Rivers and Harbors Act (RHA) jurisdiction (as defined by 33 CFR part 329) in the review area.

B. CWA SECTION 404 DETERMINATION OF JURISDICTION.

There are no "waters of the U.S." within Clean Water Act (CWA) jurisdiction (as defined by 33 CFR part 328) in the review area.

1. Waters of the U.S.: N/A

2. Non-regulated waters/wetlands (check if applicable):¹

Potentially jurisdictional waters and/or wetlands were assessed within the review area and determined to be not jurisdictional. Explain: **The review area for this determination is comprised of two linear wetlands labeled as WT-A1 (0.169 acres) and WT-A2 (0.006 acre) and four linear stream segments labeled as ST-A1 (0.003 acre), ST-A2 (0.001 acre), ST-A3 (0.001 acre), and ST-A4 (0.001 acre) in the February 2022, Core Consultants, Inc. Wetland Delineation Report. In 2005, the entire review area was graded for roadway improvements to Highway 105 and the I-25 interchange, thereby creating all six linear aquatic resources evaluated by this determination. Based on an analysis of multiple years of aerial photography, USDA web soil survey data, USGS topographic maps, USGS NHD, NWI mapping, February 2022, Core Consultants, Inc. Wetland Delineation Report, and a June 22, 2002 site visit, the Corps has determined that all six aquatic resources are linear roadside drainage features constructed in uplands during grading for the Highway 105 and the I-25 interchange projects. In accordance with Corps Regulations at 33 CFR Part 328.3(b) and associated Rapanos Guidance, the aforementioned aquatic features are not within the Corps jurisdiction because they were constructed in uplands, drain only uplands, and do not have relatively permanent flow.**

SECTION III: CWA ANALYSIS

A. TNWs AND WETLANDS ADJACENT TO TNWs: N/A

B. CHARACTERISTICS OF TRIBUTARY (THAT IS NOT A TNW) AND ITS ADJACENT WETLANDS (IF ANY): N/A

C. SIGNIFICANT NEXUS DETERMINATION: N/A

D. DETERMINATIONS OF JURISDICTIONAL FINDINGS. THE SUBJECT WATERS/WETLANDS ARE (CHECK ALL THAT APPLY): N/A

¹ Supporting documentation is presented in Section III.F.

E. ISOLATED [INTERSTATE OR INTRA-STATE] WATERS, INCLUDING ISOLATED WETLANDS, THE USE, DEGRADATION OR DESTRUCTION OF WHICH COULD AFFECT INTERSTATE COMMERCE, INCLUDING ANY SUCH WATERS (CHECK ALL THAT APPLY): N/A

F. NON-JURISDICTIONAL WATERS, INCLUDING WETLANDS (CHECK ALL THAT APPLY):

- If potential wetlands were assessed within the review area, these areas did not meet the criteria in the 1987 Corps of Engineers Wetland Delineation Manual and/or appropriate Regional Supplements.
- Review area included isolated waters with no substantial nexus to interstate (or foreign) commerce.
 - Prior to the Jan 2001 Supreme Court decision in “*SWANCC*,” the review area would have been regulated based solely on the “Migratory Bird Rule” (MBR).
- Waters do not meet the “Significant Nexus” standard, where such a finding is required for jurisdiction. Explain:
- Other (explain, if not covered above):

Provide acreage estimates for non-jurisdictional waters in the review area, where the sole potential basis of jurisdiction is the MBR factors (i.e., presence of migratory birds, presence of endangered species, use of water for irrigated agriculture), using best professional judgment (check all that apply):

- Non-wetland waters (i.e., rivers, streams): linear feet width (ft).
- Lakes/ponds: acres.
- Other non-wetland waters: acres. List type of aquatic resource: .
- Wetlands: acres.

Provide acreage estimates for non-jurisdictional waters in the review area that do not meet the “Significant Nexus” standard, where such a finding is required for jurisdiction (check all that apply):

- Non-wetland waters (i.e., rivers, streams): linear feet, width (ft).
- Lakes/ponds: acres.
- Other non-wetland waters: acres. List type of aquatic resource: .
- Wetlands: acres.

SECTION IV: DATA SOURCES.

A. SUPPORTING DATA. Data reviewed for JD (check all that apply - checked items shall be included in case file and, where checked and requested, appropriately reference sources below):

- Maps, plans, plots or plat submitted by or on behalf of the applicant/consultant: February 2022, Core Consultants, Inc.

Wetland Delineation Report

- Data sheets prepared/submitted by or on behalf of the applicant/consultant.
 - Office concurs with data sheets/delineation report.
 - Office does not concur with data sheets/delineation report.

- Data sheets prepared by the Corps:
- Corps navigable waters’ study:

- U.S. Geological Survey Hydrologic Atlas:
 - USGS NHD data.
 - USGS 8 and 12 digit HUC maps.

- U.S. Geological Survey map(s). Cite scale & quad name: 1:24k-Monument

- USDA Natural Resources Conservation Service Soil Survey. Citation: Web Soil Survey

- National wetlands inventory map(s). Cite name: National Wetland Inventory

- State/Local wetland inventory map(s):

- FEMA/FIRM maps:

- 100-year Floodplain Elevation is: (National Geodetic Vertical Datum of 1929)

- Photographs: Aerial (Name & Date): Site Photos contained in Feb 2022 Core Consultants, Inc. Wetland Delineation Report

or Other (Name & Date): Google Earth- 1999, 2004, 2005, 2006, 2008, 2010, 2011, 2015,

2017, 2019, 2020

- Previous determination(s). File no. and date of response letter:
- Applicable/supporting case law:
- Applicable/supporting scientific literature:
- Other information (please specify):

B. ADDITIONAL COMMENTS TO SUPPORT JD:

HYDROLOGIC / HYDRAULIC CALCULATIONS



For Colorado Springs and much of the Fountain Creek watershed, the 1-hour depths are fairly uniform and are summarized in Table 6-2. Depending on the location of the project, rainfall depths may be calculated using the described method and the NOAA Atlas maps shown in Figures 6-6 through 6-17.

Table 6-2. Rainfall Depths for Colorado Springs

Return Period	1-Hour Depth	6-Hour Depth	24-Hour Depth
2	1.19	1.70	2.10
5	1.50	2.10	2.70
10	1.75	2.40	3.20
25	2.00	2.90	3.60
50	2.25	3.20	4.20
100	2.52	3.50	4.60

Where $Z = 6,840 \text{ ft}/100$

These depths can be applied to the design storms or converted to intensities (inches/hour) for the Rational Method as described below. However, as the basin area increases, it is unlikely that the reported point rainfalls will occur uniformly over the entire basin. To account for this characteristic of rain storms an adjustment factor, the Depth Area Reduction Factor (DARF) is applied. This adjustment to rainfall depth and its effect on design storms is also described below. The UDFCD UD-Rain spreadsheet, available on UDFCD's website, also provides tools to calculate point rainfall depths and Intensity-Duration-Frequency curves² and should produce similar depth calculation results.

2.2 Design Storms

Design storms are used as input into rainfall/runoff models and provide a representation of the typical temporal distribution of rainfall events when the creation or routing of runoff hydrographs is required. It has long been observed that rainstorms in the Front Range of Colorado tend to occur as either short-duration, high-intensity, localized, convective thunderstorms (cloud bursts) or longer-duration, lower-intensity, broader, frontal (general) storms. The significance of these two types of events is primarily determined by the size of the drainage basin being studied. Thunderstorms can create high rates of runoff within a relatively small area, quickly, but their influence may not be significant very far downstream. Frontal storms may not create high rates of runoff within smaller drainage basins due to their lower intensity, but tend to produce larger flood flows that can be hazardous over a broader area and extend further downstream.

- **Thunderstorms:** Based on the extensive evaluation of rain storms completed in the Carlton study (Carlton 2011), it was determined that typical thunderstorms have a duration of about 2 hours. The study evaluated over 300,000 storm cells using gage-adjusted NEXRAD data, collected over a 14-year period (1994 to 2008). Storms lasting longer than 3 hours were rarely found. Therefore, the results of the Carlton study have been used to define the shorter duration design storms.

To determine the temporal distribution of thunderstorms, 22 gage-adjusted NEXRAD storm cells were studied in detail. Through a process described in a technical memorandum prepared by the City of Colorado Springs (City of Colorado Springs 2012), the results of this analysis were interpreted and normalized to the 1-hour rainfall depth to create the distribution shown in Table 6-3 with a 5 minute time interval for drainage basins up to 1 square mile in size. This distribution represents the rainfall

Table 6-6. Runoff Coefficients for Rational Method
(Source: UDFCD 2001)

Land Use or Surface Characteristics	Percent Impervious	Runoff Coefficients											
		2-year		5-year		10-year		25-year		50-year		100-year	
		HSG A&B	HSG C&D	HSG A&B	HSG C&D	HSG A&B	HSG C&D	HSG A&B	HSG C&D	HSG A&B	HSG C&D	HSG A&B	HSG C&D
Business													
Commercial Areas	95	0.79	0.80	0.81	0.82	0.83	0.84	0.85	0.87	0.87	0.88	0.88	0.89
Neighborhood Areas	70	0.45	0.49	0.49	0.53	0.53	0.57	0.58	0.62	0.60	0.65	0.62	0.68
Residential													
1/8 Acre or less	65	0.41	0.45	0.45	0.49	0.49	0.54	0.54	0.59	0.57	0.62	0.59	0.65
1/4 Acre	40	0.23	0.28	0.30	0.35	0.36	0.42	0.42	0.50	0.46	0.54	0.50	0.58
1/3 Acre	30	0.18	0.22	0.25	0.30	0.32	0.38	0.39	0.47	0.43	0.52	0.47	0.57
1/2 Acre	25	0.15	0.20	0.22	0.28	0.30	0.36	0.37	0.46	0.41	0.51	0.46	0.56
1 Acre	20	0.12	0.17	0.20	0.26	0.27	0.34	0.35	0.44	0.40	0.50	0.44	0.55
Industrial													
Light Areas	80	0.57	0.60	0.59	0.63	0.63	0.66	0.66	0.70	0.68	0.72	0.70	0.74
Heavy Areas	90	0.71	0.73	0.73	0.75	0.75	0.77	0.78	0.80	0.80	0.82	0.81	0.83
Parks and Cemeteries													
Parks and Cemeteries	7	0.05	0.09	0.12	0.19	0.20	0.29	0.30	0.40	0.34	0.46	0.39	0.52
Playgrounds	13	0.07	0.13	0.16	0.23	0.24	0.31	0.32	0.42	0.37	0.48	0.41	0.54
Railroad Yard Areas	40	0.23	0.28	0.30	0.35	0.36	0.42	0.42	0.50	0.46	0.54	0.50	0.58
Undeveloped Areas													
Historic Flow Analysis-- Greenbelts, Agriculture	2	0.03	0.05	0.09	0.16	0.17	0.26	0.26	0.38	0.31	0.45	0.36	0.51
Pasture/Meadow	0	0.02	0.04	0.08	0.15	0.15	0.25	0.25	0.37	0.30	0.44	0.35	0.50
Forest	0	0.02	0.04	0.08	0.15	0.15	0.25	0.25	0.37	0.30	0.44	0.35	0.50
Exposed Rock	100	0.89	0.89	0.90	0.90	0.92	0.92	0.94	0.94	0.95	0.95	0.96	0.96
Offsite Flow Analysis (when landuse is undefined)	45	0.26	0.31	0.32	0.37	0.38	0.44	0.44	0.51	0.48	0.55	0.51	0.59
Streets													
Paved	100	0.89	0.89	0.90	0.90	0.92	0.92	0.94	0.94	0.95	0.95	0.96	0.96
Gravel	80	0.57	0.60	0.59	0.63	0.63	0.66	0.66	0.70	0.68	0.72	0.70	0.74
Drive and Walks													
Drive and Walks	100	0.89	0.89	0.90	0.90	0.92	0.92	0.94	0.94	0.95	0.95	0.96	0.96
Roofs													
Roofs	90	0.71	0.73	0.73	0.75	0.75	0.77	0.78	0.80	0.80	0.82	0.81	0.83
Lawns													
Lawns	0	0.02	0.04	0.08	0.15	0.15	0.25	0.25	0.37	0.30	0.44	0.35	0.50

3.2 Time of Concentration

One of the basic assumptions underlying the Rational Method is that runoff is a function of the average rainfall rate during the time required for water to flow from the hydraulically most remote part of the drainage area under consideration to the design point. However, in practice, the time of concentration can be an empirical value that results in reasonable and acceptable peak flow calculations.

For urban areas, the time of concentration (t_c) consists of an initial time or overland flow time (t_i) plus the travel time (t_t) in the storm sewer, paved gutter, roadside drainage ditch, or drainage channel. For non-urban areas, the time of concentration consists of an overland flow time (t_i) plus the time of travel in a concentrated form, such as a swale or drainageway. The travel portion (t_t) of the time of concentration can be estimated from the hydraulic properties of the storm sewer, gutter, swale, ditch, or drainageway. Initial time, on the other hand, will vary with surface slope, depression storage, surface cover, antecedent rainfall, and infiltration capacity of the soil, as well as distance of surface flow. The time of concentration is represented by Equation 6-7 for both urban and non-urban areas.

Table 6-7. Conveyance Coefficient, C_v

Type of Land Surface	C_v
Heavy meadow	2.5
Tillage/field	5
Riprap (not buried)*	6.5
Short pasture and lawns	7
Nearly bare ground	10
Grassed waterway	15
Paved areas and shallow paved swales	20

* For buried riprap, select C_v value based on type of vegetative cover.

The travel time is calculated by dividing the flow distance (in feet) by the velocity calculated using Equation 6-9 and converting units to minutes.

The time of concentration (t_c) is then the sum of the overland flow time (t_o) and the travel time (t_t) per Equation 6-7.

3.2.3 First Design Point Time of Concentration in Urban Catchments

Using this procedure, the time of concentration at the first design point (typically the first inlet in the system) in an urbanized catchment should not exceed the time of concentration calculated using Equation 6-10. The first design point is defined as the point where runoff first enters the storm sewer system.

$$t_c = \frac{L}{180} + 10 \quad (\text{Eq. 6-10})$$

Where:

t_c = maximum time of concentration at the first design point in an urban watershed (min)

L = waterway length (ft)

Equation 6-10 was developed using the rainfall-runoff data collected in the Denver region and, in essence, represents regional “calibration” of the Rational Method. Normally, Equation 6-10 will result in a lesser time of concentration at the first design point and will govern in an urbanized watershed. For subsequent design points, the time of concentration is calculated by accumulating the travel times in downstream drainageway reaches.


3.2.4 Minimum Time of Concentration

If the calculations result in a t_c of less than 10 minutes for undeveloped conditions, it is recommended that a minimum value of 10 minutes be used. The minimum t_c for urbanized areas is 5 minutes.

3.2.5 Post-Development Time of Concentration

As Equation 6-8 indicates, the time of concentration is a function of the 5-year runoff coefficient for a drainage basin. Typically, higher levels of imperviousness (higher 5-year runoff coefficients) correspond to shorter times of concentration, and lower levels of imperviousness correspond to longer times of

Figure 6-5. Colorado Springs Rainfall Intensity Duration Frequency

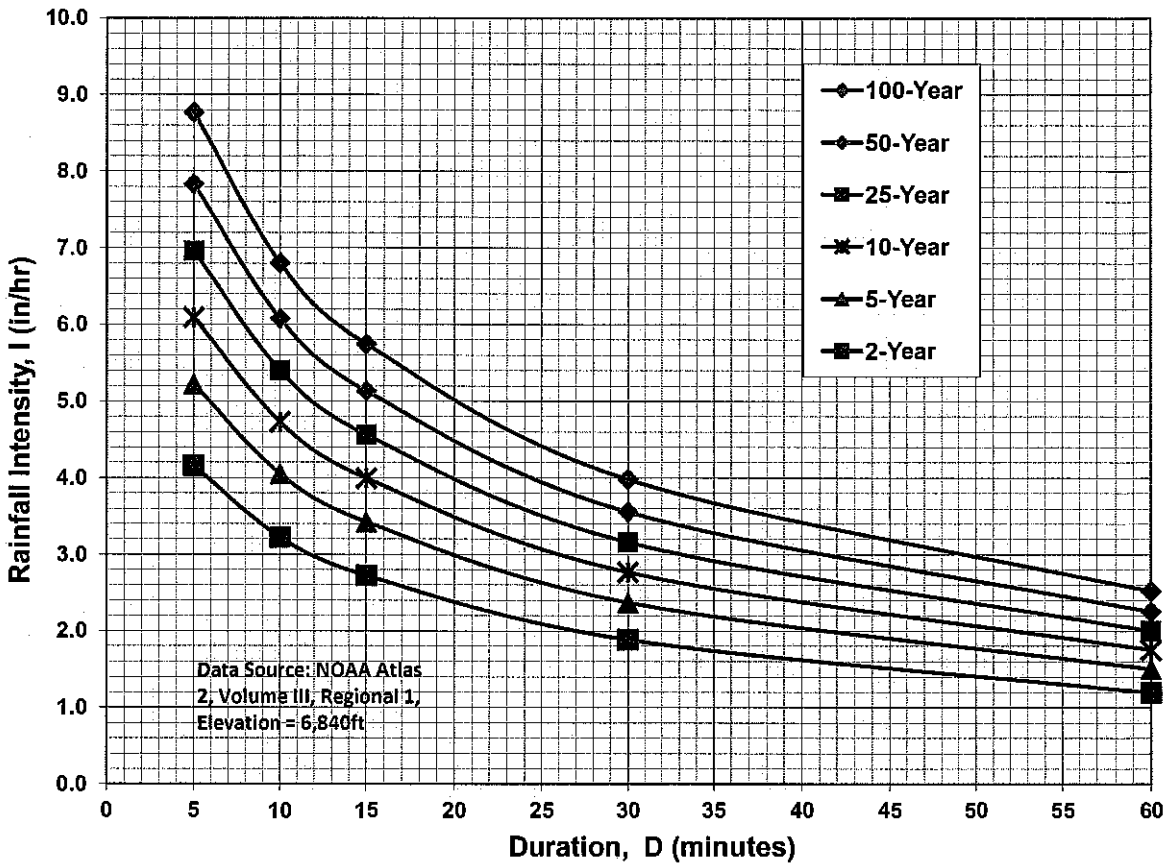

IDF Equations

$I_{100} = -2.52 \ln(D) + 12.735$

$I_{50} = -2.25 \ln(D) + 11.375$

$I_{25} = -2.00 \ln(D) + 10.111$

$I_{10} = -1.75 \ln(D) + 8.847$

$I_5 = -1.50 \ln(D) + 7.583$

$I_2 = -1.19 \ln(D) + 6.035$

Note: Values calculated by equations may not precisely duplicate values read from figure.

JOB NAME: MONUMENT JUNCTION DEVELOPMENT (HWY. 105 & JCP INT. IMPS.)
 JOB NUMBER: 1302.22
 DATE: 02/24/23
 CALCULATED BY: MAW

FINAL DRAINAGE REPORT ~ BASIN RUNOFF COEFFICIENT SUMMARY

BASIN	TOTAL AREA (AC)	DEVELOPED AREA/IMPERVIOUS AREA				LANDSCAPE/UNDEVELOPED AREAS				WEIGHTED			WEIGHTED CA			IMPERVIOUSNESS
		AREA (AC)	C(2)	C(5)	C(100)	AREA (AC)	C(2)	C(5)	C(100)	C(2)	C(5)	C(100)	CA(2)	CA(5)	CA(100)	%
G	0.20	0.05	0.79	0.81	0.88	0.15	0.03	0.09	0.36	0.22	0.27	0.49	0.04	0.05	0.10	25%
H	0.57	0.05	0.79	0.81	0.88	0.52	0.03	0.09	0.36	0.10	0.15	0.41	0.06	0.09	0.23	10%
OS-10	4.10	0.60	0.89	0.90	0.96	3.50	0.03	0.09	0.36	0.16	0.21	0.45	0.64	0.86	1.84	16%
OS10D	2.00	0.10	0.89	0.90	0.96	1.90	0.03	0.09	0.36	0.07	0.13	0.39	0.15	0.26	0.78	7%
OS-11	1.70	0.80	0.89	0.90	0.96	0.90	0.02	0.08	0.35	0.43	0.47	0.64	0.73	0.79	1.08	45%
OS11D	1.70	1.20	0.89	0.90	0.96	0.50	0.03	0.09	0.36	0.64	0.66	0.78	1.08	1.13	1.33	71%
OS-12	0.51	0.27	0.89	0.90	0.96	0.24	0.03	0.09	0.36	0.49	0.52	0.68	0.25	0.26	0.35	54%
OS12D	0.58	0.31	0.89	0.90	0.96	0.27	0.03	0.09	0.36	0.49	0.52	0.68	0.28	0.30	0.39	54%
OS-13	0.67	0.40	0.89	0.90	0.96	0.27	0.03	0.09	0.36	0.54	0.57	0.72	0.36	0.38	0.48	61%
OS13D	0.67	0.40	0.89	0.90	0.96	0.27	0.03	0.09	0.36	0.54	0.57	0.72	0.36	0.38	0.48	61%
OS-14	0.28	0.15	0.89	0.90	0.96	0.13	0.03	0.09	0.36	0.49	0.52	0.68	0.14	0.15	0.19	55%
OS14D	0.86	0.72	0.89	0.90	0.96	0.14	0.03	0.09	0.36	0.75	0.77	0.86	0.65	0.66	0.74	84%
OS-15	1.60	1.20	0.89	0.90	0.96	0.40	0.03	0.09	0.36	0.68	0.70	0.81	1.08	1.12	1.30	76%
OS15D	1.60	1.20	0.89	0.90	0.96	0.40	0.03	0.09	0.36	0.68	0.70	0.81	1.08	1.12	1.30	76%
OS-16	1.00	0.70	0.89	0.90	0.96	0.30	0.02	0.08	0.35	0.63	0.65	0.78	0.63	0.65	0.78	67%
OS-17	0.53	0.43	0.89	0.90	0.96	0.10	0.03	0.09	0.36	0.73	0.75	0.85	0.39	0.40	0.45	82%
OS17D	1.00	0.60	0.89	0.90	0.96	0.40	0.03	0.09	0.36	0.55	0.58	0.72	0.55	0.58	0.72	61%
OS-18	0.30	0.30	0.89	0.90	0.96	0.00	0.03	0.09	0.36	0.89	0.90	0.96	0.27	0.27	0.29	100%
OS18D	0.78	0.43	0.89	0.90	0.96	0.35	0.03	0.09	0.36	0.50	0.54	0.69	0.39	0.42	0.54	56%
OS-19	0.18	0.00	0.89	0.90	0.96	0.18	0.03	0.09	0.36	0.03	0.09	0.36	0.01	0.02	0.06	2%
OS-20	0.11	0.01	0.89	0.90	0.96	0.10	0.03	0.09	0.36	0.11	0.16	0.41	0.01	0.02	0.05	10%
JCP7	0.59	0.50	0.89	0.90	0.96	0.09	0.03	0.09	0.36	0.76	0.78	0.87	0.45	0.46	0.51	85%
EX2	0.56	0.56	0.03	0.09	0.36	0.00	0.03	0.09	0.36	0.03	0.09	0.36	0.02	0.05	0.20	2%
EX3	1.80	1.80	0.03	0.09	0.36	0.00	0.03	0.09	0.36	0.03	0.09	0.36	0.05	0.16	0.65	2%
Exist. Trib. to Pond	13.05															37.5%
Dev. Trib. to Pond	11.84															53.6%
Dev. Trib. to Forebay	8.49															67.2%

JOB NAME: MONUMENT JUNCTION DEVELOPMENT (HWY. 105 & JCP INT. IMPS.)
 JOB NUMBER: 1302.22
 DATE: 02/24/23
 CALC'D BY: MAW

Table 6-7. Conveyance Coefficient, C_v

Type of Land Surface	C_v
Heavy meadow	2.5
Tillage/field	5
Riprap (not buried)* $t_c = \frac{L}{180} + 10$	6.5
Short pasture and lawns	7
Nearly bare ground	10
Grassed waterway	15
Paved areas and shallow paved swales	20

*For buried riprap, select C_v value based on type of vegetative cover.

Return Period	1-Hour Depth
2	1.19
5	1.50
10	1.75
25	2.00
50	2.25
100	2.52

$$t_i = \frac{0.395(1.1 - C_s)\sqrt{L}}{S^{0.33}}$$

$$V = C_v S_w^{0.5} \quad T_c = L/V$$

FINAL DRAINAGE REPORT ~ BASIN RUNOFF SUMMARY

BASIN	WEIGHTED			OVERLAND				STREET / CHANNEL FLOW				Tc TOTAL (min)	INTENSITY			TOTAL FLOWS		
	CA(2)	CA(5)	CA(100)	C(5)	Length (ft)	Height (ft)	Tc (min)	Length (ft)	Slope (%)	Velocity (fps)	Tc (min)		I(2) (in/hr)	I(5) (in/hr)	I(100) (in/hr)	Q(2) (cfs)	Q(5) (cfs)	Q(100) (cfs)
G	0.04	0.05	0.10	0.09	30	1.5	5.9					5.9	3.93	4.93	8.27	0.17	0.3	0.8
H	0.06	0.09	0.23	0.09	40	2	6.8					6.8	3.76	4.71	7.91	0.2	0.4	1.8
OS-10	0.64	0.86	1.84	0.09	65	2	10.1	950	3.5%	1.9	8.5	18.6	2.56	3.20	5.37	2	3	10
OS10D	0.15	0.26	0.78	0.09	65	2	10.1	950	3.5%	1.9	8.5	18.6	2.56	3.20	5.37	0.4	0.8	4
OS-11	0.73	0.79	1.08	0.08	100	2	14.7	500	4.0%	2.0	4.2	18.8	2.54	3.18	5.34	1.9	3	6
OS11D	1.08	1.13	1.33	0.09	100	2	14.5	300	4.0%	2.0	2.5	17.0	2.66	3.33	5.59	3	4	7
OS-12	0.25	0.26	0.35	0.09	40	2	6.8	200	3.5%	3.7	0.9	7.7	3.61	4.53	7.60	0.9	1.2	3
OS12D	0.28	0.30	0.39	0.09	40	2	6.8	200	3.5%	3.7	0.9	7.7	3.61	4.53	7.60	1.0	1.4	3.0
OS-13	0.36	0.38	0.48	0.09	25	3	4.0	240	5.5%	4.7	0.9	5.0	4.12	5.17	8.68	1.5	2	4
OS13D	0.36	0.38	0.48	0.09	25	3	4.0	250	3.5%	3.7	1.1	5.1	4.09	5.13	8.61	1.5	2	4
OS-14	0.14	0.15	0.19	0.09	30	10	3.1	170	5.5%	4.7	0.6	5.0	4.12	5.17	8.68	0.6	0.8	2
OS14D	0.65	0.66	0.74	0.09	30	10	3.1	190	5.5%	4.7	0.7	5.0	4.12	5.17	8.68	3	3	6
OS-15	1.08	1.12	1.30	0.09	180	12	13.1	100	3.0%	1.7	1.0	14.0	2.89	3.62	6.08	3	4	8
OS15D	1.08	1.12	1.30	0.09	180	12	13.1	80	3.0%	3.5	0.4	13.5	2.94	3.68	6.18	3	4	8
OS-16	0.63	0.65	0.78	0.08	100	4	11.7	130	1.5%	1.2	1.8	13.4	2.94	3.69	6.19	1.9	2	5

JOB NAME: MONUMENT JUNCTION DEVELOPMENT (HWY. 105 & JCP INT. IMPS.)
 JOB NUMBER: 1302.22
 DATE: 02/24/23
 CALC'D BY: MAW

Table 6-7. Conveyance Coefficient, C_v

Type of Land Surface	C_v
Heavy meadow	2.5
Tillage/field	5
Riprap (not buried)* $t_c = \frac{L}{180} + 10$	6.5
Short pasture and lawns	7
Nearly bare ground	10
Grassed waterway	15
Paved areas and shallow paved swales	20

*For buried riprap, select C_v value based on type of vegetative cover.

Return Period	1-Hour Depth
2	1.19
5	1.50
10	1.75
25	2.00
50	2.25
100	2.52

$$t_i = \frac{0.395(1.1 - C_s)\sqrt{L}}{S^{0.33}}$$

$$V = C_v S_w^{0.5} \quad Tc = LV$$

FINAL DRAINAGE REPORT ~ BASIN RUNOFF SUMMARY

BASIN	WEIGHTED			OVERLAND			STREET / CHANNEL FLOW				Tc TOTAL (min)	INTENSITY			TOTAL FLOWS			
	CA(2)	CA(5)	CA(100)	C(5)	Length (ft)	Height (ft)	Tc (min)	Length (ft)	Slope (%)	Velocity (fps)		Tc (min)	I(2) (in/hr)	I(5) (in/hr)	I(100) (in/hr)	Q(2) (cfs)	Q(5) (cfs)	Q(100) (cfs)
OS-17	0.39	0.40	0.45	0.09	60	14	5.0	380	5.0%	4.5	1.4	6.4	3.82	4.80	8.05	1.5	2	4
OS17D	0.55	0.58	0.72	0.09	60	14	5.0	380	5.0%	4.5	1.4	6.4	3.82	4.80	8.05	2	3	6
OS-18	0.27	0.27	0.29	0.09	15	0.5	4.7	280	2.0%	2.8	1.6	6.4	3.83	4.80	8.06	1.0	1.3	2
OS18D	0.39	0.42	0.54	0.09	90	4	10.6	260	2.0%	2.8	1.5	12.1	3.07	3.84	6.45	1.2	1.6	3
OS-19	0.01	0.02	0.06	0.09	80	3.2	10.3	380	5.0%	4.5	1.4	11.7	3.10	3.89	6.53	0.02	0.1	0.4
OS-20	0.01	0.02	0.05	0.09	50	3	7.1					7.1	3.70	4.63	7.78	0.0	0.1	0.4
JCP7	0.45	0.46	0.51	0.09	20	0.6	5.7	300	4.5%	4.2	1.2	6.9	3.74	4.70	7.88	2	2	4
EX2	0.02	0.05	0.20	0.09	50	2	8.2					8.2	3.54	4.43	7.44	0.1	0.2	1.5
EX3	0.05	0.16	0.65	0.09	260	5	23.7					23.7	2.27	2.84	4.76	0.1	0.5	3

JOB NAME: MONUMENT JUNCTION DEVELOPMENT (HWY. 105 & JCP INT. IMPS.)
 JOB NUMBER: 1302.22
 DATE: 07/20/23
 CALCULATED BY: MAW

FINAL DRAINAGE REPORT ~ SURFACE ROUTING SUMMARY

Design Point(s)	Contributing Basins	Equivalent CA(5)	Equivalent CA(100)	Maximum Tc	Intensity		Flow		Inlet Size
					I(5)	I(100)	Q(5)	Q(100)	
H1	OS-1 thru OS-8	6.48	15.46	33.4	2.32	3.89	15	60	EXIST. 60" RCP CULVERT
H2	DP H1, OS-9, EX-1	9.17	25.43	39.4	2.07	3.48	19	88	EXIST. CDOT OUTFALL
H3	EX4	1.49	5.98	35.7	2.22	3.73	3	22	EXIST. SIDE ROAD DITCH
H4	OS-12	0.26	0.46	7.7	4.53	7.60	1	3	EXIST. 5' TYPE R AT-GRADE INLET
H5	OS-13, Flow-by from H4	0.38	0.63	5.0	5.17	8.68	2	5	EXIST. 10' TYPE R AT-GRADE INLET
H6	OS-14, Flow-by from H5	0.15	0.24	5.0	5.17	8.68	1	2	EXIST. 10' TYPE R AT-GRADE INLET
H7	OS-11 and OS-16	1.45	1.86	18.8	3.18	5.34	5	10	EXIST. 10' TYPE R AT-GRADE INLET
H8	OS-17, Flow-by from H7	0.42	0.73	6.4	4.80	8.05	2	6	EXIST. 10' TYPE R AT-GRADE INLET
H9	OS-18, Flow-by from H8	0.27	0.41	6.4	4.80	8.06	1	3	EXIST. 10' TYPE R AT-GRADE INLET
H10	EX2, EX3, OS-10 thru OS-18	5.09	7.60	23.7	2.84	4.76	14	36	EXIST. 36" RCP CDOT CULVERT

JOB NAME: MONUMENT JUNCTION DEVELOPMENT (HWY. 105 & JCP INT. IMPS.)
 JOB NUMBER: 1302.22
 DATE: 07/20/23
 CALCULATED BY: MAW

FINAL DRAINAGE REPORT ~ SURFACE ROUTING SUMMARY

Design Point(s)	Contributing Basins	Equivalent CA(5)	Equivalent CA(100)	Maximum Tc	Intensity		Flow		Inlet Size
					I(5)	I(100)	Q(5)	Q(100)	
D4	OS12D, 0.85 CFS 100Yr Flow-by from upstream	0.30	0.51	7.7	4.53	7.60	1.4	3.9	PROP. 5' TYPE R AT-GRADE INLET
D5	OS13D, Flow-by from D4	0.38	0.63	5.0	5.17	8.68	2	5	PROP. 10' TYPE R AT-GRADE INLET
D6	OS15D	1.12	1.30	13.5	3.68	6.18	4	8	PROP. CDOT TYPE C INLET
D7	OS11D, OS-16, OS-19, OS-20	1.81	2.22	17.0	3.33	5.59	6	12	PROP. 10' TYPE R AT-GRADE INLET
D8	OS14D, Flow-by from D5&D7	0.84	1.47	17.0	3.33	5.59	3	8	PROP. 10' TYPE R SUMP INLET
D9	JCP7, G	0.51	0.61	6.9	4.70	7.88	2	5	PROP. 10' TYPE R AT-GRADE INLET
D10	OS17D, Flow-by from D9	0.58	0.74	6.4	4.80	8.05	3	6	PROP. 10' TYPE R AT-GRADE INLET
D11	OS18D, Flow-by from D10	0.42	0.64	12.1	3.84	6.45	2	4	EXIST. 10' TYPE R SUMP INLET
13	G, H, JCP7, OS10D thru OS15D, OS-16, OS17D, OS18D, OS-19, OS-20	5.87	8.01	21.1	3.01	5.05	18	40	SWQ FACILITY in CDOT ROW

JOB NAME: MONUMENT JUNCTION DEVELOPMENT (HWY. 105 & JCP INT. IMPS.)
 JOB NUMBER: 1302.22
 DATE: 07/20/23
 CALCULATED BY: MAW

* PIPES ARE LISTED AT MAXIMUM SIZE REQUIRED TO ACCOMMODATE Q100 FLOWS AT MINIMUM GRADE.
 REFER TO INDIVIDUAL PIPE SHEETS FOR HYDRAULIC INFORMATION.

FINAL DRAINAGE REPORT ~ PIPE ROUTING SUMMARY

Pipe Run	Contributing Basins	Equivalent CA(5)	Equivalent CA(100)	Maximum Tc	Intensity		Flow		Pipe Size*
					I(5)	I(100)	Q(5)	Q(100)	
H1	Inlet Capture at DP-H4	0.26	0.24	7.7	4.53	7.60	1	2	Exist. 15" RCP
H2	PR-H1, Inlet Capture at DP-H5	0.65	0.77	7.8	4.51	7.57	3	6	Exist. 15" RCP
H3	PR-H2, Inlet Capture at DP-H6	0.80	1.01	7.9	4.49	7.54	4	8	Exist. 24" RCP
H4	OS-15	1.12	1.30	14.0	3.62	6.08	4	8	Exist. 18" ADS
H5	PR-H3, PR-H4, Portion of OS-11 and OS-16	3.20	3.95	18.8	3.18	5.34	10	21	Exist. 30" RCP
H6	Inlet Capture at DP-H8	0.42	0.64	6.4	4.80	8.05	2	5	Exist. 24" RCP
H7	Inlet Capture at DP-H9	0.27	0.41	6.4	4.80	8.06	1	3	Exist. 24" RCP

JOB NAME: MONUMENT JUNCTION DEVELOPMENT (HWY. 105 & JCP INT. IMPS.)
 JOB NUMBER: 1302.22
 DATE: 07/20/23
 CALCULATED BY: MAW

* PIPES ARE LISTED AT MAXIMUM SIZE REQUIRED TO ACCOMMODATE Q100 FLOWS AT MINIMUM GRADE.
 REFER TO INDIVIDUAL PIPE SHEETS FOR HYDRAULIC INFORMATION.


FINAL DRAINAGE REPORT ~ PIPE ROUTING SUMMARY

Pipe Run	Contributing Basins	Equivalent CA(5)	Equivalent CA(100)	Maximum Tc	Intensity		Flow		Pipe Size*
					I(5)	I(100)	Q(5)	Q(100)	
1	Inlet Capture at D4	0.30	0.33	7.7	4.53	7.60	1.4	2.5	PROP. 18" RCP
2	PR-1, Inlet Capture at D5	0.69	0.92	7.7	4.53	7.60	3	7	PROP. 24" RCP
3	CDOT Type C Inlet Capture at D6	1.12	1.30	13.5	3.68	6.18	4	8	PROP. 18" RCP
4	PR-2, PR-3	1.80	2.22	13.7	3.66	6.15	7	14	PROP. 24" RCP
5	Inlet Capture at D7	1.63	1.51	17.0	3.33	5.59	5	8	PROP. 18" RCP
6	PR-5, Inlet Capture at D8	2.47	2.98	17.0	3.33	5.59	8	17	PROP. 24" RCP
7	PR-6, Inlet Capture at D9	2.98	3.56	17.0	3.33	5.59	10	20	PROP. 24" RCP
8	PR-4, PR-7	4.79	5.77	17.2	3.32	5.56	16	32	PROP. 30" RCP
9	Inlet Capture at D10	0.58	0.66	6.4	4.80	8.05	3	5	PROP. 18" RCP
10	PR-8, PR9	5.36	6.43	17.4	3.30	5.54	18	36	PROP. 30" RCP
11	Inlet Capture at D11	0.42	0.64	12.1	3.84	6.45	2	4	EXIST. 18" RCP

ALLOWABLE CAPACITY FOR ONE-HALF OF STREET (Minor & Major Storm)

(Based on Regulated Criteria for Maximum Allowable Flow Depth and Spread)

Project: **MONUMENT JUNCTION - HWY. 105/JCP INT. IMPS.**
 Inlet ID: **H4**

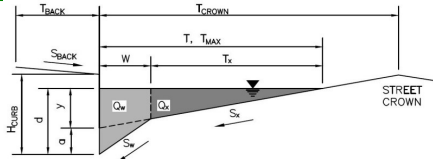


Gutter Geometry (Enter data in the blue cells)							
Maximum Allowable Width for Spread Behind Curb	$T_{BACK} = 7.0$ ft						
Side Slope Behind Curb (leave blank for no conveyance credit behind curb)	$S_{BACK} = 0.020$ ft/ft						
Manning's Roughness Behind Curb (typically between 0.012 and 0.020)	$n_{BACK} = 0.016$						
Height of Curb at Gutter Flow Line	$H_{CURB} = 6.00$ inches						
Distance from Curb Face to Street Crown	$T_{CROWN} = 35.0$ ft						
Gutter Width	$W = 2.00$ ft						
Street Transverse Slope	$S_x = 0.020$ ft/ft						
Gutter Cross Slope (typically 2 inches over 24 inches or 0.083 ft/ft)	$S_W = 0.083$ ft/ft						
Street Longitudinal Slope - Enter 0 for sump condition	$S_D = 0.035$ ft/ft						
Manning's Roughness for Street Section (typically between 0.012 and 0.020)	$n_{STREET} = 0.016$						
Max. Allowable Spread for Minor & Major Storm	<table border="1"> <tr> <th>Minor Storm</th> <th>Major Storm</th> <th>ft</th> </tr> <tr> <td>$T_{MAX} = 14.0$</td> <td>$T_{MAX} = 25.0$</td> <td></td> </tr> </table>	Minor Storm	Major Storm	ft	$T_{MAX} = 14.0$	$T_{MAX} = 25.0$	
Minor Storm	Major Storm	ft					
$T_{MAX} = 14.0$	$T_{MAX} = 25.0$						
Max. Allowable Depth at Gutter Flowline for Minor & Major Storm	<table border="1"> <tr> <th>Minor Storm</th> <th>Major Storm</th> <th>inches</th> </tr> <tr> <td>$d_{MAX} = 3.4$</td> <td>$d_{MAX} = 6.0$</td> <td></td> </tr> </table>	Minor Storm	Major Storm	inches	$d_{MAX} = 3.4$	$d_{MAX} = 6.0$	
Minor Storm	Major Storm	inches					
$d_{MAX} = 3.4$	$d_{MAX} = 6.0$						
Allow Flow Depth at Street Crown (leave blank for no)	<input type="checkbox"/> <input type="checkbox"/> check = yes						
MINOR STORM Allowable Capacity is based on Depth Criterion							
MAJOR STORM Allowable Capacity is based on Depth Criterion							
Minor storm max. allowable capacity GOOD - greater than the design flow given on sheet 'Inlet Management'							
Major storm max. allowable capacity GOOD - greater than the design flow given on sheet 'Inlet Management'							
	<table border="1"> <tr> <th>Minor Storm</th> <th>Major Storm</th> <th>cfs</th> </tr> <tr> <td>$Q_{allow} = 3.6$</td> <td>$Q_{allow} = 13.7$</td> <td></td> </tr> </table>	Minor Storm	Major Storm	cfs	$Q_{allow} = 3.6$	$Q_{allow} = 13.7$	
Minor Storm	Major Storm	cfs					
$Q_{allow} = 3.6$	$Q_{allow} = 13.7$						

Unresolved:
 Include calculation for drainage swale along top of retaining wall to show that it is sized to handle the flow.

INLET ON A CONTINUOUS GRADE

Version 4.06 Released August 2018

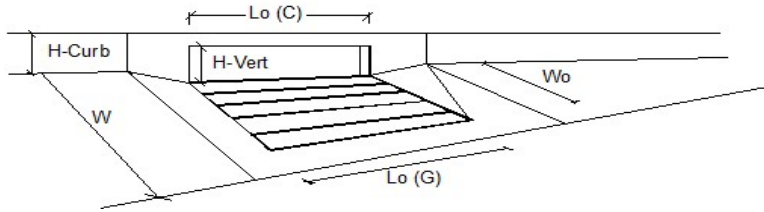


Design Information (Input)	MINOR	MAJOR	
Type of Inlet	CDOT Type R Curb Opening		
Local Depression (additional to continuous gutter depression 'a')	3.0	3.0	inches
Total Number of Units in the Inlet (Grate or Curb Opening)	1	1	
Length of a Single Unit Inlet (Grate or Curb Opening)	5.00	5.00	ft
Width of a Unit Grate (cannot be greater than W, Gutter Width)	N/A	N/A	ft
Clogging Factor for a Single Unit Grate (typical min. value = 0.5)	N/A	N/A	
Clogging Factor for a Single Unit Curb Opening (typical min. value = 0.1)	0.10	0.10	
Street Hydraulics: OK - Q < Allowable Street Capacity*			
Total Inlet Interception Capacity	1.0	2.5	cfs
Total Inlet Carry-Over Flow (flow bypassing inlet)	0.0	1.3	cfs
Capture Percentage = Q_p/Q_o =	100	66	%

ALLOWABLE CAPACITY FOR ONE-HALF OF STREET (Minor & Major Storm)

(Based on Regulated Criteria for Maximum Allowable Flow Depth and Spread)


Project: **MONUMENT JUNCTION - HWY. 105/JCP INT. IMPS.**
 Inlet ID: **H5**

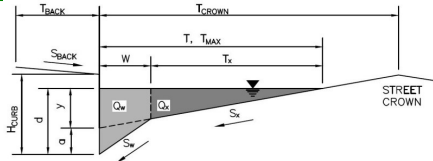

Gutter Geometry (Enter data in the blue cells)									
Maximum Allowable Width for Spread Behind Curb	$T_{BACK} = 4.0$ ft								
Side Slope Behind Curb (leave blank for no conveyance credit behind curb)	$S_{BACK} = 0.250$ ft/ft								
Manning's Roughness Behind Curb (typically between 0.012 and 0.020)	$n_{BACK} = 0.020$								
Height of Curb at Gutter Flow Line	$H_{CURB} = 6.00$ inches								
Distance from Curb Face to Street Crown	$T_{CROWN} = 30.0$ ft								
Gutter Width	$W = 2.00$ ft								
Street Transverse Slope	$S_x = 0.020$ ft/ft								
Gutter Cross Slope (typically 2 inches over 24 inches or 0.083 ft/ft)	$S_w = 0.083$ ft/ft								
Street Longitudinal Slope - Enter 0 for sump condition	$S_o = 0.056$ ft/ft								
Manning's Roughness for Street Section (typically between 0.012 and 0.020)	$n_{STREET} = 0.016$								
Max. Allowable Spread for Minor & Major Storm	<table style="width: 100%; border: none;"> <tr> <td style="width: 50%;"></td> <td style="width: 25%; text-align: center;">Minor Storm</td> <td style="width: 25%; text-align: center;">Major Storm</td> <td style="width: 10%;"></td> </tr> <tr> <td>$T_{MAX} =$</td> <td style="border: 1px solid black; text-align: center;">14.0</td> <td style="border: 1px solid black; text-align: center;">25.0</td> <td style="border: none;">ft</td> </tr> </table>		Minor Storm	Major Storm		$T_{MAX} =$	14.0	25.0	ft
	Minor Storm	Major Storm							
$T_{MAX} =$	14.0	25.0	ft						
Max. Allowable Depth at Gutter Flowline for Minor & Major Storm	<table style="width: 100%; border: none;"> <tr> <td style="width: 50%;"></td> <td style="width: 25%; text-align: center;">Minor Storm</td> <td style="width: 25%; text-align: center;">Major Storm</td> <td style="width: 10%;"></td> </tr> <tr> <td>$d_{MAX} =$</td> <td style="border: 1px solid black; text-align: center;">3.4</td> <td style="border: 1px solid black; text-align: center;">6.0</td> <td style="border: none;">inches</td> </tr> </table>		Minor Storm	Major Storm		$d_{MAX} =$	3.4	6.0	inches
	Minor Storm	Major Storm							
$d_{MAX} =$	3.4	6.0	inches						
Allow Flow Depth at Street Crown (leave blank for no)	<input type="checkbox"/> <input type="checkbox"/> check = yes								
MINOR STORM Allowable Capacity is based on Depth Criterion									
MAJOR STORM Allowable Capacity is based on Depth Criterion									
Minor storm max. allowable capacity GOOD - greater than the design flow given on sheet 'Inlet Management'									
Major storm max. allowable capacity GOOD - greater than the design flow given on sheet 'Inlet Management'									
$Q_{allow} =$	<table style="width: 100%; border: none;"> <tr> <td style="width: 50%;"></td> <td style="width: 25%; text-align: center;">Minor Storm</td> <td style="width: 25%; text-align: center;">Major Storm</td> <td style="width: 10%;"></td> </tr> <tr> <td></td> <td style="border: 1px solid black; text-align: center;">4.5</td> <td style="border: 1px solid black; text-align: center;">11.9</td> <td style="border: none;">cfs</td> </tr> </table>		Minor Storm	Major Storm			4.5	11.9	cfs
	Minor Storm	Major Storm							
	4.5	11.9	cfs						

INLET ON A CONTINUOUS GRADE

Version 4.06 Released August 2018

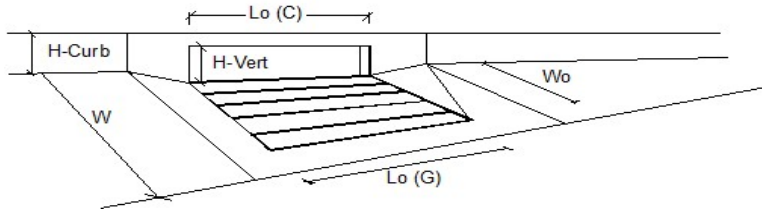


Design Information (Input)	MINOR	MAJOR	
Type of Inlet	CDOT Type R Curb Opening		
Local Depression (additional to continuous gutter depression 'a')	3.0	3.0	inches
Total Number of Units in the Inlet (Grate or Curb Opening)	1	1	
Length of a Single Unit Inlet (Grate or Curb Opening)	10.00	10.00	ft
Width of a Unit Grate (cannot be greater than W, Gutter Width)	N/A	N/A	ft
Clogging Factor for a Single Unit Grate (typical min. value = 0.5)	N/A	N/A	
Clogging Factor for a Single Unit Curb Opening (typical min. value = 0.1)	0.10	0.10	
Street Hydraulics: OK - Q < Allowable Street Capacity*			
Total Inlet Interception Capacity	2.0	4.9	cfs
Total Inlet Carry-Over Flow (flow bypassing inlet)	0.0	0.4	cfs
Capture Percentage = Q_p/Q_o =	100	93	%

ALLOWABLE CAPACITY FOR ONE-HALF OF STREET (Minor & Major Storm)

(Based on Regulated Criteria for Maximum Allowable Flow Depth and Spread)

Project: **MONUMENT JUNCTION - HWY. 105/JCP INT. IMPS.**
 Inlet ID: **H6**

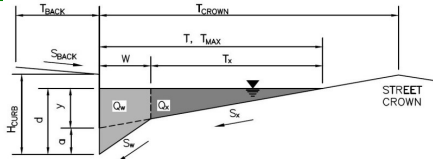

Gutter Geometry (Enter data in the blue cells)

Maximum Allowable Width for Spread Behind Curb
 Side Slope Behind Curb (leave blank for no conveyance credit behind curb)
 Manning's Roughness Behind Curb (typically between 0.012 and 0.020)

$T_{BACK} = 4.0$ ft
 $S_{BACK} = 0.250$ ft/ft
 $n_{BACK} = 0.020$

Height of Curb at Gutter Flow Line
 Distance from Curb Face to Street Crown
 Gutter Width
 Street Transverse Slope
 Gutter Cross Slope (typically 2 inches over 24 inches or 0.083 ft/ft)
 Street Longitudinal Slope - Enter 0 for sump condition
 Manning's Roughness for Street Section (typically between 0.012 and 0.020)

$H_{CURB} = 6.00$ inches
 $T_{CROWN} = 28.0$ ft
 $W = 2.00$ ft
 $S_x = 0.020$ ft/ft
 $S_w = 0.083$ ft/ft
 $S_o = 0.057$ ft/ft
 $n_{STREET} = 0.016$

Max. Allowable Spread for Minor & Major Storm
 Max. Allowable Depth at Gutter Flowline for Minor & Major Storm
 Allow Flow Depth at Street Crown (leave blank for no)

	Minor Storm	Major Storm	
$T_{MAX} =$	14.0	25.0	ft
$d_{MAX} =$	3.4	6.0	inches
	<input type="checkbox"/>	<input type="checkbox"/>	check = yes


MINOR STORM Allowable Capacity is based on Depth Criterion
MAJOR STORM Allowable Capacity is based on Depth Criterion

	Minor Storm	Major Storm	
$Q_{allow} =$	4.5	11.9	cfs

Minor storm max. allowable capacity GOOD - greater than the design flow given on sheet 'Inlet Management'
Major storm max. allowable capacity GOOD - greater than the design flow given on sheet 'Inlet Management'

INLET ON A CONTINUOUS GRADE

Version 4.06 Released August 2018

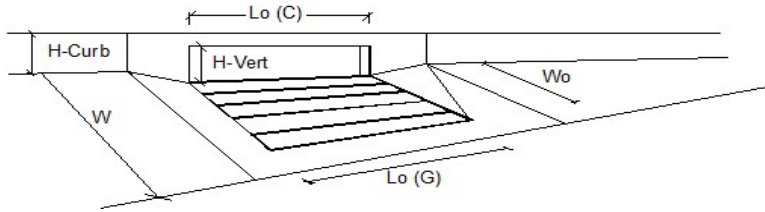

Design Information (Input)	MINOR	MAJOR	
Type of Inlet	CDOT Type R Curb Opening		
Local Depression (additional to continuous gutter depression 'a')	3.0	3.0	inches
Total Number of Units in the Inlet (Grate or Curb Opening)	1	1	
Length of a Single Unit Inlet (Grate or Curb Opening)	10.00	10.00	ft
Width of a Unit Grate (cannot be greater than W, Gutter Width)	N/A	N/A	ft
Clogging Factor for a Single Unit Grate (typical min. value = 0.5)	N/A	N/A	
Clogging Factor for a Single Unit Curb Opening (typical min. value = 0.1)	0.10	0.10	
Street Hydraulics: OK - Q < Allowable Street Capacity*			
Total Inlet Interception Capacity	1.0	2.4	cfs
Total Inlet Carry-Over Flow (flow bypassing inlet)	0.0	0.0	cfs
Capture Percentage = $Q_p/Q_o =$	100	100	%


ALLOWABLE CAPACITY FOR ONE-HALF OF STREET (Minor & Major Storm)

(Based on Regulated Criteria for Maximum Allowable Flow Depth and Spread)

MONUMENT JUNCTION - HWY. 105/JCP INT. IMPS.

Project:
Inlet ID:

H7

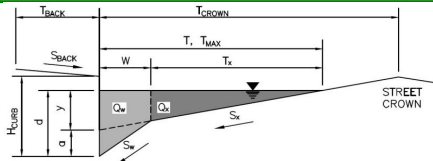

Gutter Geometry (Enter data in the blue cells)

Maximum Allowable Width for Spread Behind Curb
Side Slope Behind Curb (leave blank for no conveyance credit behind curb)
Manning's Roughness Behind Curb (typically between 0.012 and 0.020)

$T_{BACK} = 8.0$ ft
 $S_{BACK} = 0.020$ ft/ft
 $n_{BACK} = 0.020$

Height of Curb at Gutter Flow Line
Distance from Curb Face to Street Crown
Gutter Width
Street Transverse Slope
Gutter Cross Slope (typically 2 inches over 24 inches or 0.083 ft/ft)
Street Longitudinal Slope - Enter 0 for sump condition
Manning's Roughness for Street Section (typically between 0.012 and 0.020)

$H_{CURB} = 6.00$ inches
 $T_{CROWN} = 14.0$ ft
 $W = 2.00$ ft
 $S_x = 0.040$ ft/ft
 $S_w = 0.083$ ft/ft
 $S_o = 0.020$ ft/ft
 $n_{STREET} = 0.016$

Max. Allowable Spread for Minor & Major Storm
Max. Allowable Depth at Gutter Flowline for Minor & Major Storm
Allow Flow Depth at Street Crown (leave blank for no)

	Minor Storm	Major Storm	
$T_{MAX} =$	14.0	14.0	ft
$d_{MAX} =$	5.0	6.0	inches
	<input type="checkbox"/>	<input type="checkbox"/>	check = yes


MINOR STORM Allowable Capacity is based on Depth Criterion
MAJOR STORM Allowable Capacity is based on Depth Criterion

	Minor Storm	Major Storm	
$Q_{allow} =$	7.4	10.7	cfs

Minor storm max. allowable capacity GOOD - greater than the design flow given on sheet 'Inlet Management'
Major storm max. allowable capacity GOOD - greater than the design flow given on sheet 'Inlet Management'

INLET ON A CONTINUOUS GRADE

Version 4.06 Released August 2018

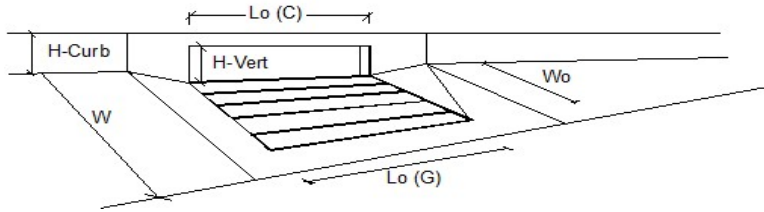


Design Information (Input)	MINOR	MAJOR	
Type of Inlet	CDOT Type R Curb Opening		
Local Depression (additional to continuous gutter depression 'a')	3.0	3.0	inches
Total Number of Units in the Inlet (Grate or Curb Opening)	1	1	
Length of a Single Unit Inlet (Grate or Curb Opening)	10.00	10.00	ft
Width of a Unit Grate (cannot be greater than W, Gutter Width)	N/A	N/A	ft
Clogging Factor for a Single Unit Grate (typical min. value = 0.5)	N/A	N/A	
Clogging Factor for a Single Unit Curb Opening (typical min. value = 0.1)	0.10	0.10	
Street Hydraulics: OK - Q < Allowable Street Capacity*			
Total Inlet Interception Capacity	4.9	7.7	cfs
Total Inlet Carry-Over Flow (flow bypassing inlet)	0.1	2.3	cfs
Capture Percentage = Q_p/Q_o =	97	77	%

ALLOWABLE CAPACITY FOR ONE-HALF OF STREET (Minor & Major Storm)

(Based on Regulated Criteria for Maximum Allowable Flow Depth and Spread)

Project: **MONUMENT JUNCTION - HWY. 105/JCP INT. IMPS.**
 Inlet ID: **H8**

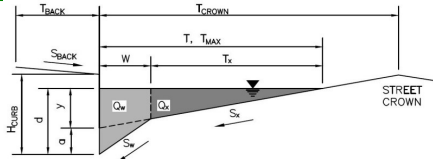

Gutter Geometry (Enter data in the blue cells)

Maximum Allowable Width for Spread Behind Curb
 Side Slope Behind Curb (leave blank for no conveyance credit behind curb)
 Manning's Roughness Behind Curb (typically between 0.012 and 0.020)
 Height of Curb at Gutter Flow Line
 Distance from Curb Face to Street Crown
 Gutter Width
 Street Transverse Slope
 Gutter Cross Slope (typically 2 inches over 24 inches or 0.083 ft/ft)
 Street Longitudinal Slope - Enter 0 for sump condition
 Manning's Roughness for Street Section (typically between 0.012 and 0.020)

$T_{BACK} =$ ft
 $S_{BACK} =$ ft/ft
 $n_{BACK} =$
 $H_{CURB} =$ inches
 $T_{CROWN} =$ ft
 $W =$ ft
 $S_x =$ ft/ft
 $S_w =$ ft/ft
 $S_o =$ ft/ft
 $n_{STREET} =$

Max. Allowable Spread for Minor & Major Storm
 Max. Allowable Depth at Gutter Flowline for Minor & Major Storm
 Allow Flow Depth at Street Crown (leave blank for no)

	Minor Storm	Major Storm	
$T_{MAX} =$	<input type="text" value="14.0"/>	<input type="text" value="25.0"/>	ft
$d_{MAX} =$	<input type="text" value="3.4"/>	<input type="text" value="6.0"/>	inches
	<input type="checkbox"/>	<input type="checkbox"/>	check = yes


MINOR STORM Allowable Capacity is based on Depth Criterion
MAJOR STORM Allowable Capacity is based on Depth Criterion

	Minor Storm	Major Storm	
$Q_{allow} =$	<input type="text" value="2.8"/>	<input type="text" value="15.8"/>	cfs

Minor storm max. allowable capacity GOOD - greater than the design flow given on sheet 'Inlet Management'
Major storm max. allowable capacity GOOD - greater than the design flow given on sheet 'Inlet Management'

INLET ON A CONTINUOUS GRADE

Version 4.06 Released August 2018

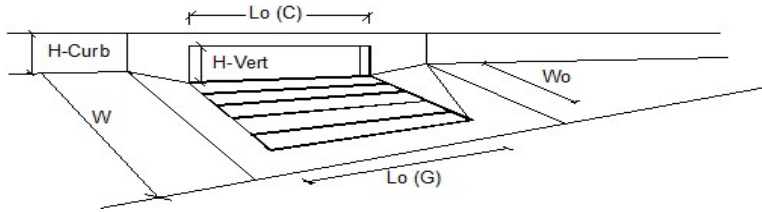

Design Information (Input)	MINOR	MAJOR	
Type of Inlet	CDOT Type R Curb Opening		
Local Depression (additional to continuous gutter depression 'a')	3.0	3.0	inches
Total Number of Units in the Inlet (Grate or Curb Opening)	1	1	
Length of a Single Unit Inlet (Grate or Curb Opening)	10.00	10.00	ft
Width of a Unit Grate (cannot be greater than W, Gutter Width)	N/A	N/A	ft
Clogging Factor for a Single Unit Grate (typical min. value = 0.5)	N/A	N/A	
Clogging Factor for a Single Unit Curb Opening (typical min. value = 0.1)	0.10	0.10	
Street Hydraulics: OK - Q < Allowable Street Capacity*			
Total Inlet Interception Capacity	2.1	5.5	cfs
Total Inlet Carry-Over Flow (flow bypassing inlet)	0.0	0.8	cfs
Capture Percentage = Q_p/Q_o =	100	87	%


ALLOWABLE CAPACITY FOR ONE-HALF OF STREET (Minor & Major Storm)

(Based on Regulated Criteria for Maximum Allowable Flow Depth and Spread)

MONUMENT JUNCTION - HWY. 105/JCP INT. IMPS.

Project:
Inlet ID:

H9

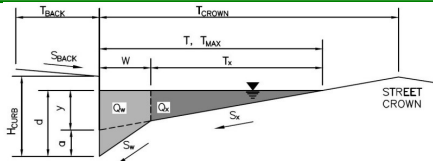

Gutter Geometry (Enter data in the blue cells)

Maximum Allowable Width for Spread Behind Curb
 Side Slope Behind Curb (leave blank for no conveyance credit behind curb)
 Manning's Roughness Behind Curb (typically between 0.012 and 0.020)
 Height of Curb at Gutter Flow Line
 Distance from Curb Face to Street Crown
 Gutter Width
 Street Transverse Slope
 Gutter Cross Slope (typically 2 inches over 24 inches or 0.083 ft/ft)
 Street Longitudinal Slope - Enter 0 for sump condition
 Manning's Roughness for Street Section (typically between 0.012 and 0.020)

$T_{BACK} = 6.0$ ft
 $S_{BACK} = 0.020$ ft/ft
 $n_{BACK} = 0.020$

$H_{CURB} = 6.00$ inches
 $T_{CROWN} = 38.0$ ft
 $W = 2.00$ ft
 $S_x = 0.020$ ft/ft
 $S_w = 0.083$ ft/ft
 $S_o = 0.000$ ft/ft
 $n_{STREET} = 0.016$

Max. Allowable Spread for Minor & Major Storm
 Max. Allowable Depth at Gutter Flowline for Minor & Major Storm
 Check boxes are not applicable in SUMP conditions

	Minor Storm	Major Storm	
$T_{MAX} =$	16.0	25.0	ft
$d_{MAX} =$	3.8	6.0	inches
	<input type="checkbox"/>	<input type="checkbox"/>	


MINOR STORM Allowable Capacity is based on Depth Criterion
 MAJOR STORM Allowable Capacity is based on Depth Criterion

$Q_{allow} =$

	Minor Storm	Major Storm	
	SUMP	SUMP	cfs

INLET IN A SUMP OR SAG LOCATION

Version 4.06 Released August 2018

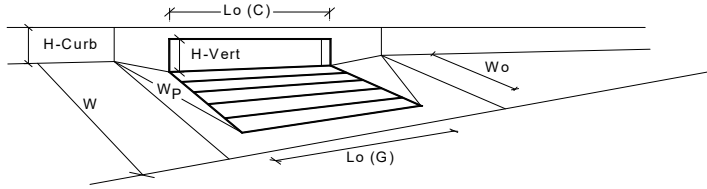


Design Information (Input)	MINOR	MAJOR	
Type of Inlet	CDOT Type R Curb Opening		
Local Depression (additional to continuous gutter depression 'a' from above)			
Number of Unit Inlets (Grate or Curb Opening)			
Water Depth at Flowline (outside of local depression)			
Grate Information	MINOR	MAJOR	
Length of a Unit Grate	N/A	N/A	feet
Width of a Unit Grate	N/A	N/A	feet
Area Opening Ratio for a Grate (typical values 0.15-0.90)	N/A	N/A	
Clogging Factor for a Single Grate (typical value 0.50 - 0.70)	N/A	N/A	
Grate Weir Coefficient (typical value 2.15 - 3.60)	N/A	N/A	
Grate Orifice Coefficient (typical value 0.60 - 0.80)	N/A	N/A	
Curb Opening Information	MINOR	MAJOR	
Length of a Unit Curb Opening	10.00	10.00	feet
Height of Vertical Curb Opening in Inches	6.00	6.00	inches
Height of Curb Orifice Throat in Inches	6.00	6.00	inches
Angle of Throat (see USDCM Figure ST-5)	63.40	63.40	degrees
Side Width for Depression Pan (typically the gutter width of 2 feet)	2.00	2.00	feet
Clogging Factor for a Single Curb Opening (typical value 0.10)	0.10	0.10	
Curb Opening Weir Coefficient (typical value 2.3-3.7)	3.60	3.60	
Curb Opening Orifice Coefficient (typical value 0.60 - 0.70)	0.67	0.67	
Low Head Performance Reduction (Calculated)	MINOR	MAJOR	
Depth for Grate Midwidth	N/A	N/A	ft
Depth for Curb Opening Weir Equation	0.15	0.33	ft
Combination Inlet Performance Reduction Factor for Long Inlets	0.36	0.57	
Curb Opening Performance Reduction Factor for Long Inlets	0.77	0.93	
Grated Inlet Performance Reduction Factor for Long Inlets	N/A	N/A	
Total Inlet Interception Capacity (assumes clogged condition)	MINOR	MAJOR	
Inlet Capacity IS GOOD for Minor and Major Storms(>Q PEAK)	2.1	8.3	cfs
Q PEAK REQUIRED =	1.0	2.8	cfs

ALLOWABLE CAPACITY FOR ONE-HALF OF STREET (Minor & Major Storm)

(Based on Regulated Criteria for Maximum Allowable Flow Depth and Spread)

Project: **MONUMENT JUNCTION - HWY. 105/JCP INT. IMPS.**
 Inlet ID: **D4**

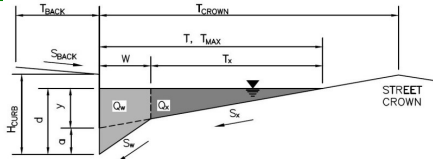

Gutter Geometry (Enter data in the blue cells)

Maximum Allowable Width for Spread Behind Curb
 Side Slope Behind Curb (leave blank for no conveyance credit behind curb)
 Manning's Roughness Behind Curb (typically between 0.012 and 0.020)

Height of Curb at Gutter Flow Line
 Distance from Curb Face to Street Crown
 Gutter Width
 Street Transverse Slope
 Gutter Cross Slope (typically 2 inches over 24 inches or 0.083 ft/ft)
 Street Longitudinal Slope - Enter 0 for sump condition
 Manning's Roughness for Street Section (typically between 0.012 and 0.020)

Max. Allowable Spread for Minor & Major Storm
 Max. Allowable Depth at Gutter Flowline for Minor & Major Storm
 Allow Flow Depth at Street Crown (leave blank for no)

MINOR STORM Allowable Capacity is based on Depth Criterion
MAJOR STORM Allowable Capacity is based on Depth Criterion
Minor storm max. allowable capacity GOOD - greater than the design flow given on sheet 'Inlet Management'
Major storm max. allowable capacity GOOD - greater than the design flow given on sheet 'Inlet Management'

T_{BACK} =	7.0	ft
S_{BACK} =	0.020	ft/ft
n_{BACK} =	0.016	
H_{CURB} =	6.00	inches
T_{CROWN} =	50.0	ft
W =	2.00	ft
S_x =	0.020	ft/ft
S_w =	0.083	ft/ft
S_o =	0.035	ft/ft
n_{STREET} =	0.016	


	Minor Storm	Major Storm	
T_{MAX} =	14.0	25.0	ft
d_{MAX} =	3.4	6.0	inches
	<input type="checkbox"/>	<input type="checkbox"/>	check = yes

	Minor Storm	Major Storm	
Q_{allow} =	3.6	13.7	cfs

Unresolved: Per road profiles in CD set, street slope is approximately 5.5%

INLET ON A CONTINUOUS GRADE

Version 4.06 Released August 2018

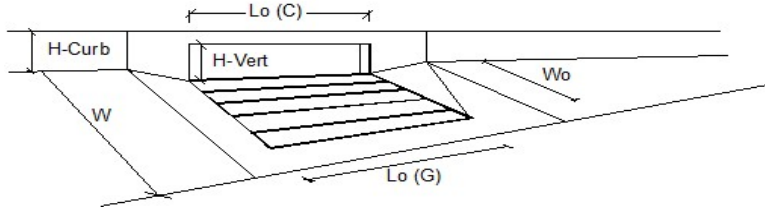


Design Information (Input)	MINOR	MAJOR	
Type of Inlet	CDOT Type R Curb Opening		
Local Depression (additional to continuous gutter depression 'a')	3.0	3.0	inches
Total Number of Units in the Inlet (Grate or Curb Opening)	1	1	
Length of a Single Unit Inlet (Grate or Curb Opening)	5.00	5.00	ft
Width of a Unit Grate (cannot be greater than W, Gutter Width)	N/A	N/A	ft
Clogging Factor for a Single Unit Grate (typical min. value = 0.5)	N/A	N/A	
Clogging Factor for a Single Unit Curb Opening (typical min. value = 0.1)	0.10	0.10	
Street Hydraulics: OK - Q < Allowable Street Capacity*			
Total Inlet Interception Capacity	1.4	2.5	cfs
Total Inlet Carry-Over Flow (flow bypassing inlet)	0.0	1.3	cfs
Capture Percentage = Q_p/Q_o =	97	66	%

ALLOWABLE CAPACITY FOR ONE-HALF OF STREET (Minor & Major Storm)

(Based on Regulated Criteria for Maximum Allowable Flow Depth and Spread)

Project: **MONUMENT JUNCTION - HWY. 105/JCP INT. IMPS.**
 Inlet ID: **D5**

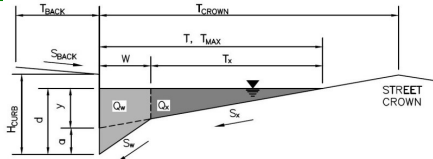

Gutter Geometry (Enter data in the blue cells)

Maximum Allowable Width for Spread Behind Curb
 Side Slope Behind Curb (leave blank for no conveyance credit behind curb)
 Manning's Roughness Behind Curb (typically between 0.012 and 0.020)

$T_{BACK} = 4.0$ ft
 $S_{BACK} = 0.250$ ft/ft
 $n_{BACK} = 0.020$

Height of Curb at Gutter Flow Line
 Distance from Curb Face to Street Crown
 Gutter Width
 Street Transverse Slope
 Gutter Cross Slope (typically 2 inches over 24 inches or 0.083 ft/ft)
 Street Longitudinal Slope - Enter 0 for sump condition
 Manning's Roughness for Street Section (typically between 0.012 and 0.020)

$H_{CURB} = 6.00$ inches
 $T_{CROWN} = 42.0$ ft
 $W = 2.00$ ft
 $S_x = 0.020$ ft/ft
 $S_w = 0.083$ ft/ft
 $S_o = 0.056$ ft/ft
 $n_{STREET} = 0.016$

Max. Allowable Spread for Minor & Major Storm
 Max. Allowable Depth at Gutter Flowline for Minor & Major Storm
 Allow Flow Depth at Street Crown (leave blank for no)

	Minor Storm	Major Storm	
$T_{MAX} =$	14.0	25.0	ft
$d_{MAX} =$	3.4	6.0	inches
	<input type="checkbox"/>	<input type="checkbox"/>	check = yes


MINOR STORM Allowable Capacity is based on Depth Criterion
MAJOR STORM Allowable Capacity is based on Depth Criterion

	Minor Storm	Major Storm	
$Q_{allow} =$	4.5	11.9	cfs

Minor storm max. allowable capacity GOOD - greater than the design flow given on sheet 'Inlet Management'
Major storm max. allowable capacity GOOD - greater than the design flow given on sheet 'Inlet Management'

INLET ON A CONTINUOUS GRADE

Version 4.06 Released August 2018

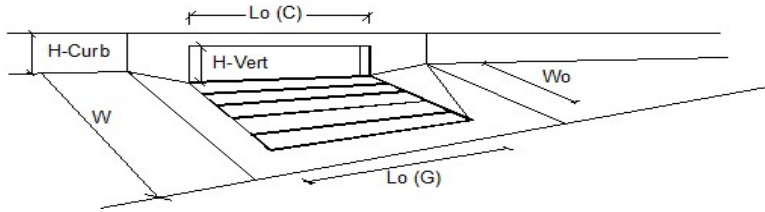


Design Information (Input)	MINOR	MAJOR	
Type of Inlet	CDOT Type R Curb Opening		
Local Depression (additional to continuous gutter depression 'a')	3.0	3.0	inches
Total Number of Units in the Inlet (Grate or Curb Opening)	1	1	
Length of a Single Unit Inlet (Grate or Curb Opening)	10.00	10.00	ft
Width of a Unit Grate (cannot be greater than W, Gutter Width)	N/A	N/A	ft
Clogging Factor for a Single Unit Grate (typical min. value = 0.5)	N/A	N/A	
Clogging Factor for a Single Unit Curb Opening (typical min. value = 0.1)	0.10	0.10	
Street Hydraulics: OK - Q < Allowable Street Capacity*			
Total Inlet Interception Capacity	2.0	4.9	cfs
Total Inlet Carry-Over Flow (flow bypassing inlet)	0.0	0.4	cfs
Capture Percentage = Q_p/Q_o =	100	93	%

AREA INLET IN A SWALE

MONUMENT JUNCTION WEST FILING NO. 1

D6

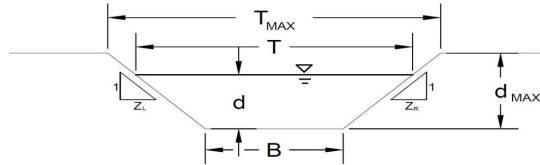

This worksheet uses the NRCS vegetative retardance method to determine Manning's n.
For more information see Section 7.2.3 of the USDCM.

Analysis of Trapezoidal Grass-Lined Channel Using SCS Method

NRCS Vegetal Retardance (A, B, C, D, or E)
Manning's n (Leave cell D16 blank to manually enter an n value)
Channel Invert Slope
Bottom Width
Left Side Slope
Right Side Slope

A, B, C, D or E
n = 0.035
S₀ = 0.0200 ft/ft
B = 5.00 ft
Z1 = 4.00 ft/ft
Z2 = 4.00 ft/ft

Check one of the following soil types:

Soil Type:	Max. Velocity (V _{MAX})	Max Froude No. (F _{MAX})
Non-Cohesive	5.0 fps	0.60
Cohesive	7.0 fps	0.80
Paved	N/A	N/A

Choose One:
 Non-Cohesive
 Cohesive
 Paved

Max. Allowable Top Width of Channel for Minor & Major Storm
Max. Allowable Water Depth in Channel for Minor & Major Storm

	Minor Storm	Major Storm	
T _{MAX} =	10.00	10.00	feet
d _{MAX} =	1.50	1.50	feet

Allowable Channel Capacity Based On Channel Geometry

MINOR STORM Allowable Capacity is based on Top Width Criterion
MAJOR STORM Allowable Capacity is based on Top Width Criterion

	Minor Storm	Major Storm	
Q _{allow} =	16.9	16.9	cfs
d _{allow} =	0.63	0.63	ft

Water Depth in Channel Based On Design Peak Flow

Design Peak Flow
Water Depth

	Minor Storm	Major Storm	
Q _c =	4.0	8.0	cfs
d =	0.28	0.42	feet

Minor storm max. allowable capacity GOOD - greater than the design flow given on sheet 'Inlet Management'
Major storm max. allowable capacity GOOD - greater than the design flow given on sheet 'Inlet Management'

AREA INLET IN A SWALE

MONUMENT JUNCTION WEST FILING NO. 1

D6

Inlet Design Information (Input)

Type of Inlet: Inlet Type =

Angle of Inclined Grate (must be <= 30 degrees): degrees

Width of Grate: feet

Length of Grate: feet

Open Area Ratio:


Height of Inclined Grate: feet

Clogging Factor:

Grate Discharge Coefficient:

Orifice Coefficient:

Weir Coefficient:

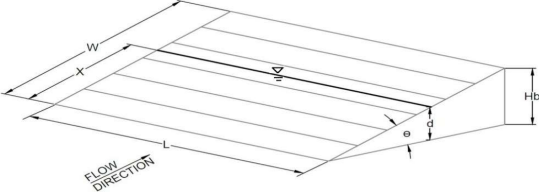


	MINOR	MAJOR	
d =	1.28	1.42	
Q_a =	16.1	16.9	cfs
Bypassed Flow, Q _b =	0.0	0.0	cfs
Capture Percentage = Q _a /Q _o = C%	100	100	%

Warning 04: Froude No. exceeds USDCM Volume I recommendation.

ALLOWABLE CAPACITY FOR ONE-HALF OF STREET (Minor & Major Storm)

(Based on Regulated Criteria for Maximum Allowable Flow Depth and Spread)


Project: **MONUMENT JUNCTION - HWY. 105/JCP INT. IMPS.**
 Inlet ID: **D7**

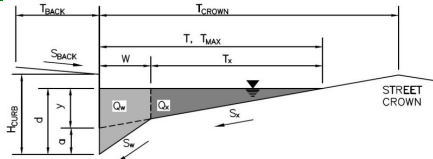

Gutter Geometry (Enter data in the blue cells)							
Maximum Allowable Width for Spread Behind Curb	$T_{BACK} = 3.0$ ft						
Side Slope Behind Curb (leave blank for no conveyance credit behind curb)	$S_{BACK} = 0.100$ ft/ft						
Manning's Roughness Behind Curb (typically between 0.012 and 0.020)	$n_{BACK} = 0.016$						
Height of Curb at Gutter Flow Line	$H_{CURB} = 6.00$ inches						
Distance from Curb Face to Street Crown	$T_{CROWN} = 42.0$ ft						
Gutter Width	$W = 1.00$ ft						
Street Transverse Slope	$S_x = 0.035$ ft/ft						
Gutter Cross Slope (typically 2 inches over 24 inches or 0.083 ft/ft)	$S_w = 0.083$ ft/ft						
Street Longitudinal Slope - Enter 0 for sump condition	$S_o = 0.040$ ft/ft						
Manning's Roughness for Street Section (typically between 0.012 and 0.020)	$n_{STREET} = 0.016$						
Max. Allowable Spread for Minor & Major Storm	<table border="1"> <tr> <th>Minor Storm</th> <th>Major Storm</th> <th>ft</th> </tr> <tr> <td>$T_{MAX} = 14.0$</td> <td>$T_{MAX} = 25.0$</td> <td></td> </tr> </table>	Minor Storm	Major Storm	ft	$T_{MAX} = 14.0$	$T_{MAX} = 25.0$	
Minor Storm	Major Storm	ft					
$T_{MAX} = 14.0$	$T_{MAX} = 25.0$						
Max. Allowable Depth at Gutter Flowline for Minor & Major Storm	<table border="1"> <tr> <th>Minor Storm</th> <th>Major Storm</th> <th>inches</th> </tr> <tr> <td>$d_{MAX} = 3.4$</td> <td>$d_{MAX} = 6.0$</td> <td></td> </tr> </table>	Minor Storm	Major Storm	inches	$d_{MAX} = 3.4$	$d_{MAX} = 6.0$	
Minor Storm	Major Storm	inches					
$d_{MAX} = 3.4$	$d_{MAX} = 6.0$						
Allow Flow Depth at Street Crown (leave blank for no)	<input type="checkbox"/> <input type="checkbox"/> check = yes						
MINOR STORM Allowable Capacity is based on Depth Criterion							
MAJOR STORM Allowable Capacity is based on Depth Criterion							
WARNING: MINOR STORM max. allowable capacity is less than the design flow given on sheet 'Inlet Management'							
WARNING: MAJOR STORM max. allowable capacity is less than the design flow given on sheet 'Inlet Management'							
	<table border="1"> <tr> <th>Minor Storm</th> <th>Major Storm</th> <th>cfs</th> </tr> <tr> <td>$Q_{allow} = 4.5$</td> <td>$Q_{allow} = 11.7$</td> <td></td> </tr> </table>	Minor Storm	Major Storm	cfs	$Q_{allow} = 4.5$	$Q_{allow} = 11.7$	
Minor Storm	Major Storm	cfs					
$Q_{allow} = 4.5$	$Q_{allow} = 11.7$						

INLET ON A CONTINUOUS GRADE

Version 4.06 Released August 2018

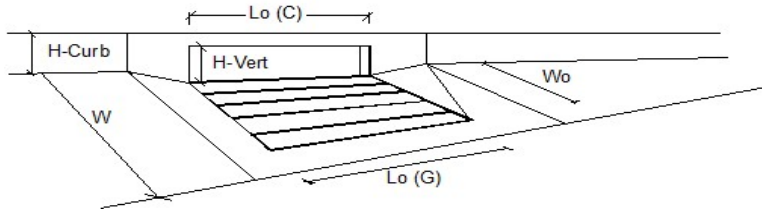

Design Information (Input)	MINOR	MAJOR	
Type of Inlet	CDOT Type R Curb Opening		
Local Depression (additional to continuous gutter depression 'a')	3.0	3.0	inches
Total Number of Units in the Inlet (Grate or Curb Opening)	1	1	
Length of a Single Unit Inlet (Grate or Curb Opening)	10.00	10.00	ft
Width of a Unit Grate (cannot be greater than W, Gutter Width)	N/A	N/A	ft
Clogging Factor for a Single Unit Grate (typical min. value = 0.5)	N/A	N/A	
Clogging Factor for a Single Unit Curb Opening (typical min. value = 0.1)	0.10	0.10	
Street Hydraulics: WARNING: Q > ALLOWABLE Q FOR MINOR & MAJOR STORM			
Total Inlet Interception Capacity	5.4	8.2	cfs
Total Inlet Carry-Over Flow (flow bypassing inlet)	0.6	3.8	cfs
Capture Percentage = Q_p/Q_o =	90	68	%


ALLOWABLE CAPACITY FOR ONE-HALF OF STREET (Minor & Major Storm)

(Based on Regulated Criteria for Maximum Allowable Flow Depth and Spread)

Project:
Inlet ID:

MONUMENT JUNCTION WEST FILING NO. 1

D8

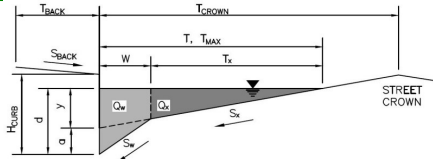

Gutter Geometry (Enter data in the blue cells)

Maximum Allowable Width for Spread Behind Curb
 Side Slope Behind Curb (leave blank for no conveyance credit behind curb)
 Manning's Roughness Behind Curb (typically between 0.012 and 0.020)
 Height of Curb at Gutter Flow Line
 Distance from Curb Face to Street Crown
 Gutter Width
 Street Transverse Slope
 Gutter Cross Slope (typically 2 inches over 24 inches or 0.083 ft/ft)
 Street Longitudinal Slope - Enter 0 for sump condition
 Manning's Roughness for Street Section (typically between 0.012 and 0.020)

$T_{BACK} = 3.0$ ft
 $S_{BACK} = 0.100$ ft/ft
 $n_{BACK} = 0.016$

$H_{CURB} = 6.00$ inches
 $T_{CROWN} = 42.0$ ft
 $W = 1.00$ ft
 $S_x = 0.045$ ft/ft
 $S_w = 0.083$ ft/ft
 $S_D = 0.000$ ft/ft
 $n_{STREET} = 0.016$

Max. Allowable Spread for Minor & Major Storm
 Max. Allowable Depth at Gutter Flowline for Minor & Major Storm
 Check boxes are not applicable in SUMP conditions

	Minor Storm	Major Storm	
$T_{MAX} =$	18.0	18.0	ft
$d_{MAX} =$	6.0	6.0	inches
	<input type="checkbox"/>	<input type="checkbox"/>	

MINOR STORM Allowable Capacity is based on Depth Criterion
MAJOR STORM Allowable Capacity is based on Depth Criterion


$Q_{allow} =$

Minor Storm	Major Storm
SUMP	SUMP

 cfs

INLET IN A SUMP OR SAG LOCATION

Version 4.06 Released August 2018

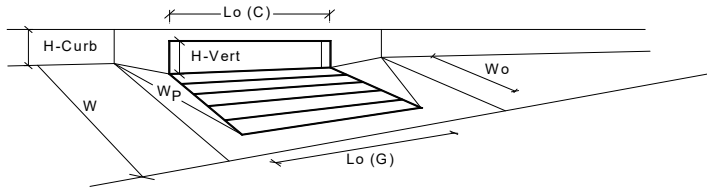


Design Information (Input)	MINOR	MAJOR	
Type of Inlet	CDOT Type R Curb Opening		
Local Depression (additional to continuous gutter depression 'a' from above)			
Number of Unit Inlets (Grate or Curb Opening)	1	1	
Water Depth at Flowline (outside of local depression)	6.0	6.0	inches
Grate Information	MINOR	MAJOR	<input type="checkbox"/> Override Depths
Length of a Unit Grate	N/A	N/A	feet
Width of a Unit Grate	N/A	N/A	feet
Area Opening Ratio for a Grate (typical values 0.15-0.90)	N/A	N/A	
Clogging Factor for a Single Grate (typical value 0.50 - 0.70)	N/A	N/A	
Grate Weir Coefficient (typical value 2.15 - 3.60)	N/A	N/A	
Grate Orifice Coefficient (typical value 0.60 - 0.80)	N/A	N/A	
Curb Opening Information	MINOR	MAJOR	
Length of a Unit Curb Opening	10.00	10.00	feet
Height of Vertical Curb Opening in Inches	6.00	6.00	inches
Height of Curb Orifice Throat in Inches	6.00	6.00	inches
Angle of Throat (see USDCM Figure ST-5)	63.40	63.40	degrees
Side Width for Depression Pan (typically the gutter width of 2 feet)	1.00	1.00	feet
Clogging Factor for a Single Curb Opening (typical value 0.10)	0.10	0.10	
Curb Opening Weir Coefficient (typical value 2.3-3.7)	3.60	3.60	
Curb Opening Orifice Coefficient (typical value 0.60 - 0.70)	0.67	0.67	
Low Head Performance Reduction (Calculated)	MINOR	MAJOR	
Depth for Grate Midwidth	N/A	N/A	ft
Depth for Curb Opening Weir Equation	0.42	0.42	ft
Combination Inlet Performance Reduction Factor for Long Inlets	0.57	0.57	
Curb Opening Performance Reduction Factor for Long Inlets	0.93	0.93	
Grated Inlet Performance Reduction Factor for Long Inlets	N/A	N/A	
Total Inlet Interception Capacity (assumes clogged condition)	MINOR	MAJOR	
Q_a	10.0	10.0	cfs
Q _{PEAK REQUIRED}	3.6	9.8	cfs

Inlet Capacity IS GOOD for Minor and Major Storms(>Q PEAK)

ALLOWABLE CAPACITY FOR ONE-HALF OF STREET (Minor & Major Storm)

(Based on Regulated Criteria for Maximum Allowable Flow Depth and Spread)

Project: **MONUMENT JUNCTION - HWY. 105/JCP INT. IMPS.**
 Inlet ID: **D9**

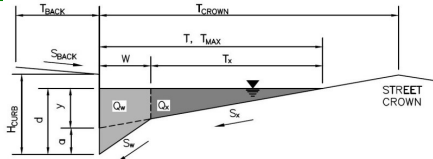

Gutter Geometry (Enter data in the blue cells)

Maximum Allowable Width for Spread Behind Curb
 Side Slope Behind Curb (leave blank for no conveyance credit behind curb)
 Manning's Roughness Behind Curb (typically between 0.012 and 0.020)

$T_{BACK} = 10.0$ ft
 $S_{BACK} = 0.020$ ft/ft
 $n_{BACK} = 0.016$

Height of Curb at Gutter Flow Line
 Distance from Curb Face to Street Crown
 Gutter Width
 Street Transverse Slope
 Gutter Cross Slope (typically 2 inches over 24 inches or 0.083 ft/ft)
 Street Longitudinal Slope - Enter 0 for sump condition
 Manning's Roughness for Street Section (typically between 0.012 and 0.020)

$H_{CURB} = 6.00$ inches
 $T_{CROWN} = 25.0$ ft
 $W = 2.00$ ft
 $S_X = 0.025$ ft/ft
 $S_W = 0.083$ ft/ft
 $S_D = 0.040$ ft/ft
 $n_{STREET} = 0.016$

Max. Allowable Spread for Minor & Major Storm
 Max. Allowable Depth at Gutter Flowline for Minor & Major Storm
 Allow Flow Depth at Street Crown (leave blank for no)

	Minor Storm	Major Storm	
$T_{MAX} =$	14.0	25.0	ft
$d_{MAX} =$	3.4	6.0	inches
	<input type="checkbox"/>	<input type="checkbox"/>	check = yes


MINOR STORM Allowable Capacity is based on Depth Criterion
MAJOR STORM Allowable Capacity is based on Depth Criterion

	Minor Storm	Major Storm	
$Q_{allow} =$	3.6	11.4	cfs

Minor storm max. allowable capacity GOOD - greater than the design flow given on sheet 'Inlet Management'
Major storm max. allowable capacity GOOD - greater than the design flow given on sheet 'Inlet Management'

INLET ON A CONTINUOUS GRADE

Version 4.06 Released August 2018

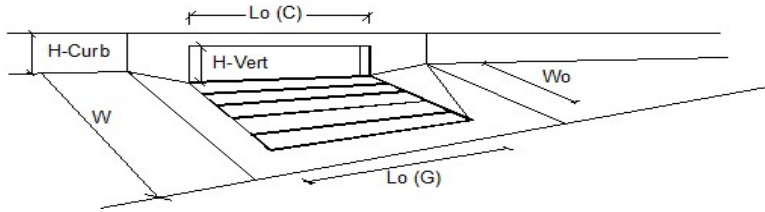


Design Information (Input)	MINOR	MAJOR	
Type of Inlet	CDOT Type R Curb Opening		
Local Depression (additional to continuous gutter depression 'a')	3.0	3.0	inches
Total Number of Units in the Inlet (Grate or Curb Opening)	1	1	
Length of a Single Unit Inlet (Grate or Curb Opening)	10.00	10.00	ft
Width of a Unit Grate (cannot be greater than W, Gutter Width)	N/A	N/A	ft
Clogging Factor for a Single Unit Grate (typical min. value = 0.5)	N/A	N/A	
Clogging Factor for a Single Unit Curb Opening (typical min. value = 0.1)	0.10	0.10	
Street Hydraulics: OK - Q < Allowable Street Capacity*			
Total Inlet Interception Capacity	2.0	4.8	cfs
Total Inlet Carry-Over Flow (flow bypassing inlet)	0.0	0.2	cfs
Capture Percentage = Q_p/Q_o =	100	95	%

ALLOWABLE CAPACITY FOR ONE-HALF OF STREET (Minor & Major Storm)

(Based on Regulated Criteria for Maximum Allowable Flow Depth and Spread)


Project: **MONUMENT JUNCTION - HWY. 105/JCP INT. IMPS.**
 Inlet ID: **D10**

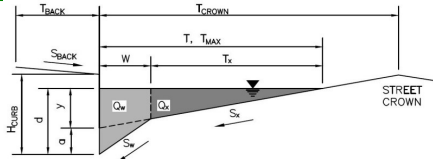

Gutter Geometry (Enter data in the blue cells)					
Maximum Allowable Width for Spread Behind Curb	$T_{BACK} = 10.0$ ft				
Side Slope Behind Curb (leave blank for no conveyance credit behind curb)	$S_{BACK} = 0.020$ ft/ft				
Manning's Roughness Behind Curb (typically between 0.012 and 0.020)	$n_{BACK} = 0.016$				
Height of Curb at Gutter Flow Line	$H_{CURB} = 6.00$ inches				
Distance from Curb Face to Street Crown	$T_{CROWN} = 48.0$ ft				
Gutter Width	$W = 2.00$ ft				
Street Transverse Slope	$S_X = 0.020$ ft/ft				
Gutter Cross Slope (typically 2 inches over 24 inches or 0.083 ft/ft)	$S_W = 0.083$ ft/ft				
Street Longitudinal Slope - Enter 0 for sump condition	$S_D = 0.030$ ft/ft				
Manning's Roughness for Street Section (typically between 0.012 and 0.020)	$n_{STREET} = 0.016$				
Max. Allowable Spread for Minor & Major Storm	<table border="1" style="display: inline-table; border-collapse: collapse;"> <tr> <th style="padding: 2px;">Minor Storm</th> <th style="padding: 2px;">Major Storm</th> </tr> <tr> <td style="text-align: center; padding: 2px;">$T_{MAX} = 14.0$</td> <td style="text-align: center; padding: 2px;">25.0</td> </tr> </table> ft	Minor Storm	Major Storm	$T_{MAX} = 14.0$	25.0
Minor Storm	Major Storm				
$T_{MAX} = 14.0$	25.0				
Max. Allowable Depth at Gutter Flowline for Minor & Major Storm	<table border="1" style="display: inline-table; border-collapse: collapse;"> <tr> <th style="padding: 2px;">Minor Storm</th> <th style="padding: 2px;">Major Storm</th> </tr> <tr> <td style="text-align: center; padding: 2px;">$d_{MAX} = 3.4$</td> <td style="text-align: center; padding: 2px;">6.0</td> </tr> </table> inches	Minor Storm	Major Storm	$d_{MAX} = 3.4$	6.0
Minor Storm	Major Storm				
$d_{MAX} = 3.4$	6.0				
Allow Flow Depth at Street Crown (leave blank for no)	<input type="checkbox"/> <input type="checkbox"/> check = yes				
MINOR STORM Allowable Capacity is based on Depth Criterion					
MAJOR STORM Allowable Capacity is based on Depth Criterion					
Minor storm max. allowable capacity GOOD - greater than the design flow given on sheet 'Inlet Management'					
Major storm max. allowable capacity GOOD - greater than the design flow given on sheet 'Inlet Management'					
	<table border="1" style="display: inline-table; border-collapse: collapse;"> <tr> <th style="padding: 2px;">Minor Storm</th> <th style="padding: 2px;">Major Storm</th> </tr> <tr> <td style="text-align: center; padding: 2px;">$Q_{allow} = 3.3$</td> <td style="text-align: center; padding: 2px;">14.4</td> </tr> </table> cfs	Minor Storm	Major Storm	$Q_{allow} = 3.3$	14.4
Minor Storm	Major Storm				
$Q_{allow} = 3.3$	14.4				

INLET ON A CONTINUOUS GRADE

Version 4.06 Released August 2018

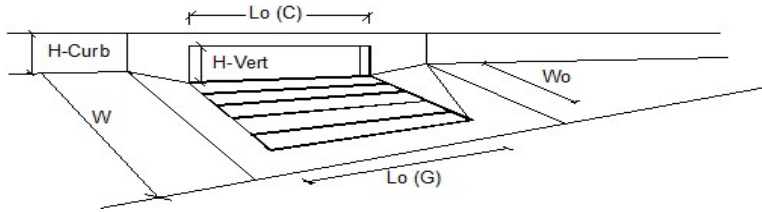

Design Information (Input)	MINOR	MAJOR	
Type of Inlet	CDOT Type R Curb Opening		
Local Depression (additional to continuous gutter depression 'a')	3.0	3.0	inches
Total Number of Units in the Inlet (Grate or Curb Opening)	1	1	
Length of a Single Unit Inlet (Grate or Curb Opening)	10.00	10.00	ft
Width of a Unit Grate (cannot be greater than W, Gutter Width)	N/A	N/A	ft
Clogging Factor for a Single Unit Grate (typical min. value = 0.5)	N/A	N/A	
Clogging Factor for a Single Unit Curb Opening (typical min. value = 0.1)	0.10	0.10	
Street Hydraulics: OK - Q < Allowable Street Capacity*			
Total Inlet Interception Capacity	3.0	5.4	cfs
Total Inlet Carry-Over Flow (flow bypassing inlet)	0.0	0.8	cfs
Capture Percentage = Q_p/Q_o =	100	88	%

ALLOWABLE CAPACITY FOR ONE-HALF OF STREET (Minor & Major Storm)


(Based on Regulated Criteria for Maximum Allowable Flow Depth and Spread)

MONUMENT JUNCTION - HWY. 105/JCP INT. IMPS.

Project:

Inlet ID:

D11

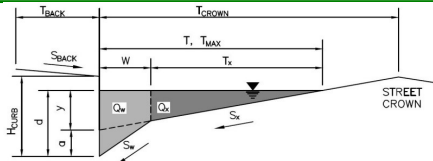

Gutter Geometry (Enter data in the blue cells)

Maximum Allowable Width for Spread Behind Curb
 Side Slope Behind Curb (leave blank for no conveyance credit behind curb)
 Manning's Roughness Behind Curb (typically between 0.012 and 0.020)

$T_{BACK} = 5.0$ ft
 $S_{BACK} = 0.020$ ft/ft
 $n_{BACK} = 0.016$

Height of Curb at Gutter Flow Line
 Distance from Curb Face to Street Crown
 Gutter Width
 Street Transverse Slope
 Gutter Cross Slope (typically 2 inches over 24 inches or 0.083 ft/ft)
 Street Longitudinal Slope - Enter 0 for sump condition
 Manning's Roughness for Street Section (typically between 0.012 and 0.020)

$H_{CURB} = 6.00$ inches
 $T_{CROWN} = 48.0$ ft
 $W = 2.00$ ft
 $S_x = 0.020$ ft/ft
 $S_w = 0.083$ ft/ft
 $S_D = 0.000$ ft/ft
 $n_{STREET} = 0.016$

Max. Allowable Spread for Minor & Major Storm
 Max. Allowable Depth at Gutter Flowline for Minor & Major Storm
 Check boxes are not applicable in SUMP conditions

	Minor Storm	Major Storm	
$T_{MAX} =$	14.0	25.0	ft
$d_{MAX} =$	3.4	6.0	inches
	<input type="checkbox"/>	<input type="checkbox"/>	


MINOR STORM Allowable Capacity is based on Depth Criterion
MAJOR STORM Allowable Capacity is based on Depth Criterion

$Q_{allow} =$

Minor Storm	Major Storm	
SUMP	SUMP	cfs

INLET IN A SUMP OR SAG LOCATION

Version 4.06 Released August 2018

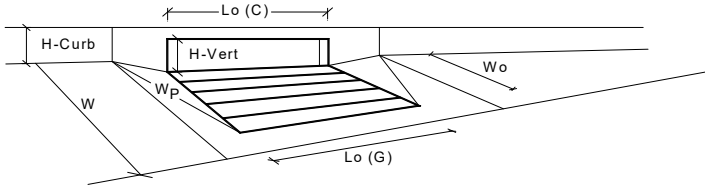


Design Information (Input)	MINOR	MAJOR	
Type of Inlet	CDOT Type R Curb Opening		
Local Depression (additional to continuous gutter depression 'a' from above)			
Number of Unit Inlets (Grate or Curb Opening)			
Water Depth at Flowline (outside of local depression)			
Grate Information	MINOR	MAJOR	
Length of a Unit Grate	L _g (G) =	N/A	feet
Width of a Unit Grate	W _g =	N/A	feet
Area Opening Ratio for a Grate (typical values 0.15-0.90)	A _{ratio} =	N/A	
Clogging Factor for a Single Grate (typical value 0.50 - 0.70)	C _f (G) =	N/A	
Grate Weir Coefficient (typical value 2.15 - 3.60)	C _w (G) =	N/A	
Grate Orifice Coefficient (typical value 0.60 - 0.80)	C _o (G) =	N/A	
Curb Opening Information	MINOR	MAJOR	
Length of a Unit Curb Opening	L _c (C) =	10.00	feet
Height of Vertical Curb Opening in Inches	H _{vert} =	6.00	inches
Height of Curb Orifice Throat in Inches	H _{throat} =	6.00	inches
Angle of Throat (see USDCM Figure ST-5)	Theta =	63.40	degrees
Side Width for Depression Pan (typically the gutter width of 2 feet)	W _p =	2.00	feet
Clogging Factor for a Single Curb Opening (typical value 0.10)	C _f (C) =	0.10	
Curb Opening Weir Coefficient (typical value 2.3-3.7)	C _w (C) =	3.60	
Curb Opening Orifice Coefficient (typical value 0.60 - 0.70)	C _o (C) =	0.67	
Low Head Performance Reduction (Calculated)	MINOR	MAJOR	
Depth for Grate Midwidth	d _{grate} =	N/A	ft
Depth for Curb Opening Weir Equation	d _{curb} =	0.33	ft
Combination Inlet Performance Reduction Factor for Long Inlets	RF _{combination} =	0.57	
Curb Opening Performance Reduction Factor for Long Inlets	RF _{curb} =	0.93	
Grated Inlet Performance Reduction Factor for Long Inlets	RF _{grate} =	N/A	
Total Inlet Interception Capacity (assumes clogged condition)	MINOR	MAJOR	
Inlet Capacity IS GOOD for Minor and Major Storms(>Q PEAK)	Q _a =	8.3	cfs
	Q _{PEAK REQUIRED} =	1.6	cfs

CIRCULAR CONDUIT FLOW (Normal & Critical Depth Computation)

MHFD-Culvert, Version 4.00 (May 2020)

Project: **MONUMENT JUNCTION DEVELOPMENT - HWY. 105 & JCP INT. IMPS.**

Pipe ID: **Pipe Run 1**

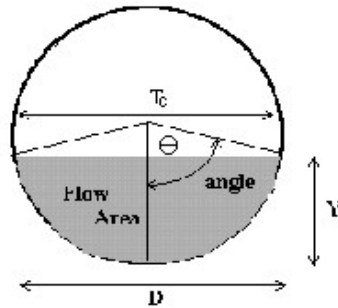


Design Information (Input)	
Pipe Invert Slope	So = 0.0100 ft/ft
Pipe Manning's n-value	n = 0.0130
Pipe Diameter	D = 18.00 inches
Design discharge	Q = 2.50 cfs
Full-Flow Capacity (Calculated)	
Full-flow area	Af = 1.77 sq ft
Full-flow wetted perimeter	Pf = 4.71 ft
Half Central Angle	Theta = 3.14 radians
Full-flow capacity	Qf = 10.53 cfs
Calculation of Normal Flow Condition	
Half Central Angle ($0 < \text{Theta} < 3.14$)	Theta = 1.23 radians
Flow area	An = 0.51 sq ft
Top width	Tn = 1.41 ft
Wetted perimeter	Pn = 1.84 ft
Flow depth	Yn = 0.50 ft
Flow velocity	Vn = 4.88 fps
Discharge	Qn = 2.50 cfs
Percent of Full Flow	Flow = 23.7% of full flow
Normal Depth Froude Number	Fr _n = 1.43 supercritical
Calculation of Critical Flow Condition	
Half Central Angle ($0 < \text{Theta-c} < 3.14$)	Theta-c = 1.37 radians
Critical flow area	Ac = 0.66 sq ft
Critical top width	Tc = 1.47 ft
Critical flow depth	Yc = 0.60 ft
Critical flow velocity	Vc = 3.80 fps
Critical Depth Froude Number	Fr _c = 1.00

CIRCULAR CONDUIT FLOW (Normal & Critical Depth Computation)

MHFD-Culvert, Version 4.00 (May 2020)

Project: **MONUMENT JUNCTION DEVELOPMENT - HWY. 105 & JCP INT. IMPS.**

Pipe ID: **Pipe Run 1**

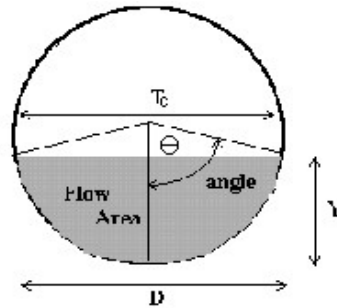


Design Information (Input)	
Pipe Invert Slope	So = 0.0536 ft/ft
Pipe Manning's n-value	n = 0.0130
Pipe Diameter	D = 18.00 inches
Design discharge	Q = 2.50 cfs
Full-Flow Capacity (Calculated)	
Full-flow area	Af = 1.77 sq ft
Full-flow wetted perimeter	Pf = 4.71 ft
Half Central Angle	Theta = 3.14 radians
Full-flow capacity	Qf = 24.38 cfs
Calculation of Normal Flow Condition	
Half Central Angle ($0 < \theta < 3.14$)	Theta = 0.97 radians
Flow area	An = 0.28 sq ft
Top width	Tn = 1.24 ft
Wetted perimeter	Pn = 1.45 ft
Flow depth	Yn = 0.32 ft
Flow velocity	Vn = 8.89 fps
Discharge	Qn = 2.50 cfs
Percent of Full Flow	Flow = 10.3% of full flow
Normal Depth Froude Number	Fr _n = 3.28 supercritical
Calculation of Critical Flow Condition	
Half Central Angle ($0 < \theta_c < 3.14$)	Theta-c = 1.37 radians
Critical flow area	Ac = 0.66 sq ft
Critical top width	Tc = 1.47 ft
Critical flow depth	Yc = 0.60 ft
Critical flow velocity	Vc = 3.80 fps
Critical Depth Froude Number	Fr _c = 1.00

CIRCULAR CONDUIT FLOW (Normal & Critical Depth Computation)

MHFD-Culvert, Version 4.00 (May 2020)

Project: **MONUMENT JUNCTION DEVELOPMENT - HWY. 105 & JCP INT. IMPS.**

Pipe ID: **Pipe Run 2**

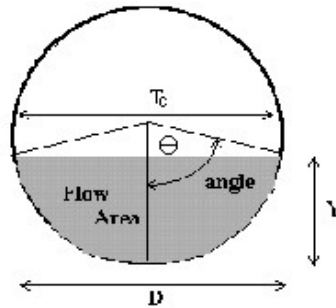


Design Information (Input)	
Pipe Invert Slope	So = 0.0568 ft/ft
Pipe Manning's n-value	n = 0.0130
Pipe Diameter	D = 24.00 inches
Design discharge	Q = 7.00 cfs
Full-Flow Capacity (Calculated)	
Full-flow area	Af = 3.14 sq ft
Full-flow wetted perimeter	Pf = 6.28 ft
Half Central Angle	Theta = 3.14 radians
Full-flow capacity	Qf = 54.06 cfs
Calculation of Normal Flow Condition	
Half Central Angle ($0 < \theta < 3.14$)	Theta = 1.03 radians
Flow area	An = 0.59 sq ft
Top width	Tn = 1.72 ft
Wetted perimeter	Pn = 2.06 ft
Flow depth	Yn = 0.49 ft
Flow velocity	Vn = 11.86 fps
Discharge	Qn = 7.00 cfs
Percent of Full Flow	Flow = 12.9% of full flow
Normal Depth Froude Number	Fr _n = 3.56 supercritical
Calculation of Critical Flow Condition	
Half Central Angle ($0 < \theta_c < 3.14$)	Theta-c = 1.51 radians
Critical flow area	Ac = 1.45 sq ft
Critical top width	Tc = 2.00 ft
Critical flow depth	Yc = 0.94 ft
Critical flow velocity	Vc = 4.83 fps
Critical Depth Froude Number	Fr _c = 1.00

CIRCULAR CONDUIT FLOW (Normal & Critical Depth Computation)

MHFD-Culvert, Version 4.00 (May 2020)

Project: MONUMENT JUNCTION DEVELOPMENT - HWY. 105 & JCP INT. IMPS.

Pipe ID: Pipe Run 3

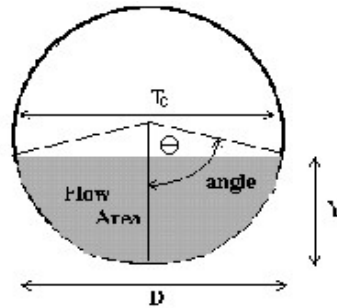


<u>Design Information (Input)</u>			
Pipe Invert Slope	So = <table border="1" style="display: inline-table; border-collapse: collapse;"><tr><td style="text-align: center;">0.0100</td><td style="text-align: left;">ft/ft</td></tr></table>	0.0100	ft/ft
0.0100	ft/ft		
Pipe Manning's n-value	n = <table border="1" style="display: inline-table; border-collapse: collapse;"><tr><td style="text-align: center;">0.0130</td><td></td></tr></table>	0.0130	
0.0130			
Pipe Diameter	D = <table border="1" style="display: inline-table; border-collapse: collapse;"><tr><td style="text-align: center;">18.00</td><td style="text-align: left;">inches</td></tr></table>	18.00	inches
18.00	inches		
Design discharge	Q = <table border="1" style="display: inline-table; border-collapse: collapse;"><tr><td style="text-align: center;">8.00</td><td style="text-align: left;">cfs</td></tr></table>	8.00	cfs
8.00	cfs		
<u>Full-Flow Capacity (Calculated)</u>			
Full-flow area	Af = <table border="1" style="display: inline-table; border-collapse: collapse;"><tr><td style="text-align: center;">1.77</td><td style="text-align: left;">sq ft</td></tr></table>	1.77	sq ft
1.77	sq ft		
Full-flow wetted perimeter	Pf = <table border="1" style="display: inline-table; border-collapse: collapse;"><tr><td style="text-align: center;">4.71</td><td></td></tr></table>	4.71	
4.71			
Half Central Angle	Theta = <table border="1" style="display: inline-table; border-collapse: collapse;"><tr><td style="text-align: center;">3.14</td><td style="text-align: left;">radians</td></tr></table>	3.14	radians
3.14	radians		
Full-flow capacity	Qf = <table border="1" style="display: inline-table; border-collapse: collapse;"><tr><td style="text-align: center;">10.53</td><td style="text-align: left;">cfs</td></tr></table>	10.53	cfs
10.53	cfs		
<u>Calculation of Normal Flow Condition</u>			
Half Central Angle ($0 < \theta < 3.14$)	Theta = <table border="1" style="display: inline-table; border-collapse: collapse;"><tr><td style="text-align: center;">1.88</td><td style="text-align: left;">radians</td></tr></table>	1.88	radians
1.88	radians		
Flow area	An = <table border="1" style="display: inline-table; border-collapse: collapse;"><tr><td style="text-align: center;">1.22</td><td style="text-align: left;">sq ft</td></tr></table>	1.22	sq ft
1.22	sq ft		
Top width	Tn = <table border="1" style="display: inline-table; border-collapse: collapse;"><tr><td style="text-align: center;">1.43</td><td></td></tr></table>	1.43	
1.43			
Wetted perimeter	Pn = <table border="1" style="display: inline-table; border-collapse: collapse;"><tr><td style="text-align: center;">2.82</td><td style="text-align: left;">ft</td></tr></table>	2.82	ft
2.82	ft		
Flow depth	Yn = <table border="1" style="display: inline-table; border-collapse: collapse;"><tr><td style="text-align: center;">0.98</td><td style="text-align: left;">ft</td></tr></table>	0.98	ft
0.98	ft		
Flow velocity	Vn = <table border="1" style="display: inline-table; border-collapse: collapse;"><tr><td style="text-align: center;">6.56</td><td style="text-align: left;">fps</td></tr></table>	6.56	fps
6.56	fps		
Discharge	Qn = <table border="1" style="display: inline-table; border-collapse: collapse;"><tr><td style="text-align: center;">8.00</td><td style="text-align: left;">cfs</td></tr></table>	8.00	cfs
8.00	cfs		
Percent of Full Flow	Flow = <table border="1" style="display: inline-table; border-collapse: collapse;"><tr><td style="text-align: center;">76.0%</td><td style="text-align: left;">of full flow</td></tr></table>	76.0%	of full flow
76.0%	of full flow		
Normal Depth Froude Number	Fr _n = <table border="1" style="display: inline-table; border-collapse: collapse;"><tr><td style="text-align: center;">1.25</td><td style="text-align: left;">supercritical</td></tr></table>	1.25	supercritical
1.25	supercritical		
<u>Calculation of Critical Flow Condition</u>			
Half Central Angle ($0 < \theta_c < 3.14$)	Theta-c = <table border="1" style="display: inline-table; border-collapse: collapse;"><tr><td style="text-align: center;">2.05</td><td style="text-align: left;">radians</td></tr></table>	2.05	radians
2.05	radians		
Critical flow area	Ac = <table border="1" style="display: inline-table; border-collapse: collapse;"><tr><td style="text-align: center;">1.38</td><td style="text-align: left;">sq ft</td></tr></table>	1.38	sq ft
1.38	sq ft		
Critical top width	Tc = <table border="1" style="display: inline-table; border-collapse: collapse;"><tr><td style="text-align: center;">1.33</td><td style="text-align: left;">ft</td></tr></table>	1.33	ft
1.33	ft		
Critical flow depth	Yc = <table border="1" style="display: inline-table; border-collapse: collapse;"><tr><td style="text-align: center;">1.10</td><td style="text-align: left;">ft</td></tr></table>	1.10	ft
1.10	ft		
Critical flow velocity	Vc = <table border="1" style="display: inline-table; border-collapse: collapse;"><tr><td style="text-align: center;">5.78</td><td style="text-align: left;">fps</td></tr></table>	5.78	fps
5.78	fps		
Critical Depth Froude Number	Fr _c = <table border="1" style="display: inline-table; border-collapse: collapse;"><tr><td style="text-align: center;">1.00</td><td></td></tr></table>	1.00	
1.00			

CIRCULAR CONDUIT FLOW (Normal & Critical Depth Computation)

MHFD-Culvert, Version 4.00 (May 2020)

Project: **MONUMENT JUNCTION DEVELOPMENT - HWY. 105 & JCP INT. IMPS.**

Pipe ID: **Pipe Run 4**

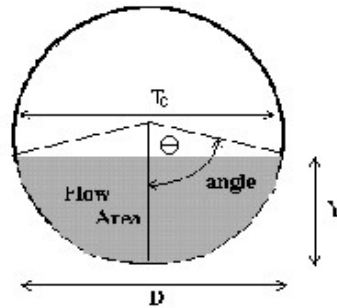


Design Information (Input)	
Pipe Invert Slope	So = 0.0763 ft/ft
Pipe Manning's n-value	n = 0.0130
Pipe Diameter	D = 24.00 inches
Design discharge	Q = 14.00 cfs
Full-Flow Capacity (Calculated)	
Full-flow area	Af = 3.14 sq ft
Full-flow wetted perimeter	Pf = 6.28 ft
Half Central Angle	Theta = 3.14 radians
Full-flow capacity	Qf = 62.66 cfs
Calculation of Normal Flow Condition	
Half Central Angle ($0 < \theta < 3.14$)	Theta = 1.21 radians
Flow area	An = 0.87 sq ft
Top width	Tn = 1.87 ft
Wetted perimeter	Pn = 2.41 ft
Flow depth	Yn = 0.64 ft
Flow velocity	Vn = 16.07 fps
Discharge	Qn = 14.00 cfs
Percent of Full Flow	Flow = 22.3% of full flow
Normal Depth Froude Number	Fr _n = 4.15 supercritical
Calculation of Critical Flow Condition	
Half Central Angle ($0 < \theta_c < 3.14$)	Theta-c = 1.93 radians
Critical flow area	Ac = 2.25 sq ft
Critical top width	Tc = 1.88 ft
Critical flow depth	Yc = 1.35 ft
Critical flow velocity	Vc = 6.22 fps
Critical Depth Froude Number	Fr _c = 1.00

CIRCULAR CONDUIT FLOW (Normal & Critical Depth Computation)

MHFD-Culvert, Version 4.00 (May 2020)

Project: **MONUMENT JUNCTION DEVELOPMENT - HWY. 105 & JCP INT. IMPS.**

Pipe ID: **Pipe Run 5**

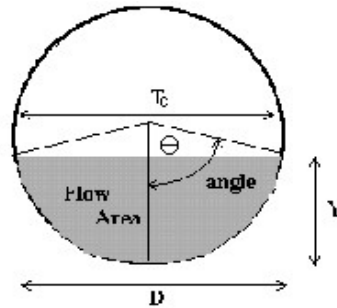


Design Information (Input)	
Pipe Invert Slope	So = 0.0448 ft/ft
Pipe Manning's n-value	n = 0.0130
Pipe Diameter	D = 18.00 inches
Design discharge	Q = 8.00 cfs
Full-Flow Capacity (Calculated)	
Full-flow area	Af = 1.77 sq ft
Full-flow wetted perimeter	Pf = 4.71 ft
Half Central Angle	Theta = 3.14 radians
Full-flow capacity	Qf = 22.29 cfs
Calculation of Normal Flow Condition	
Half Central Angle ($0 < \text{Theta} < 3.14$)	Theta = 1.40 radians
Flow area	An = 0.69 sq ft
Top width	Tn = 1.48 ft
Wetted perimeter	Pn = 2.10 ft
Flow depth	Yn = 0.62 ft
Flow velocity	Vn = 11.58 fps
Discharge	Qn = 8.00 cfs
Percent of Full Flow	Flow = 35.9% of full flow
Normal Depth Froude Number	Fr _n = 2.98 supercritical
Calculation of Critical Flow Condition	
Half Central Angle ($0 < \text{Theta-c} < 3.14$)	Theta-c = 2.05 radians
Critical flow area	Ac = 1.38 sq ft
Critical top width	Tc = 1.33 ft
Critical flow depth	Yc = 1.10 ft
Critical flow velocity	Vc = 5.78 fps
Critical Depth Froude Number	Fr _c = 1.00

CIRCULAR CONDUIT FLOW (Normal & Critical Depth Computation)

MHFD-Culvert, Version 4.00 (May 2020)

Project: **MONUMENT JUNCTION DEVELOPMENT - HWY. 105 & JCP INT. IMPS.**

Pipe ID: **Pipe Run 6**

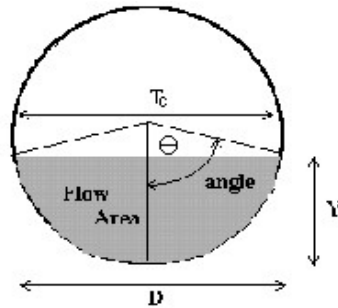


Design Information (Input)	
Pipe Invert Slope	So = 0.0307 ft/ft
Pipe Manning's n-value	n = 0.0130
Pipe Diameter	D = 24.00 inches
Design discharge	Q = 17.00 cfs
Full-Flow Capacity (Calculated)	
Full-flow area	Af = 3.14 sq ft
Full-flow wetted perimeter	Pf = 6.28 ft
Half Central Angle	Theta = 3.14 radians
Full-flow capacity	Qf = 39.74 cfs
Calculation of Normal Flow Condition	
Half Central Angle ($0 < \theta < 3.14$)	Theta = 1.48 radians
Flow area	An = 1.40 sq ft
Top width	Tn = 1.99 ft
Wetted perimeter	Pn = 2.97 ft
Flow depth	Yn = 0.91 ft
Flow velocity	Vn = 12.16 fps
Discharge	Qn = 17.00 cfs
Percent of Full Flow	Flow = 42.8% of full flow
Normal Depth Froude Number	Fr _n = 2.56 supercritical
Calculation of Critical Flow Condition	
Half Central Angle ($0 < \theta_c < 3.14$)	Theta-c = 2.08 radians
Critical flow area	Ac = 2.50 sq ft
Critical top width	Tc = 1.75 ft
Critical flow depth	Yc = 1.49 ft
Critical flow velocity	Vc = 6.79 fps
Critical Depth Froude Number	Fr _c = 1.00

CIRCULAR CONDUIT FLOW (Normal & Critical Depth Computation)

MHFD-Culvert, Version 4.00 (May 2020)

Project: **MONUMENT JUNCTION DEVELOPMENT - HWY. 105 & JCP INT. IMPS.**

Pipe ID: **Pipe Run 7**

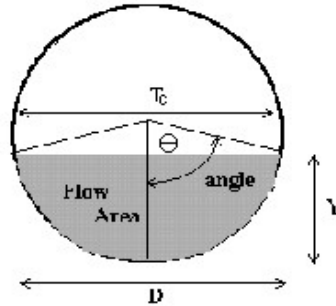

Design Information (Input)	
Pipe Invert Slope	So = 0.1140 ft/ft
Pipe Manning's n-value	n = 0.0130
Pipe Diameter	D = 24.00 inches
Design discharge	Q = 20.00 cfs
Full-Flow Capacity (Calculated)	
Full-flow area	Af = 3.14 sq ft
Full-flow wetted perimeter	Pf = 6.28 ft
Half Central Angle	Theta = 3.14 radians
Full-flow capacity	Qf = 76.59 cfs
Calculation of Normal Flow Condition	
Half Central Angle ($0 < \theta < 3.14$)	Theta = 1.26 radians
Flow area	An = 0.98 sq ft
Top width	Tn = 1.91 ft
Wetted perimeter	Pn = 2.53 ft
Flow depth	Yn = 0.70 ft
Flow velocity	Vn = 20.51 fps
Discharge	Qn = 20.00 cfs
Percent of Full Flow	Flow = 26.1% of full flow
Normal Depth Froude Number	Fr _n = 5.05 supercritical
Calculation of Critical Flow Condition	
Half Central Angle ($0 < \theta_c < 3.14$)	Theta-c = 2.22 radians
Critical flow area	Ac = 2.70 sq ft
Critical top width	Tc = 1.59 ft
Critical flow depth	Yc = 1.61 ft
Critical flow velocity	Vc = 7.40 fps
Critical Depth Froude Number	Fr _c = 1.00


Per ECM section 3.3.1.J.8 maximum storm sewer velocity is 18 fps. Please revise

CIRCULAR CONDUIT FLOW (Normal & Critical Depth Computation)

MHFD-Culvert, Version 4.00 (May 2020)

Project: MONUMENT JUNCTION DEVELOPMENT - HWY. 105 & JCP INT. IMPS.

Pipe ID: Pipe Run 8

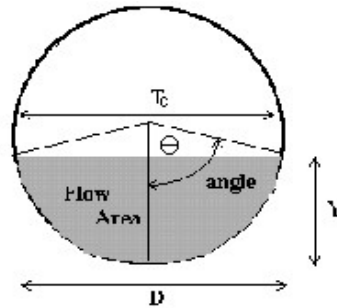


<u>Design Information (Input)</u>	
Pipe Invert Slope	So = 0.0065 ft/ft
Pipe Manning's n-value	n = 0.0130
Pipe Diameter	D = 30.00 inches
Design discharge	Q = 32.00 cfs
<u>Full-Flow Capacity (Calculated)</u>	
Full-flow area	Af = 4.91 sq ft
Full-flow wetted perimeter	Pf = 7.85 ft
Half Central Angle	Theta = 3.14 radians
Full-flow capacity	Qf = 33.16 cfs
<u>Calculation of Normal Flow Condition</u>	
Half Central Angle ($0 < \text{Theta} < 3.14$)	Theta = 2.19 radians
Flow area	An = 4.16 sq ft
Top width	Tn = 2.04 ft
Wetted perimeter	Pn = 5.47 ft
Flow depth	Yn = 1.97 ft
Flow velocity	Vn = 7.69 fps
Discharge	Qn = 32.00 cfs
Percent of Full Flow	Flow = 96.5% of full flow
Normal Depth Froude Number	Fr _n = 0.95 subcritical
<u>Calculation of Critical Flow Condition</u>	
Half Central Angle ($0 < \text{Theta-c} < 3.14$)	Theta-c = 2.14 radians
Critical flow area	Ac = 4.06 sq ft
Critical top width	Tc = 2.10 ft
Critical flow depth	Yc = 1.93 ft
Critical flow velocity	Vc = 7.88 fps
Critical Depth Froude Number	Fr _c = 1.00

CIRCULAR CONDUIT FLOW (Normal & Critical Depth Computation)

MHFD-Culvert, Version 4.00 (May 2020)

Project: MONUMENT JUNCTION DEVELOPMENT - HWY. 105 & JCP INT. IMPS.

Pipe ID: Pipe Run 9

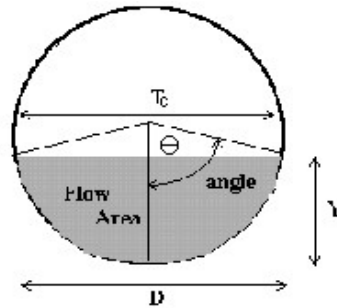


<u>Design Information (Input)</u>			
Pipe Invert Slope	So = <table border="1" style="display: inline-table; border-collapse: collapse;"><tr><td style="text-align: center;">0.0100</td><td style="text-align: left;">ft/ft</td></tr></table>	0.0100	ft/ft
0.0100	ft/ft		
Pipe Manning's n-value	n = <table border="1" style="display: inline-table; border-collapse: collapse;"><tr><td style="text-align: center;">0.0130</td><td></td></tr></table>	0.0130	
0.0130			
Pipe Diameter	D = <table border="1" style="display: inline-table; border-collapse: collapse;"><tr><td style="text-align: center;">18.00</td><td style="text-align: left;">inches</td></tr></table>	18.00	inches
18.00	inches		
Design discharge	Q = <table border="1" style="display: inline-table; border-collapse: collapse;"><tr><td style="text-align: center;">5.00</td><td style="text-align: left;">cfs</td></tr></table>	5.00	cfs
5.00	cfs		
<u>Full-Flow Capacity (Calculated)</u>			
Full-flow area	Af = <table border="1" style="display: inline-table; border-collapse: collapse;"><tr><td style="text-align: center;">1.77</td><td style="text-align: left;">sq ft</td></tr></table>	1.77	sq ft
1.77	sq ft		
Full-flow wetted perimeter	Pf = <table border="1" style="display: inline-table; border-collapse: collapse;"><tr><td style="text-align: center;">4.71</td><td></td></tr></table>	4.71	
4.71			
Half Central Angle	Theta = <table border="1" style="display: inline-table; border-collapse: collapse;"><tr><td style="text-align: center;">3.14</td><td style="text-align: left;">radians</td></tr></table>	3.14	radians
3.14	radians		
Full-flow capacity	Qf = <table border="1" style="display: inline-table; border-collapse: collapse;"><tr><td style="text-align: center;">10.53</td><td style="text-align: left;">cfs</td></tr></table>	10.53	cfs
10.53	cfs		
<u>Calculation of Normal Flow Condition</u>			
Half Central Angle ($0 < \text{Theta} < 3.14$)	Theta = <table border="1" style="display: inline-table; border-collapse: collapse;"><tr><td style="text-align: center;">1.54</td><td style="text-align: left;">radians</td></tr></table>	1.54	radians
1.54	radians		
Flow area	An = <table border="1" style="display: inline-table; border-collapse: collapse;"><tr><td style="text-align: center;">0.85</td><td style="text-align: left;">sq ft</td></tr></table>	0.85	sq ft
0.85	sq ft		
Top width	Tn = <table border="1" style="display: inline-table; border-collapse: collapse;"><tr><td style="text-align: center;">1.50</td><td></td></tr></table>	1.50	
1.50			
Wetted perimeter	Pn = <table border="1" style="display: inline-table; border-collapse: collapse;"><tr><td style="text-align: center;">2.31</td><td style="text-align: left;">ft</td></tr></table>	2.31	ft
2.31	ft		
Flow depth	Yn = <table border="1" style="display: inline-table; border-collapse: collapse;"><tr><td style="text-align: center;">0.73</td><td style="text-align: left;">ft</td></tr></table>	0.73	ft
0.73	ft		
Flow velocity	Vn = <table border="1" style="display: inline-table; border-collapse: collapse;"><tr><td style="text-align: center;">5.88</td><td style="text-align: left;">fps</td></tr></table>	5.88	fps
5.88	fps		
Discharge	Qn = <table border="1" style="display: inline-table; border-collapse: collapse;"><tr><td style="text-align: center;">5.00</td><td style="text-align: left;">cfs</td></tr></table>	5.00	cfs
5.00	cfs		
Percent of Full Flow	Flow = <table border="1" style="display: inline-table; border-collapse: collapse;"><tr><td style="text-align: center;">47.5%</td><td style="text-align: left;">of full flow</td></tr></table>	47.5%	of full flow
47.5%	of full flow		
Normal Depth Froude Number	Fr _n = <table border="1" style="display: inline-table; border-collapse: collapse;"><tr><td style="text-align: center;">1.38</td><td style="text-align: left;">supercritical</td></tr></table>	1.38	supercritical
1.38	supercritical		
<u>Calculation of Critical Flow Condition</u>			
Half Central Angle ($0 < \text{Theta-c} < 3.14$)	Theta-c = <table border="1" style="display: inline-table; border-collapse: collapse;"><tr><td style="text-align: center;">1.72</td><td style="text-align: left;">radians</td></tr></table>	1.72	radians
1.72	radians		
Critical flow area	Ac = <table border="1" style="display: inline-table; border-collapse: collapse;"><tr><td style="text-align: center;">1.05</td><td style="text-align: left;">sq ft</td></tr></table>	1.05	sq ft
1.05	sq ft		
Critical top width	Tc = <table border="1" style="display: inline-table; border-collapse: collapse;"><tr><td style="text-align: center;">1.48</td><td style="text-align: left;">ft</td></tr></table>	1.48	ft
1.48	ft		
Critical flow depth	Yc = <table border="1" style="display: inline-table; border-collapse: collapse;"><tr><td style="text-align: center;">0.86</td><td style="text-align: left;">ft</td></tr></table>	0.86	ft
0.86	ft		
Critical flow velocity	Vc = <table border="1" style="display: inline-table; border-collapse: collapse;"><tr><td style="text-align: center;">4.77</td><td style="text-align: left;">fps</td></tr></table>	4.77	fps
4.77	fps		
Critical Depth Froude Number	Fr _c = <table border="1" style="display: inline-table; border-collapse: collapse;"><tr><td style="text-align: center;">1.00</td><td></td></tr></table>	1.00	
1.00			

CIRCULAR CONDUIT FLOW (Normal & Critical Depth Computation)

MHFD-Culvert, Version 4.00 (May 2020)

Project: **MONUMENT JUNCTION DEVELOPMENT - HWY. 105 & JCP INT. IMPS.**

Pipe ID: **Pipe Run 10**

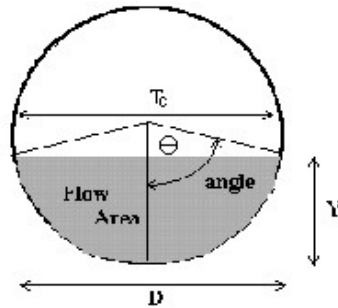


Design Information (Input)	
Pipe Invert Slope	So = 0.0080 ft/ft
Pipe Manning's n-value	n = 0.0130
Pipe Diameter	D = 30.00 inches
Design discharge	Q = 36.00 cfs
Full-Flow Capacity (Calculated)	
Full-flow area	Af = 4.91 sq ft
Full-flow wetted perimeter	Pf = 7.85 ft
Half Central Angle	Theta = 3.14 radians
Full-flow capacity	Qf = 36.79 cfs
Calculation of Normal Flow Condition	
Half Central Angle ($0 < \theta < 3.14$)	Theta = 2.22 radians
Flow area	An = 4.21 sq ft
Top width	Tn = 2.00 ft
Wetted perimeter	Pn = 5.54 ft
Flow depth	Yn = 2.00 ft
Flow velocity	Vn = 8.54 fps
Discharge	Qn = 36.00 cfs
Percent of Full Flow	Flow = 97.9% of full flow
Normal Depth Froude Number	Fr _n = 1.04 supercritical
Calculation of Critical Flow Condition	
Half Central Angle ($0 < \theta_c < 3.14$)	Theta-c = 2.25 radians
Critical flow area	Ac = 4.28 sq ft
Critical top width	Tc = 1.95 ft
Critical flow depth	Yc = 2.03 ft
Critical flow velocity	Vc = 8.41 fps
Critical Depth Froude Number	Fr _c = 1.00

DETERMINATION OF CULVERT HEADWATER AND OUTLET PROTECTION

MHFD-Culvert, Version 4.00 (May 2020)

Project: MONUMENT JUNCTION - HWY. 105 / JCP INT. IMPROVEMENTS
ID: 30" RCP STORMWATER QUALITY OUTFALL

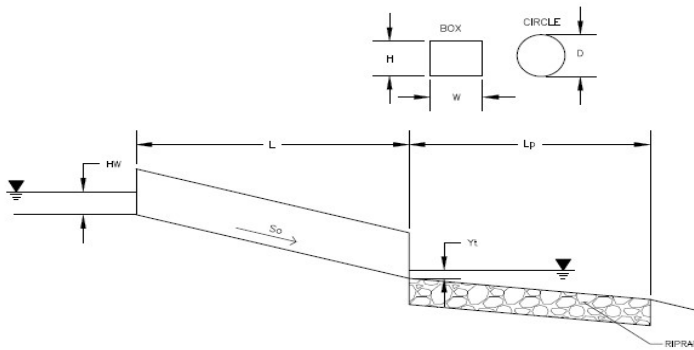

Soil Type:

Choose One:

- Sandy
 Non-Sandy

Design Information:

Design Discharge	Q = <input type="text" value="36"/> cfs
Circular Culvert:	
Barrel Diameter in Inches	D = <input type="text" value="30"/> inches
Inlet Edge Type (Choose from pull-down list)	Square Edge Projecting
OR:	
Box Culvert:	
Barrel Height (Rise) in Feet	H (Rise) = <input type="text"/> ft
Barrel Width (Span) in Feet	W (Span) = <input type="text"/> ft
Inlet Edge Type (Choose from pull-down list)	
Number of Barrels	# Barrels = <input type="text" value="1"/>
Inlet Elevation	Elev IN = <input type="text" value="7013.25"/> ft
Outlet Elevation OR Slope	Elev OUT = <input type="text" value="7012.75"/> ft
Culvert Length	L = <input type="text" value="100"/> ft
Manning's Roughness	n = <input type="text" value="0.013"/>
Bend Loss Coefficient	k_b = <input type="text" value="0"/>
Exit Loss Coefficient	k_x = <input type="text" value="1"/>
Tailwater Surface Elevation	Y_t Elevation = <input type="text"/> ft
Max Allowable Channel Velocity	V = <input type="text" value="7"/> ft/s

Calculated Results:

Culvert Cross Sectional Area Available	A = <input type="text" value="4.91"/> ft ²
Culvert Normal Depth	Y_n = <input type="text" value="2.50"/> ft
Culvert Critical Depth	Y_c = <input type="text" value="2.03"/> ft
Froude Number	Fr = <input type="text" value="-"/> Pressure flow!
Entrance Loss Coefficient	k_e = <input type="text" value="0.20"/>
Friction Loss Coefficient	k_f = <input type="text" value="0.92"/>
Sum of All Loss Coefficients	k_s = <input type="text" value="2.12"/> ft

Headwater:

Inlet Control Headwater	HW _I = <input type="text" value="3.85"/> ft
Outlet Control Headwater	HW _O = <input type="text" value="3.54"/> ft
Design Headwater Elevation	HW = <input type="text" value="7017.10"/> ft
Headwater/Diameter OR Headwater/Rise Ratio	HW/D = <input type="text" value="1.54"/> HW/D > 1.5!

Outlet Protection:


Flow/(Diameter ^{2.5})	Q/D ^{2.5} = <input type="text" value="3.64"/> ft ^{0.5} /s
Tailwater Surface Height	Y_t = <input type="text" value="1.00"/> ft
Tailwater/Diameter	Y_t/D = <input type="text" value="0.40"/>
Expansion Factor	1/(2*tan(θ)) = <input type="text" value="3.82"/>
Flow Area at Max Channel Velocity	A_t = <input type="text" value="5.14"/> ft ²
Width of Equivalent Conduit for Multiple Barrels	W_{eq} = <input type="text" value="-"/> ft
Length of Riprap Protection	L_p = <input type="text" value="11"/> ft
Width of Riprap Protection at Downstream End	T = <input type="text" value="6"/> ft
Adjusted Diameter for Supercritical Flow	Da = <input type="text" value="-"/> ft
Minimum Theoretical Riprap Size	d ₅₀ min = <input type="text" value="8"/> in
Nominal Riprap Size	d ₅₀ nominal = <input type="text" value="9"/> in
MHFD Riprap Type	Type = <input type="text" value="L"/>

CIRCULAR CONDUIT FLOW (Normal & Critical Depth Computation)

MHFD-Culvert, Version 4.00 (May 2020)

Project: MONUMENT JUNCTION DEVELOPMENT - HWY. 105 & JCP INT. IMPS.

Pipe ID: Pipe Run 11

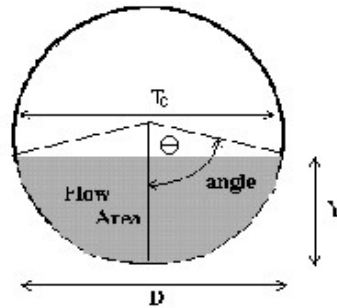


<u>Design Information (Input)</u>			
Pipe Invert Slope	So = <table border="1" style="display: inline-table; border-collapse: collapse;"><tr><td style="text-align: center;">0.0100</td><td style="text-align: left;">ft/ft</td></tr></table>	0.0100	ft/ft
0.0100	ft/ft		
Pipe Manning's n-value	n = <table border="1" style="display: inline-table; border-collapse: collapse;"><tr><td style="text-align: center;">0.0130</td><td></td></tr></table>	0.0130	
0.0130			
Pipe Diameter	D = <table border="1" style="display: inline-table; border-collapse: collapse;"><tr><td style="text-align: center;">18.00</td><td style="text-align: left;">inches</td></tr></table>	18.00	inches
18.00	inches		
Design discharge	Q = <table border="1" style="display: inline-table; border-collapse: collapse;"><tr><td style="text-align: center;">4.00</td><td style="text-align: left;">cfs</td></tr></table>	4.00	cfs
4.00	cfs		
<u>Full-Flow Capacity (Calculated)</u>			
Full-flow area	Af = <table border="1" style="display: inline-table; border-collapse: collapse;"><tr><td style="text-align: center;">1.77</td><td style="text-align: left;">sq ft</td></tr></table>	1.77	sq ft
1.77	sq ft		
Full-flow wetted perimeter	Pf = <table border="1" style="display: inline-table; border-collapse: collapse;"><tr><td style="text-align: center;">4.71</td><td></td></tr></table>	4.71	
4.71			
Half Central Angle	Theta = <table border="1" style="display: inline-table; border-collapse: collapse;"><tr><td style="text-align: center;">3.14</td><td style="text-align: left;">radians</td></tr></table>	3.14	radians
3.14	radians		
Full-flow capacity	Qf = <table border="1" style="display: inline-table; border-collapse: collapse;"><tr><td style="text-align: center;">10.53</td><td style="text-align: left;">cfs</td></tr></table>	10.53	cfs
10.53	cfs		
<u>Calculation of Normal Flow Condition</u>			
Half Central Angle ($0 < \theta < 3.14$)	Theta = <table border="1" style="display: inline-table; border-collapse: collapse;"><tr><td style="text-align: center;">1.42</td><td style="text-align: left;">radians</td></tr></table>	1.42	radians
1.42	radians		
Flow area	An = <table border="1" style="display: inline-table; border-collapse: collapse;"><tr><td style="text-align: center;">0.72</td><td style="text-align: left;">sq ft</td></tr></table>	0.72	sq ft
0.72	sq ft		
Top width	Tn = <table border="1" style="display: inline-table; border-collapse: collapse;"><tr><td style="text-align: center;">1.48</td><td></td></tr></table>	1.48	
1.48			
Wetted perimeter	Pn = <table border="1" style="display: inline-table; border-collapse: collapse;"><tr><td style="text-align: center;">2.14</td><td style="text-align: left;">ft</td></tr></table>	2.14	ft
2.14	ft		
Flow depth	Yn = <table border="1" style="display: inline-table; border-collapse: collapse;"><tr><td style="text-align: center;">0.64</td><td style="text-align: left;">ft</td></tr></table>	0.64	ft
0.64	ft		
Flow velocity	Vn = <table border="1" style="display: inline-table; border-collapse: collapse;"><tr><td style="text-align: center;">5.55</td><td style="text-align: left;">fps</td></tr></table>	5.55	fps
5.55	fps		
Discharge	Qn = <table border="1" style="display: inline-table; border-collapse: collapse;"><tr><td style="text-align: center;">4.00</td><td style="text-align: left;">cfs</td></tr></table>	4.00	cfs
4.00	cfs		
Percent of Full Flow	Flow = <table border="1" style="display: inline-table; border-collapse: collapse;"><tr><td style="text-align: center;">38.0%</td><td style="text-align: left;">of full flow</td></tr></table>	38.0%	of full flow
38.0%	of full flow		
Normal Depth Froude Number	Fr _n = <table border="1" style="display: inline-table; border-collapse: collapse;"><tr><td style="text-align: center;">1.40</td><td style="text-align: left;">supercritical</td></tr></table>	1.40	supercritical
1.40	supercritical		
<u>Calculation of Critical Flow Condition</u>			
Half Central Angle ($0 < \theta_c < 3.14$)	Theta-c = <table border="1" style="display: inline-table; border-collapse: collapse;"><tr><td style="text-align: center;">1.59</td><td style="text-align: left;">radians</td></tr></table>	1.59	radians
1.59	radians		
Critical flow area	Ac = <table border="1" style="display: inline-table; border-collapse: collapse;"><tr><td style="text-align: center;">0.91</td><td style="text-align: left;">sq ft</td></tr></table>	0.91	sq ft
0.91	sq ft		
Critical top width	Tc = <table border="1" style="display: inline-table; border-collapse: collapse;"><tr><td style="text-align: center;">1.50</td><td style="text-align: left;">ft</td></tr></table>	1.50	ft
1.50	ft		
Critical flow depth	Yc = <table border="1" style="display: inline-table; border-collapse: collapse;"><tr><td style="text-align: center;">0.77</td><td style="text-align: left;">ft</td></tr></table>	0.77	ft
0.77	ft		
Critical flow velocity	Vc = <table border="1" style="display: inline-table; border-collapse: collapse;"><tr><td style="text-align: center;">4.41</td><td style="text-align: left;">fps</td></tr></table>	4.41	fps
4.41	fps		
Critical Depth Froude Number	Fr _c = <table border="1" style="display: inline-table; border-collapse: collapse;"><tr><td style="text-align: center;">1.00</td><td></td></tr></table>	1.00	
1.00			

CIRCULAR CONDUIT FLOW (Normal & Critical Depth Computation)

MHFD-Culvert, Version 4.00 (May 2020)

Project: **MONUMENT JUNCTION DEVELOPMENT - HWY. 105 & JCP INT. IMPS.**

Pipe ID: **EXIST. 36" RCP CULVERT**

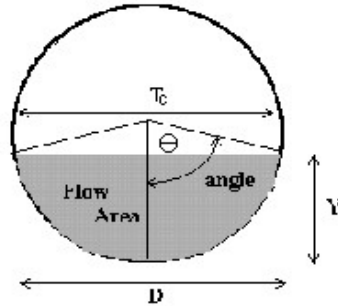


Design Information (Input)	
Pipe Invert Slope	So = 0.0100 ft/ft
Pipe Manning's n-value	n = 0.0130
Pipe Diameter	D = 36.00 inches
Design discharge	Q = 40.00 cfs
Full-Flow Capacity (Calculated)	
Full-flow area	Af = 7.07 sq ft
Full-flow wetted perimeter	Pf = 9.42 ft
Half Central Angle	Theta = 3.14 radians
Full-flow capacity	Qf = 66.88 cfs
Calculation of Normal Flow Condition	
Half Central Angle ($0 < \theta < 3.14$)	Theta = 1.69 radians
Flow area	An = 4.05 sq ft
Top width	Tn = 2.98 ft
Wetted perimeter	Pn = 5.06 ft
Flow depth	Yn = 1.67 ft
Flow velocity	Vn = 9.88 fps
Discharge	Qn = 40.00 cfs
Percent of Full Flow	Flow = 59.8% of full flow
Normal Depth Froude Number	Fr _n = 1.49 supercritical
Calculation of Critical Flow Condition	
Half Central Angle ($0 < \theta_c < 3.14$)	Theta-c = 1.95 radians
Critical flow area	Ac = 5.17 sq ft
Critical top width	Tc = 2.78 ft
Critical flow depth	Yc = 2.06 ft
Critical flow velocity	Vc = 7.73 fps
Critical Depth Froude Number	Fr _c = 1.00

DETERMINATION OF CULVERT HEADWATER AND OUTLET PROTECTION

MHFD-Culvert, Version 4.00 (May 2020)

Project: MONUMENT JUNCTION - HWY. 105 / JCP INT. IMPROVEMENTS

ID: Exist. 36" RCP CDOT Outfall

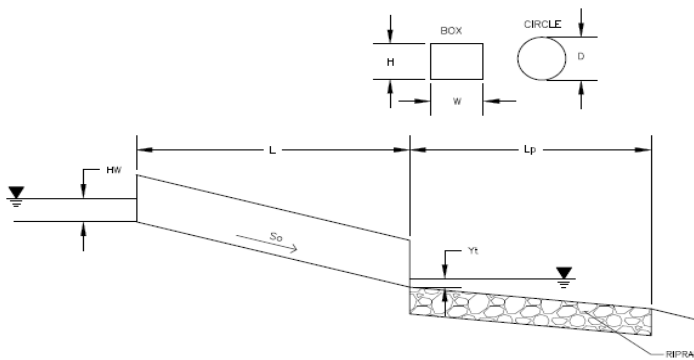

Soil Type:

Choose One:

- Sandy
 Non-Sandy

Supercritical Flow! Using Adjusted Diameter to calculate protection type.

Design Information:

Design Discharge	Q =	25.2	cfs
Circular Culvert:			
Barrel Diameter in Inches	D =	36	inches
Inlet Edge Type (Choose from pull-down list)			Square Edge Projecting
OR:			
Box Culvert:			
Barrel Height (Rise) in Feet	H (Rise) =	OR	ft
Barrel Width (Span) in Feet	W (Span) =	OR	ft
Inlet Edge Type (Choose from pull-down list)			
Number of Barrels	# Barrels =	1	
Inlet Elevation	Elev IN =	7003.8	ft
Outlet Elevation OR Slope	So =	0.01	ft/ft
Culvert Length	L =	116	ft
Manning's Roughness	n =	0.013	
Bend Loss Coefficient	k _b =	0	
Exit Loss Coefficient	k _x =	1	
Tailwater Surface Elevation	Y _t , Elevation =	OR	ft
Max Allowable Channel Velocity	V =	7	ft/s

Calculated Results:

Culvert Cross Sectional Area Available	A =	7.07	ft ²
Culvert Normal Depth	Y _n =	1.28	ft
Culvert Critical Depth	Y _c =	1.62	ft
Froude Number	Fr =	1.58	Supercritical!
Entrance Loss Coefficient	k _e =	0.20	
Friction Loss Coefficient	k _f =	0.83	
Sum of All Loss Coefficients	k _s =	2.03	ft


Headwater:

Inlet Control Headwater	HW _I =	2.40	ft
Outlet Control Headwater	HW _O =	N/A	ft
Design Headwater Elevation	HW =	7006.20	ft
Headwater/Diameter OR Headwater/Rise Ratio	HW/D =	0.80	

Outlet Control Headwater Approximation Method Inaccurate for Low Flow - Backwater Calculations Required

Outlet Protection:

Flow/(Diameter ^{2.5})	Q/D ^{2.5} =	1.62	ft ^{0.5} /s
Tailwater Surface Height	Y _t =	1.20	ft
Tailwater/Diameter	Y _t /D =	0.40	
Expansion Factor	1/(2*tan(Θ)) =	6.11	
Flow Area at Max Channel Velocity	A _t =	3.60	ft ²
Width of Equivalent Conduit for Multiple Barrels	W _{eq} =	-	ft
Length of Riprap Protection	L_p =	9	ft
Width of Riprap Protection at Downstream End	T =	5	ft
Adjusted Diameter for Supercritical Flow	Da =	2.14	ft
Minimum Theoretical Riprap Size	d _{50 min} =	4	in
Nominal Riprap Size	d _{50 nominal} =	6	in
MHFD Riprap Type	Type =	VL	

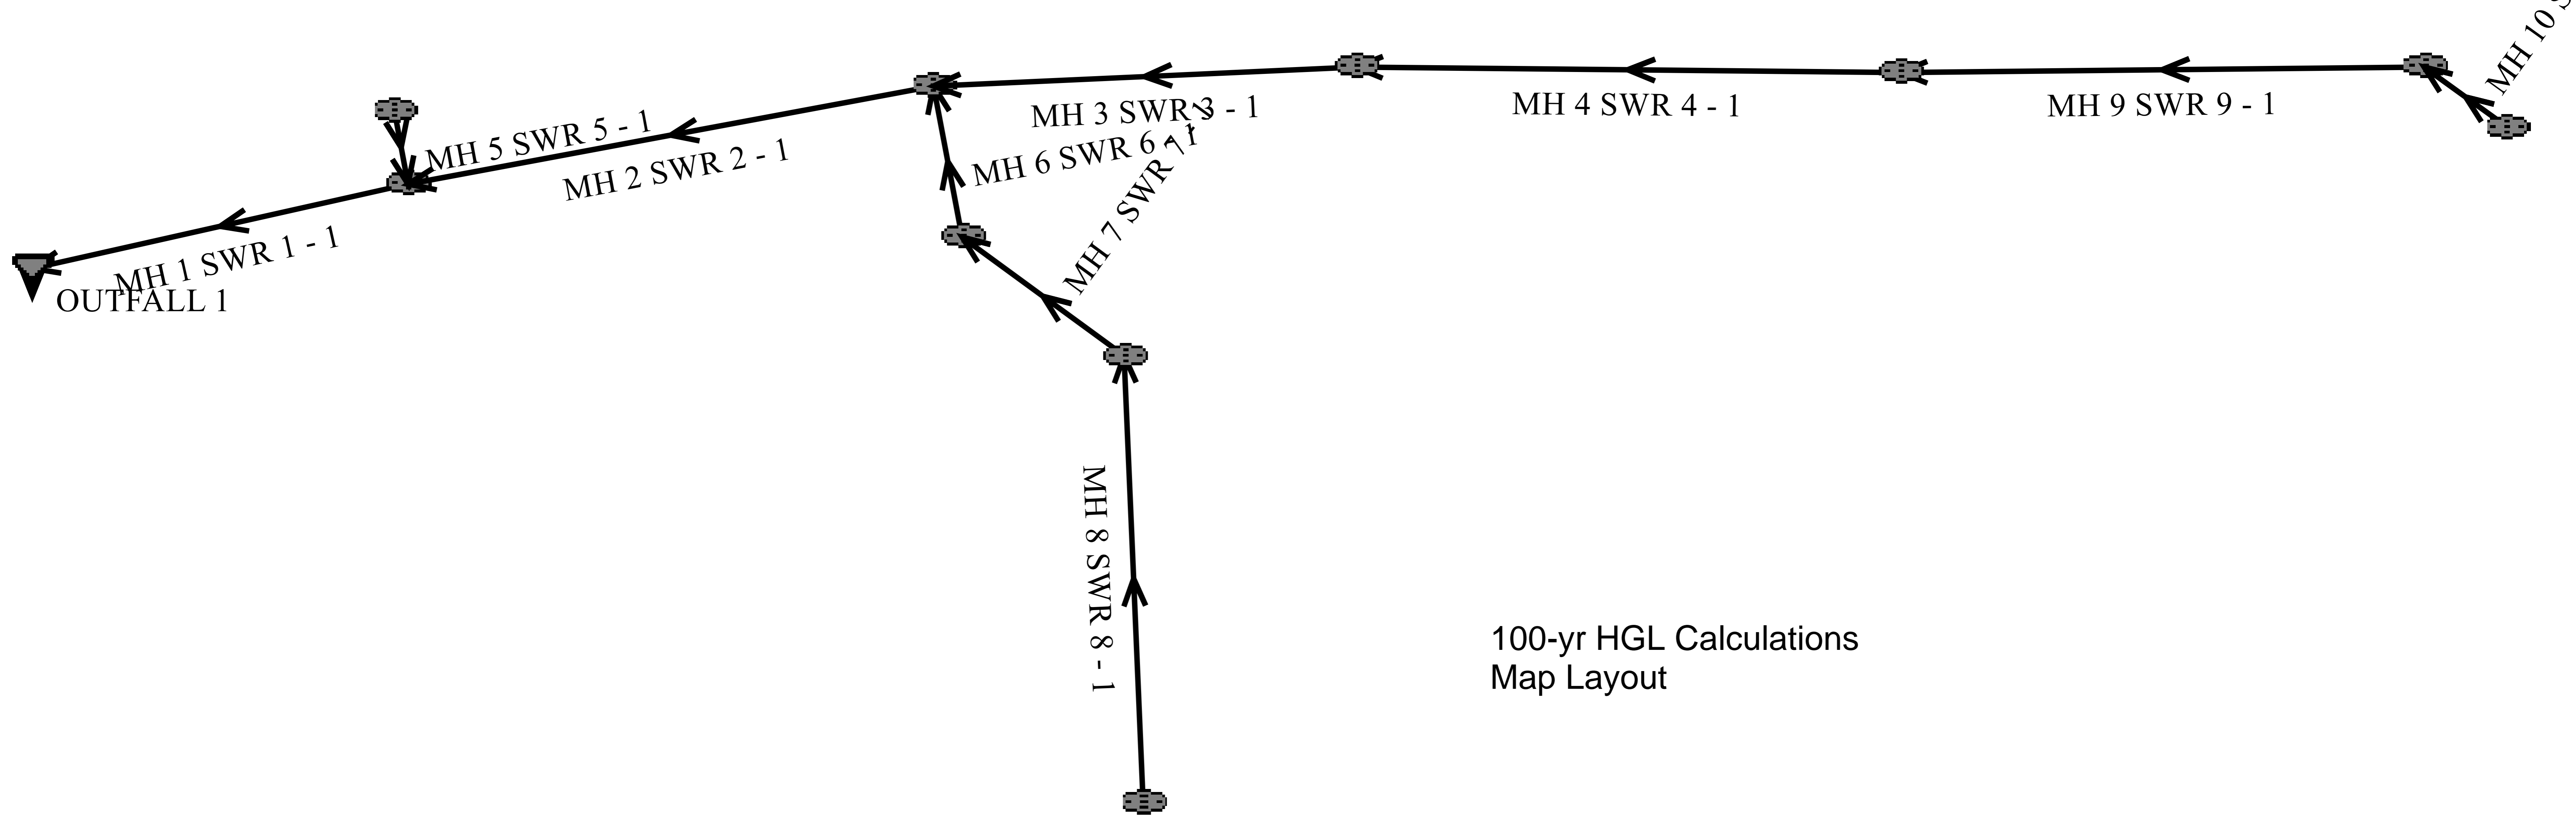

100-yr HGL Calculations
Map Layout

System Input Summary

Rainfall Parameters

Rainfall Return Period: 100

Rainfall Calculation Method: Table

Time	Intensity
5	8.68
10	6.93
20	5.19
30	4.16
40	3.44
60	2.42
120	0.67

Rational Method Constraints

Minimum Urban Runoff Coeff.: 0.20

Maximum Rural Overland Len. (ft): 500

Maximum Urban Overland Len. (ft): 300

Used UDFCD Tc. Maximum: Yes

Sizer Constraints

Minimum Sewer Size (in): 18.00

Maximum Depth to Rise Ratio: 0.90

Manhole Output Summary:

Element Name	Local Contribution					Total Design Flow				Comment
	Overland Time (min)	Gutter Time (min)	Basin Tc (min)	Intensity (in/hr)	Local Contrib (cfs)	Coeff. Area	Intensity (in/hr)	Manhole Tc (min)	Peak Flow (cfs)	
OUTFALL 1	0.00	0.00	0.00	0.00	0.00	54.92	0.66	0.38	36.00	
MH 1 SWR 1 - 1	0.00	0.00	0.00	0.00	0.00	0.00	0.00	0.00	36.00	
MH 5 SWR 5 - 1	0.00	0.00	0.00	0.00	0.00	0.00	0.00	0.00	5.00	
MH 2 SWR 2 - 1	0.00	0.00	0.00	0.00	0.00	0.00	0.00	0.00	32.00	
MH 3 SWR 3 - 1	0.00	0.00	0.00	0.00	0.00	0.00	0.00	0.00	14.00	
MH 4 SWR 4 - 1	0.00	0.00	0.00	0.00	0.00	0.00	0.00	0.00	7.00	
MH 9 SWR 9 - 1	0.00	0.00	0.00	0.00	0.00	0.00	0.00	0.00	2.50	
MH 10 SWR 10 - 1	0.00	0.00	0.00	0.00	0.00	0.00	0.00	0.00	2.50	
MH 6 SWR 6 - 1	0.00	0.00	0.00	0.00	0.00	0.00	0.00	0.00	20.00	
MH 7 SWR 7 - 1	0.00	0.00	0.00	0.00	0.00	0.00	0.00	0.00	17.00	
MH 8 SWR 8 - 1	0.00	0.00	0.00	0.00	0.00	0.00	0.00	0.00	8.00	

Sewer Input Summary:

Element Name	Sewer Length (ft)	Elevation			Loss Coefficients			Given Dimensions		
		Downstream Invert (ft)	Slope (%)	Upstream Invert (ft)	Mannings n	Bend Loss	Lateral Loss	Cross Section	Rise (ft or in)	Span (ft or in)
MH 1 SWR 1 - 1	166.16	7012.75	0.5	7013.58	0.013	0.03	1.00	CIRCULAR	30.00 in	30.00 in

MH 5 SWR 5 - 1	3.17	7014.58	1.0	7014.61	0.013	1.32	0.00	CIRCULAR	18.00 in	18.00 in
MH 2 SWR 2 - 1	256.17	7014.08	0.5	7015.36	0.013	0.05	1.00	CIRCULAR	30.00 in	30.00 in
MH 3 SWR 3 - 1	187.50	7015.87	7.6	7030.16	0.013	0.05	1.00	CIRCULAR	24.00 in	24.00 in
MH 4 SWR 4 - 1	145.36	7030.66	5.7	7038.92	0.013	0.05	1.00	CIRCULAR	18.00 in	18.00 in
MH 9 SWR 9 - 1	275.71	7039.42	5.4	7054.20	0.013	0.83	0.00	CIRCULAR	18.00 in	18.00 in
MH 10 SWR 10 - 1	7.53	7054.70	1.1	7054.78	0.013	0.38	1.00	CIRCULAR	18.00 in	18.00 in
MH 6 SWR 6 - 1	41.85	7015.86	11.4	7020.63	0.013	0.83	1.00	CIRCULAR	24.00 in	24.00 in
MH 7 SWR 7 - 1	69.88	7021.13	3.1	7023.28	0.013	0.94	1.00	CIRCULAR	24.00 in	24.00 in
MH 8 SWR 8 - 1	200.00	7023.78	4.5	7032.73	0.013	0.05	1.00	CIRCULAR	18.00 in	18.00 in

Unresolved:
Per storm profiles in
CD set, pipe size is 24".

Sewer Flow Summary:

Element Name	Full Flow Capacity		Critical Flow		Normal Flow				Flow (cfs)	Surcharged Length (ft)	Comment
	Flow (cfs)	Velocity (fps)	Depth (in)	Velocity (fps)	Depth (in)	Velocity (fps)	Froude Number	Flow Condition			
MH 1 SWR 1 - 1	29.08	5.92	30.00	7.33	30.00	7.33	0.00	Pressurized	36.00	166.16	
MH 5 SWR 5 - 1	10.53	5.96	10.32	4.77	8.73	5.88	1.38	Pressurized	5.00	3.17	
MH 2 SWR 2 - 1	29.08	5.92	30.00	6.52	30.00	6.52	0.00	Pressurized	32.00	256.17	

MH 3 SWR 3 - 1	62.62	19.93	16.17	6.22	7.71	16.06	4.14	Supercritical Jump	14.00	18.03	
MH 4 SWR 4 - 1	25.11	14.21	12.29	5.45	6.50	12.17	3.40	Supercritical	7.00	0.00	
MH 9 SWR 9 - 1	24.39	13.80	7.18	3.80	3.89	8.89	3.28	Supercritical	2.50	0.00	
MH 10 SWR 10 - 1	10.83	6.13	7.18	3.80	5.88	4.98	1.47	Supercritical	2.50	0.00	
MH 6 SWR 6 - 1	76.58	24.38	19.27	7.40	8.37	20.51	5.05	Supercritical Jump	20.00	11.11	Velocity is Too High
MH 7 SWR 7 - 1	39.79	12.66	17.83	6.79	10.96	12.17	2.56	Supercritical	17.00	0.00	
MH 8 SWR 8 - 1	22.28	12.61	13.15	5.78	7.46	11.57	2.98	Supercritical	8.00	0.00	

- A Froude number of 0 indicates that pressurized flow occurs (adverse slope or undersized pipe)
- If the sewer is not pressurized, full flow represents the maximum gravity flow in the sewer.
- If the sewer is pressurized, full flow represents the pressurized flow conditions.

Per ECM section 3.3.1.J.8 maximum storm sewer velocity is 18 fps. Please revise

Sewer Sizing Summary:

Element Name	Peak Flow (cfs)	Cross Section	Existing		Calculated		Used			Comment
			Rise	Span	Rise	Span	Rise	Span	Area (ft ²)	
MH 1 SWR 1 - 1	36.00	CIRCULAR	30.00 in	30.00 in	33.00 in	33.00 in	30.00 in	30.00 in	4.91	Existing height is smaller than the suggested height.

											Existing width is smaller than the suggested width. Exceeds max. Depth/Rise
MH 5 SWR 5 - 1	5.00	CIRCULAR	18.00 in	18.00 in	18.00 in	18.00 in	18.00 in	18.00 in	18.00 in	1.77	
MH 2 SWR 2 - 1	32.00	CIRCULAR	30.00 in	30.00 in	33.00 in	33.00 in	30.00 in	30.00 in	30.00 in	4.91	Existing height is smaller than the suggested height. Existing width is smaller than the suggested width. Exceeds max. Depth/Rise
MH 3 SWR 3 - 1	14.00	CIRCULAR	24.00 in	24.00 in	18.00 in	18.00 in	24.00 in	24.00 in	24.00 in	3.14	
MH 4 SWR 4 - 1	7.00	CIRCULAR	18.00 in	18.00 in	18.00 in	18.00 in	18.00 in	18.00 in	18.00 in	1.77	
MH 9 SWR 9 - 1	2.50	CIRCULAR	18.00 in	18.00 in	18.00 in	18.00 in	18.00 in	18.00 in	18.00 in	1.77	
MH 10 SWR 10 - 1	2.50	CIRCULAR	18.00 in	18.00 in	18.00 in	18.00 in	18.00 in	18.00 in	18.00 in	1.77	
MH 6 SWR 6 - 1	20.00	CIRCULAR	24.00 in	24.00 in	18.00 in	18.00 in	24.00 in	24.00 in	24.00 in	3.14	
MH 7 SWR 7 - 1	17.00	CIRCULAR	24.00 in	24.00 in	18.00 in	18.00 in	24.00 in	24.00 in	24.00 in	3.14	
MH 8 SWR 8 - 1	8.00	CIRCULAR	18.00 in	18.00 in	18.00 in	18.00 in	18.00 in	18.00 in	18.00 in	1.77	

- Calculated diameter was determined by sewer hydraulic capacity rounded up to the nearest commercially available size.
 - Sewer sizes should not decrease downstream.
 - All hydraulics were calculated using the 'Used' parameters.
-

Grade Line Summary:

Tailwater Elevation (ft): 7013.75

Element Name	Invert Elev.		Downstream Manhole Losses		HGL		EGL		
	Downstream (ft)	Upstream (ft)	Bend Loss (ft)	Lateral Loss (ft)	Downstream (ft)	Upstream (ft)	Downstream (ft)	Friction Loss (ft)	Upstream (ft)
MH 1 SWR 1 - 1	7012.75	7013.58	0.00	0.00	7015.25	7016.52	7016.08	1.27	7017.36
MH 5 SWR 5 - 1	7014.58	7014.61	0.16	0.00	7017.40	7017.40	7017.52	0.01	7017.53
MH 2 SWR 2 - 1	7014.08	7015.36	0.03	0.18	7016.91	7018.46	7017.57	1.55	7019.12
MH 3 SWR 3 - 1	7015.87	7030.16	0.02	0.35	7019.18	7031.51	7019.48	12.62	7032.11
MH 4 SWR 4 - 1	7030.66	7038.92	0.01	0.06	7031.58	7039.94	7033.50	6.90	7040.40
MH 9 SWR 9 - 1	7039.42	7054.20	0.03	0.00	7039.97	7054.80	7040.97	14.05	7055.02
MH 10 SWR 10 - 1	7054.70	7054.78	0.01	0.00	7055.19	7055.38	7055.58	0.03	7055.60
MH 6 SWR 6 - 1	7015.86	7020.63	0.52	0.03	7019.04	7022.24	7019.67	3.42	7023.09
MH 7 SWR 7 - 1	7021.13	7023.28	0.43	0.17	7022.84	7024.77	7024.34	1.14	7025.48
MH 8 SWR 8 - 1	7023.78	7032.73	0.02	0.14	7024.92	7033.83	7026.48	7.87	7034.35

- Bend and Lateral losses only apply when there is an outgoing sewer. The system outfall, sewer #0, is not considered a sewer.
- Bend loss = Bend K * V_{fi} ^ 2 / (2 * g)
- Lateral loss = V_{fo} ^ 2 / (2 * g) - Junction Loss K * V_{fi} ^ 2 / (2 * g).
- Friction loss is always Upstream EGL - Downstream EGL.

STORMWATER QUALITY CALCULATIONS



Design Procedure Form: Extended Detention Basin (EDB)

UD-BMP (Version 3.07, March 2018)

Sheet 1 of 3

Designer: Marc A. Whorton, P.E.
Company: Classic Consulting
Date: July 20, 2023
Project: Monument Junction Development - Hwy. 105 & JCP Int. Imps.
Location: SWQ Facility in CDOT ROW

<p>1. Basin Storage Volume</p> <p>A) Effective Imperviousness of Tributary Area, I_a</p> <p>B) Tributary Area's Imperviousness Ratio ($i = I_a / 100$)</p> <p>C) Contributing Watershed Area</p> <p>D) For Watersheds Outside of the Denver Region, Depth of Average Runoff Producing Storm</p> <p>E) Design Concept (Select EURV when also designing for flood control)</p> <p>F) Design Volume (WQCV) Based on 40-hour Drain Time ($V_{DESIGN} = (1.0 * (0.91 * i^3 - 1.19 * i^2 + 0.78 * i) / 12 * Area)$)</p> <p>G) For Watersheds Outside of the Denver Region, Water Quality Capture Volume (WQCV) Design Volume ($V_{WQCV\ OTHER} = (d_6 * V_{DESIGN} / 0.43)$)</p> <p>H) User Input of Water Quality Capture Volume (WQCV) Design Volume (Only if a different WQCV Design Volume is desired)</p> <p>I) NRCS Hydrologic Soil Groups of Tributary Watershed i) Percentage of Watershed consisting of Type A Soils ii) Percentage of Watershed consisting of Type B Soils iii) Percentage of Watershed consisting of Type C/D Soils</p> <p>J) Excess Urban Runoff Volume (EURV) Design Volume For HSG A: $EURV_A = 1.68 * i^{1.28}$ For HSG B: $EURV_B = 1.36 * i^{1.08}$ For HSG C/D: $EURV_{C/D} = 1.20 * i^{1.08}$</p> <p>K) User Input of Excess Urban Runoff Volume (EURV) Design Volume (Only if a different EURV Design Volume is desired)</p>	<p>$I_a =$ <input type="text" value="53.6"/> %</p> <p>$i =$ <input type="text" value="0.536"/></p> <p>Area = <input type="text" value="11.840"/> ac</p> <p>$d_6 =$ <input type="text" value="0.42"/> in</p> <div style="border: 1px solid black; padding: 5px; margin: 5px 0;"> <p>Choose One</p> <p><input checked="" type="radio"/> Water Quality Capture Volume (WQCV)</p> <p><input type="radio"/> Excess Urban Runoff Volume (EURV)</p> </div> <p>$V_{DESIGN} =$ <input type="text"/> ac-ft</p> <p>$V_{DESIGN\ OTHER} =$ <input type="text"/> ac-ft</p> <p>$V_{DESIGN\ USER} =$ <input type="text" value="0.121"/> ac-ft</p> <p>HSG _A = <input type="text"/> %</p> <p>HSG _B = <input type="text"/> %</p> <p>HSG _{C/D} = <input type="text"/> %</p> <p>$EURV_{DESIGN} =$ <input type="text"/> ac-ft</p> <p>$EURV_{DESIGN\ USER} =$ <input type="text"/> ac-ft</p>
<p>2. Basin Shape: Length to Width Ratio (A basin length to width ratio of at least 2:1 will improve TSS reduction.)</p>	<p>L : W = <input type="text" value="2.0"/> : 1</p>
<p>3. Basin Side Slopes</p> <p>A) Basin Maximum Side Slopes (Horizontal distance per unit vertical, 4:1 or flatter preferred)</p>	<p>Z = <input type="text" value="3.00"/> ft / ft</p> <p align="center">DIFFICULT TO MAINTAIN, INCREASE WHERE POSSIBLE</p>
<p>4. Inlet</p> <p>A) Describe means of providing energy dissipation at concentrated inflow locations:</p>	<p>Concrete Forebay</p> <hr/> <hr/> <hr/>
<p>5. Forebay</p> <p>A) Minimum Forebay Volume ($V_{FMIN} =$ <input type="text" value="3%"/> of the WQCV)</p> <p>B) Actual Forebay Volume</p> <p>C) Forebay Depth ($D_F =$ <input type="text" value="18"/> inch maximum)</p> <p>D) Forebay Discharge</p> <p>i) Undetained 100-year Peak Discharge</p> <p>ii) Forebay Discharge Design Flow ($Q_F = 0.02 * Q_{100}$)</p> <p>E) Forebay Discharge Design</p> <p>F) Discharge Pipe Size (minimum 8-inches)</p> <p>G) Rectangular Notch Width</p>	<p>$V_{FMIN} =$ <input type="text" value="0.004"/> ac-ft</p> <p>$V_F =$ <input type="text" value="0.004"/> ac-ft</p> <p>$D_F =$ <input type="text" value="18.0"/> in</p> <p>$Q_{100} =$ <input type="text" value="36.00"/> cfs</p> <p>$Q_F =$ <input type="text" value="0.72"/> cfs</p> <div style="border: 1px solid black; padding: 5px; margin: 5px 0;"> <p>Choose One</p> <p><input type="radio"/> Berm With Pipe</p> <p><input checked="" type="radio"/> Wall with Rect. Notch</p> <p><input type="radio"/> Wall with V-Notch Weir</p> </div> <p align="right" style="color: blue;">Flow too small for berm w/ pipe</p> <p>Calculated $D_P =$ <input type="text"/> in</p> <p>Calculated $W_N =$ <input type="text" value="5.0"/> in</p>

Design Procedure Form: Extended Detention Basin (EDB)

Designer: Marc A. Whorton, P.E.
Company: Classic Consulting
Date: July 20, 2023
Project: Monument Junction Development - Hwy. 105 & JCP Int. Imps.
Location: SWQ Facility in CDOT ROW

<p>6. Trickle Channel</p> <p>A) Type of Trickle Channel</p> <p>F) Slope of Trickle Channel</p>	<div style="border: 1px solid black; padding: 2px; margin-bottom: 5px;"> Choose One <input type="radio"/> Concrete <input checked="" type="radio"/> Soft Bottom </div> <p style="color: blue; font-size: small;">PROVIDE A CONSISTENT LONGITUDINAL SLOPE FROM FOREBAY TO MICROPOOL WITH NO MEANDERING. RIPRAP AND SOIL RIPRAP LINED CHANNELS ARE NOT RECOMMENDED. MINIMUM DEPTH OF 1.5 FEET</p> <p>S = <input style="width: 50px;" type="text" value="0.0200"/> ft / ft</p>
<p>7. Micropool and Outlet Structure</p> <p>A) Depth of Micropool (2.5-foot minimum)</p> <p>B) Surface Area of Micropool (10 ft² minimum)</p> <p>C) Outlet Type</p> <p>D) Smallest Dimension of Orifice Opening Based on Hydrograph Routing (Use UD-Detention)</p> <p>E) Total Outlet Area</p>	<p>D_M = <input style="width: 50px;" type="text" value="2.5"/> ft</p> <p>A_M = <input style="width: 50px;" type="text" value="48"/> sq ft</p> <div style="border: 1px solid black; padding: 2px; margin-bottom: 5px;"> Choose One <input checked="" type="radio"/> Orifice Plate <input type="radio"/> Other (Describe): </div> <hr/> <hr/> <p>D_{orifice} = <input style="width: 50px;" type="text" value="1.19"/> inches</p> <p>A_{orifice} = <input style="width: 50px;" type="text" value="4.36"/> square inches</p>
<p>8. Initial Surcharge Volume</p> <p>A) Depth of Initial Surcharge Volume (Minimum recommended depth is 4 inches)</p> <p>B) Minimum Initial Surcharge Volume (Minimum volume of 0.3% of the WQCV)</p> <p>C) Initial Surcharge Provided Above Micropool</p>	<p>D_{IS} = <input style="width: 50px;" type="text" value="6"/> in</p> <p>V_{IS} = <input style="width: 50px;" type="text" value="16"/> cu ft</p> <p>V_s = <input style="width: 50px;" type="text" value="24.0"/> cu ft</p>
<p>9. Trash Rack</p> <p>A) Water Quality Screen Open Area: $A_t = A_{ot} * 38.5 * (e^{-0.095D})$</p> <p>B) Type of Screen (If specifying an alternative to the materials recommended in the USDCM, indicate "other" and enter the ratio of the total open area to the total screen area for the material specified.)</p> <p style="text-align: center;">Other (Y/N): <input style="width: 50px;" type="text" value="N"/></p> <p>C) Ratio of Total Open Area to Total Area (only for type 'Other')</p> <p>D) Total Water Quality Screen Area (based on screen type)</p> <p>E) Depth of Design Volume (EURV or WQCV) (Based on design concept chosen under 1E)</p> <p>F) Height of Water Quality Screen (H_{TR})</p> <p>G) Width of Water Quality Screen Opening (W_{opening}) (Minimum of 12 inches is recommended)</p>	<p>A_t = <input style="width: 50px;" type="text" value="150"/> square inches</p> <div style="border: 1px solid black; padding: 2px; margin-bottom: 5px; text-align: center;"> <i>S.S. Well Screen with 60% Open Area</i> </div> <hr/> <hr/> <p>User Ratio = <input style="width: 50px;" type="text"/></p> <p>A_{total} = <input style="width: 50px;" type="text" value="250"/> sq. in.</p> <p>H = <input style="width: 50px;" type="text" value="5.5"/> feet</p> <p>H_{TR} = <input style="width: 50px;" type="text" value="94"/> inches</p> <p>W_{opening} = <input style="width: 50px;" type="text" value="12.0"/> inches</p> <p style="color: red; font-size: small;">VALUE LESS THAN RECOMMENDED MIN. WIDTH. WIDTH HAS BEEN SET TO 12 INCHES.</p>

Design Procedure Form: Extended Detention Basin (EDB)

Sheet 3 of 3

Designer: Marc A. Whorton, P.E.
Company: Classic Consulting
Date: July 20, 2023
Project: Monument Junction Development - Hwy. 105 & JCP Int. Imps.
Location: SWQ Facility in CDOT ROW

<p>10. Overflow Embankment</p> <p>A) Describe embankment protection for 100-year and greater overtopping:</p> <p>B) Slope of Overflow Embankment (Horizontal distance per unit vertical, 4:1 or flatter preferred)</p>	<p>Buried Rip-Rap</p> <hr/> <hr/> <p>Ze = <input style="width: 50px;" type="text" value="50.00"/> ft / ft</p>
<p>11. Vegetation</p>	<div style="border: 1px solid black; padding: 5px;"> <p>Choose One</p> <p><input type="radio"/> Irrigated</p> <p><input checked="" type="radio"/> Not Irrigated</p> </div>
<p>12. Access</p> <p>A) Describe Sediment Removal Procedures</p>	<hr/> <hr/> <hr/> <hr/> <hr/>
<p>Notes: _____</p> <hr/> <hr/> <hr/>	

Design Procedure Form: Extended Detention Basin (EDB)

UD-BMP (Version 3.07, March 2018)

Sheet 1 of 3

Designer: Marc A. Whorton, P.E.
Company: Classic Consulting
Date: July 20, 2023
Project: Monument Junction Development - Hwy. 105 & JCP Int. Imps.
Location: SWQ Facility - Forebay Sizing

<p>1. Basin Storage Volume</p> <p>A) Effective Imperviousness of Tributary Area, I_a</p> <p>B) Tributary Area's Imperviousness Ratio ($i = I_a / 100$)</p> <p>C) Contributing Watershed Area</p> <p>D) For Watersheds Outside of the Denver Region, Depth of Average Runoff Producing Storm</p> <p>E) Design Concept (Select EURV when also designing for flood control)</p> <p>F) Design Volume (WQCV) Based on 40-hour Drain Time ($V_{DESIGN} = (1.0 * (0.91 * i^3 - 1.19 * i^2 + 0.78 * i) / 12 * Area)$)</p> <p>G) For Watersheds Outside of the Denver Region, Water Quality Capture Volume (WQCV) Design Volume ($V_{WQCV\ OTHER} = (d_s * V_{DESIGN} / 0.43)$)</p> <p>H) User Input of Water Quality Capture Volume (WQCV) Design Volume (Only if a different WQCV Design Volume is desired)</p> <p>I) NRCS Hydrologic Soil Groups of Tributary Watershed i) Percentage of Watershed consisting of Type A Soils ii) Percentage of Watershed consisting of Type B Soils iii) Percentage of Watershed consisting of Type C/D Soils</p> <p>J) Excess Urban Runoff Volume (EURV) Design Volume For HSG A: $EURV_A = 1.68 * i^{1.28}$ For HSG B: $EURV_B = 1.36 * i^{1.08}$ For HSG C/D: $EURV_{C/D} = 1.20 * i^{1.08}$</p> <p>K) User Input of Excess Urban Runoff Volume (EURV) Design Volume (Only if a different EURV Design Volume is desired)</p>	<p>$I_a =$ <input type="text" value="67.2"/> %</p> <p>$i =$ <input type="text" value="0.672"/></p> <p>Area = <input type="text" value="8.490"/> ac</p> <p>$d_s =$ <input type="text" value="0.42"/> in</p> <div style="border: 1px solid black; padding: 5px; margin: 5px 0;"> <p>Choose One</p> <p><input checked="" type="radio"/> Water Quality Capture Volume (WQCV)</p> <p><input type="radio"/> Excess Urban Runoff Volume (EURV)</p> </div> <p>$V_{DESIGN} =$ <input type="text"/> ac-ft</p> <p>$V_{DESIGN\ OTHER} =$ <input type="text"/> ac-ft</p> <p>$V_{DESIGN\ USER} =$ <input type="text" value="0.121"/> ac-ft</p> <p>HSG _A = <input type="text"/> %</p> <p>HSG _B = <input type="text"/> %</p> <p>HSG _{C/D} = <input type="text"/> %</p> <p>$EURV_{DESIGN} =$ <input type="text"/> ac-ft</p> <p>$EURV_{DESIGN\ USER} =$ <input type="text"/> ac-ft</p>
<p>2. Basin Shape: Length to Width Ratio (A basin length to width ratio of at least 2:1 will improve TSS reduction.)</p>	<p>L : W = <input type="text" value="2.0"/> : 1</p>
<p>3. Basin Side Slopes</p> <p>A) Basin Maximum Side Slopes (Horizontal distance per unit vertical, 4:1 or flatter preferred)</p>	<p>Z = <input type="text" value="3.00"/> ft / ft</p> <p align="center">DIFFICULT TO MAINTAIN, INCREASE WHERE POSSIBLE</p>
<p>4. Inlet</p> <p>A) Describe means of providing energy dissipation at concentrated inflow locations:</p>	<p>Concrete Forebay</p> <hr/> <hr/> <hr/>
<p>5. Forebay</p> <p>A) Minimum Forebay Volume ($V_{FMIN} =$ <input type="text" value="3%"/> of the WQCV)</p> <p>B) Actual Forebay Volume</p> <p>C) Forebay Depth ($D_F =$ <input type="text" value="18"/> inch maximum)</p> <p>D) Forebay Discharge</p> <p>i) Undetained 100-year Peak Discharge</p> <p>ii) Forebay Discharge Design Flow ($Q_F = 0.02 * Q_{100}$)</p> <p>E) Forebay Discharge Design</p> <p>F) Discharge Pipe Size (minimum 8-inches)</p> <p>G) Rectangular Notch Width</p>	<p>$V_{FMIN} =$ <input type="text" value="0.004"/> ac-ft</p> <p>$V_F =$ <input type="text" value="0.004"/> ac-ft</p> <p>$D_F =$ <input type="text" value="18.0"/> in</p> <p>$Q_{100} =$ <input type="text" value="36.00"/> cfs</p> <p>$Q_F =$ <input type="text" value="0.72"/> cfs</p> <div style="border: 1px solid black; padding: 5px; margin: 5px 0;"> <p>Choose One</p> <p><input type="radio"/> Berm With Pipe</p> <p><input checked="" type="radio"/> Wall with Rect. Notch</p> <p><input type="radio"/> Wall with V-Notch Weir</p> </div> <p align="right" style="color: blue;">Flow too small for berm w/ pipe</p> <p>Calculated $D_P =$ <input type="text"/> in</p> <p>Calculated $W_N =$ <input type="text" value="5.0"/> in</p>

Design Procedure Form: Extended Detention Basin (EDB)

Designer: Marc A. Whorton, P.E.
Company: Classic Consulting
Date: July 20, 2023
Project: Monument Junction Development - Hwy. 105 & JCP Int. Imps.
Location: SWQ Facility - Forebay Sizing

<p>6. Trickle Channel</p> <p>A) Type of Trickle Channel</p> <p>F) Slope of Trickle Channel</p>	<div style="border: 1px solid black; padding: 5px; margin-bottom: 10px;"> <p>Choose One</p> <p><input type="radio"/> Concrete</p> <p><input checked="" type="radio"/> Soft Bottom</p> </div> <p style="color: blue; font-size: small;">PROVIDE A CONSISTENT LONGITUDINAL SLOPE FROM FOREBAY TO MICROPOOL WITH NO MEANDERING. RIPRAP AND SOIL RIPRAP LINED CHANNELS ARE NOT RECOMMENDED. MINIMUM DEPTH OF 1.5 FEET</p> <p>S = <input style="width: 50px;" type="text" value="0.0200"/> ft / ft</p>
<p>7. Micropool and Outlet Structure</p> <p>A) Depth of Micropool (2.5-foot minimum)</p> <p>B) Surface Area of Micropool (10 ft² minimum)</p> <p>C) Outlet Type</p> <p>D) Smallest Dimension of Orifice Opening Based on Hydrograph Routing (Use UD-Detention)</p> <p>E) Total Outlet Area</p>	<p>D_M = <input style="width: 50px;" type="text"/> ft</p> <p>A_M = <input style="width: 50px;" type="text"/> sq ft</p> <div style="border: 1px solid black; padding: 5px; margin-bottom: 10px;"> <p>Choose One</p> <p><input checked="" type="radio"/> Orifice Plate</p> <p><input type="radio"/> Other (Describe):</p> </div> <p>_____</p> <p>_____</p> <p>D_{orifice} = <input style="width: 50px;" type="text"/> inches</p> <p>A_{orifice} = <input style="width: 50px;" type="text"/> square inches</p>
<p>8. Initial Surcharge Volume</p> <p>A) Depth of Initial Surcharge Volume (Minimum recommended depth is 4 inches)</p> <p>B) Minimum Initial Surcharge Volume (Minimum volume of 0.3% of the WQCV)</p> <p>C) Initial Surcharge Provided Above Micropool</p>	<p>D_{IS} = <input style="width: 50px;" type="text"/> in</p> <p>V_{IS} = <input style="width: 50px;" type="text" value="16"/> cu ft</p> <p>V_s = <input style="width: 50px;" type="text"/> cu ft</p>
<p>9. Trash Rack</p> <p>A) Water Quality Screen Open Area: $A_t = A_{ot} * 38.5 * (e^{-0.095D})$</p> <p>B) Type of Screen (If specifying an alternative to the materials recommended in the USDCM, indicate "other" and enter the ratio of the total open are to the total screen are for the material specified.)</p> <p style="padding-left: 40px;">Other (Y/N): <input style="width: 80px;" type="text"/></p> <p>C) Ratio of Total Open Area to Total Area (only for type 'Other')</p> <p>D) Total Water Quality Screen Area (based on screen type)</p> <p>E) Depth of Design Volume (EURV or WQCV) (Based on design concept chosen under 1E)</p> <p>F) Height of Water Quality Screen (H_{TR})</p> <p>G) Width of Water Quality Screen Opening (W_{opening}) (Minimum of 12 inches is recommended)</p>	<p>A_t = <input style="width: 50px;" type="text"/> square inches</p> <p>_____</p> <p>_____</p> <p>_____</p> <p>User Ratio = <input style="width: 50px;" type="text"/></p> <p>A_{total} = <input style="width: 50px;" type="text"/> sq. in.</p> <p>H = <input style="width: 50px;" type="text"/> feet</p> <p>H_{TR} = <input style="width: 50px;" type="text"/> inches</p> <p>W_{opening} = <input style="width: 50px;" type="text"/> inches</p>

Design Procedure Form: Extended Detention Basin (EDB)

Sheet 3 of 3

Designer: Marc A. Whorton, P.E.
Company: Classic Consulting
Date: July 20, 2023
Project: Monument Junction Development - Hwy. 105 & JCP Int. Imps.
Location: SWQ Facility - Forebay Sizing


<p>10. Overflow Embankment</p> <p>A) Describe embankment protection for 100-year and greater overtopping:</p> <p>B) Slope of Overflow Embankment (Horizontal distance per unit vertical, 4:1 or flatter preferred)</p>	<p>Buried Rip-Rap</p> <hr/> <hr/> <p>Ze = <input style="width: 50px; text-align: center;" type="text" value="4.00"/> ft / ft</p>
<p>11. Vegetation</p>	<div style="border: 1px solid black; padding: 5px;"> <p>Choose One</p> <p><input type="radio"/> Irrigated</p> <p><input checked="" type="radio"/> Not Irrigated</p> </div>
<p>12. Access</p> <p>A) Describe Sediment Removal Procedures</p>	<hr/> <hr/> <hr/> <hr/> <hr/>
<p>Notes: _____</p> <hr/> <hr/> <hr/>	

DETENTION FACILITY CALCULATIONS



DETENTION BASIN STAGE-STORAGE TABLE BUILDER

MHFD-Detention, Version 4.05 (January 2022)

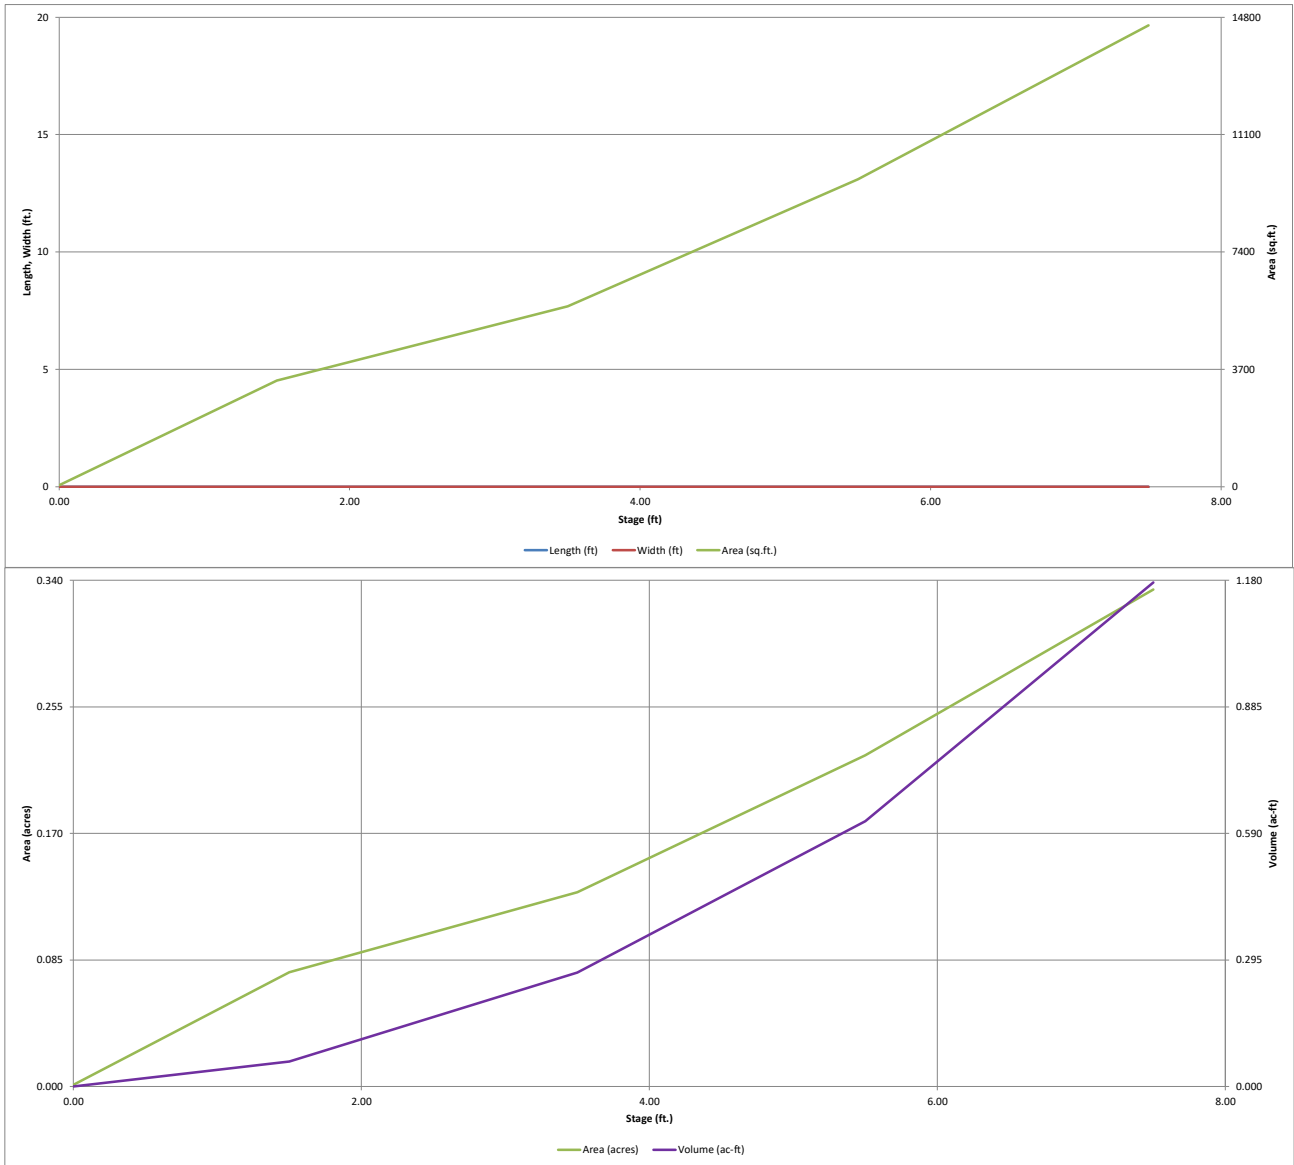


DETENTION BASIN OUTLET STRUCTURE DESIGN

MHFD-Detention, Version 4.05 (January 2022)

Project: Monument Junction Development - Hwy. 105 & JCP Int. Imps.

Basin ID: SWQ Facility in CDOT ROW

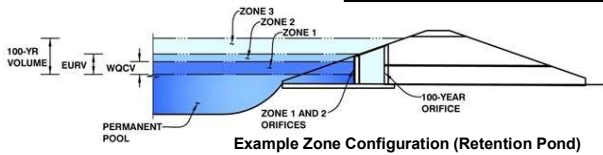

	Estimated Stage (ft)	Estimated Volume (ac-ft)	Outlet Type
Zone 1 (WQCV)	3.09	0.213	Orifice Plate
Zone 2 (EURV)	5.44	0.390	Orifice Plate
Zone 3 (100-year)	7.35	0.520	Weir&Pipe (Restrict)
Total (all zones)		1.124	

User Input: Orifice at Underdrain Outlet (typically used to drain WQCV in a Filtration BMP)

Underdrain Orifice Invert Depth =	N/A	ft (distance below the filtration media surface)
Underdrain Orifice Diameter =	N/A	inches

Calculated Parameters for Underdrain

Underdrain Orifice Area =	N/A	ft ²
Underdrain Orifice Centroid =	N/A	feet

User Input: Orifice Plate with one or more orifices or Elliptical Slot Weir (typically used to drain WQCV and/or EURV in a sedimentation BMP)

Centroid of Lowest Orifice =	0.00	ft (relative to basin bottom at Stage = 0 ft)
Depth at top of Zone using Orifice Plate =	5.50	ft (relative to basin bottom at Stage = 0 ft)
Orifice Plate: Orifice Vertical Spacing =	16.50	inches
Orifice Plate: Orifice Area per Row =	1.09	sq. inches (diameter = 1-3/16 inches)

Calculated Parameters for Plate

WQ Orifice Area per Row =	7.569E-03	ft ²
Elliptical Half-Width =	N/A	feet
Elliptical Slot Centroid =	N/A	feet
Elliptical Slot Area =	N/A	ft ²

User Input: Stage and Total Area of Each Orifice Row (numbered from lowest to highest)

	Row 1 (required)	Row 2 (optional)	Row 3 (optional)	Row 4 (optional)	Row 5 (optional)	Row 6 (optional)	Row 7 (optional)	Row 8 (optional)
Stage of Orifice Centroid (ft)	0.00	1.40	2.80	4.20				
Orifice Area (sq. inches)	1.09	1.09	1.09	1.09				

	Row 9 (optional)	Row 10 (optional)	Row 11 (optional)	Row 12 (optional)	Row 13 (optional)	Row 14 (optional)	Row 15 (optional)	Row 16 (optional)
Stage of Orifice Centroid (ft)								
Orifice Area (sq. inches)								

User Input: Vertical Orifice (Circular or Rectangular)

	Not Selected	Not Selected	
Invert of Vertical Orifice =	N/A	N/A	ft (relative to basin bottom at Stage = 0 ft)
Depth at top of Zone using Vertical Orifice =	N/A	N/A	ft (relative to basin bottom at Stage = 0 ft)
Vertical Orifice Diameter =	N/A	N/A	inches

Calculated Parameters for Vertical Orifice

	Not Selected	Not Selected	
Vertical Orifice Area =	N/A	N/A	ft ²
Vertical Orifice Centroid =	N/A	N/A	feet

User Input: Overflow Weir (Dropbox with Flat or Sloped Grate and Outlet Pipe OR Rectangular/Trapezoidal Weir and No Outlet Pipe)

	Zone 3 Weir	Not Selected	
Overflow Weir Front Edge Height, Ho =	5.50	N/A	ft (relative to basin bottom at Stage = 0 ft)
Overflow Weir Front Edge Length =	6.00	N/A	feet
Overflow Weir Grate Slope =	0.00	N/A	H:V
Horiz. Length of Weir Sides =	3.00	N/A	feet
Overflow Grate Type =	Type C Grate	N/A	
Debris Clogging % =	50%	N/A	%

Calculated Parameters for Overflow Weir

	Zone 3 Weir	Not Selected	
Height of Grate Upper Edge, H _u =	5.50	N/A	feet
Overflow Weir Slope Length =	3.00	N/A	feet
Grate Open Area / 100-yr Orifice Area =	1.77	N/A	
Overflow Grate Open Area w/o Debris =	12.53	N/A	ft ²
Overflow Grate Open Area w/ Debris =	6.26	N/A	ft ²

User Input: Outlet Pipe w/ Flow Restriction Plate (Circular Orifice, Restrictor Plate, or Rectangular Orifice)

	Zone 3 Restrictor	Not Selected	
Depth to Invert of Outlet Pipe =	0.70	N/A	ft (distance below basin bottom at Stage = 0 ft)
Outlet Pipe Diameter =	36.00	N/A	inches
Restrictor Plate Height Above Pipe Invert =	36.00		inches

Calculated Parameters for Outlet Pipe w/ Flow Restriction Plate

	Zone 3 Restrictor	Not Selected	
Outlet Orifice Area =	7.07	N/A	ft ²
Outlet Orifice Centroid =	1.50	N/A	feet
Half-Central Angle of Restrictor Plate on Pipe =	3.14	N/A	radians

User Input: Emergency Spillway (Rectangular or Trapezoidal)

Spillway Invert Stage =	6.50	ft (relative to basin bottom at Stage = 0 ft)
Spillway Crest Length =	30.00	feet
Spillway End Slopes =	3.00	H:V
Freeboard above Max Water Surface =	1.00	feet

Calculated Parameters for Spillway

Spillway Design Flow Depth =	0.51	feet
Stage at Top of Freeboard =	8.01	feet
Basin Area at Top of Freeboard =	0.33	acres
Basin Volume at Top of Freeboard =	1.18	acre-ft




Routed Hydrograph Results

The user can override the default CUHP hydrographs and runoff volumes by entering new values in the Inflow Hydrographs table (Columns W through AF).

	WQCV	EURV	2 Year	5 Year	10 Year	25 Year	50 Year	100 Year	500 Year
Design Storm Return Period =	N/A	N/A	1.19	1.50	1.75	2.00	2.25	2.52	3.85
One-Hour Rainfall Depth (in) =	N/A	N/A	1.19	1.50	1.75	2.00	2.25	2.52	3.85
CUHP Runoff Volume (acre-ft) =	0.213	0.604	0.673	0.955	1.195	1.472	1.723	2.026	3.392
Inflow Hydrograph Volume (acre-ft) =	N/A	N/A	0.673	0.955	1.195	1.472	1.723	2.026	3.392
CUHP Predevelopment Peak Q (cfs) =	N/A	N/A	2.6	5.4	7.5	11.5	14.2	17.5	31.7
OPTIONAL Override Predevelopment Peak Q (cfs) =	N/A	N/A	10.0	14.0	20.0	27.0	30.0	36.0	
Predevelopment Unit Peak Flow, q (cfs/acre) =	N/A	N/A	0.84	1.18	1.69	2.28	2.53	3.04	2.68
Peak Inflow Q (cfs) =	N/A	N/A	11.9	16.8	20.2	25.4	29.7	35.1	57.6
Peak Outflow Q (cfs) =	0.1	0.3	0.5	4.6	7.8	14.8	19.2	25.2	51.2
Ratio Peak Outflow to Predevelopment Q =	N/A	N/A	N/A	0.3	0.4	0.5	0.6	0.7	1.6
Structure Controlling Flow =	Plate	Plate	Overflow Weir 1	Overflow Weir 1	Overflow Weir 1	Overflow Weir 1	Overflow Weir 1	Overflow Weir 1	Spillway
Max Velocity through Grate 1 (fps) =	N/A	N/A	0.02	0.3	0.6	1.2	1.5	2.0	2.9
Max Velocity through Grate 2 (fps) =	N/A	N/A	N/A	N/A	N/A	N/A	N/A	N/A	N/A
Time to Drain 97% of Inflow Volume (hours) =	38	58	61	58	56	53	51	49	42
Time to Drain 99% of Inflow Volume (hours) =	40	63	66	65	64	63	62	61	56
Maximum Ponding Depth (ft) =	3.08	5.44	5.54	5.78	5.91	6.13	6.25	6.40	6.79
Area at Maximum Ponding Depth (acres) =	0.12	0.22	0.22	0.24	0.24	0.26	0.26	0.27	0.29
Maximum Volume Stored (acre-ft) =	0.213	0.606	0.626	0.683	0.712	0.768	0.801	0.842	0.949

DETENTION BASIN OUTLET STRUCTURE DESIGN

MHFD-Detention, Version 4.05 (January 2022)

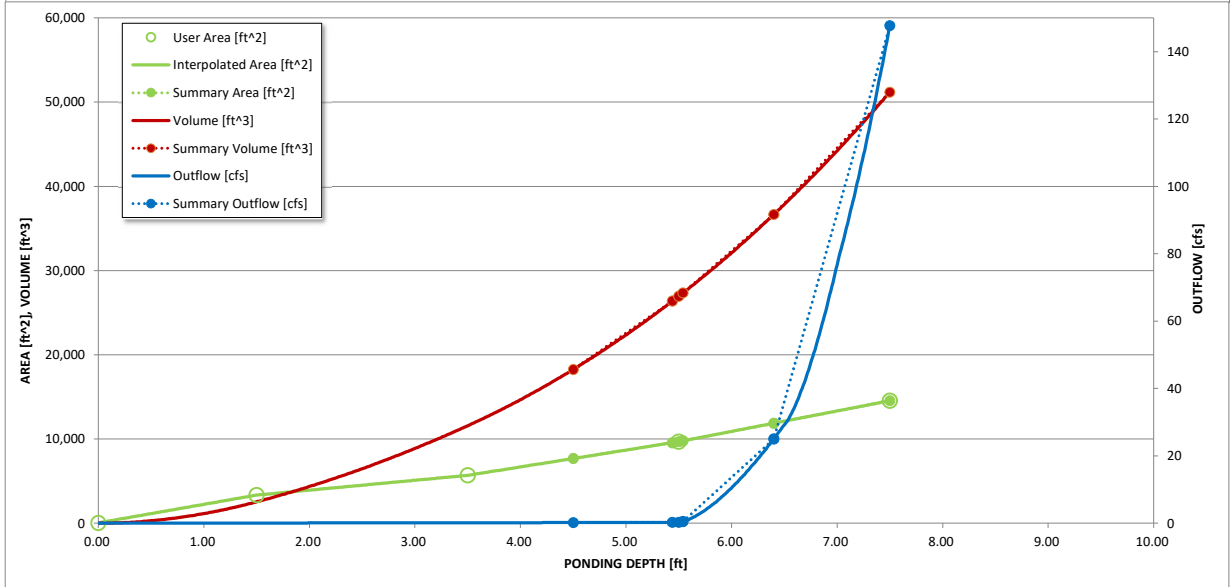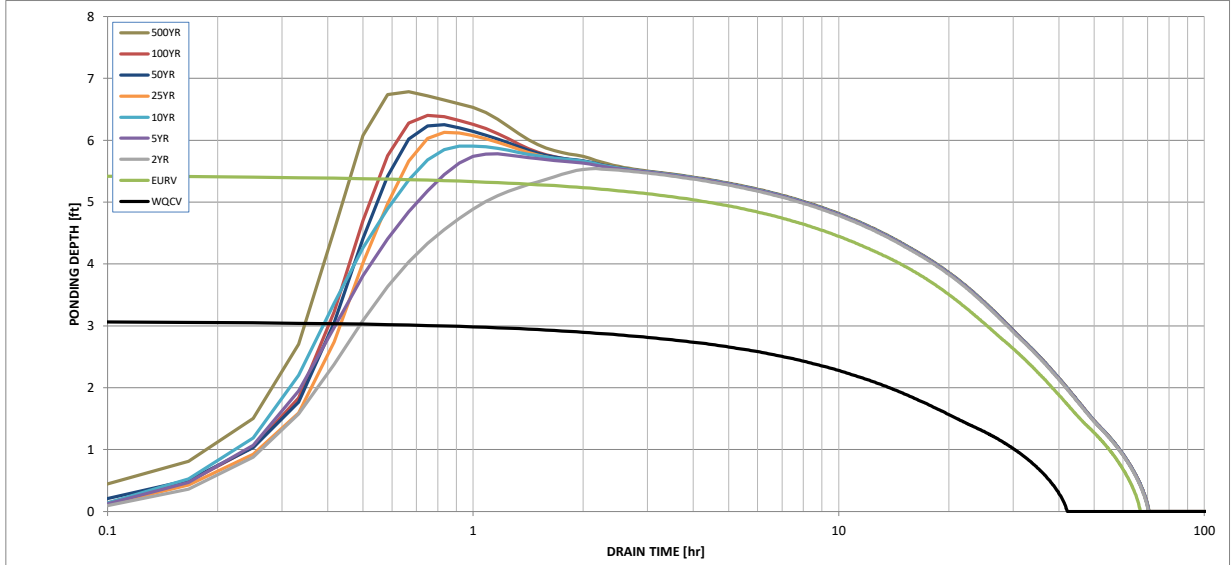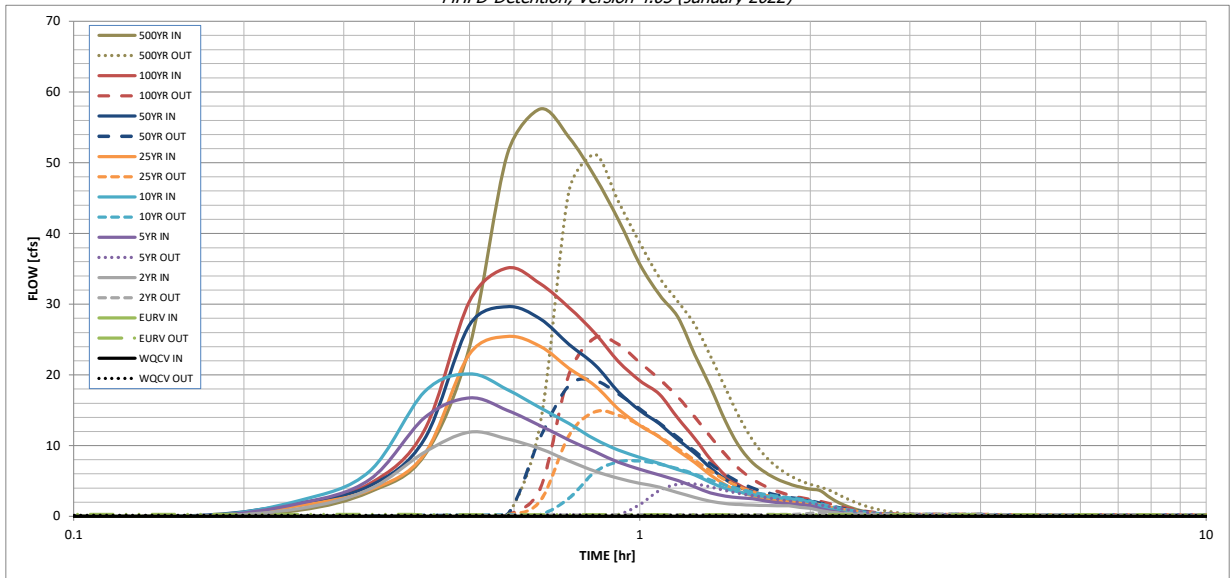

S-A-V-D Chart Axis Override	X-axis	Left Y-Axis	Right Y-Axis
minimum bound			
maximum bound			

DETENTION BASIN OUTLET STRUCTURE DESIGN

Outflow Hydrograph Workbook Filename: _____

Inflow Hydrographs


The user can override the calculated inflow hydrographs from this workbook with inflow hydrographs developed in a separate program.

Time Interval	SOURCE	CUHP	CUHP	CUHP	CUHP	CUHP	CUHP	CUHP	CUHP	CUHP	
	TIME	WQCV [cfs]	EURV [cfs]	2 Year [cfs]	5 Year [cfs]	10 Year [cfs]	25 Year [cfs]	50 Year [cfs]	100 Year [cfs]	500 Year [cfs]	
5.00 min	0:00:00	0.00	0.00	0.00	0.00	0.00	0.00	0.00	0.00	0.00	
	0:05:00	0.00	0.00	0.00	0.00	0.00	0.00	0.00	0.00	0.00	
	0:10:00	0.00	0.00	0.00	0.00	0.00	0.00	0.00	0.13	0.01	0.85
	0:15:00	0.00	0.00	1.11	1.81	2.23	1.50	1.86	1.83	3.46	3.46
	0:20:00	0.00	0.00	3.84	5.19	6.38	3.70	4.30	4.62	8.62	8.62
	0:25:00	0.00	0.00	9.05	13.93	17.60	8.81	10.91	12.17	23.92	23.92
	0:30:00	0.00	0.00	11.92	16.76	20.16	22.94	27.05	30.39	51.17	51.17
	0:35:00	0.00	0.00	10.94	15.00	17.92	25.45	29.66	35.13	57.60	57.60
	0:40:00	0.00	0.00	9.56	12.83	15.35	24.05	27.92	32.89	53.60	53.60
	0:45:00	0.00	0.00	7.81	10.80	13.12	20.93	24.30	29.53	48.00	48.00
	0:50:00	0.00	0.00	6.41	9.13	10.90	18.49	21.42	25.87	41.94	41.94
	0:55:00	0.00	0.00	5.38	7.67	9.37	15.18	17.62	21.91	35.64	35.64
	1:00:00	0.00	0.00	4.69	6.67	8.35	12.86	14.96	19.17	31.30	31.30
	1:05:00	0.00	0.00	4.13	5.84	7.48	11.21	13.06	17.26	28.20	28.20
	1:10:00	0.00	0.00	3.36	5.07	6.62	9.29	10.87	13.89	22.87	22.87
	1:15:00	0.00	0.00	2.68	4.16	5.84	7.61	8.94	11.01	18.28	18.28
	1:20:00	0.00	0.00	2.13	3.32	4.80	5.85	6.85	8.06	13.45	13.45
	1:25:00	0.00	0.00	1.81	2.87	3.97	4.46	5.23	5.78	9.81	9.81
	1:30:00	0.00	0.00	1.67	2.64	3.44	3.51	4.13	4.39	7.57	7.57
	1:35:00	0.00	0.00	1.59	2.48	3.07	2.90	3.42	3.54	6.19	6.19
	1:40:00	0.00	0.00	1.54	2.17	2.80	2.51	2.95	2.97	5.24	5.24
	1:45:00	0.00	0.00	1.51	1.94	2.62	2.24	2.63	2.58	4.60	4.60
	1:50:00	0.00	0.00	1.48	1.77	2.49	2.06	2.42	2.31	4.15	4.15
	1:55:00	0.00	0.00	1.28	1.65	2.31	1.94	2.27	2.12	3.83	3.83
	2:00:00	0.00	0.00	1.13	1.50	2.04	1.85	2.17	2.01	3.65	3.65
	2:05:00	0.00	0.00	0.83	1.10	1.48	1.36	1.59	1.47	2.67	2.67
	2:10:00	0.00	0.00	0.60	0.79	1.05	0.97	1.13	1.05	1.91	1.91
	2:15:00	0.00	0.00	0.43	0.56	0.75	0.69	0.81	0.76	1.37	1.37
	2:20:00	0.00	0.00	0.30	0.39	0.52	0.49	0.57	0.54	0.97	0.97
	2:25:00	0.00	0.00	0.21	0.26	0.36	0.33	0.39	0.37	0.67	0.67
	2:30:00	0.00	0.00	0.14	0.17	0.24	0.23	0.27	0.26	0.46	0.46
	2:35:00	0.00	0.00	0.08	0.11	0.16	0.15	0.18	0.17	0.30	0.30
	2:40:00	0.00	0.00	0.05	0.07	0.09	0.09	0.11	0.10	0.18	0.18
	2:45:00	0.00	0.00	0.02	0.03	0.04	0.04	0.05	0.05	0.09	0.09
	2:50:00	0.00	0.00	0.01	0.01	0.01	0.01	0.02	0.02	0.03	0.03
	2:55:00	0.00	0.00	0.00	0.00	0.00	0.00	0.00	0.00	0.00	0.00
	3:00:00	0.00	0.00	0.00	0.00	0.00	0.00	0.00	0.00	0.00	0.00
DRAINAGE MAPS



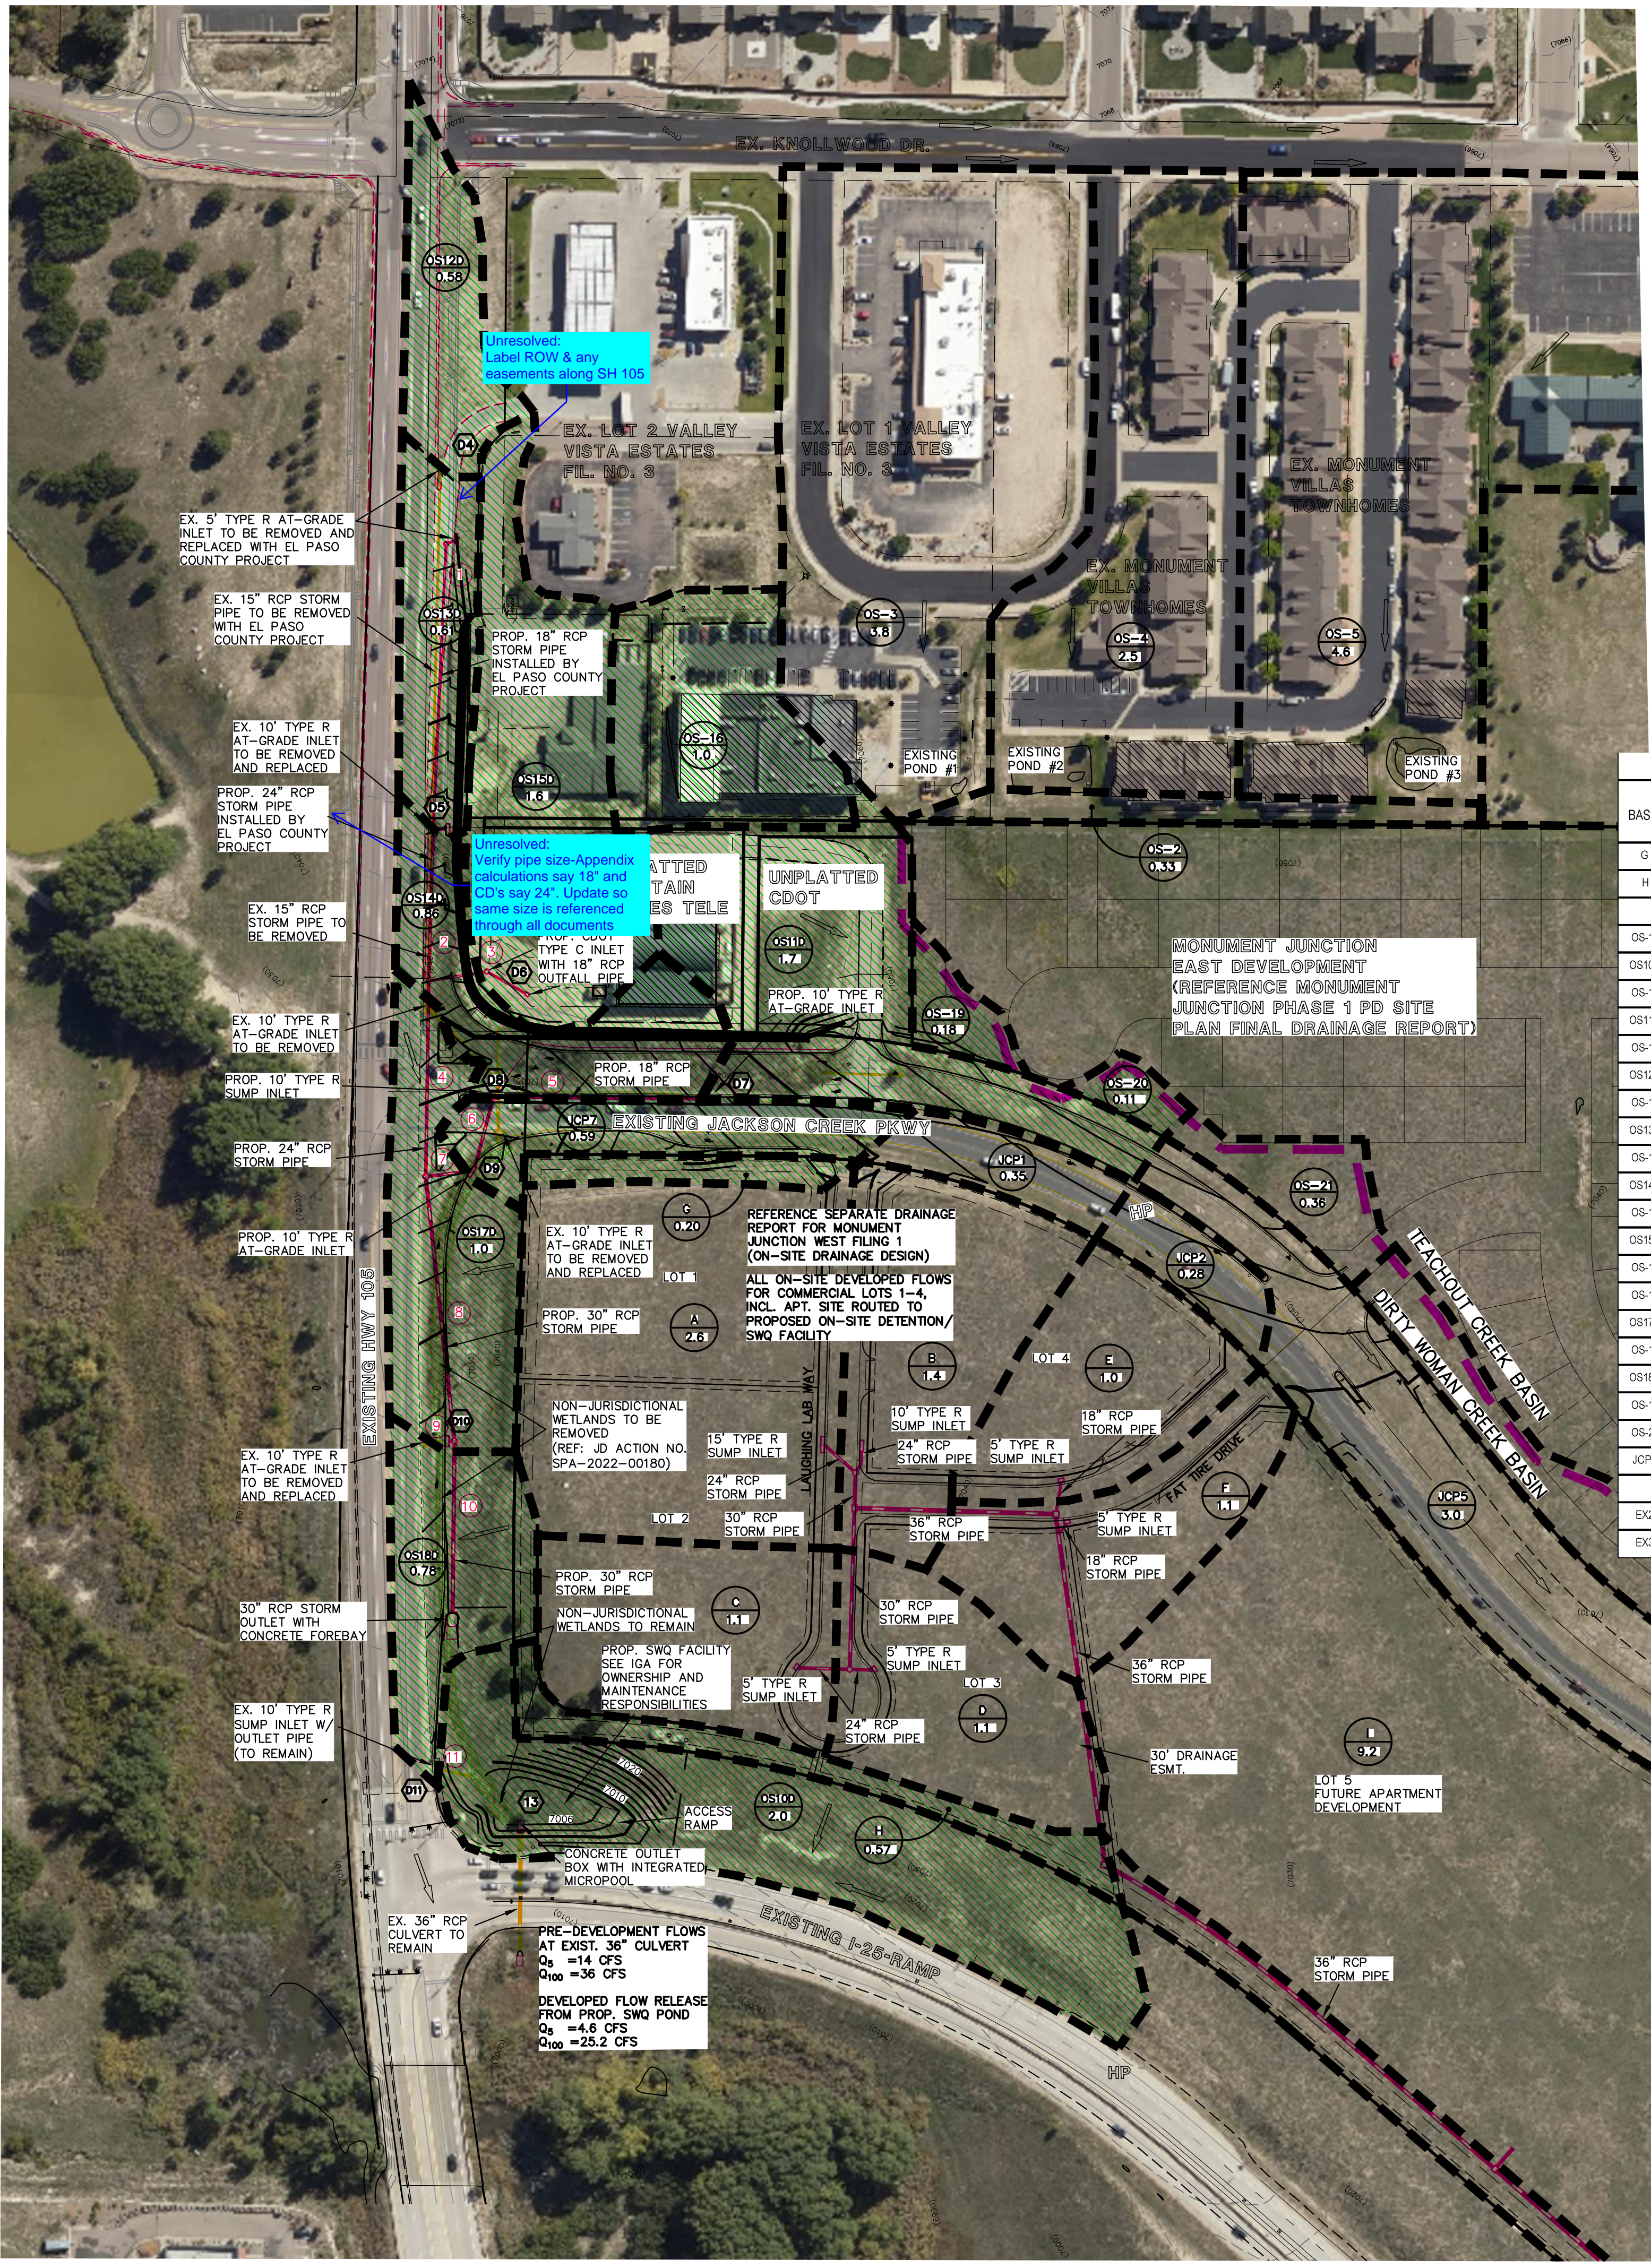

FINAL DRAINAGE REPORT ~ BASIN RUNOFF COEFFICIENT SUMMARY

BASIN	TOTAL AREA (AC)	DEVELOPED AREA/IMPERVIOUS AREA			LANDSCAPE/UNDEVELOPED AREAS				WEIGHTED			WEIGHTED CA			IMPERVIOUSNESS %	
		AREA (AC)	C(2)	C(5)	C(100)	AREA (AC)	C(2)	C(5)	C(100)	C(2)	C(5)	C(100)	CA(2)	CA(5)		CA(100)
G	0.20	0.05	0.79	0.81	0.88	0.15	0.03	0.09	0.36	0.22	0.27	0.49	0.04	0.05	0.10	25%
H	0.57	0.05	0.79	0.81	0.88	0.52	0.03	0.09	0.36	0.10	0.15	0.41	0.06	0.09	0.23	10%
OS-10	4.10	0.60	0.89	0.90	0.96	3.50	0.03	0.09	0.36	0.16	0.21	0.45	0.64	0.86	1.84	16%
OS10D	2.00	0.10	0.89	0.90	0.96	1.90	0.03	0.09	0.36	0.07	0.13	0.39	0.15	0.26	0.78	7%
OS-11	1.70	0.80	0.89	0.90	0.96	0.90	0.02	0.08	0.35	0.43	0.47	0.64	0.73	0.79	1.08	45%
OS11D	1.70	1.20	0.89	0.90	0.96	0.50	0.03	0.09	0.36	0.64	0.66	0.78	1.08	1.13	1.33	71%
OS-12	0.51	0.27	0.89	0.90	0.96	0.24	0.03	0.09	0.36	0.49	0.52	0.68	0.25	0.26	0.35	54%
OS12D	0.58	0.31	0.89	0.90	0.96	0.27	0.03	0.09	0.36	0.49	0.52	0.68	0.28	0.30	0.39	54%
OS-13	0.67	0.40	0.89	0.90	0.96	0.27	0.03	0.09	0.36	0.54	0.57	0.72	0.38	0.38	0.48	61%
OS13D	0.67	0.40	0.89	0.90	0.96	0.27	0.03	0.09	0.36	0.54	0.57	0.72	0.38	0.38	0.48	61%
OS-14	0.28	0.15	0.89	0.90	0.96	0.13	0.03	0.09	0.36	0.49	0.52	0.68	0.14	0.15	0.19	55%
OS14D	0.86	0.72	0.89	0.90	0.96	0.14	0.03	0.09	0.36	0.75	0.77	0.96	0.65	0.66	0.74	84%
OS-15	1.60	1.20	0.89	0.90	0.96	0.40	0.03	0.09	0.36	0.68	0.70	0.81	1.08	1.12	1.30	76%
OS15D	1.60	1.20	0.89	0.90	0.96	0.40	0.03	0.09	0.36	0.68	0.70	0.81	1.08	1.12	1.30	76%
OS-16	1.00	0.70	0.89	0.90	0.96	0.30	0.02	0.08	0.35	0.63	0.65	0.78	0.63	0.65	0.78	67%
OS16D	0.53	0.43	0.89	0.90	0.96	0.10	0.03	0.09	0.36	0.73	0.75	0.85	0.39	0.40	0.45	82%
OS17D	1.00	0.60	0.89	0.90	0.96	0.40	0.03	0.09	0.36	0.55	0.58	0.72	0.55	0.58	0.72	61%
OS-18	0.30	0.30	0.89	0.90	0.96	0.00	0.03	0.09	0.36	0.89	0.90	0.96	0.27	0.27	0.29	100%
OS18D	0.78	0.43	0.89	0.90	0.96	0.35	0.03	0.09	0.36	0.50	0.54	0.69	0.39	0.42	0.54	56%
OS-19	0.18	0.00	0.89	0.90	0.96	0.18	0.03	0.09	0.36	0.03	0.09	0.36	0.01	0.02	0.06	2%
OS-20	0.11	0.01	0.89	0.90	0.96	0.10	0.03	0.09	0.36	0.11	0.16	0.41	0.01	0.02	0.05	10%
JCP7	0.59	0.50	0.89	0.90	0.96	0.09	0.03	0.09	0.36	0.76	0.78	0.87	0.45	0.46	0.51	85%
EX2	0.56	0.56	0.03	0.09	0.36	0.00	0.03	0.09	0.36	0.03	0.09	0.36	0.02	0.05	0.20	2%
EX3	1.80	1.80	0.03	0.09	0.36	0.00	0.03	0.09	0.36	0.03	0.09	0.36	0.05	0.16	0.65	2%
Exist. Trib. to Pond	13.05															37.6%
Dev. Trib. to Pond	11.84															53.6%
Dev. Trib. to Forebay	8.49															67.2%

FINAL DRAINAGE REPORT ~ BASIN RUNOFF SUMMARY


BASIN	WEIGHTED			OVERLAND				STREET / CHANNEL FLOW				INTENSITY			TOTAL FLOWS			
	CA(2)	CA(5)	CA(100)	C(5)	Length (ft)	Height (ft)	Tc (min)	Length (ft)	Slope (%)	Velocity (fps)	Tc (min)	TOTAL (cfs)	I(2) (in/hr)	I(5) (in/hr)	I(100) (in/hr)	Q(2) (cfs)	Q(5) (cfs)	Q(100) (cfs)
G	0.04	0.05	0.10	0.09	30	1.5	5.9					5.9	3.93	4.93	8.27	0.17	0.3	0.8
H	0.06	0.09	0.23	0.09	40	2	6.8					6.8	3.76	4.71	7.91	0.2	0.4	1.8
OS-10	0.64	0.66	1.94	0.09	65	2	10.1	950	3.5%	1.9	8.5	18.6	2.56	3.20	5.37	2	3	10
OS10D	0.15	0.26	0.78	0.09	65	2	10.1	950	3.5%	1.9	8.5	18.6	2.56	3.20	5.37	0.4	0.8	4
OS-11	0.73	0.79	1.08	0.08	100	2	14.7	500	4.0%	2.0	4.2	18.8	2.54	3.18	5.34	1.9	3	8
OS11D	1.08	1.13	1.33	0.09	100	2	14.5	300	4.0%	2.0	2.5	17.0	2.66	3.33	5.59	3	4	7
OS-12	0.25	0.26	0.36	0.09	40	2	6.8	200	3.5%	3.7	0.9	7.7	3.61	4.53	7.60	0.9	1.2	3
OS12D	0.28	0.30	0.39	0.09	40	2	6.8	200	3.5%	3.7	0.9	7.7	3.61	4.53	7.60	1.0	1.4	3.0
OS-13	0.36	0.38	0.48	0.09	25	3	4.0	240	5.5%	4.7	0.9	5.0	4.12	5.17	8.68	1.5	2	4
OS13D	0.36	0.38	0.48	0.09	25	3	4.0	250	5.5%	3.7	1.1	5.1	4.09	5.13	8.61	1.5	2	4
OS-14	0.14	0.15	0.19	0.09	30	10	3.1	170	5.5%	4.7	0.6	5.0	4.12	5.17	8.68	0.6	0.8	2
OS14D	0.65	0.66	0.74	0.09	30	10	3.1	190	5.5%	4.7	0.7	5.0	4.12	5.17	8.68	3	3	6
OS-15	1.08	1.12	1.30	0.09	180	12	13.1	100	3.0%	1.7	1.0	14.0	2.89	3.62	6.08	3	4	8
OS15D	1.08	1.12	1.30	0.09	180	12	13.1	90	3.0%	3.5	0.4	13.5	2.94	3.68	6.18	3	4	8
OS-16	0.63	0.65	0.78	0.08	100	4	11.7	130	1.5%	1.2	1.8	13.4	2.94	3.69	6.19	1.9	2	5
OS-17	0.39	0.40	0.45	0.09	60	14	5.0	380	5.0%	4.5	1.4	6.4	3.82	4.80	8.05	1.5	2	4
OS17D	0.55	0.58	0.72	0.09	60	14	5.0	380	5.0%	4.5	1.4	6.4	3.82	4.80	8.05	2	3	6
OS-18	0.27	0.27	0.29	0.09	15	0.5	4.7	280	2.0%	2.8	1.6	6.4	3.83	4.80	8.06	1.0	1.3	2
OS18D	0.39	0.42	0.54	0.09	90	4	10.6	290	2.0%	2.8	1.5	12.1	3.07	3.84	6.45	1.2	1.6	3
OS-19	0.01	0.02	0.06	0.09	80	3.2	10.3	380	5.0%	4.5	1.4	11.7	3.10	3.89	6.53	0.02	0.1	0.4
OS-20	0.01	0.02	0.05	0.09	50	3	7.1	370	4.63	7.78	0.0	11.7	3.70	4.63	7.78	0.0	0.1	0.4
JCP7	0.45	0.46	0.51	0.09	20	0.6	5.7	300	4.5%	4.2	1.2	6.9	3.74	4.70	7.88	2	2	4
EX2	0.02	0.05	0.20	0.09	50	2	8.2					8.2	3.54	4.43	7.44	0.1	0.2	1.5
EX3	0.05	0.16	0.65	0.09	260	5	23.7					23.7	2.27	2.84	4.76	0.1	0.5	3

FINAL DRAINAGE REPORT ~ SURFACE ROUTING SUMMARY

Design Point(s)	Contributing Basins	Equivalent CA(5)	Equivalent CA(100)	Maximum Tc	Intensity		Flow		Inlet Size
					I(5)	I(100)	Q(5)	Q(100)	
13	G, H, JCP7, OS10D thru OS15D, OS-16, OS17D, OS18D	5.84	7.90	21.1	3.01	5.05	18	40	CDOT SWQ FACILITY
D4	OS12D, 0.85 CFS 100Yr Flow-by from upstream	0.30	0.51	7.7	4.53	7.60	1.4	3.9	PROP. 5' TYPE R AT-GRADE INLET
D5	OS13D, Flow-by from D4	0.38	0.63	5.0	5.17	8.68	2	5	PROP. 10' TYPE R AT-GRADE INLET
D6	OS15D	1.12	1.30	13.5	3.68	6.18	4	8	PROP. CDOT TYPE C INLET
D7	OS11D, OS-16, OS-19, OS-20	1.81	2.22	17.0	3.33	5.59	6	12	PROP. 10' TYPE R AT-GRADE INLET
D8	OS14D, Flow-by from D5&D7	0.84	1.47	17.0	3.33	5.59	3	8	PROP. 10' TYPE R SUMP INLET
D9	JCP7, G	0.51	0.61	6.9	4.70	7.88	2	5	PROP. 10' TYPE R AT-GRADE INLET
D10	OS17D, Flow-by from D8	0.58	0.74	6.4	4.80	8.05	3	6	PROP. 10' TYPE R AT-GRADE INLET
D11	OS18D, Flow-by from D9	0.42	0.64	12.1	3.84	6.45	2	4	EXIST. 10' TYPE R SUMP INLET

FINAL DRAINAGE REPORT ~ PIPE ROUTING SUMMARY

Pipe Run	Contributing Basins	Equivalent CA(5)	Equivalent CA(100)	Maximum Tc	Intensity		Flow		Pipe Size*
					I(5)	I(100)	Q(5)	Q(100)	
1	Inlet Capture at D4	0.30	0.33	7.7	4.53	7.60	1.4	2.5	PROP. 15' RCP
2	PR-1, Inlet Capture at D5	0.69	0.92	7.7	4.53	7.60	3	7	PROP. 18' RCP
3	CDOT Type C Inlet Capture at D6	1.12	1.30	13.5	3.68	6.18	4	8	PROP. 18' RCP
4	PR-2, PR-3	1.80	2.22	13.7	3.66	6.15	7	14	PROP. 24' RCP
5	Inlet Capture at D7	1.63	1.51	17.0	3.33	5.59	5	8	PROP. 18' RCP
6	PR-5, Inlet Capture at D8	2.47	2.98	17.0	3.33	5.59	8	17	PROP. 24' RCP
7	PR-6, Inlet Capture at D9	2.98	3.56	17.0	3.33	5.59	10	20	PROP. 24' RCP
8	PR-4, PR-7	4.79	5.77	17.2	3.32	5.56	16	32	PROP. 30' RCP
9	Inlet Capture at D10	0.58	0.66	6.4	4.80	8.05	3	5	PROP. 18' RCP
10	PR-8, PR9	5.36	6.43	17.4	3.30	5.54	18	36	PROP. 30' RCP
11	Inlet Capture at D11	0.42	0.64	12.1	3.84	6.45	2	4	EXIST. 18' RCP

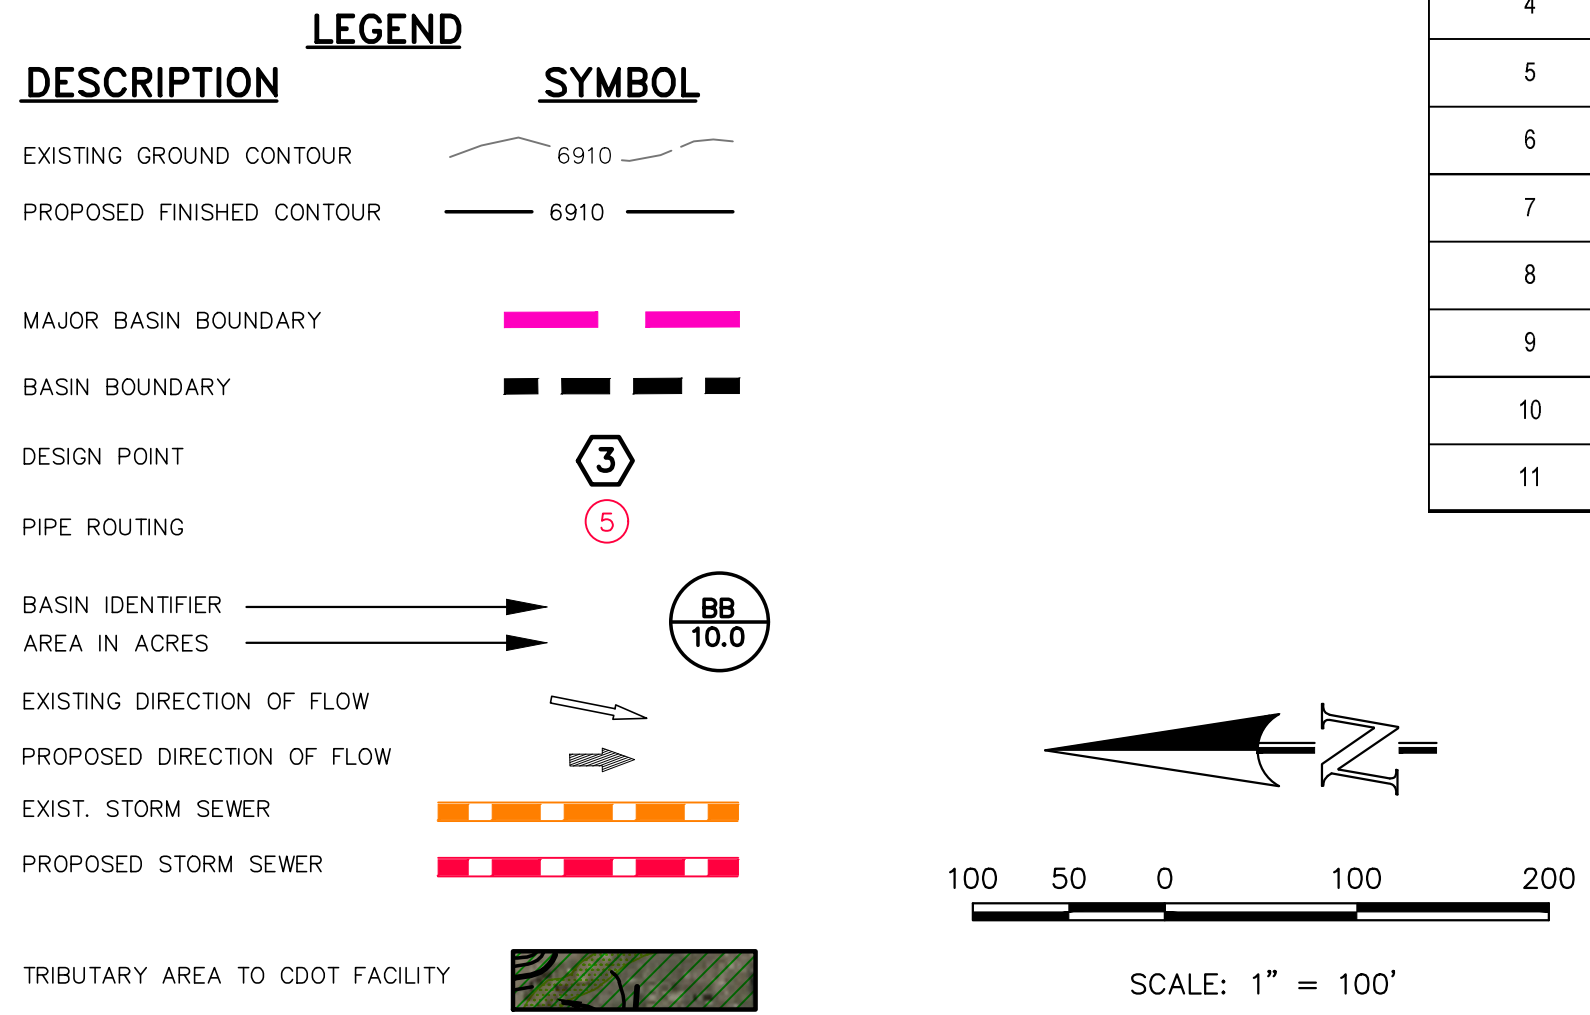

STATE HIGHWAY 105 / JACKSON CREEK PARKWAY - PHASE 2

COUNTY OF EL PASO, TOWN OF MONUMENT, STATE OF COLORADO

CONSTRUCTION PLANS


FEBRUARY 2023

Comments provided by DPW Capital Projects

Comments provided by DPW Development Services

EL PASO COUNTY GENERAL CONSTRUCTION NOTES:

- THE LOCATION OF EXISTING UTILITIES ARE SHOWN IN AN APPROXIMATE WAY ONLY AND MAY NOT INCLUDE ALL UTILITIES. THE EXCAVATION CONTRACTOR SHALL DETERMINE THE EXACT LOCATION OF ALL EXISTING UTILITIES BEFORE COMMENCING WORK. THE CONTRACTOR AGREES TO BE FULLY RESPONSIBLE FOR ANY AND ALL DAMAGES WHICH MIGHT BE OCCASIONED BY HIS FAILURE TO EXACTLY LOCATE AND PRESERVE ANY AND ALL UTILITIES.
- BEFORE COMMENCING ANY EXCAVATION, CALL 1-800-922-1987 FOR EXISTING UTILITY LOCATIONS.
- THE CONTRACTOR WILL TAKE THE NECESSARY PRECAUTIONS TO PROTECT EXISTING UTILITIES FROM DAMAGE DUE TO THIS OPERATION. ANY DAMAGE TO THE UTILITIES WILL BE REPAIRED AT THE CONTRACTOR'S EXPENSE, AND ANY SERVICE DISRUPTION WILL BE SETTLED BY THE CONTRACTOR.
- ALL BACKFILL, SUB-BASE AND/OR BASE COURSE (CLASS 6) MATERIAL SHALL BE COMPACTED TO THE SOILS ENGINEER'S RECOMMENDATIONS, AND APPROVED BY EL PASO COUNTY PLANNING AND COMMUNITY DEVELOPMENT (PCD).
- ALL STATIONING IS CENTERLINE UNLESS OTHERWISE INDICATED. ALL ELEVATIONS ARE CENTERLINE UNLESS OTHERWISE INDICATED.
- THE CONTRACTOR SHALL REVEGETATE ALL DISTURBED AREAS AS SOON AS POSSIBLE AND EROSION CONTROL SHALL BE INSTALLED AND MAINTAINED IN A FUNCTIONAL MANNER AT ALL TIMES. DEVELOPER RESPONSIBLE FOR MAINTAINING DISTURBED AREAS UNTIL REVEGETATION IS COMPLETE.
- ALL DISTURBED PAVEMENT EDGES SHALL BE CUT TO NEAT LINES. REPAIR SHALL CONFORM TO THE EPC ECM APPENDIX K - 1.2C.
- ADDITIONAL EROSION CONTROL STRUCTURES MAY BE REQUIRED AT THE TIME OF CONSTRUCTION.
- BUILDING CONTRACTORS WILL BE RESPONSIBLE FOR CONSTRUCTING POSITIVE DRAINAGE AWAY FROM ALL STRUCTURES.
- ASPHALT THICKNESS AND BASE COURSE THICKNESS (COMPACTED) FOR ROADS SHALL BE PER DESIGN REPORT BY OWNER'S GEOTECHNICAL ENGINEER. OWNER'S GEOTECHNICAL ENGINEER TO BE ON SITE AT TIME OF ROAD CONSTRUCTION TO EVALUATE SOIL CONDITIONS AND DETERMINE IF ADDITIONAL MEASURES ARE NECESSARY TO ASSURE STABILITY OF THE NEW ROADS. PAVEMENT DESIGN SHALL BE APPROVED BY PLANNING AND COMMUNITY DEVELOPMENT PRIOR TO CONSTRUCTION.
- THE CONTRACTOR SHALL REVEGETATE ALL DISTURBED AREAS WITHIN 21 DAYS OF SUBSTANTIAL GRADING COMPLETION. EROSION CONTROL SHALL BE INSTALLED AND MAINTAINED IN A FUNCTIONAL MANNER AT ALL TIMES. DEVELOPER IS RESPONSIBLE FOR MAINTAINING DISTURBED AREAS UNTIL REVEGETATION IS COMPLETE.
- TYPE M RIP-RAP WITH 4" OF TYPE II GRANULAR BEDDING AND MIRAFI 180N OR EQUAL MAY BE SUBSTITUTED WHERE TYPE L RIP-RAP WITH MIRAFI FW 700 OR EQUAL IS SPECIFIED
- ALL MATERIALS AND INSTALLATION PROCEDURES SHALL BE IN COMPLIANCE WITH ANY AND ALL APPLICABLE EL PASO COUNTY STANDARDS.

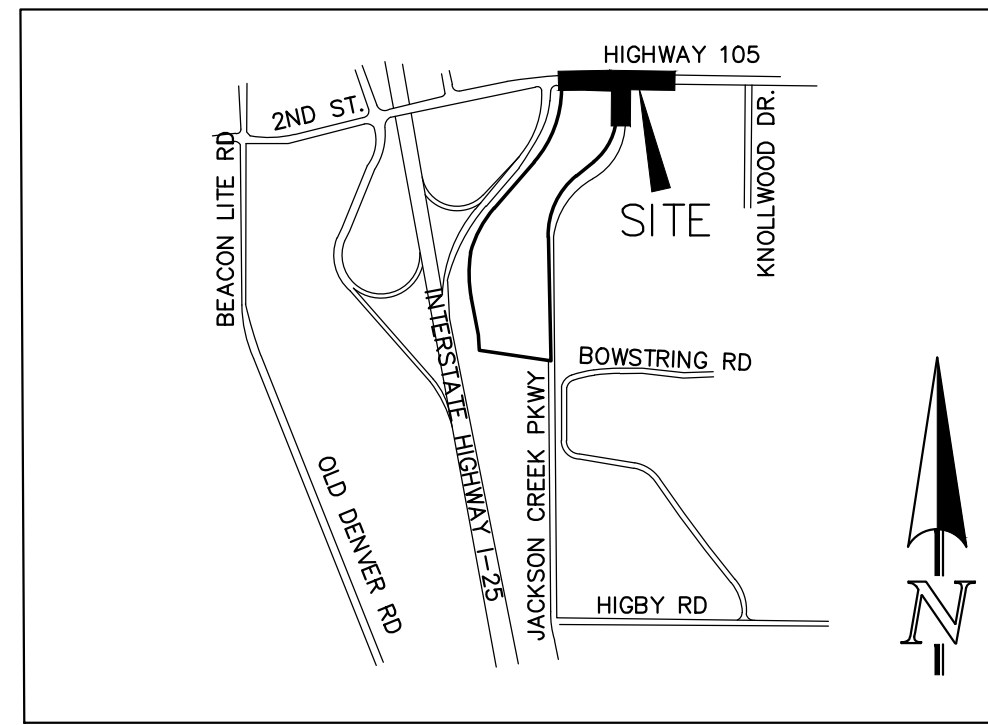


VICINITY MAP
N.T.S.

STANDARD NOTES FOR EL PASO COUNTY CONSTRUCTION PLANS:

- ALL DRAINAGE AND ROADWAY CONSTRUCTION SHALL MEET THE STANDARDS AND SPECIFICATIONS OF THE CITY OF COLORADO SPRINGS/EL PASO COUNTY DRAINAGE CRITERIA MANUAL, VOLUMES 1 AND 2, AND THE EL PASO COUNTY ENGINEERING CRITERIA MANUAL.
- CONTRACTOR SHALL BE RESPONSIBLE FOR THE NOTIFICATION AND FIELD NOTIFICATION OF ALL EXISTING UTILITIES, WHETHER SHOWN ON THE PLANS OR NOT, BEFORE BEGINNING CONSTRUCTION. LOCATION OF EXISTING UTILITIES SHALL BE VERIFIED BY THE CONTRACTOR PRIOR TO CONSTRUCTION. CALL 811 TO CONTACT THE UTILITY NOTIFICATION CENTER OF COLORADO (UNCC).
- CONTRACTOR SHALL KEEP A COPY OF THESE APPROVED PLANS, THE GRADING AND EROSION CONTROL PLAN, THE STORMWATER MANAGEMENT PLAN (SWMP), THE SOILS AND GEOTECHNICAL REPORT, AND THE APPROPRIATE DESIGN AND CONSTRUCTION STANDARDS AND SPECIFICATIONS AT THE JOB SITE AT ALL TIMES, INCLUDING THE FOLLOWING:
 - EL PASO COUNTY ENGINEERING CRITERIA MANUAL (ECM)
 - CITY OF COLORADO SPRINGS/EL PASO COUNTY DRAINAGE CRITERIA MANUAL, VOLUMES 1 AND 2
 - COLORADO DEPARTMENT OF TRANSPORTATION (CDOT) STANDARD SPECIFICATIONS FOR ROAD AND BRIDGE CONSTRUCTION
 - CDOT M & S STANDARDS
- NOTWITHSTANDING ANYTHING DEPICTED IN THESE PLANS IN WORDS OR GRAPHIC REPRESENTATION, ALL DESIGN AND CONSTRUCTION RELATED TO ROADS, STORM DRAINAGE AND EROSION CONTROL SHALL CONFORM TO THE STANDARDS AND REQUIREMENTS OF THE MOST RECENT VERSION OF THE RELEVANT ADOPTED EL PASO COUNTY STANDARDS, INCLUDING THE LAND DEVELOPMENT CODE, THE ENGINEERING CRITERIA MANUAL, THE DRAINAGE CRITERIA MANUAL, AND THE DRAINAGE CRITERIA MANUAL VOLUME 2. ANY DEVIATIONS FROM REGULATIONS AND STANDARDS MUST BE REQUESTED, AND APPROVED, IN WRITING. ANY MODIFICATIONS NECESSARY TO MEET CRITERIA AFTER-THE-FACT WILL BE ENTIRELY THE DEVELOPER'S RESPONSIBILITY TO RECTIFY.
- IT IS THE DESIGN ENGINEER'S RESPONSIBILITY TO ACCURATELY SHOW EXISTING CONDITIONS, BOTH ONSITE AND OFFSITE, ON THE CONSTRUCTION PLANS. ANY MODIFICATIONS NECESSARY DUE TO CONFLICTS, OMISSIONS, OR CHANGED CONDITIONS WILL BE ENTIRELY THE DEVELOPER'S RESPONSIBILITY TO RECTIFY.
- CONTRACTOR SHALL SCHEDULE A PRE-CONSTRUCTION MEETING WITH EL PASO COUNTY PLANNING AND COMMUNITY DEVELOPMENT - INSPECTIONS, PRIOR TO STARTING CONSTRUCTION.
- IT IS THE CONTRACTOR'S RESPONSIBILITY TO UNDERSTAND THE REQUIREMENTS OF ALL JURISDICTIONAL AGENCIES AND TO OBTAIN ALL REQUIRED PERMITS, INCLUDING BUT NOT LIMITED TO EL PASO COUNTY EROSION AND STORMWATER QUALITY CONTROL PERMIT (ESQCP), REGIONAL BUILDING FLOODPLAIN DEVELOPMENT PERMIT, U.S. ARMY CORPS OF ENGINEERS-ISSUED 401 AND/OR 404 PERMITS, AND COUNTY AND STATE FUGITIVE DUST PERMITS.
- CONTRACTOR SHALL NOT DEVIATE FROM THE PLANS WITHOUT FIRST OBTAINING WRITTEN APPROVAL FROM THE DESIGN ENGINEER AND PCD. CONTRACTOR SHALL NOTIFY THE DESIGN ENGINEER IMMEDIATELY UPON DISCOVERY OF ANY ERRORS OR INCONSISTENCIES.
- ALL STORM DRAIN PIPE SHALL BE CLASS III RCP OR CLASS IV WITH WATER TIGHT JOINTS WHERE CALLED OUT, UNLESS OTHERWISE NOTED AND APPROVED BY PCD.
- CONTRACTOR SHALL COORDINATE GEOTECHNICAL TESTING PER ECM STANDARDS. PAVEMENT DESIGN SHALL BE APPROVED BY EL PASO COUNTY PCD PRIOR TO PLACEMENT OF CURB AND GUTTER AND PAVEMENT.
- ALL CONSTRUCTION TRAFFIC MUST ENTER/EXIT THE SITE AT APPROVED CONSTRUCTION ACCESS POINTS.
- SIGHT VISIBILITY TRIANGLES AS IDENTIFIED IN THE PLANS SHALL BE PROVIDED AT ALL INTERSECTIONS. OBSTRUCTIONS GREATER THAN 18 INCHES ABOVE FLOWLINE ARE NOT ALLOWED WITHIN SIGHT TRIANGLES.
- SIGNING AND STRIPING SHALL COMPLY WITH EL PASO COUNTY DEPARTMENT OF PUBLIC WORKS AND MUTCD CRITERIA.
- CONTRACTOR SHALL OBTAIN ANY PERMITS REQUIRED BY EL PASO COUNTY DEPARTMENT OF PUBLIC WORKS, INCLUDING WORK WITHIN THE RIGHT-OF-WAY AND SPECIAL TRANSPORT PERMITS.
- THE LIMITS OF CONSTRUCTION SHALL REMAIN WITHIN THE PROPERTY LINE UNLESS OTHERWISE NOTED. THE OWNER/DEVELOPER SHALL OBTAIN WRITTEN PERMISSION AND EASEMENTS, WHERE REQUIRED, FROM ADJOINING PROPERTY OWNER(S) PRIOR TO ANY OFF-SITE DISTURBANCE, GRADING, OR CONSTRUCTION.

EL PASO COUNTY SIGNING AND STRIPING NOTES:

- ALL SIGNS AND PAVEMENT MARKINGS SHALL BE IN COMPLIANCE WITH THE CURRENT MANUAL ON UNIFORM TRAFFIC CONTROL DEVICES (MUTCD).
- REMOVAL OF EXISTING PAVEMENT MARKINGS SHALL BE ACCOMPLISHED BY A METHOD THAT DOES NOT MATERIALLY DAMAGE THE PAVEMENT. THE PAVEMENT MARKINGS SHALL BE REMOVED TO THE EXTENT THAT THEY WILL NOT BE VISIBLE UNDER DAY OR NIGHT CONDITIONS. AT NO TIME WILL IT BE ACCEPTABLE TO PAINT OVER EXISTING PAVEMENT MARKINGS.
- ANY DEVIATION FROM THE STRIPING AND SIGNING PLAN SHALL BE APPROVED BY EL PASO COUNTY PLANNING AND COMMUNITY DEVELOPMENT.
- ALL SIGNS SHOWN ON THE SIGNING AND STRIPING PLAN SHALL BE NEW SIGNS. EXISTING SIGNS MAY REMAIN OR BE REUSED IF THEY MEET CURRENT EL PASO COUNTY AND MUTCD STANDARDS.
- STREET NAME AND REGULATORY STOP SIGNS SHALL BE ON THE SAME POST AT INTERSECTIONS.
- ALL REMOVED SIGNS SHALL BE DISPOSED OF IN A PROPER MANNER BY THE CONTRACTOR.
- ALL STREET NAME SIGNS SHALL HAVE "D" SERIES LETTERS, WITH LOCAL ROADWAY SIGNS BEING 4" UPPER-LOWER CASE LETTERING ON 8" BLANK AND NON-LOCAL ROADWAY SIGNS BEING 6" LETTERING, UPPER-LOWER CASE ON 12" BLANK, WITH A WHITE BORDER THAT IS NOT RECESSED. MULTI-LANE ROADWAYS WITH SPEED LIMITS OF 40 MPH OR HIGHER SHALL HAVE 8" UPPER-LOWER CASE LETTERING ON 18" BLANK WITH A WHITE BORDER THAT IS NOT RECESSED. THE WIDTH OF THE NON-RECESSED WHITE BORDERS SHALL MATCH PAGE 255 OF THE 2012 MUTCD "STANDARD HIGHWAY SIGNS."
- ALL TRAFFIC SIGNS SHALL HAVE A MINIMUM HIGH INTENSITY PRISMATIC GRADE SHEETING.
- ALL LOCAL RESIDENTIAL STREET SIGNS SHALL BE MOUNTED ON A 1.75" X 1.75" SQUARE TUBE SIGN POST AND STUB POST BASE. FOR OTHER APPLICATIONS, REFER TO THE CDOT STANDARD S-614-8 REGARDING USE OF THE P2 TUBULAR STEEL POST SUBBASE DESIGN.
- ALL SIGNS SHALL BE SINGLE SHEET ALUMINUM WITH 0.100" MINIMUM THICKNESS.
- ALL LIMIT LINES/STOP LINES, CROSSWALK LINES, PAVEMENT LEGENDS, AND ARROWS SHALL BE A MINIMUM 125 MIL THICKNESS PREFORMED THERMOPLASTIC PAVEMENT MARKINGS WITH TAPERED LEADING EDGES PER CDOT STANDARD S-627-1. WORD AND SYMBOL MARKINGS SHALL BE THE NARROW TYPE. STOP BARS SHALL BE 24" IN WIDTH. CROSSWALKS LINES SHALL BE 24" WIDE AND 9' LONG.
- ALL LONGITUDINAL LINES SHALL BE A MINIMUM 15MIL THICKNESS EPOXY PAINT. ALL NON-LOCAL RESIDENTIAL ROADWAYS SHALL INCLUDE BOTH RIGHT AND LEFT EDGE LINE STRIPING AND ANY ADDITIONAL STRIPING AS REQUIRED BY CDOT S-627-1.
- THE CONTRACTOR SHALL NOTIFY EL PASO COUNTY PLANNING AND COMMUNITY DEVELOPMENT (719) 520-6819 PRIOR TO AND UPON COMPLETION OF SIGNING AND STRIPING.
- THE CONTRACTOR SHALL OBTAIN A WORK IN THE RIGHT OF WAY PERMIT FROM THE EL PASO COUNTY DEPARTMENT OF PUBLIC WORKS (DPW) PRIOR TO ANY SIGNAGE OR STRIPING WORK WITHIN AN EXISTING EL PASO COUNTY ROADWAY.

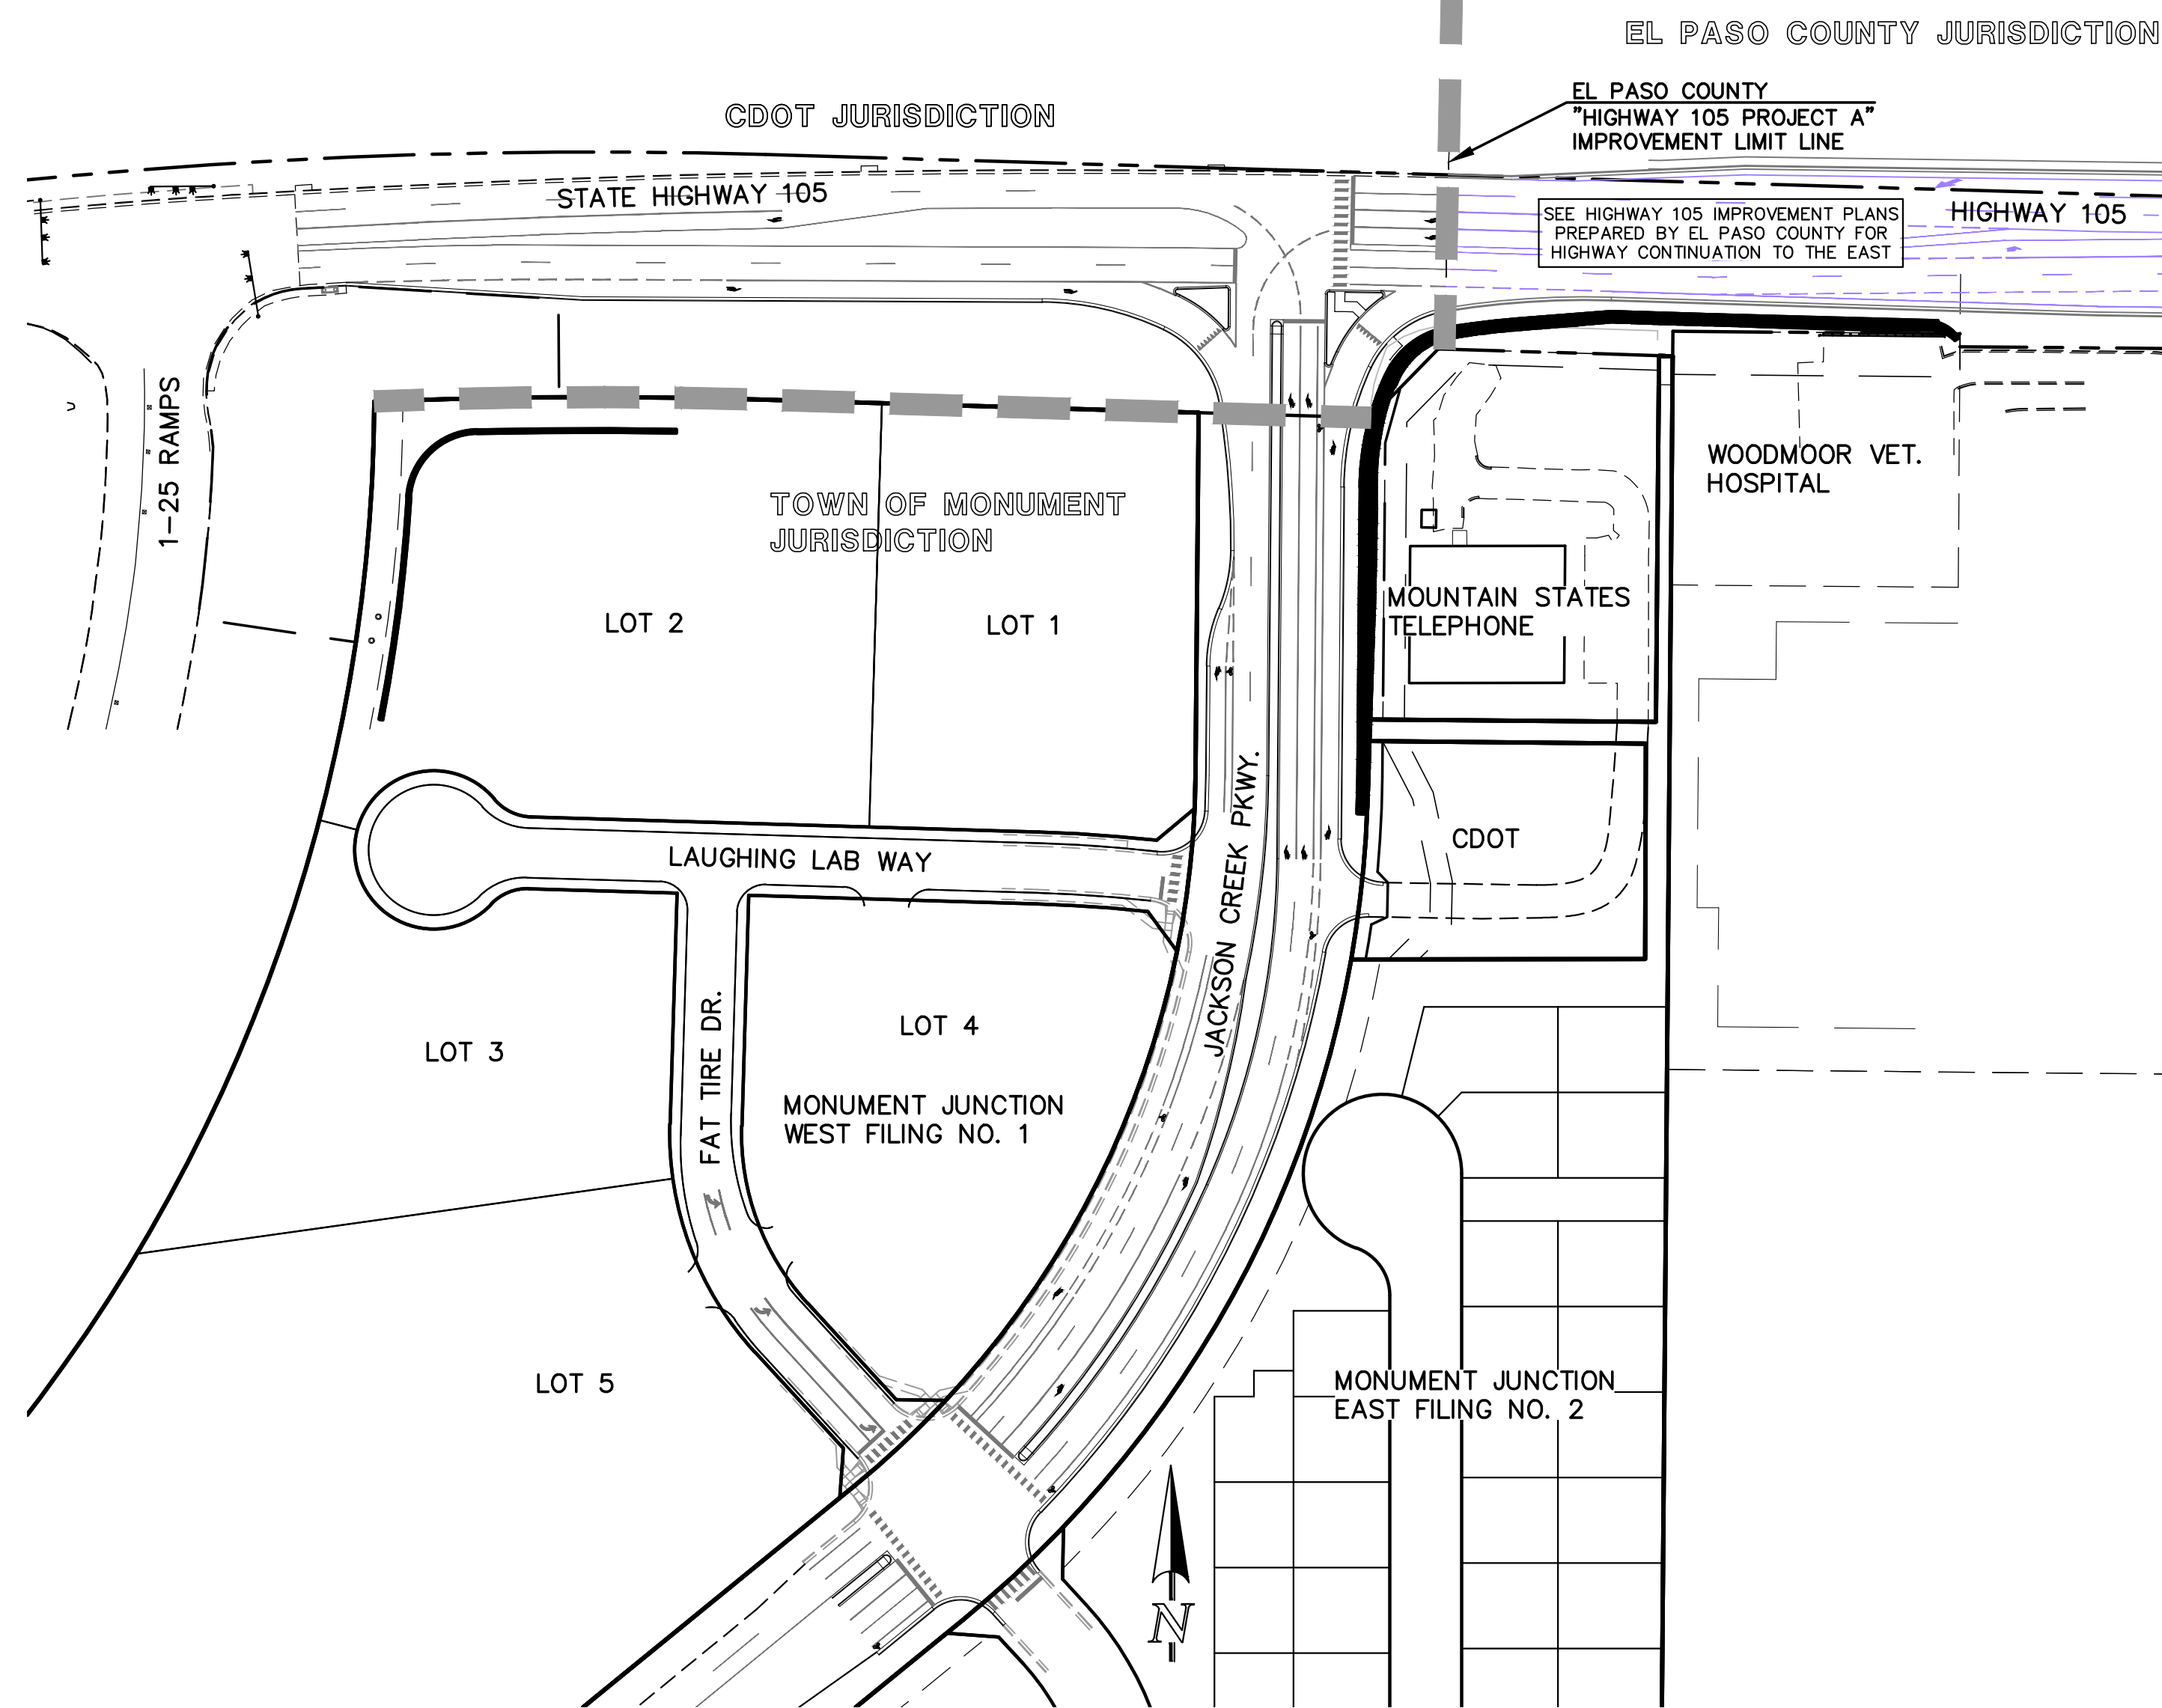

KEY MAP
1" = 100'

EDARP PROJECT NUMBER: CDR237

48 HOURS BEFORE YOU DIG, CALL UTILITY LOCATORS 811 UTILITY NOTIFICATION CENTER OF COLORADO IT'S THE LAW		NO. REVISION	DATE
THE LOCATIONS OF EXISTING UNDERGROUND UTILITIES ARE SHOWN IN AN APPROXIMATE WAY ONLY. THE CONTRACTOR SHALL DETERMINE THE EXACT LOCATION OF ALL EXISTING UTILITIES BEFORE COMMENCING WORK. THE CONTRACTOR SHALL BE FULLY RESPONSIBLE FOR ANY AND ALL DAMAGES WHICH MIGHT BE CAUSED BY HIS FAILURE TO EXACTLY LOCATE AND PRESERVE ANY AND ALL UNDERGROUND UTILITIES.		1	REVISED PER CDOT/COUNTY COMMENTS 5/11/23

REVIEW:	DATE
PREPARED UNDER MY DIRECT SUPERVISION FOR AND ON BEHALF OF CLASSIC CONSULTING ENGINEERS AND SURVEYORS, LLC	
MARC A. WHORTON, COLORADO P.E. #37155	

CLASSIC CONSULTING

DESIGNED BY: PRA
DRAWN BY: PRA
CHECKED BY: (V)

SCALE: (H) 1"=VARIES
(V) 1"= N/A

DATE: 02-23-23
SHEET: 1 OF 26
JOB NO.: 1302.22

STATE HIGHWAY 105 / JACKSON CREEK PKWY. - PHASE 2 CONSTRUCTION PLANS

ROADWAY IMPROVEMENT PLANS

TITLE SHEET

DESIGNED BY: PRA
DRAWN BY: PRA
CHECKED BY: (V)

SCALE: (H) 1"=VARIES
(V) 1"= N/A

DATE: 02-23-23
SHEET: 1 OF 26
JOB NO.: 1302.22

AGENCIES

- DEVELOPER: ELITE PROPERTIES OF AMERICA, INC.
2138 FLYING HORSE CLUB DR
COLORADO SPRINGS, CO 80921
MR. STEVE SCHLOSSER, (719) 592-9333
- CIVIL ENGINEER: CLASSIC CONSULTING
619 N. CASCADE AVENUE, SUITE 200
COLORADO SPRINGS, COLORADO 80903
MR. MARC A. WHORTON, P.E. (719) 785-2802
- COLORADO DEPARTMENT OF TRANSPORTATION, PERMIT REVIEW: REGION 2 - ACCESS
5615 WILLS BOULEVARD
PUEBLO, COLORADO 81008
MS. MICHELLE REGALDO (719) 546-5416
- COLORADO DEPARTMENT OF TRANSPORTATION, NORTH PROGRAM: REGION 2 - NORTH PROGRAM
1480 QUAIL LAKE LOOP ROAD, SUITE A
COLORADO SPRINGS, COLORADO 80906
MR. ANDY STECKLEIN, P.E. (719) 227-3264
- COLORADO DEPARTMENT OF TRANSPORTATION, ENVIRONMENTAL / ROW: REGION 2 - ACCESS
5615 WILLS BOULEVARD
PUEBLO, COLORADO 81008
MR. GABRIEL COSYLEON (719) 562-5528 (ENV. MANAGER)
MR. AMBER BILLINGS (719) 227-5725 (ROW MANAGER)
- COUNTY ENGINEERING: EL PASO COUNTY PLANNING AND COMMUNITY DEVELOPMENT
2880 INTERNATIONAL CIRCLE, SUITE 110
COLORADO SPRINGS, COLORADO 80910
MR. GILBERT LAFORCE (719) 520-7945
- GAS COMPANY: BLACKHILLS ENERGY
37 WIDEFIELD BOULEVARD
WIDEFIELD, COLORADO 80911
MR. GEORGE M. PETERSON, (719) 392-3491
- ELECTRIC COMPANY: MOUNTAIN VIEW ELECTRIC
P.O. BOX 1600
LIMON, COLORADO 80828
MR. LES ULFERS, (719) 495-2283
- TELEPHONE COMPANY: U.S. WEST COMMUNICATIONS (LOCATORS) (800) 922-1987

APPROVALS:

DESIGN ENGINEER'S STATEMENT:

THESE DETAILED PLANS AND SPECIFICATIONS WERE PREPARED UNDER MY DIRECTION AND SUPERVISION. SAID PLANS AND SPECIFICATIONS HAVE BEEN PREPARED ACCORDING TO THE CRITERIA ESTABLISHED BY THE COUNTY FOR DETAILED ROADWAY, DRAINAGE, GRADING AND EROSION CONTROL PLANS AND SPECIFICATIONS, AND SAID PLANS AND SPECIFICATIONS ARE IN CONFORMITY WITH APPLICABLE MASTER DRAINAGE PLANS AND MASTER TRANSPORTATION PLANS. SAID PLANS AND SPECIFICATIONS MEET THE PURPOSES FOR WHICH THE PARTICULAR ROADWAY AND DRAINAGE FACILITIES ARE DESIGNED AND ARE CORRECT TO THE BEST OF MY KNOWLEDGE AND BELIEF. I ACCEPT RESPONSIBILITY FOR ANY LIABILITY DIRECTLY CAUSED BY THE NEGLIGENCE, ACTS, ERRORS, OR OMISSIONS ON MY PART IN PREPARATION OF THESE DETAILED PLANS AND SPECIFICATIONS.

MARC A. WHORTON, COLORADO P.E. #37155 DATE _____
FOR AND ON THE BEHALF OF CLASSIC CONSULTING ENGINEERS & SURVEYORS

OWNER/DEVELOPER'S STATEMENT:

I, THE OWNER/DEVELOPER HAVE READ AND WILL COMPLY WITH THE REQUIREMENTS OF THE GRADING AND EROSION CONTROL PLAN AND ALL OF THE REQUIREMENTS SPECIFIED IN THESE DETAILED PLANS AND SPECIFICATIONS.

STEVE SCHLOSSER DATE _____

TOWN OF MONUMENT APPROVAL:

THESE PLANS HAVE BEEN REVIEWED BY TOWN OF MONUMENT STAFF AND FOUND TO BE IN GENERAL COMPLIANCE WITH TOWN STANDARDS. IT IS THE RESPONSIBILITY OF THE SITE ENGINEER AND GENERAL CONTRACTOR TO ENSURE COMPLIANCE WITH THESE PLANS AND IN CONFORMANCE WITH THE TOWN OF MONUMENT ORDINANCES AND REGULATIONS. THE SPECIFICATIONS, STANDARDS, AND INTENT OF THE TOWN OF MONUMENT ORDINANCES, REGULATIONS AND THE CITY OF COLORADO SPRINGS DRAINAGE CRITERIA MANUALS VOLUMES 1 AND 2 SHALL PREVAIL IN ANY INSTANCES WHERE THESE PLANS DIFFER FROM THOSE REQUIREMENTS. THE DEVELOPMENT SERVICES DEPARTMENT SHALL BE NOTIFIED IF ANY CHANGES NEED TO BE MADE.

THIS REVIEW IS ONLY FOR THE PROPOSED CONSTRUCTION ON JACKSON CREEK PARKWAY.

SIGNED _____ DATE _____
TOWN OF MONUMENT

EL PASO COUNTY:

COUNTY PLAN REVIEW IS PROVIDED ONLY FOR GENERAL CONFORMANCE WITH COUNTY DESIGN CRITERIA. THE COUNTY IS NOT RESPONSIBLE FOR THE ACCURACY AND ADEQUACY OF THE DESIGN, DIMENSIONS, AND/OR ELEVATIONS WHICH SHALL BE CONFIRMED AT THE JOB SITE. THE COUNTY THROUGH THE APPROVAL OF THIS DOCUMENT ASSUMES NO RESPONSIBILITY FOR COMPLETENESS AND/OR ACCURACY OF THIS DOCUMENT.

FILED IN ACCORDANCE WITH THE REQUIREMENTS OF THE EL PASO COUNTY LAND DEVELOPMENT CODE, DRAINAGE CRITERIA MANUAL, VOLUMES 1 AND 2 AND ENGINEERING CRITERIA MANUAL AS AMENDED.

IN ACCORDANCE WITH WITH ECM SECTION 1.12, THESE CONSTRUCTION DOCUMENTS WILL BE VALID FOR CONSTRUCTION FOR A PERIOD OF 2 YEARS FROM THE DATE SIGNED BY THE EL PASO COUNTY ENGINEER. IF CONSTRUCTION HAS NOT STARTED WITHIN THOSE 2 YEARS, THE PLANS WILL NEED TO BE RESUBMITTED FOR APPROVAL, INCLUDING PAYMENT OF REVIEW FEES AT THE PLANNING AND COMMUNITY DEVELOPMENT DIRECTOR'S DISCRETION.

THIS REVIEW IS ONLY FOR THE PROPOSED CONSTRUCTION IN HIGHWAY 105, EAST OF JACKSON CREEK PARKWAY.

JOSHUA PALMER, P.E. DATE _____
COUNTY ENGINEER / ECM ADMINISTRATOR

N:\130222\UPRAWINGS\CONSTRUCTION\DRAWINGS\01-SHEET-01-TITLE-SHEET.dwg, 7/14/2023, 11:13:19 AM, eraprop, 1:1

CDOT GENERAL NOTES

- ALL CONSTRUCTION MATERIALS, TECHNIQUES, AND PROCEDURES WITHIN THE HIGHWAY LIMITS SHALL BE IN CONFORMANCE WITH THE COLORADO DEPARTMENT OF TRANSPORTATION (CDOT) STANDARD SPECIFICATIONS FOR ROAD CONSTRUCTION AS SET FORTH IN THE LATEST "M & S" STANDARDS MANUAL.
- A FULLY EXECUTED COMPLETE COPY OF THE ACCESS PERMITS AND A VALID NOTICE TO PROCEED TO CONSTRUCTION MUST BE ON THE JOB SITE WITH THE CONTRACTOR AT ALL TIMES DURING CONSTRUCTION.
- ANY ADDITIONAL PERMITS AND CLEARANCES REQUIRED BY OTHER FEDERAL, STATE, AND LOCAL GOVERNMENT AGENCIES IS THE RESPONSIBILITY OF THE OWNER/DEVELOPER.
- IT SHALL BE THE RESPONSIBILITY OF THE CONTRACTOR TO VERIFY THE EXISTENCE AND LOCATION OF ALL UNDERGROUND UTILITIES ALONG THE ROUTE OF HIGHWAY CONSTRUCTION. THE OMISSION FROM OR THE INCLUSION OF UTILITY LOCATIONS ON THE PLANS IS NOT TO BE CONSIDERED AS THE NONEXISTENCE OF OR A DEFINITE LOCATION OF EXISTING UNDERGROUND UTILITIES.
- THE CONTRACTOR WILL TAKE THE NECESSARY PRECAUTIONS TO PROTECT EXISTING UTILITIES FROM DAMAGE DUE TO THIS OPERATION. ANY DAMAGE TO THE UTILITIES WILL BE REPAIRED AT THE CONTRACTOR'S EXPENSE, AND ANY SERVICE DISRUPTION WILL BE SETTLED BY THE CONTRACTOR.
- ALL STATIONING IS CENTERLINE UNLESS OTHERWISE INDICATED. ALL ELEVATIONS ARE CENTERLINE UNLESS OTHERWISE INDICATED.
- FIVE WORKING DAYS PRIOR TO BEGINNING CONSTRUCTION, THE OWNER/CONTRACTOR MUST CONTACT MR. RON YOUNG (719) 289-8718, CDOT ACCESS/TRAFFIC MANAGER, TO COORDINATE CONSTRUCTION.
- WORK SHALL BEGIN AFTER 8:30 AM AND ALL EQUIPMENT SHALL BE OUT OF THE RIGHT-OF-WAY BEFORE 3:00 PM DURING SCHOOL HOURS/DAYS. NO WORK IS ALLOWED WITHIN THE HIGHWAY RIGHT-OF-WAY ON WEEKENDS OR STATE/FEDERAL HOLIDAYS. NO CONSTRUCTION VEHICLES SHALL BE PARKED, OR CONSTRUCTION MATERIALS STOCKPILED IN THE HIGHWAY RIGHT-OF-WAY OVERNIGHT. NO PRIVATE VEHICLES MAY BE PARKED IN THE HIGHWAY RIGHT-OF-WAY AT ANY TIME DURING CONSTRUCTION.
- TWO WAY TRAFFIC SHALL BE MAINTAINED THROUGHOUT THE WORK AREA AT ALL TIMES.
- ALL SIGNS SHALL BE MANUFACTURED IN ACCORDANCE WITH THE MANUAL ON UNIFORM TRAFFIC CONTROL DEVICES (M.U.T.C.D.). THE SHEETING FOR THE SIGNS BE HIGHWAY INTENSITY SHEETING (ASTM TYPE IV RETRO REFLECTIVE SHEETING).
- ALL DISTURBED PAVEMENT EDGES SHALL BE CUT TO NEAT LINES 1' FROM EXISTING EDGE OF PAVEMENT. NEW SURFACING FOR THE ACCESS AND THE HIGHWAY WIDENING SHALL BE A FULL DEPTH TOTAL OF 7 INCHES OF COMPACTED HOT MIX ASPHALT (HMA), GRAD-S(100), PG. 58-28 OR PG. 64-22 (WITH 1% LIME) PLACED IN 3 LIFTS, OVER 12 INCHES OF CEMENT TREATED SUBGRADE, OVER COMPACTED RANDOM FILL SUBGRADE WITH A MINIMUM R-VALUE OF 17 CONFIRMED WITH R2 MATERIALS.
- PLACEMENT AND COMPACTION OF HOT MIX ASPHALT (HMA) SHALL COMPLY WITH SECTION 401 OF THE 2005 CDOT STANDARD SPECIFICATIONS AS WELL AS THE LATEST CDOT STANDARD SPECIAL PROVISIONS.
- PLACEMENT AND COMPACTION OF SUB-GRADE, EMBANKMENTS, AND BACKFILLS SHALL COMPLY WITH SECTION 203 OF THE CDOT STANDARD SPECIFICATIONS AS WELL AS THE LATEST CDOT STANDARD SPECIAL PROVISIONS.
- SOIL PREPARATION INCLUDING TOPSOIL, SEEDING, AND MULCHING IS REQUIRED WITHIN THE HIGHWAY RIGHT-OF-WAY ON ALL DISTURBED AREAS NOT SURFACED AND THOSE AREAS BEYOND THE HIGHWAY THAT MAY ERODE AND SEND DEBRIS INTO THE HIGHWAY RIGHT-OF-WAY.
- ADDITIONAL EROSION CONTROL STRUCTURES MAY BE REQUIRED AT THE TIME OF CONSTRUCTION.
- WIDENED AREAS OF THE ROADWAY SHALL BE A MINIMUM OF 20-YEAR DESIGN LIFE.
- OVERLAY OF EXISTING PAVEMENT SHALL ALSO BE A MINIMUM OF 20-YEAR DESIGN LIFE TO AVOID DIFFERING MAINTENANCE ISSUES BETWEEN THE OVERLAY SECTION AND THE NEW PAVEMENT WIDENING.
- WATER SHALL BE USED AS A DUST PALLIATIVE WHERE REQUIRED. COST OF WATER SHALL BE INCLUDED IN THE WORK.
- THIS DESIGN IS IN FULL COMPLIANCE WITH SECTION 4 OF THE STATE HIGHWAY ACCESS CODE, 2 COR 601-1 EXCEPT FOR THE FOLLOWING APPROVED VARIANCES: NONE
- THIS DESIGN IS IN FULL COMPLIANCE WITH TITLE II ADA ACCESSIBILITY REQUIREMENTS EXCEPT FOR THE FOLLOWING APPROVED VARIANCES: NONE

COLORADO DEPARTMENT OF TRANSPORTATION:
 CDOT PLAN REVIEW IS PROVIDED ONLY FOR GENERAL CONFORMANCE WITH THE CDOT DESIGN CRITERIA. CDOT IS NOT RESPONSIBLE FOR THE ACCURACY AND ADEQUACY OF THE DESIGN, DIMENSIONS, AND/OR ELEVATIONS WHICH SHALL BE CONFIRMED AT THE JOB SITE. CDOT THROUGH THE APPROVAL OF THIS DOCUMENT ASSUMES NO RESPONSIBILITY FOR COMPLETENESS AND/OR ACCURACY OF THIS DOCUMENT.

EL PASO COUNTY TRAFFIC SIGNAL NOTES

- THE CONTRACTOR SHALL PROVIDE, FOR REVIEW, BY THE ENGINEER, A COMPLETE TRAFFIC SIGNAL MATERIAL SUBMITTAL PACKAGE THAT CONTAINS, ALL OF THE PROPOSED TRAFFIC SIGNAL EQUIPMENT, INCLUDING MATERIAL SPECIFICATIONS AND DESCRIPTIONS THAT WILL BE NECESSARY TO COMPLETE THE TRAFFIC SIGNAL WORK. THE CONTRACTOR SHALL ALLOW FOR A MINIMUM THREE-WEEK SUBMITTAL REVIEW PERIOD AND SHALL NOT ORDER ANY SIGNAL EQUIPMENT UNTIL AFTER A REVIEW OF ALL SUBMITTALS HAVE BEEN COMPLETED BY THE ENGINEER AND VERIFIED BY THE CONTRACTOR.
- FUNCTIONAL AND OPERATIONAL RESPONSIBILITY FOR ALL NEWLY INSTALLED AND EXISTING TRAFFIC SIGNAL EQUIPMENT WILL BECOME THE RESPONSIBILITY OF THE CONTRACTOR UNTIL FINAL ACCEPTANCE OF THE PROJECT. THE CONTRACTOR SHALL CONSIDER THIS WORK INCIDENTAL TO THE OVERALL WORK BEING PERFORMED AND SHALL BE INCLUDED AS PART OF THE PROJECT.
- SEE COLORADO DEPARTMENT OF TRANSPORTATION SIGNAL DETAILS FOR CONSTRUCTION/ INSTALLATION DETAILS NOT SHOWN ON THESE PLANS.
- ALL SIGNAL EQUIPMENT REMOVED BY THE CONTRACTOR SHALL BE SALVAGED AND BECOME THE PROPERTY OF EL PASO COUNTY. THE SALVAGED EQUIPMENT SHALL BE DELIVERED AS DIRECTED BY THE ENGINEER. DELIVERY OF THE SIGNAL EQUIPMENT WILL NOT BE PAID FOR SEPARATELY, BUT WILL BE INCLUDED IN THE WORK FOR REMOVAL OF TRAFFIC SIGNAL EQUIPMENT.
- OVERHEAD STREET NAME SIGN DESIGN AND LAYOUT INFORMATION SHALL BE PER THE STREET NAME SIGN DETAIL CONTAINED IN THE PROJECT PLAN.
- TRAFFIC SIGNS MOUNTED ON SIGNAL POLES, MAST ARMS, AND PEDESTALS SHALL BE MOUNTED USING BANDING, ALUMINUM CHANNELS, AND BACKING ZEES PER APPLICABLE CDOT STANDARD PLANS, OR SIMILAR RIGID SIGN BRACING MOUNTING ASSEMBLY.
- ONCE THE PROFESSIONAL ENGINEERING CONSULTANT HAS COMPLETED ALL TRAFFIC SIGNAL CONTROLLER TIMING DEVELOPMENT AND CONTROLLER PROGRAMMING, THE CONTRACTOR WILL COORDINATE THE DELIVERY DATE OF THE PROGRAMMED TRAFFIC SIGNAL CONTROLLER FOR REVIEW OF EPC DEPARTMENT OF PUBLIC WORKS, HIGHWAY DIVISION SIGNAL SHOP AND ALLOW FOR A MINIMUM TWO-WEEK REVIEW PERIOD, AFTER WHICH TIME THE CONTRACTOR MAY MAKE ARRANGEMENTS FOR PICKING UP THE SIGNAL CONTROLLER.
- CONTROLLER CABINET SHALL BE FURNISHED WITH A "BEST" DOOR LOCK KIT LOCK AND CODE IS "BEST"; 5/6R LEFT AND RIGHT.
- CONDUIT IS TO BE REPLACED IN THE EVENT THAT EXISTING CONDUIT IS DAMAGED AND AS DIRECTED BY THE ENGINEER.
- ELECTRICAL SERVICE DISCONNECT BOXES SHALL BE LOCKABLE AND WEATHER PROOF WITH NEMA TYPE CIRCUIT BREAKER. ENCLOSURES SHALL BE PROVIDED AT THE CONNECTION POINT OF EACH POWER SOURCE OR POINT OF SERVICE AS DIRECTED BY THE ENGINEER.
- THE CONTRACTOR SHALL FURNISH AND INSTALL ALL WIRING REQUIRED TO COMPLETE THE INSTALLATION AND ESTABLISH THE FUNCTIONALITY OF ALL TRAFFIC SIGNAL EQUIPMENT.
- ALL INCIDENTAL ITEMS NOT SHOWN IN THE SUMMARY OF APPROXIMATE QUANTITIES OR TABULATION OF SIGNAL EQUIPMENT SHALL BE CONSIDERED TO BE INCLUDED AS PART OF THE TRAFFIC SIGNAL INSTALLATION AND WILL NOT BE MEASURED AND PAID FOR SEPARATELY. ALL QUANTITIES ARE APPROXIMATE. THE CONTRACTOR SHALL BE RESPONSIBLE FOR ALL WORK NECESSARY TO COMPLETE THE CONSTRUCTION SHOWN ON THESE PLANS.
- THE SIGNAL SHALL NOT BE TURNED ON OR STARTED UNTIL DIRECTED BY THE ENGINEER. PRIOR TO SIGNAL ACTIVATION, THE ENGINEER SHALL CONFIRM THAT THE APPROPRIATE PAVEMENT MARKINGS AND SIGNING ARE IN PLACE AND THAT ALL WORK NECESSARY FOR PROPER SIGNAL OPERATION HAS BEEN COMPLETED.
- THE SIGNAL CONTROLLER SHALL BE A MACCRAIN 2070 FLEX ATC CONTROLLER AND THE CONFLICT MONITOR SHALL BE MODEL 2010 ECU W/ ETHERNET PORT (EDI). THE CONTROLLER CABINET SHALL BE A COOT SPECIFICATION MODEL 332D WITH BATTERY BACKUP AND AUX RACK AND SHALL CONTAIN ANTI-GRAFFITI SILVER FINISH COATING. THE CABINET SHALL BE MOUNTED ON A CAST-IN-PLACE CONCRETE FOUNDATION PER APPLICABLE COOT'S STANDARDS STANDARD PLAN AND THE CABINET SHALL BE POSITIONED SUCH THAT, WITH THE FRONT DOOR OPEN, BOTH THE CONTROLLER DISPLAY AND THE SIGNAL INSTALLATION BE VISIBLE.
- LUMINAIRES SHALL CONSIST OF AN ASSEMBLY THAT UTILIZES LEDS AS THE LIGHT SOURCE. IN ADDITION, A COMPLETE LUMINAIRE SHALL CONSIST OF A HOUSING, LED ARRAY, AND ELECTRONIC DRIVER (POWER SUPPLY). ALL LUMINAIRES SHALL BE WIRED 120 VOLTS AC WITH MULTI-TAP HEADS. THE LED FIXTURE MUST HAVE A COLOR TEMPERATURE OF 4100K (+/- SOOK), MUST BE DESIGNED TO OPERATE AT A TEMPERATURE RANGE OF -40°F TO 105°F (-40°C TO 40°C), AND PROVIDE A MINIMUM OF 70,000 HOURS OF OPERATION. LUMINAIRES SHALL BE E-LIGHT-STAR LED STREET LIGHT, OR APPROVED EQUIVALENT. THE CONTRACTOR SHALL PROVIDE A RECOMMENDATION FOR TYPE OF THE STREET LIGHT BASED ON THE CONSTRUCTION PLANS AND MANUFACTURER'S SPECIFICATIONS, TO BE APPROVED BY THE ENGINEER. THE FIXTURE MUST BE CAST ALUMINUM, PROVIDED WITH FUSING, SURGE SUPPRESSION AND MUST BE UL LISTED FOR WET LOCATIONS. THE FIXTURE MUST HAVE AN INTERNAL WEATHER-TIGHT LED DRIVE. NO ACTIVE COOLING FEATURES (FANS, ETC.) WILL BE ALLOWED. THE FINISHED SHALL MATCH THE EXTENSION ARM SHAFTS. THE LUMINAIRES WILL BE INSTALLED ON 15 FOOT EXTENSION ARM SHAFTS AT NOMINAL HEIGHT OF 40 FEET AND SHALL BE WELDED TO THE SIGNAL POLE PER CDOT TYPICAL TRAFFIC SIGNAL INSTALLATION DETAILS STANDARD PLAN S-614-40. LUMINAIRE ARM SHAFT SHALL BE IN ACCORDANCE WITH THE PROJECT PLANS.
- THE INTERSECTION DETECTION SYSTEM (MICROWAVE RADAR) CONTRACT ITEM INCLUDES DEVICE INSTALLATION (I.E., DETECTOR UNIT, HARDWARE, WIRING, PROCESSOR MODULE, ETC.), AND VERIFICATION OF SUCCESSFUL IN-FIELD DETECTION ZONE OPERATION BASED ON SEVERAL VEHICLE ACTIONS IN ALL DETECTION ZONES.
- THE CONTRACTOR SHALL COORDINATE THE SCHEDULES OF THE CONTRACTED PROFESSIONAL ENGINEERING CONSULTANT AND THE EPC DEPARTMENT OF PUBLIC WORKS, HIGHWAY DIVISION TRAFFIC SIGNAL STAFF FOR SCHEDULING THE ON-SITE FIELD IMPLEMENTATION OF ALL TRAFFIC SIGNAL TIMING AND OPERATIONAL PROGRAMMING, VEHICLE DETECTION ZONE PLACEMENT, AND DETECTION EQUIPMENT POSITIONING. THIS WORK SHALL BE SCHEDULED NEAR THE END OF THE PROJECT, PRIOR TO PROJECT ACCEPTANCE, AND ONLY AFTER ALL FINAL PAVEMENT MARKINGS, SIGNING, AND TRAFFIC SIGNAL WORK HAS BEEN COMPLETED.
- THE MICROWAVE RADAR DETECTION SYSTEM SHALL UTILIZE MS SEDCO INTERSECTOR TC-K1-SBE WITH INTERFACE BOARD.
- PEDESTRIAN SIGNAL HEAD INSTALLATION SHALL INCLUDE ALUMINUM AND POWDER COATED GLOSS BLACK SIGNAL HEAD WITH APPROVED LED COUNTDOWN DISPLAY, ALUMINUM OPEN VISOR WITH THE OUTSIDE POWDER COATED GLOSS BLACK, PUSHBUTTON, AND INSTRUCTIONAL R10-3E COUNTDOWN PEDESTRIAN ACTUATION SIGN. PUSHBUTTONS SHALL BE POLERA NAVIGATOR S 2-WIRE PUSH BUTTONS, SPECIFIED AS INS2 5 UN 1-B-BD-ES, OR APPROVED EQUIVALENT. CUSTOM MESSAGING SHALL NOT INTERFERE WITH TRADITIONAL NON-VISUAL FORMATS SPECIFIED IN 4E OF THE MUTCD AND SHALL ONLY PROVIDE ADDITIONAL INFORMATION AS DIRECTED BY THE ENGINEER.
- ALL TRAFFIC SIGNAL POLES, MAST ARMS, PEDESTALS, AND LUMINAIRE ARMS SHALL HAVE A GLOSS BLACK COAT FINISH OVER HOT DIP GALVANIZED BASE COAT, INSTALLED IN ACCORDANCE WITH THE PAINT MANUFACTURER'S INSTRUCTIONS.
- ALL SIGNAL POLE AND CONTROLLER LOCATIONS SHOWN ARE APPROXIMATE ONLY. MAST ARMS SHALL BE OF SUFFICIENT LENGTH AND DESIGN TO ALLOW PROPER PLACEMENT OF SIGNAL HEADS AND OVERHEAD SIGNING PER THE PLANS. ACTUAL LOCATIONS SHALL BE STAKED IN THE FIELD AND FIELD VERIFIED BY THE ENGINEER PRIOR TO DRILLING, EXCAVATION, AND ORDERING THE SIGNAL EQUIPMENT AND MAST ARMS. THE LOCATION OF EACH SIGNAL POLE FOUNDATION SHALL BE POTHOLED PRIOR TO DRILLING TO CONFIRM WHETHER OR NOT ANY UTILITY CONFLICTS EXIST.
- LATERAL OFFSETS FROM THE NEAR EDGE OF TRAFFIC SIGNAL POLES, PEDESTALS, AND CABINETS TO THE FACE OF CURB OR EDGE OF PAVED SHOULDER SHOULD BE AT LEAST SIX FEET, HOWEVER, A MINIMUM LATERAL OFFSET OF AT LEAST FOUR FEET MAY BE PROVIDED FOR CURB OFFSETS. IF NO PAVED SHOULDER EXISTS, A MINIMUM LATERAL OFFSET OF AT LEAST EIGHT FEET SHOULD BE PROVIDED FROM THE EDGE OF PAVEMENT FOR AN AUXILIARY LANE AND A MINIMUM LATERAL OFFSET OF AT LEAST TWELVE FEET SHOULD BE PROVIDED FROM THE EDGE OF PAVEMENT FOR A THROUGH LANE.
- SHOULD THE CONTRACTOR ENCOUNTER WATER IN THE CAISSON, ANY DE-WATERING METHODS AND NECESSARY PERMITS SHALL BE INCLUDED IN THE COST OF THE CAISSON AND WILL BE CONSIDERED INCIDENTAL TO THE WORK.
- ALL TRAFFIC SIGNAL COMPONENT PULL BOXES SHALL BE PRE-CAST HIGH DENSITY POLYMER CONCRETE (HPCC) MATERIAL WITH THE FOLLOWING SIZES: 36 INCH X 48 INCH X 18 INCH FOR THE PULL BOX ADJACENT TO THE CONTROLLER CABINET FOUNDATION AND 24 INCH X 36 INCH X 18 INCH FOR THE REMAINING PULL BOXES.
- TRAFFIC PULL BOX LOCATIONS SHOWN IN THE PROJECT PLANS ARE APPROXIMATE. ACTUAL LOCATIONS SHALL BE VERIFIED IN THE FIELD BY THE ENGINEER. PULL BOXES SHALL BE FLUSH WITH THE FINISHED GROUND SURFACE AND SHALL NOT BE PLACED IN AREAS THAT ARE SUSCEPTIBLE TO WATER RUNOFF OR STANDING WATER. CONDUIT RUNS BETWEEN PULL BOXES SHALL NOT EXCEED APPROXIMATELY 200 FEET AND PULL BOXES SHALL NOT BE LOCATED IN HANDICAP RAMPS, PEDESTRIAN LANDING AREAS, SIDEWALKS, PRIMARY SIDEWALK PATHS, OR ROADWAY PAVEMENT AREAS.

EL PASO COUNTY TRAFFIC SIGNAL NOTES (CONT.)

- THE CONDUIT NUMBER AND SIZES FOR TYPICAL CONDUIT RUNS INCLUDE THE FOLLOWING FOR A PREEMINENT MAST ARM SIGNAL INSTALLATION.
 - BETWEEN THE SIGNAL POLE FOUNDATION AND ADJACENT SIGNAL POLE PULL BOX: TWO (2) 2 INCH AND ONE (1) 3 INCH.
 - BETWEEN SIGNAL PULL BOXES: TWO (2) 2 INCH AND THREE (3) 3 INCH.
 - BETWEEN THE CONTROLLER CABINET FOUNDATION AND ADJACENT PULL BOX: THREE (3) 2 INCH AND FOUR (4) 3 INCH.
 - BETWEEN THE SECONDARY SERVICE PEDESTAL METER FOUNDATION AND THE CONTROLLER CABINET FOUNDATION ONE (1) 2 INCH FOR THE ELECTRICAL SERVICE FEED.
- ALL CONDUIT AND FITTINGS SHALL BE SCHEDULE 80 PVC AND ALL CONDUIT SHALL HAVE A PULL ROPE LEFT IN THEM WHEN CONSTRUCTION IS COMPLETED. ALL CONDUIT ENTERING THE CABINET FOUNDATION AND PULL BOXES SHALL HAVE BELL END STYLE COUPLINGS ON ALL CONDUIT ENDS.
- ALL CONDUIT THAT IS DIRECTIONALLY BORED SHALL BE A MINIMUM OF THREE FEET BELOW THE EXISTING PAVEMENT. THIS WORK SHALL AVOID DISTURBING OR DAMAGING EXISTING FACILITIES AND THE CONTRACTOR SHALL BE RESPONSIBLE FOR THE PROMPT RECONSTRUCTION, ALTERATION, REPAIR OR MAINTENANCE OF HIGHWAY PROPERTY, AS NECESSARY, TO REPAIR DAMAGE CAUSED BY THE ACCOMMODATION OF THE UTILITY, AND TO RESTORE THE HIGHWAY TO PRE-EXISTING OR BETTER CONDITIONS.
- ALL SIGNAL CABLE SHALL BE CONTINUOUS FROM CONNECTIONS MADE IN THE HANDHOLE COMPARTMENT OF THE SIGNAL POLE BASE TO THE TERMINAL COMPARTMENT OF THE CONTROLLER CABINET AND SHALL CONTAIN NO SPLICES. EACH SIGNAL HEAD SHALL CONTAIN SEPARATE AND CONTINUOUS SIGNAL CABLE FROM THE SIGNAL HEAD TO THE ABOVE GROUND HANDHOLE AT THE BASE OF THE SIGNAL POLE AND SHALL CONTAIN NO SPLICES.
- A SEPARATE AND CONTINUOUS 21 CONDUCTOR CABLE SHALL RUN FROM THE CONTROLLER CABINET TO THE HANDHOLE AT EACH SIGNAL POLE AND SHALL CONTAIN NO SPLICES.
- ALL SIGNS MOUNTED ON SIGNAL POLES, MAST ARMS, AND PEDESTALS SHALL BE MOUNTED USING BANDING ALUMINUM CHANNELS, AND BACKING ZEES PER CDOT TYPICAL POLE MOUNT SIGN INSTALLATIONS STANDARD PLAN S-614-20, OR SIMILAR RIGID SIGN BRACING MOUNTING ASSEMBLY, AS DIRECTED BY THE ENGINEER. MAST ARM SIGNS THAT REQUIRE Z-BRACKETS SHALL BE MOUNTED ON ASTRO-STYLE BRACKETS AND RISERS. THE COST OF ALL HARDWARE FITTINGS, TOOLS, AND EQUIPMENT NECESSARY FOR A COMPLETE INSTALLATION OF MAST ARM SIGNS WILL NOT BE MEASURED AND PAID FOR SEPARATELY BUT SHALL BE INCLUDED IN THE COST OF THE WORK.
- ALL CONDUCTORS AND CABINET WIRING SHALL BE COLOR CODED AND PERMANENTLY TAGGED PER ENGINEER DIRECTION AND IN ACCORDANCE WITH THE SIGNAL PHASE NUMBERING AND DETECTION ZONE PHASE NUMBERING INFORMATION CONTAINED IN THE PROJECT PLANS.
- ALL VEHICLE SIGNAL HEADS SHALL HAVE APPROVED 12 INCH LED INDICATORS AND SHALL BE ALUMINUM WITH POWDER COATED GLOSS BLACK FINISH AND SHALL CONTAIN 12 INCH ALUMINUM TUNNEL VISORS WITH THE OUTSIDE POWDER COATED GLOSS BLACK. ALL VEHICLE SIGNAL HEADS SHALL HAVE ALUMINUM LOUVERED BACK PLATES WITH POWDER COATED GLOSS BLACK FINISH AND YELLOW RETRO REFLECTIVE BORDER. MAST ARM SIGNAL HEADS SHALL USE ASTRO-TYPE MOUNTING ASSEMBLIES AND SHALL BE INSTALLED APPROXIMATELY LEVEL WITH ONE ANOTHER AT A 17 TO 19 FOOT VERTICAL CLEARANCE ABOVE THE HIGH POINT OF THE PAVEMENT GRADE.
- FINAL VEHICLE DIRECTION ZONE PLACEMENT AND DIMENSIONS, IN ACCORDANCE WITH THE PROJECT PLAN, AND FINAL SIGNAL PROGRAMMING SHALL BE COMPLETED IN THE FIELD AND THE CONTRACTOR SHALL CONTACT THE ENGINEER FOR COORDINATING AND SCHEDULING THIS WORK.
- ALL VEHICLE AND PEDESTRIAN SIGNAL HEADS THAT HAVE NOT BEEN PLACED IN SERVICE SHALL BE COVERED WITH PREFABRICATED WEATHER RESISTANT NYLON FORM FITTING SIGNAL FACE COVER MATERIAL. THE SIGNAL FACE SHALL REMAIN COMPLETELY COVERED UNTIL THE SIGNAL HEAD IS PLACED IN SERVICE AND IS FULLY FUNCTIONAL AND OPERATIONAL.
- ALL DETECTION EQUIPMENT, DETECTION ZONES, AND SIGNAL TIMING OPERATION SHALL BE CONFIRMED IN THE FIELD BY THE PROFESSIONAL ENGINEERING CONSULTANT TO BE ACHIEVING SATISFACTORY TRAFFIC SIGNAL OPERATION.
- COMMUNICATION SYSTEM SHALL BE A DYMEX ETHERNET SWITCH KY-3170EMX AND CELLULAR MODEM MICROHARD BULLET LTE, WITH CTEL SURGE SUPPRESSION ON ALL THESE COMPONENTS.
- THE CONTRACTED PROFESSIONAL ENGINEERING TRAFFIC SIGNAL TIMING, CONTROLLER PROGRAMMING AND OPERATION AND OVERALL TRAFFIC SIGNAL OPERATIONAL CONSULTANT SERVICES THAT ARE TO BE RETAINED BY THE OWNER/ DEVELOPER/ DISTRICT SHALL INCLUDE, BUT NOT BE LIMITED TO:
 - DEVELOPING ALL TRAFFIC SIGNAL TIMING AND ALL OPERATIONAL PARAMETERS FOR ACHIEVING ISOLATED, FULL-ACTUATED VEHICLE AND PEDESTRIAN INTERSECTION OPERATION AND, WHEN DOCUMENTED TO BE NECESSARY, COORDINATED SIGNAL SYSTEM TIMING PLAN OPERATION DURING VARIOUS TIMES OF THE DAY.
 - PROGRAMMING ALL SIGNAL TIMING PARAMETERS INTO THE TRAFFIC SIGNAL CONTROLLER.
 - FIELD IMPLEMENTING AND FINE-TUNING/ ADJUSTING ALL TRAFFIC SIGNAL TIMING PARAMETERS, INCLUDING FOLLOW-UP FIELD REVIEWS AS MAY BE NECESSARY.
 - DEVELOPING, PROGRAMMING, FIELD IMPLEMENTING, AND FINE-TUNING ALL VEHICLE DETECTION ZONE DIMENSIONS, ZONE LOCATIONS, AND OPERATIONAL PARAMETERS.

ALL OF THE AFOREMENTIONED CONTRACTED PROFESSIONAL ENGINEERING TRAFFIC SIGNAL OPERATIONAL CONSULTANT SERVICED DELIVERABLES SHALL BE CONSISTENT WITH NATIONAL PUBLICATIONS, INCLUDING BUT NOT LIMITED TO: MANUAL ON UNIFORM TRAFFIC CONTROL DEVICES (MUTCD) LATEST EDITION/ REVISION, FHWA-HOP-08-024 "TRAFFIC SIGNAL TIMING MANUAL" (JUNE 2008), FHWA-HRT-04-091 "SIGNALIZED INTERSECTIONS: INFORMATION GUIDE" (AUGUST 2004), FHWA-HOP-06-006 "TRAFFIC CONTROL SYSTEMS HANDBOOK" (OCTOBER 2005), FHWA-DTFH61-01-C-00183 "SIGNAL TIMING PROCESS FINAL REPORT" (DECEMBER 2003), NCHRP REPORT 731 "GUIDELINES FOR TIMING YELLOW AND ALL-RED INTERVALS AT SIGNALIZED INTERSECTIONS" (2012), NCHRP REPORT 812 "SIGNAL TIMING MANUAL SECOND EDITION" (2015)

TOWN OF MONUMENT GENERAL NOTES:

- ALL MATERIALS, WORKMANSHIP, AND CONSTRUCTION OF SITE IMPROVEMENTS SHALL MEET OR EXCEED THE SITE WORK STANDARDS AND SPECIFICATIONS AND THE STANDARDS AND SPECIFICATIONS SET FORTH IN THE TOWN OF MONUMENT MUNICIPAL CODE CRITERIA AND APPLICABLE STANDARDS, AND APPLICABLE LOCAL, STATE, AND FEDERAL REGULATIONS. WHERE THERE IS CONFLICT BETWEEN THESE PLANS AND THE SPECIFICATIONS, OR ANY APPLICABLE STANDARDS, THE HIGHER QUALITY STANDARD SHALL APPLY. ALL WORK WITHIN PUBLIC R.O.W. OR EASEMENTS SHALL BE INSPECTED AND APPROVED BY THE TOWN OF MONUMENT INSPECTOR. THE TOWN WILL ALSO INSPECT ALL WORK ON PRIVATE PROPERTY.
- THE CONTRACTOR IS SPECIFICALLY CAUTIONED THAT THE LOCATION AND/OR ELEVATION OF EXISTING UTILITIES, AS SHOWN ON THESE PLANS, IS BASED ON RECORDS OF THE VARIOUS UTILITY COMPANIES AND, WHERE POSSIBLE, MEASUREMENTS TAKEN IN THE FIELD. THE INFORMATION IS NOT TO BE RELIED UPON AS BEING EXACT OR COMPLETE. THE CONTRACTOR MUST CALL THE LOCAL UTILITY LOCATION CENTER AT LEAST 48 HOURS BEFORE ANY EXCAVATION TO REQUEST EXACT FIELD LOCATIONS OF THE UTILITIES. PRIOR TO CONSTRUCTION, THE CONTRACTOR SHALL VERIFY PERTINENT LOCATIONS AND ELEVATIONS, ESPECIALLY AT THE CONNECTION POINTS AND AT POTENTIAL UTILITY CONFLICTS. IT SHALL BE THE RESPONSIBILITY OF THE CONTRACTOR TO RELOCATE ALL EXISTING UTILITIES THAT CONFLICT WITH THE PROPOSED IMPROVEMENTS SHOWN ON THESE PLANS.
- THE CONTRACTOR SHALL BE RESPONSIBLE FOR OBTAINING ALL NECESSARY PERMITS FROM THE TOWN OF MONUMENT AND ALL APPLICABLE AGENCIES. THE CONTRACTOR SHALL NOTIFY THE TOWN INSPECTOR AT LEAST 48 HOURS PRIOR TO THE START OF ANY EARTH DISTURBING ACTIVITY, OR CONSTRUCTION ON ANY AND ALL PUBLIC IMPROVEMENTS.
- THE CONTRACTOR SHALL COORDINATE AND COOPERATE WITH THE TOWN AND ALL UTILITY COMPANIES INVOLVED WITH REGARD TO RELOCATIONS OR ADJUSTMENTS OF EXISTING UTILITIES DURING CONSTRUCTION AND TO ASSURE THAT THE WORK IS ACCOMPLISHED IN A TIMELY FASHION AND WITH THE MINIMUM DISRUPTION OF SERVICE. THE CONTRACTOR SHALL BE RESPONSIBLE FOR CONTACTING ALL PARTIES AFFECTED BY ANY DISRUPTION OF ANY UTILITY SERVICE.
- THE CONTRACTOR SHALL HAVE ONE (1) SIGNED COPY OF THE APPROVED PLANS, ONE (1) COPY OF THE APPROPRIATE STANDARDS AND SPECIFICATIONS, AND A COPY OF ALL PERMITS NEEDED FOR THE JOB, ON-SITE AT ALL TIMES.
- THE CONTRACTOR SHALL BE RESPONSIBLE FOR ALL ASPECTS OF SAFETY INCLUDING, BUT NOT LIMITED TO, EXCAVATION, TRENCHING, SHORING, TRAFFIC CONTROL, AND SECURITY.
- IF, DURING THE CONSTRUCTION PROCESS, CONDITIONS ARE ENCOUNTERED WHICH COULD INDICATE A SITUATION THAT IS NOT IDENTIFIED IN THE PLANS OR SPECIFICATIONS, THE CONTRACTOR SHALL CONTACT THE ENGINEER OF RECORD AND THE TOWN INSPECTOR IMMEDIATELY.
- ALL REFERENCES TO ANY PUBLISHED STANDARDS SHALL REFER TO THE LATEST REVISION OF SAID STANDARD, UNLESS SPECIFICALLY STATED OTHERWISE.
- THE CONTRACTOR SHALL SUBMIT A TRAFFIC CONTROL PLAN, IN ACCORDANCE WITH M.U.T.C.D. TO THE TOWN OF MONUMENT FOR APPROVAL, PRIOR TO ANY CONSTRUCTION ACTIVITIES WITHIN, OR AFFECTING, THE RIGHT-OF-WAY. THE CONTRACTOR SHALL BE RESPONSIBLE FOR PROVIDING ANY AND ALL TRAFFIC CONTROL DEVICES AS MAY BE REQUIRED BY THE CONSTRUCTION ACTIVITIES.
- THE CONTRACTOR IS RESPONSIBLE FOR PROVIDING ALL LABOR AND MATERIALS NECESSARY FOR THE COMPLETION OF THE INTENDED IMPROVEMENTS SHOWN ON THESE DRAWINGS OR DESIGNATED TO BE PROVIDED, INSTALLED, OR CONSTRUCTED, UNLESS SPECIFICALLY NOTED OTHERWISE.
- THE CONTRACTOR SHALL BE RESPONSIBLE FOR KEEPING ROADWAYS FREE AND CLEAR OF ALL CONSTRUCTION DEBRIS AND DIRT TRACKED FROM THE SITE.
- THE CONTRACTOR SHALL BE RESPONSIBLE FOR RECORDING AS-BUILT INFORMATION ON A SET OF RECORD DRAWINGS KEPT AT THE CONSTRUCTION SITE. THE TOWN OF MONUMENT DEVELOPMENT SERVICES DEPARTMENT INSPECTOR AT ALL TIMES. A REPRODUCIBLE SET OF AS-BUILT DRAWINGS MUST BE FURNISHED TO THE TOWN OF MONUMENT AT THE COMPLETION OF THE PROJECT, PRIOR TO FINAL APPROVAL BY THE TOWN AND AS A CONDITION FOR OBTAINING A CERTIFICATE OF OCCUPANCY.
- DIMENSIONS FOR LAYOUT AND CONSTRUCTION ARE NOT TO BE SCALED FROM ANY DRAWING. IF PERTINENT DIMENSIONS ARE NOT SHOWN, CONTACT THE ENGINEER-OF-RECORD FOR CLARIFICATION, AND ANNOTATE THE DIMENSION ON THE AS-BUILT RECORD DRAWINGS.
- ALL STRUCTURAL EROSION CONTROL MEASURES SHALL BE INSTALLED, AT THE LIMITS OF CONSTRUCTION, PRIOR TO ANY OTHER GROUND DISTURBING ACTIVITY. ALL EROSION CONTROL MEASURES SHALL BE MAINTAINED IN GOOD REPAIR BY THE CONTRACTOR, UNTIL SUCH TIME AS THE ENTIRE DISTURBED AREAS ARE STABILIZED WITH HARD SURFACE OR LANDSCAPING.
- THE CONTRACTOR SHALL SEQUENCE THE INSTALLATION OF UTILITIES IN SUCH A MANNER AS TO MINIMIZE POTENTIAL UTILITY CONFLICTS. IN GENERAL, STORM SEWER AND SANITARY SEWER SHOULD BE CONSTRUCTED PRIOR TO INSTALLATION OF WATER LINES AND DRY UTILITIES.
- NO SITE-RELATED IMPROVEMENTS MAY COMMENCE UNTIL A PRE-CONSTRUCTION MEETING IS HELD WITH THE TOWN OF MONUMENT AND ALL APPLICABLE PERMITS ARE OBTAINED.
- THE DEVELOPER MUST IDENTIFY TO THE TOWN OF MONUMENT, PRIOR TO THE START OF ANY WORK, A QUALIFIED PERSON RESPONSIBLE FOR REVIEWING AND MONITORING ALL OPERATIONS IN ORDER TO PREVENT OR MINIMIZE THE IMPACT OF VIBRATION, NOISE, DUST, DRAINAGE, AND EROSION DAMAGE, AND OTHER FORMS OF POLLUTION ON NEARBY PROPERTY AND THE PUBLIC AS A WHOLE. THE DEVELOPER MUST WRITE TO THE OWNERS/OCCUPANTS OF PROPERTIES WITHIN AT LEAST 100 YARDS OF THE WORKSITE, INFORMING THEM OF THE NATURE AND TIMING OF THE PROJECT AND PROVIDING CONTACT DETAILS FOR COMPLAINTS. THE TOWN, PRIOR TO THE COMMENCEMENT OF THE PROJECT, MUST APPROVE A COPY OF THE LETTER, MAILING LIST, AND DELIVERY DATES.
- ***TOWN OF MONUMENT DISCLAIMER*****
 THE APPROVAL OF THESE SITE CONSTRUCTION PLANS PRIOR TO SITE PLAN APPROVAL DOES NOT IN ANY WAY OBLIGATE THE TOWN TO APPROVE SUBSEQUENT SUBMITTALS (I.E., SITE PLANS AND PLATS), AND THE TOWN HAS NO LIABILITY IN ANY FORM DUE TO ITS ACTIONS IN THE APPROVAL OF THESE SITE CONSTRUCTION PLANS.

TOWN OF MONUMENT CONSTRUCTION NOTES:

- THE TOWN OF MONUMENT DESIGN CRITERIA & CONSTRUCTION SPECIFICATIONS MANUAL IS CONSIDERED PART OF THIS CONSTRUCTION DRAWING SET. THIS DESIGN AND PLAN SET IS INCOMPLETE WITHOUT THIS SPECIFICATIONS MANUAL. THE CONTRACTOR SHALL OBTAIN A COPY OF THIS MANUAL AND BE FAMILIAR WITH IT FOR ALL CONSTRUCTION ACTIVITIES. A COPY CAN BE OBTAINED FROM THE TOWN BY CALLING (719)-499-3375.
- ALL MATERIALS AND WORKMANSHIP SHALL BE IN COMPLIANCE WITH THE TOWN CRITERIA AND CONSTRUCTION SPECIFICATION MANUAL AND TOWN OF MONUMENT MUNICIPAL CODE AND SHALL BE SUBJECT TO INSPECTION BY THE TOWN OF MONUMENT INSPECTOR.
- THE CONTRACTOR SHALL VERIFY THE LOCATION OF ALL EXISTING UTILITIES PRIOR TO ACTUAL CONSTRUCTION. ALL EXISTING UTILITIES SHOWN ARE BASED ON INFORMATION OF RECORD. THE CONTRACTOR IS RESPONSIBLE TO TAKE PRECAUTIONARY MEASURES TO PROTECT THE EXISTING UTILITIES SHOWN HEREON AND ANY OTHER EXISTING UTILITIES NOT OF RECORD OR NOT SHOWN ON THESE PLANS AND AGREES TO ACCEPT FULL RESPONSIBILITY FOR FAILURE TO LOCATE AND PRESERVE ANY AND ALL EXISTING UTILITIES.
- THE HORIZONTAL AND VERTICAL LOCATION OF EXISTING IMPROVEMENTS TO BE MET BY THE PROPOSED IMPROVEMENTS SHOWN ON THESE PLANS SHALL BE CONFIRMED BY FIELD MEASUREMENTS PRIOR TO CONSTRUCTION. ANY SIGNIFICANT DISCREPANCIES FOUND BETWEEN THIS PLAN SET AND ACTUAL FIELD CONDITIONS SHALL BE IMMEDIATELY REPORTED TO THE ENGINEER OF RECORD FOR APPROPRIATE ACTION.
- THE CONTRACTOR IS ADVISED THAT ALL EXISTING CONDITIONS OUTSIDE THE AREA OF WORK SHALL BE PROTECTED, IF DAMAGE OCCURS DURING CONSTRUCTION, IT WILL BE REPLACED IN THE ORIGINAL EXISTING CONDITION AT THE CONTRACTOR'S EXPENSE.
- CONCRETE USED FOR CONSTRUCTION OF CURB AND GUTTER, SIDEWALK, AND CROSSPANS SHALL HAVE A MINIMUM COMPRESSIVE STRENGTH OF 4,000 P.S.I. AFTER 28 DAYS.
- ALL DISTURBED PAVEMENT EDGES WILL BE CUT TO NEAT LINES. THE THICKNESS OF ANY REPLACED ASPHALT AND BASE COURSE SHALL EQUAL OR EXCEED THE EXISTING THICKNESS.
- WHEN ABUTTING NEW PAVEMENT TO EXISTING, OR TO REMOVE ANY BROKEN OR CRACKED PAVEMENT, SAWCUT EXISTING PAVEMENT TO A STRAIGHT EDGE AND AT A RIGHT ANGLE, OR AS APPROVED BY THE TOWN INSPECTOR.
- FINAL GRADING OF CURBS AND PAVING SHALL PROVIDE POSITIVE DRAINAGE. STANDING WATER POCKETS OR PONDING WILL NOT BE ACCEPTABLE.
- WHERE REMOVAL OF EXISTING CURB, GUTTER, SIDEWALK, OR PAVEMENT IS REQUIRED, THE CONTRACTOR SHALL SAWCUT AND/OR REMOVE TO THE NEAREST JOINT. CURB, GUTTER, AND SIDEWALK SHOWN AS EXISTING ON THESE PLANS IS NOT TO BE REMOVED UNLESS OTHERWISE NOTED. IF ANY OF THE EXISTING CURB, GUTTER, OR SIDEWALK IS DAMAGED BY THE CONTRACTOR, THEN IT SHALL BE REPLACED AT THE CONTRACTOR'S EXPENSE.
- CONTRACTOR SHALL PROVIDE TRAFFIC CONTROL AND ROUTING DURING CONSTRUCTION, IF REQUIRED. TWO-WAY TRAFFIC SHALL BE MAINTAINED THROUGH THE WORK AREA AT ALL TIMES.
- ALL DISTURBED AREAS THAT ARE TO REMAIN UNCOVERED FOR A PERIOD GREATER THAN 2 MONTHS SHALL BE RESEDED AND WATERED UNTIL STABLE VEGETATION IS ESTABLISHED.
- AT LEAST ONE SIGNED AND STAMPED SET OF THESE CONSTRUCTION DRAWINGS SHALL BE KEPT ON-SITE AT ALL TIMES.

<p style="text-align: center;">48 HOURS BEFORE YOU DIG, CALL UTILITY LOCATORS</p> <p style="text-align: center;">811</p> <p style="text-align: center;">UTILITY NOTIFICATION CENTER OF COLORADO IT'S THE LAW</p> <p>THE LOCATIONS OF EXISTING UNDERGROUND UTILITIES ARE SHOWN IN AN APPROXIMATE WAY ONLY. THE CONTRACTOR SHALL DETERMINE THE EXACT LOCATION OF ALL EXISTING UTILITIES BEFORE COMMENCING WORK. THE CONTRACTOR SHALL BE FULLY RESPONSIBLE FOR ANY AND ALL DAMAGES WHICH MIGHT BE CAUSED BY HIS FAILURE TO EXACTLY LOCATE AND PRESERVE ANY AND ALL UNDERGROUND UTILITIES.</p>	<table border="1" style="width:100%; border-collapse: collapse;"> <thead> <tr> <th style="width:30%;">NO.</th> <th style="width:40%;">REVISION</th> <th style="width:30%;">DATE</th> </tr> </thead> <tbody> <tr> <td style="text-align: center;">1</td> <td>REVISED PER CDOT/COUNTY COMMENTS</td> <td style="text-align: center;">5/12/23</td> </tr> <tr> <td> </td> <td> </td> <td> </td> </tr> <tr> <td> </td> <td> </td> <td> </td> </tr> <tr> <td> </td> <td> </td> <td> </td> </tr> </tbody> </table>	NO.	REVISION	DATE	1	REVISED PER CDOT/COUNTY COMMENTS	5/12/23										<p>REVIEW:</p> <p>PREPARED UNDER MY DIRECT SUPERVISION FOR AND ON BEHALF OF CLASSIC CONSULTING ENGINEERS AND SURVEYORS, LLC</p> <p style="text-align: right;">MARC A. WHORTON, COLORADO P.E. #37155 DATE</p>	<p>STATE HIGHWAY 105 / JACKSON CREEK PKWY. – PHASE 2 CONSTRUCTION PLANS ROADWAY IMPROVEMENT PLANS STANDARD NOTES</p> <table border="1" style="width:100%; border-collapse: collapse;"> <tr> <td>DESIGNED BY</td> <td>PRA</td> <td>SCALE</td> <td>DATE</td> <td>02-23-23</td> </tr> <tr> <td>DRAWN BY</td> <td>PRA</td> <td>(H) 1"=VARIES</td> <td>SHEET</td> <td>2 OF 26</td> </tr> <tr> <td>CHECKED BY</td> <td>(V)</td> <td>1"= N/A</td> <td>JOB NO.</td> <td>1302.22</td> </tr> </table>	DESIGNED BY	PRA	SCALE	DATE	02-23-23	DRAWN BY	PRA	(H) 1"=VARIES	SHEET	2 OF 26	CHECKED BY	(V)	1"= N/A	JOB NO.	1302.22
NO.	REVISION	DATE																															
1	REVISED PER CDOT/COUNTY COMMENTS	5/12/23																															
DESIGNED BY	PRA	SCALE	DATE	02-23-23																													
DRAWN BY	PRA	(H) 1"=VARIES	SHEET	2 OF 26																													
CHECKED BY	(V)	1"= N/A	JOB NO.	1302.22																													

N:\130222\DRAWINGS\CONSTRUCTION\DRAWING\811\811.dwg, 7/19/2023 4:23:03 PM, W:\monmon, 1:1

PLAN NUMBER	M STANDARD TITLE	PAGE NUMBER
<input type="checkbox"/> M-100-1	STANDARD SYMBOLS (3 SHEETS).....	1-3
<input type="checkbox"/> M-100-2	ACRONYMS AND ABBREVIATIONS (4 SHEETS).....	4-7
<input type="checkbox"/> M-203-1	APPROACH ROADS.....	8
<input type="checkbox"/> M-203-2	DITCH TYPES.....	9
<input type="checkbox"/> M-203-11	SUPERELEVATION CROWNED AND DIVIDED HIGHWAYS (3 SHEETS).....	10-12
<input checked="" type="checkbox"/> M-203-12	SUPERELEVATION STREETS (2 SHEETS).....	13-14
<input checked="" type="checkbox"/> M-206-1	EXCAVATION AND BACKFILL FOR STRUCTURES (2 SHEETS).....	15-16
<input type="checkbox"/> M-206-2	EXCAVATION AND BACKFILL FOR BRIDGES (2 SHEETS).....	17-18
<input checked="" type="checkbox"/> M-208-1	TEMPORARY EROSION CONTROL (11 SHEETS).....	19-29
<input type="checkbox"/> M-210-1	MAILBOX SUPPORTS (2 SHEETS).....	30-31
<input type="checkbox"/> M-214-1	NURSERY STOCK DETAILS.....	32
<input checked="" type="checkbox"/> M-216-1	SOIL RETENTION COVERING (2 SHEETS).....	33-34
<input type="checkbox"/> M-412-1	CONCRETE PAVEMENT JOINTS (9 SHEETS).....	35-39
<input type="checkbox"/> M-412-2	CONCRETE PAVEMENT CRACK REPAIR (6 SHEETS).....	40-45
<input type="checkbox"/> M-510-1	STRUCTURAL PLATE PIPE H-20 LOADING.....	40
<input type="checkbox"/> M-601-1	SINGLE CONCRETE BOX CULVERT (CAST-IN-PLACE) (2 SHEETS).....	41-42
<input type="checkbox"/> M-601-2	DOUBLE CONCRETE BOX CULVERT (CAST-IN-PLACE) (2 SHEETS).....	43-44
<input type="checkbox"/> M-601-3	TRIPLE CONCRETE BOX CULVERT (CAST-IN-PLACE) (2 SHEETS).....	45-46
<input checked="" type="checkbox"/> M-601-10	HEADWALL FOR PIPES.....	47
<input type="checkbox"/> M-601-11	TYPE "S" SADDLE HEADWALLS FOR PIPE.....	48
<input type="checkbox"/> M-601-12	HEADWALLS AND PIPE OUTLET PAVING.....	49
<input type="checkbox"/> M-601-20	WINGWALLS FOR PIPE OR BOX CULVERTS (2 SHEETS).....	50-51
<input type="checkbox"/> M-603-1	METAL PIPE (4 SHEETS).....	52-55
<input checked="" type="checkbox"/> M-603-2	REINFORCED CONCRETE PIPE.....	56
<input type="checkbox"/> M-603-3	PRECAST CONCRETE BOX CULVERT.....	57
<input type="checkbox"/> M-603-4	CORRUGATED POLYETHYLENE PIPE (AASHTO M294) AND CORRUGATED POLYPROPYLENE PIPE (AASHTO M330) (2 sheets).....	58
<input type="checkbox"/> M-603-5	POLYVINYL CHLORIDE (PVC) PIPE (AASHTO M304).....	59
<input type="checkbox"/> M-603-6	STEEL REINFORCED POLYETHYLENE RIBBED PIPE (AASHTO MP 20).....	60
<input type="checkbox"/> M-603-10	CONCRETE AND METAL END SECTIONS.....	61
<input type="checkbox"/> M-603-12	TRAVERSABLE END SECTIONS AND SAFETY GRATES (3 SHEETS).....	62-64
<input checked="" type="checkbox"/> M-604-10	INLET, TYPE C.....	65
<input type="checkbox"/> M-604-11	INLET, TYPE D.....	66
<input checked="" type="checkbox"/> M-604-12	CURB INLET TYPE R (2 SHEETS).....	67-68
<input type="checkbox"/> M-604-13	CONCRETE INLET TYPE 13.....	69
<input checked="" type="checkbox"/> M-604-20	MANHOLES (3 SHEETS).....	70-72
<input type="checkbox"/> M-604-25	VANE GRATE INLET (5 SHEETS).....	73-77
<input checked="" type="checkbox"/> M-605-1	SUBSURFACE DRAINS.....	78

PLAN NUMBER	M STANDARD TITLE	PAGE NUMBER
<input type="checkbox"/> M-606-1	MIDWEST GUARDRAIL SYSTEM TYPE 3 W-BEAM 31 INCHES (19 SHEETS).....	79-97
<input type="checkbox"/> M-606-13	GUARDRAIL TYPE 7 F-SHAPE BARRIER (4 SHEETS).....	98-101
<input type="checkbox"/> M-606-14	PRECAST TYPE 7 CONCRETE BARRIER (4 SHEETS).....	102-104
<input type="checkbox"/> M-606-15	GUARDRAIL TYPE 9 SINGLE SLOPE BARRIER (11 SHEETS).....	105-115
<input type="checkbox"/> M-607-1	WIRE FENCES AND GATES (3 SHEETS).....	116-118
<input type="checkbox"/> M-607-2	CHAIN LINK FENCE (3 SHEETS).....	119-121
<input type="checkbox"/> M-607-3	BARRIER FENCE.....	122
<input type="checkbox"/> M-607-4	DEER FENCE, GATES, AND GAME RAMPS (7 SHEETS).....	123-127
<input type="checkbox"/> M-607-10	PICKET SNOW FENCE.....	128
<input type="checkbox"/> M-607-15	ROAD CLOSURE GATE (9 SHEETS).....	129-137
<input checked="" type="checkbox"/> M-608-1	CURB RAMPS (10 SHEETS).....	138-147
<input checked="" type="checkbox"/> M-609-1	CURBS, GUTTERS, AND SIDEWALKS (4 SHEETS).....	148-151
<input type="checkbox"/> M-611-1	CATTLE GUARD (2 SHEETS).....	152-153
<input type="checkbox"/> M-611-2	DEER GUARD (2 SHEETS).....	154-155
<input type="checkbox"/> M-614-1	RUMBLE STRIPS (3 SHEETS).....	156-158
<input type="checkbox"/> M-614-2	SAND BARREL ARRAYS (2 SHEETS).....	159-160
<input type="checkbox"/> M-615-1	EMBANKMENT PROTECTOR TYPE 3.....	161
<input type="checkbox"/> M-615-2	EMBANKMENT PROTECTOR TYPE 5.....	162
<input type="checkbox"/> M-616-1	INVERTED SIPHON.....	163
<input type="checkbox"/> M-620-1	FIELD LABORATORY CLASS 1.....	164
<input type="checkbox"/> M-620-2	FIELD LABORATORY CLASS 2 (2 SHEETS).....	165-166
<input type="checkbox"/> M-620-11	FIELD OFFICE CLASS 1.....	167
<input type="checkbox"/> M-620-12	FIELD OFFICE CLASS 2.....	168
<input type="checkbox"/> M-629-1	SURVEY MONUMENTS (2 SHEETS).....	169-170


PLAN NUMBER	S STANDARD TITLE	PAGE NUMBER
<input type="checkbox"/> S-612-1	DELINEATOR INSTALLATIONS (8 SHEETS).....	171-178
<input type="checkbox"/> S-613-1	ROADWAY LIGHTING (6 SHEETS).....	179-186
<input type="checkbox"/> S-613-2	ALTERNATIVE ROADWAY LIGHTING (4 SHEETS) (NEW, ISSUED ON SEPTEMBER 30, 2020).....	
<input checked="" type="checkbox"/> S-614-1	GROUND SIGN PLACEMENT (2 SHEETS).....	187-188
<input checked="" type="checkbox"/> S-614-2	CLASS I SIGNS.....	189
<input checked="" type="checkbox"/> S-614-3	CLASS II SIGNS.....	190
<input type="checkbox"/> S-614-4	CLASS III SIGNS (3 SHEETS).....	191-193
<input type="checkbox"/> S-614-5	BREAK-AWAY SIGN SUPPORT DETAILS FOR CLASS III SIGNS (2 SHEETS).....	194-195
<input type="checkbox"/> S-614-6	CONCRETE FOOTINGS AND SIGN ISLANDS FOR CLASS III SIGNS (2 SHEETS).....	196-197
<input checked="" type="checkbox"/> S-614-8	TUBULAR STEEL SIGN SUPPORT DETAILS (7 SHEETS).....	198-204
S-614-9	PEDESTRIAN PUSH BUTTON POST ASSEMBLY (2 SHEETS).....	205-206
<input type="checkbox"/> S-614-10	MARKER ASSEMBLY INSTALLATIONS.....	207
<input type="checkbox"/> S-614-11	MILEPOST SIGN DETAIL FOR HIGH SNOW AREAS.....	208
<input type="checkbox"/> S-614-12	STRUCTURE NUMBER INSTALLATION (2 SHEETS).....	209-210
<input type="checkbox"/> S-614-14	FLASHING BEACON AND SIGN INSTALLATIONS (4 SHEETS).....	211-214
<input checked="" type="checkbox"/> S-614-20	TYPICAL POLE MOUNT SIGN INSTALLATIONS.....	215
<input type="checkbox"/> S-614-21	CONCRETE BARRIER SIGN POST INSTALLATIONS (2 SHEETS) (REVISED ON SEPTEMBER 21, 2020).....	216-217
<input checked="" type="checkbox"/> S-614-22	TYPICAL MULTI-SIGN INSTALLATIONS.....	218
<input type="checkbox"/> S-614-40	TYPICAL TRAFFIC SIGNAL 30'-75' DOUBLE MAST ARMS 65'-75' SINGLE MAST ARMS (5 SHEETS) (REVISED ON JULY 22, 2022).....	219-223
<input checked="" type="checkbox"/> S-614-40A	ALTERNATIVE TRAFFIC SIGNAL 25'-55' SINGLE MAST ARMS (4 SHEETS) (REVISED ON JULY 22, 2022).....	224-227
<input type="checkbox"/> S-614-41	TEMPORARY SPAN WIRE SIGNALS (13 SHEETS).....	228-240
<input checked="" type="checkbox"/> S-614-42	CABINET FOUNDATION DETAIL (4 SHEETS).....	241-244
<input type="checkbox"/> S-614-43	TRAFFIC LOOP AND MISCELLANEOUS SIGNAL DETAILS (8 SHEETS).....	245-252
<input type="checkbox"/> S-614-44	PEDESTAL POLE SIGNALS (2 SHEETS).....	253-254
<input checked="" type="checkbox"/> S-614-45	PEDESTRIAN PUSH BUTTON POST ASSEMBLY DETAILS (6 SHEETS) (REVISED ON DECEMBER 3, 2020).....	255-266
<input type="checkbox"/> S-614-50	STATIC SIGN MONOTUBE STRUCTURES (12 SHEETS).....	267-280
<input type="checkbox"/> S-614-60	DYNAMIC SIGN MONOTUBE STRUCTURES (14 SHEETS).....	267-280
<input checked="" type="checkbox"/> S-627-1	PAVEMENT MARKINGS (11 SHEETS).....	281-289
<input checked="" type="checkbox"/> S-630-1	TRAFFIC CONTROLS FOR HIGHWAY CONSTRUCTION (26 SHEETS) (REVISED ON JANUARY 20, 2023).....	290-313
<input checked="" type="checkbox"/> S-630-2	BARRICADES, DRUMS, CONCRETE BARRIERS (TEMP.) AND VERTICAL PANELS.....	314
<input type="checkbox"/> S-630-3	FLASHING BEACON (PORTABLE) DETAILS.....	315
<input type="checkbox"/> S-630-4	STEEL SIGN SUPPORT (TEMPORARY) INSTALLATION DETAILS (2 SHEETS).....	316-317
<input type="checkbox"/> S-630-5	PORTABLE RUMBLE STRIPS (TEMPORARY) (2 SHEETS).....	318-319
<input type="checkbox"/> S-630-6	EMERGENCY PULL-OFF AREA (TEMPORARY).....	320
<input type="checkbox"/> S-630-7	ROLLING ROADBLOCKS FOR TRAFFIC CONTROL (3 SHEETS).....	321-323

COLORADO
DEPARTMENT OF TRANSPORTATION
M&S STANDARDS PLANS LIST
 July 31, 2019 UPDATE THIS SHEET AS APPLICABLE
 Revised on April 14, 2023



ALL OF THE M&S STANDARD PLANS, AS SUPPLEMENTED AND REVISED, APPLY TO THIS PROJECT WHEN USED BY DESIGNATED PAY ITEM OR SUBSIDIARY ITEM.

THE M&S STANDARD PLANS USED TO DESIGN THIS PROJECT ARE INDICATED BY A MARKED BOX , AND WILL BE ATTACHED TO THE PLANS. ALL OTHER M&S STANDARD PLANS ARE STILL ELIGIBLE FOR USE IN CONSTRUCTION IF APPROVED BY AN APPROPRIATE CDOT ENGINEER.

Computer File Information		Sheet Revisions	Colorado Department of Transportation	STANDARD PLANS LIST	STANDARD PLAN NO.
Creation Date: 07/31/19		Date: _____	2829 West Howard Place	STANDARD PLANS LIST Issued by the Project Development Branch: July 31, 2019	STANDARDS PLANS LIST Standard Sheet No. 1 of 1 Project Sheet Number: _____
Designer Initials: JBK	<input checked="" type="checkbox"/> R-X	Comments: _____	CDOT HQ, 3rd Floor		
Last Modification Date: 04/14/23	<input checked="" type="checkbox"/> R-X		Denver, CO 80204		
Detailer Initials: LTA	<input checked="" type="checkbox"/> R-X		Phone: 303-757-9021 FAX: 303-757-9868		
CAD Ver.: MicroStation V8 Scale: Not to Scale Units: English	<input checked="" type="checkbox"/> R-X		Construction Engineering Services JBK		

48 HOURS BEFORE YOU DIG, CALL UTILITY LOCATORS 811 UTILITY NOTIFICATION CENTER OF COLORADO IT'S THE LAW <small>THE LOCATIONS OF EXISTING UNDERGROUND UTILITIES ARE SHOWN IN AN APPROXIMATE WAY ONLY. THE CONTRACTOR SHALL DETERMINE THE EXACT LOCATION OF ALL EXISTING UTILITIES BEFORE COMMENCING WORK. THE CONTRACTOR SHALL BE FULLY RESPONSIBLE FOR ANY AND ALL DAMAGES WHICH MIGHT BE CAUSED BY HIS FAILURE TO EXACTLY LOCATE AND PRESERVE ANY AND ALL UNDERGROUND UTILITIES.</small>	NO. REVISION 1 REVISED PER CDOT COMMENTS DATE 5/18/23	REVIEW: PREPARED UNDER MY DIRECT SUPERVISION FOR AND ON BEHALF OF CLASSIC CONSULTING ENGINEERS AND SURVEYORS, LLC MARC A. WHORTON, COLORADO P.E. #37155 DATE _____	 STATE HIGHWAY 105 / JACKSON CREEK PRWY. - PHASE 2 CONSTRUCTION PLANS CDOT STANDARD PLAN SHEET DESIGNED BY: PRA SCALE: DATE: 02-23-23 DRAWN BY: PRA (H) 1"= N/A SHEET 3 OF 26 CHECKED BY: (V) 1"= N/A JOB NO. 1302.22
---	--	--	---

N:\130222\DRAWINGS\CDOT\STRUCT\CDOT\STANDARD PLANS LIST.dwg, 7/15/2023 4:23:32 PM, W:\morton, 1:1

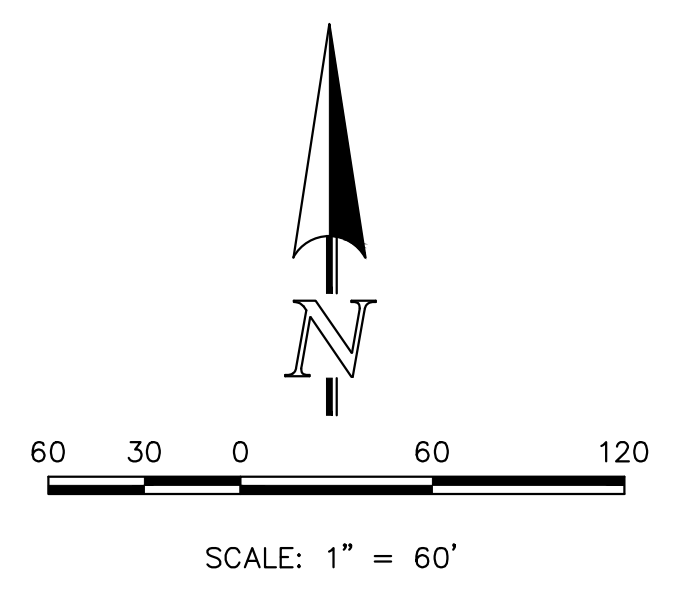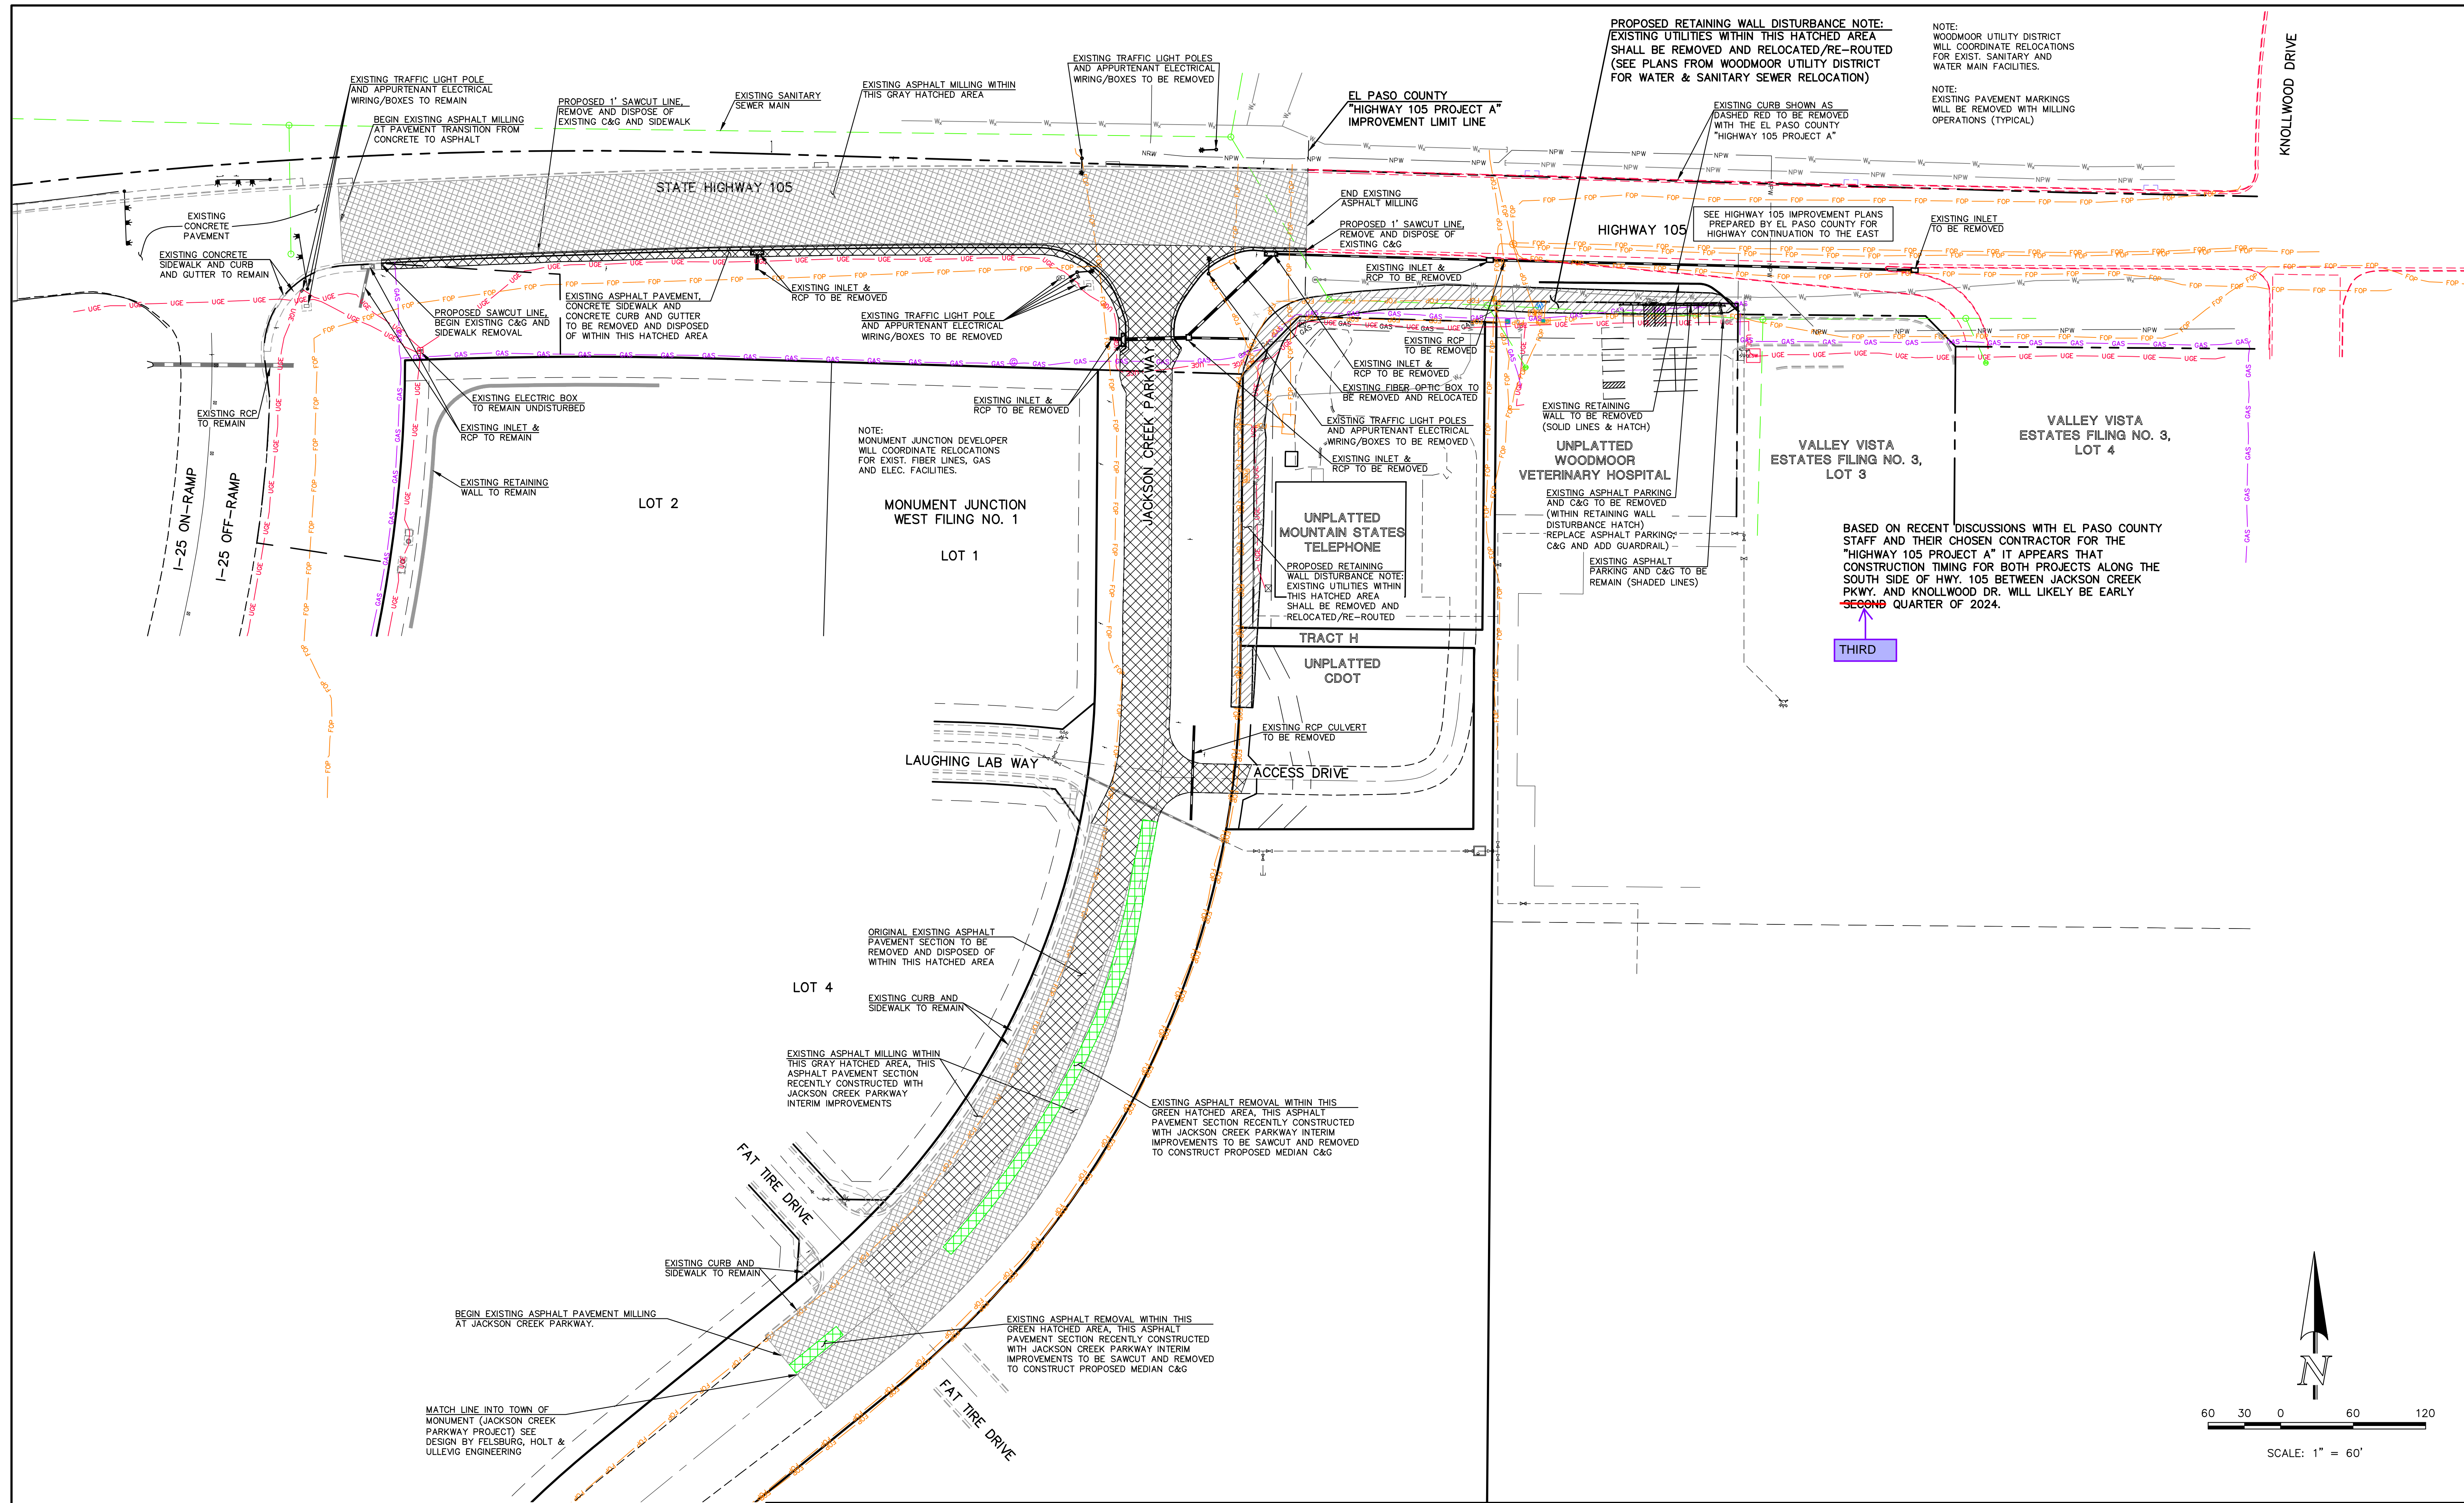

<p>48 HOURS BEFORE YOU DIG, CALL UTILITY LOCATORS</p> <p>811</p> <p>UTILITY NOTIFICATION CENTER OF COLORADO IT'S THE LAW</p> <p>THE LOCATIONS OF EXISTING UNDERGROUND UTILITIES ARE SHOWN IN AN APPROXIMATE WAY ONLY. THE CONTRACTOR SHALL DETERMINE THE EXACT LOCATION OF ALL EXISTING UTILITIES BEFORE COMMENCING WORK. THE CONTRACTOR SHALL BE FULLY RESPONSIBLE FOR ANY AND ALL DAMAGES WHICH MIGHT BE CAUSED BY HIS FAILURE TO EXACTLY LOCATE AND PRESERVE ANY AND ALL UNDERGROUND UTILITIES.</p>		<table border="1"> <thead> <tr> <th>NO.</th> <th>REVISION</th> <th>DATE</th> </tr> </thead> <tbody> <tr> <td>1</td> <td>REVISED PER CDOT/COUNTY/TOWN OF MONUMENT COMMENTS</td> <td>7/10/23</td> </tr> <tr> <td> </td> <td> </td> <td> </td> </tr> <tr> <td> </td> <td> </td> <td> </td> </tr> <tr> <td> </td> <td> </td> <td> </td> </tr> </tbody> </table>	NO.	REVISION	DATE	1	REVISED PER CDOT/COUNTY/TOWN OF MONUMENT COMMENTS	7/10/23									
NO.	REVISION	DATE															
1	REVISED PER CDOT/COUNTY/TOWN OF MONUMENT COMMENTS	7/10/23															

REVIEW:

PREPARED UNDER MY DIRECT SUPERVISION FOR AND ON BEHALF OF CLASSIC CONSULTING ENGINEERS AND SURVEYORS, LLC


MARC. A. WHORTON, COLORADO P.E. #37155 DATE

CLASSICSM
 CONSULTING
 ENGINEERS & SURVEYORS

619 N. Cascade Avenue, Suite 200 (719) 785-0790
 Colorado Springs, Colorado 80903 (719) 785-0799(fax)

<p>STATE HIGHWAY 105 / JACKSON CREEK PKWY. - PHASE 2 CONSTRUCTION PLANS</p> <p>ROADWAY IMPROVEMENT PLANS</p> <p>DEMOLITION PLAN</p>			
DESIGNED BY	PRA	SCALE	DATE 02-23-23
DRAWN BY	PRA	(H) 1" = 60'	SHEET 4 OF 26
CHECKED BY	(V) 1" = N/A	JOB NO.	1302.22

N:\130222\DRAWINGS\CONSTRUCT\CD\CONSTRUCT\CD\SPRINT-04-DEMOL PLAN.dwg, 7/14/2023 11:08:47 AM, mrosgon, 1:1

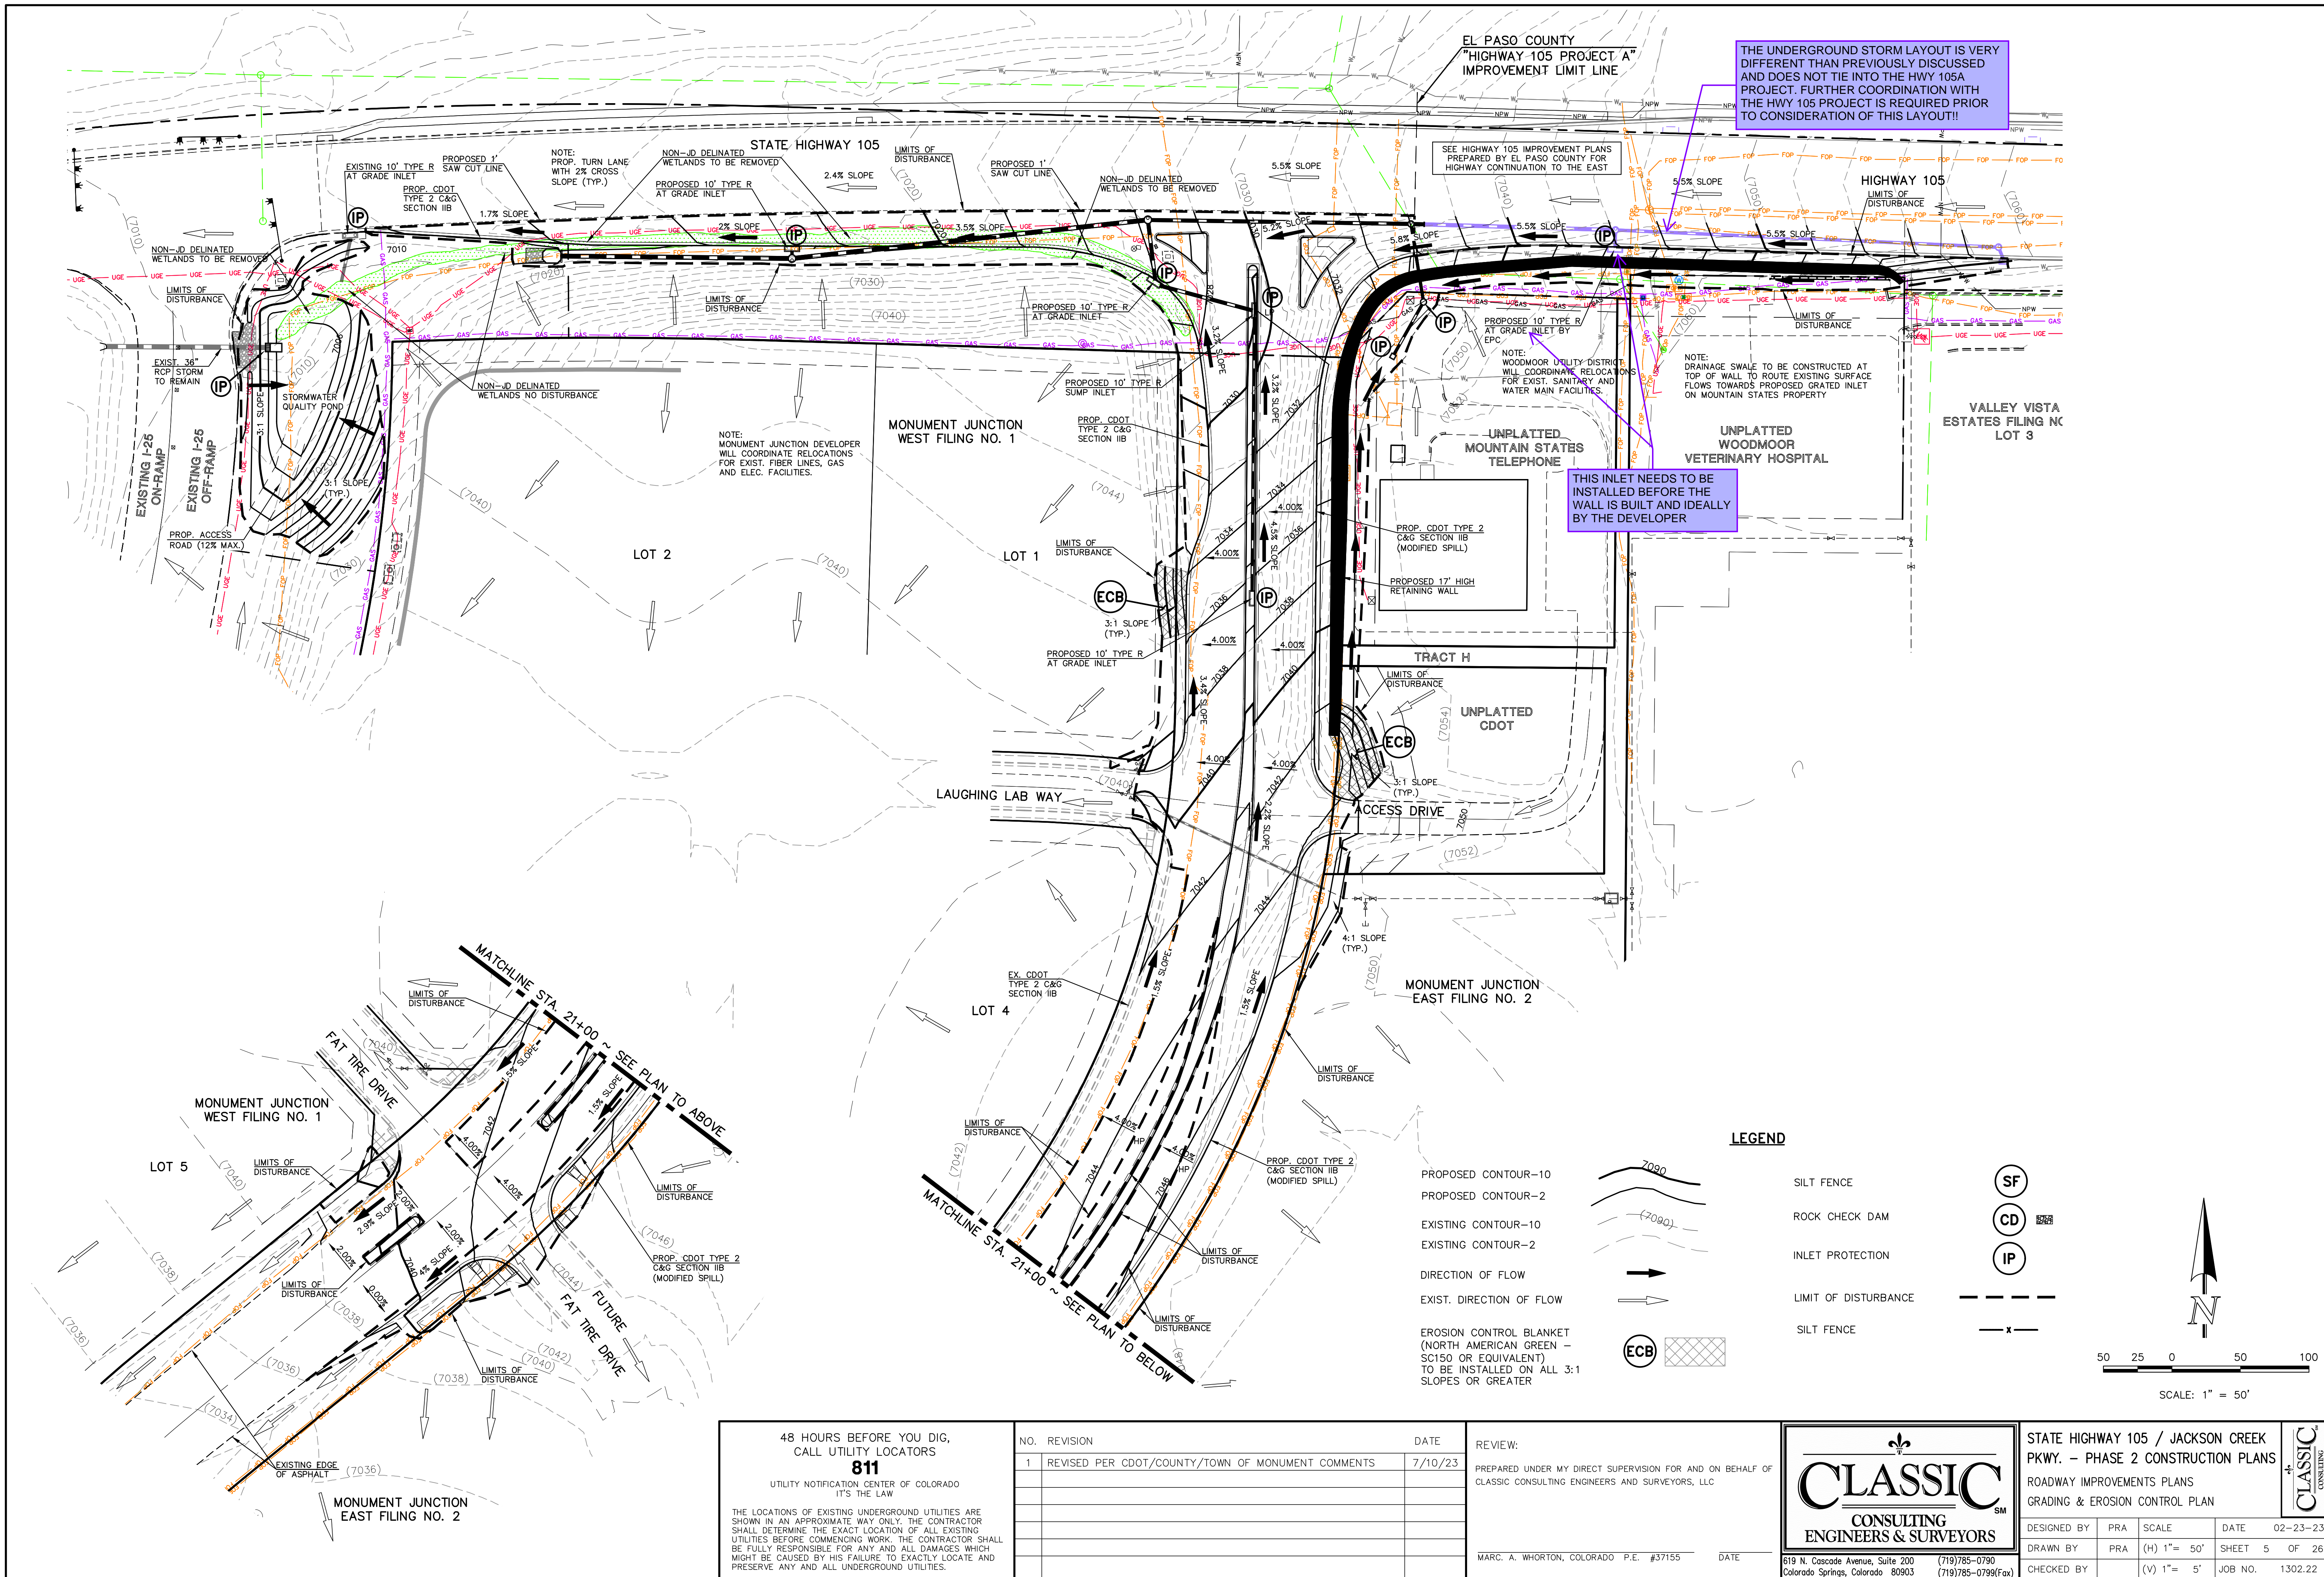

THE UNDERGROUND STORM LAYOUT IS VERY DIFFERENT THAN PREVIOUSLY DISCUSSED AND DOES NOT TIE INTO THE HWY 105A PROJECT. FURTHER COORDINATION WITH THE HWY 105 PROJECT IS REQUIRED PRIOR TO CONSIDERATION OF THIS LAYOUT!!

SEE HIGHWAY 105 IMPROVEMENT PLANS PREPARED BY EL PASO COUNTY FOR HIGHWAY CONTINUATION TO THE EAST

THIS INLET NEEDS TO BE INSTALLED BEFORE THE WALL IS BUILT AND IDEALLY BY THE DEVELOPER

LEGEND

- PROPOSED CONTOUR-10
- PROPOSED CONTOUR-2
- EXISTING CONTOUR-10
- EXISTING CONTOUR-2
- DIRECTION OF FLOW
- EXIST. DIRECTION OF FLOW
- EROSION CONTROL BLANKET (NORTH AMERICAN GREEN - SC150 OR EQUIVALENT) TO BE INSTALLED ON ALL 3:1 SLOPES OR GREATER
- SILT FENCE (SF)
- ROCK CHECK DAM (CD)
- INLET PROTECTION (IP)
- LIMIT OF DISTURBANCE
- SILT FENCE (x)

SCALE: 1" = 50'

48 HOURS BEFORE YOU DIG, CALL UTILITY LOCATORS
811
 UTILITY NOTIFICATION CENTER OF COLORADO
 IT'S THE LAW

THE LOCATIONS OF EXISTING UNDERGROUND UTILITIES ARE SHOWN IN AN APPROXIMATE WAY ONLY. THE CONTRACTOR SHALL DETERMINE THE EXACT LOCATION OF ALL EXISTING UTILITIES BEFORE COMMENCING WORK. THE CONTRACTOR SHALL BE FULLY RESPONSIBLE FOR ANY AND ALL DAMAGES WHICH MIGHT BE CAUSED BY HIS FAILURE TO EXACTLY LOCATE AND PRESERVE ANY AND ALL UNDERGROUND UTILITIES.

NO.	REVISION	DATE
1	REVISED PER CDOT/COUNTY/TOWN OF MONUMENT COMMENTS	7/10/23

REVIEW:
 PREPARED UNDER MY DIRECT SUPERVISION FOR AND ON BEHALF OF CLASSIC CONSULTING ENGINEERS AND SURVEYORS, LLC


MARC. A. WHORTON, COLORADO P.E. #37155 DATE

CLASSIC
 CONSULTING ENGINEERS & SURVEYORS

619 N. Cascade Avenue, Suite 200
 Colorado Springs, Colorado 80903
 (719) 785-0790
 (719) 785-0799 (fax)

STATE HIGHWAY 105 / JACKSON CREEK PKWY. - PHASE 2 CONSTRUCTION PLANS			
ROADWAY IMPROVEMENTS PLANS			
GRADING & EROSION CONTROL PLAN			
DESIGNED BY	PRA	SCALE	DATE 02-23-23
DRAWN BY	PRA	(H) 1" = 50'	SHEET 5 OF 26
CHECKED BY	(V) 1" = 5'	JOB NO.	1302.22

CLASSIC CONSULTING ENGINEERS & SURVEYORS

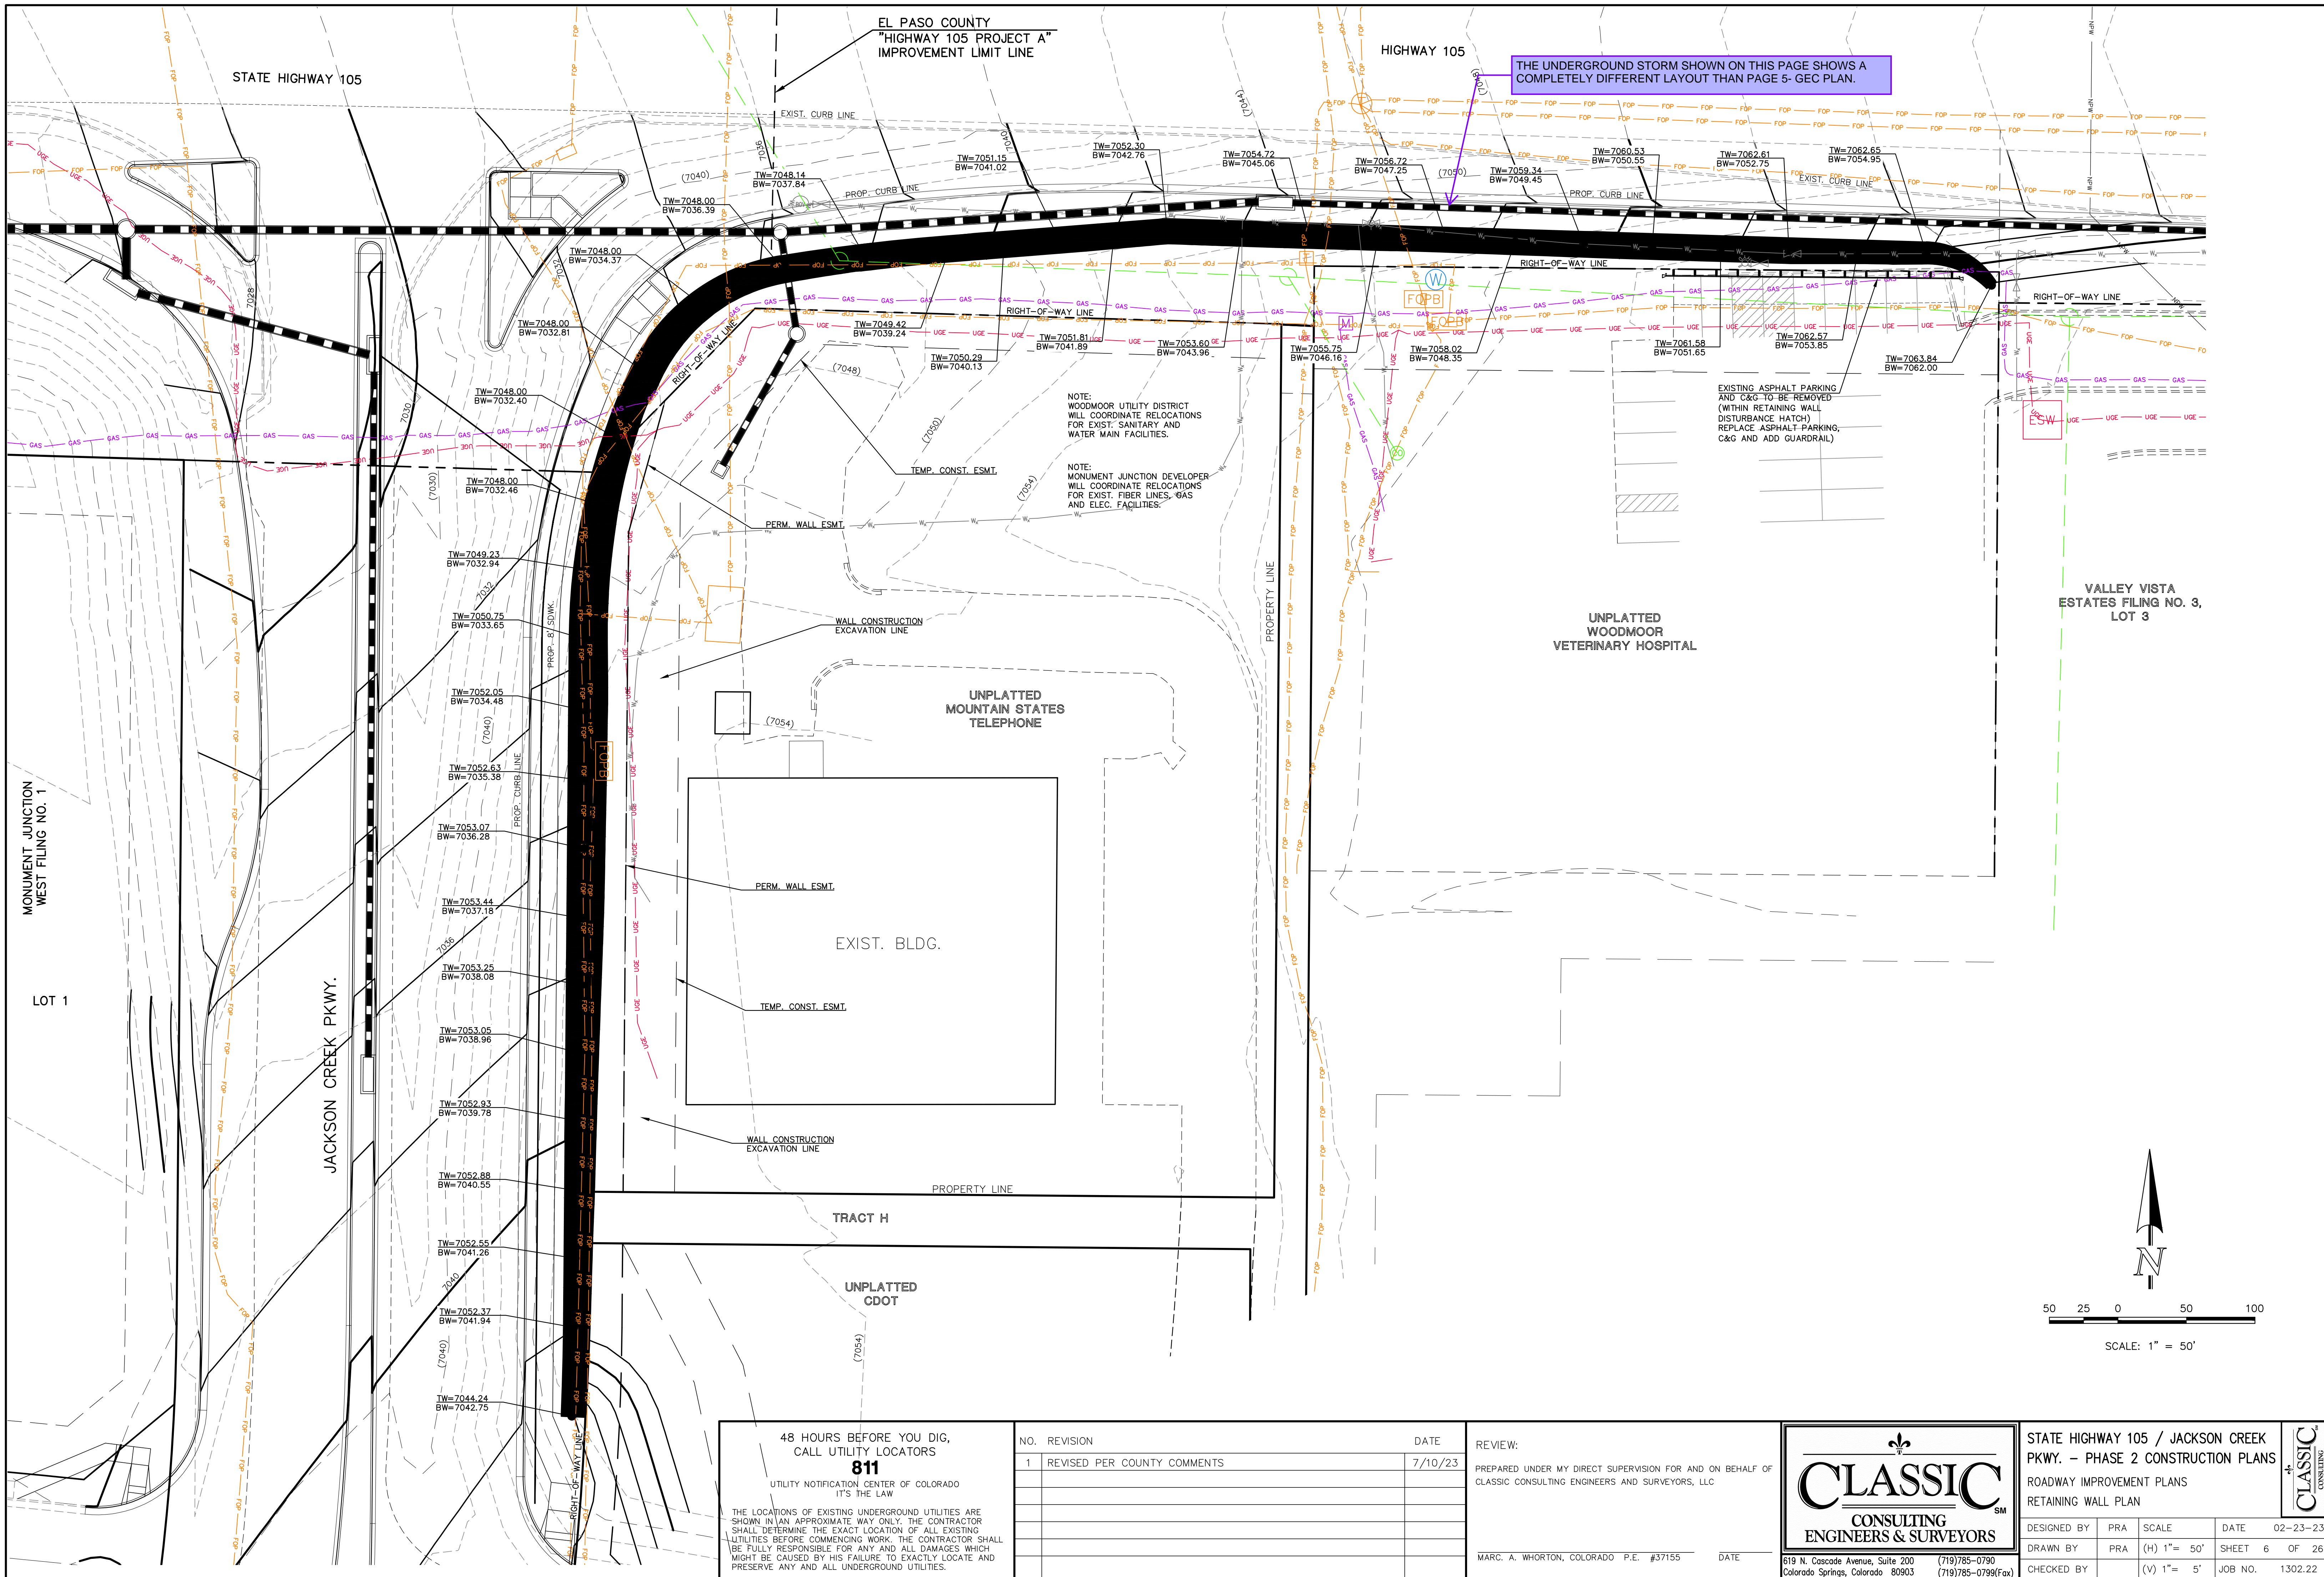


NOTE:
WOODMOOR UTILITY DISTRICT
WILL COORDINATE RELOCATIONS
FOR EXIST. SANITARY AND
WATER MAIN FACILITIES.

NOTE:
MONUMENT JUNCTION DEVELOPER
WILL COORDINATE RELOCATIONS
FOR EXIST. FIBER LINES, GAS
AND ELEC. FACILITIES.

EXISTING ASPHALT PARKING
AND C&G TO BE REMOVED
(WITHIN RETAINING WALL
DISTURBANCE HATCH)
REPLACE ASPHALT PARKING,
C&G AND ADD GUARDRAIL)

VALLEY VISTA
ESTATES FILING NO. 3,
LOT 3

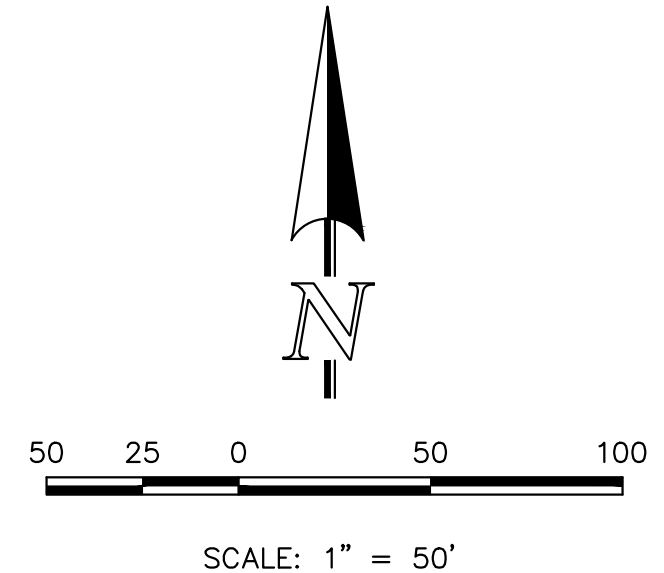

<p>48 HOURS BEFORE YOU DIG, CALL UTILITY LOCATORS 811 UTILITY NOTIFICATION CENTER OF COLORADO IT'S THE LAW</p> <p>THE LOCATIONS OF EXISTING UNDERGROUND UTILITIES ARE SHOWN IN AN APPROXIMATE WAY ONLY. THE CONTRACTOR SHALL DETERMINE THE EXACT LOCATION OF ALL EXISTING UTILITIES BEFORE COMMENCING WORK. THE CONTRACTOR SHALL BE FULLY RESPONSIBLE FOR ANY AND ALL DAMAGES WHICH MIGHT BE CAUSED BY HIS FAILURE TO EXACTLY LOCATE AND PRESERVE ANY AND ALL UNDERGROUND UTILITIES.</p>		<table border="1"> <thead> <tr> <th>NO.</th> <th>REVISION</th> <th>DATE</th> </tr> </thead> <tbody> <tr> <td>1</td> <td>REVISED PER COUNTY COMMENTS</td> <td>7/10/23</td> </tr> <tr> <td> </td> <td> </td> <td> </td> </tr> <tr> <td> </td> <td> </td> <td> </td> </tr> <tr> <td> </td> <td> </td> <td> </td> </tr> </tbody> </table>	NO.	REVISION	DATE	1	REVISED PER COUNTY COMMENTS	7/10/23									
NO.	REVISION	DATE															
1	REVISED PER COUNTY COMMENTS	7/10/23															

REVIEW:
PREPARED UNDER MY DIRECT SUPERVISION FOR AND ON BEHALF OF
CLASSIC CONSULTING ENGINEERS AND SURVEYORS, LLC

MARC. A. WHORTON, COLORADO P.E. #37155 DATE


CLASSIC
 CONSULTING
 ENGINEERS & SURVEYORS

STATE HIGHWAY 105 / JACKSON CREEK PKWY. -- PHASE 2 CONSTRUCTION PLANS			
ROADWAY IMPROVEMENT PLANS			
RETAINING WALL PLAN			
DESIGNED BY	PRA	SCALE	DATE 02-23-23
DRAWN BY	PRA	(H) 1" = 50'	SHEET 6 OF 26
CHECKED BY	(V) 1" = 5'	JOB NO.	1302.22

CLASSIC CONSULTING ENGINEERS & SURVEYORS

N:\130222\DRAWINGS\CONSTRUCT\DWG\SHEET-06-07-RETAINING WALL PLANS.DWG, 7/10/2023 3:17:53 PM, enrgon, 1:1

REDI-ROCK RETAINING WALL JACKSON CREEK PARKWAY & STATE HIGHWAY 105

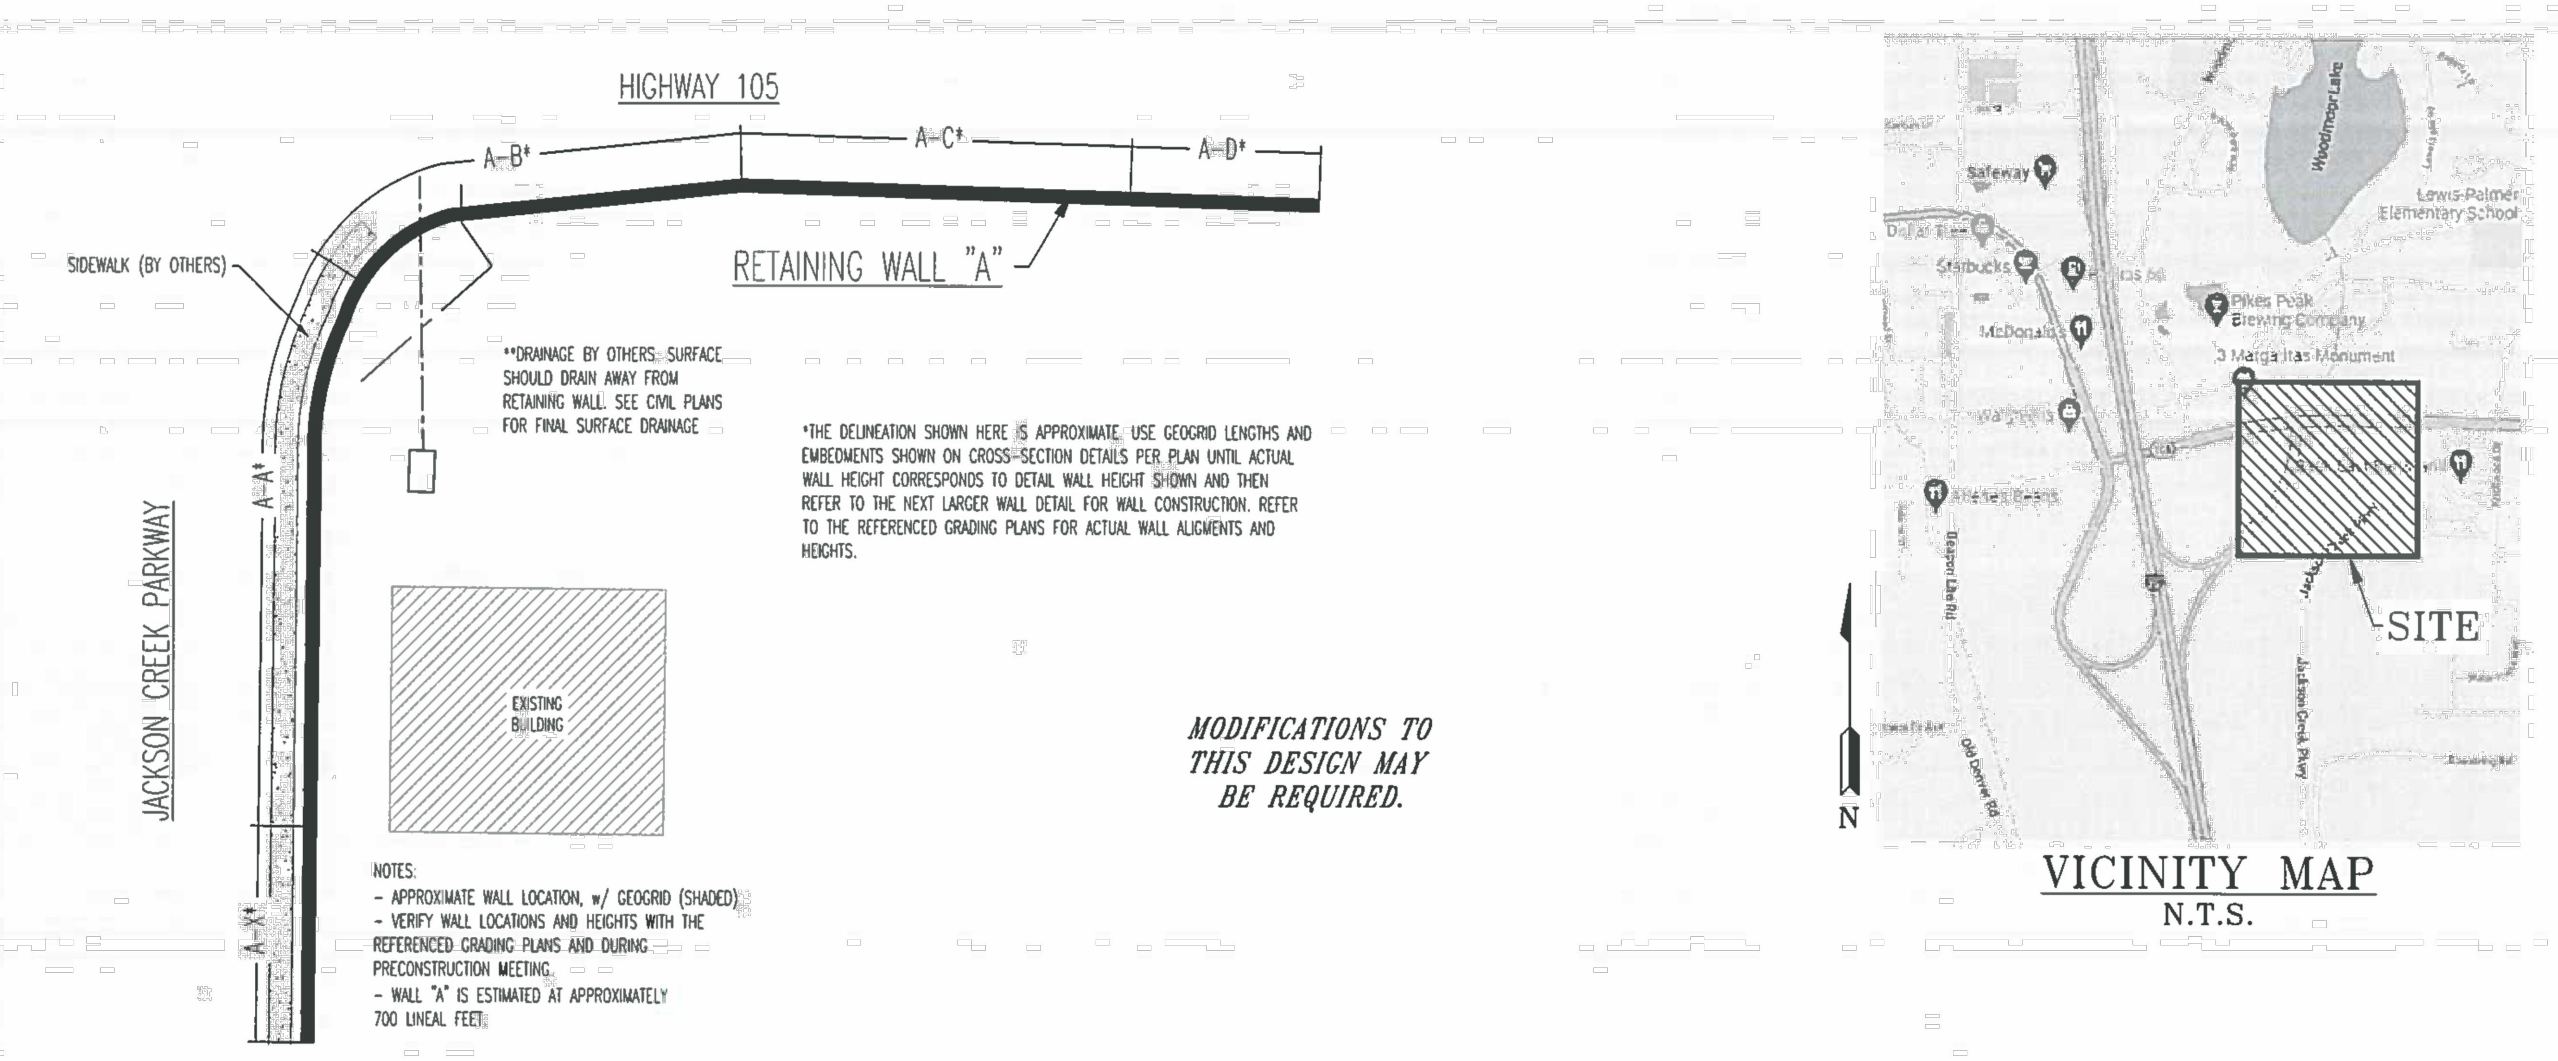



CONCEPTUAL PLAN VIEW
N.T.S.

INDEX OF SHEETS
PLAN & COVER SHEET
GENERAL NOTES & DETAILS
WALL "A" ELEVATION & SECTIONS
WALL "A" SECTIONS

PLAN SHEET NO.	INDEX OF SHEETS
1	PLAN & COVER SHEET
2	GENERAL NOTES & DETAILS
3	WALL "A" ELEVATION & SECTIONS
4	WALL "A" SECTIONS

NOTE: THIS DESIGN WAS BASED ON CONSTRUCTION PLANS BY CLASSIC CONSULTING ENGINEERS & SURVEYORS, AND THE SUBSURFACE SOILS INVESTIGATION BY ENTECH ENGINEERING, INC., DATED OCTOBER 20, 2022, ENTECH JOB NO. 221459. CONTRACTOR TO VERIFY RETAINING WALL DESIGN TO FINAL PLANS. IF THE RETAINED SOILS DIFFER FROM OUR ASSUMED SOIL TYPES, THEN THE ENGINEER MUST BE NOTIFIED AND MODIFICATIONS TO THIS DESIGN MAY BE REQUIRED.

Unresolved: Include calculation in drainage report to show that drainage is sized to adequately handle flow.

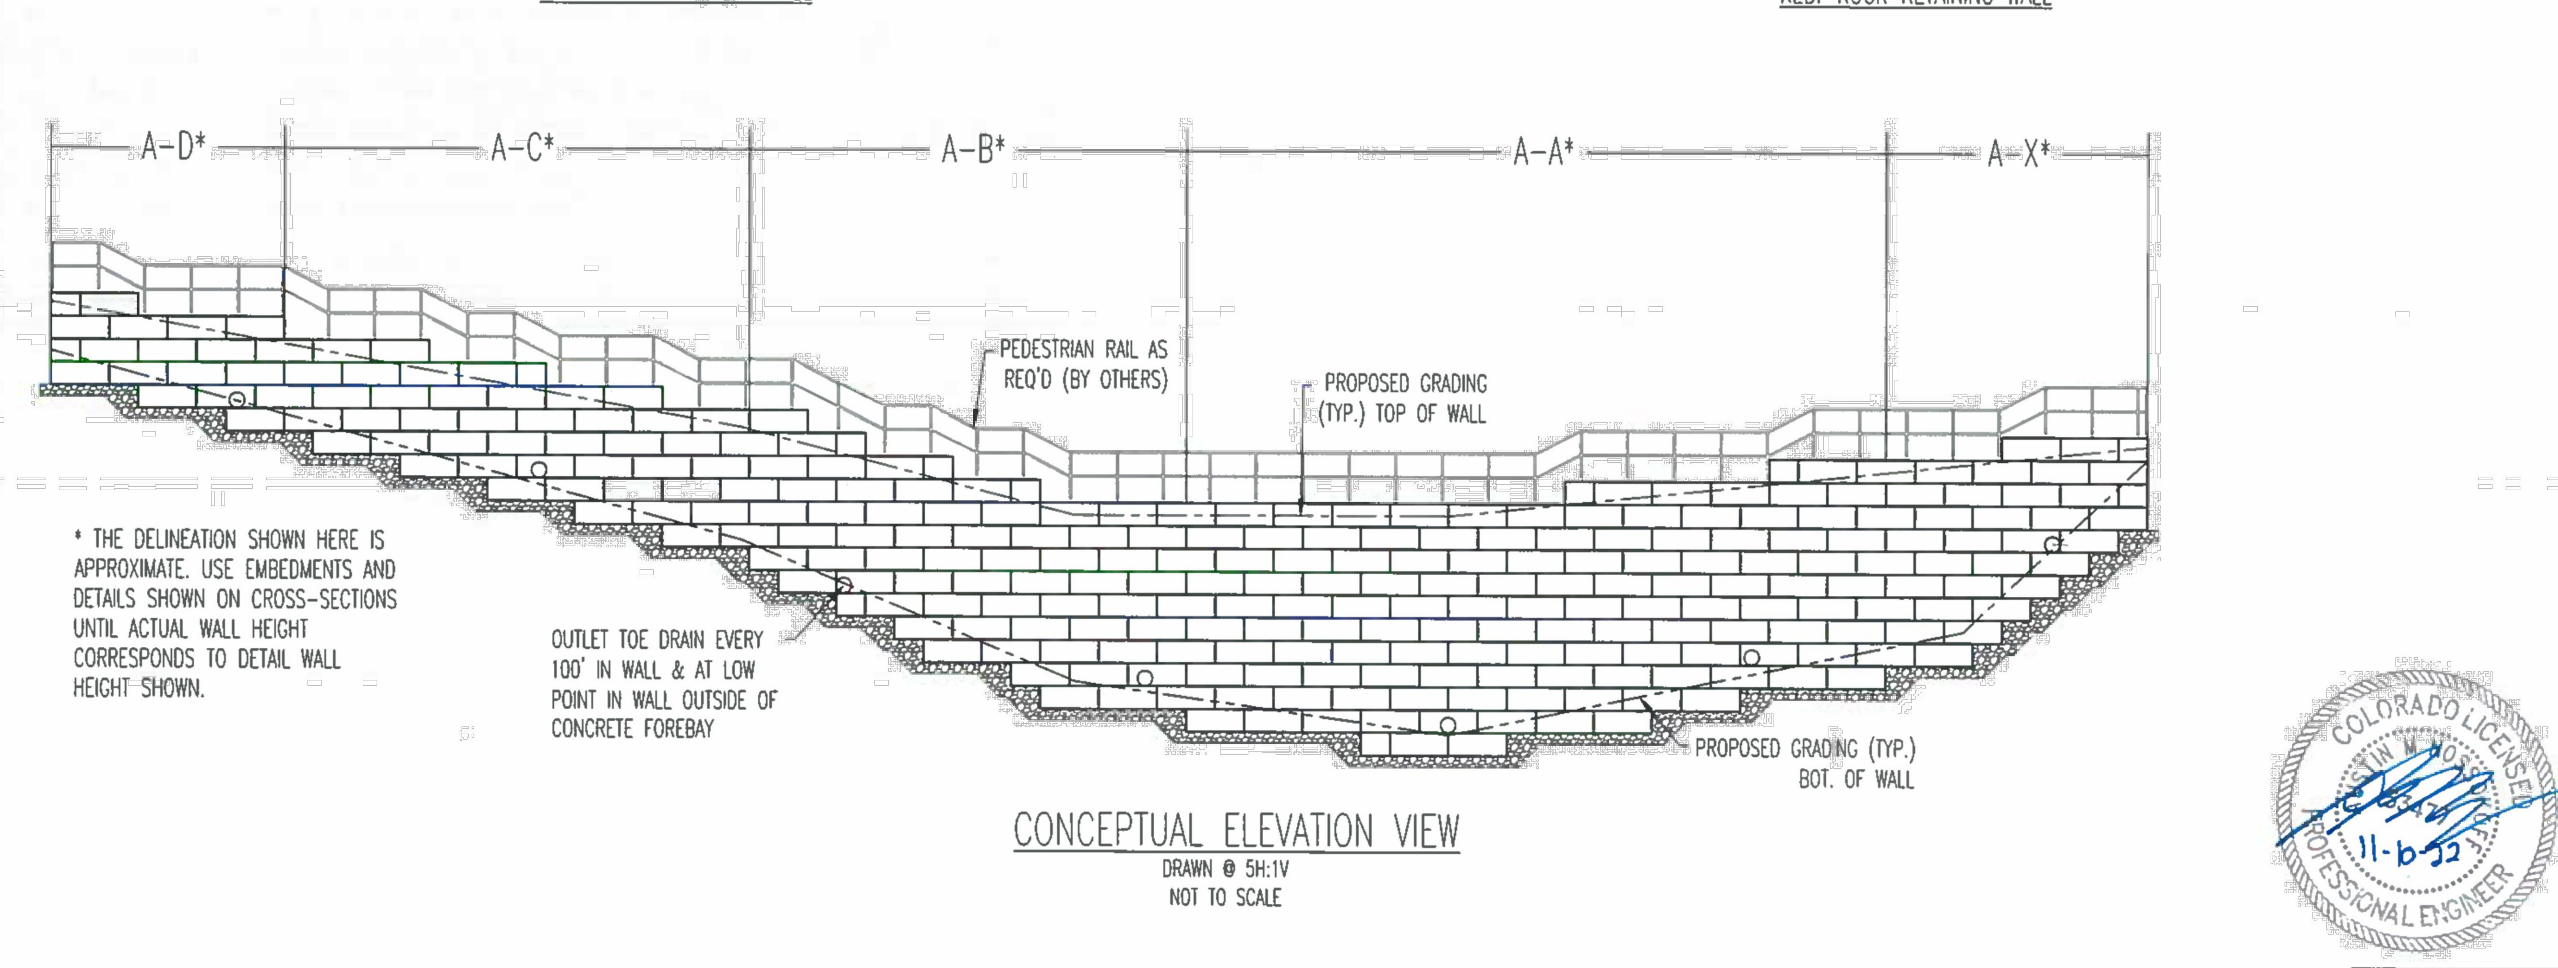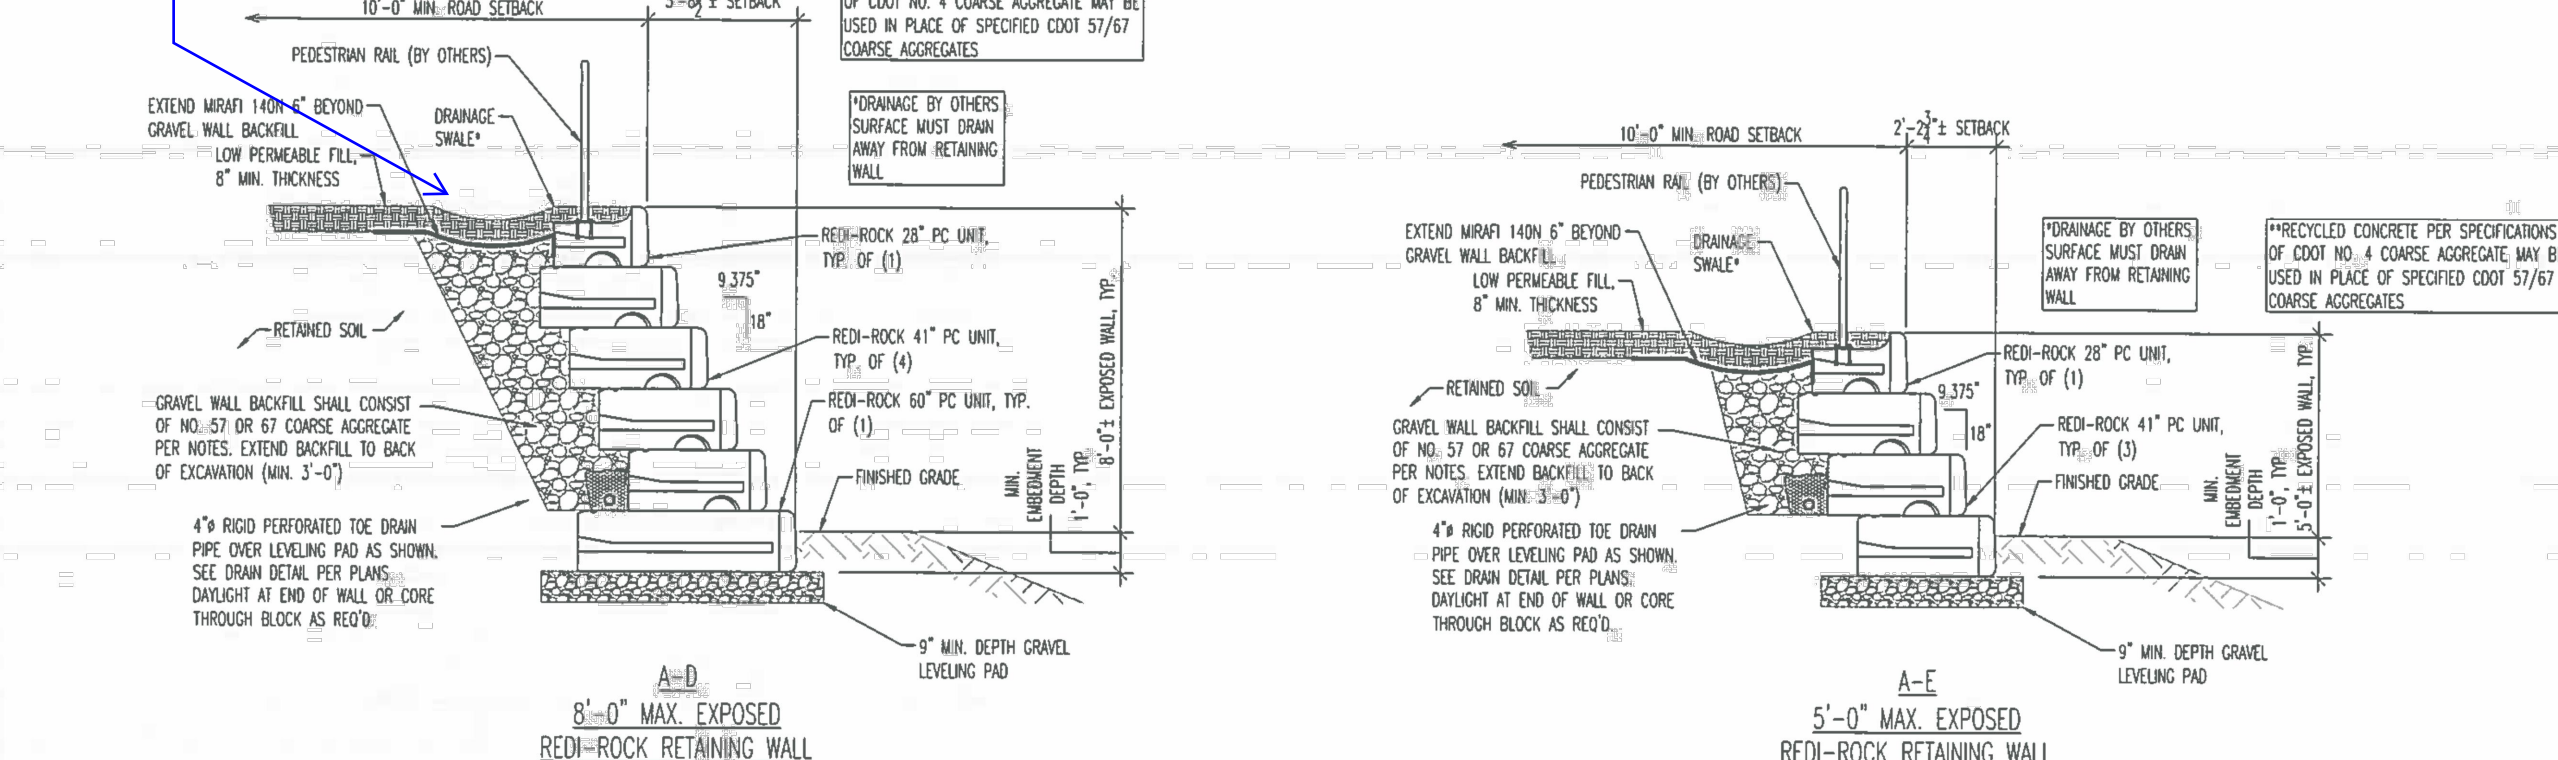

STATE OF COLORADO P.E. 11-b-22
PROFESSIONAL ENGINEER

ENTECH ENGINEERING, INC.
1110 S. W. 10th St., Suite 100
Monument, CO 80131
(719) 338-0000

REDI-ROCK RETAINING WALL
PLAN & COVER SHEET
JACKSON CREEK PKWY & STATE HWY 105
MONUMENT, CO
FOR: CLASSIC COMMUNITIES

DESIGNED BY: JAW
CHECKED BY: JAW
DATE: 11/16/2022
SCALE: N.T.S.
JOB NO.: 221459
SHEET NO.: 1 OF 4

ENTECH ENGINEERING, INC.
1110 S. W. 10th St., Suite 100
Monument, CO 80131
(719) 338-0000

REDI-ROCK RETAINING WALL
WALL "A" ELEVATION & SECTIONS
JACKSON CREEK PKWY & STATE HWY 105
MONUMENT, CO
FOR: CLASSIC COMMUNITIES

DESIGNED BY: JAW
CHECKED BY: JAW
DATE: 11/16/2022
SCALE: N.T.S.
JOB NO.: 221459
SHEET NO.: 2 OF 4

GENERAL NOTES

- These notes shall be read in conjunction with the drawings. In the event of a conflict, notify the Engineer for clarification.
- Before enclosing anything herein, check actual job conditions. Report any discrepancy, dimensional or otherwise, and any other error, omission, or difficulty affecting the work to the Engineer for review.
- These retaining wall plans have been prepared to represent specific design parameters. It is the responsibility of the Project Owner/General Contractor to resolve construction problems due to changed conditions encountered during the progress of any portion of the work. The Project Owner/General Contractor is responsible for contacting the Engineer prior to making any changes to this design. This design addresses local retaining wall stability including lateral and external stability and does not include a slope or global stability analysis for areas beyond the retaining wall.
- Groundwater or footing level was not considered in the design of this retaining wall. If groundwater is encountered, contact the Engineer immediately.
- The Owner or his representative reserves the right to inspect any material, fabrication, or workmanship of any type in the field or shop for conformance to the specifications, general notes, and drawings.
- All details and sections are intended to be typical and shall be construed to apply to any similar situation elsewhere, except where a different detail is shown.
- The Contractor shall make substitutions as noted herein to the Engineer in a timely manner so as to allow a ten business day review period. Quantities and dimensions are the responsibility of the Contractor. The Contractor shall make substitutions as necessary until the concurrence of the Engineer and his Consultants is obtained. Substitutions will not be considered by the Engineer or his Consultants unless submitted two weeks prior to time of installation, and complete documentation is provided substantiating compliance with the Contract Documents. Substituted products and samples as required. Substitutions will not be considered when acceptance will require substantial revision of the Contract Documents. The Engineer and his Consultants will determine acceptability of proposed substitution.
- The Contractor shall obtain a copy of and understand all applicable manufacturer's specifications. If discrepancies occur between manufacturer's specifications and those shown on the details, contact the Engineer immediately. Backfill areas shall be sloped to avoid ponding water and to allow for surface drainage to flow away from the wall.
- This design is valid only for the proposed retaining wall at the specified address. This retaining wall has been designed according to the grading plans by Classic Consulting Engineers & Surveyors, and the Subsurface Soils Investigation by Entech Engineering, Inc., dated October 20, 2022, Entech Job No. 221459.

B. BLOCK UNITS

- Redi-Rock PC. It shall be the contractor's responsibility to ensure that all units are erected in undamaged conditions. Units with cracks or other imperfections which, in the opinion of the Engineer, are unacceptable shall not be placed in the wall. Rejected units shall be removed from the site with no additional compensation.

C. WALL LAYOUT AND BASE PREPARATION

- Excavation to sound soil material shall be made at the base of the wall. Expansive Material may be encountered. Based on information obtained in the Subsurface Soils Investigation, expansive material should be removed and replaced per the recommendations provided in the Subsurface Soils Investigation. Unless shown otherwise, benches shall be made horizontal in the line of the wall.
- Contractor shall provide sufficient notice to the Engineer for observations, testing, and approval of the excavation prior to placing the granular bedding. If structural fill is used to obtain base elevation, the base soil shall be compacted to a minimum 95% of the Modified Proctor Dry Density (ASTM D1557-10).
- Finished base excavation shall be within 0.5 inches of the base elevation and shall include vertical steps where the base of the wall is to step.

D. LEVELING PAD

- After approval of a base wall, a continuous gravel pad (see plans) shall be placed below the first course of the concrete block to be used as a leveling pad. This pad shall consist of a minimum of 6-inch deep, U.M.C., COOT No. 57 or 67 coarse aggregate. (COOT Standard Specifications Table 703-2). The wall is to be placed by placing the first course of concrete block directly onto the leveling pad.

E. WALL UNIT INSTALLATION

- The units in the base course shall be checked for level alignment.
- Capstones used on the top course shall be attached with adhesive on a clean, dry surface as specified by the Manufacturer.

F. DRAINAGE MATERIAL PLACEMENT

- Place and compact drainage fill material behind wall units:
- Material shall consist of No. 57 or 67 coarse aggregate (COOT Standard Specifications Table 703-2).
- Minimum stacked vertical height of wall units prior to fill placement shall not exceed 2 courses.

G. BACKFILL MATERIAL

- Backfill materials used behind the wall shall consist of select granular structural backfill, compliant with COOT Class 1 backfill requirements or COOT 57 or 67 Aggregate per plan.
- Backfill materials shall be placed in lifts not exceeding 8 inches in loose thickness and compacted to a minimum of 95% of the Modified Proctor Dry Density (ASTM D1557-10).

H. LOW PERMEABLE SOIL CAP

- Soil used for low permeable soils cap such as styrofoam (SC) soils or import approved by the engineer. Materials shall be placed in lifts not exceeding 8 inches in loose thickness and compacted to a minimum of 95% of the Modified Proctor Dry Density (ASTM D1557-10).
- 4" of gravel is to be placed on top of the impermeable layer. The top 6" from the surface down shall be tamped or mixed to ensure cohesion of the impermeable and topsoil layers.

CONSTRUCTION PRECAUTIONS

- During construction, Contractor shall slope backfill fill of each day away from wall units and shall not allow runoff from adjacent areas to enter construction area.
- Construction practices shall comply with OSHA standards and regulations.

PRECONSTRUCTION

- Contractor must schedule a preconstruction meeting with the Engineer prior to the initiation of any excavation, with at least 24 hours of advanced notice.

K. WALL GEOMETRY

- Design Wall Height (H): See Plans
- Embedment Wall Height (H_e): See Plans
- Exposed Wall Design Height (H₁): See Plans
- Wall Inclination (Deg.): See Plans

L. SEGMENTAL UNIT DATA - VERIFY w/ MANUFACTURER SPECS.

SOIL DATA				
Soil Zone	Description	Cohesion (C) (pcf)	Friction Angle (φ) (deg)	Unit Weight (γ) (pcf)
Structural Soil	Silty Sand	0.00	33.00	120.00
Retained Soil	Silty Sand	0.00	33.00	120.00
Leveling Pad Soil	Gravel	0.00	36.00	125.00
Foundation Soil	Silty Sand	0.00	33.00	120.00

M. WALL GRADES

- Top Slope: See Plans
- Toe Slope: See Plans

N. RETAINING WALL DESIGN PARAMETERS

- Distributed Surcharge: 100 Pedestrian (As Req'd)
- Live Load (psf): 100 Pedestrian (As Req'd)
- Minimum Factors of Safety:
 - External Stability: 1.5
 - Overturning: 2.0
 - Bearing Capacity: 2.0
- Internal Stability:
 - Overturning: 1.5
 - Pushout: 1.5

O. DRAIN DETAIL

4" ROD PERFORATED TO DRAIN PIPE OVER LEVELING PAD AS SHOWN. SEE DRAIN DETAIL PER PLANS. DRAINAGE AT END OF WALL OR CORE THROUGH BLOCK AS REQ'D.

NOTE: MAINTAIN 1 CUBIC FOOT OF AGGREGATE PER 1 LF OF DRAIN.

4" ROD PERFORATED TO DRAIN PIPE AT A 1% SLOPE TO DRAINAGE.

3" MIN. SLOPE

12" MIN.

4" MIN. DEPTH GRAVEL LEVELING PAD

8" MIN. DEPTH GRAVEL LEVELING PAD

17'-0" MAX EXPOSED REDI-ROCK RETAINING WALL

14'-0" MAX EXPOSED REDI-ROCK RETAINING WALL

11'-0" MAX EXPOSED REDI-ROCK RETAINING WALL

8'-0" MAX EXPOSED REDI-ROCK RETAINING WALL

5'-0" MAX EXPOSED REDI-ROCK RETAINING WALL

STATE OF COLORADO P.E. 11-b-22
PROFESSIONAL ENGINEER

ENTECH ENGINEERING, INC.
1110 S. W. 10th St., Suite 100
Monument, CO 80131
(719) 338-0000

REDI-ROCK RETAINING WALL
GENERAL NOTES
JACKSON CREEK PARKWAY & STATE HWY 105
MONUMENT, CO
FOR: CLASSIC COMMUNITIES

DESIGNED BY: JAW
CHECKED BY: JAW
DATE: 11/16/2022
SCALE: N.T.S.
JOB NO.: 221459
SHEET NO.: 3 OF 4

ENTECH ENGINEERING, INC.
1110 S. W. 10th St., Suite 100
Monument, CO 80131
(719) 338-0000

REDI-ROCK RETAINING WALL
WALL "A" SECTIONS
JACKSON CREEK PARKWAY & HWY 105
MONUMENT, CO
FOR: CLASSIC COMMUNITIES

DESIGNED BY: JAW
CHECKED BY: JAW
DATE: 11/16/2022
SCALE: N.T.S.
JOB NO.: 221459
SHEET NO.: 4 OF 4

48 HOURS BEFORE YOU DIG,
CALL UTILITY LOCATORS
811
UTILITY NOTIFICATION CENTER OF COLORADO
IT'S THE LAW

THE LOCATIONS OF EXISTING UNDERGROUND UTILITIES ARE SHOWN IN AN APPROXIMATE WAY ONLY. THE CONTRACTOR SHALL DETERMINE THE EXACT LOCATION OF ALL EXISTING UTILITIES BEFORE COMMENCING WORK. THE CONTRACTOR SHALL BE FULLY RESPONSIBLE FOR ANY AND ALL DAMAGES WHICH MIGHT BE CAUSED BY HIS FAILURE TO EXACTLY LOCATE AND PRESERVE ANY AND ALL UNDERGROUND UTILITIES.

NO. REVISION

NO.	REVISION	DATE

REVIEW:

PREPARED UNDER MY DIRECT SUPERVISION FOR AND ON BEHALF OF CLASSIC CONSULTING ENGINEERS AND SURVEYORS, LLC

MARC. A. WHORTON, COLORADO P.E. #37155 DATE

619 N. Cascade Avenue, Suite 200
Colorado Springs, Colorado 80903
(719) 785-0790
(719) 785-0799(Fax)


STATE HIGHWAY 105 / JACKSON CREEK PKWY. - PHASE 2 CONSTRUCTION PLANS
ROADWAY IMPROVEMENT PLANS
RETAINING WALL DETAILS

DESIGNED BY: PRA SCALE: DATE: 02-23-23


DRAWN BY: PRA (H) 1" = 50' SHEET 7 OF 26

CHECKED BY: (V) 1" = 5' JOB NO. 1302.22


N:\130222\DRAWINGS\CONSTRUCT\CON\SH-105-07-RETAINING WALL PLANS.DWG, 7/10/2023 4:16:22 PM, enyong, 1:1

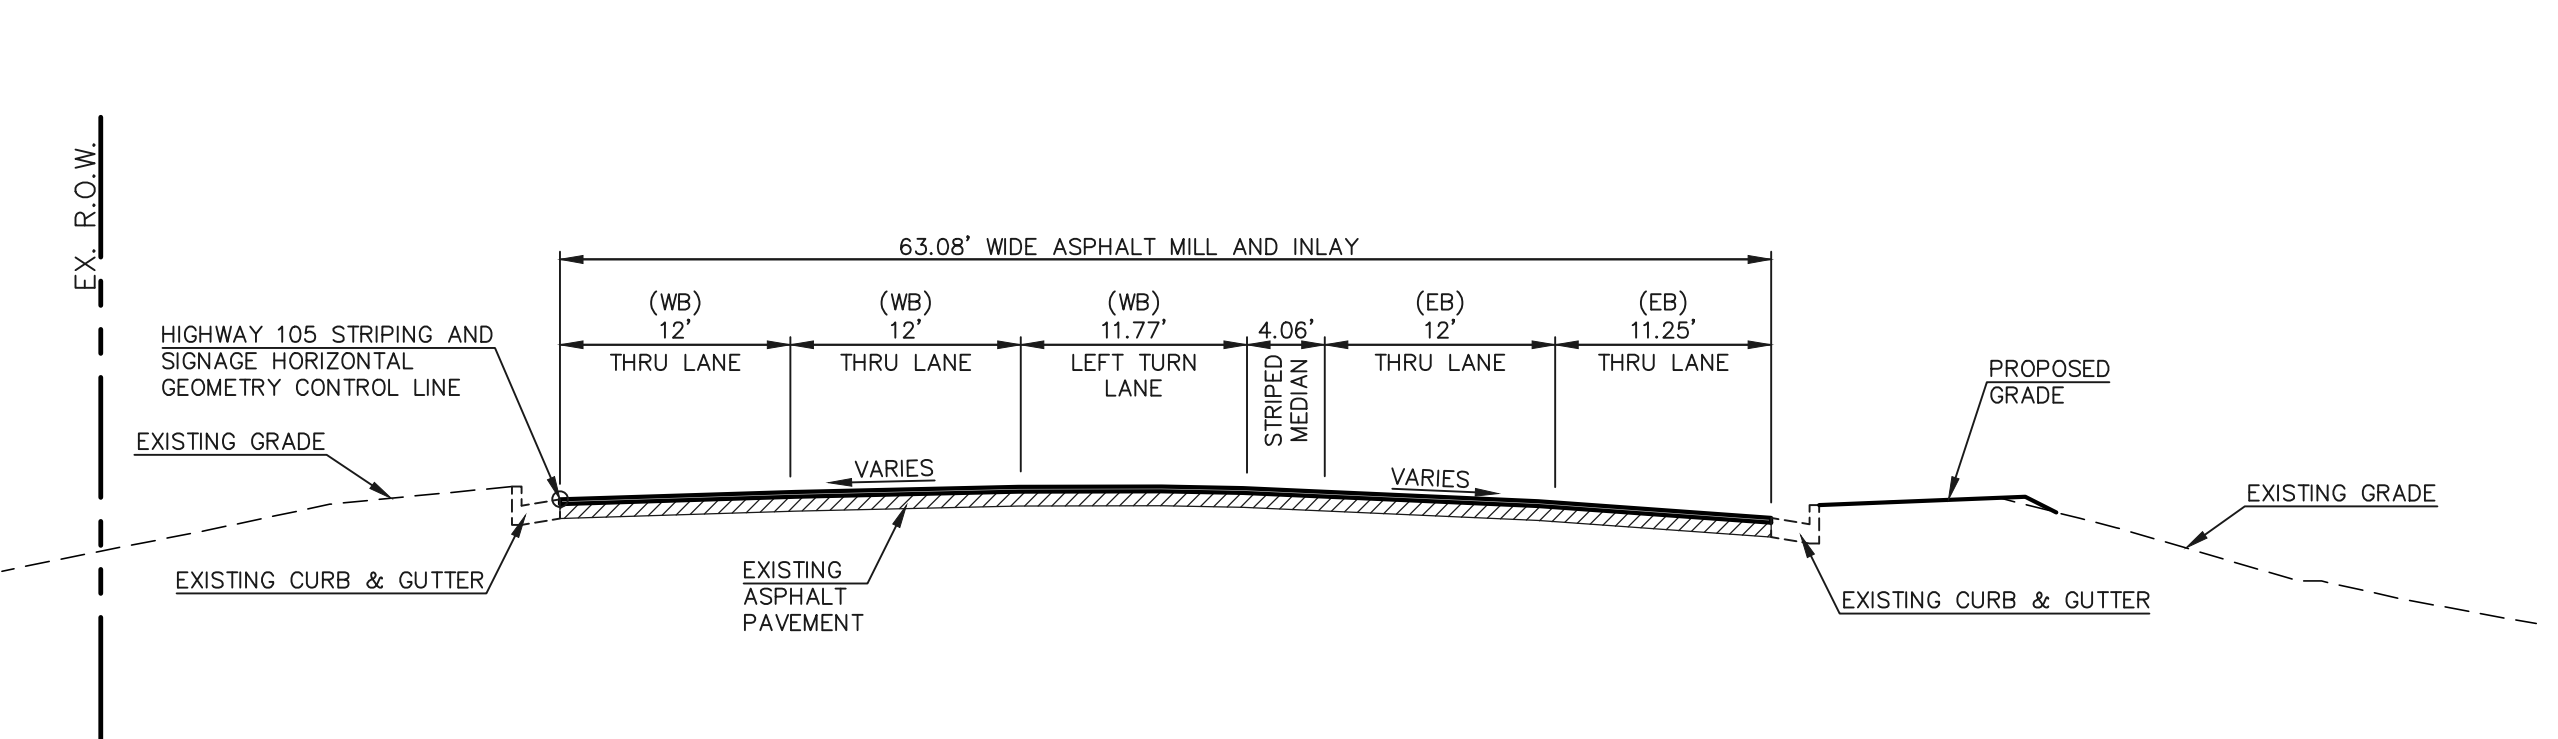

STATE HIGHWAY 105 ROADWAY SECTION
STA. 0+32.32
SCALE: 1"=10' (H), 1"=5' (V)

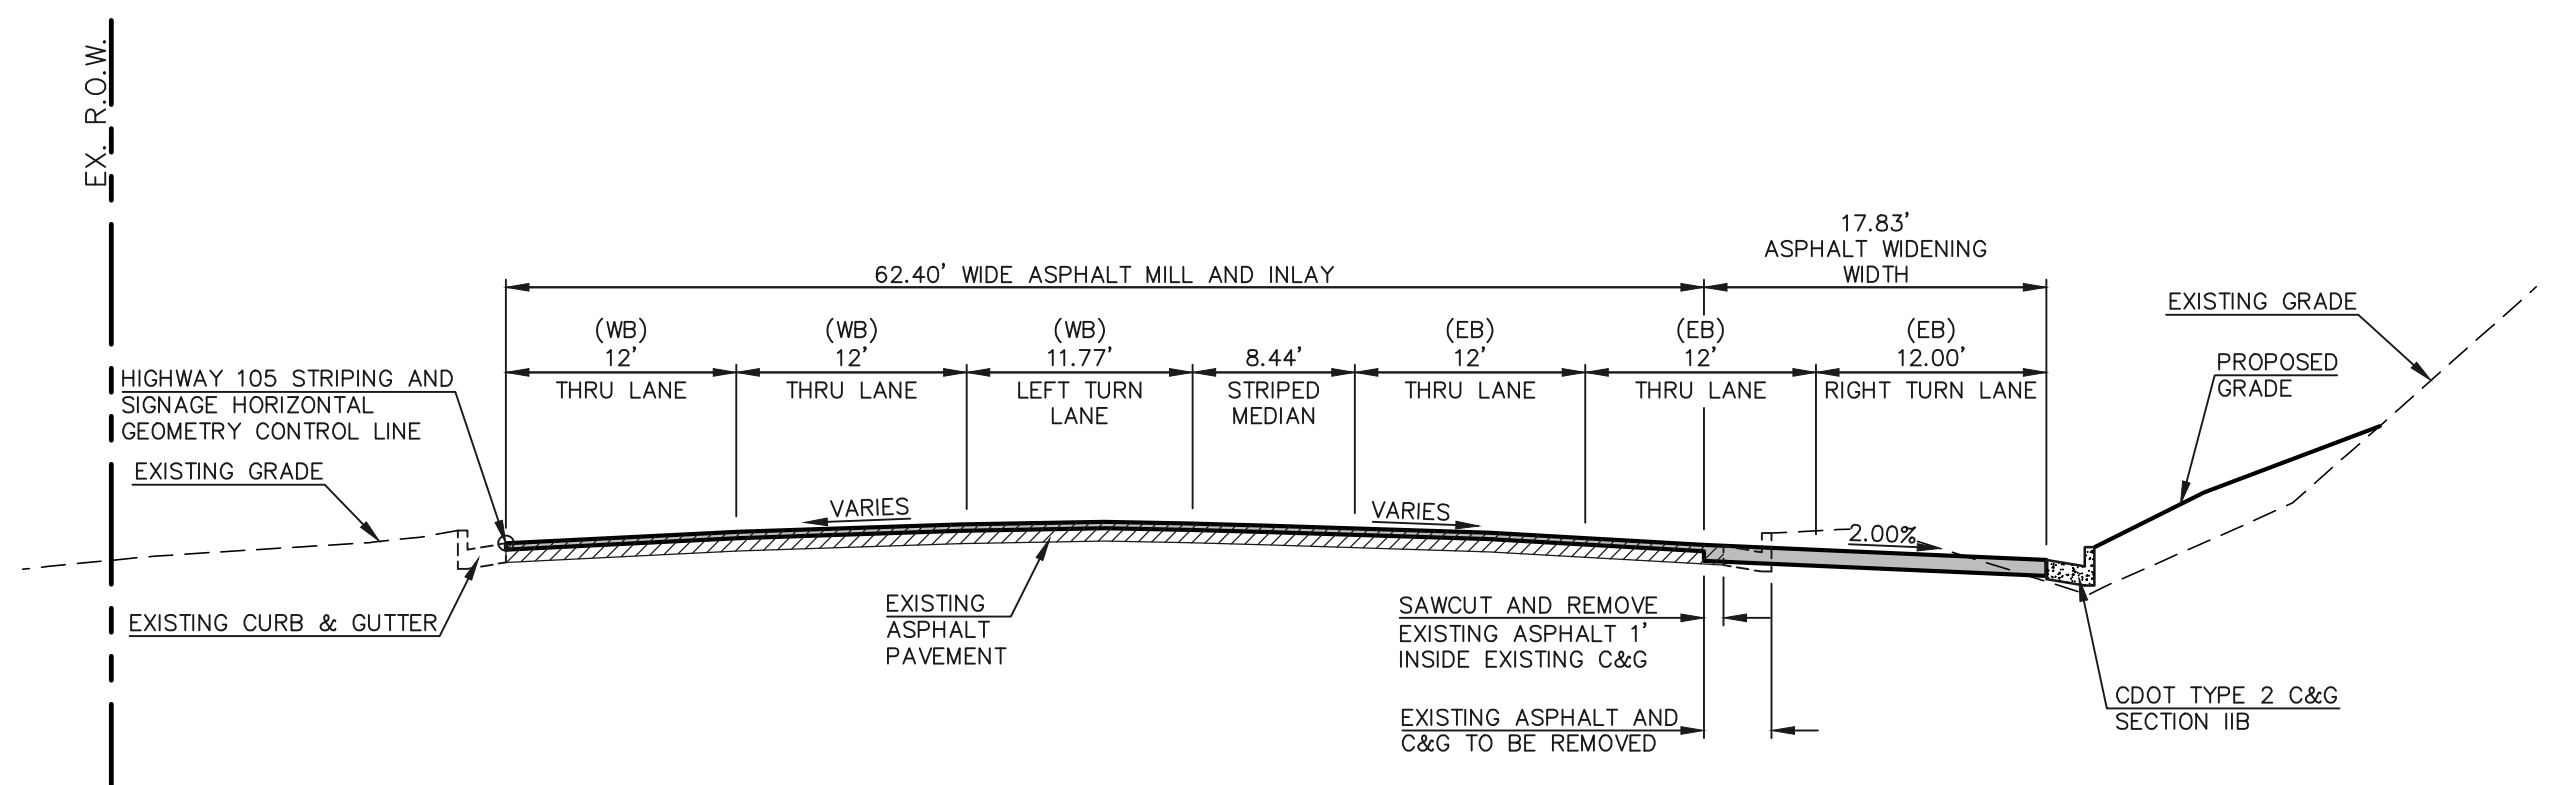



STATE HIGHWAY 105 ROADWAY SECTION
STA. 1+97.85
SCALE: 1"=10' (H), 1"=5' (V)

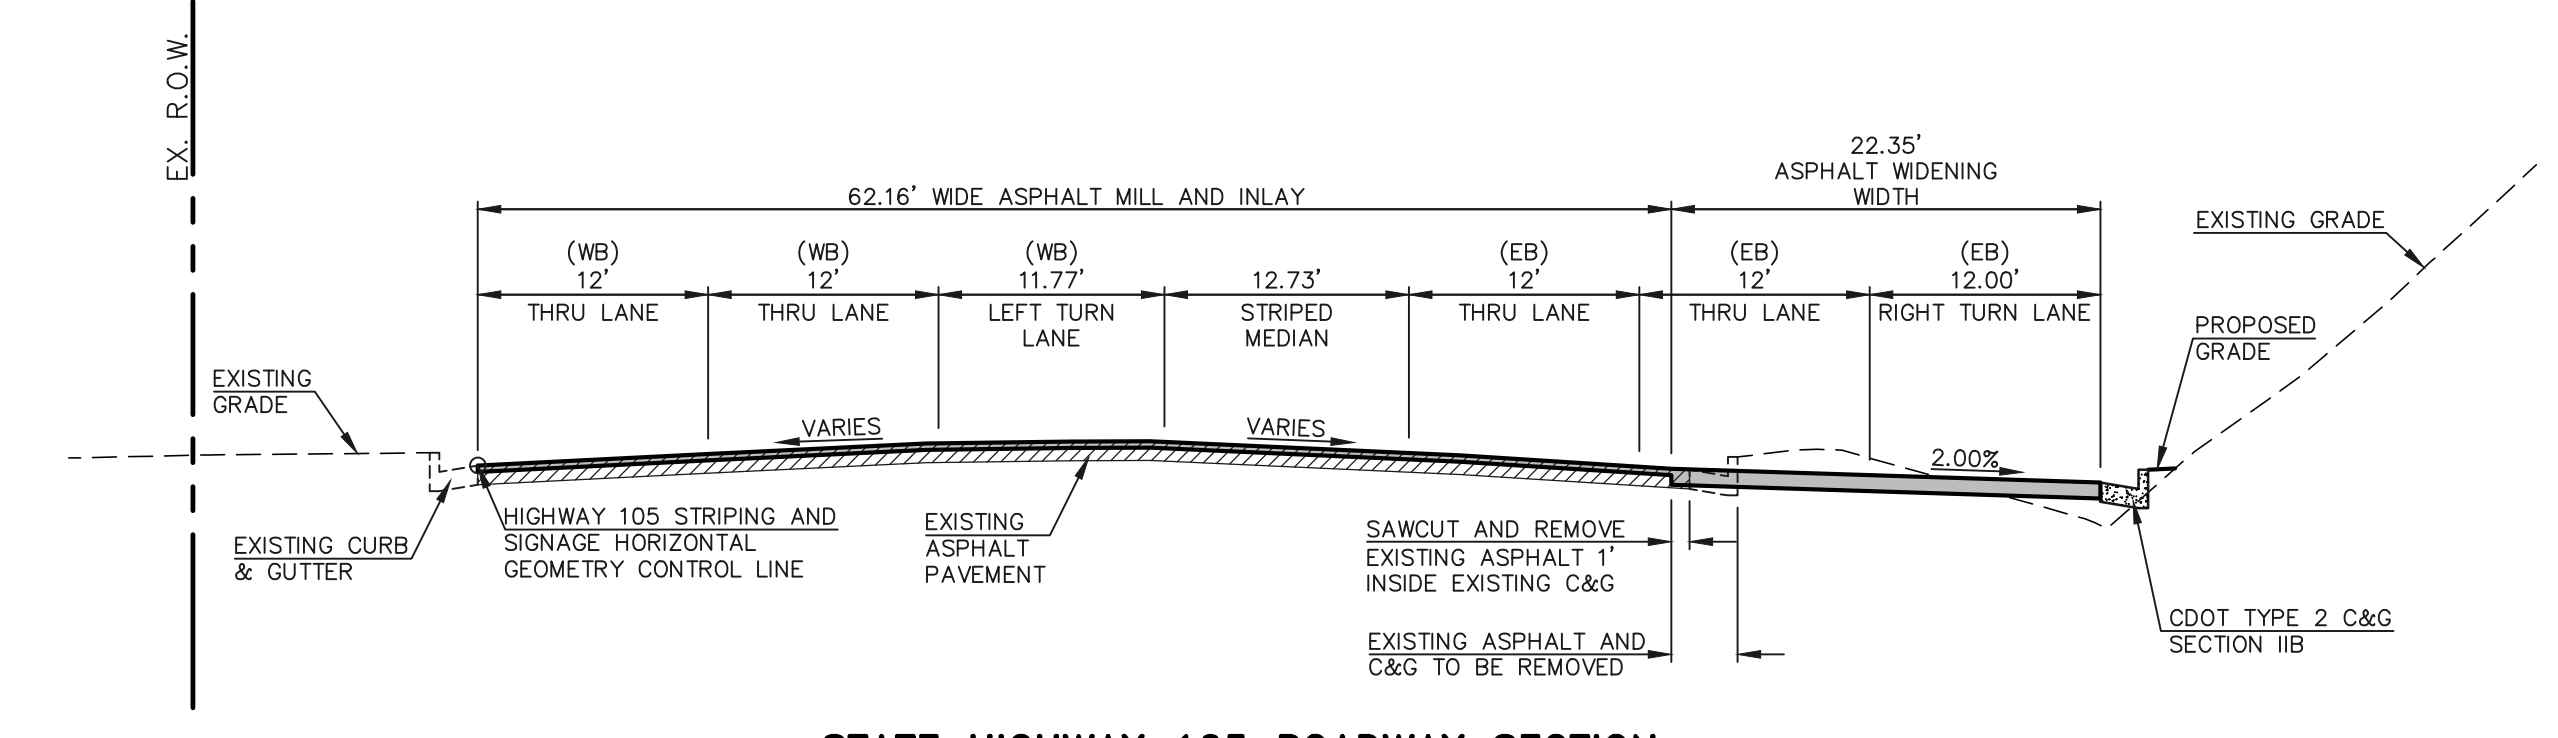


STATE HIGHWAY 105 ROADWAY SECTION
STA. 3+38.75
SCALE: 1"=10' (H), 1"=5' (V)

HOT MIX ASPHALT PAVEMENT STRUCTURE TABLE


TOTAL HOT MIX ASPHALT DEPTH	5.0"
# OF LIFTS	2
HOT MIX ASPHALT BINDER COURSE GRAD-S(75) (PG 64-22)	LIFT 1 3.0"
HOT MIX ASPHALT SURFACE COURSE GRAD-SX(75) (PG 64-28)	LIFT 2 2.0"

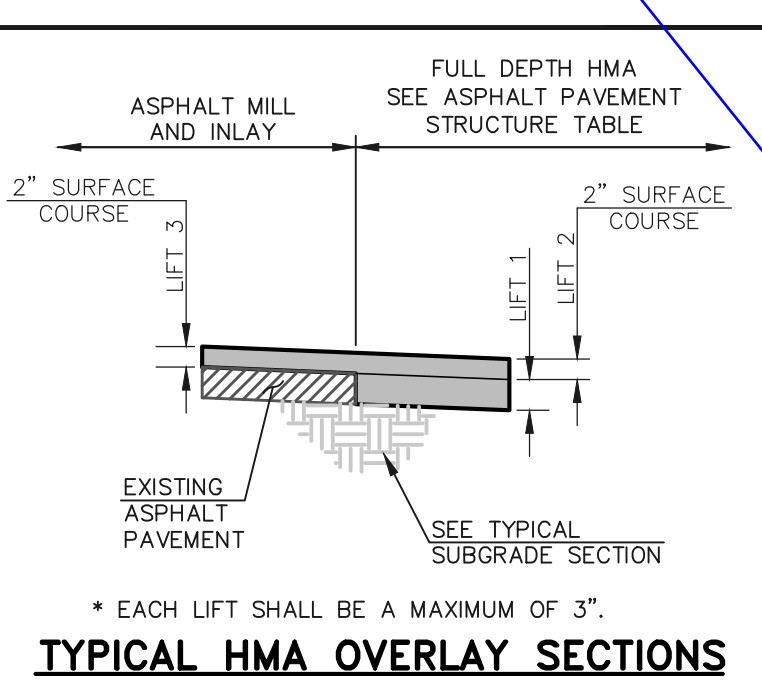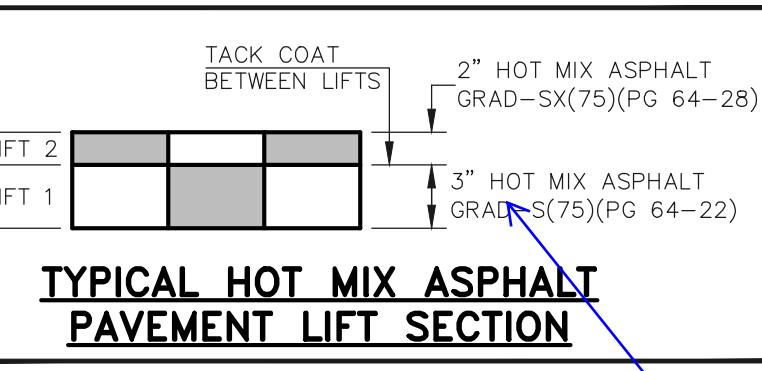


SUBGRADE NOTES:
SUBGRADE FOR CUT CONDITIONS:
 IF SUBGRADE IS R >= 17, THEN PERFORM CEMENT TREATED SUBGRADE ON TOP 12 INCHES.
 IF SUBGRADE IS R < 17, THEN OVER EXCAVATE 24 INCHES AND REPLACE WITH R >= 17 MATERIAL AND PERFORM CEMENT TREATED SUBGRADE ON TOP 12 INCHES.
 [RECONDITIONING IS SPECIFIED IN SECTION 306 OF THE CDOT STANDARD SPECIFICATIONS].
SUBGRADE FOR FILL CONDITIONS:
 ALL FILL SHALL BE R >= 17 MATERIAL WITH 12 INCHES OF CEMENT TREATED SUBGRADE ON TOP OF FILL MATERIAL.

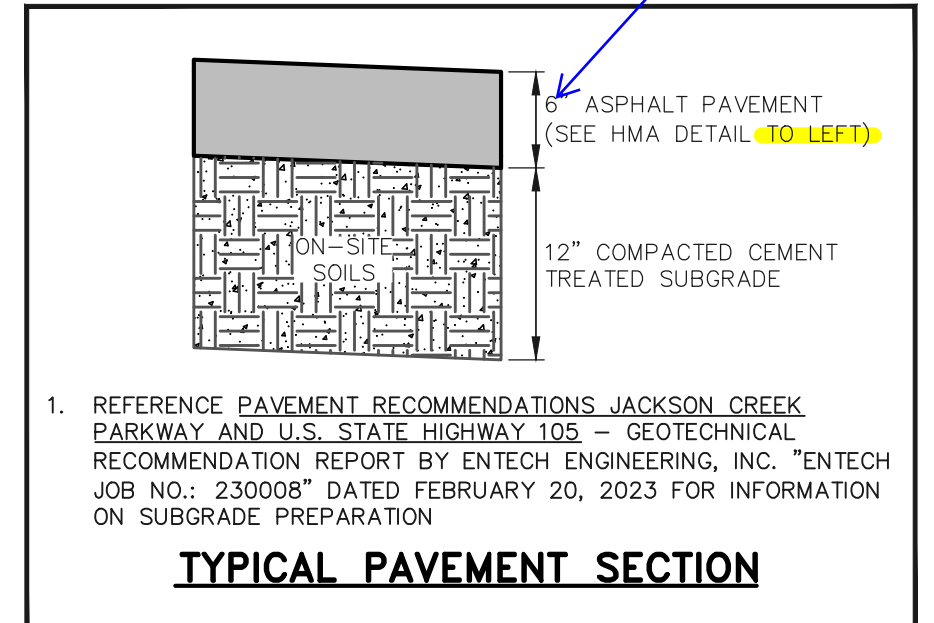


- HIGHWAY 105 TYPICAL SECTION NOTES**
- BREAK POINTS IN SLOPES SHALL BE ROUNDED BY THE CONTRACTOR FOR A PLEASING APPEARANCE DURING CONSTRUCTION.
 - SEE HIGHWAY 105 IMPROVEMENT PLANS (SHEETS 9, 10 AND 17) FOR ADDITIONAL INFORMATION ON THE ROADWAY SECTION DIMENSIONS.
 - A TWO-INCH OVERLAY OF THE ROADWAY IN AREAS OF RECONSTRUCTION AND/OR RE-STRIPING IS REQUIRED. THE WIDTH OF THE OVERLAY SHALL ENCOMPASS ALL LANES CONTIGUOUS TO AREAS OF RECONSTRUCTION AND/OR RE-STRIPING.
 - SEE PAVEMENT RECOMMENDATIONS JACKSON CREEK PARKWAY AND U.S. STATE HIGHWAY 105 - GEOTECHNICAL RECOMMENDATION REPORT BY ENTECH ENGINEERING, INC. "ENTECH JOB NO.: 230008" DATED FEBRUARY 20, 2023 FOR INFORMATION ON SUBGRADE PREPARATION.
 - THE CONTRACTOR SHALL VERIFY ALL SUBGRADE CONDITIONS IN CUT AREAS PRIOR TO PREPARATION AND PAVING.
 - FOR FILL CONDITIONS, THE CONTRACTOR SHALL VERIFY SUBGRADE CONDITIONS THROUGH COMPACTION AND DENSITY TESTING PRIOR TO PAVING.
 - SMOOTHNESS CATEGORY SHALL BE CATEGORY 2.

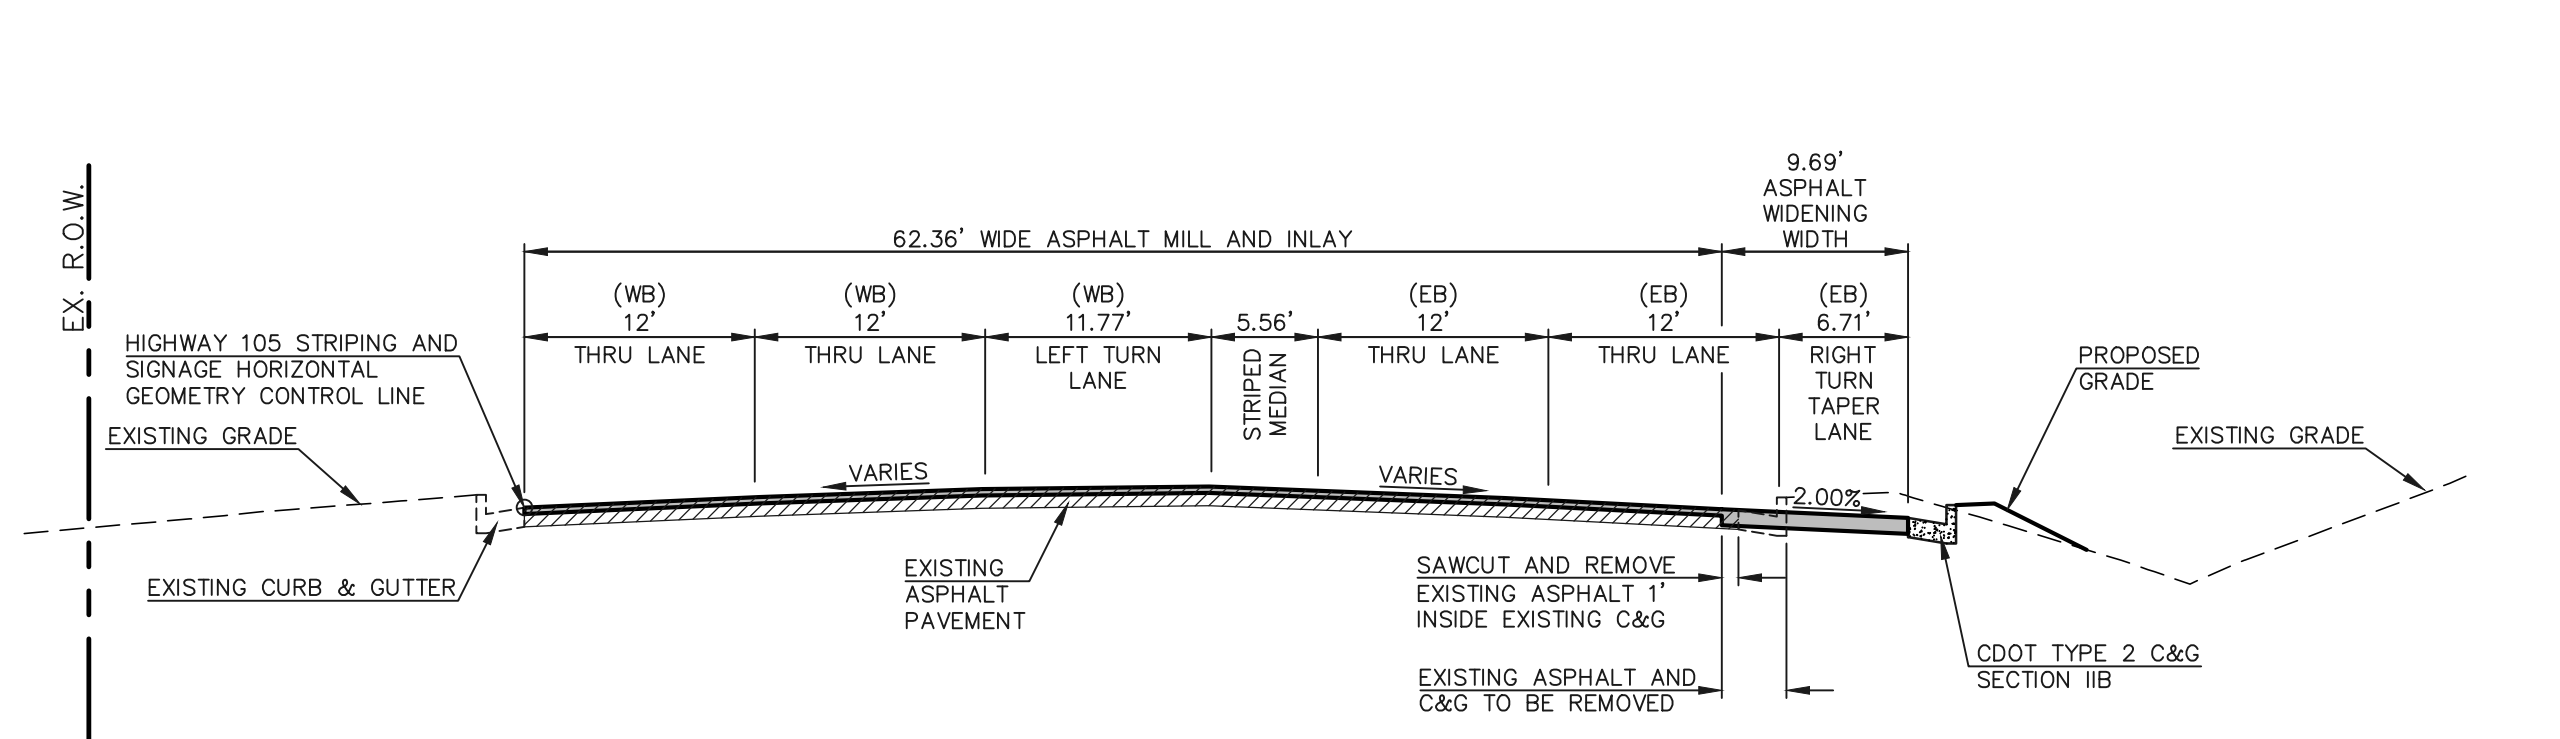

STATE HIGHWAY 105 ROADWAY SECTION
STA. 1+15.00
SCALE: 1"=10' (H), 1"=5' (V)

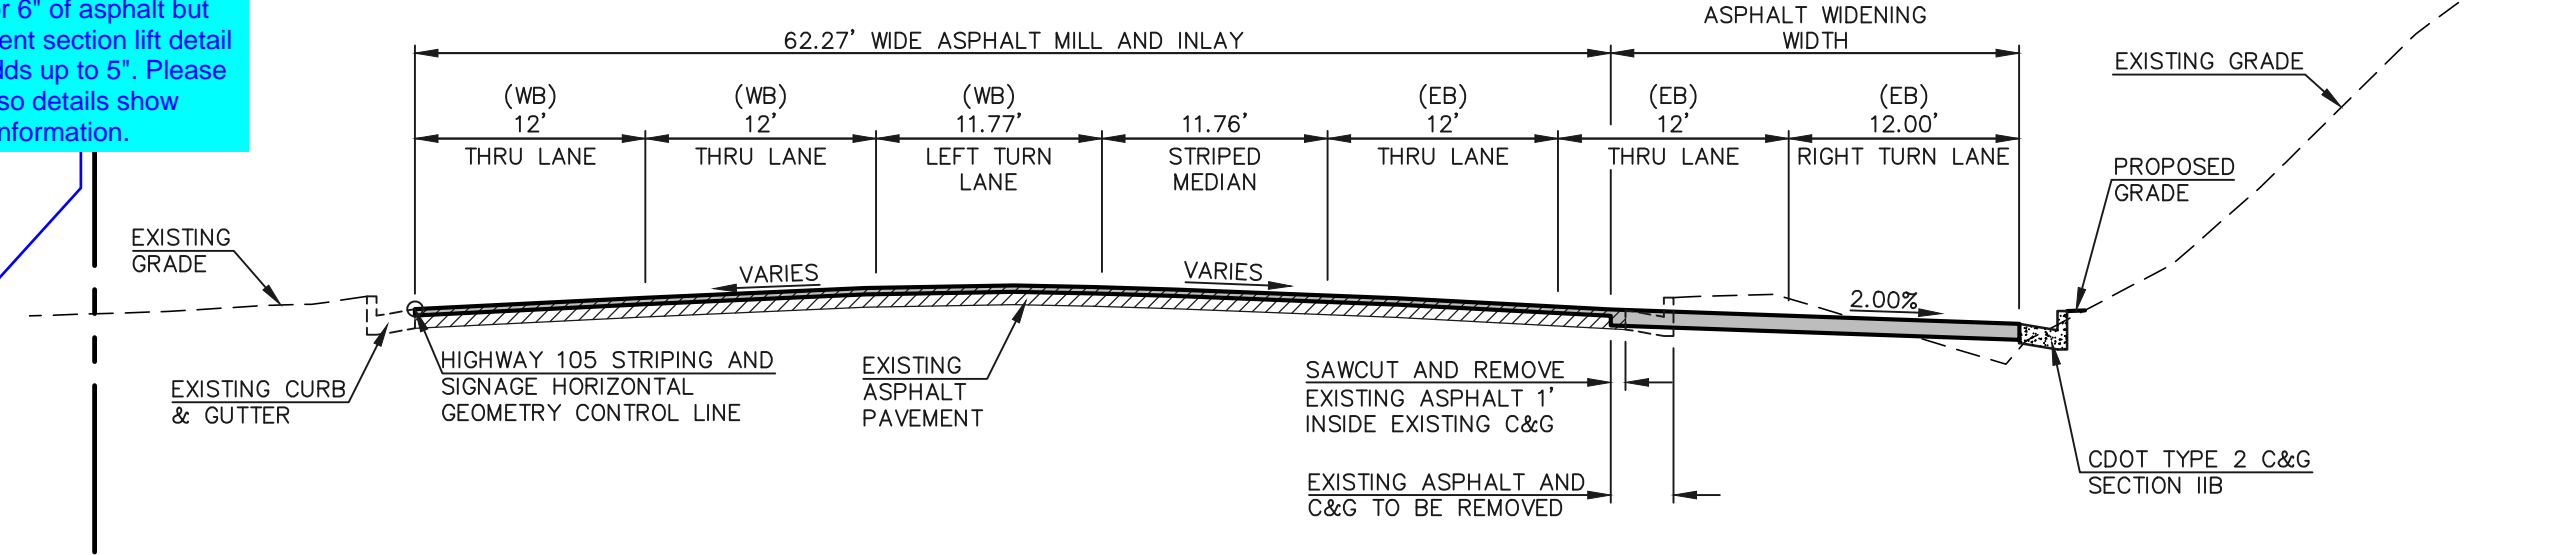

STATE HIGHWAY 105 ROADWAY SECTION
STA. 2+99.16
SCALE: 1"=10' (H), 1"=5' (V)

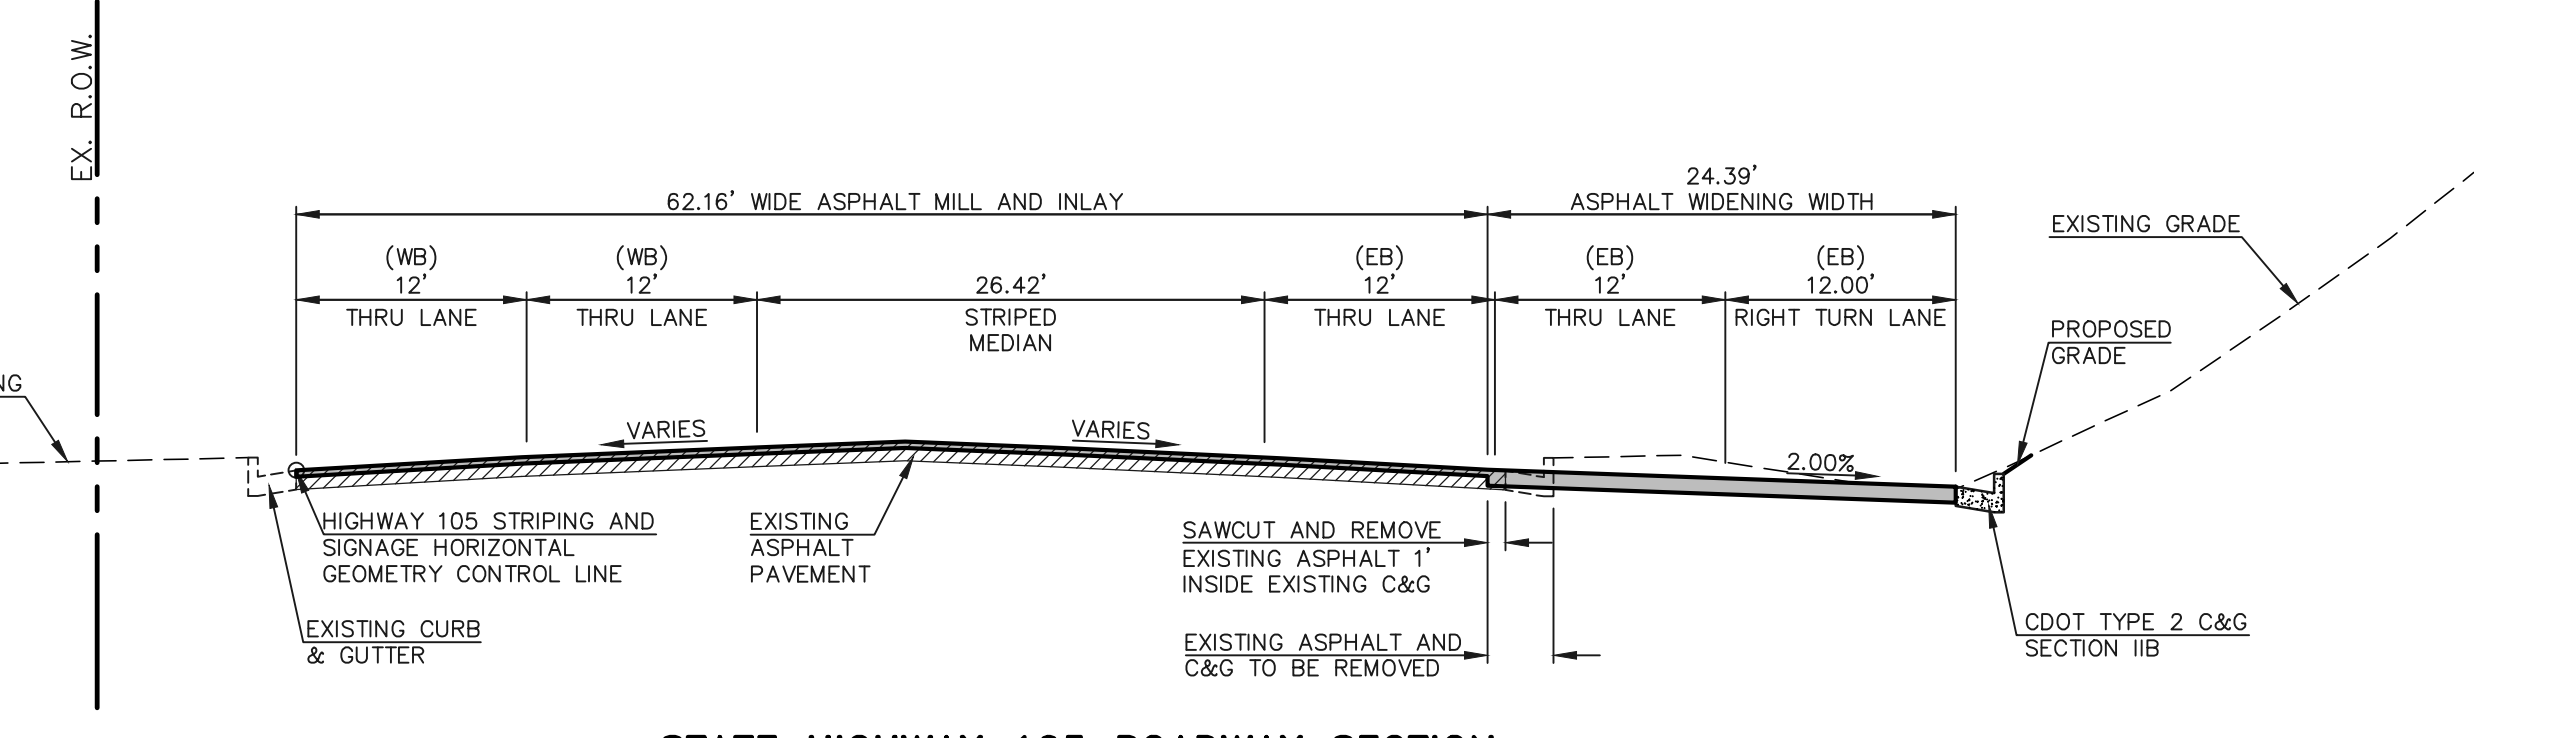

STATE HIGHWAY 105 ROADWAY SECTION
STA. 4+39.51
SCALE: 1"=10' (H), 1"=5' (V)

Pavement section detail calls for 6" of asphalt but pavement section lift detail only adds up to 5". Please revise so details show same information.




48 HOURS BEFORE YOU DIG,
 CALL UTILITY LOCATORS
811
 UTILITY NOTIFICATION CENTER OF COLORADO
 IT'S THE LAW
 THE LOCATIONS OF EXISTING UNDERGROUND UTILITIES ARE SHOWN IN AN APPROXIMATE WAY ONLY. THE CONTRACTOR SHALL DETERMINE THE EXACT LOCATION OF ALL EXISTING UTILITIES BEFORE COMMENCING WORK. THE CONTRACTOR SHALL BE FULLY RESPONSIBLE FOR ANY AND ALL DAMAGES WHICH MIGHT BE CAUSED BY HIS FAILURE TO EXACTLY LOCATE AND PRESERVE ANY AND ALL UNDERGROUND UTILITIES.

NO.	REVISION	DATE
1	ADDED SECTION SHEET PER CDOT COMMENTS	7/10/23

REVIEW:
 PREPARED UNDER MY DIRECT SUPERVISION FOR AND ON BEHALF OF CLASSIC CONSULTING ENGINEERS AND SURVEYORS, LLC
 MARC A. WHORTON, COLORADO P.E. #37155 DATE




STATE HIGHWAY 105 / JACKSON CREEK PKWY. - PHASE 2 CONSTRUCTION PLANS
 ROADWAY IMPROVEMENT PLANS
 HIGHWAY 105 ROADWAY SECTIONS
 DESIGNED BY PRA SCALE DATE 02-23-23
 DRAWN BY PRA (H) 1"= 50' SHEET 8 OF 26
 CHECKED BY (V) 1"= N/A JOB NO. 1302.22

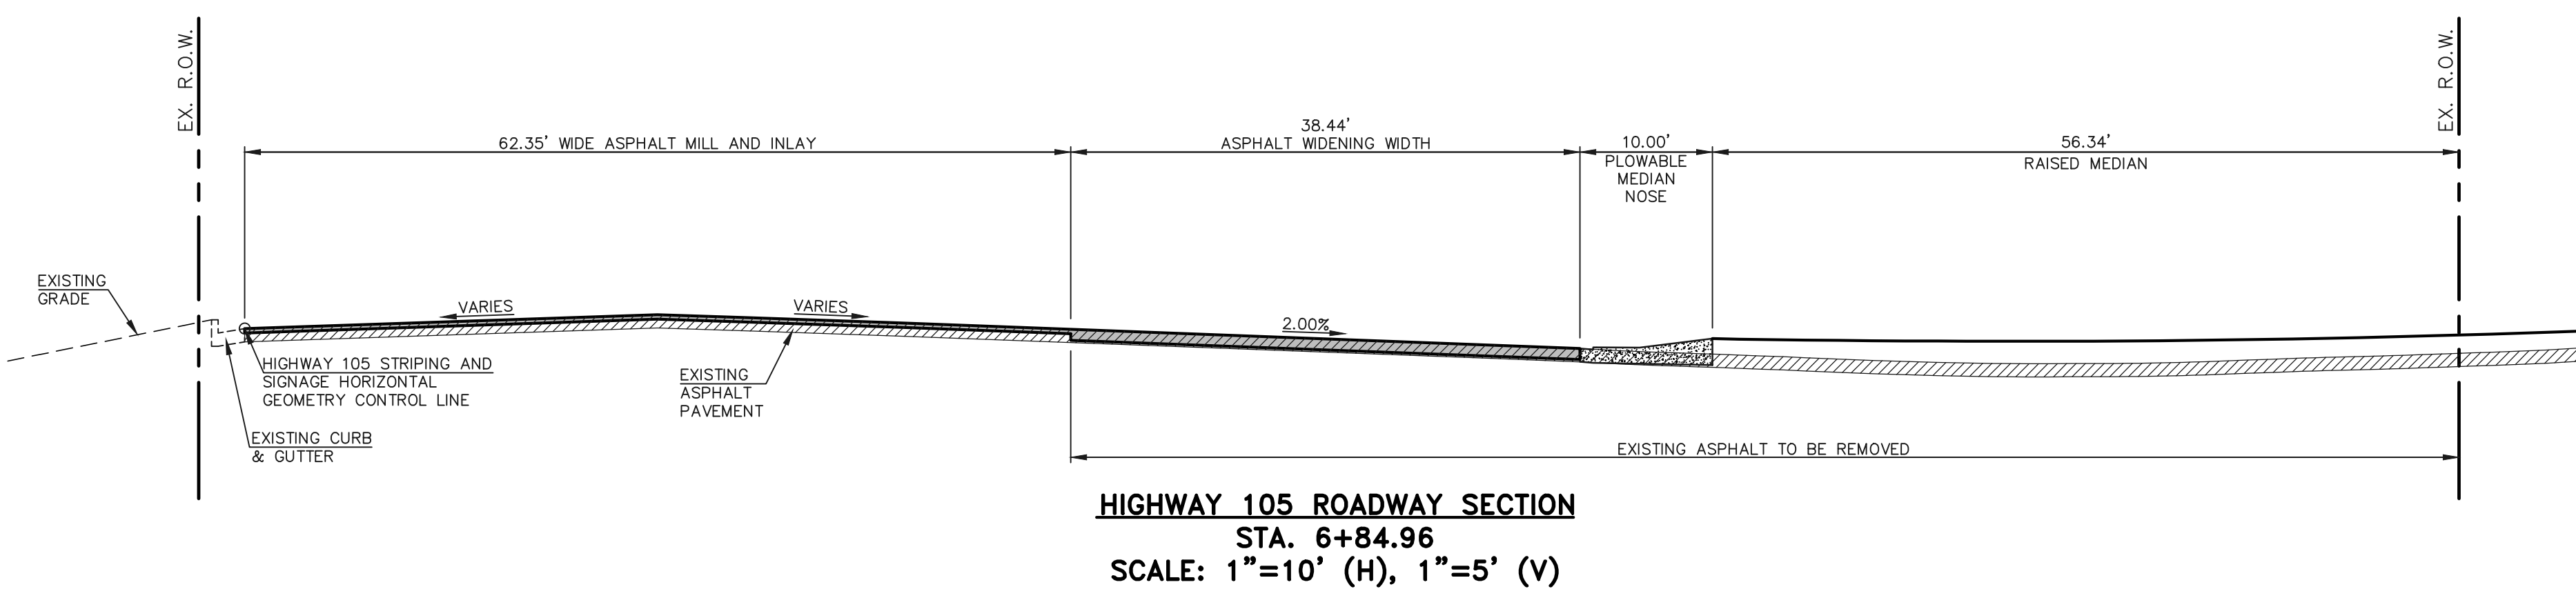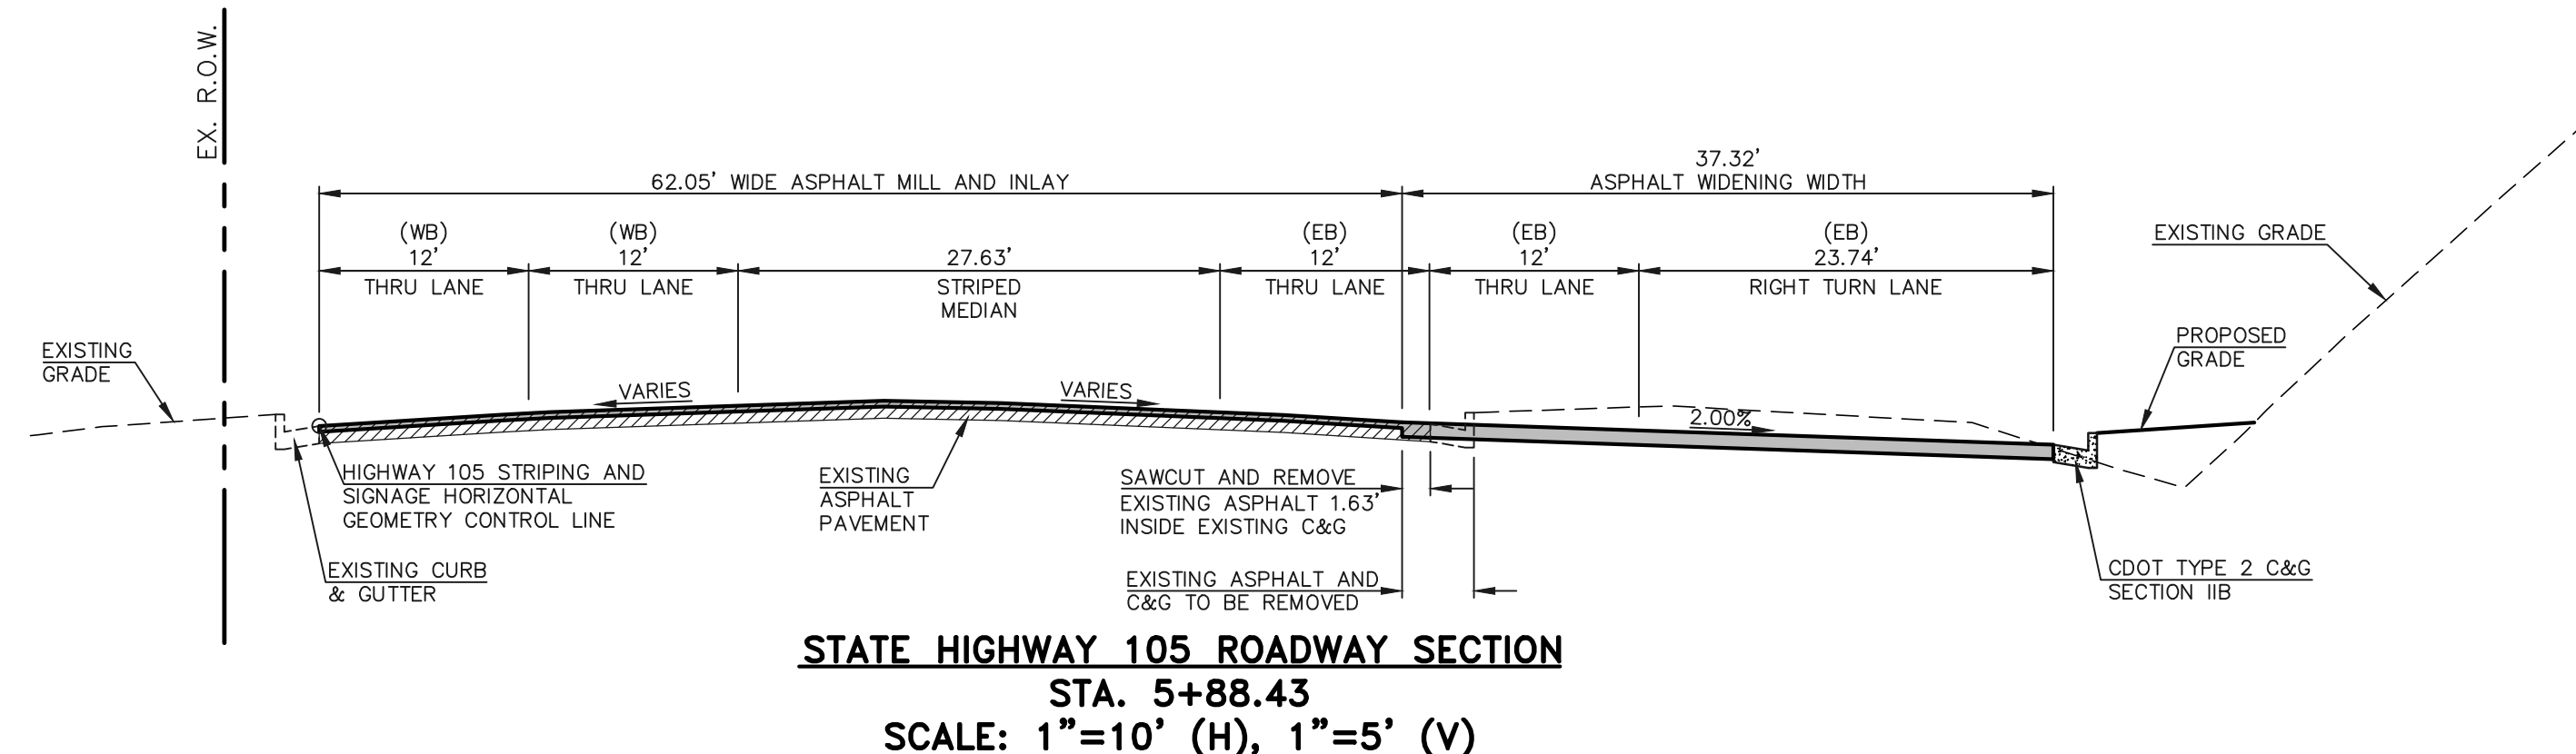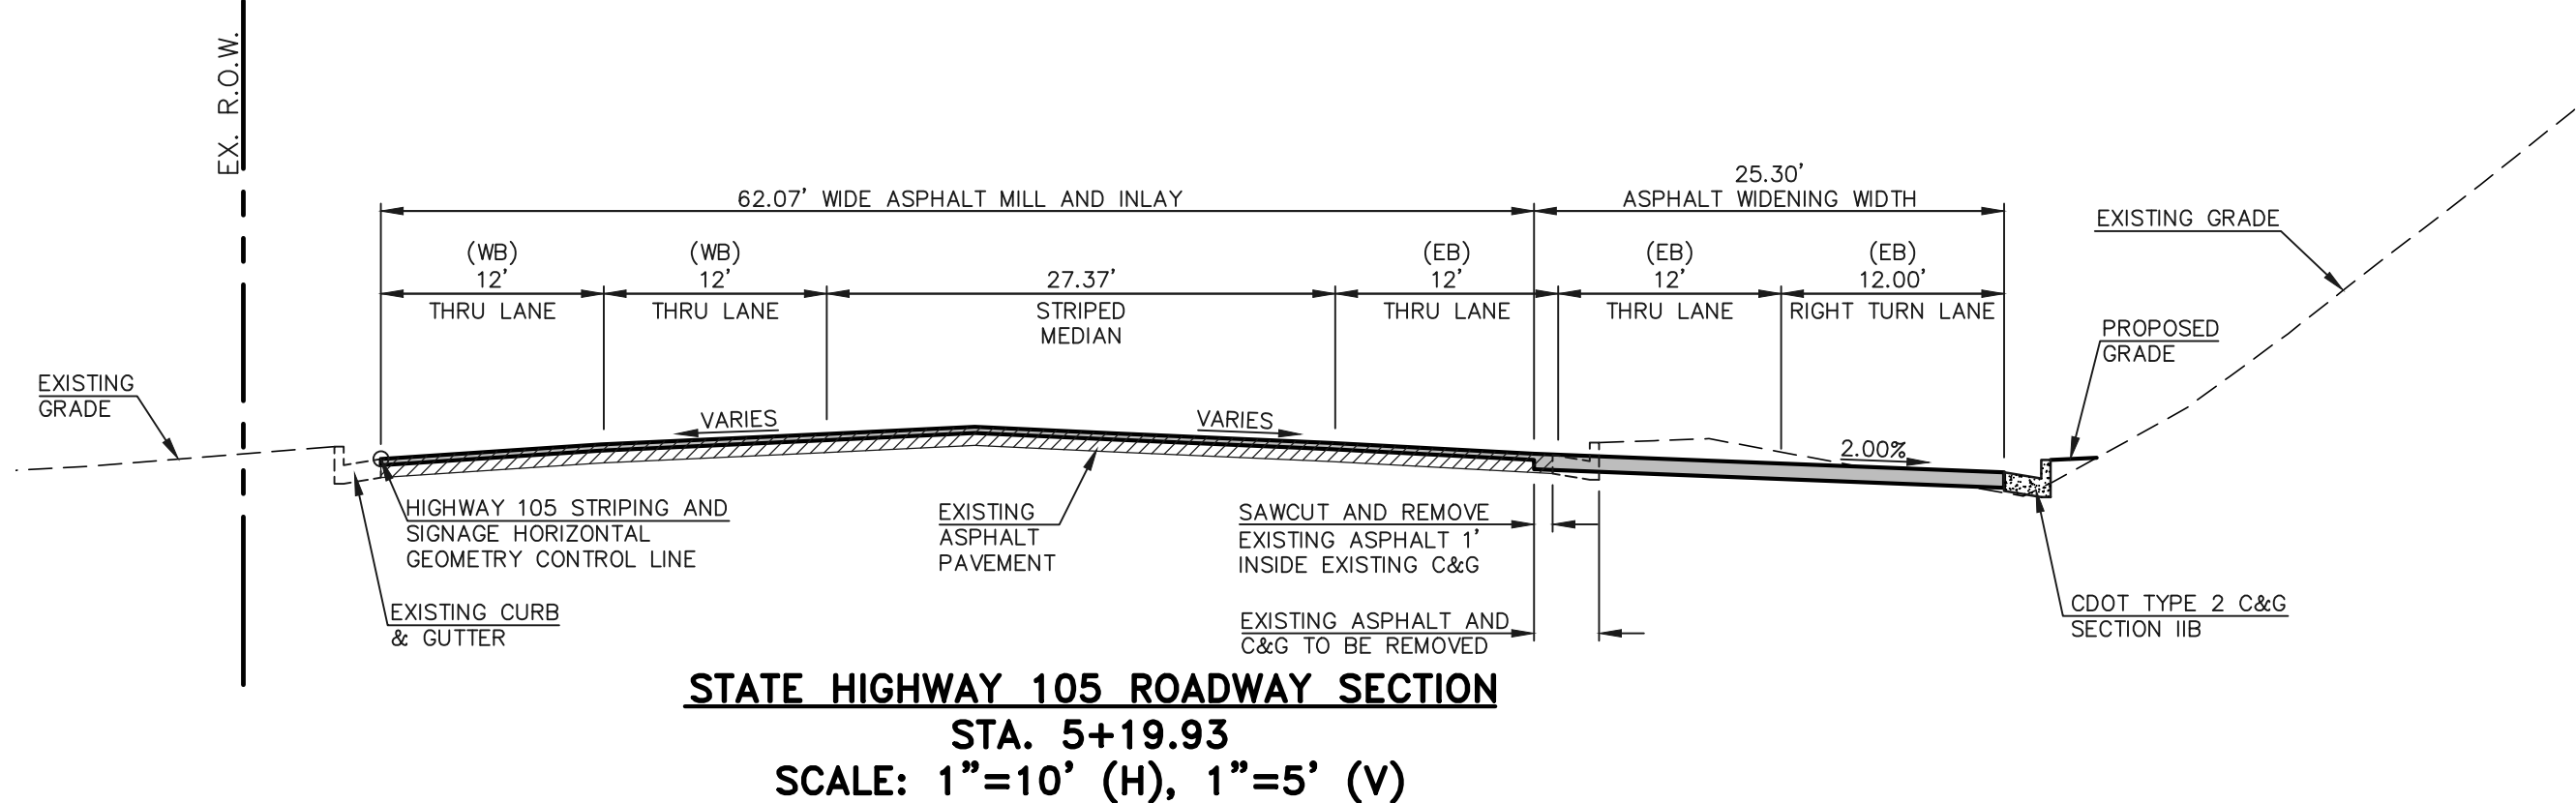

HOT MIX ASPHALT PAVEMENT STRUCTURE TABLE

TOTAL HOT MIX ASPHALT DEPTH	5.0"
# OF LIFTS	2
HOT MIX ASPHALT BINDER COURSE GRAD-S(75) (PG 64-22)	LIFT 1 3.0"
HOT MIX ASPHALT SURFACE COURSE GRAD-SX(75) (PG 64-28)	LIFT 2 2.0"

TYPICAL HOT MIX ASPHALT PAVEMENT LIFT SECTION

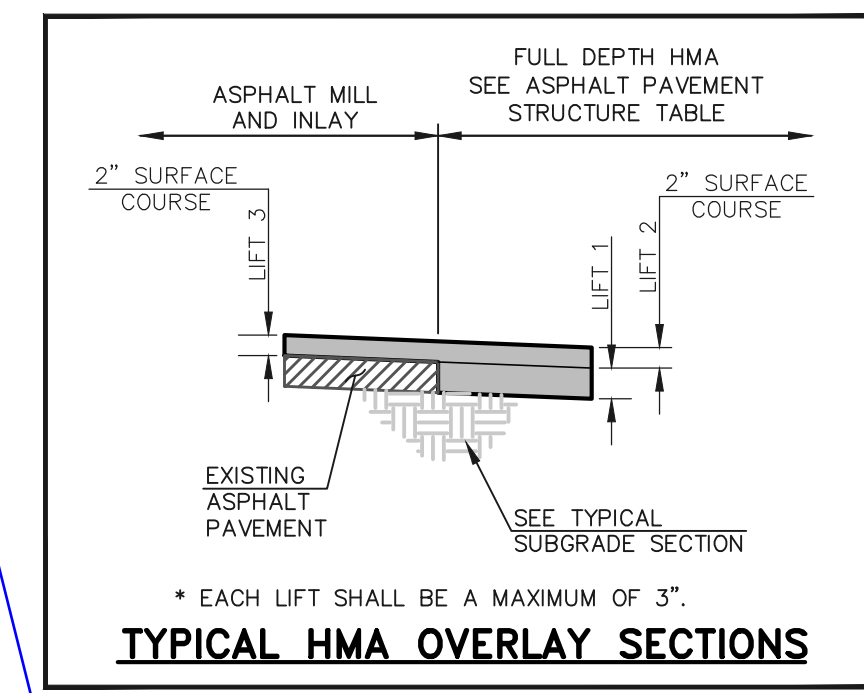

SUBGRADE NOTES:

SUBGRADE FOR CUT CONDITIONS:
 IF SUBGRADE IS R >= 17, THEN PERFORM CEMENT TREATED SUBGRADE ON TOP 12 INCHES.



SUBGRADE FOR FILL CONDITIONS:
 IF SUBGRADE IS R < 17, THEN OVER EXCAVATE 24 INCHES AND REPLACE WITH R >= 17 MATERIAL AND PERFORM CEMENT TREATED SUBGRADE ON TOP 12 INCHES. [RECONDITIONING IS SPECIFIED IN SECTION 306 OF THE CDOT STANDARD SPECIFICATIONS].

ALL FILL SHALL BE R >= 17 MATERIAL WITH 12 INCHES OF CEMENT TREATED SUBGRADE ON TOP OF FILL MATERIAL.

TYPICAL PAVEMENT SECTION

1. REFERENCE PAVEMENT RECOMMENDATIONS JACKSON CREEK PARKWAY AND U.S. STATE HIGHWAY 105 - GEOTECHNICAL RECOMMENDATION REPORT BY ENTECH ENGINEERING, INC. "ENTECH JOB NO.: 230008" DATED FEBRUARY 20, 2023 FOR INFORMATION ON SUBGRADE PREPARATION

Pavement section detail calls for 6" of asphalt but pavement section lift detail only adds up to 5". Please revise so details show same information.

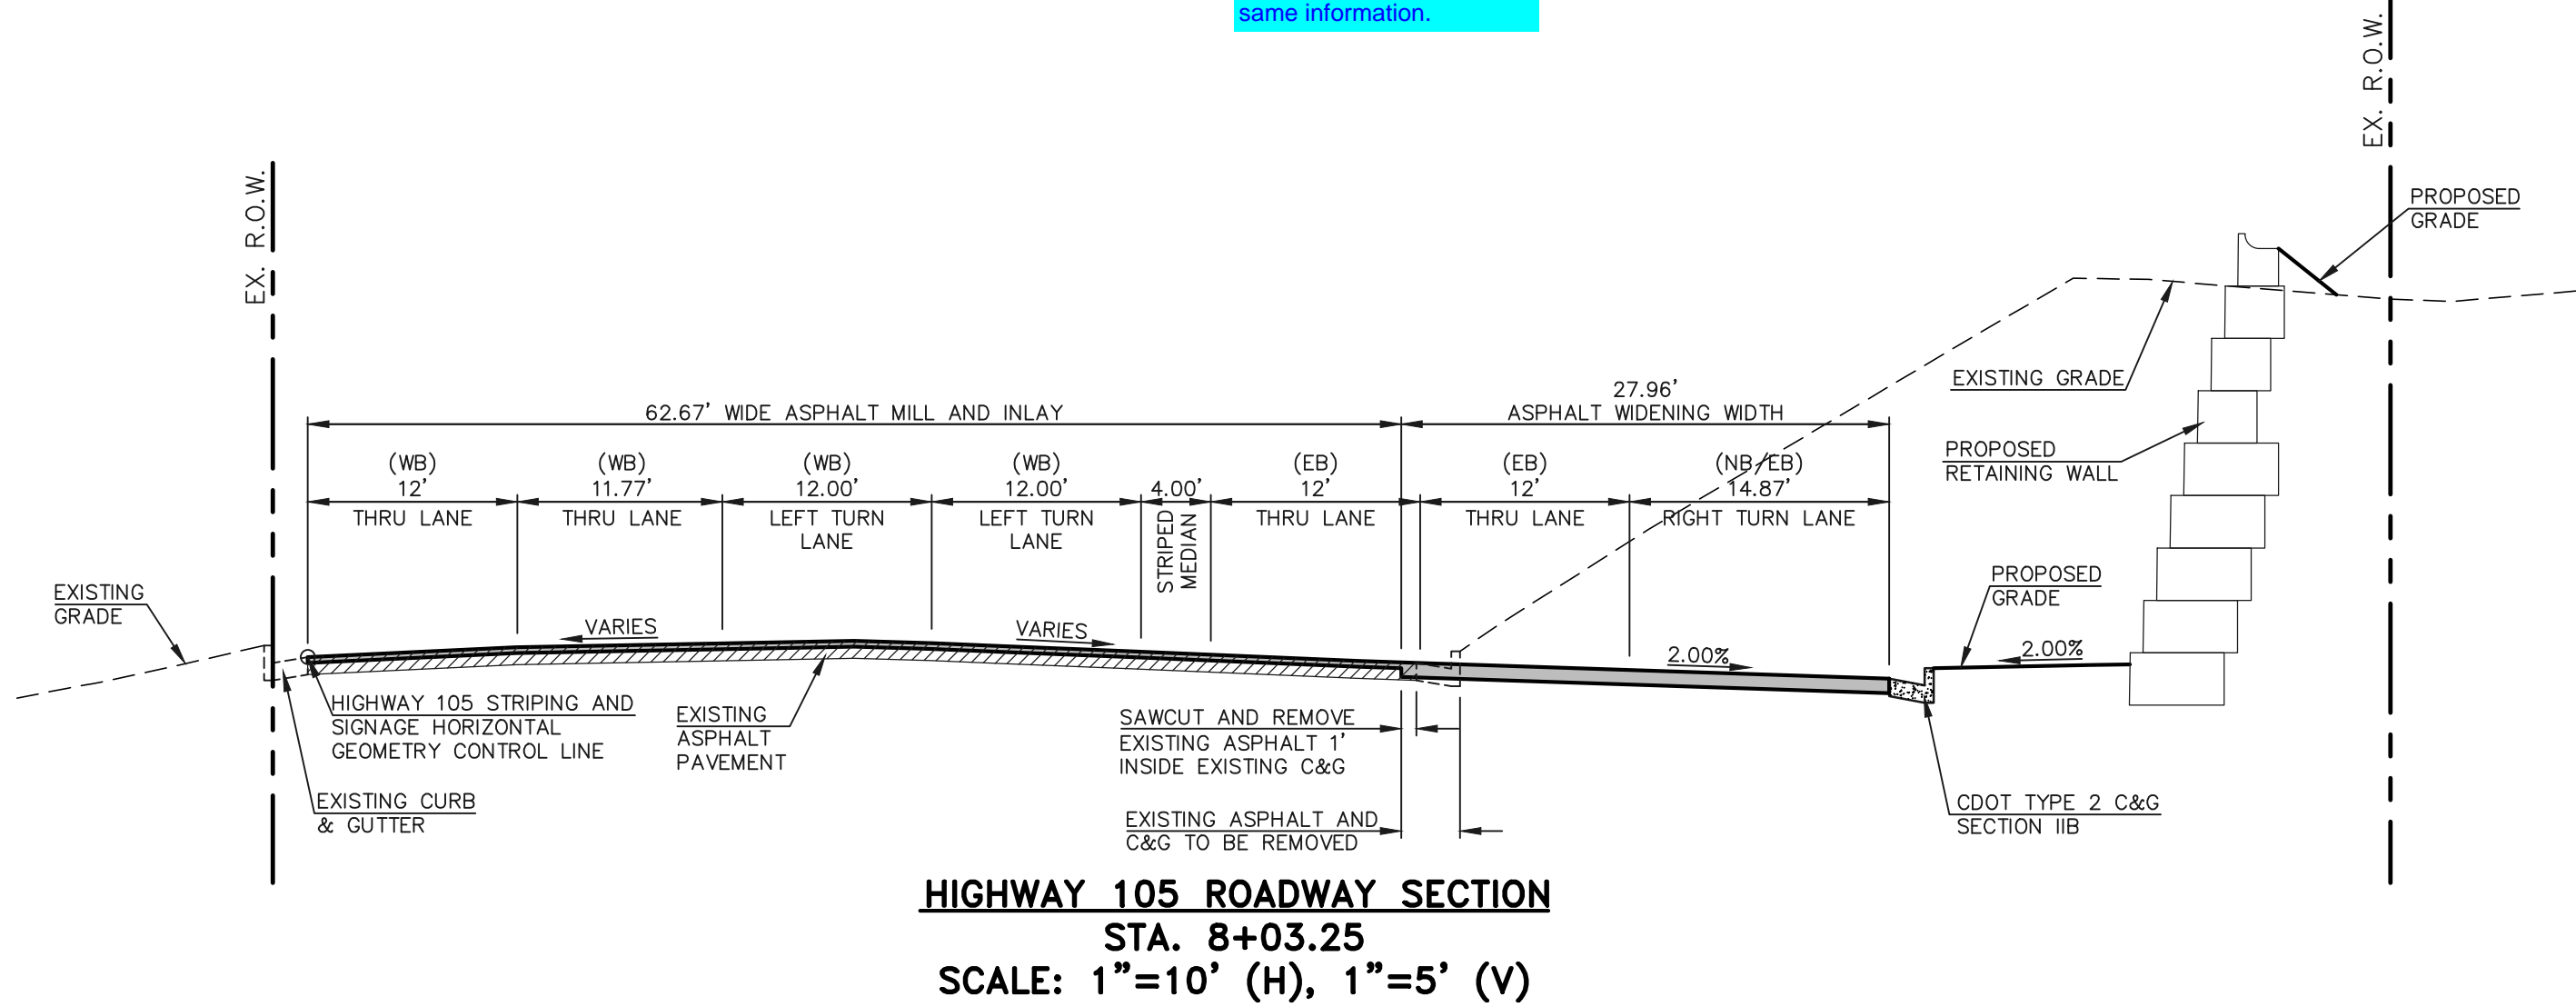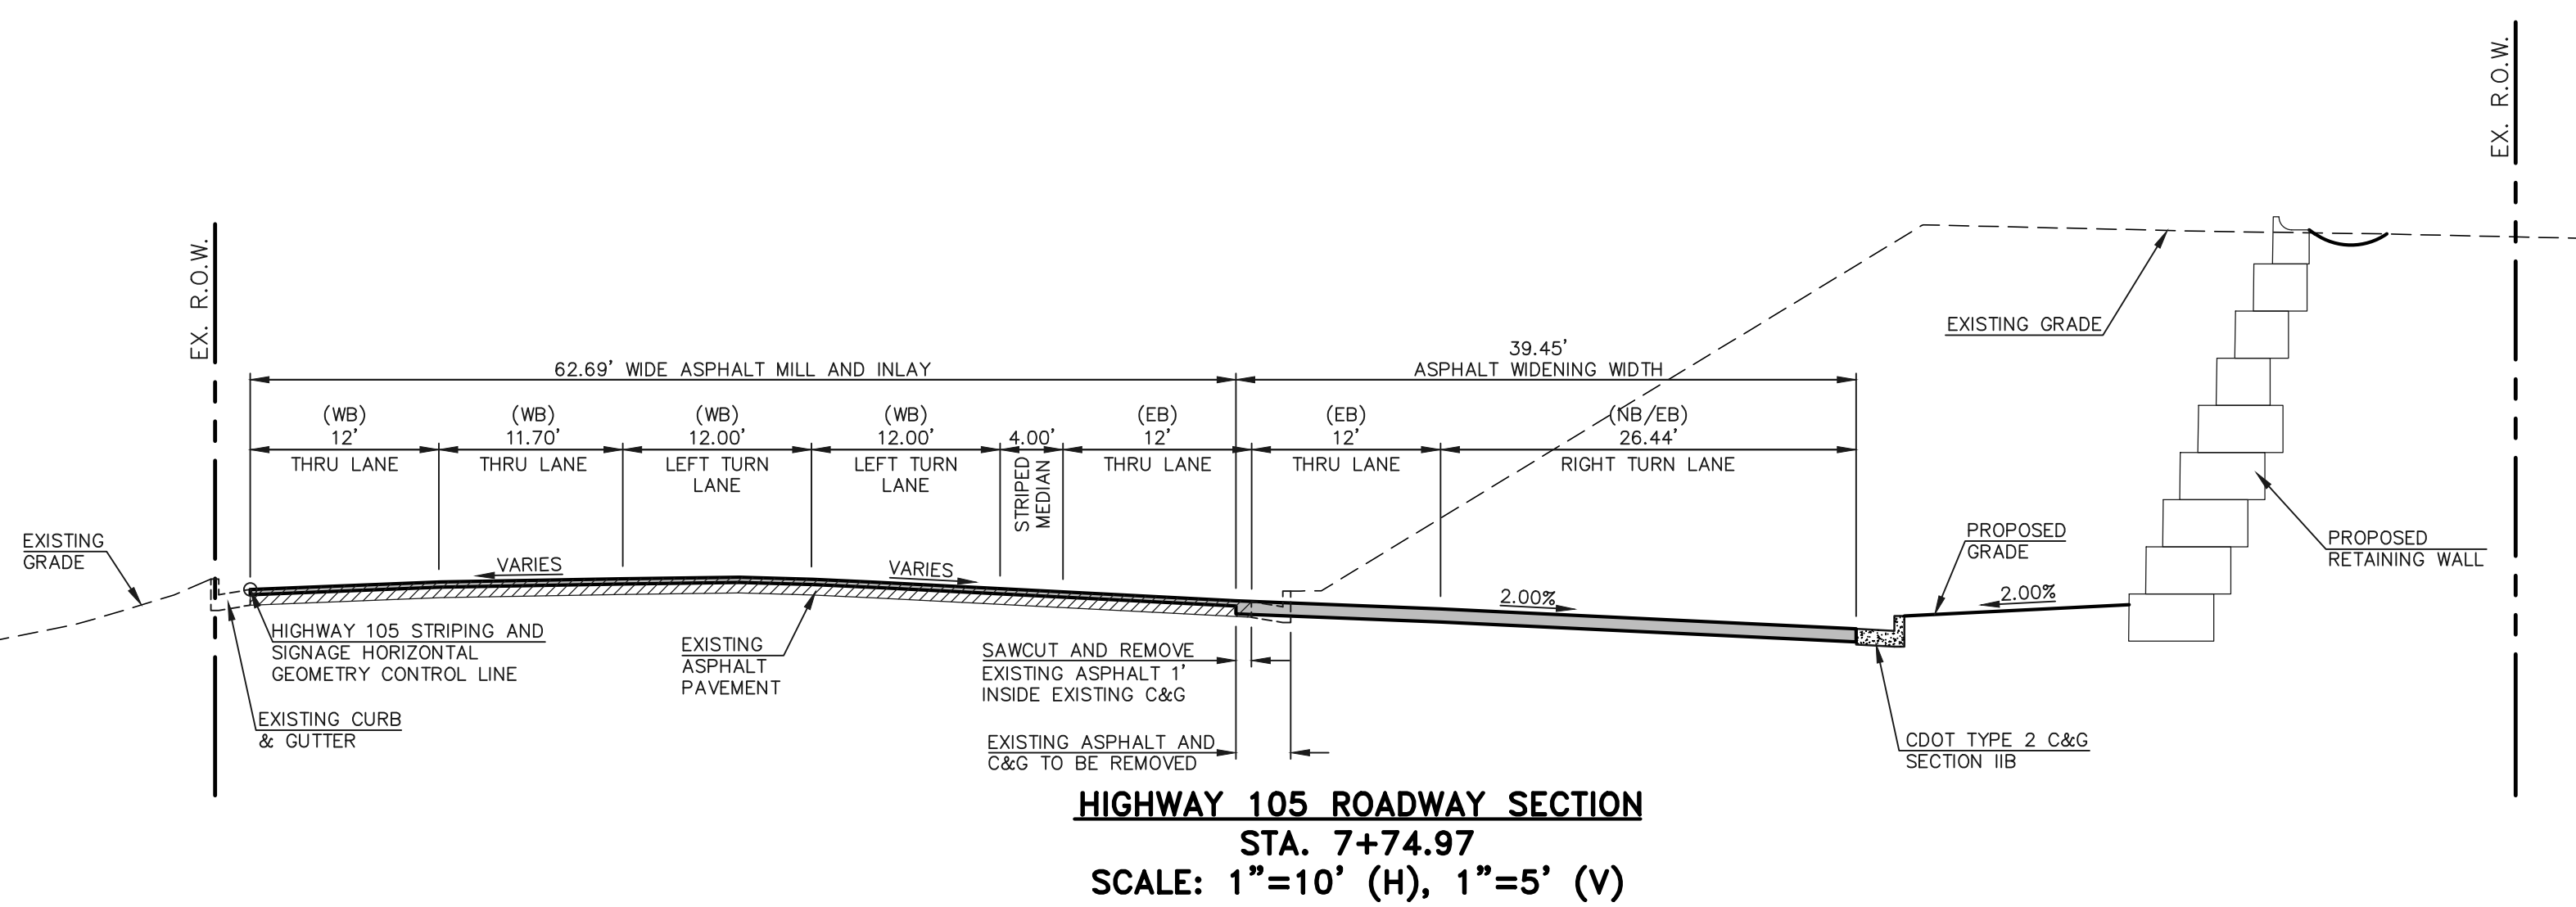

- HIGHWAY 105 TYPICAL SECTION NOTES**
- BREAK POINTS IN SLOPES SHALL BE ROUNDED BY THE CONTRACTOR FOR A PLEASING APPEARANCE DURING CONSTRUCTION.
 - SEE HIGHWAY 105 IMPROVEMENT PLANS (SHEETS 9, 10 AND 17) FOR ADDITIONAL INFORMATION ON THE ROADWAY SECTION DIMENSIONS.
 - A TWO-INCH OVERLAY OF THE ROADWAY IN AREAS OF RECONSTRUCTION AND/OR RE-STRIPING IS REQUIRED. THE WIDTH OF THE OVERLAY SHALL ENCOMPASS ALL LANES CONTIGUOUS TO AREAS OF RECONSTRUCTION AND/OR RE-STRIPING.
 - SEE PAVEMENT RECOMMENDATIONS JACKSON CREEK PARKWAY AND U.S. STATE HIGHWAY 105 - GEOTECHNICAL RECOMMENDATION REPORT BY ENTECH ENGINEERING, INC. "ENTECH JOB NO.: 230008" DATED FEBRUARY 20, 2023 FOR INFORMATION ON SUBGRADE PREPARATION.
 - THE CONTRACTOR SHALL VERIFY ALL SUBGRADE CONDITIONS IN CUT AREAS PRIOR TO PREPARATION AND PAVING.
 - FOR FILL CONDITIONS, THE CONTRACTOR SHALL VERIFY SUBGRADE CONDITIONS THROUGH COMPACTION AND DENSITY TESTING PRIOR TO PAVING.
 - SMOOTHNESS CATEGORY SHALL BE CATEGORY 2.

FIX PAGE NUMBERS

48 HOURS BEFORE YOU DIG,
 CALL UTILITY LOCATORS
811
 UTILITY NOTIFICATION CENTER OF COLORADO
 IT'S THE LAW

THE LOCATIONS OF EXISTING UNDERGROUND UTILITIES ARE SHOWN IN AN APPROXIMATE WAY ONLY. THE CONTRACTOR SHALL DETERMINE THE EXACT LOCATION OF ALL EXISTING UTILITIES BEFORE COMMENCING WORK. THE CONTRACTOR SHALL BE FULLY RESPONSIBLE FOR ANY AND ALL DAMAGES WHICH MIGHT BE CAUSED BY HIS FAILURE TO EXACTLY LOCATE AND PRESERVE ANY AND ALL UNDERGROUND UTILITIES.

NO.	REVISION	DATE
1	ADDED SECTION SHEET PER CDOT COMMENTS	7/10/23

REVIEW:

PREPARED UNDER MY DIRECT SUPERVISION FOR AND ON BEHALF OF CLASSIC CONSULTING ENGINEERS AND SURVEYORS, LLC

MARC A. WHORTON, COLORADO P.E. #37155 DATE




STATE HIGHWAY 105 / JACKSON CREEK PKWY. - PHASE 2 CONSTRUCTION PLANS


ROADWAY IMPROVEMENT PLANS
 HIGHWAY 105 ROADWAY SECTIONS

DESIGNED BY	PRA	SCALE	DATE	02-23-23
DRAWN BY	PRA	(H) 1"= 50'	SHEET	9 OF 26
CHECKED BY		(V) 1"= N/A	JOB NO.	1302.22


N:\130222\DRAWINGS\CONSTRUCTION\105-ROADWAY-SEC2.dwg, 7/11/2023, 12:47:18 PM, enrogon, 1:1

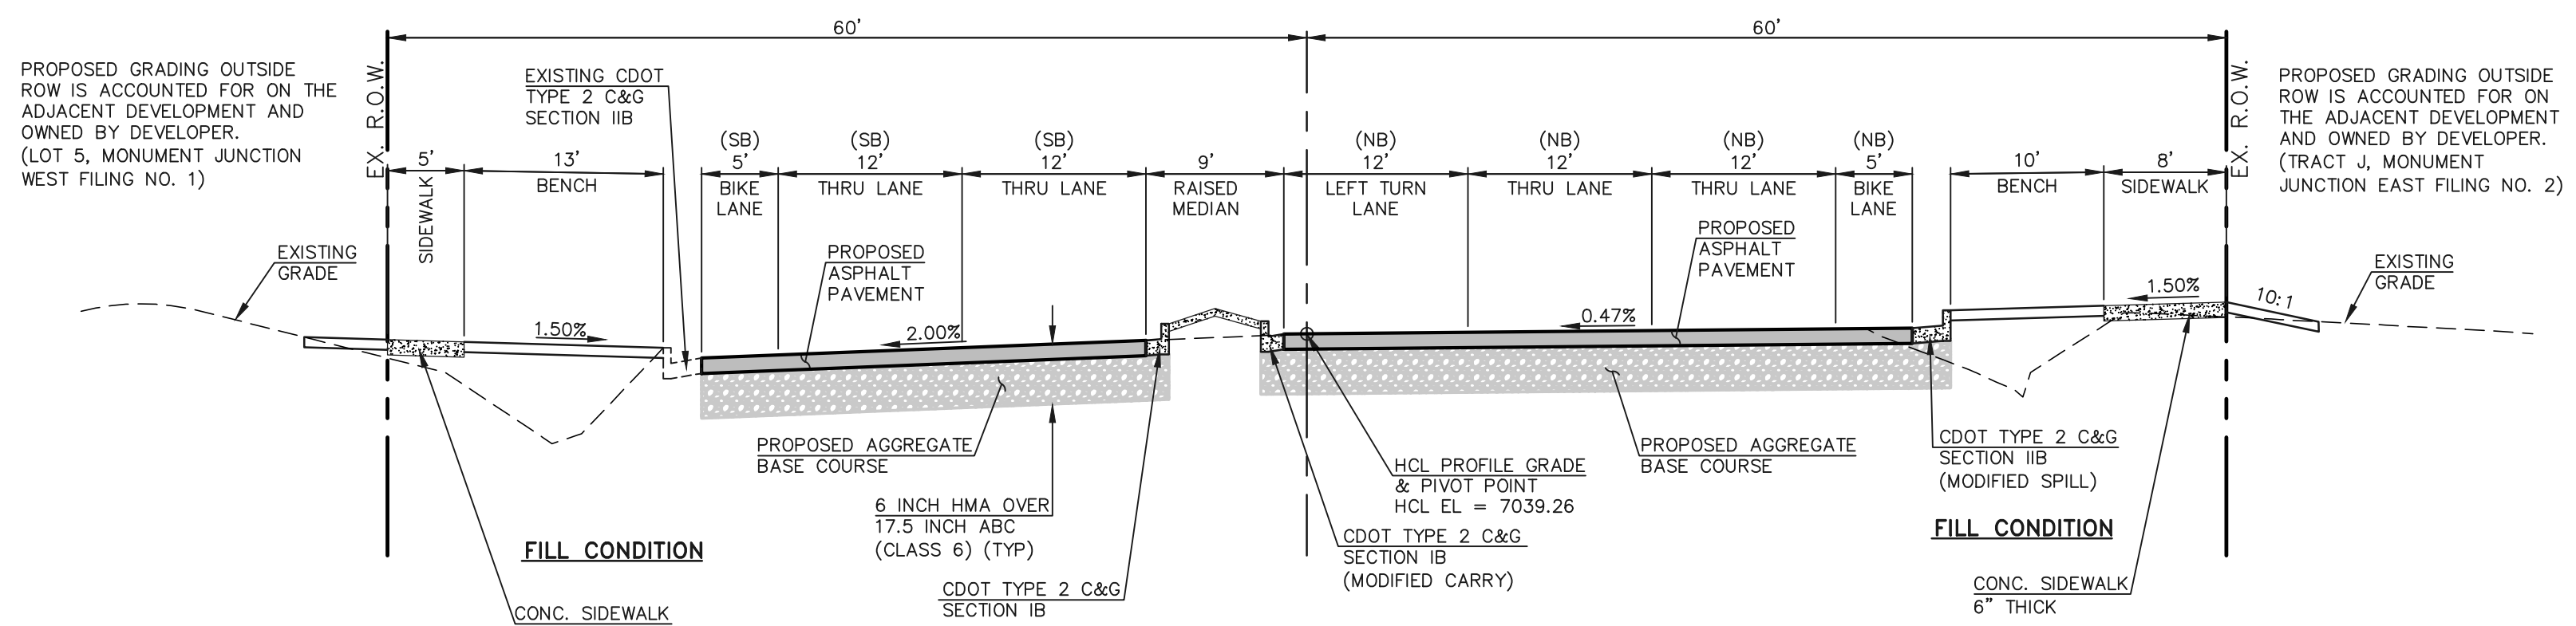


JACKSON CREEK PARKWAY SECTION
STA. 18+73.48
SCALE: 1"=10' (H), 1"=5' (V)

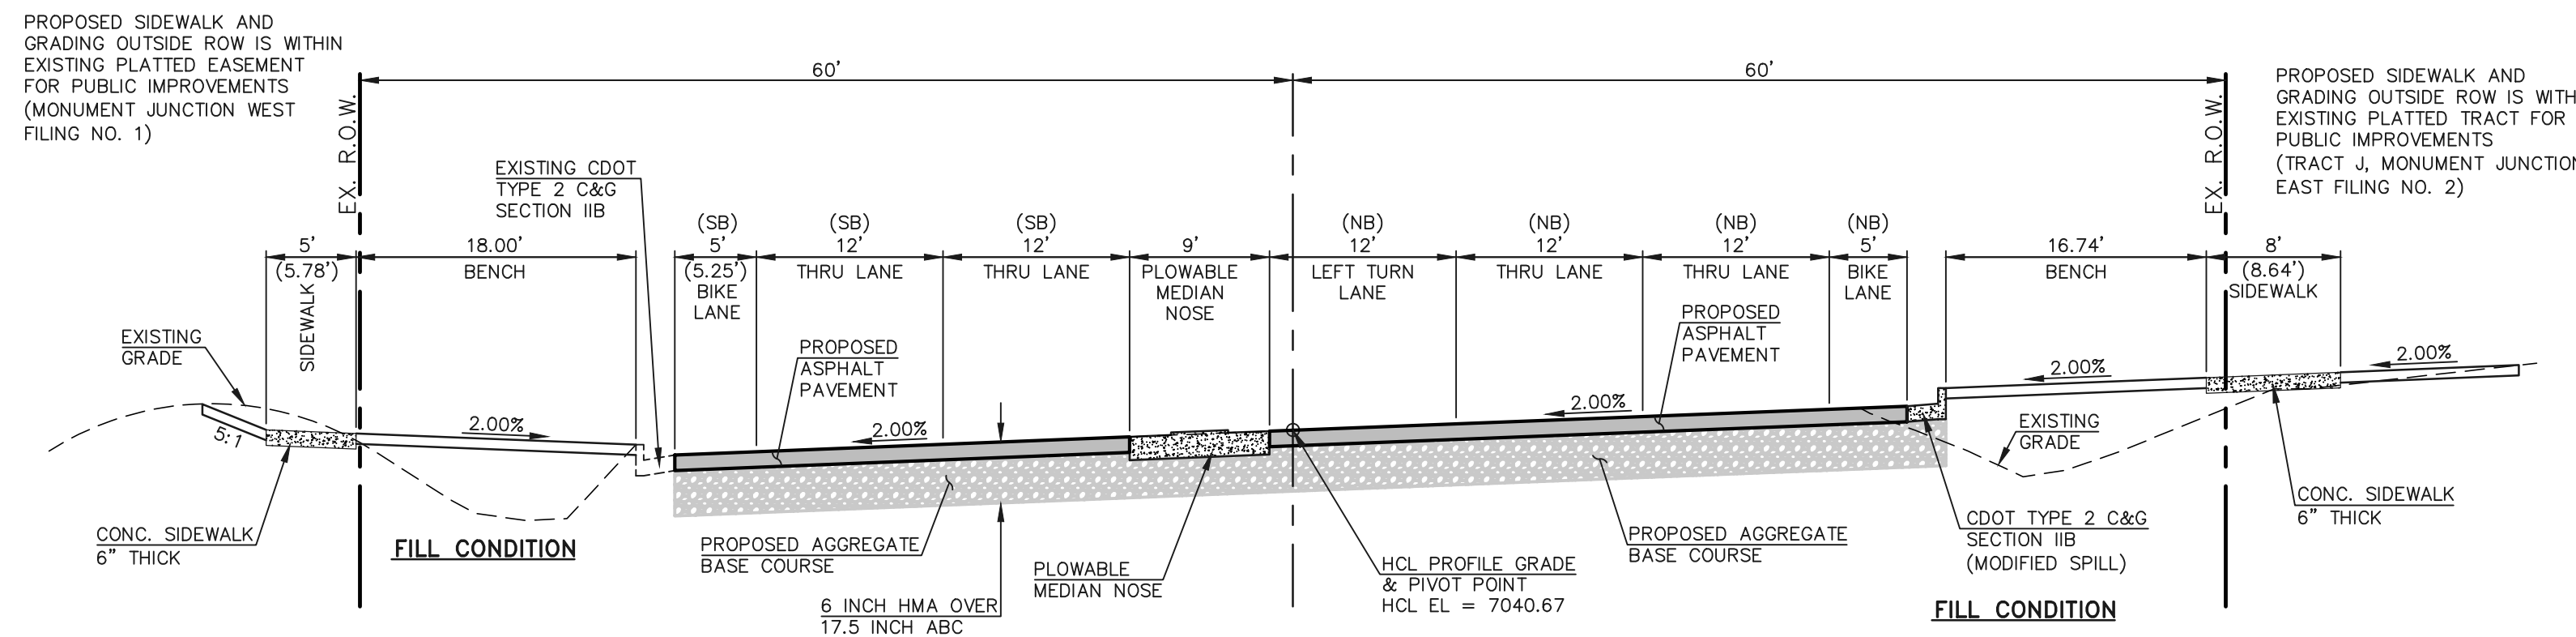


JACKSON CREEK PARKWAY SECTION
STA. 19+22.22
SCALE: 1"=10' (H), 1"=5' (V)

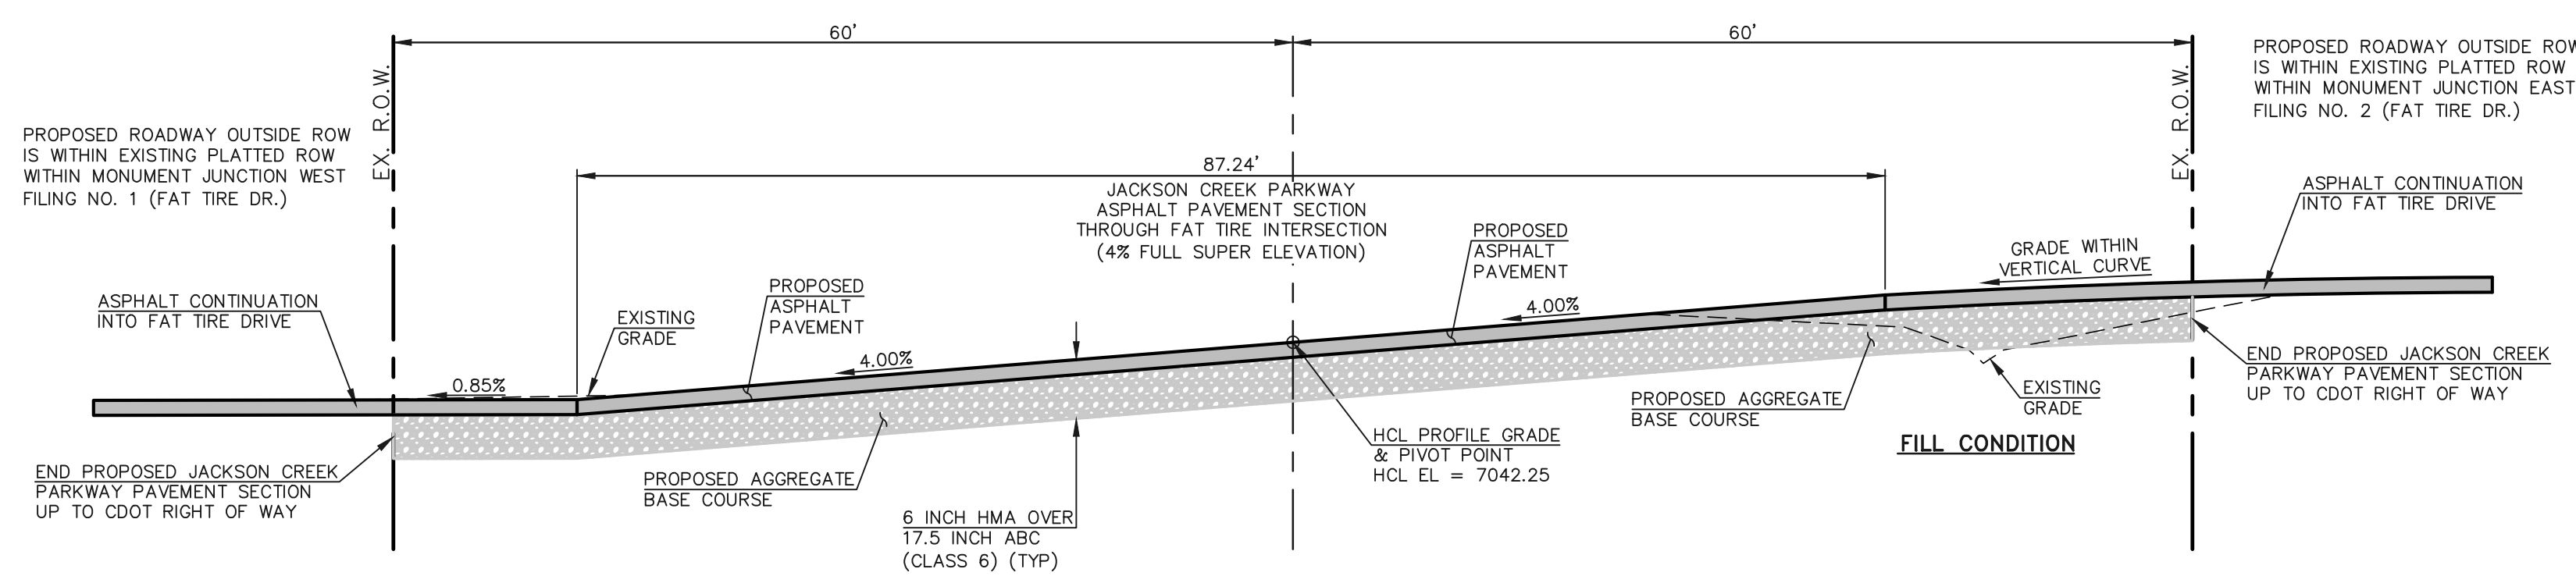

JACKSON CREEK PARKWAY SECTION
STA. 19+84.20
SCALE: 1"=10' (H), 1"=5' (V)

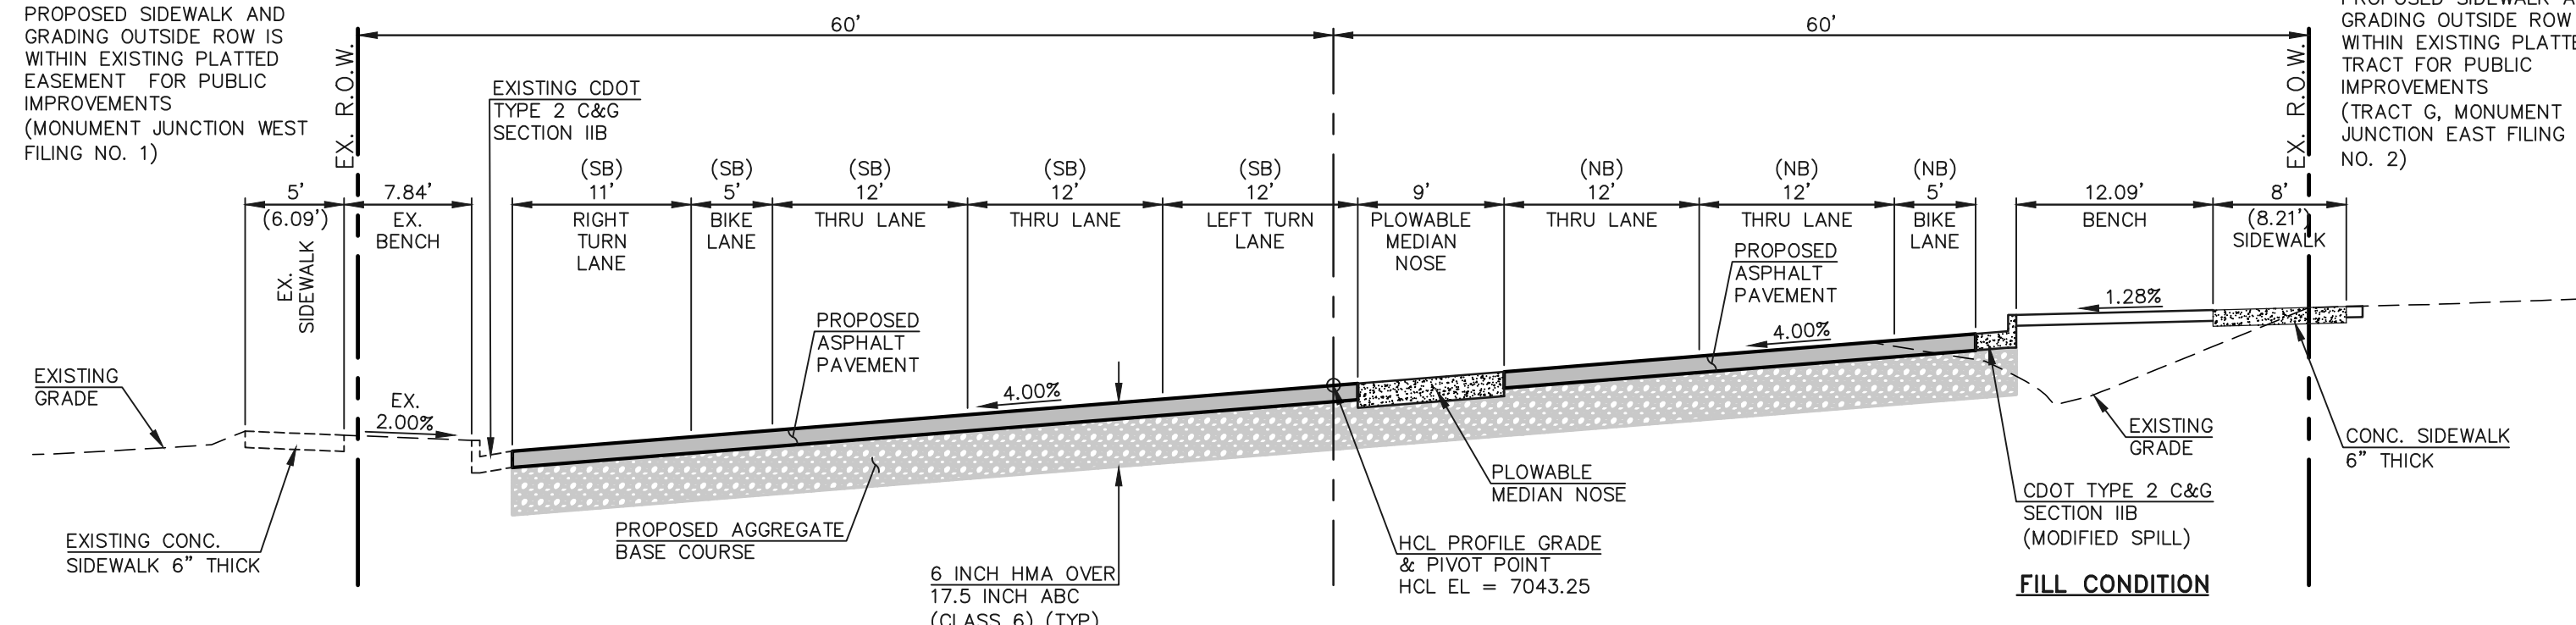

JACKSON CREEK PARKWAY SECTION
STA. 20+34.01
SCALE: 1"=10' (H), 1"=5' (V)

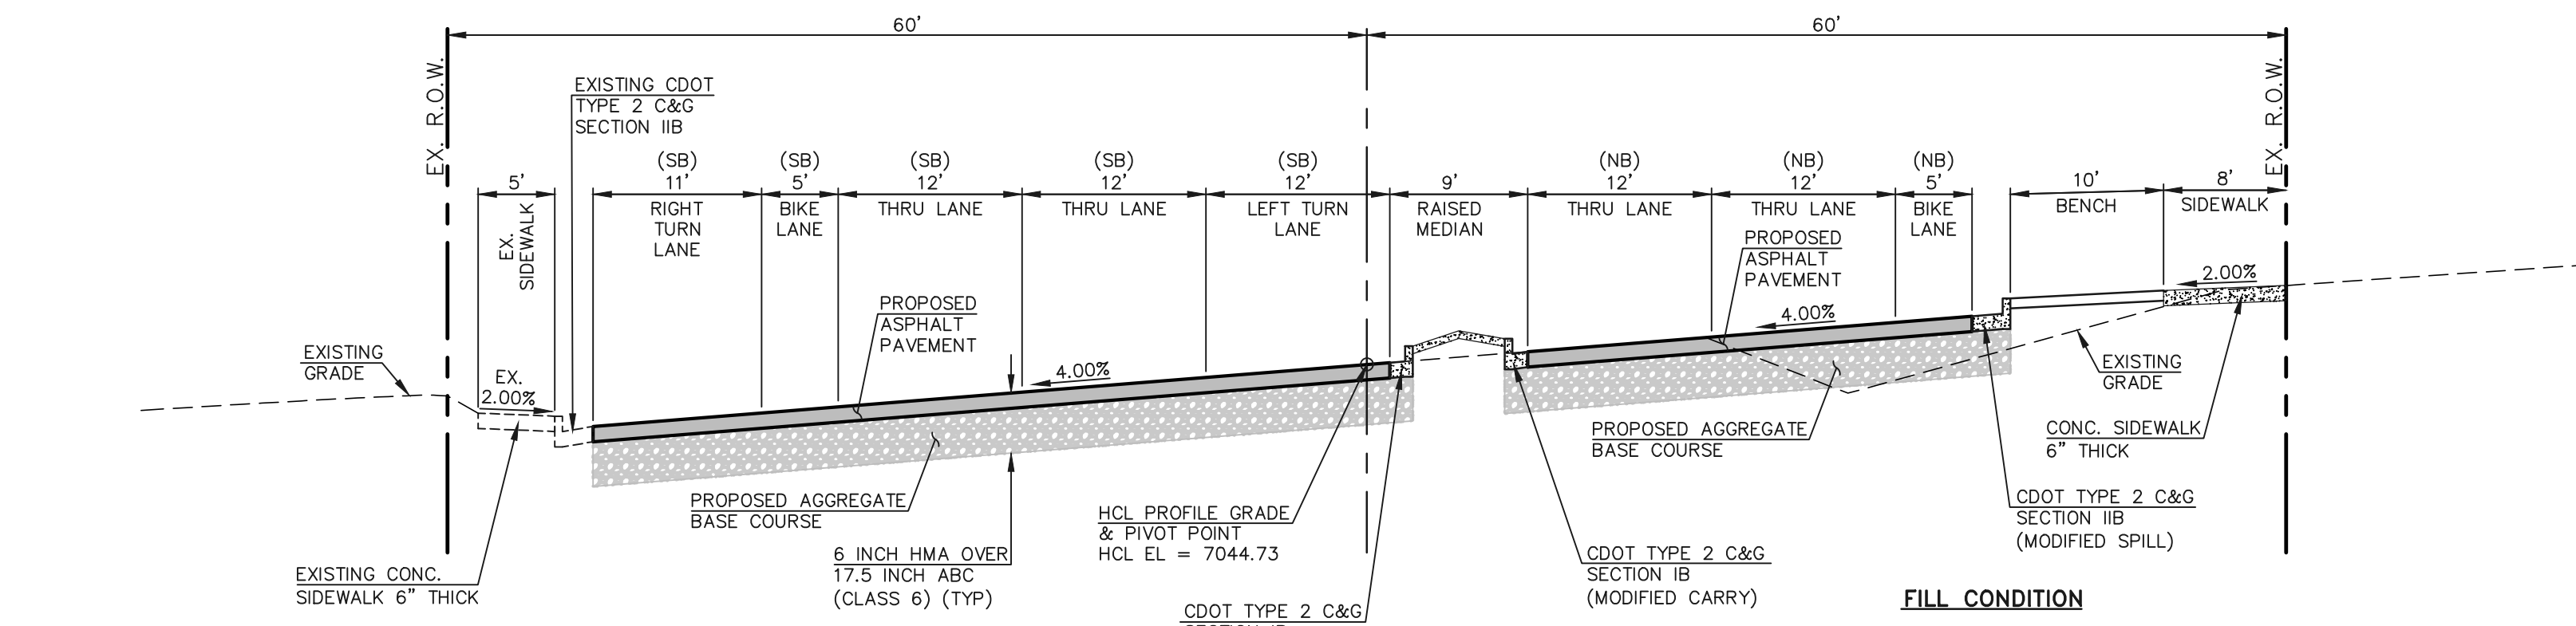

JACKSON CREEK PARKWAY SECTION
STA. 22+63.43
SCALE: 1"=10' (H), 1"=5' (V)


TYPICAL SECTION NOTES

- BREAK POINTS IN SLOPES SHALL BE ROUNDED BY THE CONTRACTOR FOR A PLEASING APPEARANCE DURING CONSTRUCTION.
- SEE JACKSON CREEK PARKWAY IMPROVEMENT PLANS (SHEETS 12, 13 AND 17) FOR ADDITIONAL INFORMATION ON THE ROADWAY SECTION DIMENSIONS.
- A TWO-INCH OVERLAY OF THE ROADWAY IN AREAS OF RECONSTRUCTION AND/OR RE-STRIPING IS REQUIRED. THE WIDTH OF THE OVERLAY SHALL ENCOMPASS ALL LANES CONTIGUOUS TO AREAS OF RECONSTRUCTION AND/OR RE-STRIPING.
- SEE PROPOSED JACKSON CREEK PARKWAY WIDENING, HIGHWAY 105 TO HIGBY ROAD - GEOTECHNICAL EVALUATION REPORT (DRAFT) BY VIVID ENGINEERING GROUP "VIVID PROJECT NO.: D21-2-456" DATED 2-18-2022 FOR INFORMATION ON SUBGRADE PREPARATION.
- THE CONTRACTOR SHALL VERIFY ALL SUBGRADE CONDITIONS IN CUT AREAS PRIOR TO PREPARATION AND PAVING.
- FOR FILL CONDITIONS, THE CONTRACTOR SHALL VERIFY SUBGRADE CONDITIONS THROUGH COMPACTION AND DENSITY TESTING PRIOR TO PAVING.
- SMOOTHNESS CATEGORY SHALL BE CATEGORY 2.


HOT MIX ASPHALT PAVEMENT STRUCTURE TABLE

TOTAL HOT MIX ASPHALT DEPTH		6.0"
# OF LIFTS		3
HOT MIX ASPHALT BINDER COURSE	LIFT 1	2.0"
GRAD-S(75) (PG 64-22)	LIFT 2	2.0"
HOT MIX ASPHALT SURFACE COURSE	LIFT 3	2.0"
GRAD-SX(75) (PG 64-28)		

Asphalt lift is different than previous sheets. Please revise to same detail or clearly state where different lift sections are happening within plan.

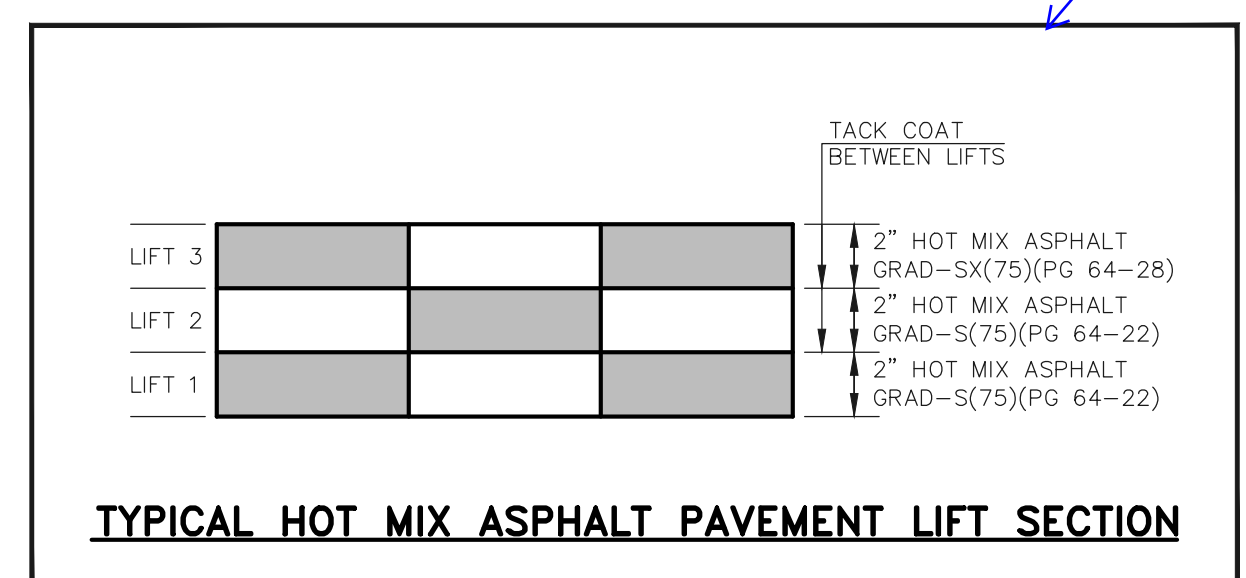

TYPICAL HOT MIX ASPHALT PAVEMENT LIFT SECTION

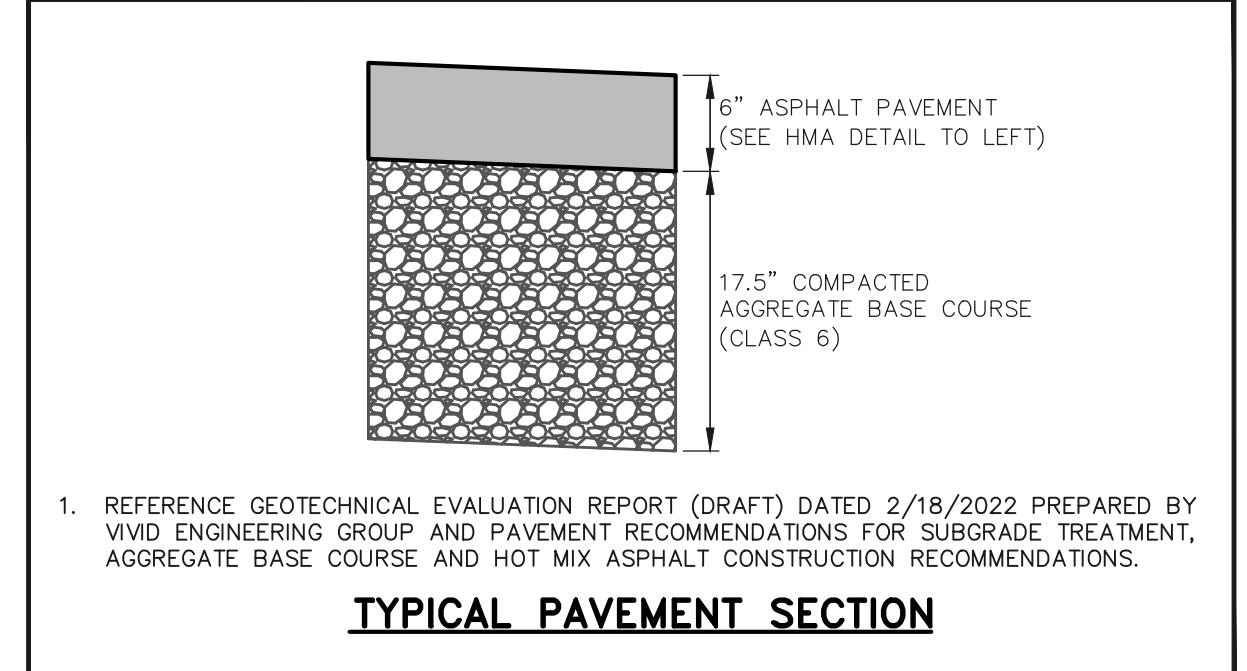

1. REFERENCE GEOTECHNICAL EVALUATION REPORT (DRAFT) DATED 2/18/2022 PREPARED BY VIVID ENGINEERING GROUP AND PAVEMENT RECOMMENDATIONS FOR SUBGRADE TREATMENT, AGGREGATE BASE COURSE AND HOT MIX ASPHALT CONSTRUCTION RECOMMENDATIONS.

TYPICAL PAVEMENT SECTION

48 HOURS BEFORE YOU DIG,
 CALL UTILITY LOCATORS
811
 UTILITY NOTIFICATION CENTER OF COLORADO
 IT'S THE LAW

THE LOCATIONS OF EXISTING UNDERGROUND UTILITIES ARE SHOWN IN AN APPROXIMATE WAY ONLY. THE CONTRACTOR SHALL DETERMINE THE EXACT LOCATION OF ALL EXISTING UTILITIES BEFORE COMMENCING WORK. THE CONTRACTOR SHALL BE FULLY RESPONSIBLE FOR ANY AND ALL DAMAGES WHICH MIGHT BE CAUSED BY HIS FAILURE TO EXACTLY LOCATE AND PRESERVE ANY AND ALL UNDERGROUND UTILITIES.

NO.	REVISION	DATE
1	REVISED PER JACOBS COMMENTS	5/17/23

REVIEW:
 PREPARED UNDER MY DIRECT SUPERVISION FOR AND ON BEHALF OF CLASSIC CONSULTING ENGINEERS AND SURVEYORS, LLC


MARC A. WHORTON, COLORADO P.E. #37155 DATE




STATE HIGHWAY 105 / JACKSON CREEK PKWY. - PHASE 2 CONSTRUCTION PLANS
 ROADWAY IMPROVEMENT PLANS
 JACKSON CREEK PKWY. ROADWAY SECTIONS

DESIGNED BY PRA SCALE DATE 02-23-23
 DRAWN BY PRA (H) 1"= 50' SHEET 10 OF 26
 CHECKED BY (V) 1"= N/A JOB NO. 1302.22




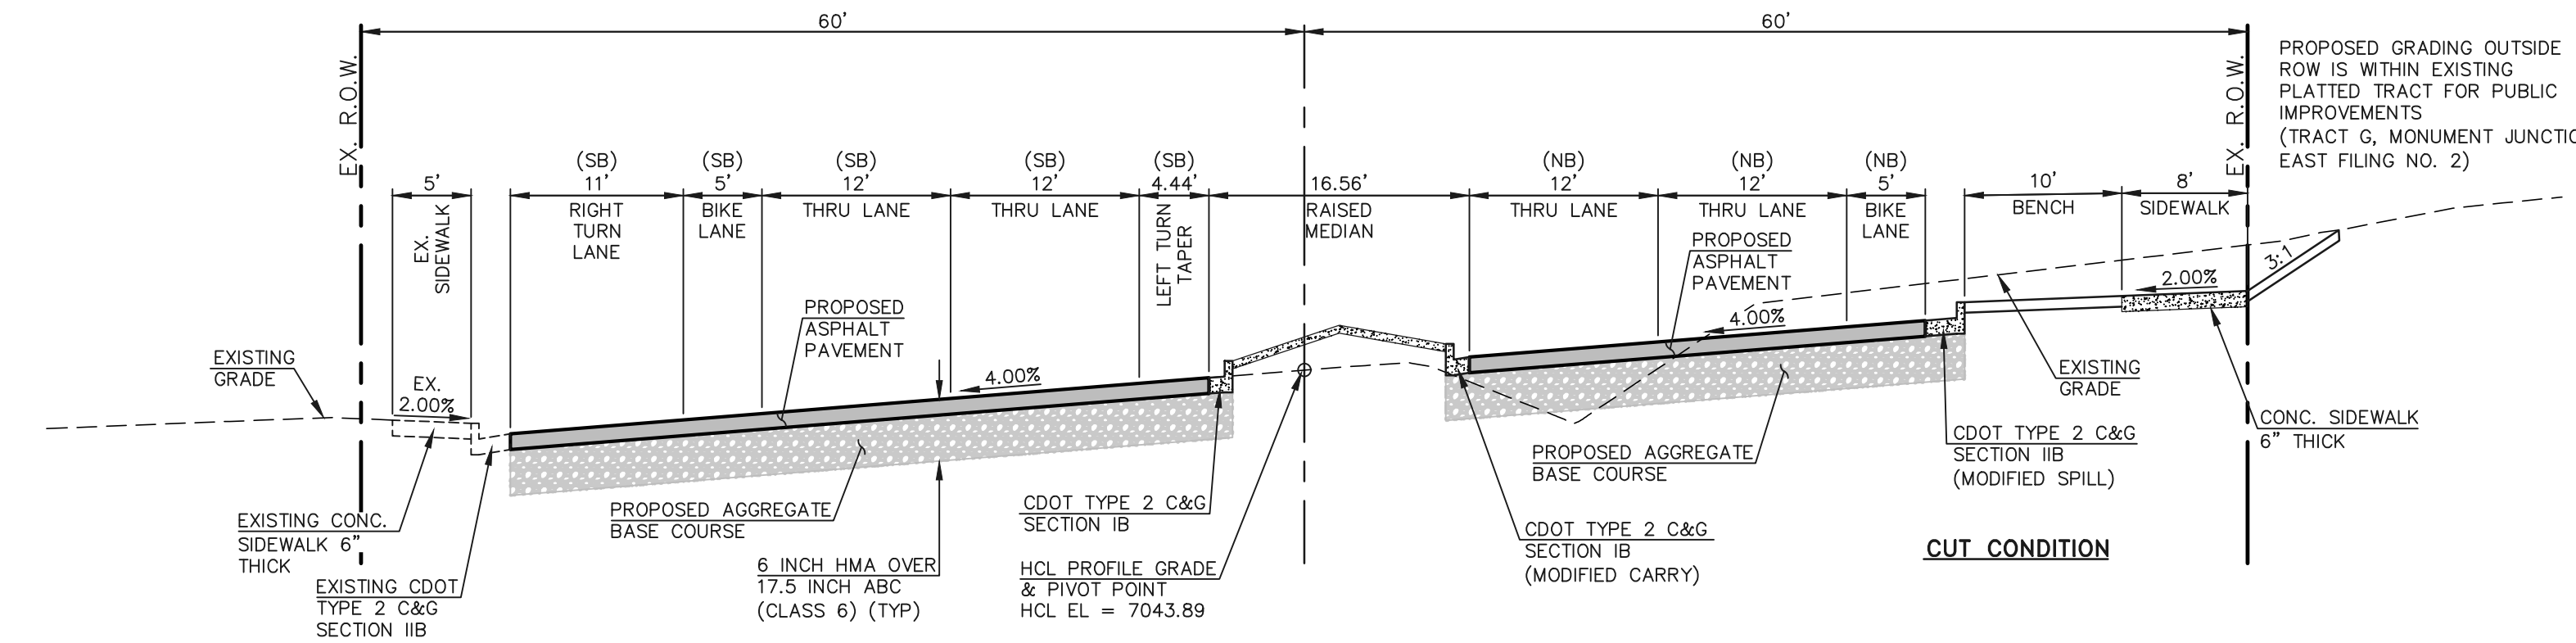


JACKSON CREEK PARKWAY SECTION
STA. 23+55.45
SCALE: 1"=10' (H), 1"=5' (V)

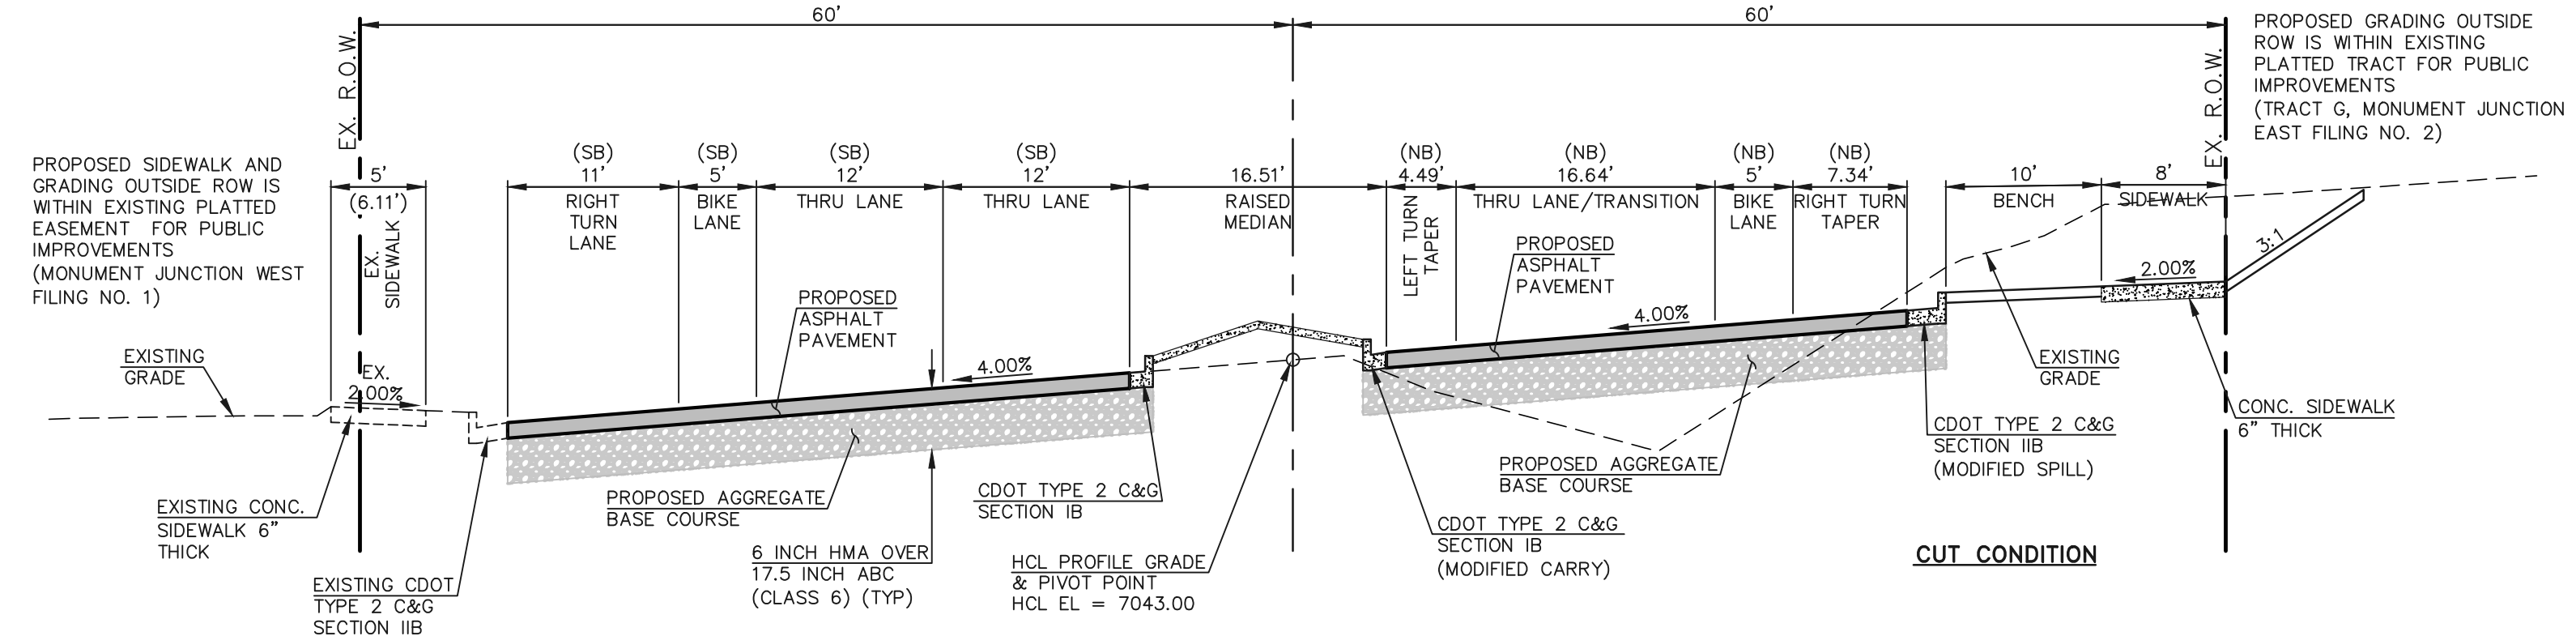


JACKSON CREEK PARKWAY SECTION
STA. 24+09.60
SCALE: 1"=10' (H), 1"=5' (V)

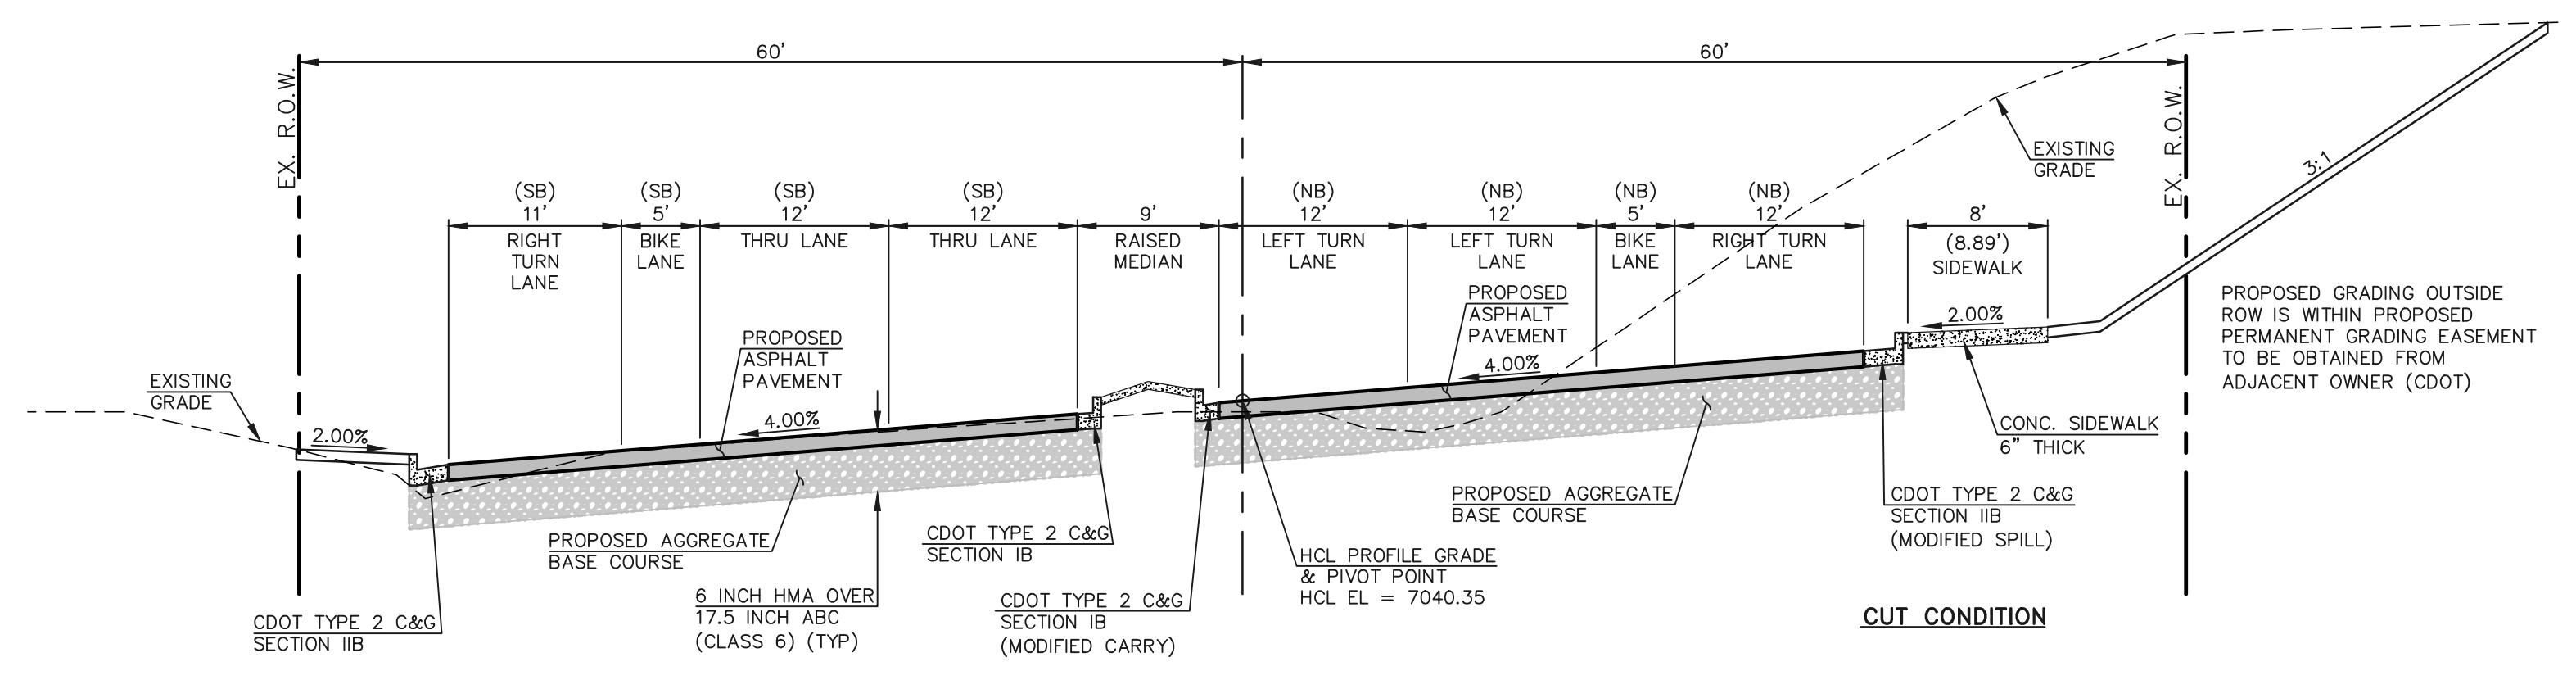

JACKSON CREEK PARKWAY SECTION
STA. 25+26.86
SCALE: 1"=10' (H), 1"=5' (V)

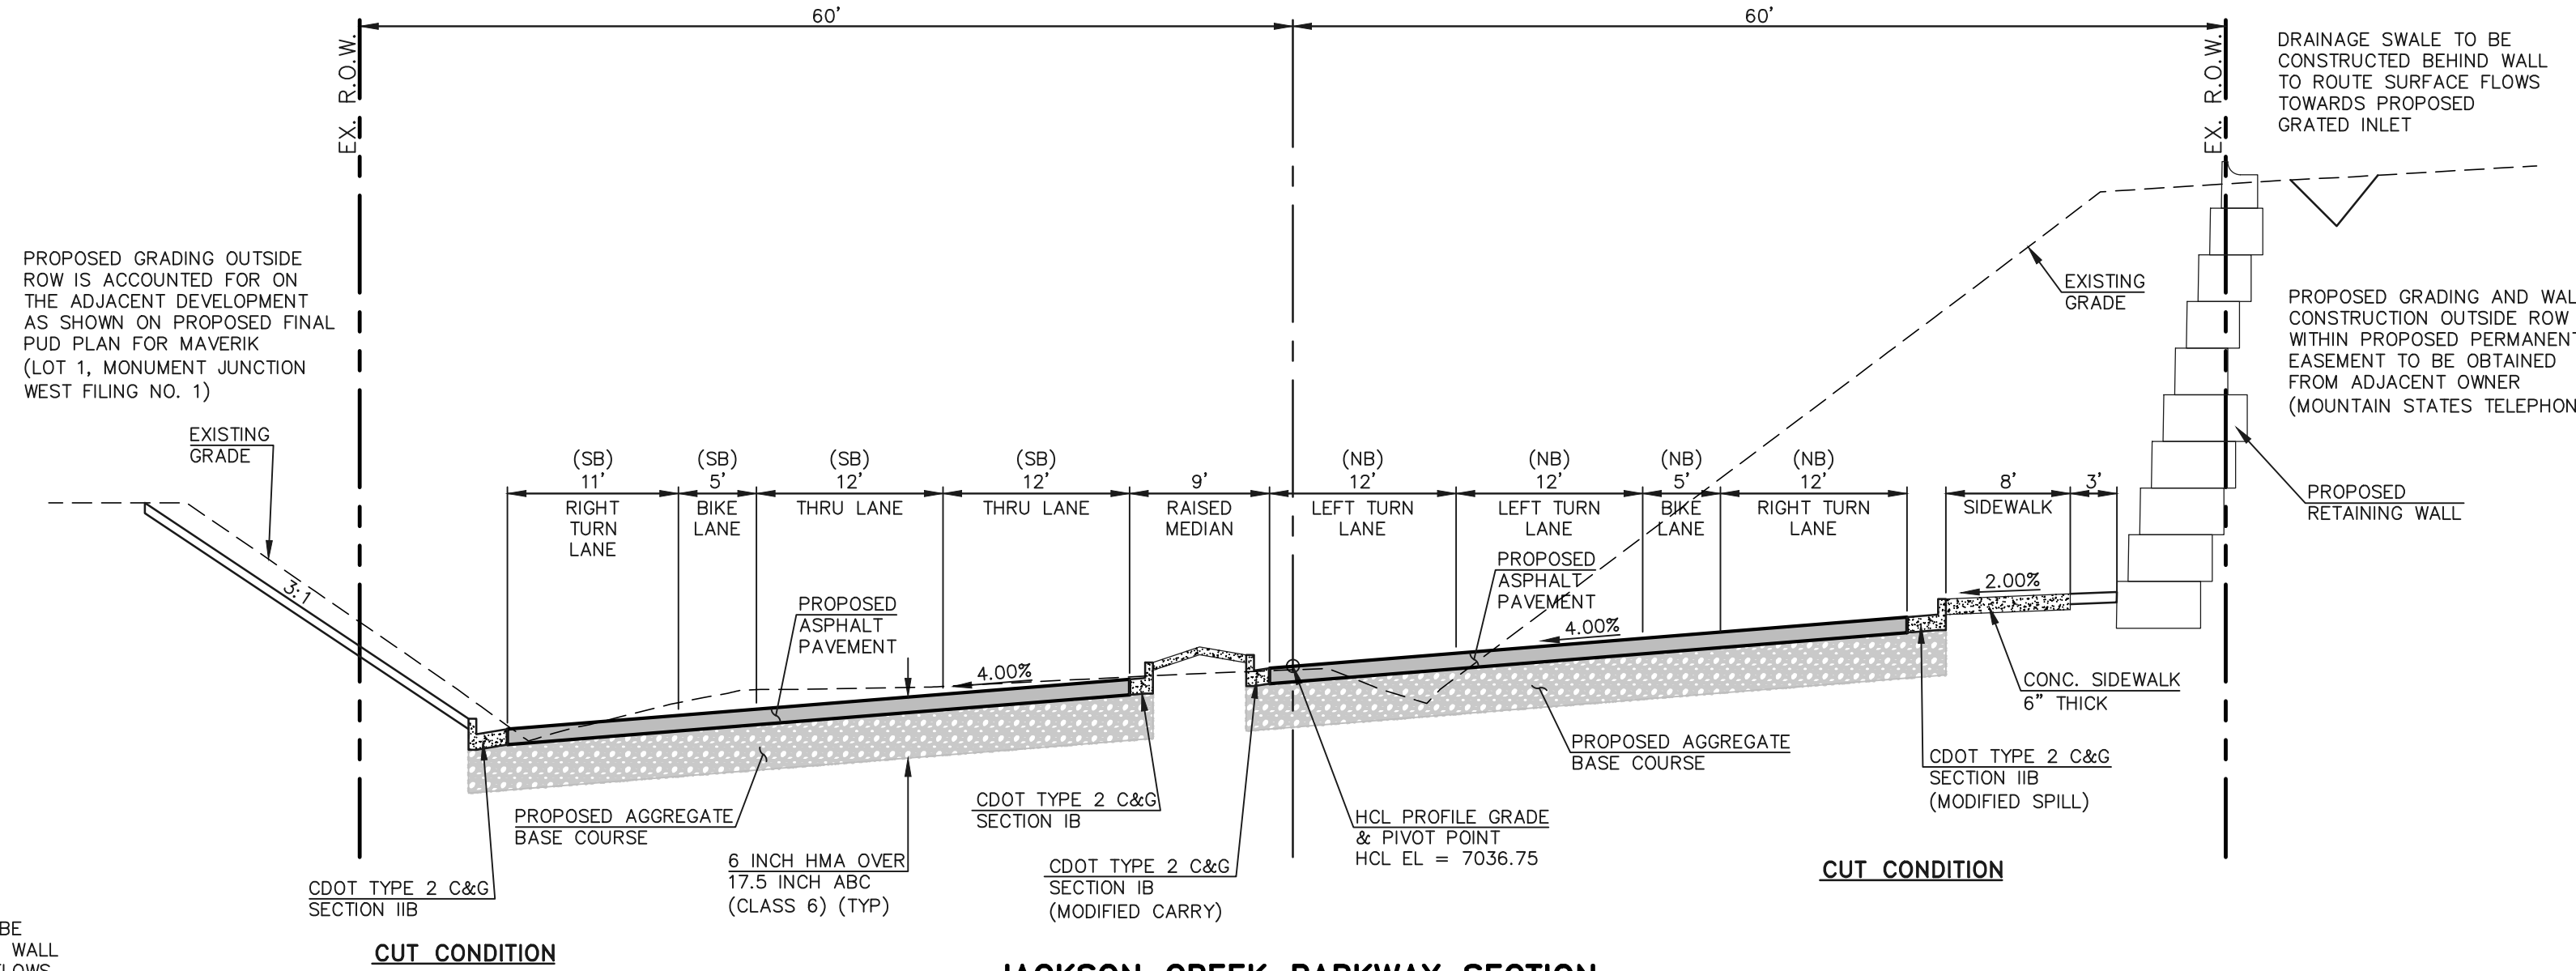

JACKSON CREEK PARKWAY SECTION
STA. 26+29.82
SCALE: 1"=10' (H), 1"=5' (V)

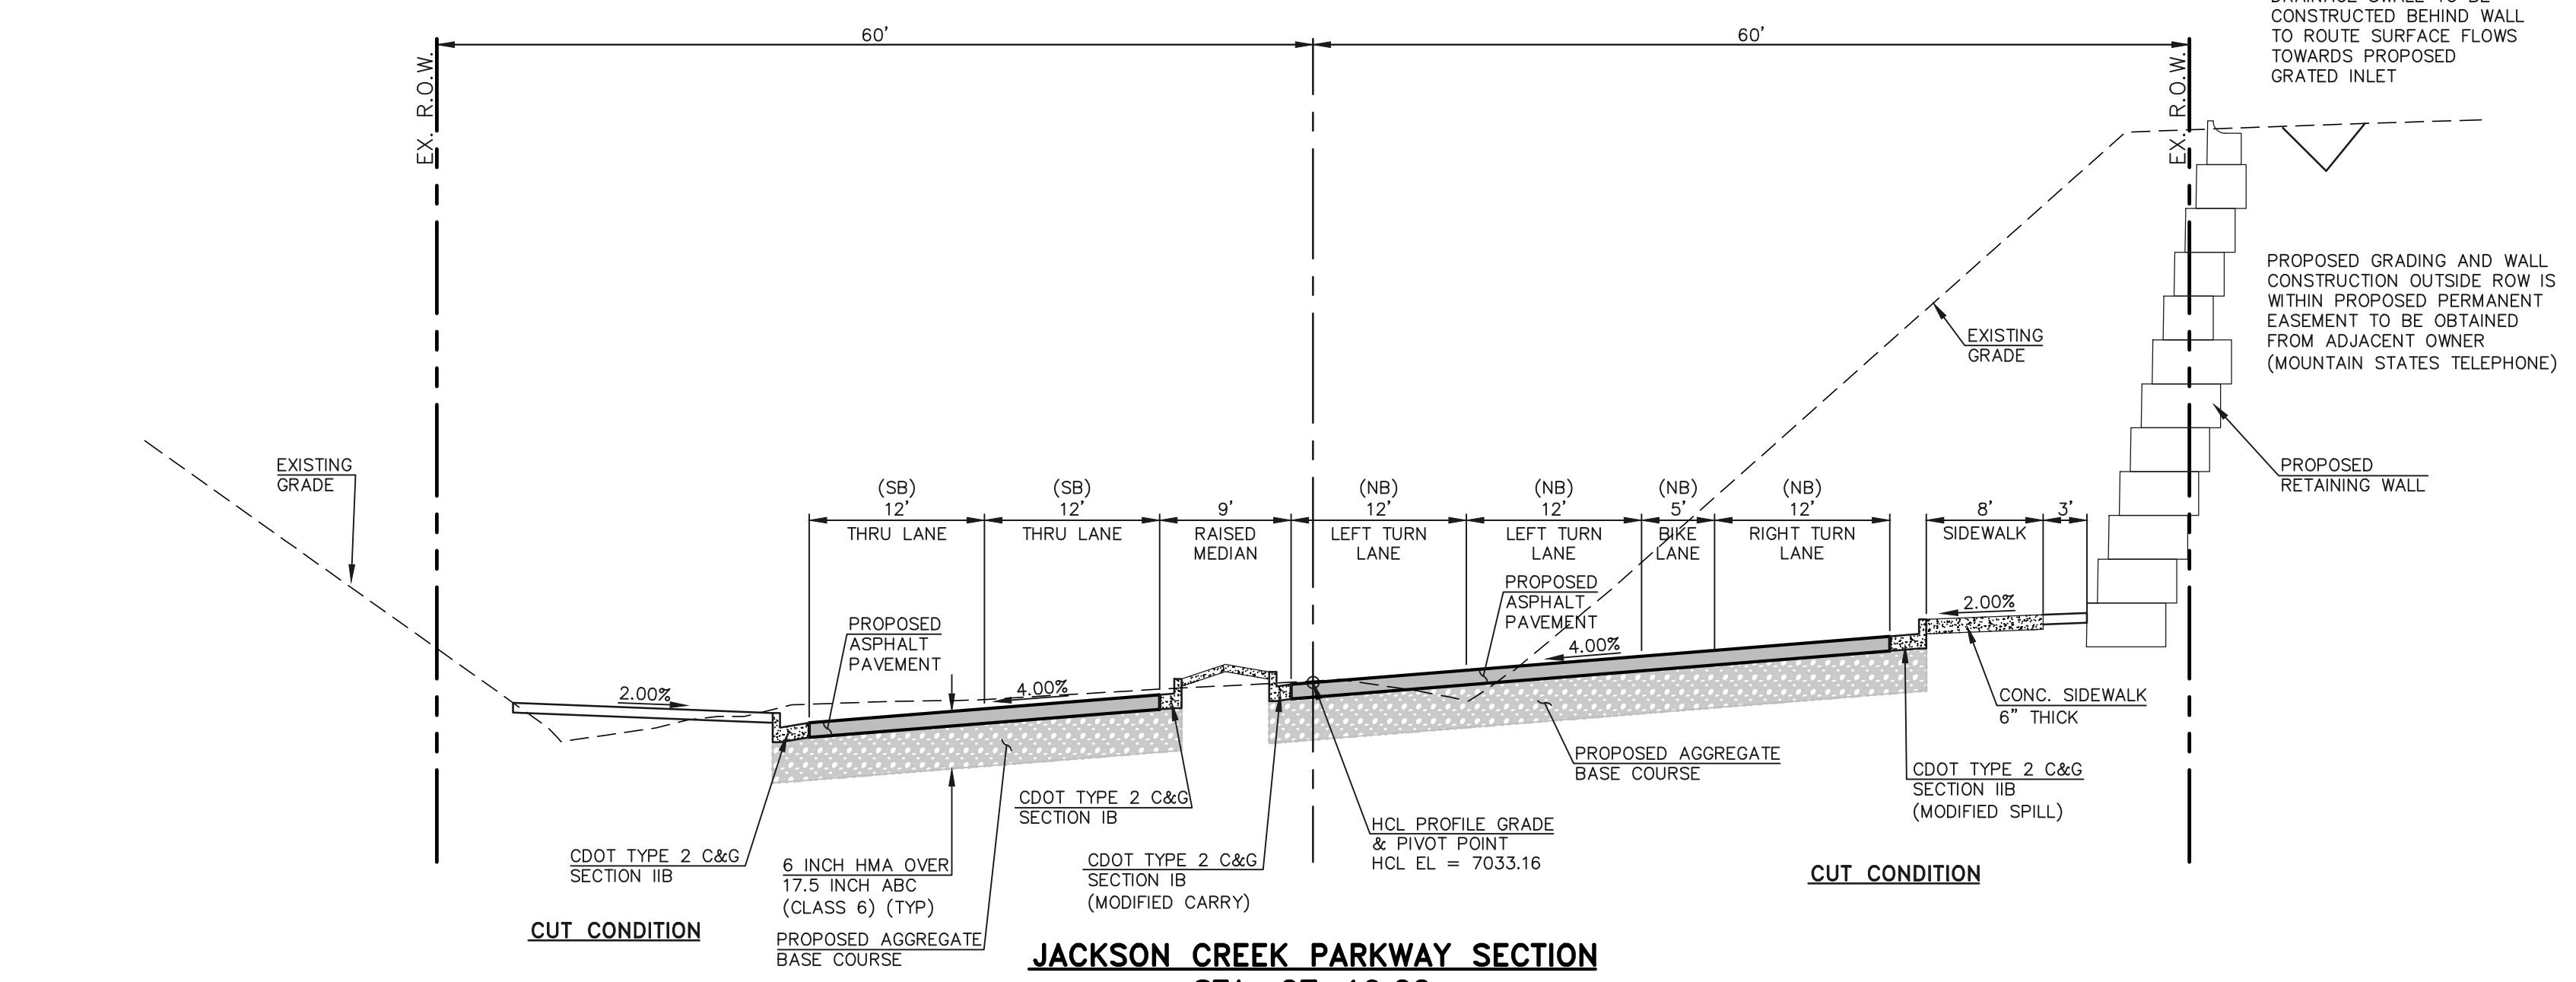

JACKSON CREEK PARKWAY SECTION
STA. 27+10.22
SCALE: 1"=10' (H), 1"=5' (V)



TYPICAL SECTION NOTES

- BREAK POINTS IN SLOPES SHALL BE ROUNDED BY THE CONTRACTOR FOR A PLEASING APPEARANCE DURING CONSTRUCTION.
- SEE JACKSON CREEK PARKWAY IMPROVEMENT PLANS (SHEETS 12, 13 AND 17) FOR ADDITIONAL INFORMATION ON THE ROADWAY SECTION DIMENSIONS.
- A TWO-INCH OVERLAY OF THE ROADWAY IN AREAS OF RECONSTRUCTION AND/OR RE-STRIPING IS REQUIRED. THE WIDTH OF THE OVERLAY SHALL ENCOMPASS ALL LANES CONTIGUOUS TO AREAS OF RECONSTRUCTION AND/OR RE-STRIPING.
- SEE PROPOSED JACKSON CREEK PARKWAY WIDENING, HIGHWAY 105 TO HIGBY ROAD - GEOTECHNICAL EVALUATION REPORT (DRAFT) BY VIVID ENGINEERING GROUP "VIVID PROJECT NO.: D21-2-456" DATED 2-18-2022 FOR INFORMATION ON SUBGRADE PREPARATION.
- THE CONTRACTOR SHALL VERIFY ALL SUBGRADE CONDITIONS IN CUT AREAS PRIOR TO PREPARATION AND PAVING.
- FOR FILL CONDITIONS, THE CONTRACTOR SHALL VERIFY SUBGRADE CONDITIONS THROUGH COMPACTION AND DENSITY TESTING PRIOR TO PAVING.
- SMOOTHNESS CATEGORY SHALL BE CATEGORY 2.

HOT MIX ASPHALT PAVEMENT STRUCTURE TABLE

TOTAL HOT MIX ASPHALT DEPTH	6.0"
# OF LIFTS	3
HOT MIX ASPHALT BINDER COURSE	LIFT 1 2.0"
GRAD-S(75) (PG 64-22)	LIFT 2 2.0"
HOT MIX ASPHALT SURFACE COURSE	LIFT 3 2.0"
GRAD-SX(75) (PG 64-28)	

Asphalt lift is different than previous sheets. Please revise to same detail or clearly state where different lift sections are happening within plan.

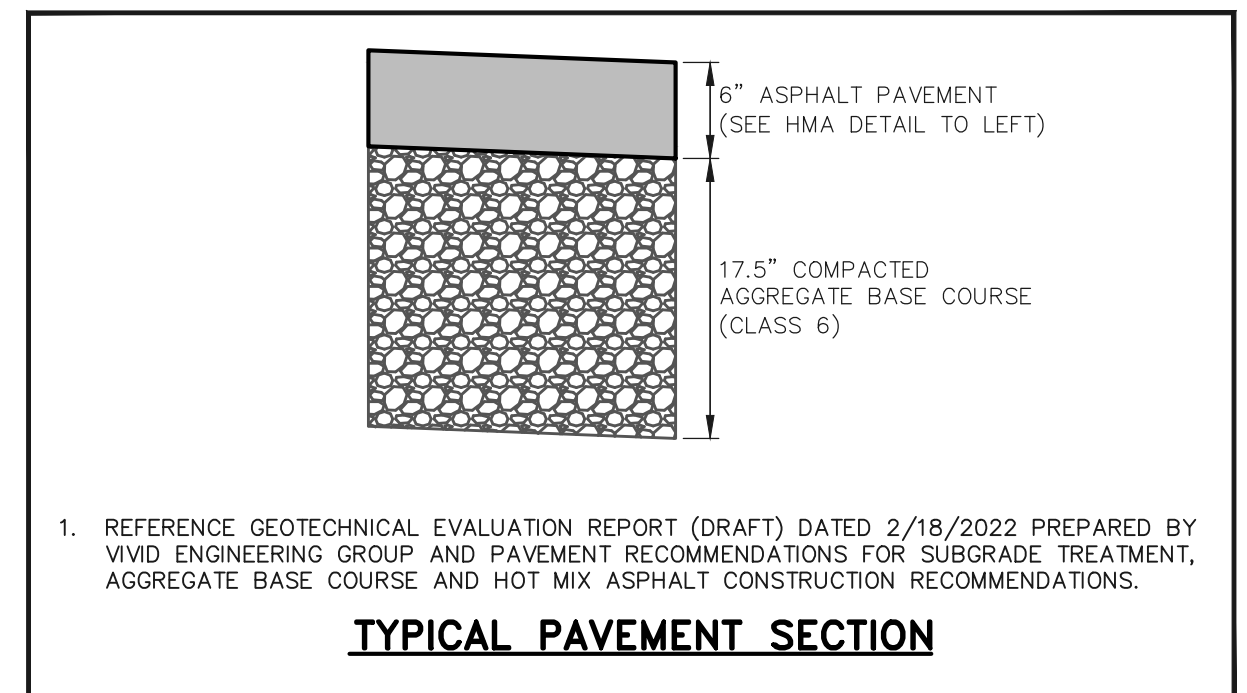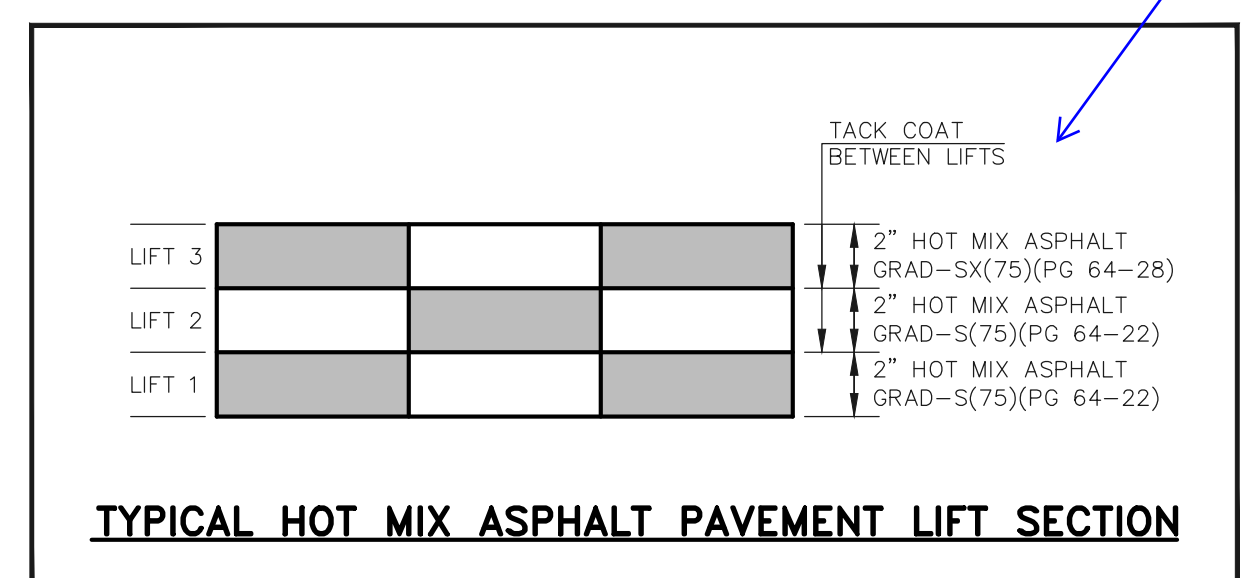

1. REFERENCE GEOTECHNICAL EVALUATION REPORT (DRAFT) DATED 2/18/2022 PREPARED BY VIVID ENGINEERING GROUP AND PAVEMENT RECOMMENDATIONS FOR SUBGRADE TREATMENT, AGGREGATE BASE COURSE AND HOT MIX ASPHALT CONSTRUCTION RECOMMENDATIONS.

48 HOURS BEFORE YOU DIG,
 CALL UTILITY LOCATORS
811
 UTILITY NOTIFICATION CENTER OF COLORADO
 IT'S THE LAW

THE LOCATIONS OF EXISTING UNDERGROUND UTILITIES ARE SHOWN IN AN APPROXIMATE WAY ONLY. THE CONTRACTOR SHALL DETERMINE THE EXACT LOCATION OF ALL EXISTING UTILITIES BEFORE COMMENCING WORK. THE CONTRACTOR SHALL BE FULLY RESPONSIBLE FOR ANY AND ALL DAMAGES WHICH MIGHT BE CAUSED BY HIS FAILURE TO EXACTLY LOCATE AND PRESERVE ANY AND ALL UNDERGROUND UTILITIES.


NO.	REVISION	DATE	REVIEW:
1	REVISED PER JACOBS COMMENTS	5/17/23	PREPARED UNDER MY DIRECT SUPERVISION FOR AND ON BEHALF OF CLASSIC CONSULTING ENGINEERS AND SURVEYORS, LLC
			MARC A. WHORTON, COLORADO P.E. #37155



STATE HIGHWAY 105 / JACKSON CREEK PKWY. - PHASE 2 CONSTRUCTION PLANS
 ROADWAY IMPROVEMENT PLANS
 JACKSON CREEK PKWY. ROADWAY SECTIONS

DESIGNED BY: PRA SCALE: DATE: 02-23-23
 DRAWN BY: PRA (H) 1"= 50' SHEET 11 OF 26
 CHECKED BY: (V) 1"= N/A JOB NO. 1302.22




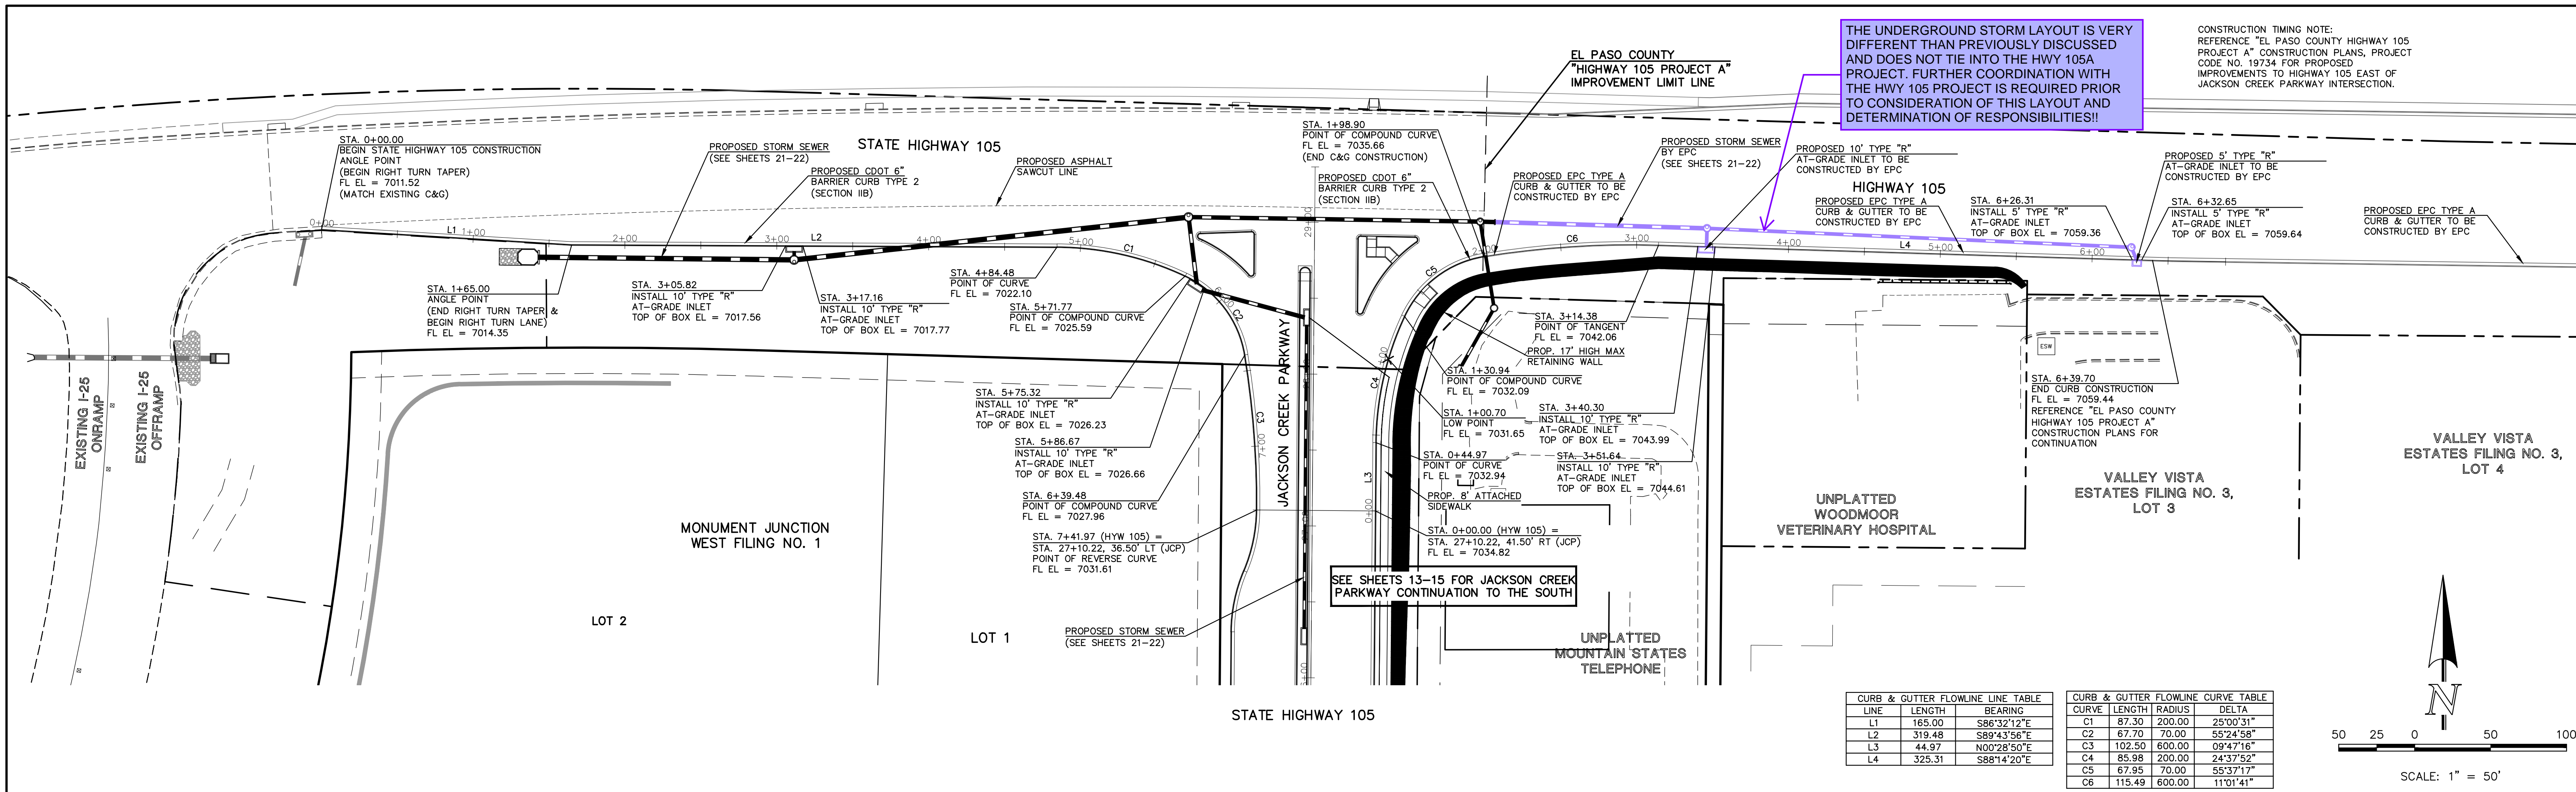


CURB & GUTTER FLOWLINE TABLE

LINE	LENGTH	BEARING
L1	165.00	S86°32'12"E
L2	319.48	S89°43'56"E
L3	44.97	N00°28'50"E
L4	325.31	S88°14'20"E

CURB & GUTTER FLOWLINE CURVE TABLE

CURVE	LENGTH	RADIUS	DELTA
C1	87.30	200.00	25°00'31"
C2	67.70	70.00	55°24'58"
C3	102.50	600.00	09°47'16"
C4	85.88	200.00	24°37'52"
C5	67.95	70.00	55°37'17"
C6	115.49	600.00	11°01'41"

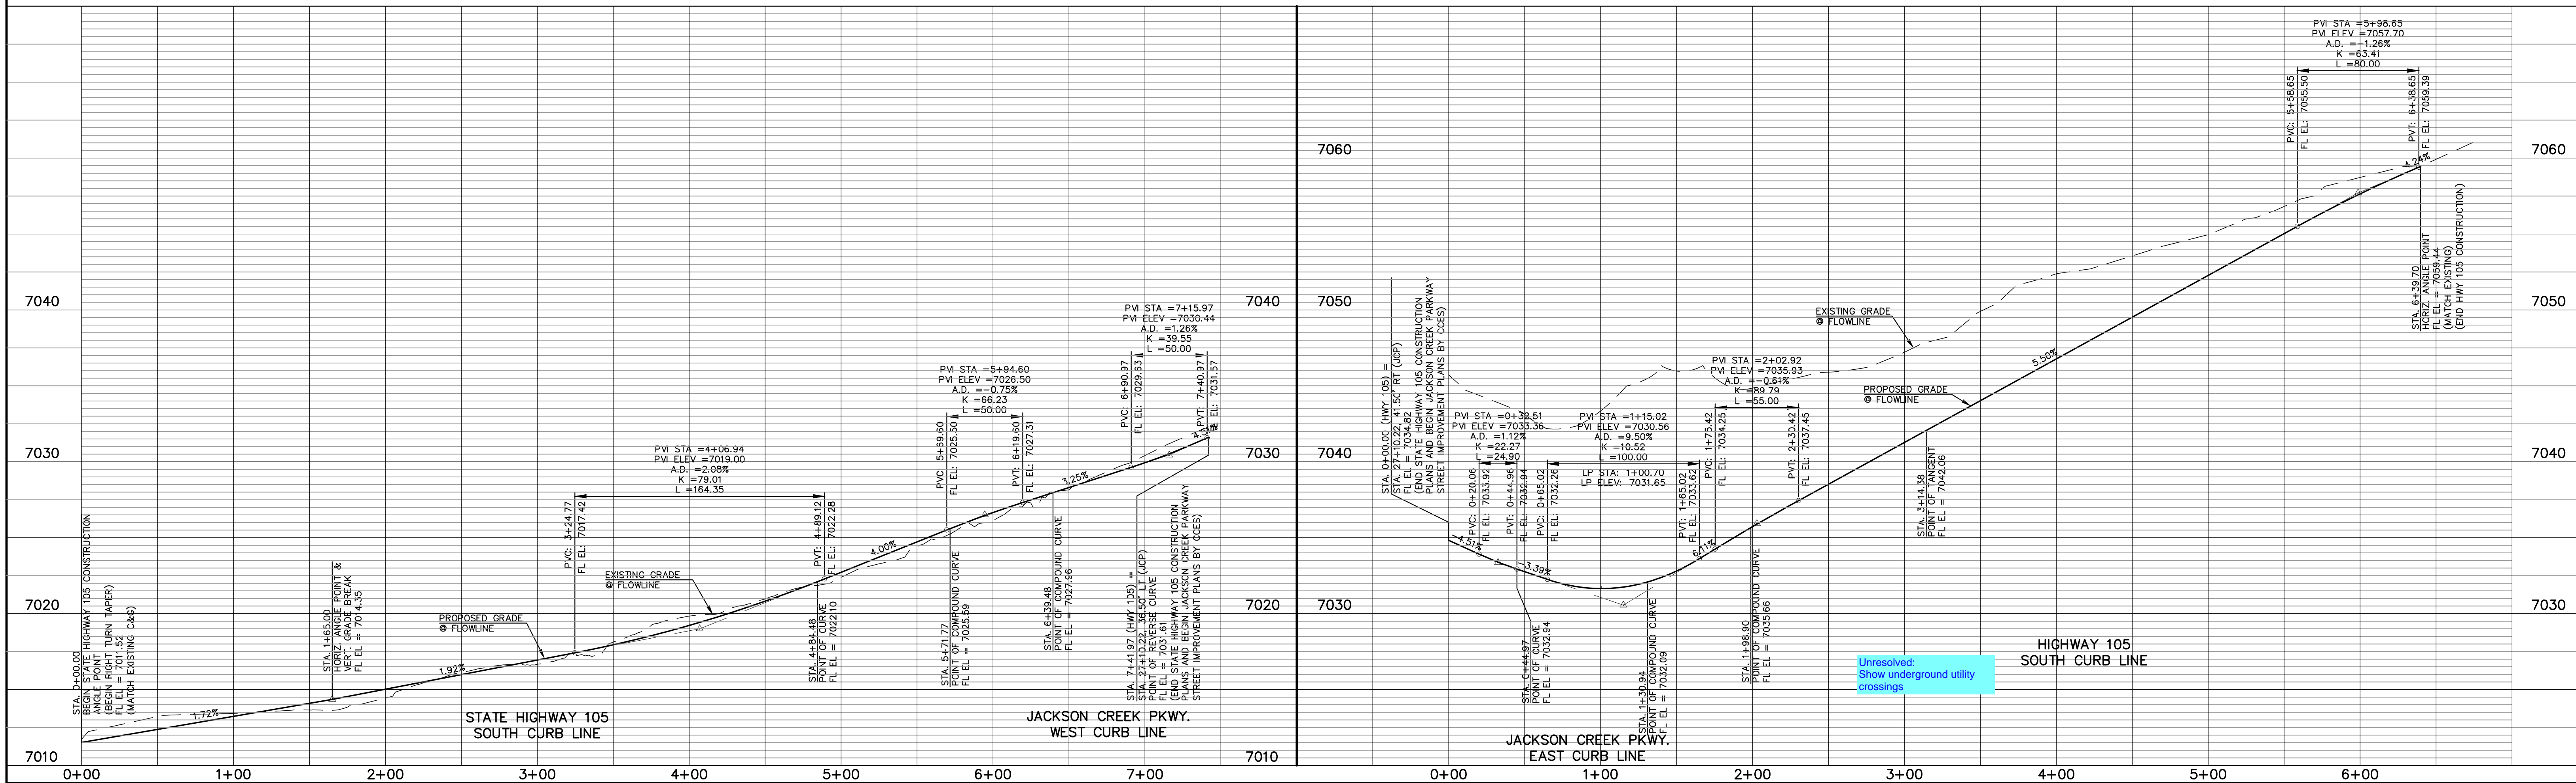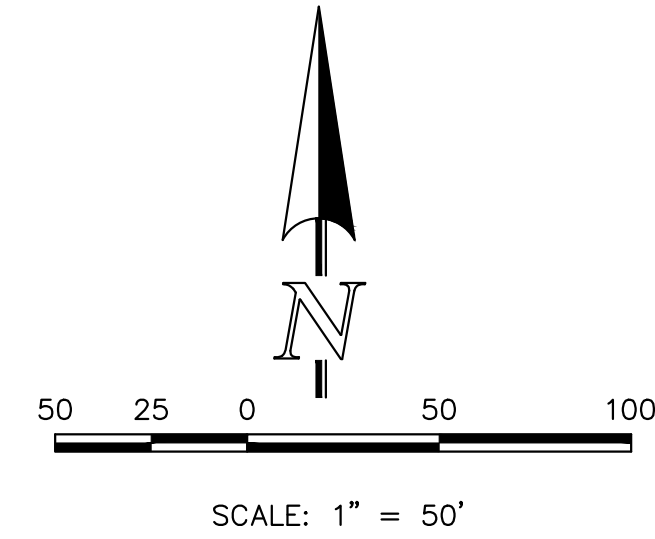

48 HOURS BEFORE YOU DIG, CALL UTILITY LOCATORS
811
 UTILITY NOTIFICATION CENTER OF COLORADO
 IT'S THE LAW

THE LOCATIONS OF EXISTING UNDERGROUND UTILITIES ARE SHOWN IN AN APPROXIMATE WAY ONLY. THE CONTRACTOR SHALL DETERMINE THE EXACT LOCATION OF ALL EXISTING UTILITIES BEFORE COMMENCING WORK. THE CONTRACTOR SHALL BE FULLY RESPONSIBLE FOR ANY AND ALL DAMAGES WHICH MIGHT BE CAUSED BY HIS FAILURE TO EXACTLY LOCATE AND PRESERVE ANY AND ALL UNDERGROUND UTILITIES.

NO. REVISION DATE

1	REVISED PER CDOT/COUNTY/TOWN OF MONUMENT COMMENTS	7/10/23
---	---	---------

REVIEW:

PREPARED UNDER MY DIRECT SUPERVISION FOR AND ON BEHALF OF CLASSIC CONSULTING ENGINEERS AND SURVEYORS, LLC



MARC. A. WHORTON, COLORADO P.E. #37155 DATE



STATE HIGHWAY 105 / JACKSON CREEK PKWY. - PHASE 2 CONSTRUCTION PLANS
 ROADWAY IMPROVEMENT PLANS
 HIGHWAY 105 PLAN & PROFILE

DESIGNED BY	PRA	SCALE	DATE	02-23-23
DRAWN BY	PRA	(H) 1" = 50'	SHEET	12 OF 26
CHECKED BY	(V) 1" = 5'	JOB NO.	1302.22	

CLASSIC CONSULTING ENGINEERS & SURVEYORS

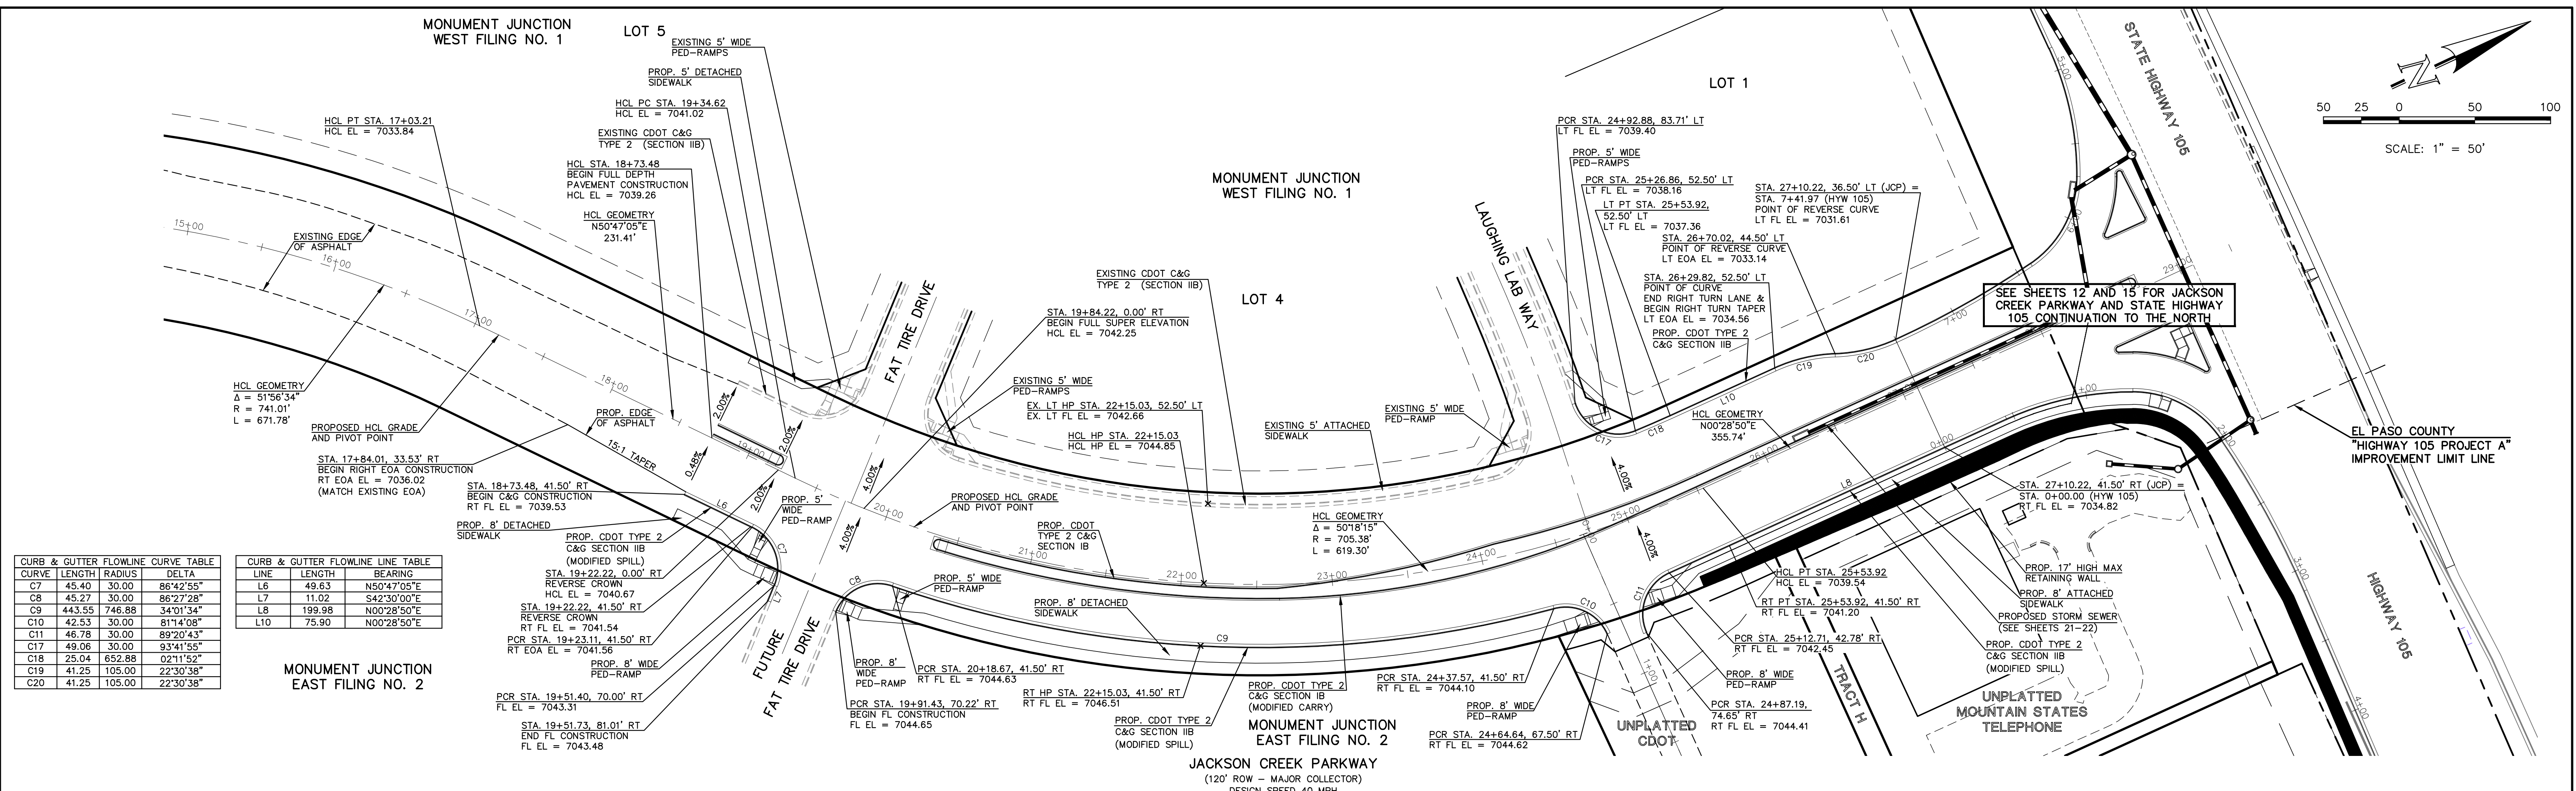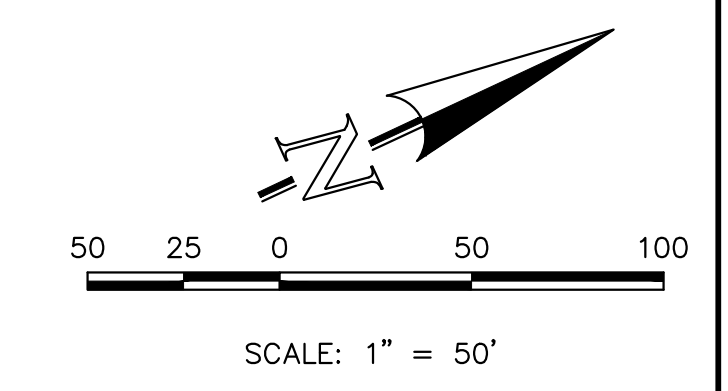


CURB & GUTTER FLOWLINE CURVE TABLE

CURVE	LENGTH	RADIUS	DELTA
C7	45.40	30.00	86°42'55"
C8	45.27	30.00	86°27'28"
C9	443.55	746.88	34°01'34"
C10	42.53	30.00	81°14'08"
C11	46.78	30.00	89°20'43"
C17	49.06	30.00	93°41'55"
C18	25.04	652.88	02°11'52"
C19	41.25	105.00	22°30'38"
C20	41.25	105.00	22°30'38"

CURB & GUTTER FLOWLINE LINE TABLE

LINE	LENGTH	BEARING
L6	49.63	N50°47'05"E
L7	11.02	S42°30'00"E
L8	199.98	N00°28'50"E
L10	75.90	N00°28'50"E

MONUMENT JUNCTION EAST FILING NO. 2

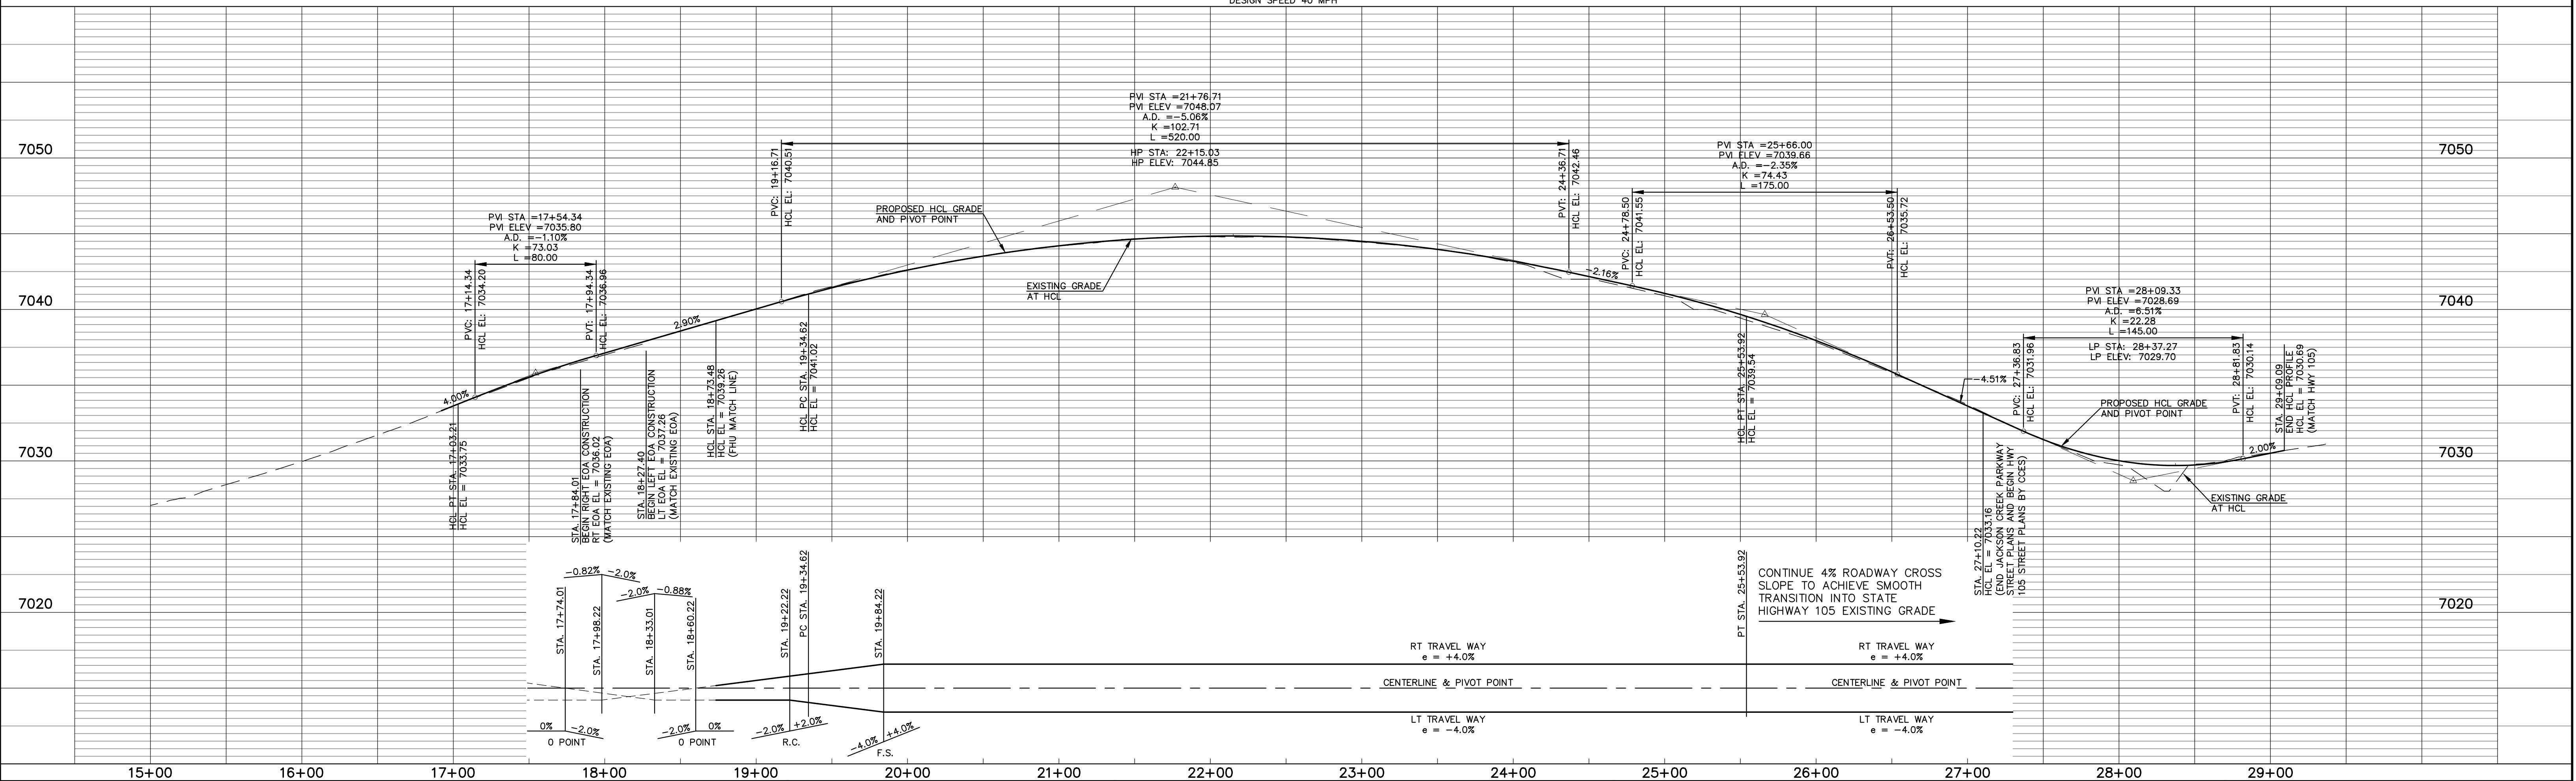

811
UTILITY NOTIFICATION CENTER OF COLORADO
IT'S THE LAW

THE LOCATIONS OF EXISTING UNDERGROUND UTILITIES ARE SHOWN IN AN APPROXIMATE WAY ONLY. THE CONTRACTOR SHALL DETERMINE THE EXACT LOCATION OF ALL EXISTING UTILITIES BEFORE COMMENCING WORK. THE CONTRACTOR SHALL BE FULLY RESPONSIBLE FOR ANY AND ALL DAMAGES WHICH MIGHT BE CAUSED BY HIS FAILURE TO EXACTLY LOCATE AND PRESERVE ANY AND ALL UNDERGROUND UTILITIES.

NO.	REVISION	DATE
1	REVISED PER CDOT/COUNTY/TOWN OF MONUMENT COMMENTS	7/10/23

REVIEW:
PREPARED UNDER MY DIRECT SUPERVISION FOR AND ON BEHALF OF CLASSIC CONSULTING ENGINEERS AND SURVEYORS, LLC

MARC. A. WHORTON, COLORADO P.E. #37155 DATE


CLASSIC
CONSULTING ENGINEERS & SURVEYORS

STATE HIGHWAY 105 / JACKSON CREEK PKWY. - PHASE 2 CONSTRUCTION PLANS
ROADWAY IMPROVEMENT PLANS
JACKSON CREEK PKWY. PLAN & PROFILE

DESIGNED BY	PRA	SCALE	DATE	02-23-23
DRAWN BY	PRA	(H) 1" = 50'	SHEET	13 OF 26
CHECKED BY	(V) 1" = 5'	JOB NO.	1302.21	


619 N. Cascade Avenue, Suite 200
Colorado Springs, Colorado 80903 (719) 785-0790 (719) 785-0799 (fax)

V:\13022\DRAWINGS\CONSTRUCTION\13022-13-01.dwg, 7/19/2023 3:27:29 PM, cwhorton, 1:1

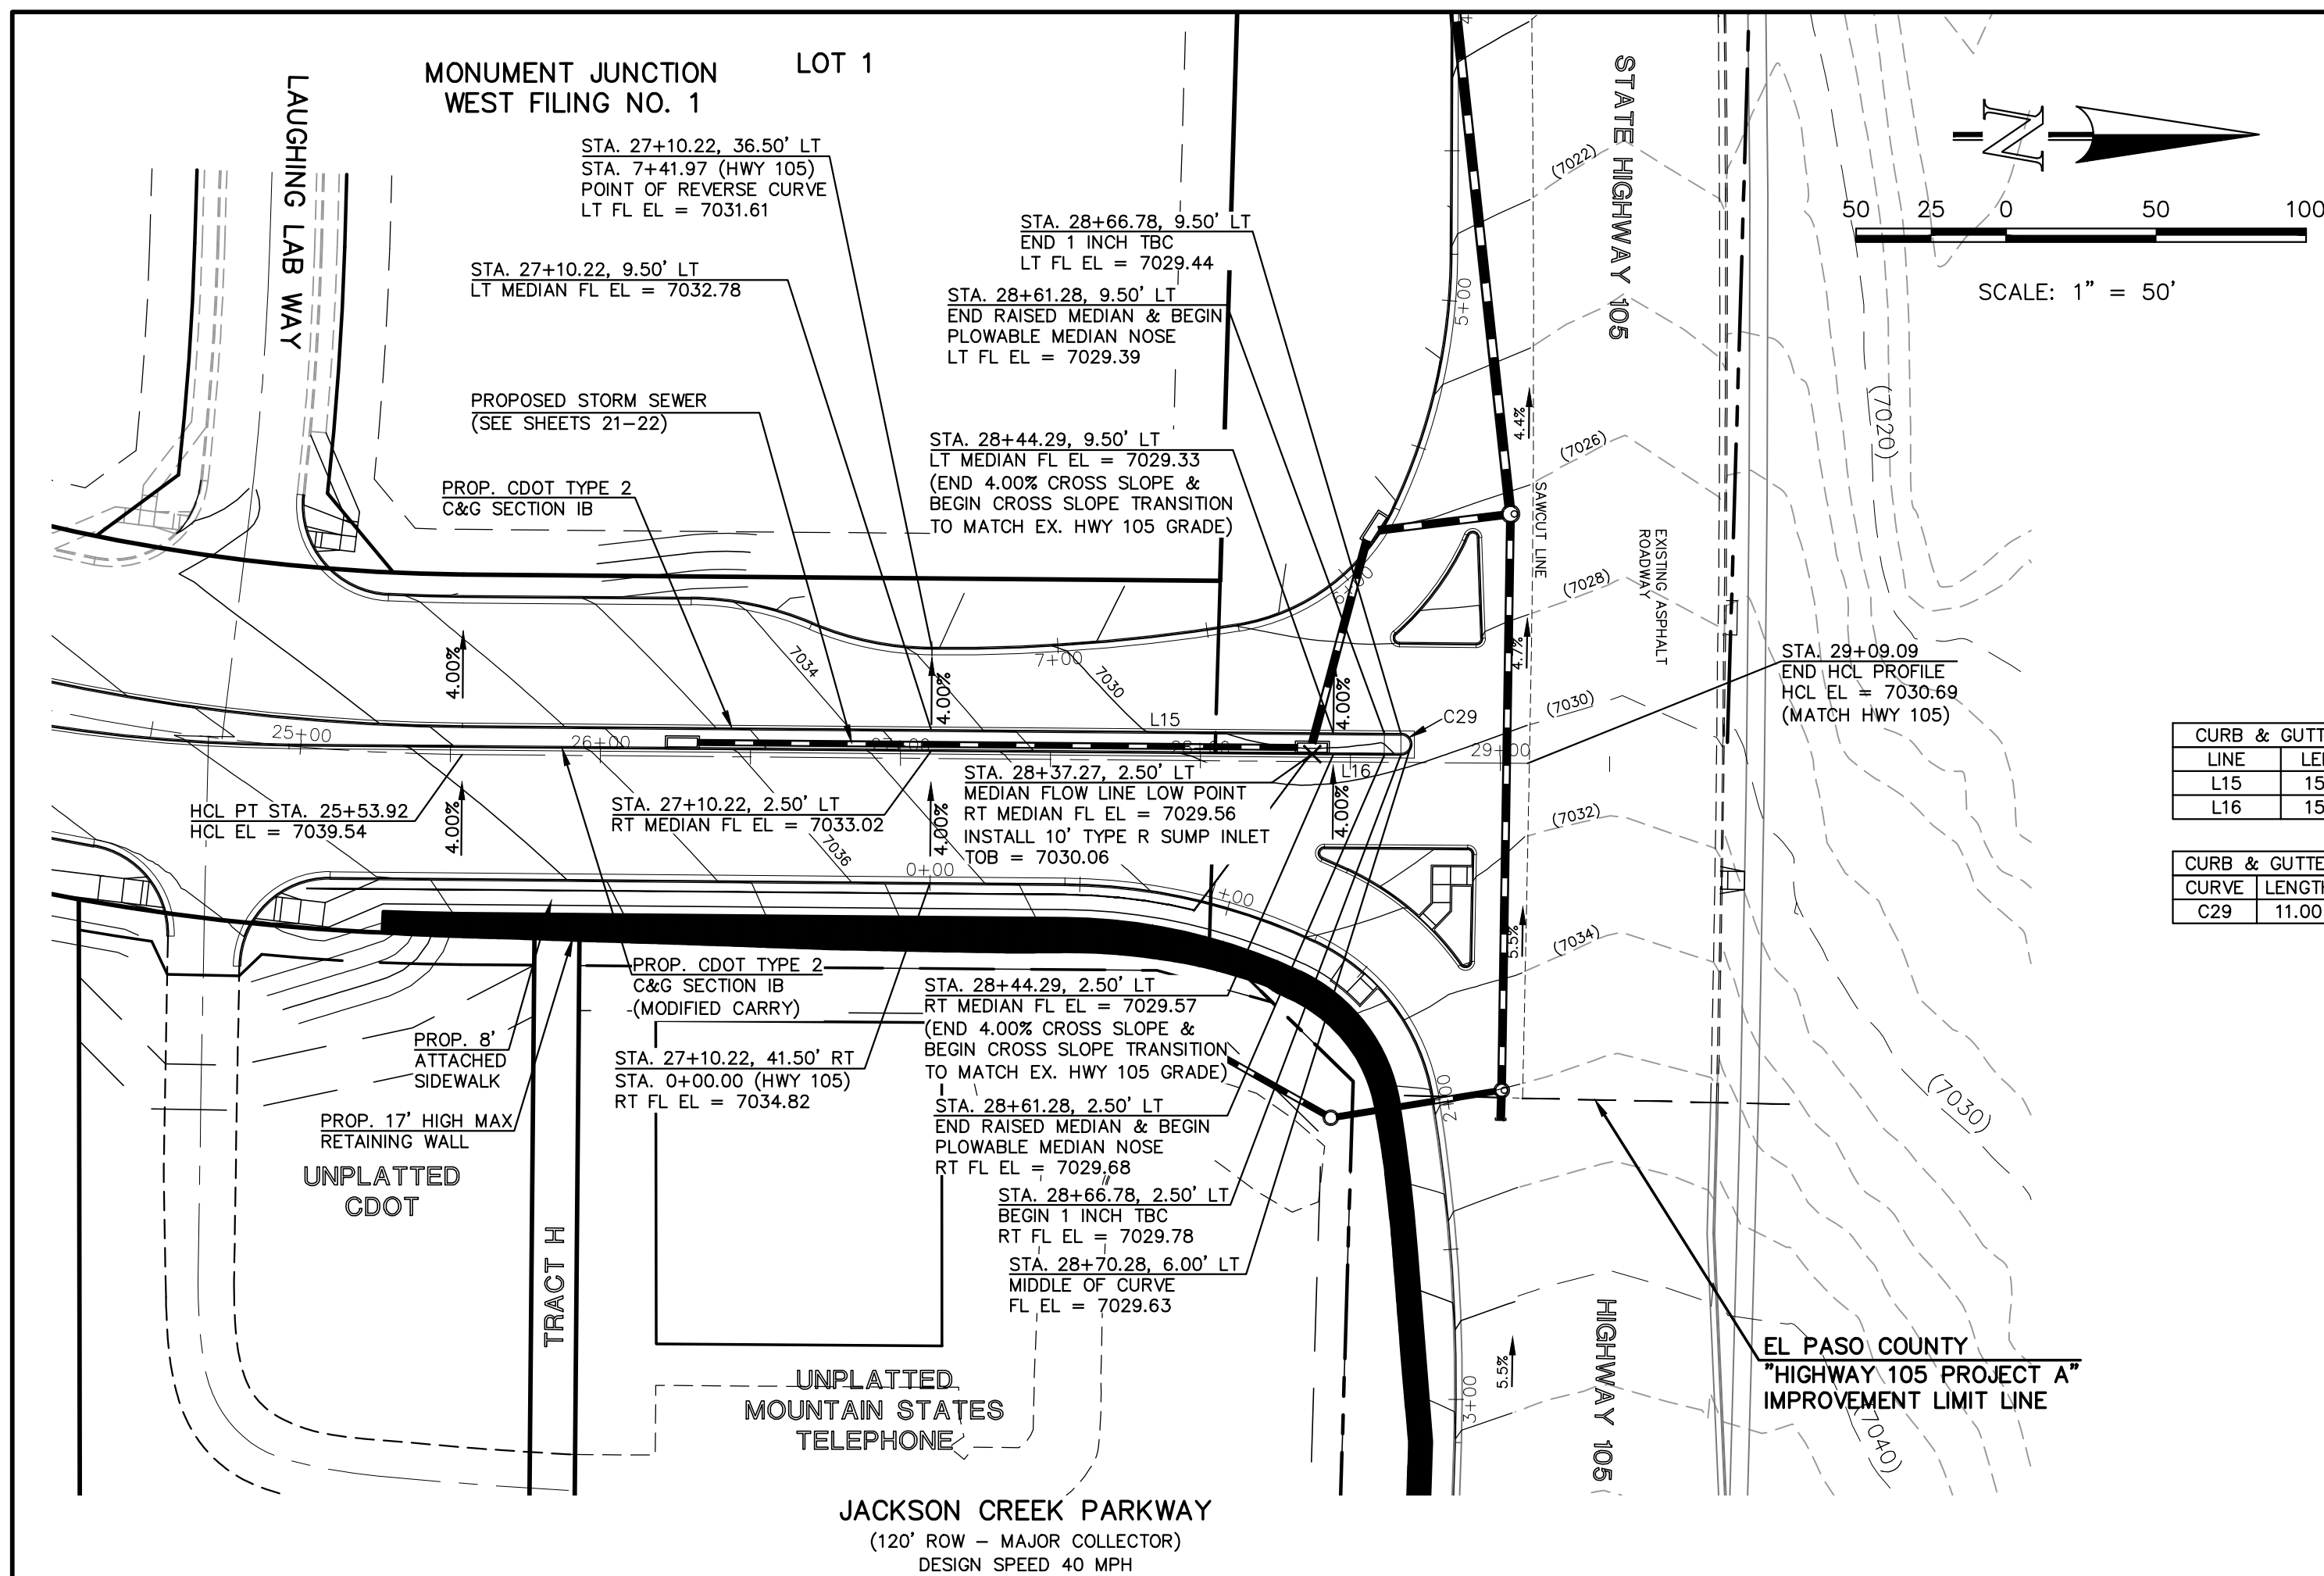


LINE	LENGTH	BEARING
L15	156.56	N00°28'50"E
L16	156.56	N00°28'50"E

CURVE	LENGTH	RADIUS	DELTA
C29	11.00	3.50	180°00'00"

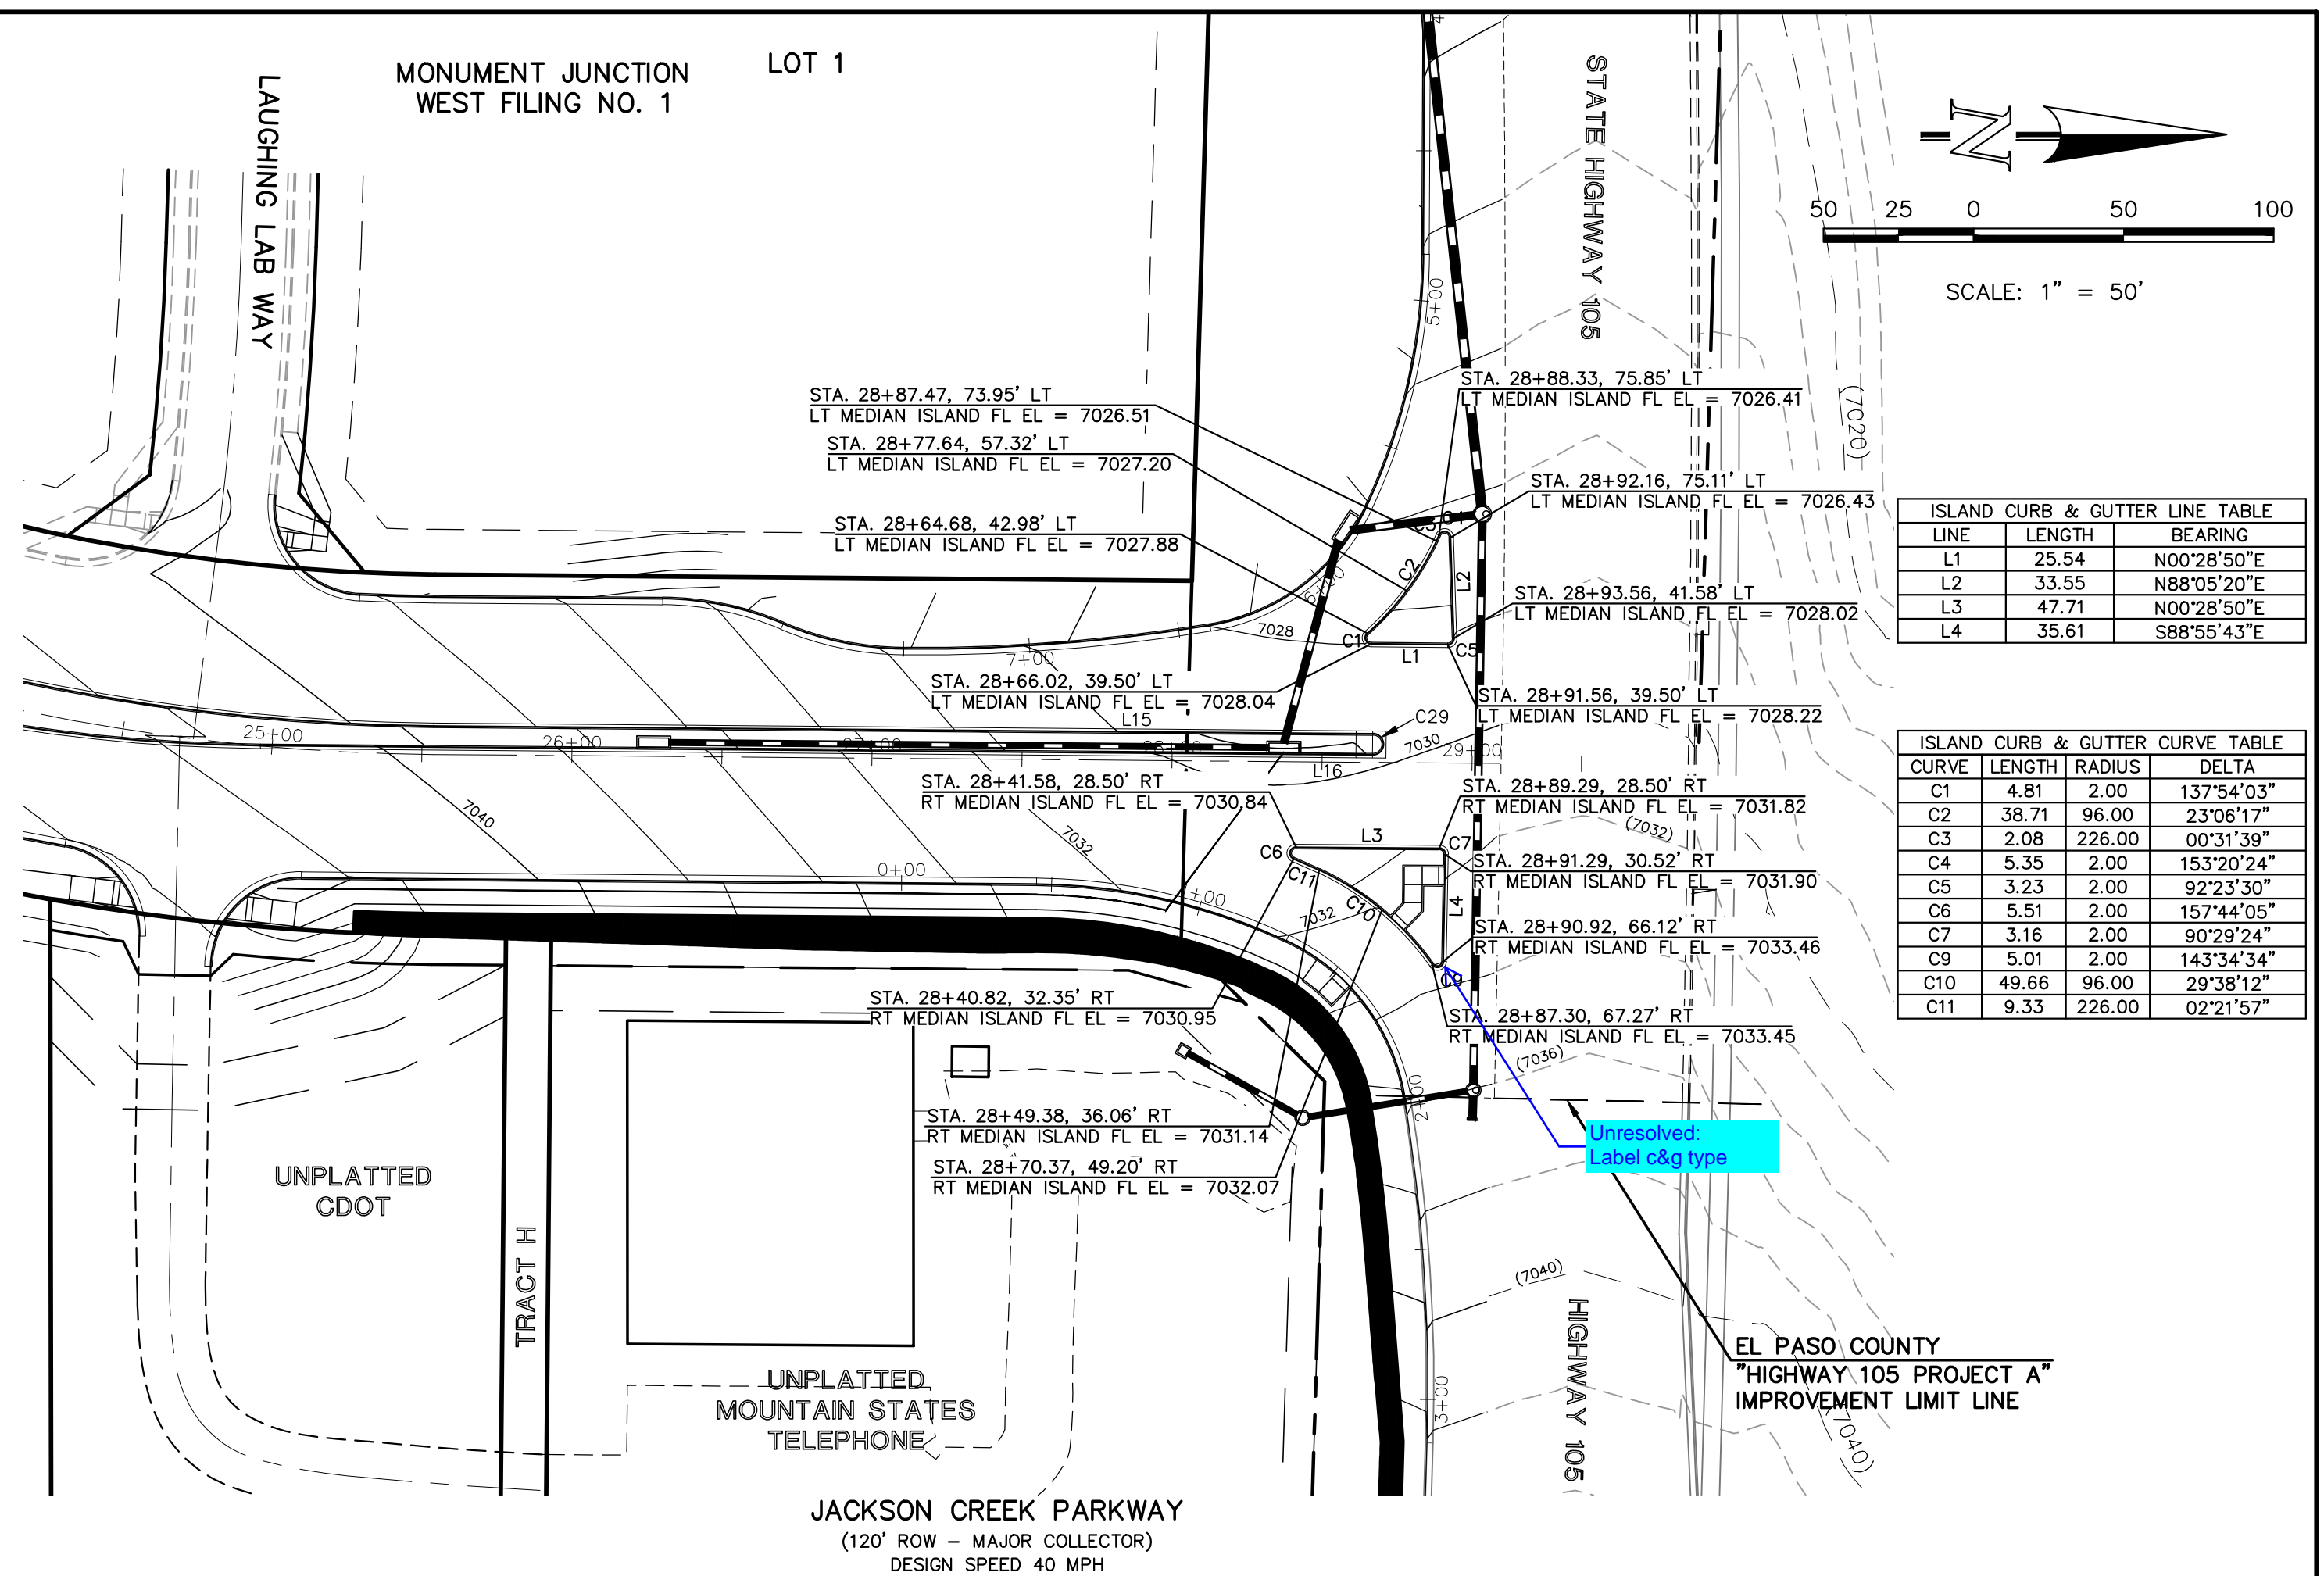

LINE	LENGTH	BEARING
L1	25.54	N00°28'50"E
L2	33.55	N88°05'20"E
L3	47.71	N00°28'50"E
L4	35.61	S88°55'43"E

CURVE	LENGTH	RADIUS	DELTA
C1	4.81	2.00	137°54'03"
C2	38.71	96.00	23°06'17"
C3	2.08	226.00	00°31'39"
C4	5.35	2.00	153°20'24"
C5	3.23	2.00	92°23'30"
C6	5.51	2.00	157°44'05"
C7	3.16	2.00	90°29'24"
C9	5.01	2.00	143°34'34"
C10	49.66	96.00	29°38'12"
C11	9.33	226.00	02°21'57"

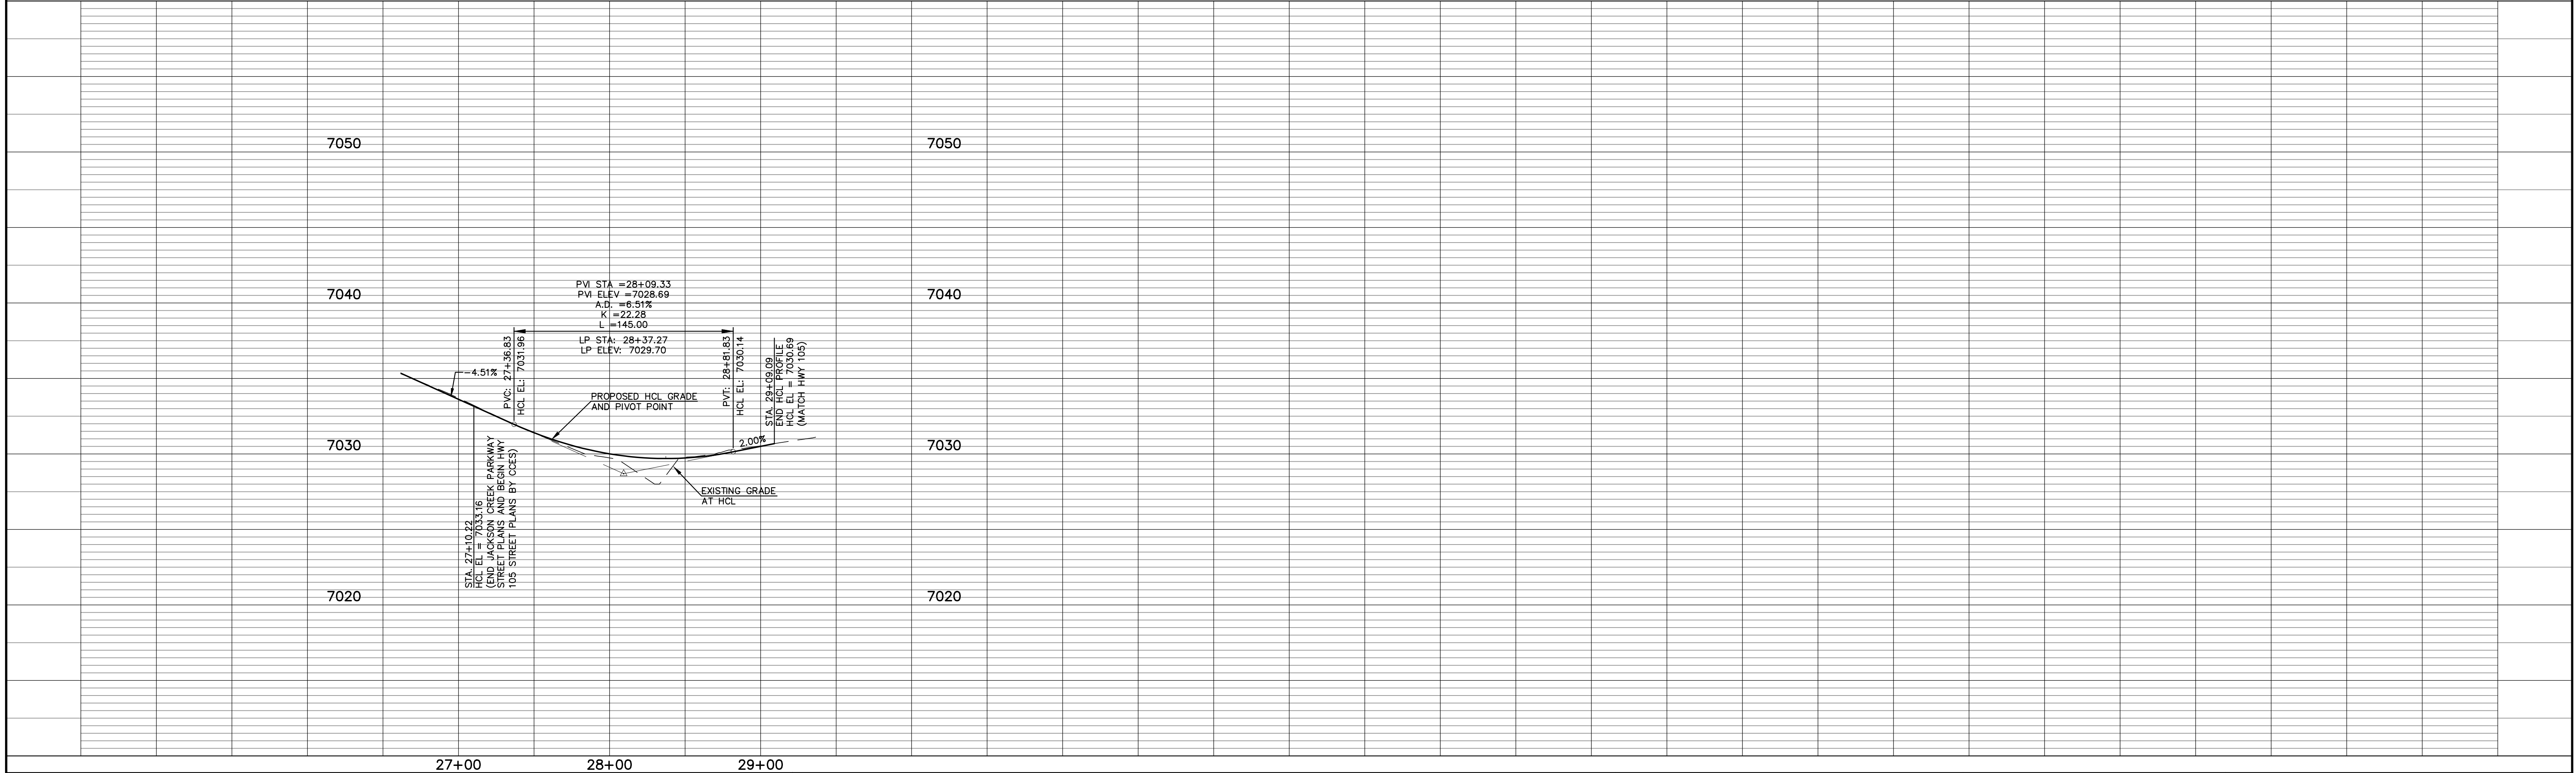

NO.	REVISION	DATE
1	REVISED PER CDOT/COUNTY/TOWN OF MONUMENT COMMENTS	7/10/23

48 HOURS BEFORE YOU DIG,
CALL UTILITY LOCATORS
811
UTILITY NOTIFICATION CENTER OF COLORADO
ITS THE LAW

THE LOCATIONS OF EXISTING UNDERGROUND UTILITIES ARE SHOWN IN AN APPROXIMATE WAY ONLY. THE CONTRACTOR SHALL DETERMINE THE EXACT LOCATION OF ALL EXISTING UTILITIES BEFORE COMMENCING WORK. THE CONTRACTOR SHALL BE FULLY RESPONSIBLE FOR ANY AND ALL DAMAGES WHICH MIGHT BE CAUSED BY HIS FAILURE TO EXACTLY LOCATE AND PRESERVE ANY AND ALL UNDERGROUND UTILITIES.

REVIEW:
PREPARED UNDER MY DIRECT SUPERVISION FOR AND ON BEHALF OF CLASSIC CONSULTING ENGINEERS AND SURVEYORS, LLC





MARC. A. WHORTON, COLORADO P.E. #37155 DATE

STATE HIGHWAY 105 / JACKSON CREEK PKWY. - PHASE 2 CONSTRUCTION PLANS
ROADWAY IMPROVEMENT PLANS
INTERSECTION RAISED MEDIAN PLAN

DESIGNED BY	PRA	SCALE	DATE	02-23-23
DRAWN BY	PRA	(H) 1" = 50'	SHEET	15 OF 26
CHECKED BY	(V) 1" = 5'	JOB NO.	1302.22	

619 N. Cascade Avenue, Suite 200
Colorado Springs, Colorado 80903 (719) 785-0790 (719) 785-0799(fax)

V:\130222\DRAWINGS\CD\STRUCT\CON\STATE-15-91-04.dwg, 7/19/2023 3:32:47 PM, cwhorton, 1:1

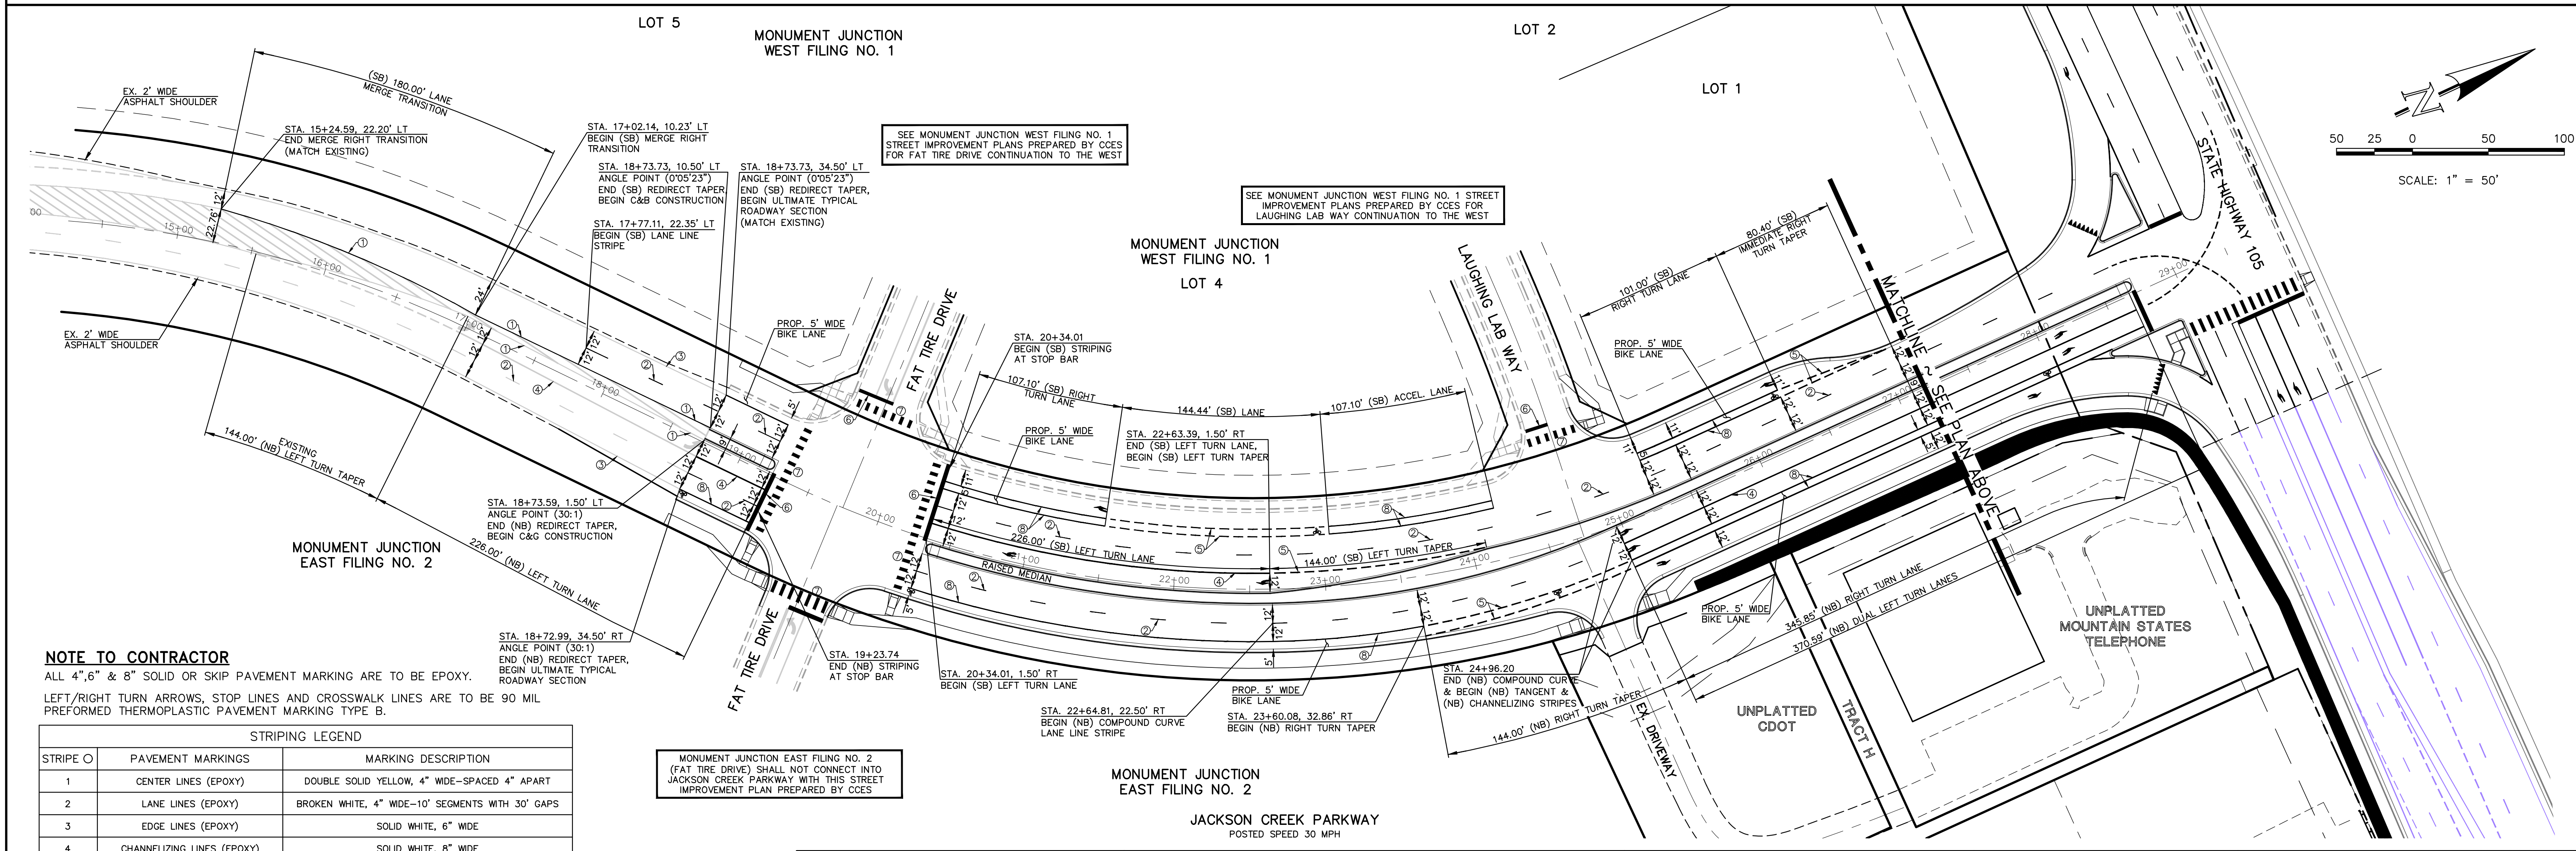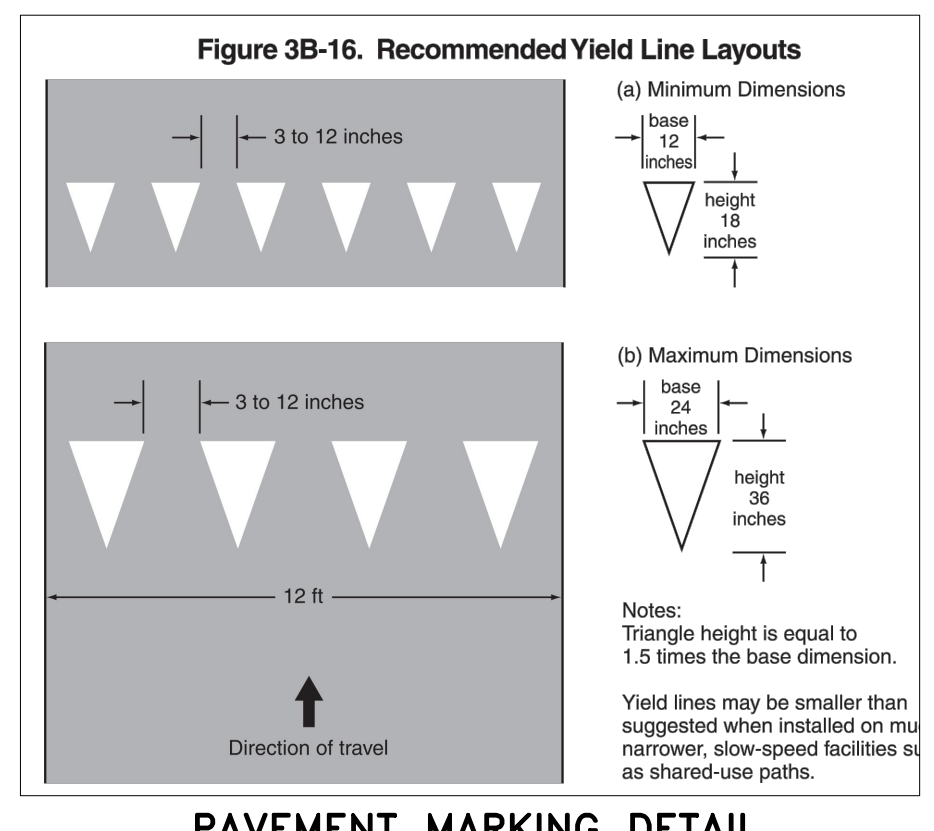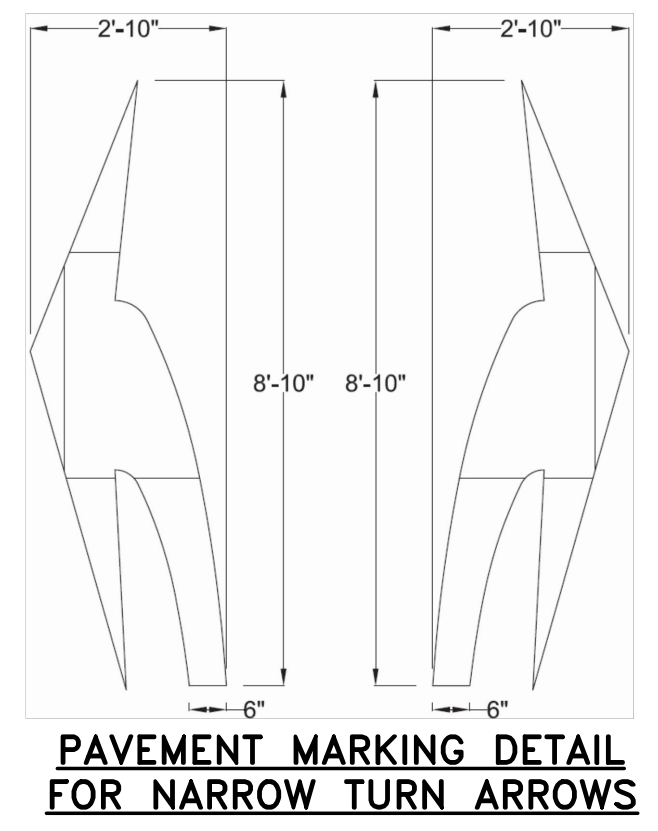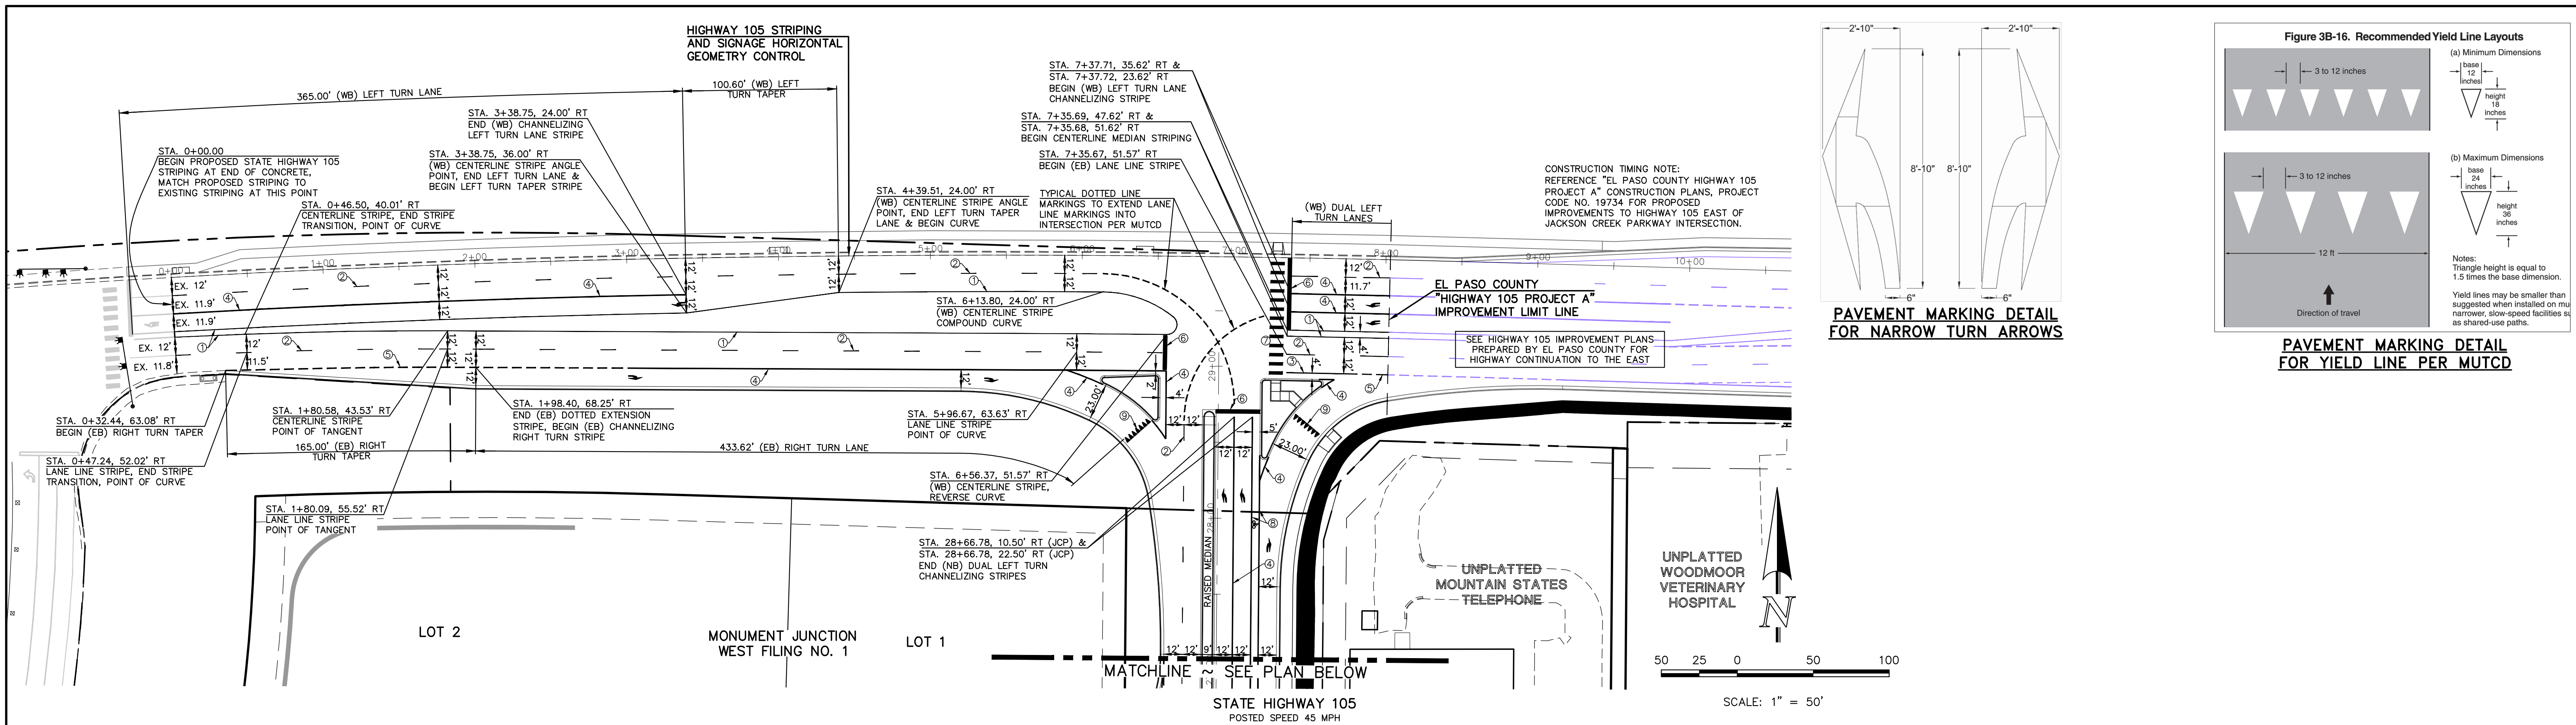

NOTE TO CONTRACTOR
 ALL 4", 6" & 8" SOLID OR SKIP PAVEMENT MARKING ARE TO BE EPOXY.
 LEFT/RIGHT TURN ARROWS, STOP LINES AND CROSSWALK LINES ARE TO BE 90 MIL PERFORMED THERMOPLASTIC PAVEMENT MARKING TYPE B.

STRIPE	PAVEMENT MARKINGS	MARKING DESCRIPTION
1	CENTER LINES (EPOXY)	DOUBLE SOLID YELLOW, 4" WIDE-SPACED 4" APART
2	LANE LINES (EPOXY)	BROKEN WHITE, 4" WIDE-10" SEGMENTS WITH 30' GAPS
3	EDGE LINES (EPOXY)	SOLID WHITE, 6" WIDE
4	CHANNELIZING LINES (EPOXY)	SOLID WHITE, 8" WIDE
5	DOTTED LANE LINES (EPOXY)	BROKEN WHITE, 6" WIDE-3" SEGMENTS WITH 12' GAPS
6	STOP LINES (THERMO PLASTIC)	SOLID WHITE, 24" WIDE
7	CROSSWALK LINES (THERMO PLASTIC)	SOLID WHITE, 24" WIDE, 9' LONG, 48" GAPS
8	BIKE LANE CHANNELIZING LINES (EPOXY)	SOLID WHITE, 6" WIDE
9	YIELD PAVEMENT MARKINGS (EPOXY)	SEE DETAIL AT TOP RIGHT OF PLAN

MONUMENT JUNCTION EAST FILING NO. 2 (FAT TIRE DRIVE) SHALL NOT CONNECT INTO JACKSON CREEK PARKWAY WITH THIS STREET IMPROVEMENT PLAN PREPARED BY CDES

48 HOURS BEFORE YOU DIG,
 CALL UTILITY LOCATORS
811
 UTILITY NOTIFICATION CENTER OF COLORADO
 IT'S THE LAW
 THE LOCATIONS OF EXISTING UNDERGROUND UTILITIES ARE SHOWN IN AN APPROXIMATE WAY ONLY. THE CONTRACTOR SHALL DETERMINE THE EXACT LOCATION OF ALL EXISTING UTILITIES BEFORE COMMENCING WORK. THE CONTRACTOR SHALL BE FULLY RESPONSIBLE FOR ANY AND ALL DAMAGES WHICH MIGHT BE CAUSED BY HIS FAILURE TO EXACTLY LOCATE AND PRESERVE ANY AND ALL UNDERGROUND UTILITIES.

NO.	REVISION	DATE
1	REVISED PER CDOT/COUNTY/TOWN OF MONUMENT COMMENTS	7/10/23





REVIEW:
 PREPARED UNDER MY DIRECT SUPERVISION FOR AND ON BEHALF OF CLASSIC CONSULTING ENGINEERS AND SURVEYORS, LLC
 MARC. A. WHORTON, COLORADO P.E. #37155 DATE

CLASSIC
 CONSULTING ENGINEERS & SURVEYORS
 619 N. Cascade Avenue, Suite 200
 Colorado Springs, Colorado 80903
 (719) 785-0790
 (719) 785-0799 (fax)

DESIGNED BY	SCALE	DATE
PRA	(H) 1" = 50'	02-23-23
DRAWN BY	SCALE	SHEET
PRA	(V) 1" = N/A	17 OF 26
CHECKED BY	DATE	JOB NO.
		1302.22


V:\130222\ROADWORKS\CDOT\CONSTRUCTION\DRAWINGS\17-STRIPING-01.dwg, 7/20/2023 10:38:39 AM, Whorton, T1

NOTE TO CONTRACTOR
 SIGNS AND POSTS SHALL BE PER CDOT STANDARDS
 S-614-8, S-614-2, AND S-614-3, LATEST REVISION.
 ALL SIGNAGE INSTALLATION IS TO BE IN COMPLIANCE WITH
 THE MANUAL ON UNIFORM TRAFFIC CONTROL DEVICES.
NOTE:
 ALL INTERNAL STREET NAME SIGNS SHALL BE
 4" FONT LETTER SIZE.
 6" FONT LETTER SIZE ON ALL STREETS POSTED
 30MPH OR GREATER

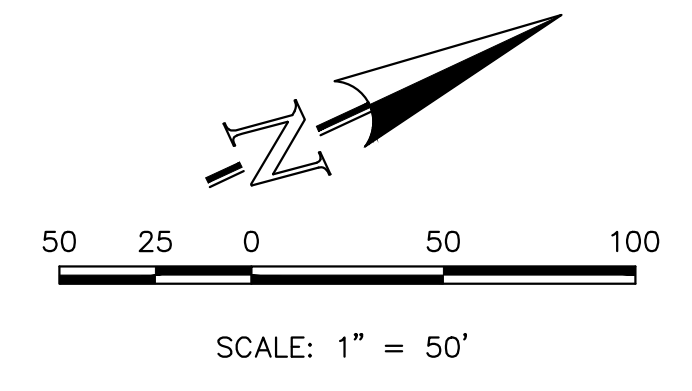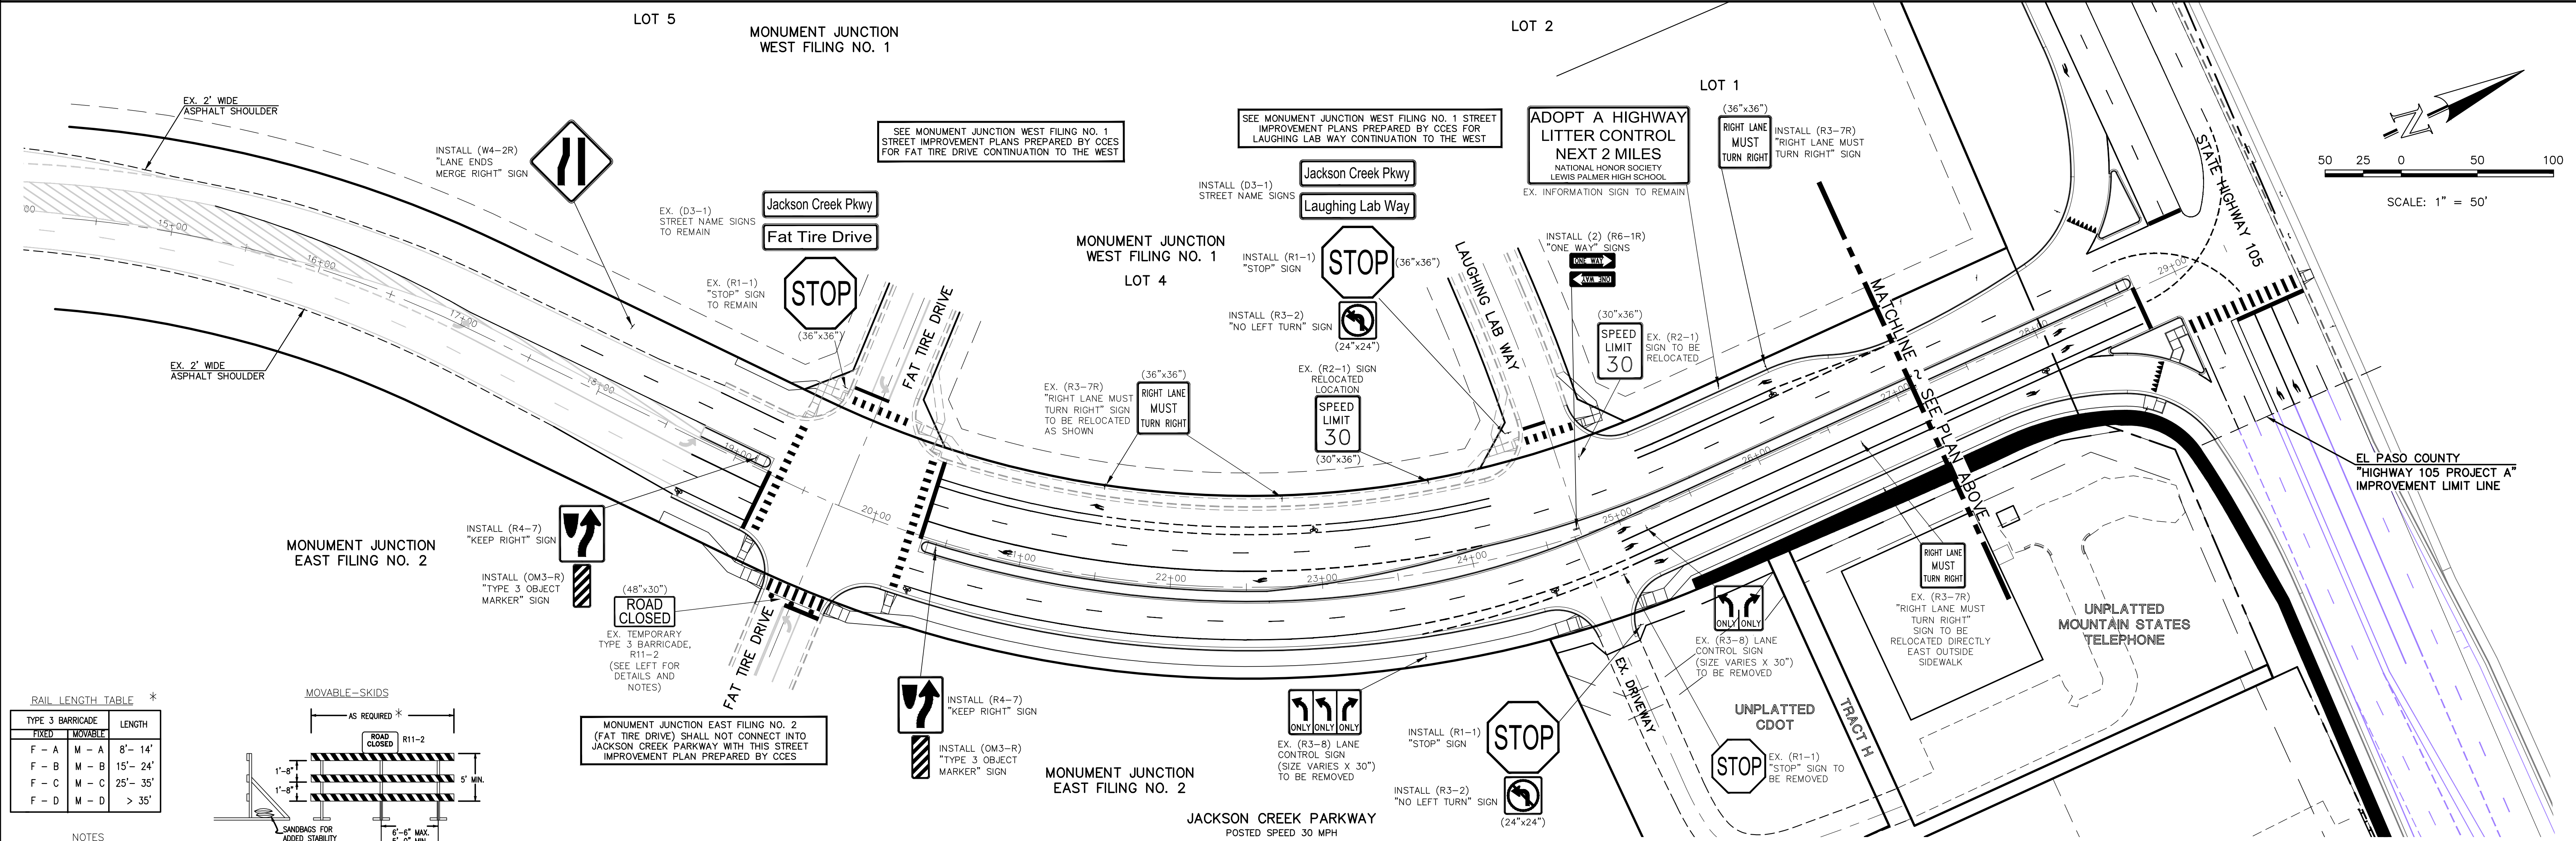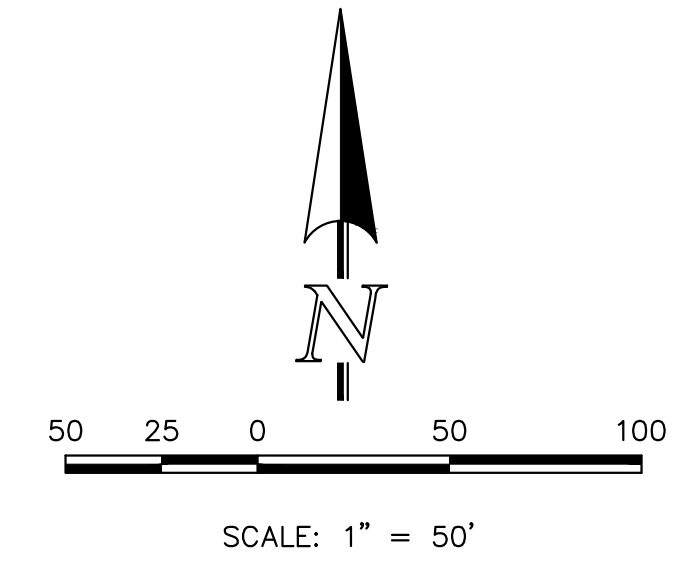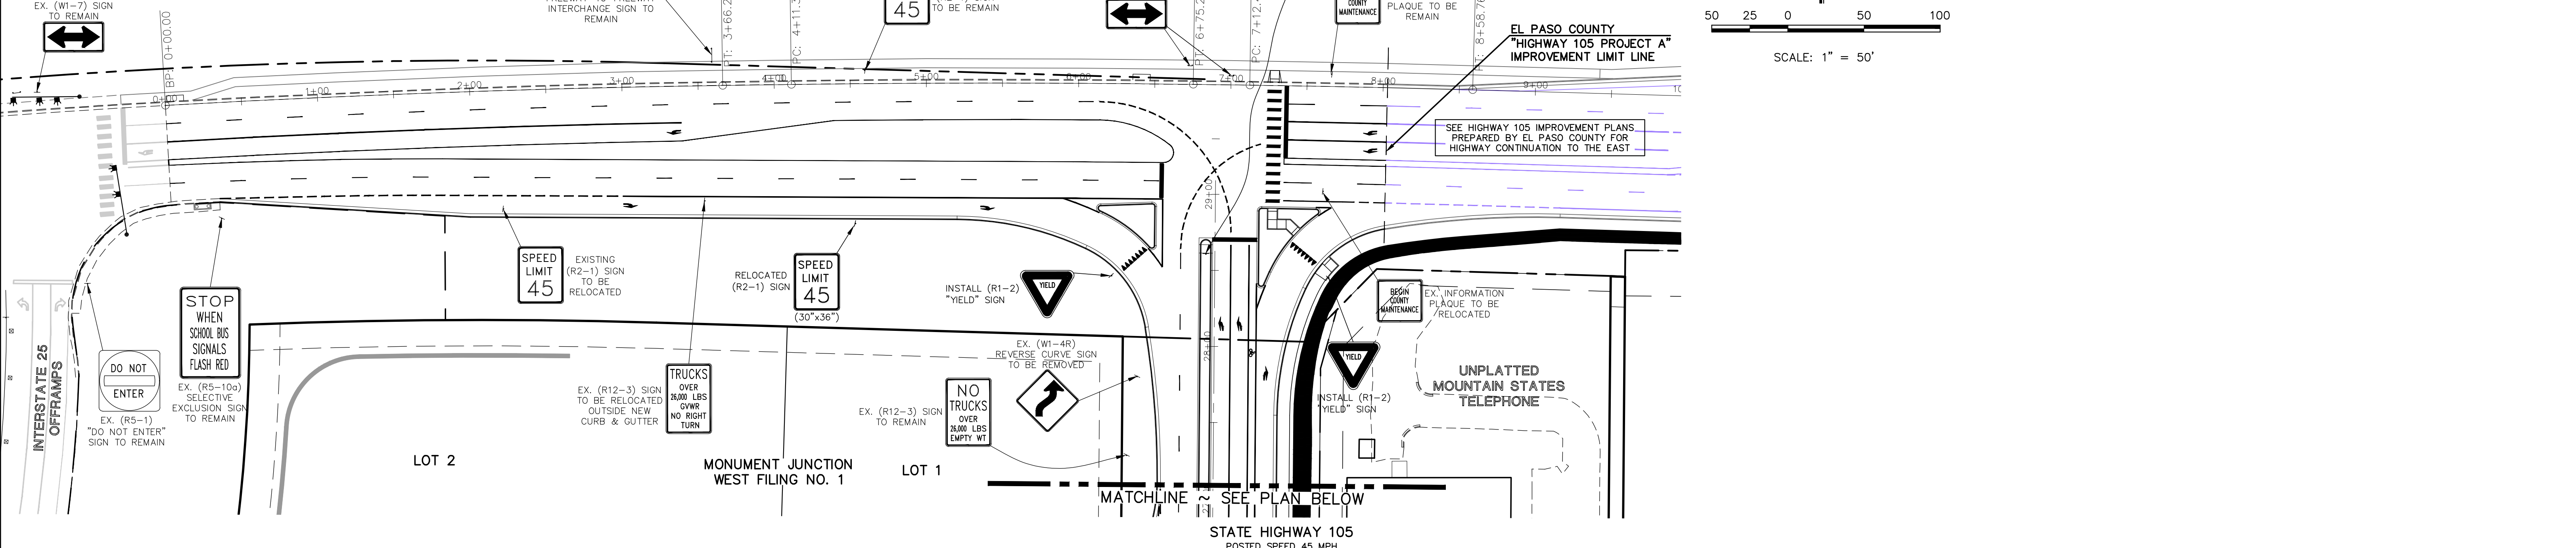

RAIL LENGTH TABLE *

TYPE	FIXED	MOVABLE	LENGTH
F - A	M - A	8' - 14'	
F - B	M - B	15' - 24'	
F - C	M - C	25' - 35'	
F - D	M - D	> 35'	

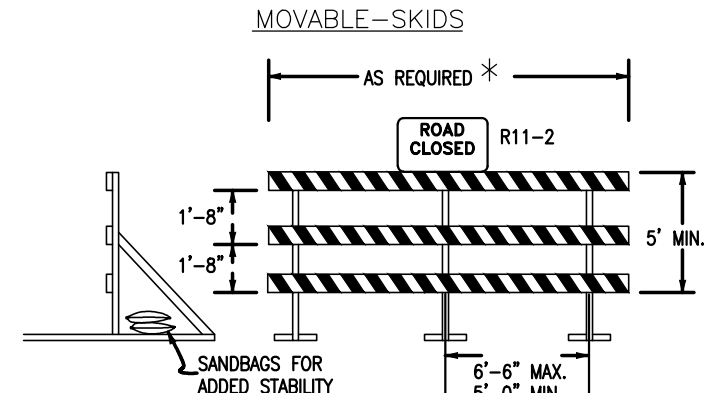

- NOTES**
- TYPE 3 BARRICADES HAVE 3 REFLECTORIZED RAIL FACES IF FACING TRAFFIC IN ONE DIRECTION AND 6 IF FACING TRAFFIC IN TWO DIRECTIONS.
 - THE PORTION OF THE POST ABOVE THE GROUND LINE SHALL BE PAINTED IN ACCORDANCE WITH THE APPROPRIATE GENERAL NOTE.
 - DETACHABLE EXTENSION WING RAILS FOR BYPASSING OF CONSTRUCTION EQUIPMENT ARE PERMITTED, WHEN NECESSARY, ON FIXED OR MOVABLE TYPE 3 BARRICADES. THE LENGTH SHALL BE ADEQUATE TO CLOSE THE SHOULDER AS REQUIRED.

TYPICAL TYPE 3 BARRICADES

48 HOURS BEFORE YOU DIG,
 CALL UTILITY LOCATORS
811
 UTILITY NOTIFICATION CENTER OF COLORADO
 ITS THE LAW

THE LOCATIONS OF EXISTING UNDERGROUND UTILITIES ARE SHOWN IN AN APPROXIMATE WAY ONLY. THE CONTRACTOR SHALL DETERMINE THE EXACT LOCATION OF ALL EXISTING UTILITIES BEFORE COMMENCING WORK. THE CONTRACTOR SHALL BE FULLY RESPONSIBLE FOR ANY AND ALL DAMAGES WHICH MIGHT BE CAUSED BY HIS FAILURE TO EXACTLY LOCATE AND PRESERVE ANY AND ALL UNDERGROUND UTILITIES.

NO.	REVISION	DATE
1	REVISED PER CDOT/COUNTY/TOWN OF MONUMENT COMMENTS	7/10/23

REVIEW:

PREPARED UNDER MY DIRECT SUPERVISION FOR AND ON BEHALF OF CLASSIC CONSULTING ENGINEERS AND SURVEYORS, LLC

MARC. A. WHORTON, COLORADO P.E. #37155

CLASSIC
 CONSULTING ENGINEERS & SURVEYORS


619 N. Cascade Avenue, Suite 200
 Colorado Springs, Colorado 80903

(719) 785-0790
 (719) 785-0799 (fax)

STATE HIGHWAY 105 / JACKSON CREEK PKWY. - PHASE 2 CONSTRUCTION PLANS
 ROADWAY IMPROVEMENT PLANS
 SIGNAGE PLAN

DESIGNED BY	PRA	SCALE	DATE	02-23-23
DRAWN BY	PRA	(H) 1" = 50'	SHEET	18 OF 26
CHECKED BY	(V) 1" = N/A	JOB NO.	1302.22	

N:\130222\DRAWINGS\CONSTRUCTION\DWG\18-SIGNAGE-01.dwg, 7/14/2023 10:46:29 AM, mrogon, 11

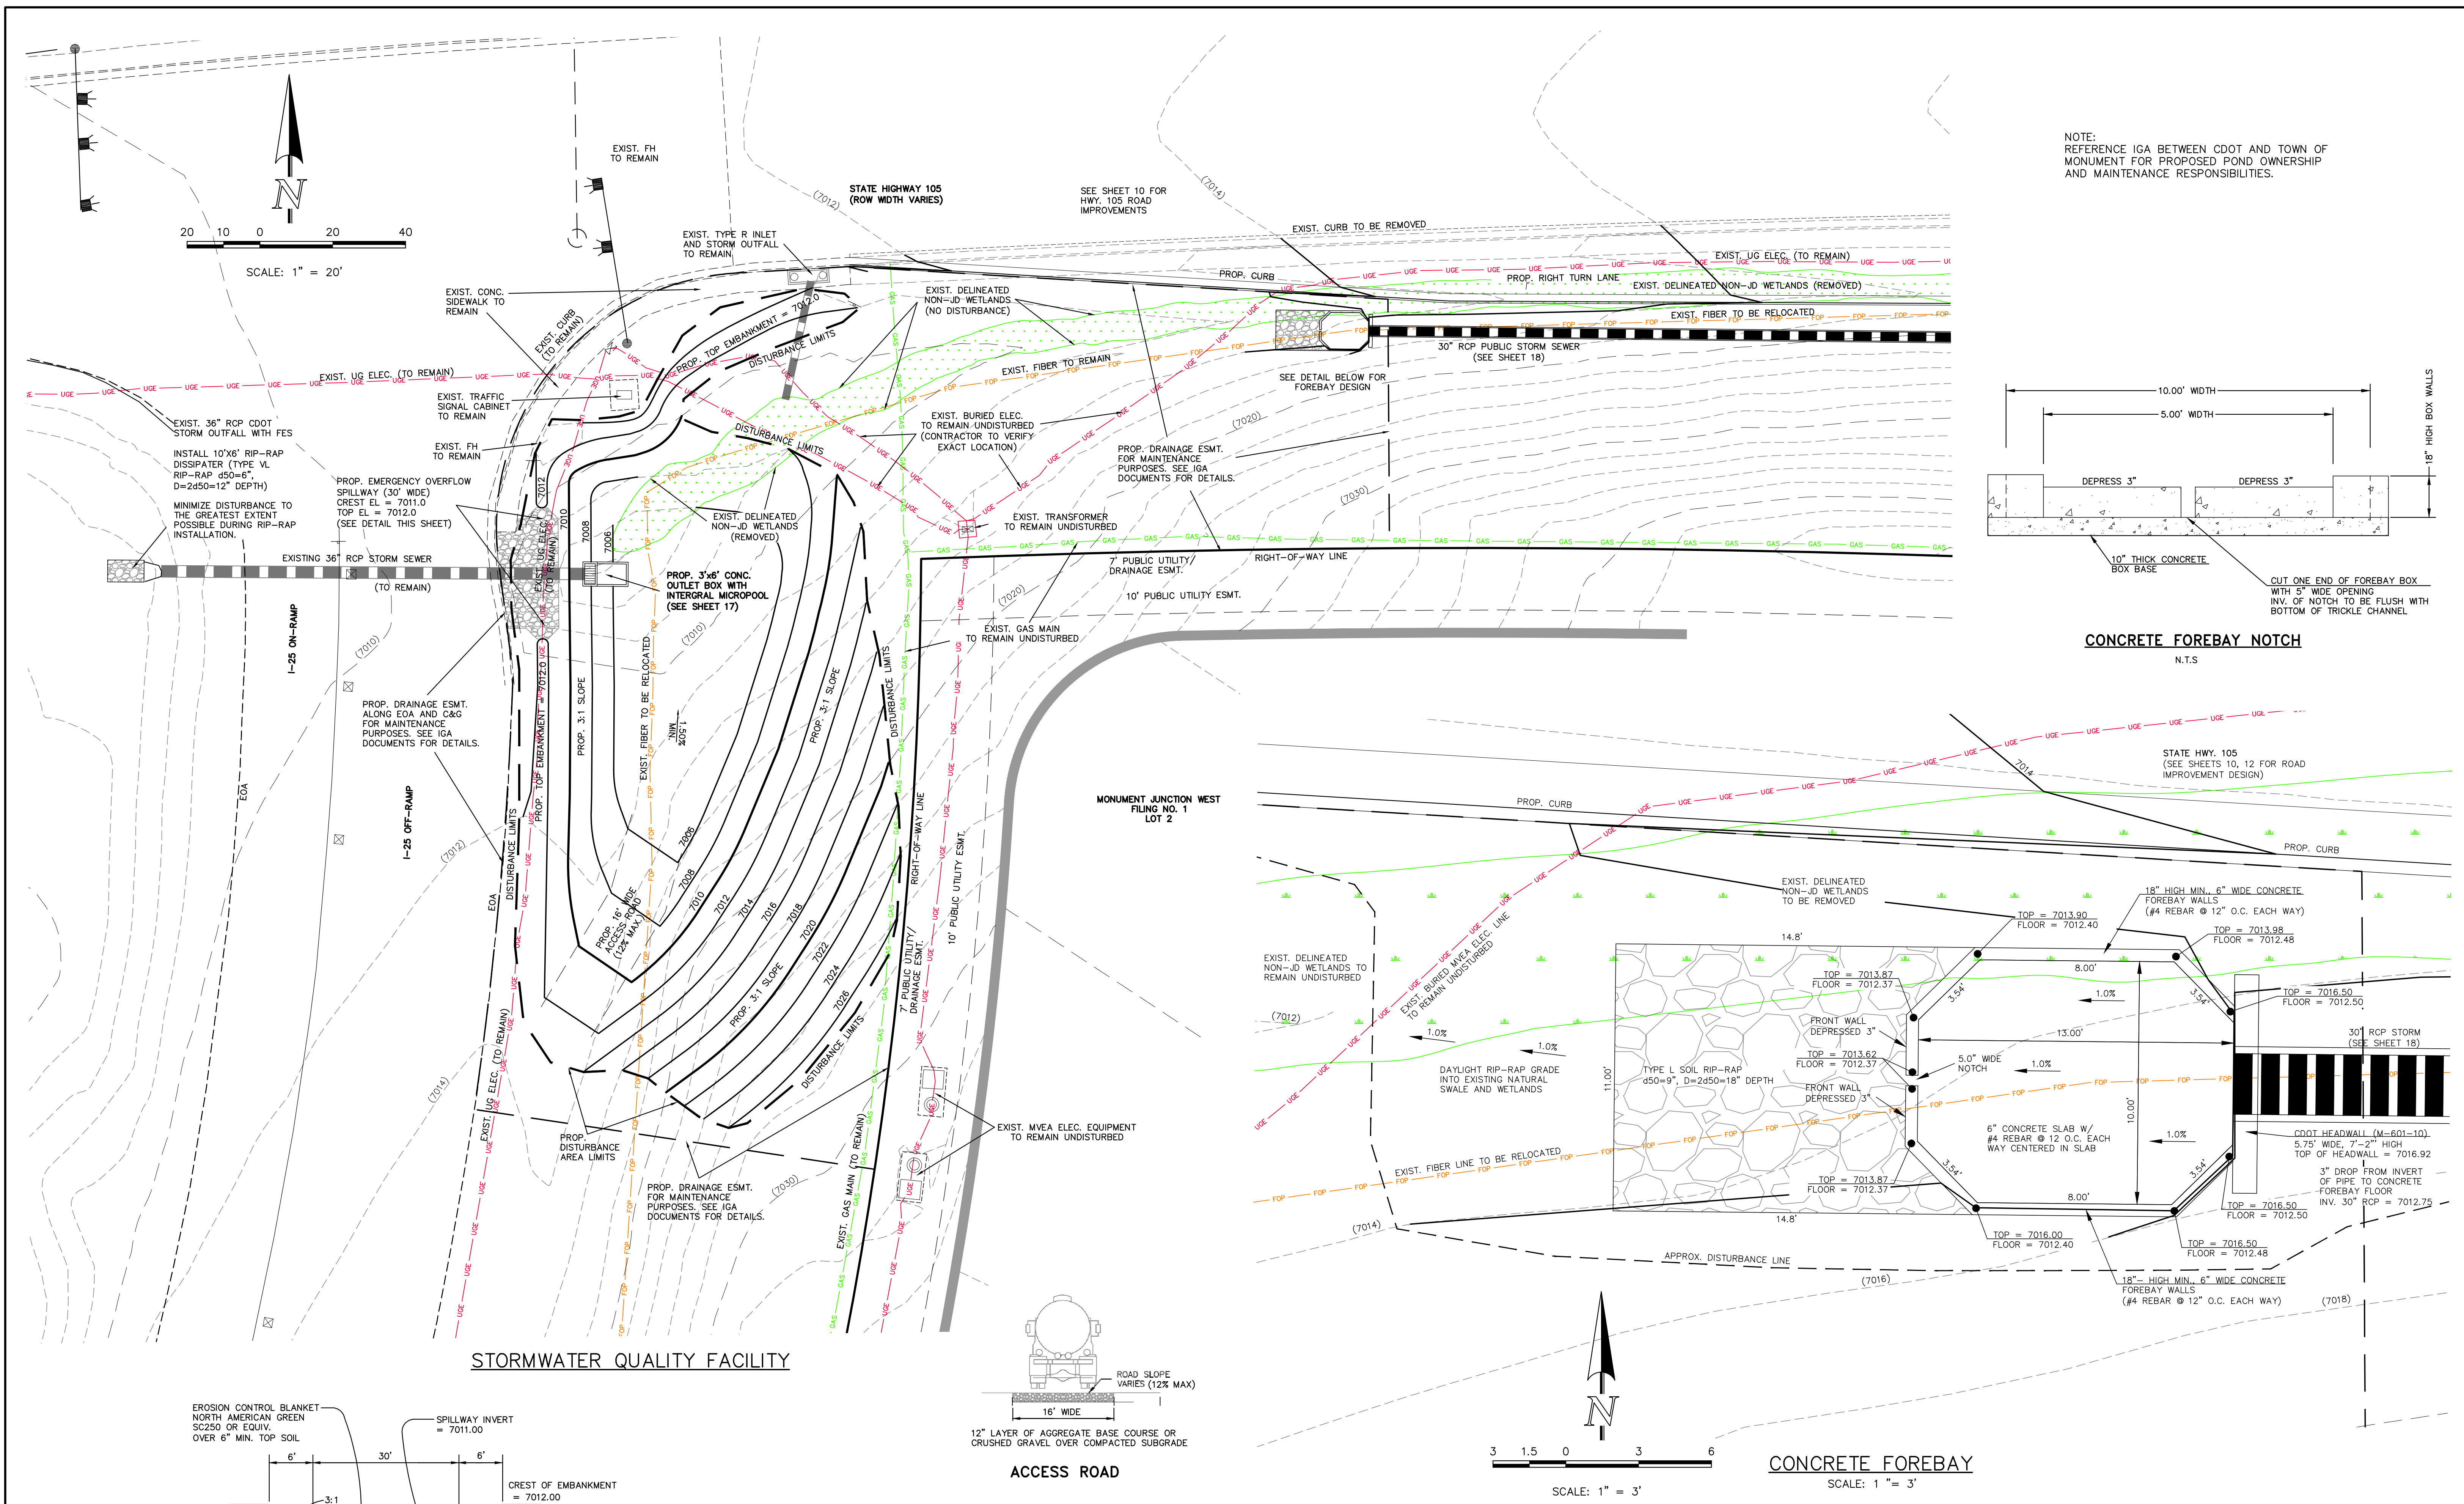


V:\13022\DRAWINGS\CD\STRUCT\CON\SHW1-19-2010-01.dwg, 7/20/2013 11:19:00 AM, MWhorton, 1-1

48 HOURS BEFORE YOU DIG, CALL UTILITY LOCATORS 811 UTILITY NOTIFICATION CENTER OF COLORADO IT'S THE LAW		NO. REVISION 1 REVISED PER CDOT/COUNTY/TOWN OF MONUMENT COMMENTS DATE 7/10/23	REVIEW: PREPARED UNDER MY DIRECT SUPERVISION FOR AND ON BEHALF OF CLASSIC CONSULTING ENGINEERS AND SURVEYORS, LLC MARC A. WHORTON, COLORADO P.E. #37155 DATE
--	--	--	---


CLASSIC
 CONSULTING ENGINEERS & SURVEYORS
 619 N. Cascade Avenue, Suite 200
 Colorado Springs, Colorado 80903
 (719) 785-0790
 (719) 785-0799 (Fax)

STATE HIGHWAY 105 / JACKSON CREEK PKWY. - PHASE 2 CONSTRUCTION PLANS STORMWATER QUALITY FACILITY POND PLAN AND FOREBAY DETAIL			
DESIGNED BY	MAW	SCALE	DATE 02-23-23
DRAWN BY	MAW	(H) 1" = 20'	SHEET 19 OF 26
CHECKED BY	(V) 1" = N/A	JOB NO.	1302.22

THE LOCATIONS OF EXISTING UNDERGROUND UTILITIES ARE SHOWN IN AN APPROXIMATE WAY ONLY. THE CONTRACTOR SHALL DETERMINE THE EXACT LOCATION OF ALL EXISTING UTILITIES BEFORE COMMENCING WORK. THE CONTRACTOR SHALL BE FULLY RESPONSIBLE FOR ANY AND ALL DAMAGES WHICH MIGHT BE CAUSED BY HIS FAILURE TO EXACTLY LOCATE AND PRESERVE ANY AND ALL UNDERGROUND UTILITIES.

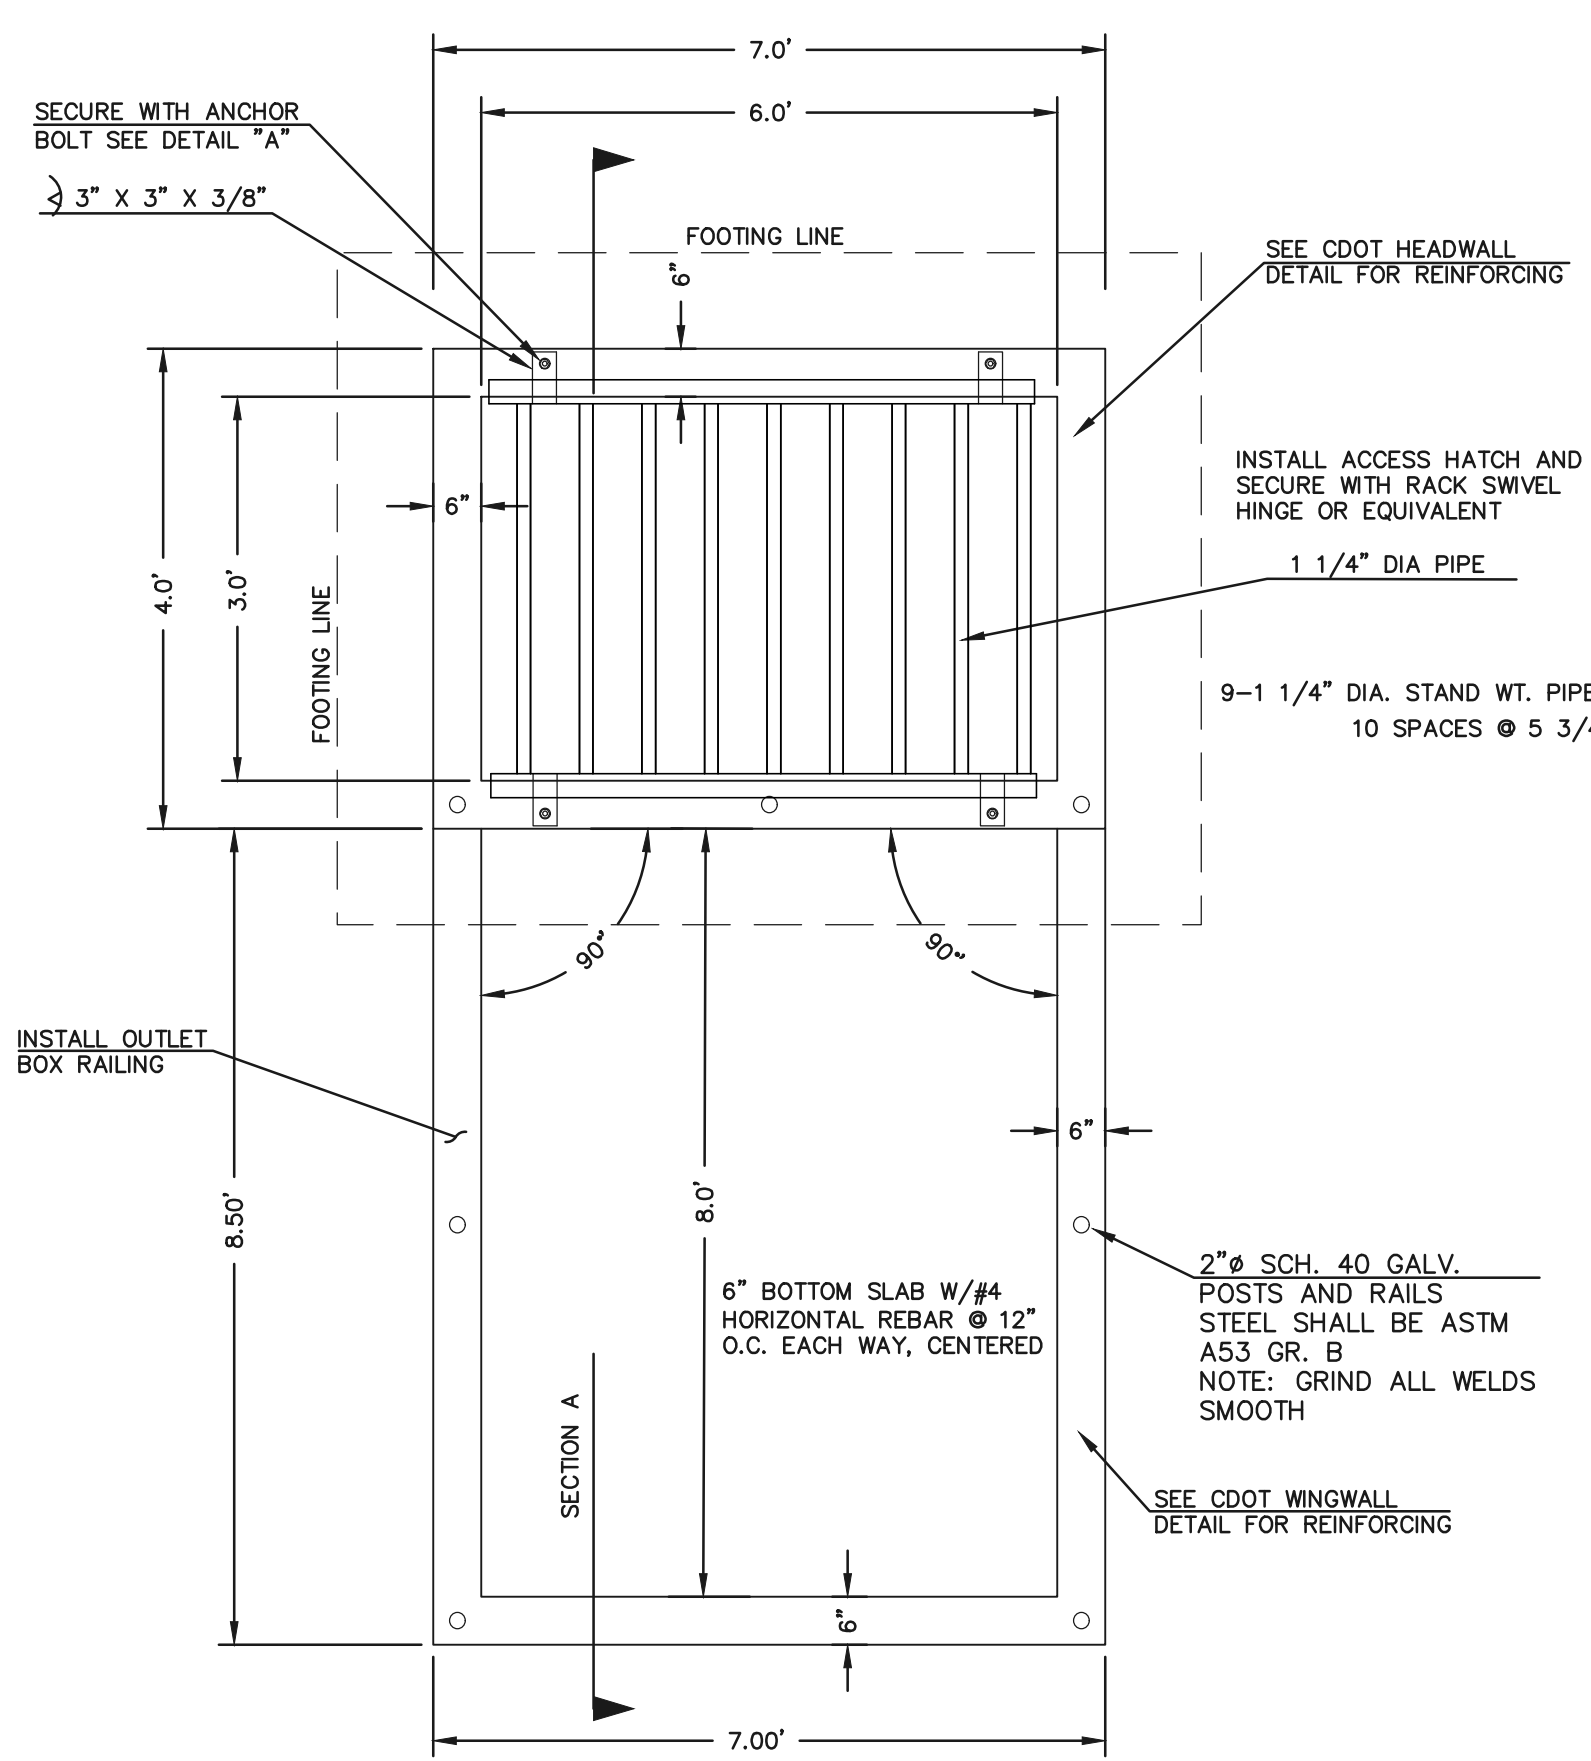




CONCRETE MICROPOOL
SCALE 1" = 2'

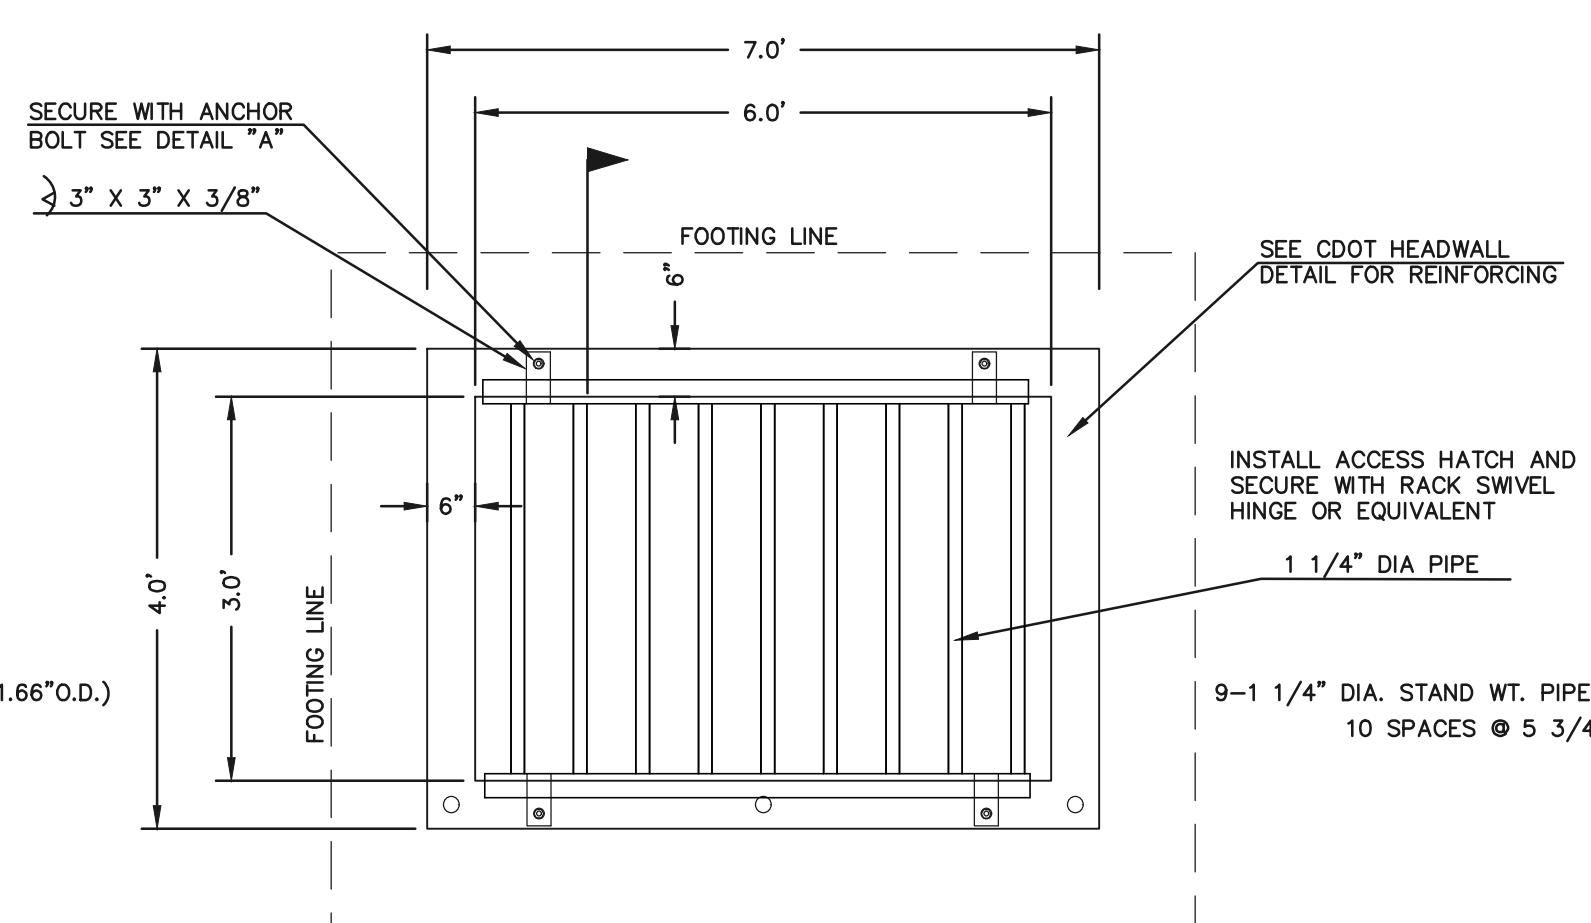


3'x6' OUTLET BOX OVERFLOW TRASH RACK
SCALE 1" = 2'

NOTES:

1. WELD PLATES EMBEDS MAY BE SUBSTITUTED. DESIGN CRITERIA SHALL BE IN ACCORDANCE WITH AASHTO STANDARDS.
2. HANDRAIL DESIGN SHALL BE COMPATIBLE WITH THE DESIGN OF THE WINGWALLS AND HEADWALLS. RAILING POSTS SHALL BE SET TO NORMAL TO GRADE. RAILS SHALL RUN PARALLEL TO THE SLOPES OF TOPS OF THE WALLS.
3. ALL RAILS SHALL HAVE EXPANSION JOINTS SPACED AT 40'-0" MAX. JOINT ENDS SHALL BE FREE OF ANY SHARP EDGES OR CORNERS.

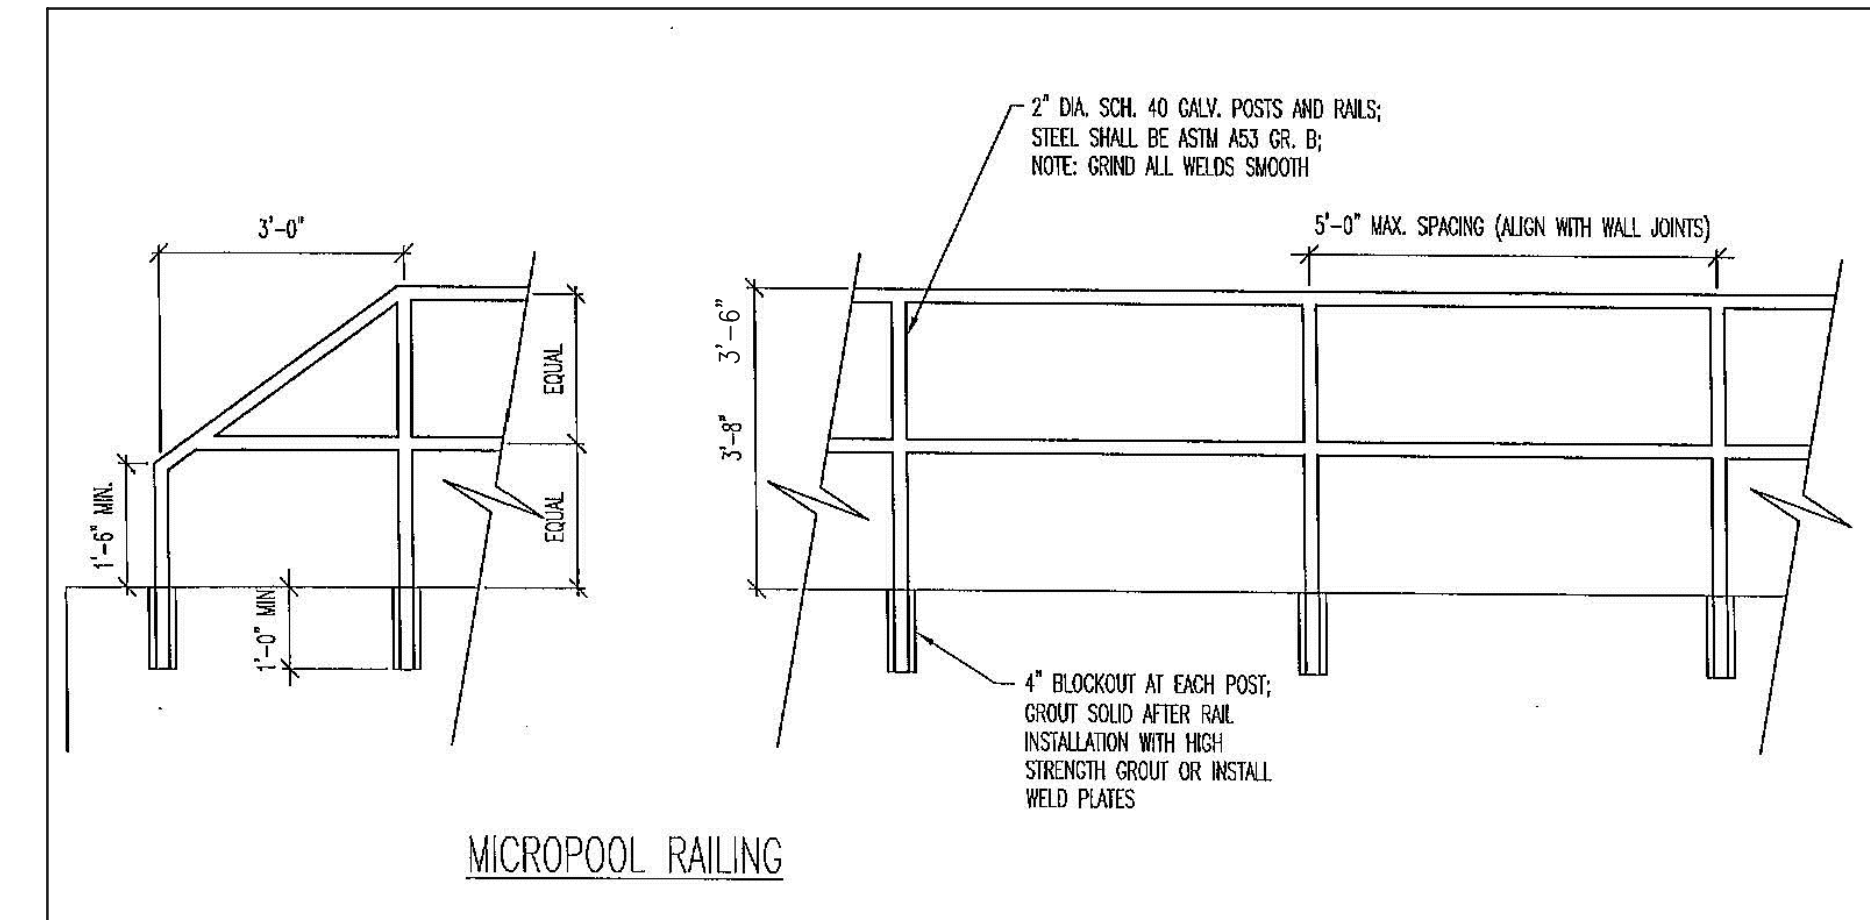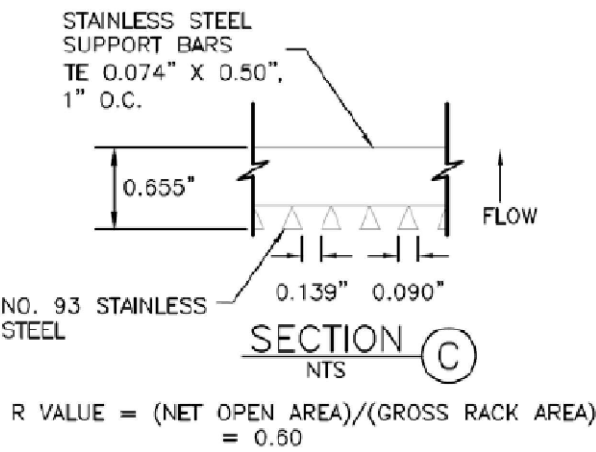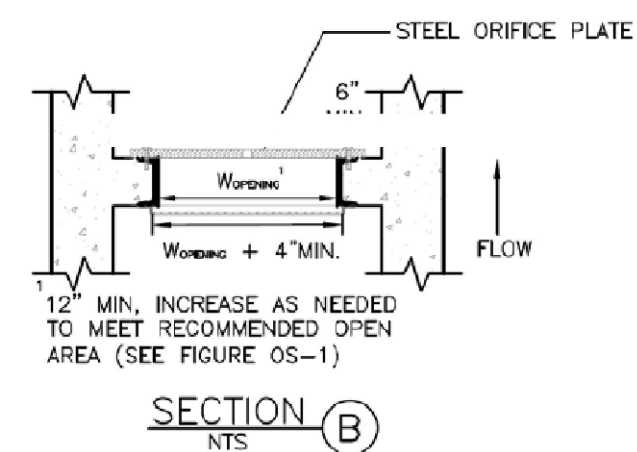

OUTLET BOX RAILING
N.T.S.

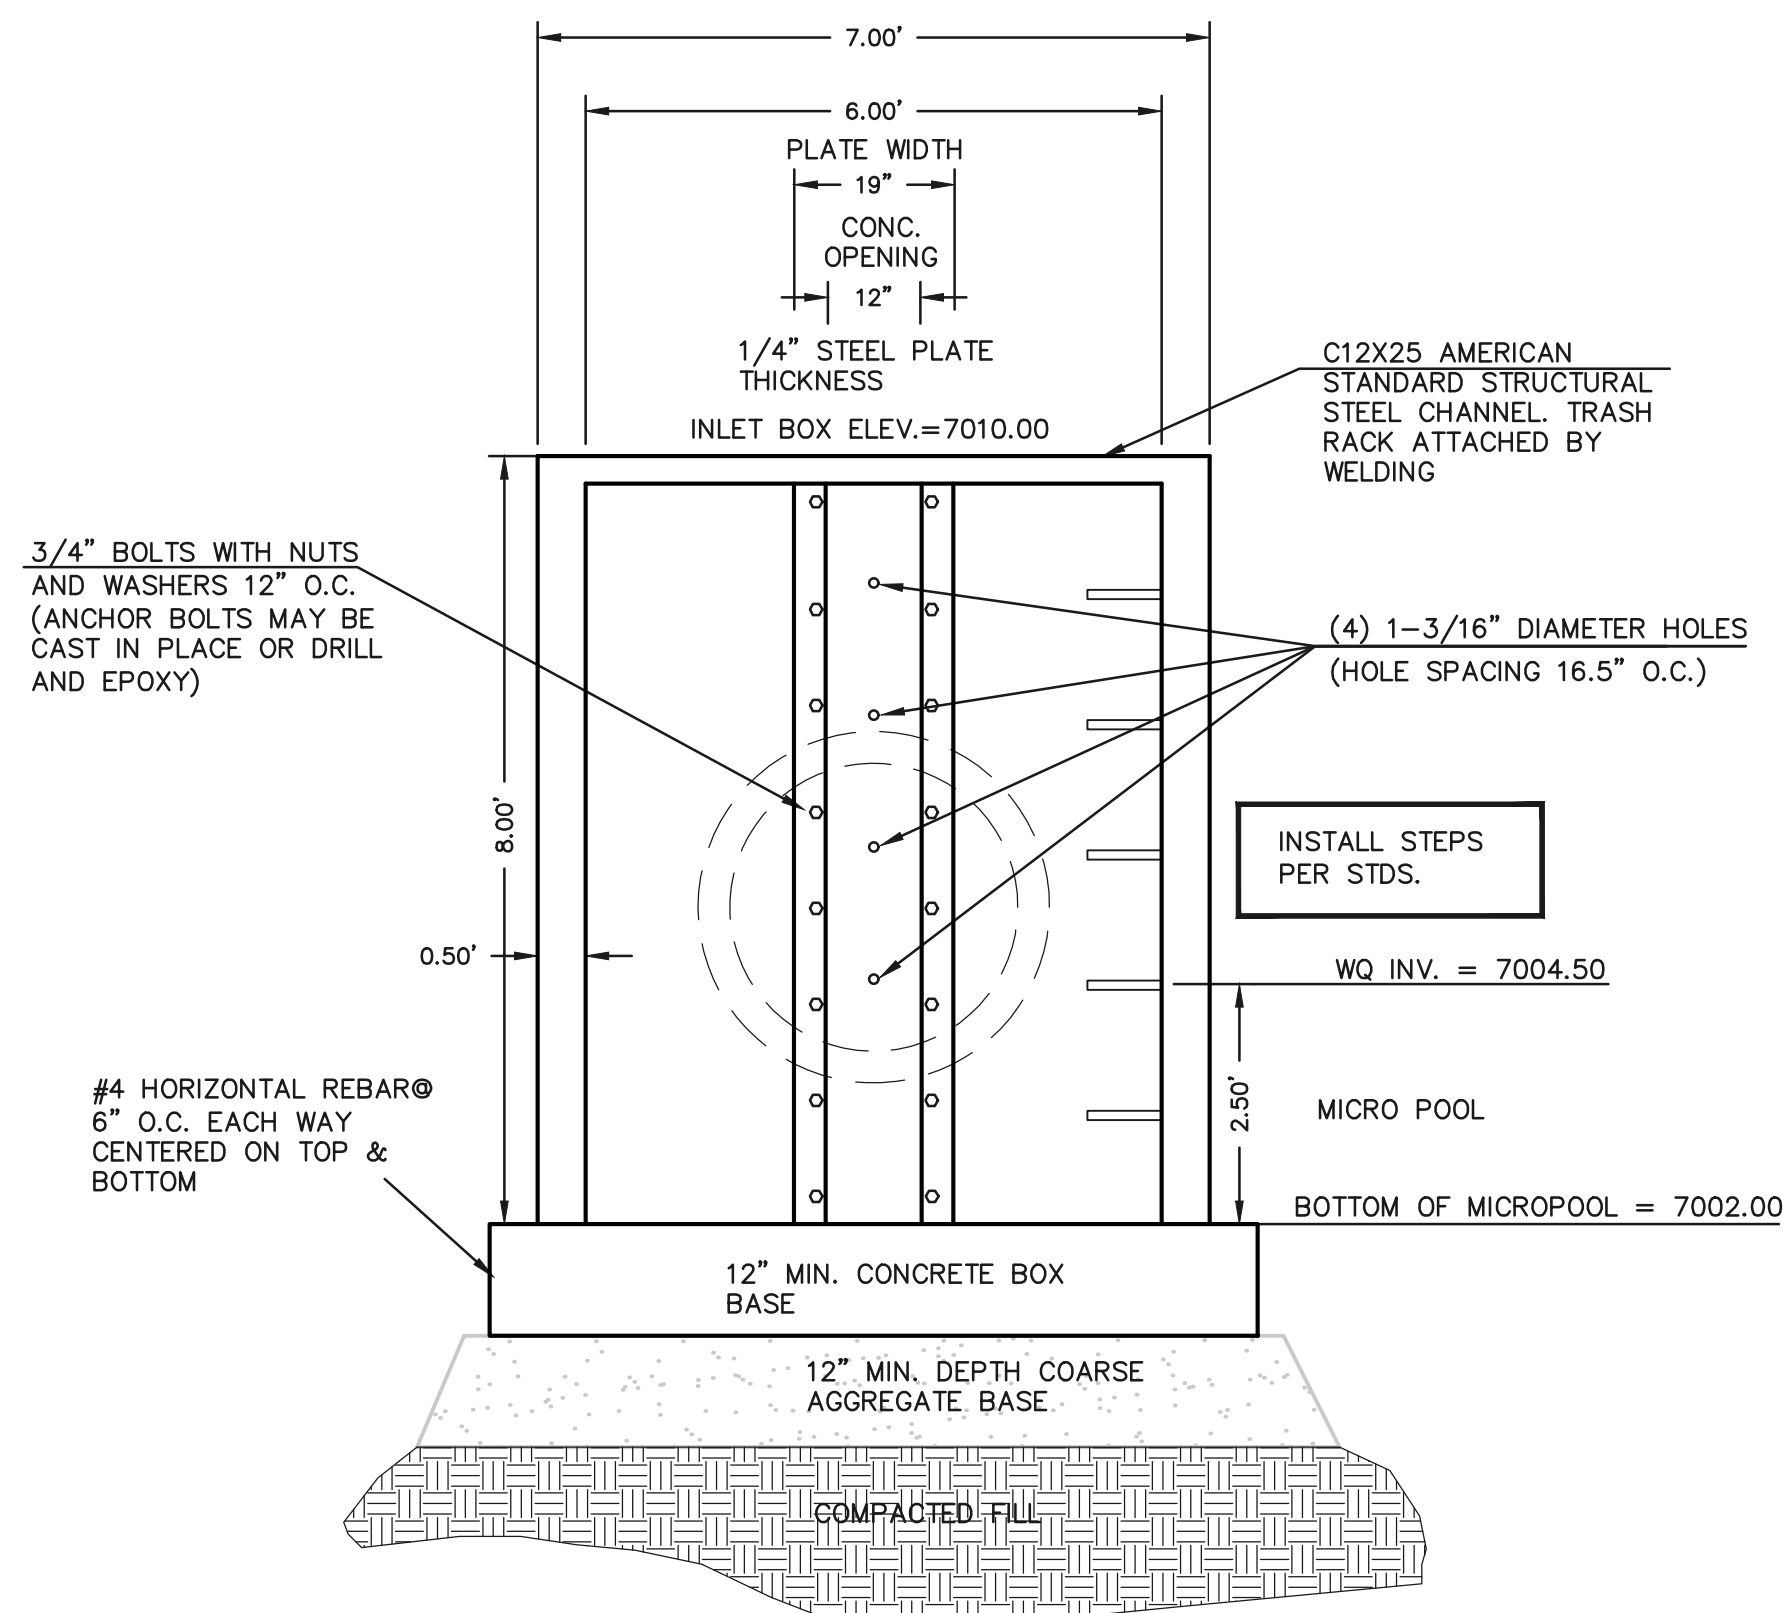

3'x6' OUTLET BOX ORIFICE PLATE
SCALE 1" = 2'


(ALL MATERIALS PER CDOT SPECIFICATIONS)

ORIFICE PLATE NOTES:

1. INSTALL HOLES AS SHOWN ON DETAIL TO LEFT.
2. PROVIDE GASKET MATERIAL BETWEEN THE ORIFICE PLATE AND CONCRETE
3. ALL STAINLESS STEEL USED TO BE GALVANIZED.
4. WELL-SCREEN TRASH RACKS SHALL BE STAINLESS STEEL AND SHALL BE ATTACHED BY INTERMITTENT WELDS ALONG THE EDGE OF THE MOUNTING FRAME.
5. BAR GRATE TRASH RACKS SHALL BE ALUMINUM AND SHALL BE BOLTED USING STAINLESS STEEL HARDWARE.
6. STRUCTURAL DESIGN OF TRASH RACKS SHALL BE BASED ON FULL HYDROSTATIC HEAD WITH ZERO HEAD DOWNSTREAM OF RACK

OVERFLOW TRASH RACKS:


1. ALL TRASH RACKS SHALL BE MOUNTED USING STAINLESS STEEL HARDWARE AND PROVIDED WITH HINGED AND LOCKABLE OR BOLTABLE ACCESS PANELS.
2. TRASH RACKS SHALL BE STAINLESS STEEL, ALUMINUM, OR STEEL. TRASH RACKS SHALL BE HOT DIP GALVANIZED AND MAY BE HOT POWDER COATED AFTER GALVANIZING.
3. TRASH RACKS SHALL BE DESIGNED SUCH THAT THE DIAGONAL DIMENSION OF EACH OPENING IS SMALLER THAN THE DIAMETER OF THE OUTLET PIPE.
4. STRUCTURAL DESIGN OF THE TRASH RACKS SHALL BE BASED ON FULL HYDROSTATIC HEAD WITH ZERO HEAD DOWNSTREAM OF THE RACK.

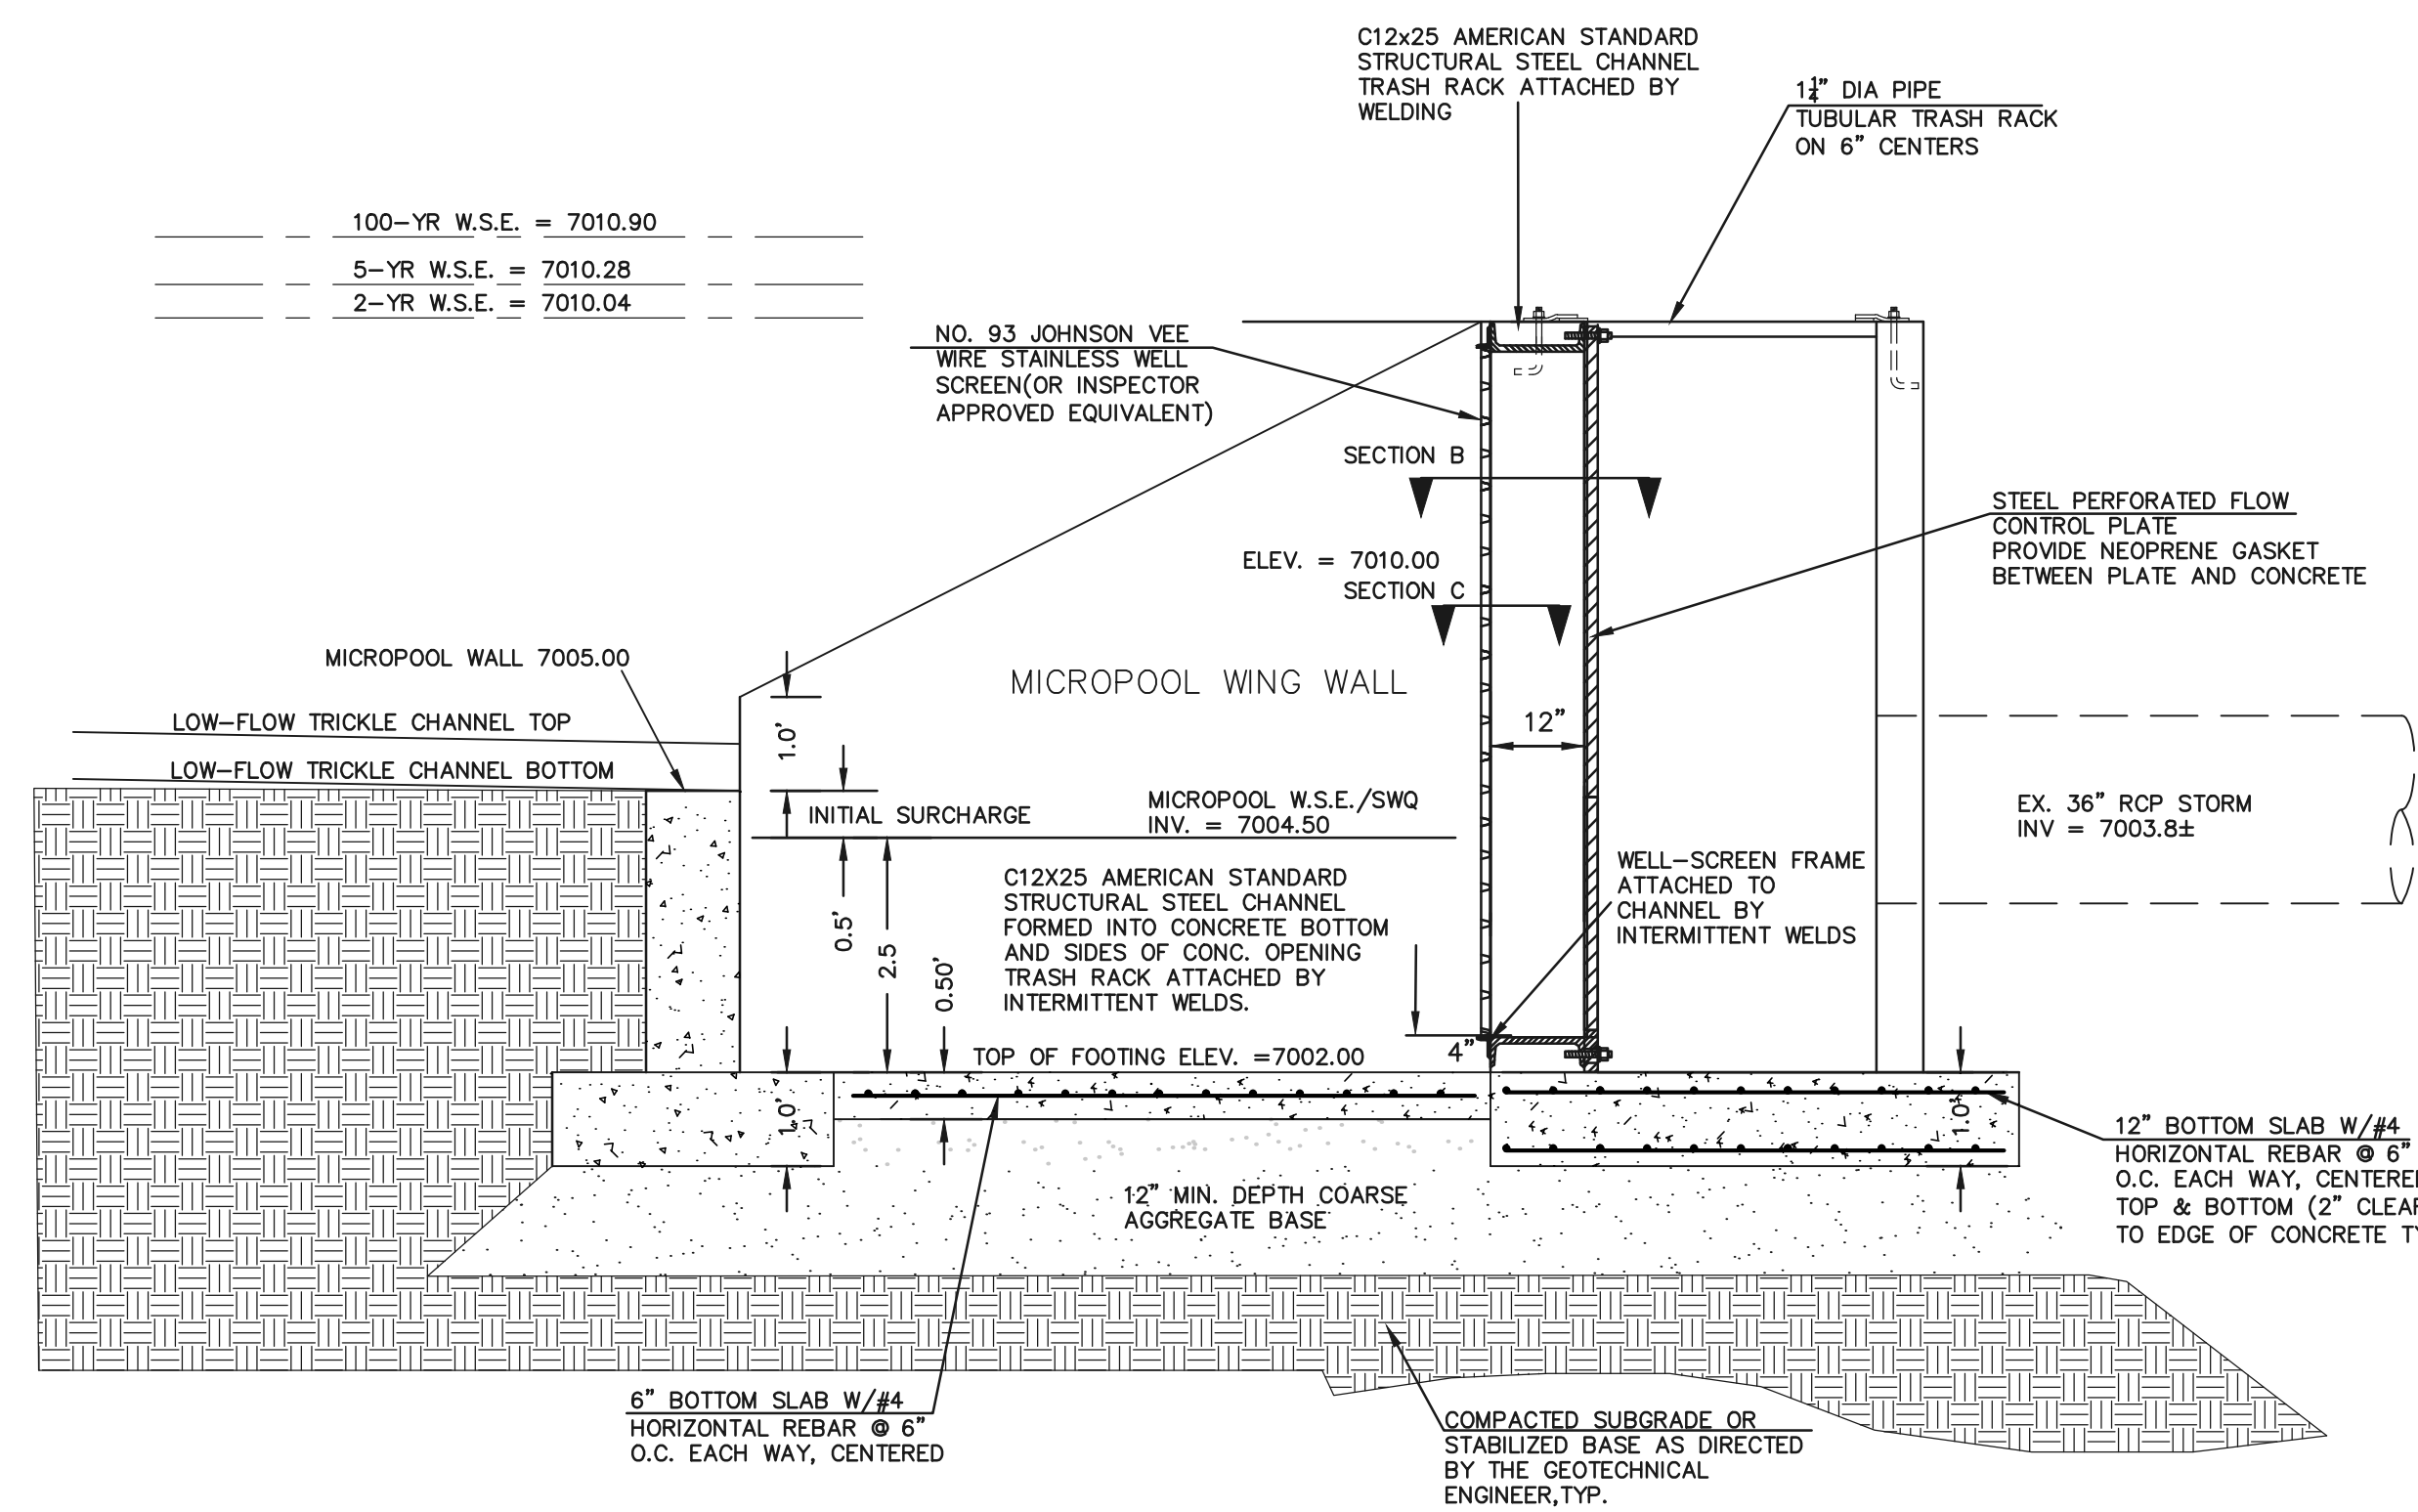

3'x6' OUTLET BOX MICRO POOL SECTION A
SCALE 1" = 2'



<p>48 HOURS BEFORE YOU DIG, CALL UTILITY LOCATORS</p> <p>811</p> <p>UTILITY NOTIFICATION CENTER OF COLORADO IT'S THE LAW</p> <p>THE LOCATIONS OF EXISTING UNDERGROUND UTILITIES ARE SHOWN IN AN APPROXIMATE WAY ONLY. THE CONTRACTOR SHALL DETERMINE THE EXACT LOCATION OF ALL EXISTING UTILITIES BEFORE COMMENCING WORK. THE CONTRACTOR SHALL BE FULLY RESPONSIBLE FOR ANY AND ALL DAMAGES WHICH MIGHT BE CAUSED BY HIS FAILURE TO EXACTLY LOCATE AND PRESERVE ANY AND ALL UNDERGROUND UTILITIES.</p>	<p>NO. REVISION</p> <p>1 REVISED PER CDOT/COUNTY/TOWN OF MONUMENT COMMENTS</p>	<p>DATE</p> <p>7/10/23</p>	<p>REVIEW:</p> <p>PREPARED UNDER MY DIRECT SUPERVISION FOR AND ON BEHALF OF CLASSIC CONSULTING ENGINEERS AND SURVEYORS, LLC</p> <p>MARC A. WHORTON, COLORADO P.E. #37155</p>	<p>STATE HIGHWAY 105 / JACKSON CREEK PKWY. - PHASE 2 CONSTRUCTION PLANS</p> <p>STORMWATER QUALITY FACILITY</p> <p>OUTLET BOX DETAILS</p> <p>DESIGNED BY MAW SCALE DATE 02-23-23</p> <p>DRAWN BY PRA (H) 1"= N/A SHEET 20 OF 26</p> <p>CHECKED BY (V) 1"= N/A JOB NO. 1302.22</p>
	<p>CLASSIC CONSULTING ENGINEERS & SURVEYORS</p> <p>619 N. Cascade Avenue, Suite 200 Colorado Springs, Colorado 80903 (719)785-0790 (719)785-0799(Fax)</p>			

V:\130222\DRAWINGS\CONSTRUCT\CON\SH105-20-000-02.dwg, 7/20/2023 11:20:50 AM, MWhorton, 1:1

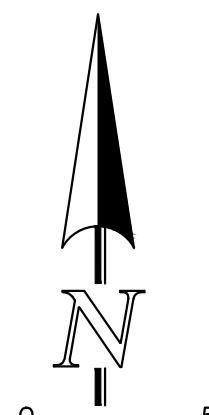

50 25 0 50 100
SCALE: 1" = 50'

THE UNDERGROUND STORM LAYOUT IS VERY DIFFERENT THAN PREVIOUSLY DISCUSSED AND DOES NOT TIE INTO THE HWY 105A PROJECT. FURTHER COORDINATION WITH THE HWY 105 PROJECT IS REQUIRED PRIOR TO CONSIDERATION OF THIS LAYOUT AND DETERMINATION OF RESPONSIBILITIES!

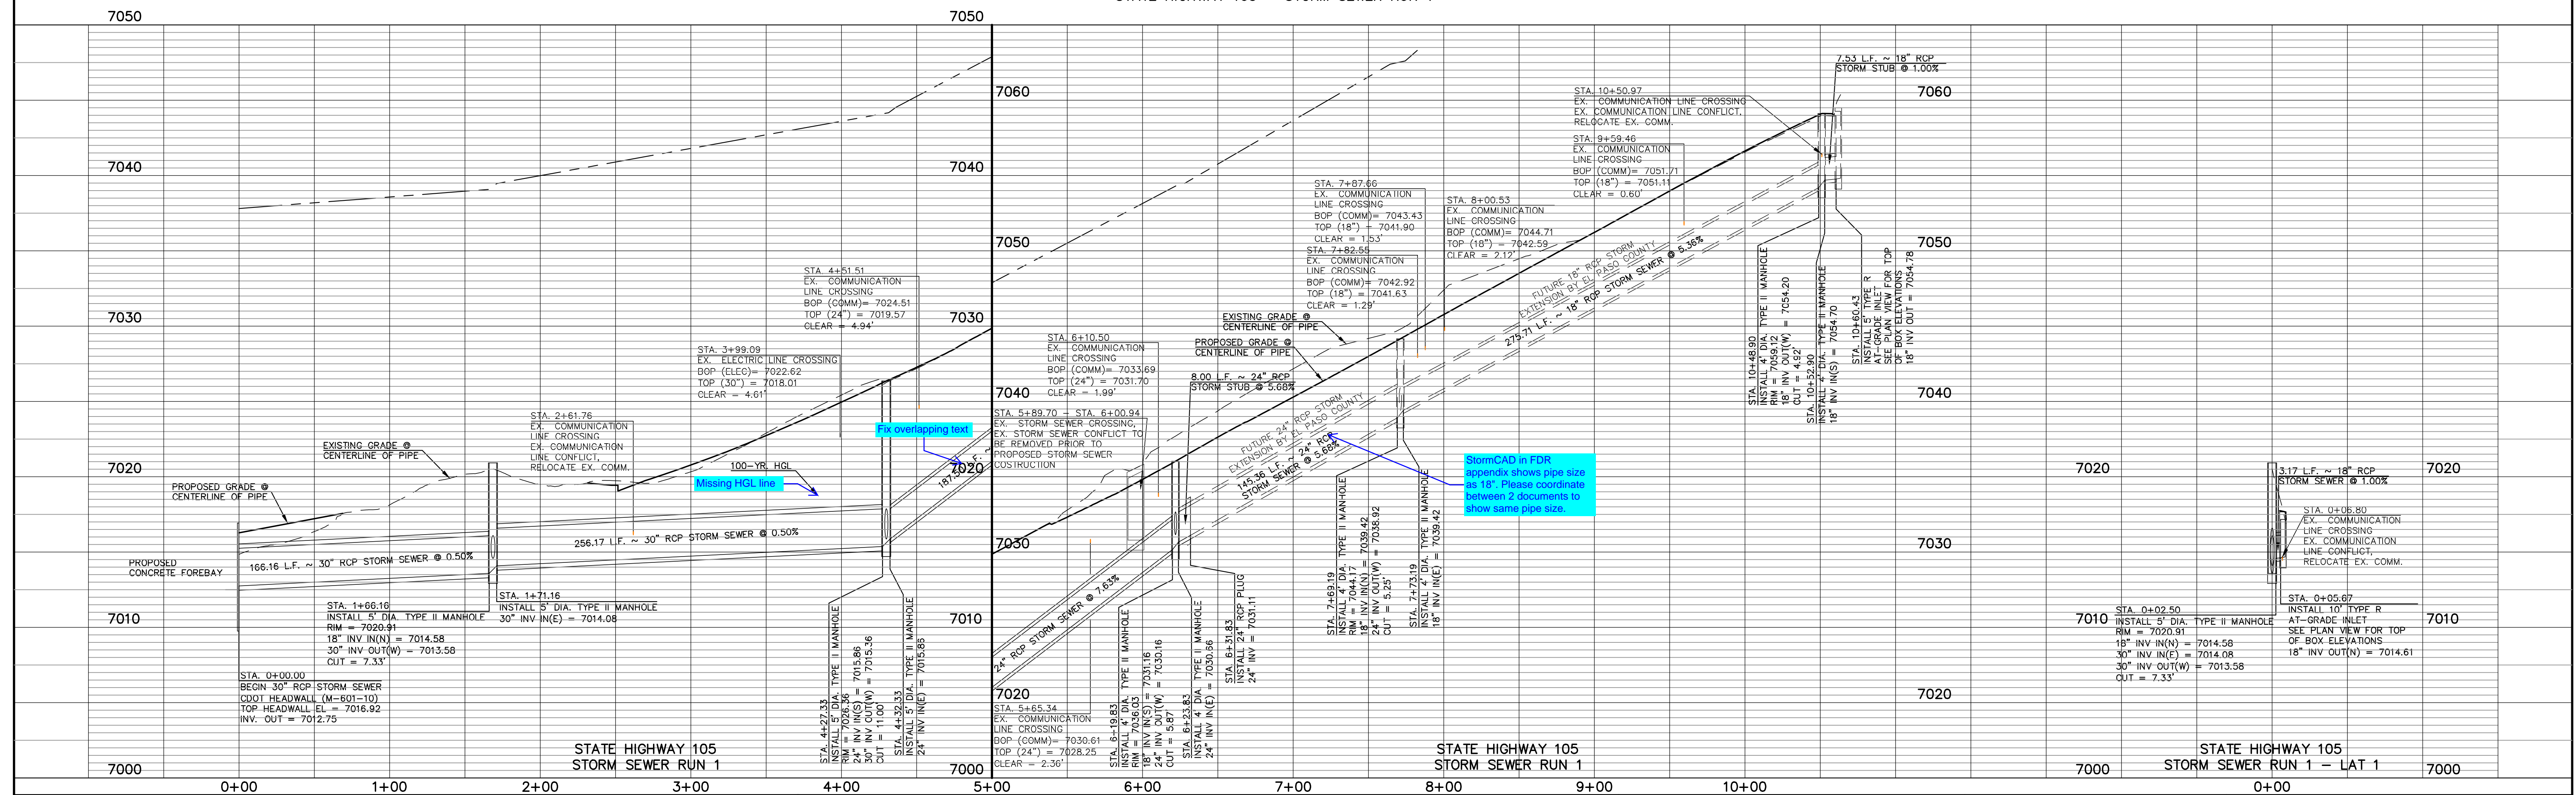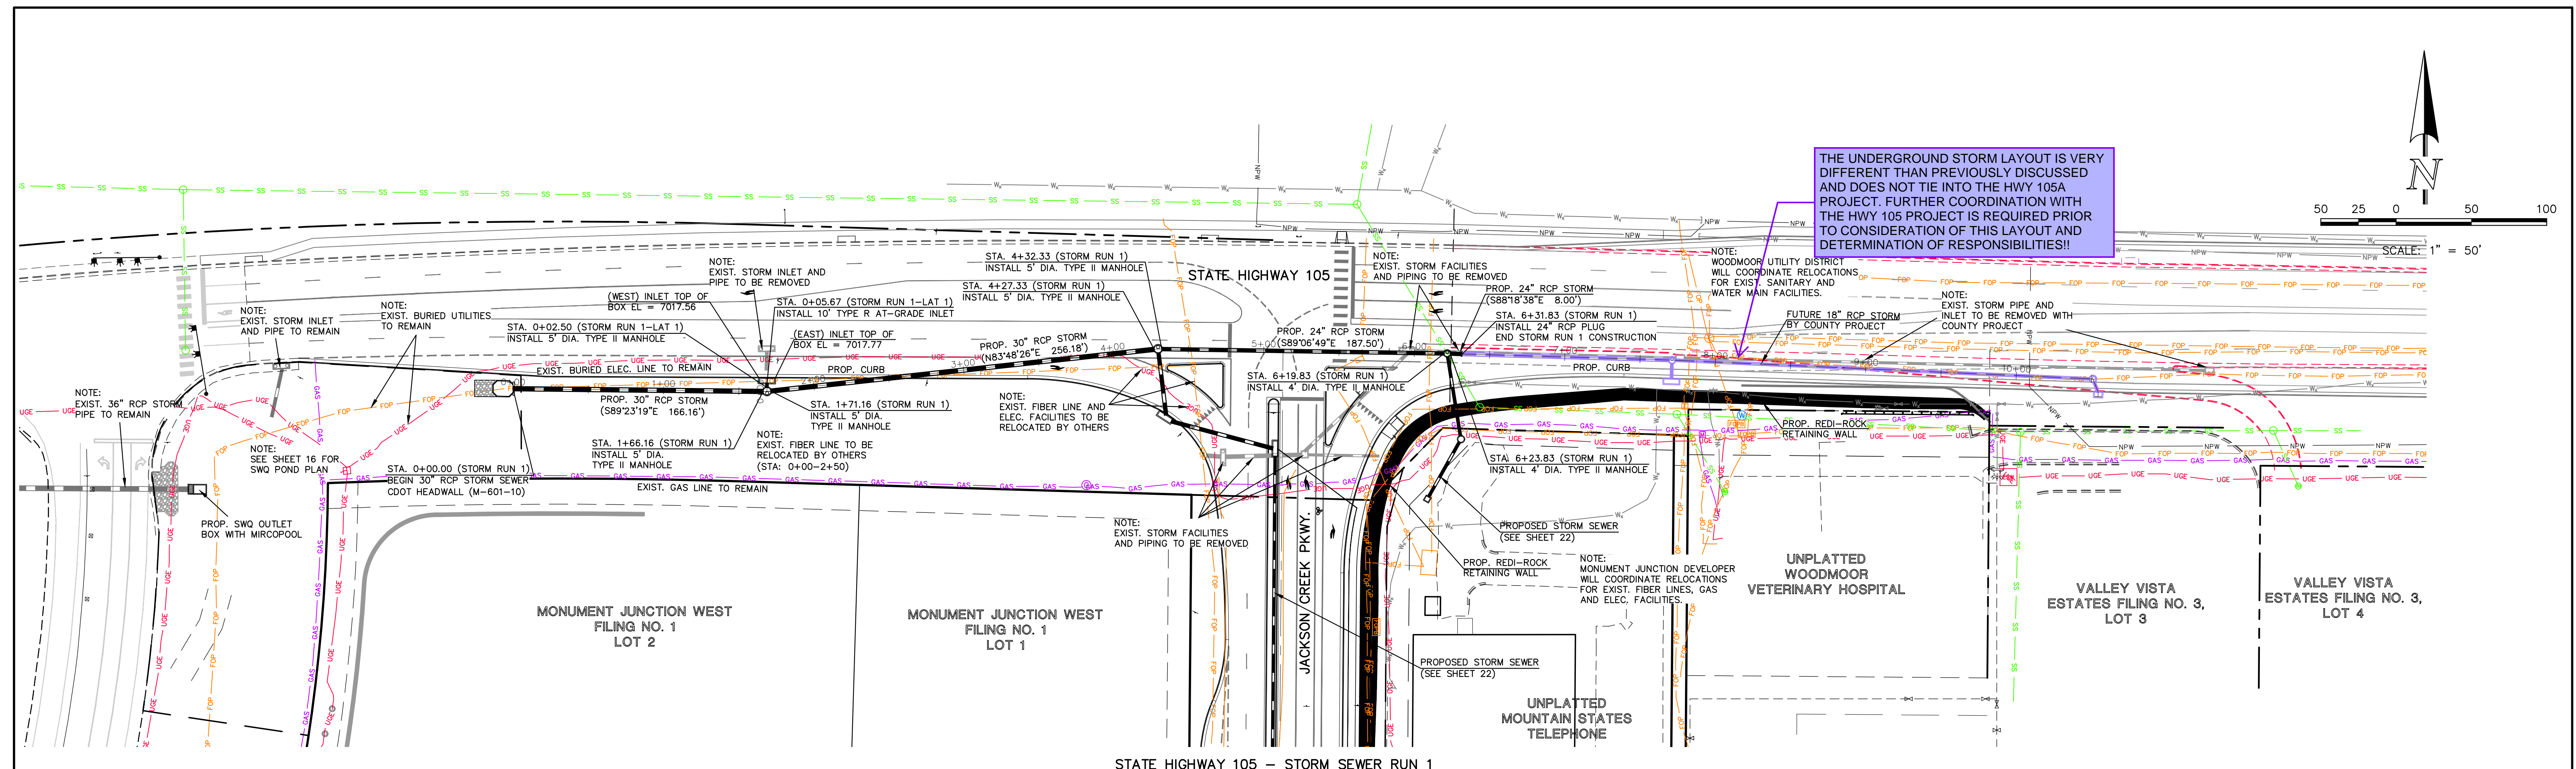

7050
7040
7030
7020
7010
7000

0+00 1+00 2+00 3+00 4+00 5+00 6+00 7+00 8+00 9+00 10+00

STATE HIGHWAY 105 STORM SEWER RUN 1

NO.	REVISION	DATE
1	REVISED PER CDOT/COUNTY/TOWN OF MONUMENT COMMENTS	7/10/23

48 HOURS BEFORE YOU DIG,
CALL UTILITY LOCATORS
811
UTILITY NOTIFICATION CENTER OF COLORADO
ITS THE LAW

THE LOCATIONS OF EXISTING UNDERGROUND UTILITIES ARE SHOWN IN AN APPROXIMATE WAY ONLY. THE CONTRACTOR SHALL DETERMINE THE EXACT LOCATION OF ALL EXISTING UTILITIES BEFORE COMMENCING WORK. THE CONTRACTOR SHALL BE FULLY RESPONSIBLE FOR ANY AND ALL DAMAGES WHICH MIGHT BE CAUSED BY HIS FAILURE TO EXACTLY LOCATE AND PRESERVE ANY AND ALL UNDERGROUND UTILITIES.

REVIEW:

PREPARED UNDER MY DIRECT SUPERVISION FOR AND ON BEHALF OF CLASSIC CONSULTING ENGINEERS AND SURVEYORS, LLC

MARC. A. WHORTON, COLORADO P.E. #37155 DATE


619 N. Cascade Avenue, Suite 200
Colorado Springs, Colorado 80903 (719)785-0790
(719)785-0799(fax)

STATE HIGHWAY 105 / JACKSON CREEK PKWY. - PHASE 2 CONSTRUCTION PLANS



STORM SEWER PLAN & PROFILE

DESIGNED BY	PRA	SCALE	DATE
DRAWN BY	PRA	(H) 1" = 50'	SHEET 21 OF 26
CHECKED BY	(V) 1" = 5'	JOB NO.	1302.22



N:\130222\PARAMICS\CONSTRUC\DON\STATE-21-STORM-01.dwg, 7/14/2023 10:33:11 AM, rmpgms, 1:1

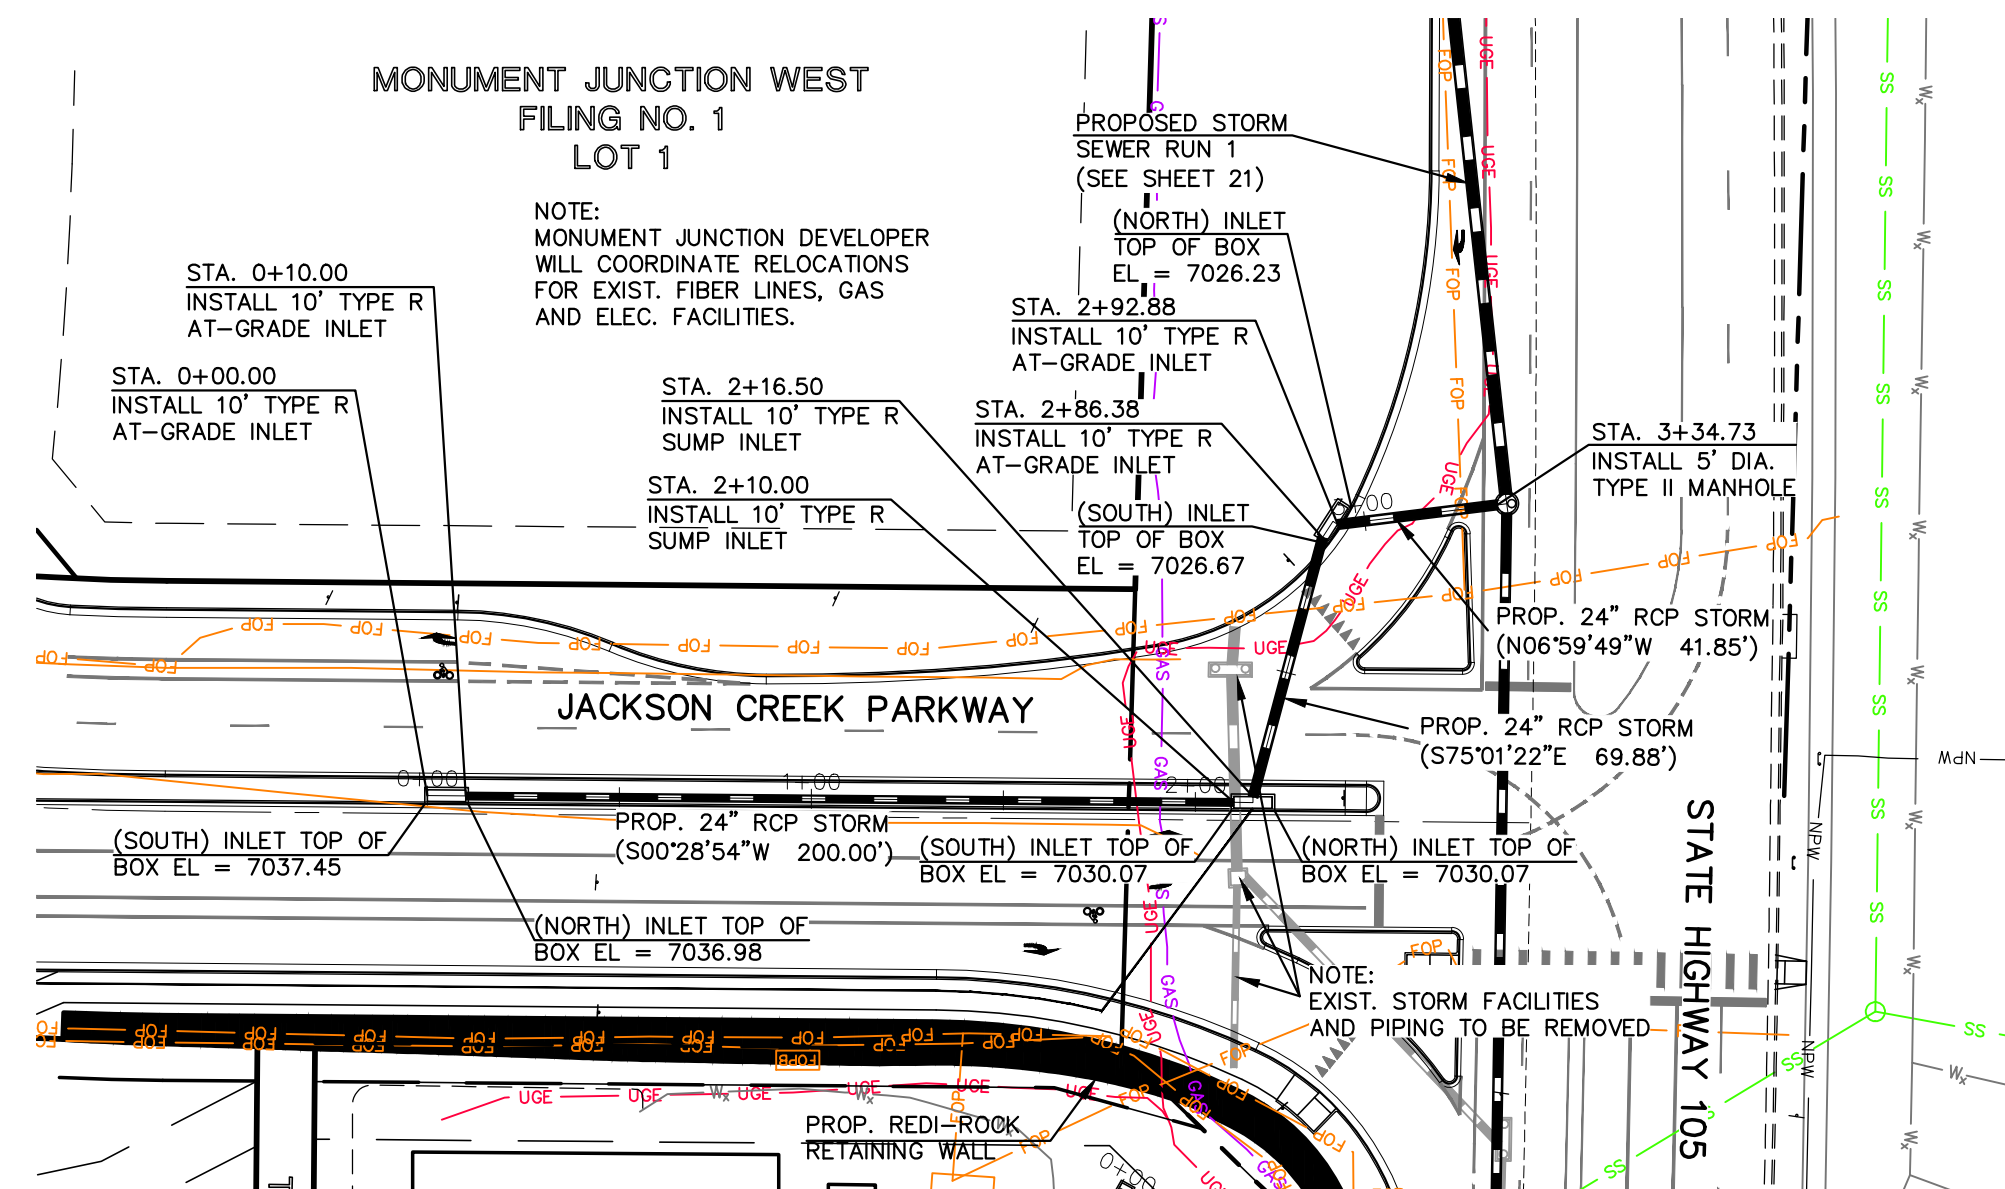


STATE HIGHWAY 105
STORM SEWER RUN-2

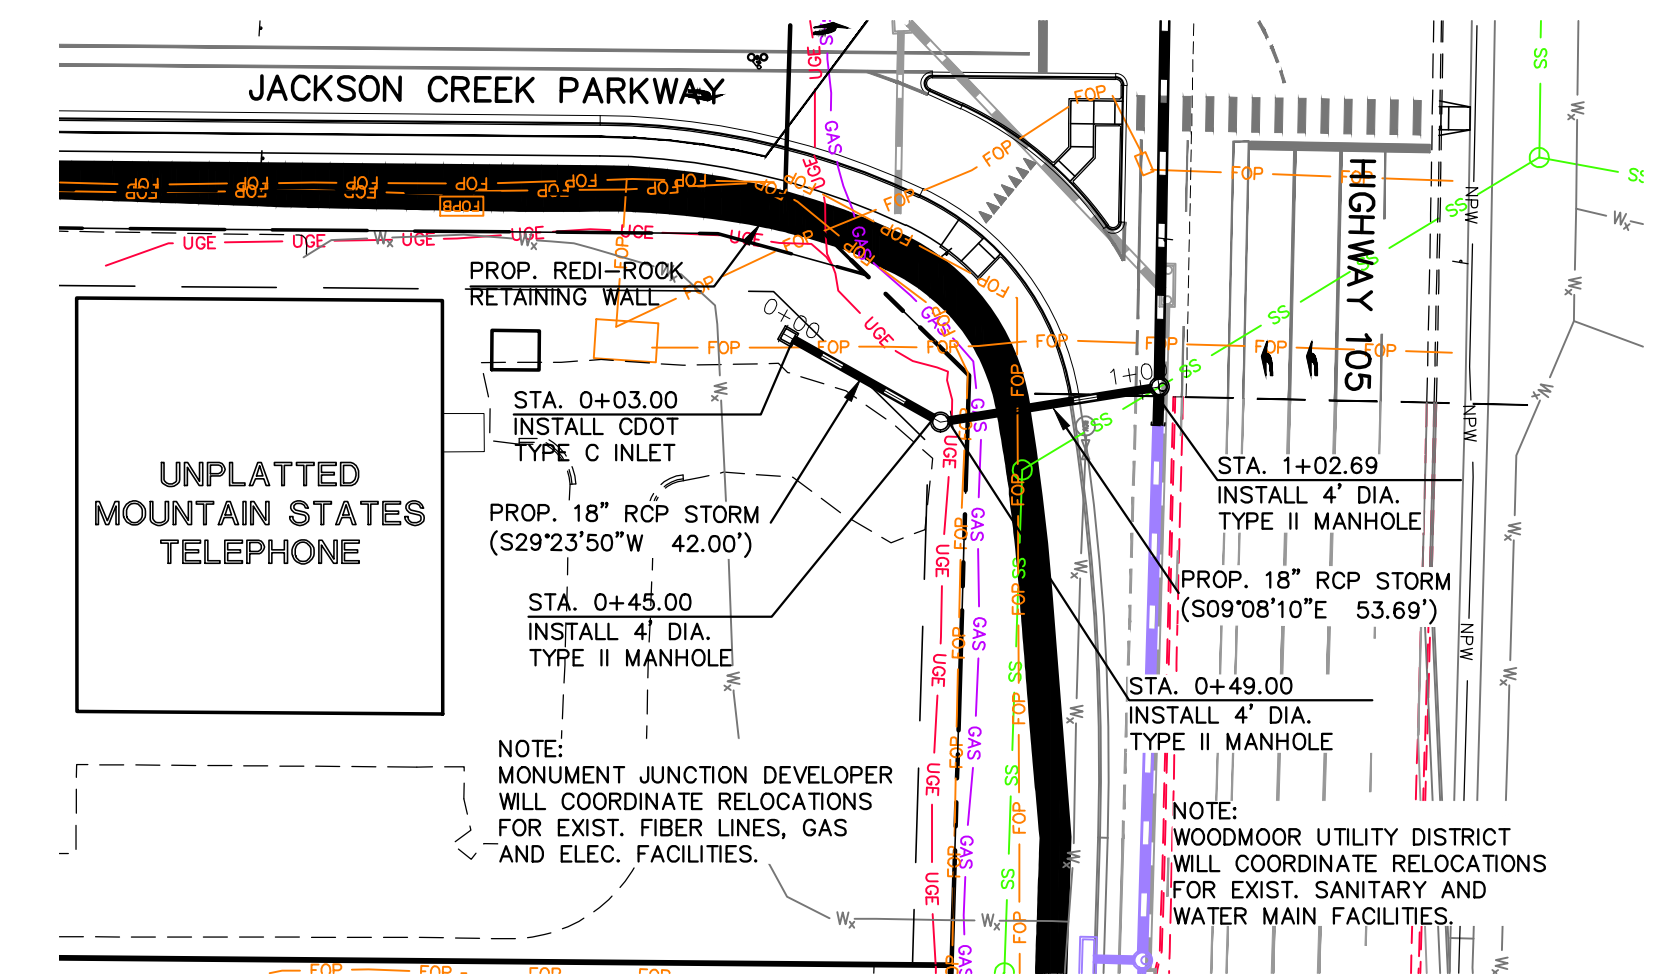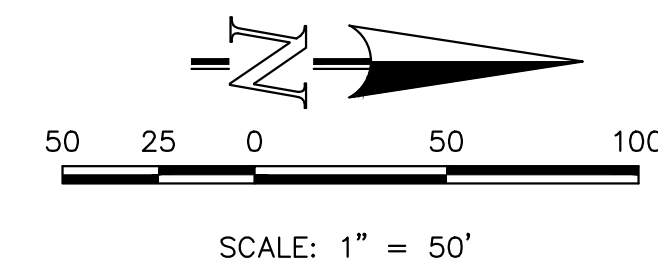

STATE HIGHWAY 105
STORM SEWER RUN-3

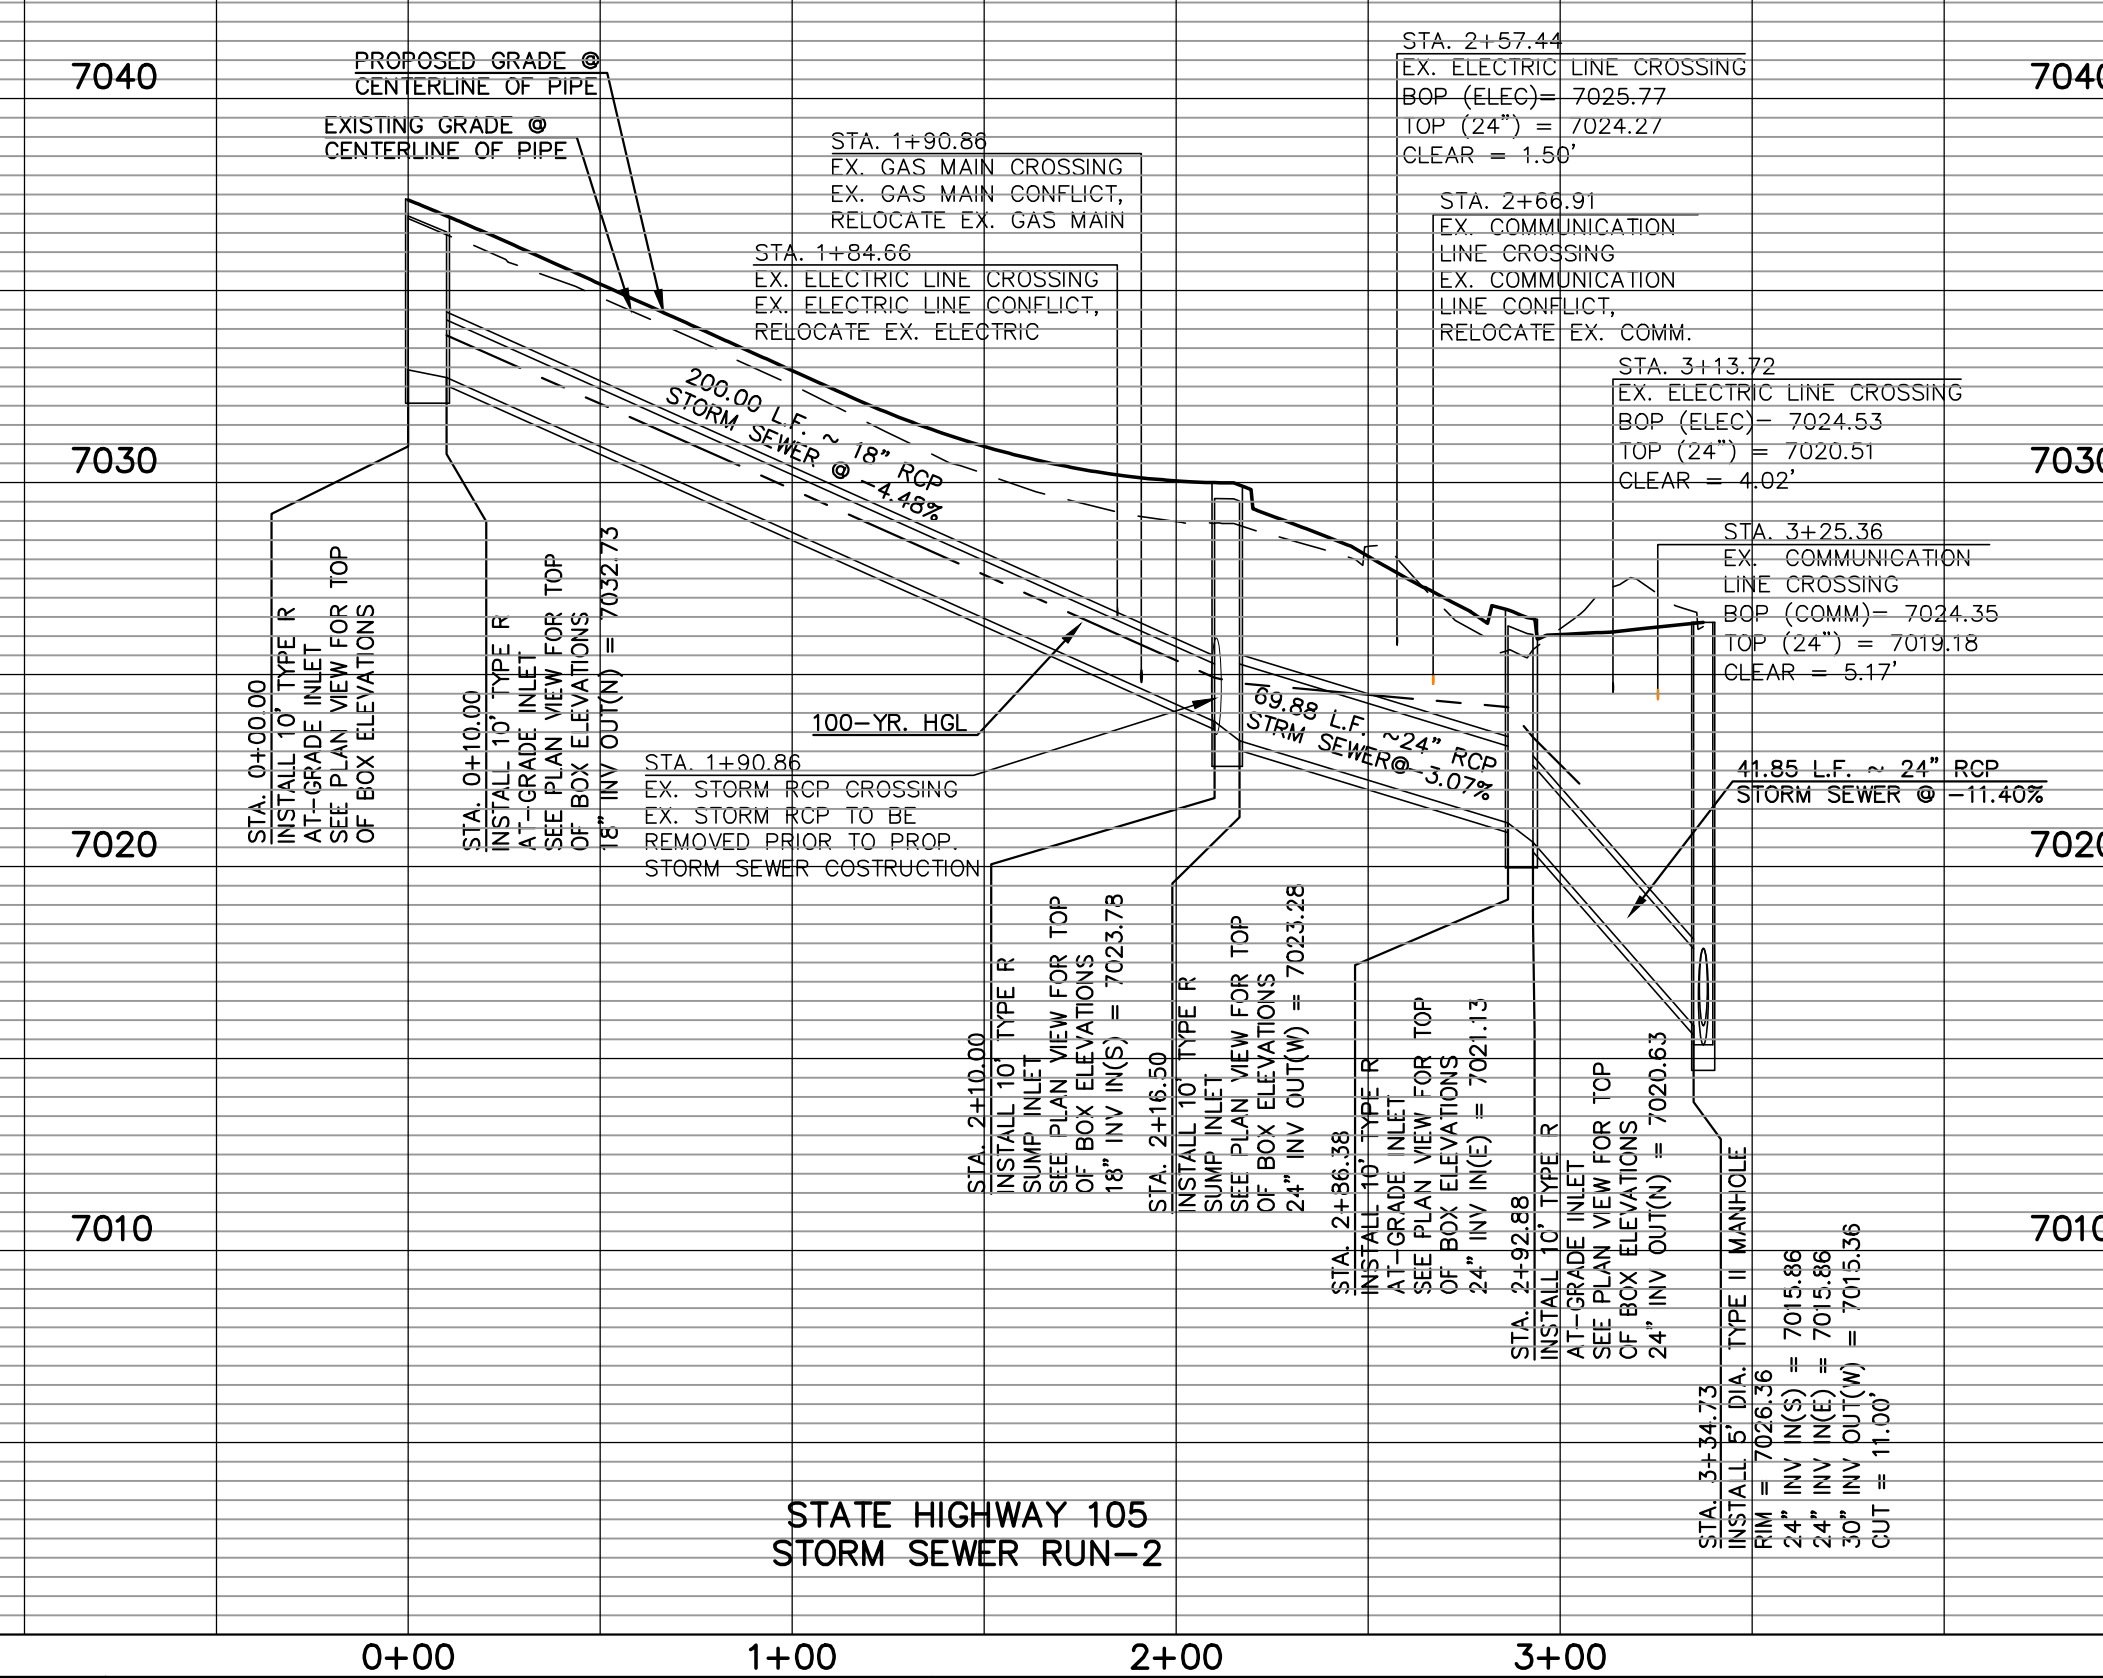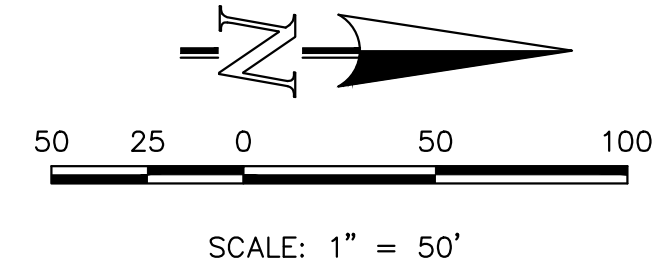

STATE HIGHWAY 105
STORM SEWER RUN-2

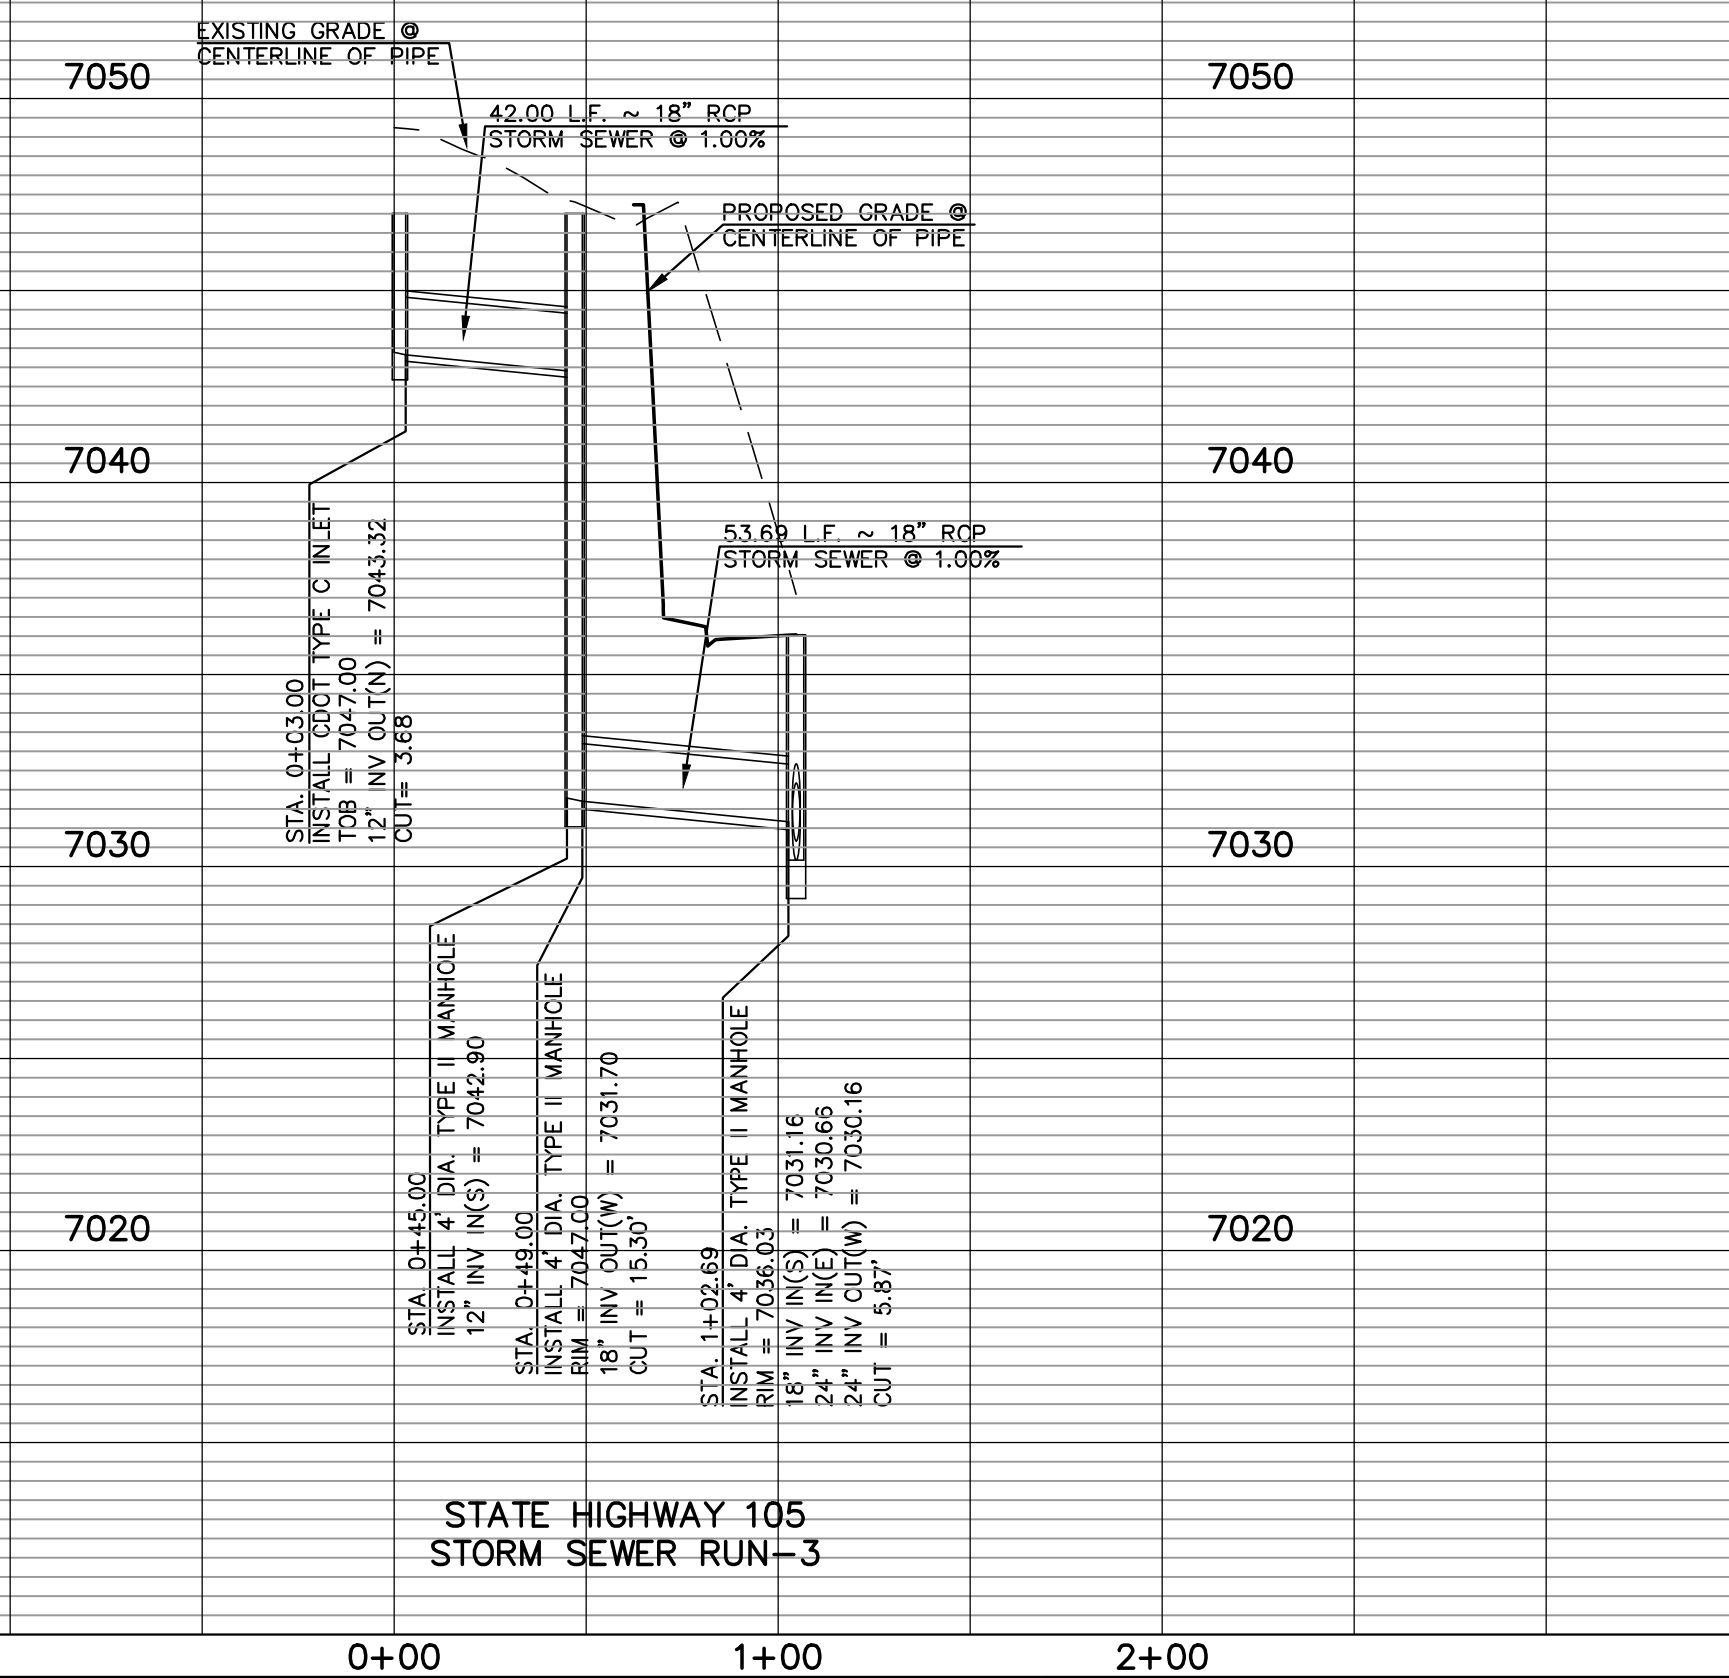

STATE HIGHWAY 105
STORM SEWER RUN-3

0+00 1+00 2+00 3+00 0+00 1+00 2+00

48 HOURS BEFORE YOU DIG,
CALL UTILITY LOCATORS
811
UTILITY NOTIFICATION CENTER OF COLORADO
IT'S THE LAW


THE LOCATIONS OF EXISTING UNDERGROUND UTILITIES ARE SHOWN IN AN APPROXIMATE WAY ONLY. THE CONTRACTOR SHALL DETERMINE THE EXACT LOCATION OF ALL EXISTING UTILITIES BEFORE COMMENCING WORK. THE CONTRACTOR SHALL BE FULLY RESPONSIBLE FOR ANY AND ALL DAMAGES WHICH MIGHT BE CAUSED BY HIS FAILURE TO EXACTLY LOCATE AND PRESERVE ANY AND ALL UNDERGROUND UTILITIES.

NO.	REVISION	DATE
1	REVISED PER CDOT/COUNTY/TOWN OF MONUMENT COMMENTS	7/10/23

REVIEW:
PREPARED UNDER MY DIRECT SUPERVISION FOR AND ON BEHALF OF CLASSIC CONSULTING ENGINEERS AND SURVEYORS, LLC
MARC. A. WHORTON, COLORADO P.E. #37155 DATE

STATE HIGHWAY 105 /JACKSON CREEK PKWY. - PHASE 2 CONSTRUCTION PLANS
STORM SEWER PLAN & PROFILE
DESIGNED BY PRA SCALE DATE 02-23-23
DRAWN BY PRA (H) 1"= 50' SHEET 22 OF 26
CHECKED BY (V) 1"= 5' JOB NO. 1302.22

CLASSIC CONSULTING ENGINEERS & SURVEYORS

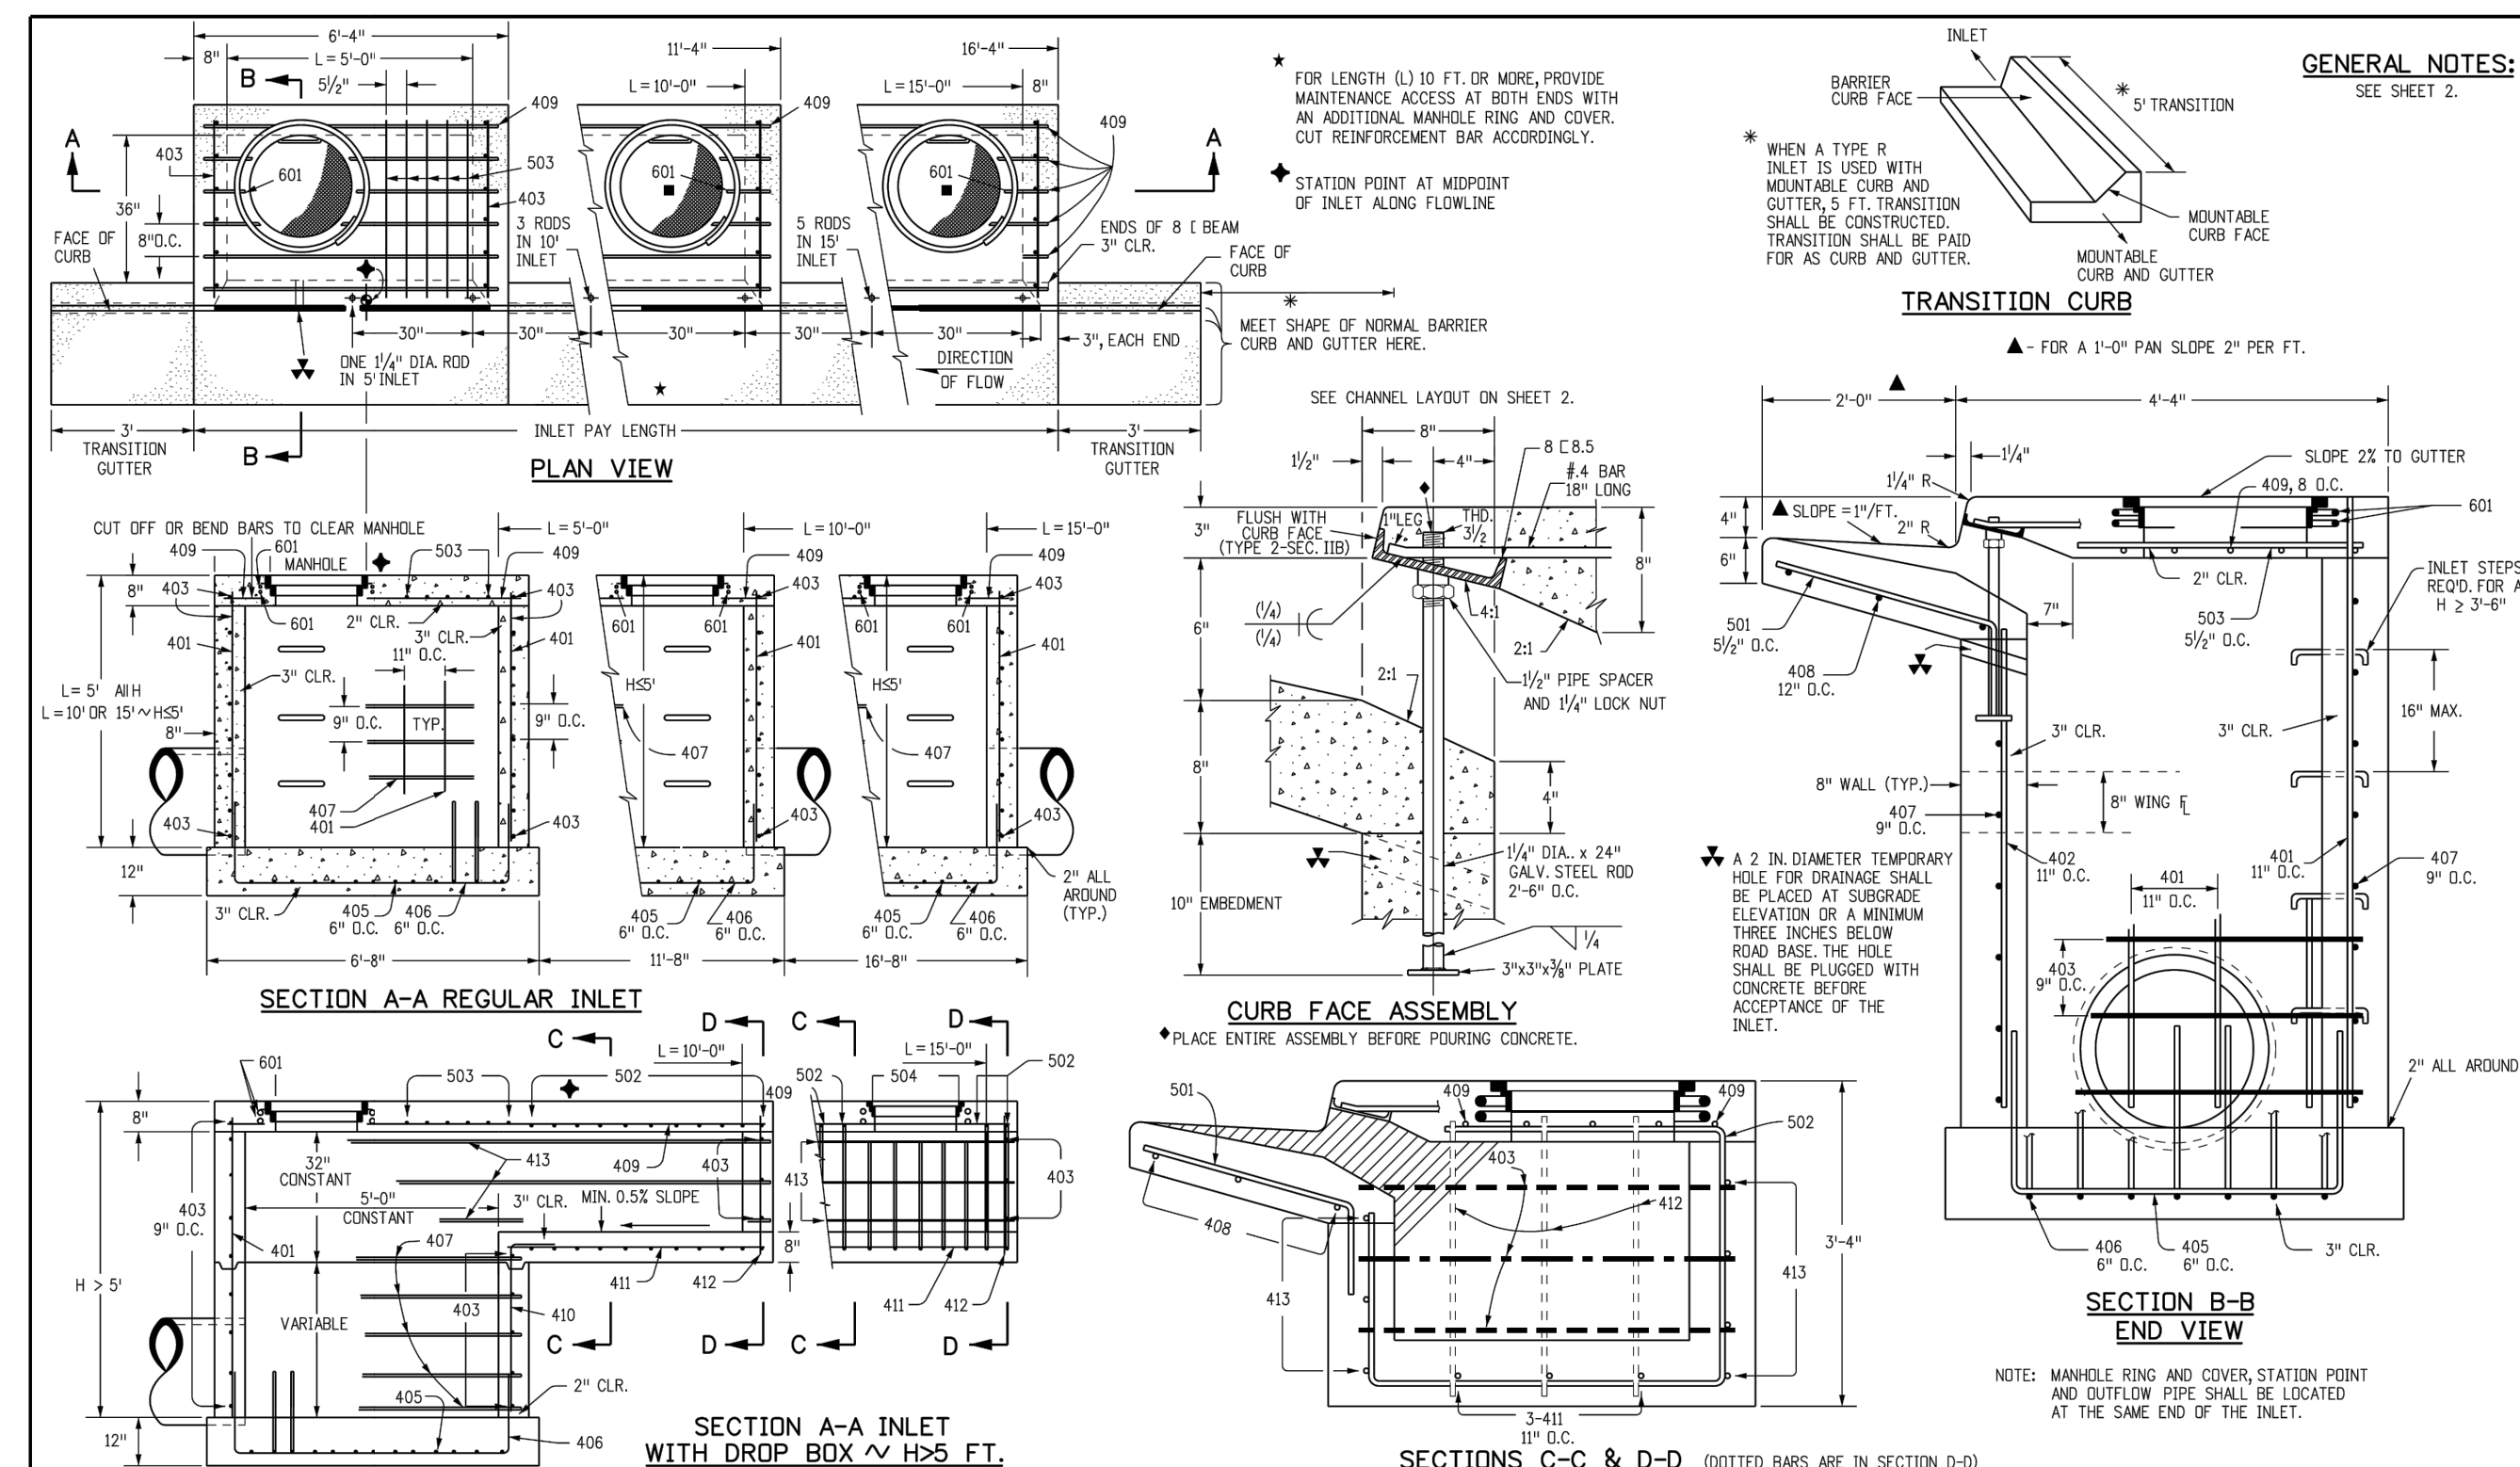

Computer File Information Creation Date: 07/31/19 Designer: JBK Last Modification Date: 07/31/19 Detailer: LTA CAD Ver: MicroStation V8 Scale: Not to Scale Units: English	Sheet Revisions Date: _____ Comments: _____	Colorado Department of Transportation 2829 West Howard Place CDOT HQ, 3rd Floor Denver, CO 80204 Phone: 303-757-9921 FAX: 303-757-9968 Project Development Branch JBK	CURB INLET TYPE R STANDARD PLAN NO. M-604-12 Standard Sheet No. 1 of 2 Issued by the Project Development Branch July 31, 2019 Project Sheet Number:
--	--	---	--

MARK	BAR # OR SIZE	O.C. SPACING	TYPE	ALL INLETS		INLETS H ≤ 5 FT.		INLETS H > 5 FT.	
				L = 5 FT.	L = 10 FT.	L = 5 FT.	L = 10 FT.	L = 5 FT.	L = 10 FT.
401	4	11"	II	15	21	26	31	11	11
402	4	11"	II	7	13	18	24	7	7
403	4	11"	II	7	13	18	24	7	7
TABLE ONE ~ BAR LIST FOR CURB INLETS, TYPE "R"

INLET TYPE	LENGTH	NO. REQ'D.		L = 5 FT.		L = 10 FT.		L = 15 FT.	
		REGULAR	DEEP BOX	CONC. STEEL (CU. YDS.)	CONC. STEEL (CU. YDS.)	CONC. STEEL (CU. YDS.)	CONC. STEEL (CU. YDS.)	CONC. STEEL (CU. YDS.)	CONC. STEEL (CU. YDS.)
3'-0"	2'-8"	1	0	3.2	385	5.3	497	7.4	706
3'-0"	3'-2"	1	0	3.4	305	5.7	528	7.9	747
4'-0"	3'-8"	1	0	3.7	326	6.0	559	8.4	786
4'-0"	4'-2"	1	0	3.9	334	6.4	571	8.8	803
5'-0"	4'-8"	1	0	4.1	354	6.7	602	9.3	844
5'-0"	5'-2"	1	0	4.4	375	7.0	637	9.8	885
6'-0"	5'-8"	1	0	4.6	382	7.2	656	10.1	907
6'-0"	6'-2"	1	0	4.8	402	7.4	677	10.4	927
7'-0"	7'-2"	1	0	5.0	423	7.6	694	10.7	944
7'-0"	7'-6"	1	0	5.1	430	7.7	711	10.9	964
8'-0"	8'-2"	1	0	5.2	441	7.8	727	11.1	974
8'-0"	8'-6"	1	0	5.3	449	7.9	732	11.2	974
10'-0"	9'-8"	1	0	5.8	520	8.0	749	11.4	992
10'-0"	10'-2"	1	0	5.8	527	8.1	759	11.5	1001
10'-0"	10'-6"	1	0	5.9	547	8.1	779	11.6	1022

TABLE TWO ~ BARS AND QUANTITIES VARIABLE WITH "H"

INLET TYPE	LENGTH	NO. REQ'D.		L = 5 FT.		L = 10 FT.		L = 15 FT.	
		REGULAR	DEEP BOX	CONC. STEEL (CU. YDS.)	CONC. STEEL (CU. YDS.)	CONC. STEEL (CU. YDS.)	CONC. STEEL (CU. YDS.)	CONC. STEEL (CU. YDS.)	CONC. STEEL (CU. YDS.)
3'-0"	2'-8"	1	0	3.2	385	5.3	497	7.4	706
3'-0"	3'-2"	1	0	3.4	305	5.7	528	7.9	747
4'-0"	3'-8"	1	0	3.7	326	6.0	559	8.4	786
4'-0"	4'-2"	1	0	3.9	334	6.4	571	8.8	803
5'-0"	4'-8"	1	0	4.1	354	6.7	602	9.3	844
5'-0"	5'-2"	1	0	4.4	375	7.0	637	9.8	885
6'-0"	5'-8"	1	0	4.6	382	7.2	656	10.1	907
6'-0"	6'-2"	1	0	4.8	402	7.4	677	10.4	927
7'-0"	7'-2"	1	0	5.0	423	7.6	694	10.7	944
7'-0"	7'-6"	1	0	5.1	430	7.7	711	10.9	964
8'-0"	8'-2"	1	0	5.2	441	7.8	727	11.1	974
8'-0"	8'-6"	1	0	5.3	449	7.9	732	11.2	974
10'-0"	9'-8"	1							

S:\121234-01 - Jackson Creek Parkway\04_CIVIL\CADD\Traffic\ITS\Drawings\105_Signal\T121234-01SIG-TAB01_5/5/2023 11:26:27 AM_Ben.Harms

TABULATION OF TRAFFIC SIGNAL ITEMS

CDOT ITEM NO.	ITEM DESCRIPTION	UNITS	TOTAL	NOTES
202-00828	REMOVAL OF TRAFFIC SIGNAL EQUIPMENT	L S	1	REFER TO THE REMOVAL ITEMS AND QUANTITIES BELOW
FOR INFORMATION ONLY	REMOVAL OF TRAFFIC SIGNAL POLE	EACH	4	RETURN TO EL PASO COUNTY
	REMOVAL OF TRAFFIC SIGNAL HEAD	EACH	12	
	REMOVAL OF TRAFFIC SIGNAL CONTROLLER AND CABINET	EACH	1	
	REMOVAL OF LUMINAIRE	EACH	4	
	REMOVAL OF STREET NAME SIGN	EACH	3	
	REMOVAL OF LANE USE/OPERATION SIGN	EACH	2	
	REMOVAL OF SPAN WIRE CABLE	LF	320	
210-00479	RESET RADIO COMMUNICATION ANTENNA	EACH	1	
503-00036	DRILLED SHAFT (36 INCH)	LF	60	CDOT STD. S-614-40A FOOTING
613-00206	2 INCH ELECTRICAL CONDUIT (BORED)	LF	400	SCHEDULE 80
613-00306	3 INCH ELECTRICAL CONDUIT (BORED)	LF	800	SCHEDULE 80
613-01200	2 INCH ELECTRICAL CONDUIT (PLASTIC)	LF	155	SCHEDULE 80
613-01300	3 INCH ELECTRICAL CONDUIT (PLASTIC)	LF	190	SCHEDULE 80
613-07003	TYPE THREE PULL BOX	EACH	4	SIGNAL POLE AND CONTROLLER PULL BOXES
613-07004	TYPE FOUR PULL BOX	EACH	1	HOME RUN PULL BOX
613-10000	WIRING	L S	1	SIGNAL AND LIGHTING
613-13004	LUMINAIRE (LED) (4,000 LUMENS)	EACH	4	
613-50109	METER POWER PEDESTAL	EACH	1	
614-00011	SIGN PANEL (CLASS I)	SF	40	
614-70150	PEDESTRIAN SIGNAL FACE (16) (COUNTDOWN)	EACH	2	LED TYPE, POLYCARBONATE, YELLOW INCOLOR
614-70336	TRAFFIC SIGNAL FACE (12-12-12)	EACH	15	LED TYPE, POLYCARBONATE, YELLOW INCOLOR
614-72855	TRAFFIC SIGNAL CONTROLLER CABINET	EACH	1	
614-72860	PEDESTRIAN PUSH BUTTON	EACH	1	PUSH BUTTON STATION, R10-3e SIGN AND ANY NECESSARY EXTENDER
614-72863	PEDESTRIAN PUSH BUTTON POST ASSEMBLY	EACH	2	CDOT STD. S-614-45, INCLUDES R10-3e SIGNS
614-72866	FIRE PREEMPTION UNIT AND TIMER	EACH	1	INCLUDES 2 PREEMPTION UNITS
614-72886	INTERSECTION DETECTION SYSTEM (CAMERA)	EACH	2	
614-81000	TRAFFIC SIGNAL-LIGHT POLE STEEL	EACH	1	
614-81125	TRAFFIC SIGNAL-LIGHT POLE STEEL (1-25 FOOT MAST ARM)	EACH	1	CDOT STD. S-614-40A
614-81145	TRAFFIC SIGNAL-LIGHT POLE STEEL (1-45 FOOT MAST ARM)	EACH	1	CDOT STD. S-614-40A
614-81155	TRAFFIC SIGNAL-LIGHT POLE STEEL (1-55 FOOT MAST ARM)	EACH	1	CDOT STD. S-614-40A
614-86248	TRAFFIC SIGNAL CONTROLLER (TYPE 2070LC)	EACH	1	

PRINT DATE: 05/5/2023 11:26 AM
 FILE NAME: T121234-01SIG-TAB01.DWG
 HORIZ. SCALE: N/A VERT. SCALE: N/A




3 South Tejon Street, Suite 300
 Colorado Springs, CO 80903
 Phone: 719.314.1800
 www.FHUENG.com

SHEET REVISIONS			
DATE	COMMENTS	INITIALS	



AS CONSTRUCTED	JACKSON CREEK PARKWAY TRAFFIC SIGNAL TABULATIONS STATE HIGHWAY 105		PROJECT NO./CODE
NO. REVISIONS:			121234-01
REVISED:	DESIGNER: BJH	STRUCTURE NUMBERS:	
	DETAILER: BEN.HARMS		
VOID:	SHEET SUBSET: TRAFFIC	SHEET SUBSET: TT-01 OF 1	


S:\121234-01 - Jackson Creek Parkway\04_CIVIL\CADD\Traffic\ITS\Drawings\105_Signal\T121234-01SIG-PLN01_5/5/2023 11:25:45 AM - Ben.Harms

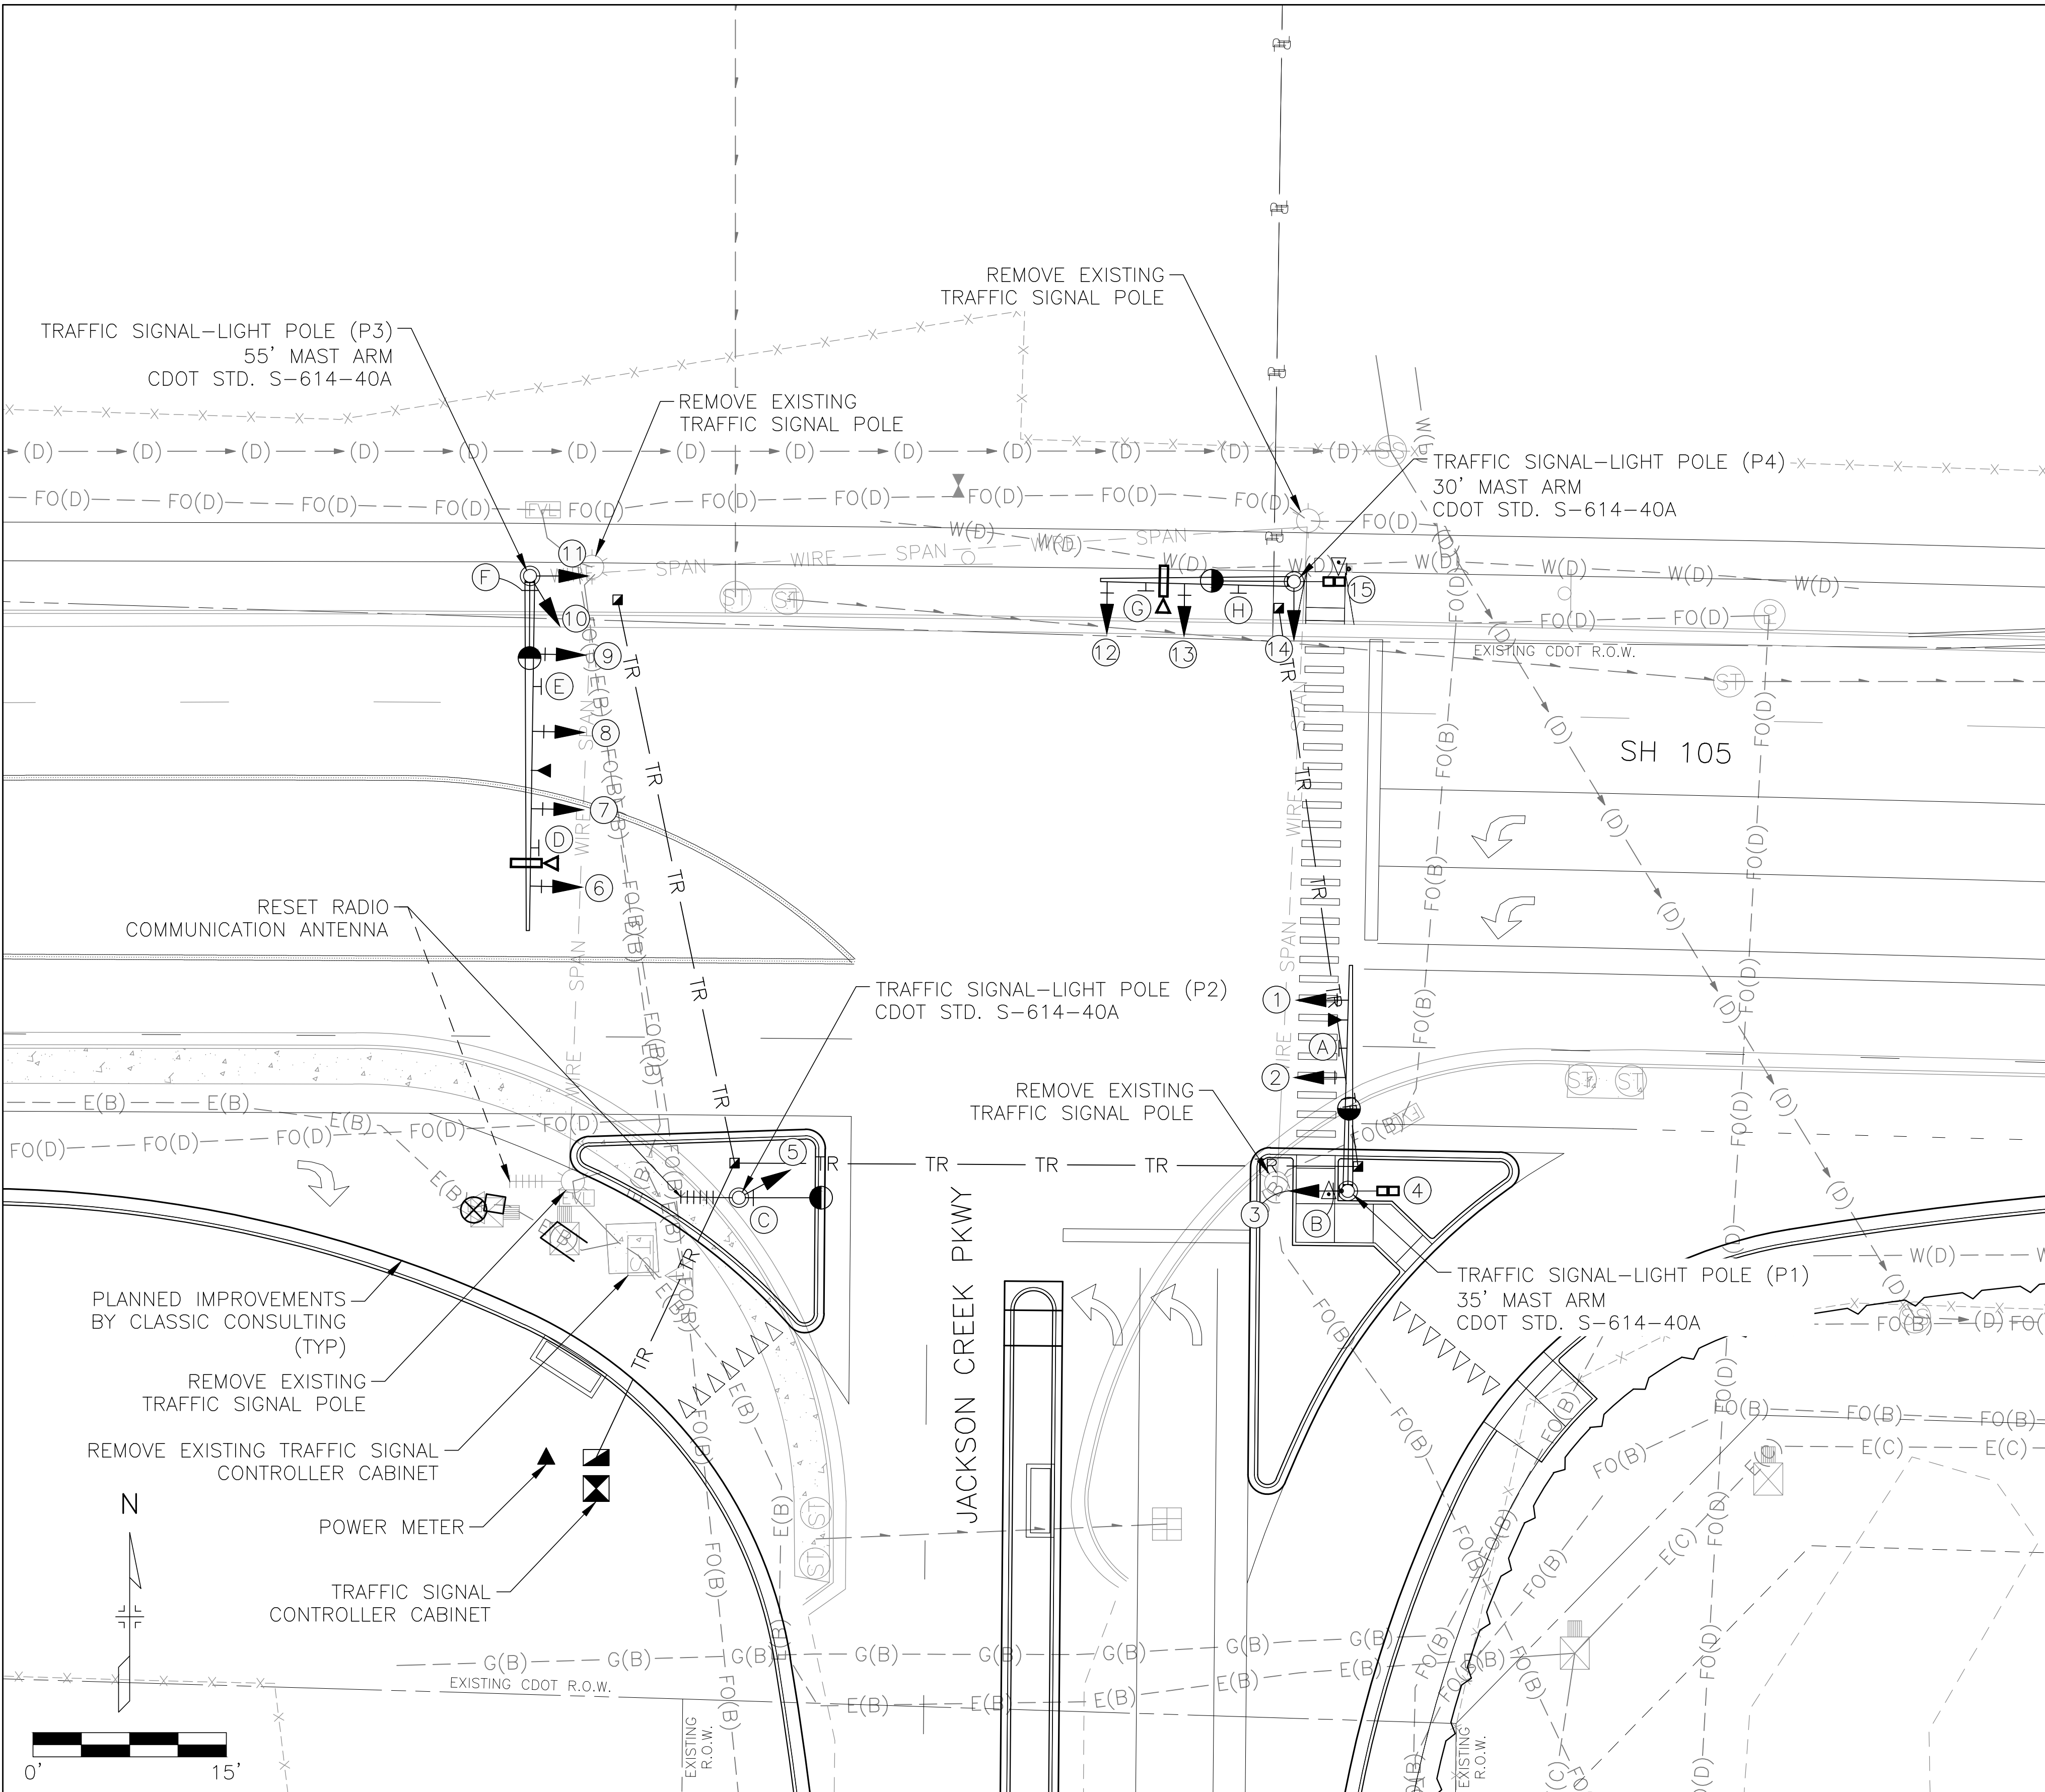


TRAFFIC SIGNAL SYMBOLS

- TRAFFIC SIGNAL POLE AND MAST ARM
- PEDESTRIAN PUSH BUTTON POLE
- LUMINAIRE
- TRAFFIC SIGNAL HEAD
- TRAFFIC SIGNAL HEAD & BACKPLATE
- PEDESTRIAN SIGNAL HEAD
- SIGNAL CONTROLLER CABINET
- PULL BOX
- SIGNAL CONDUITS
- VEHICLE DETECTOR CAMERA
- PED PUSH BUTTON & SIGN
- FIRE PREEMPTION UNIT
- RADIO COMMUNICATION ANTENNA

PROPOSED SIGNAL HEADS

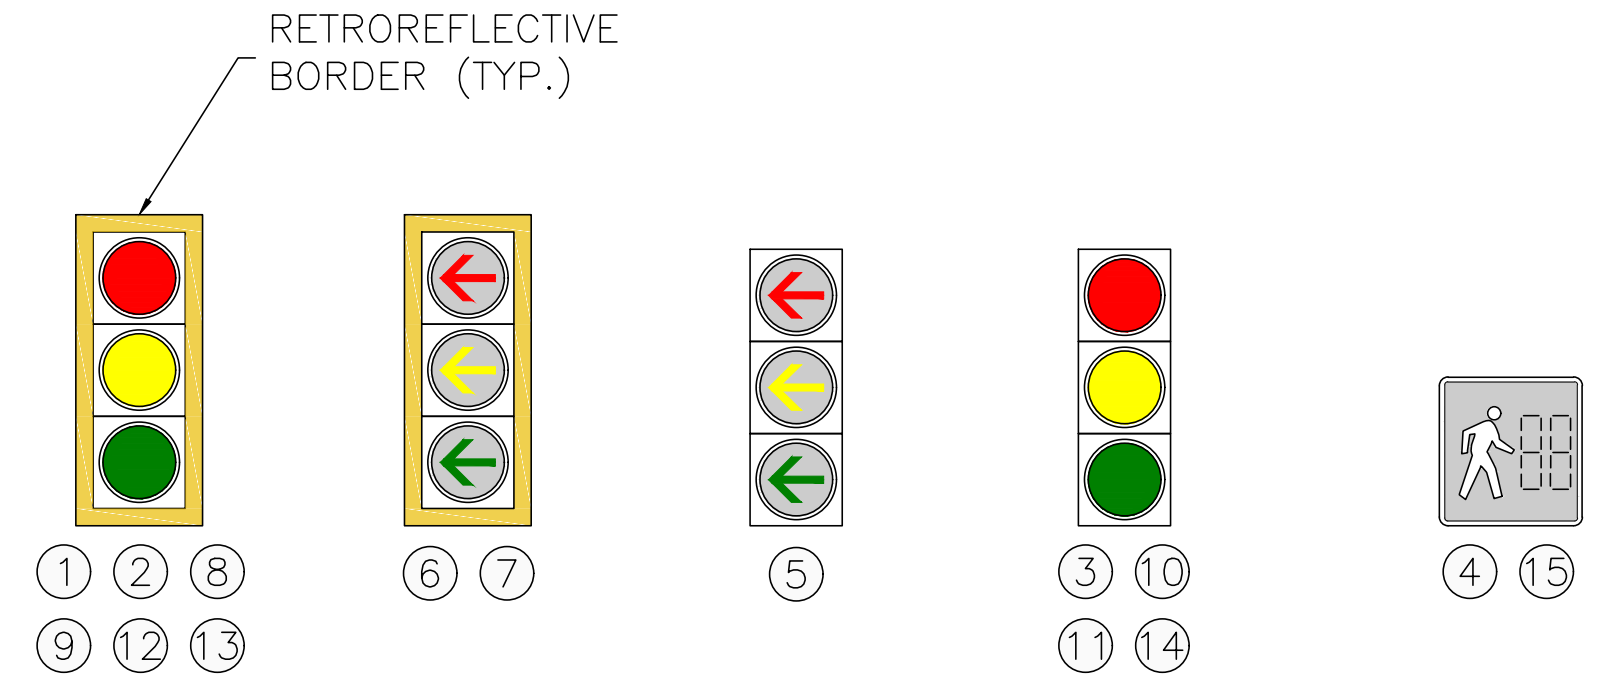

PROPOSED SIGNS

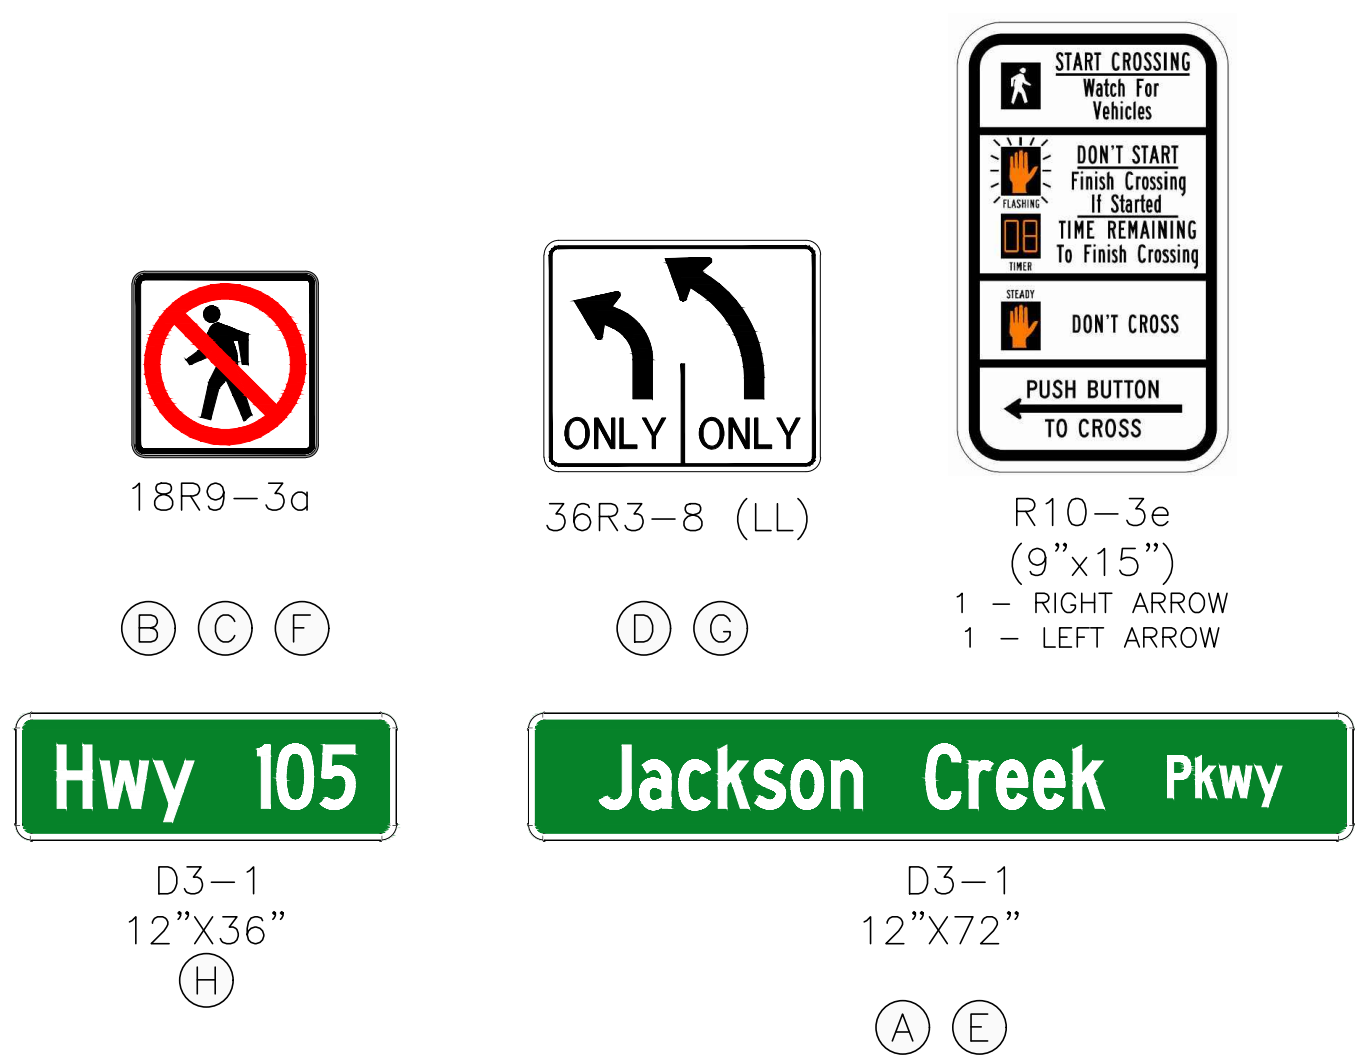

PRINT DATE: 05/5/2023 11:25 AM
 FILE NAME: T121234-01SIG-PLN01.DWG
 HORIZ. SCALE: 1" = 15' VERT. SCALE: N/A


SHEET REVISIONS			
DATE	COMMENTS	INITIALS	




AS CONSTRUCTED	JACKSON CREEK PARKWAY TRAFFIC SIGNAL PLAN STATE HIGHWAY 105		PROJECT NO./CODE
NO. REVISIONS:	DESIGNER: BJH		121234-01
REVISED:	DETAILER: BEN.HARMS	STRUCTURE NUMBERS:	
VOID:	SHEET SUBSET: TRAFFIC	SHEET SUBSET: TS-01 OF 2	

FELSBURG HOLT & ULLEVIG
 3 South Tejon Street, Suite 300
 Colorado Springs, CO 80903
 Phone: 719.314.1800
 www.FHUENG.com


JACKSON CREEK PKWY/S.H. 105—NW CORNER
SIGNAL POLE DETAILS

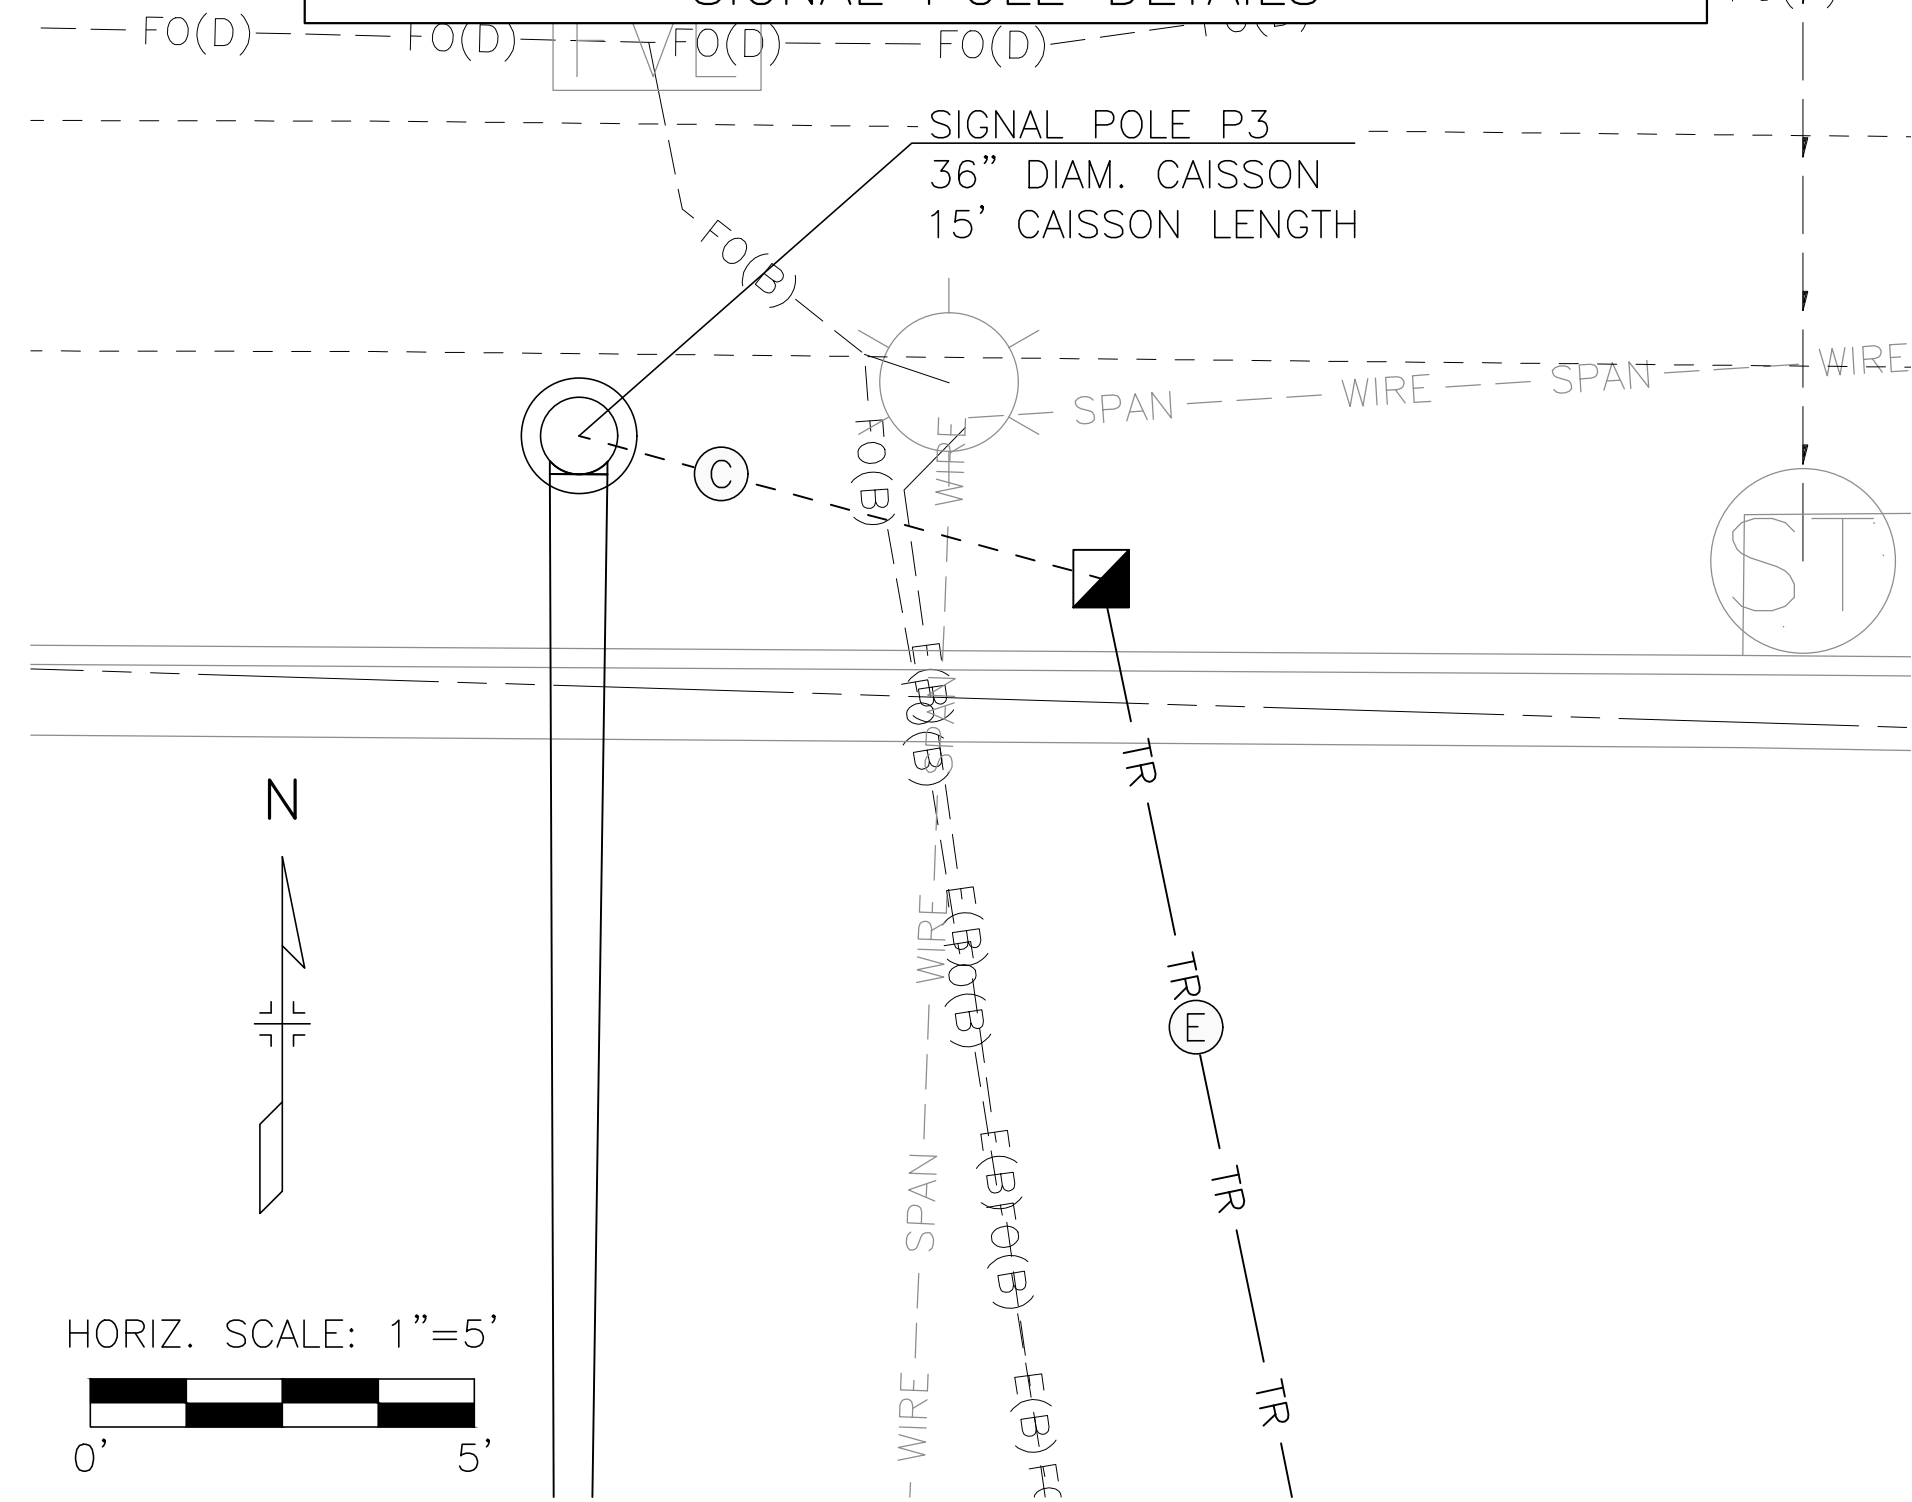


JACKSON CREEK PKWY/S.H. 105—NE CORNER
SIGNAL POLE DETAILS

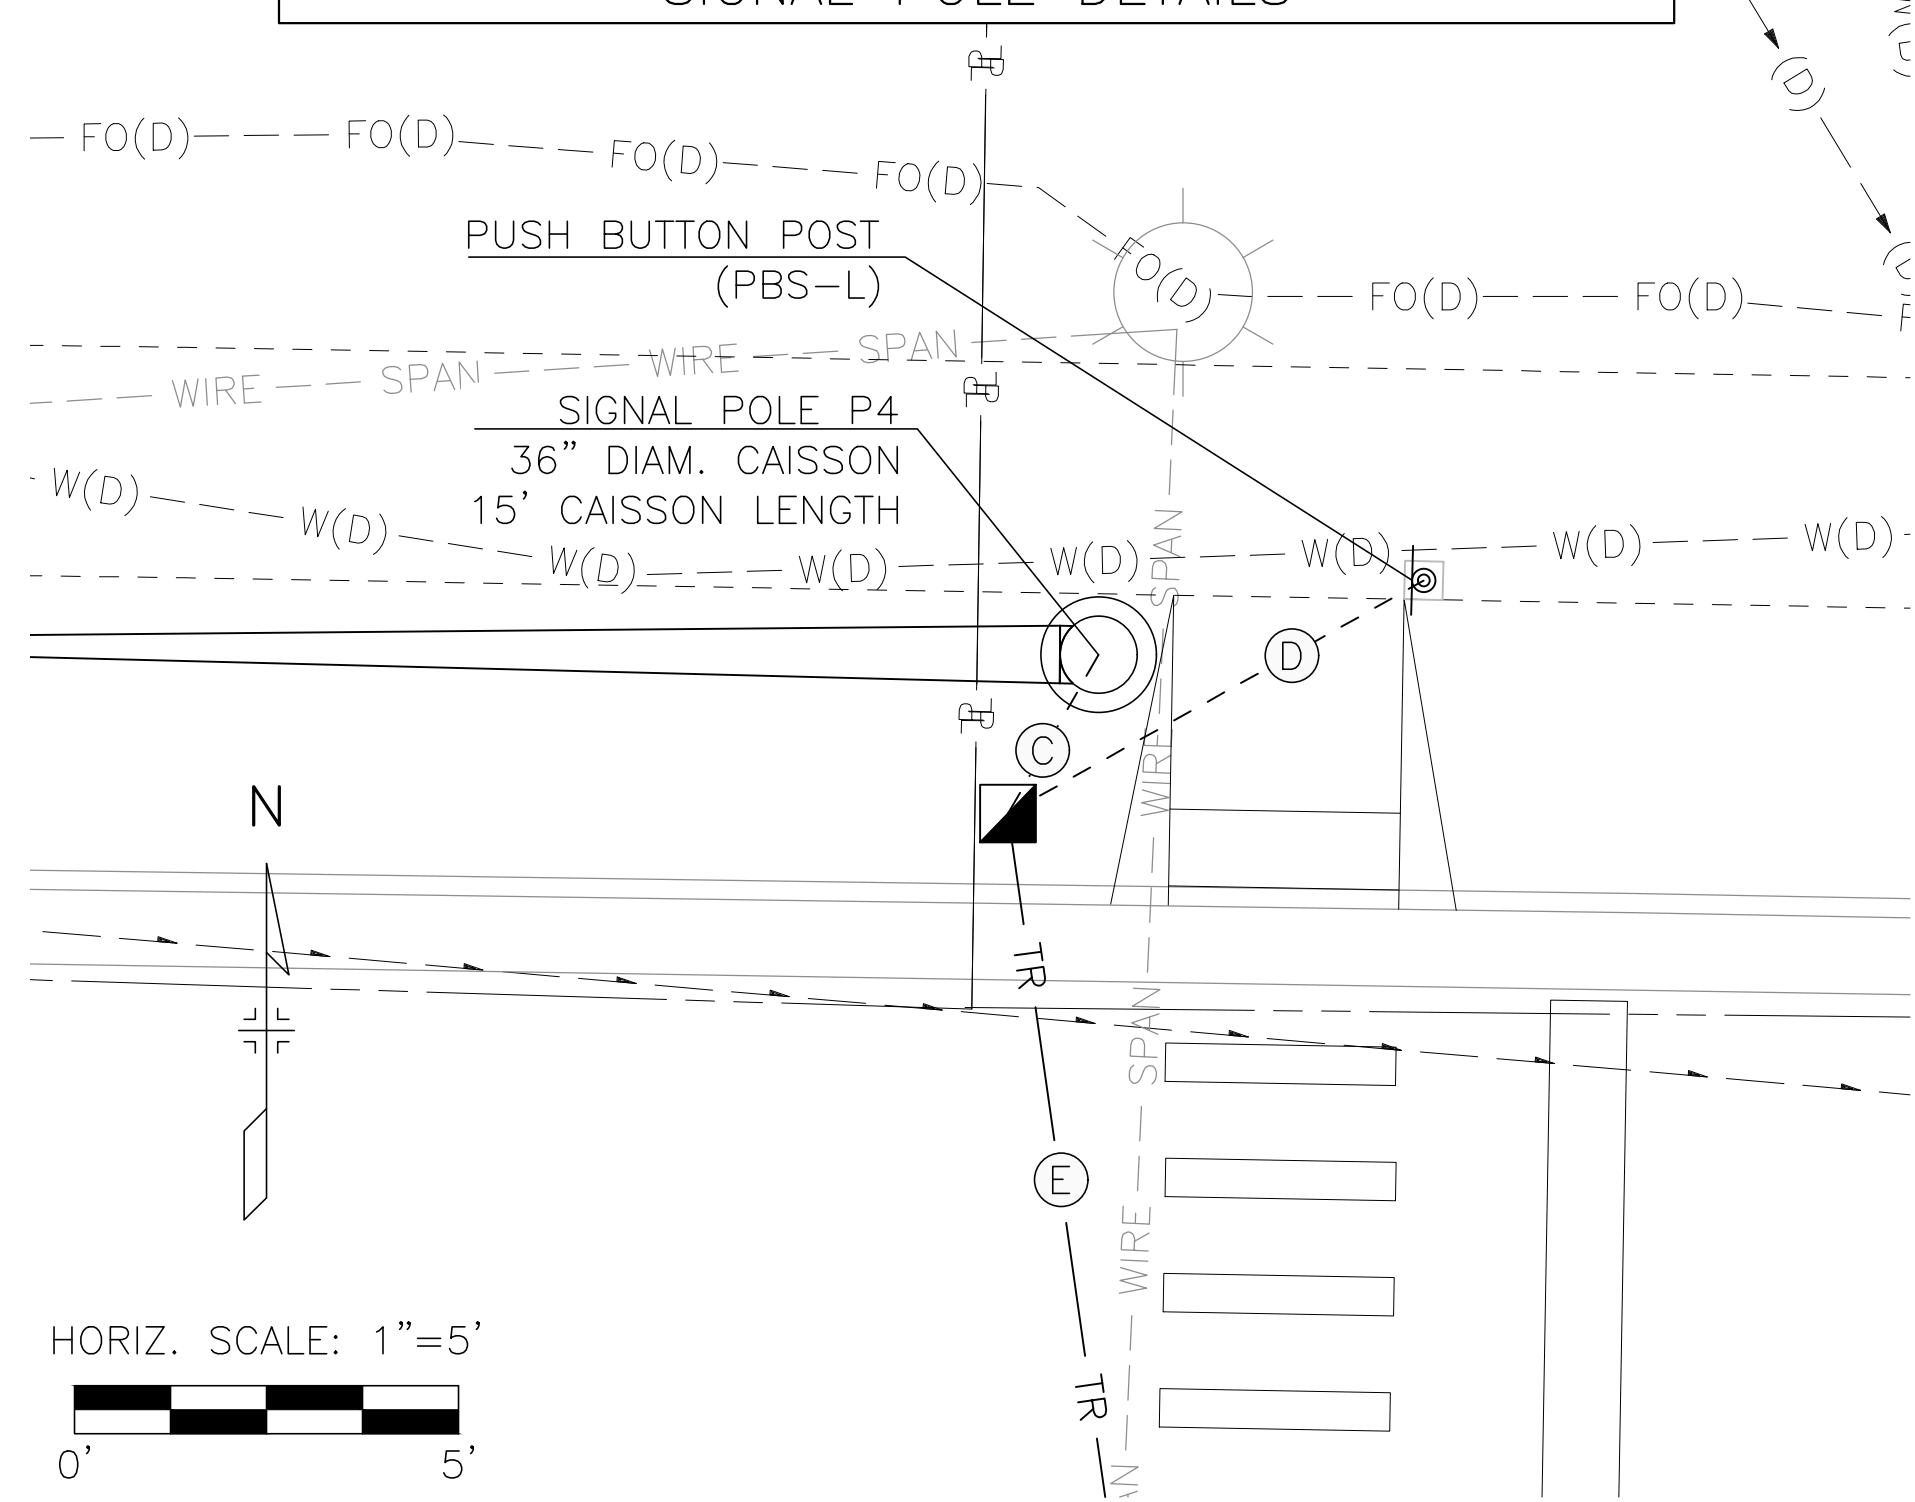

JACKSON CREEK PKWY/S.H. 105—SW CORNER
SIGNAL POLE DETAILS

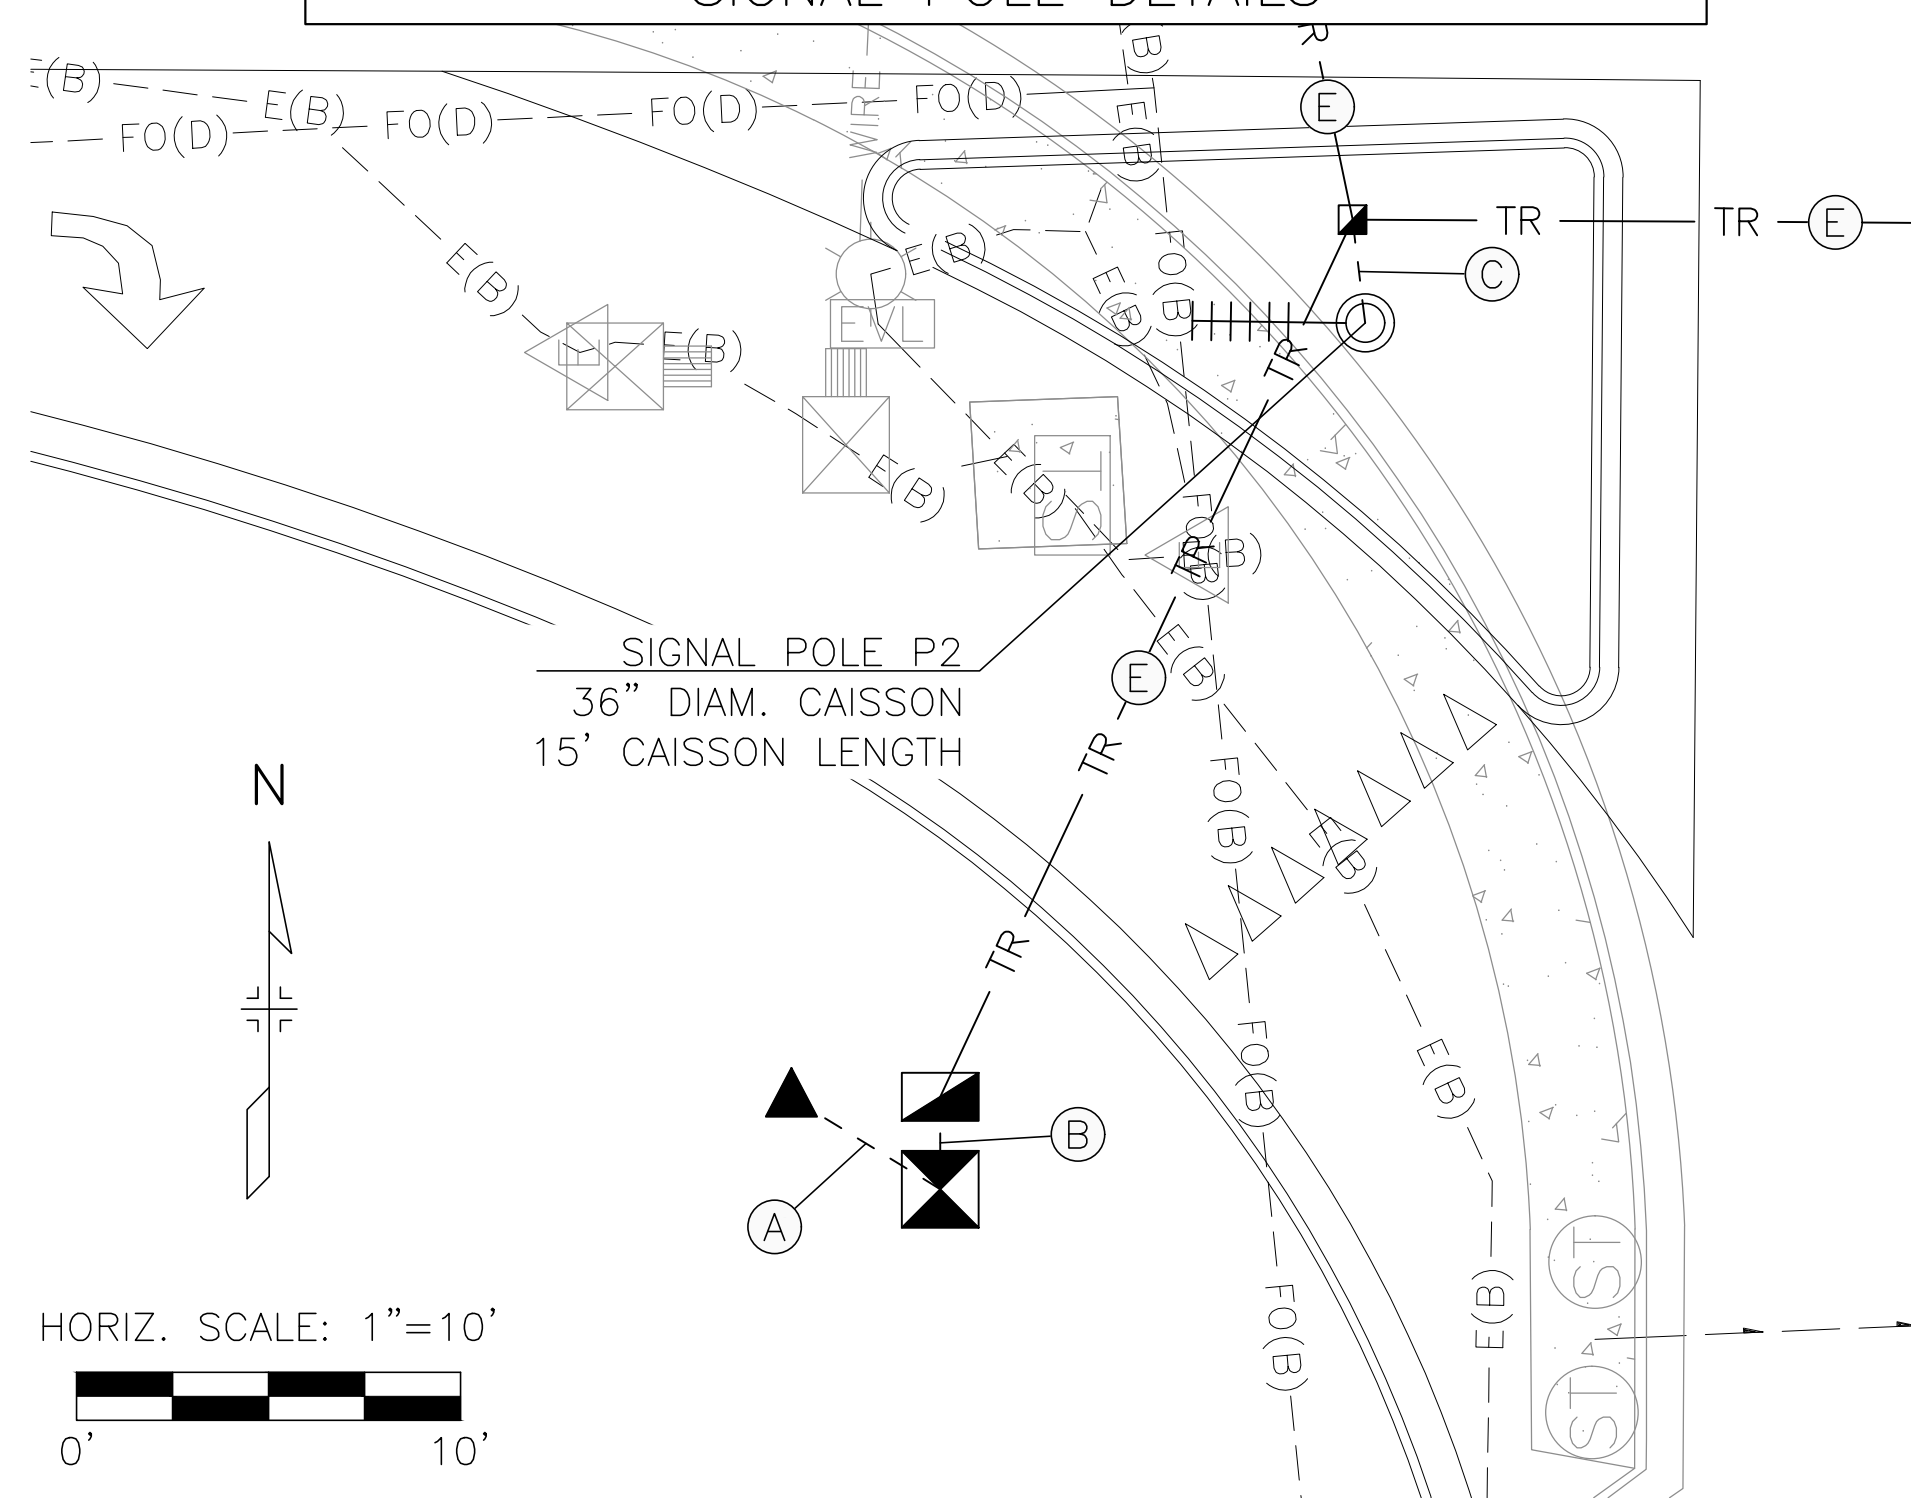


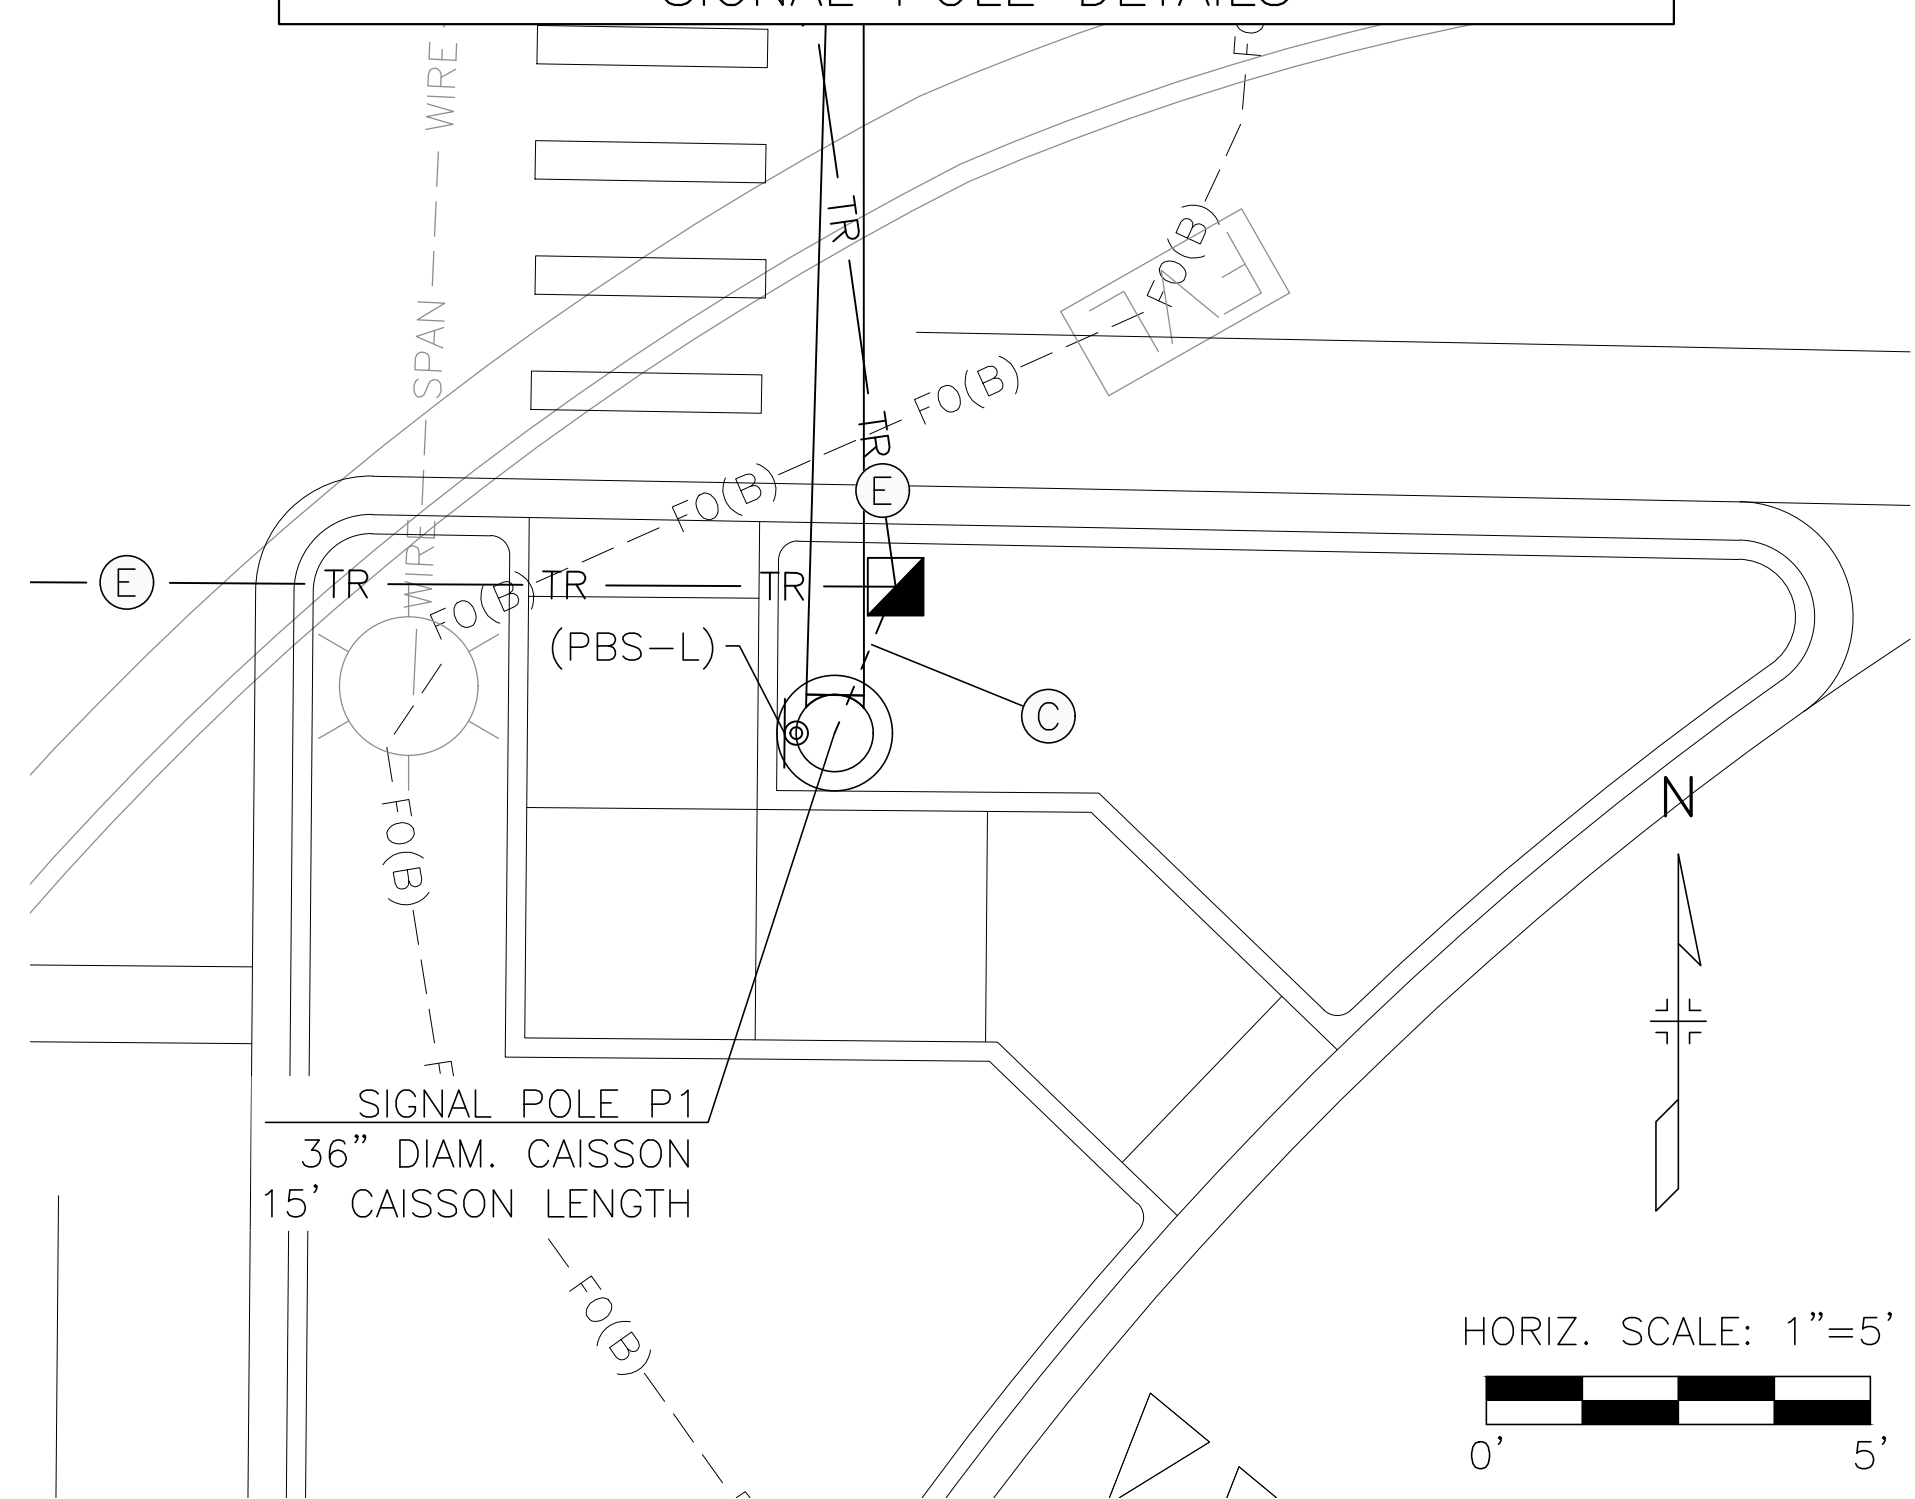


JACKSON CREEK PKWY/S.H. 105—SE CORNER
SIGNAL POLE DETAILS



LEGEND

(PBS-R/L = PED PUSH BUTTON STATION WITH
R10-3e RIGHT OR LEFT SIGN

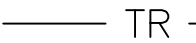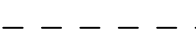-  PULL BOX (TYPE 4) (24"x36"x24")
-  PULL BOX (TYPE 3) (17"x30"x12")
-  TR ——— TRAFFIC SIGNAL CONDUIT STREET CROSSINGS
-  - - - - - TRAFFIC SIGNAL CONDUIT PULL BOX CONNECTIONS

SIGNAL CONDUITS

- (A) POWER METER: 1-2" (TRENCHED)
- (B) CONTROLLER 1-2" AND 4-3" (TRENCHED)
- (C) SIGNAL POLES 1-2" AND 2-3" (TRENCHED)
- (D) PUSH BUTTON POST 2-2" (TRENCHED)
- (E) STREET CROSSINGS 1-2" AND 2-3" (BORED)

NOTE:

PULL BOX AND CONDUIT LOCATIONS ARE APPROXIMATE ONLY. TO THE EXTENT POSSIBLE, THE CONTRACTOR SHALL INSTALL PULL BOXES OUTSIDE OF SIDEWALK AREAS; HOWEVER, IF PULL BOXES NEED TO BE PLACED WITHIN SIDEWALKS, THEY SHALL BE INSTALLED FLUSH WITH THE FINISHED SURFACE AND THE LIDS SHALL HAVE AN ANTI-SKID SURFACE TREATMENT. PULL BOXES SHALL NOT BE INSTALLED IN ANY CURB RAMPS.

SCHEDULE OF TRAFFIC SIGNAL POLES

POLE ID	TRAFFIC SIGNAL POLE		STAKING LOCATION AND CAISSON DETAILS			
	MAST ARM	LUMINAIRE ARM	NORTHING	EASTING	DIAMETER	DEPTH
P1	35 FT	15 FT ARM	1459419.60	3183115.91	36 IN	15 FT
P2	-	15 FT ARM	1459418.55	3183021.45	36 IN	15 FT
P3	55 FT	15 FT ARM	1459515.01	3182989.04	36 IN	15 FT
P4	30 FT	15 FT ARM	1459514.13	3183107.67	36 IN	15 FT



Know what's below.
Call before you dig.

PRINT DATE: 05/5/2023 11:25 AM
 FILE NAME: T121234-01SIG-PLN02.DWG
 HORIZ. SCALE: VARIES VERT. SCALE: N/A

FELSBURG HOLT & ULLEVIG
 3 South Tejon Street, Suite 300
 Colorado Springs, CO 80903
 Phone: 719.314.1800
 www.FHUENG.com

SHEET REVISIONS			
DATE	COMMENTS	INITIALS	




AS CONSTRUCTED	JACKSON CREEK PARKWAY TRAFFIC SIGNAL POLE DETAILS STATE HIGHWAY 105		PROJECT NO./CODE
NO. REVISIONS:			121234-01
REVISED:	DESIGNER: BJH	STRUCTURE NUMBERS	
VOID:	DETAILER: BEN.HARMS	SHEET SUBSET: TRAFFIC	SHEET SUBSET: TS-02 OF 2

S:\121234-01 - Jackson Creek Parkway\04_CIVIL\CADD\Traffic\ITS\Drawings\105_Signal\T121234-01SIG-PLN02_5/5/2023 11:25:29 AM - Ben.Harms

Document1.pdf Markup Summary


8/11/2023 12:57:30 PM (1)

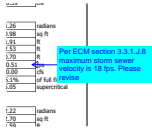

Subject: Callout
Page Label: 85
Author: CDurham
Date: 8/11/2023 12:57:30 PM
Status:
Color: ■
Layer:
Space:

Per ECM section 3.3.1.J.8 maximum storm sewer velocity is 18 fps. Please revise


8/11/2023 12:59:53 PM (1)

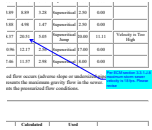

Subject: Callout
Page Label: 98
Author: CDurham
Date: 8/11/2023 12:59:53 PM
Status:
Color: ■
Layer:
Space:

Per ECM section 3.3.1.J.8 maximum storm sewer velocity is 18 fps. Please revise


8/11/2023 1:02:53 PM (1)

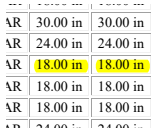

Subject: Highlight
Page Label: 97
Author: CDurham
Date: 8/11/2023 1:02:53 PM
Status:
Color: ■
Layer:
Space:

18.00 in 18.00 in


8/11/2023 1:03:19 PM (1)

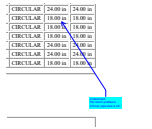

Subject: Callout
Page Label: 97
Author: CDurham
Date: 8/11/2023 1:03:19 PM
Status:
Color: ■
Layer:
Space:

Unresolved:
Per storm profiles in CD set, pipe size is 24".

8/11/2023 1:09:23 PM (1)

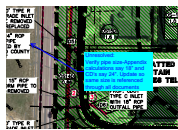

Subject: Callout
Page Label: [1] Layout1
Author: CDurham
Date: 8/11/2023 1:09:23 PM
Status:
Color: ■
Layer:
Space:

Unresolved:
Verify pipe size-Appendix calculations say 18" and CD's say 24". Update so same size is referenced through all documents


8/11/2023 1:09:46 PM (1)



Subject: Callout
Page Label: [1] Layout1
Author: CDurham
Date: 8/11/2023 1:09:46 PM
Status:
Color: ■
Layer:
Space:

Unresolved:
Label ROW & any easements along SH 105


8/11/2023 1:10:53 PM (1)

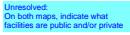

Subject: Text Box
Page Label: [1] Layout1
Author: CDurham
Date: 8/11/2023 1:10:53 PM
Status:
Color: ■
Layer:
Space:

Unresolved:
On both maps, indicate what facilities are public and/or private


8/11/2023 1:13:26 PM (1)

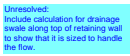

Subject: Text Box
Page Label: 50
Author: CDurham
Date: 8/11/2023 1:13:26 PM
Status:
Color: ■
Layer:
Space:

Unresolved:
Include calculation for drainage swale along top of retaining wall to show that it is sized to handle the flow.


8/11/2023 1:30:46 PM (1)

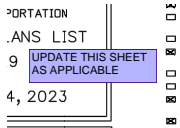

Subject: Text Box
Page Label: [1] Layout1
Author: EPCDPW-Werre
Date: 8/11/2023 1:30:46 PM
Status:
Color: ■
Layer:
Space:

UPDATE THIS SHEET AS APPLICABLE


8/11/2023 1:37:22 PM (1)

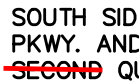

Subject: Line
Page Label: [1] LAYOUT1
Author: EPCDPW-Werre
Date: 8/11/2023 1:37:22 PM
Status:
Color: ■
Layer:
Space:

THIRD


8/11/2023 1:37:48 PM (1)

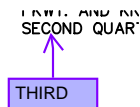

Subject: Callout
Page Label: [1] LAYOUT1
Author: EPCDPW-Werre
Date: 8/11/2023 1:37:48 PM
Status:
Color: ■
Layer:
Space:

THIRD


8/11/2023 1:56:42 PM (1)

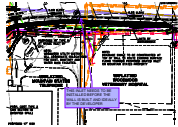

Subject: Callout
Page Label: [1] LAYOUT1
Author: EPCDPW-Werre
Date: 8/11/2023 1:56:42 PM
Status:
Color: ■
Layer:
Space:


THIS INLET NEEDS TO BE INSTALLED BEFORE THE WALL IS BUILT AND IDEALLY BY THE DEVELOPER

8/11/2023 1:57:05 PM (1)

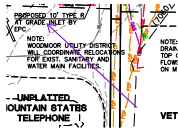

Subject: Arrow
Page Label: [1] LAYOUT1
Author: EPCDPW-Werre
Date: 8/11/2023 1:57:05 PM
Status:
Color: ■
Layer:
Space:


8/11/2023 2:25:03 PM (1)

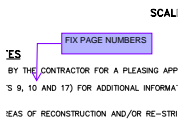

Subject: Callout
Page Label: [1] Layout1
Author: EPCDPW-Werre
Date: 8/11/2023 2:25:03 PM
Status:
Color: ■
Layer:
Space:

FIX PAGE NUMBERS


8/11/2023 2:30:17 PM (1)

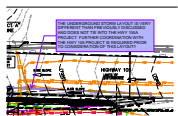

Subject: Callout
Page Label: [1] LAYOUT1
Author: EPCDPW-Werre
Date: 8/11/2023 2:30:17 PM
Status:
Color: ■
Layer:
Space:

THE UNDERGROUND STORM LAYOUT IS VERY DIFFERENT THAN PREVIOUSLY DISCUSSED AND DOES NOT TIE INTO THE HWY 105A PROJECT. FURTHER COORDINATION WITH THE HWY 105 PROJECT IS REQUIRED PRIOR TO CONSIDERATION OF THIS LAYOUT!!

8/11/2023 2:30:56 PM (1)

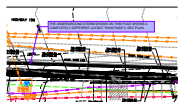

Subject: Callout
Page Label: [1] LAYOUT1
Author: EPCDPW-Werre
Date: 8/11/2023 2:30:56 PM
Status:
Color: ■
Layer:
Space:

THE UNDERGROUND STORM SHOWN ON THIS PAGE SHOWS A COMPLETELY DIFFERENT LAYOUT THAN PAGE 5- GEC PLAN.

8/11/2023 2:32:05 PM (1)



Subject: Callout
Page Label: [1] SI-01
Author: EPCDPW-Werre
Date: 8/11/2023 2:32:05 PM
Status:
Color: ■
Layer:
Space:

THE UNDERGROUND STORM LAYOUT IS VERY DIFFERENT THAN PREVIOUSLY DISCUSSED AND DOES NOT TIE INTO THE HWY 105A PROJECT. FURTHER COORDINATION WITH THE HWY 105 PROJECT IS REQUIRED PRIOR TO CONSIDERATION OF THIS LAYOUT AND DETERMINATION OF RESPONSIBILITIES!!

 
8/11/2023 2:38:36 PM (1)



Subject: Callout
Page Label: [1] STORM-1
Author: EPCDPW-Werre
Date: 8/11/2023 2:38:36 PM
Status:
Color: ■
Layer:
Space:

THE UNDERGROUND STORM LAYOUT IS VERY DIFFERENT THAN PREVIOUSLY DISCUSSED AND DOES NOT TIE INTO THE HWY 105A PROJECT. FURTHER COORDINATION WITH THE HWY 105 PROJECT IS REQUIRED PRIOR TO CONSIDERATION OF THIS LAYOUT AND DETERMINATION OF RESPONSIBILITIES!!


8/14/2023 8:28:34 AM (1)



Subject: Text Box
Page Label: [1] Layout1
Author: CDurham
Date: 8/14/2023 8:28:34 AM
Status:
Color: ■
Layer:
Space:

Comments provided by DPW Capital Projects


8/14/2023 8:28:46 AM (1)

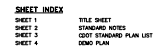

Subject: Text Box
Page Label: [1] Layout1
Author: CDurham
Date: 8/14/2023 8:28:46 AM
Status:
Color: ■
Layer:
Space:

Comments provided by DPW Development Services

8/14/2023 9:21:12 AM (1)

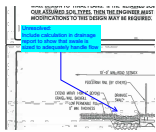

Subject: Callout
Page Label: [1] LAYOUT2
Author: CDurham
Date: 8/14/2023 9:21:12 AM
Status:
Color: ■
Layer:
Space:

Unresolved:
Include calculation in drainage report to show that swale is sized to adequately handle flow


8/14/2023 9:25:46 AM (1)



Subject: Callout
Page Label: [1] Layout1
Author: CDurham
Date: 8/14/2023 9:25:46 AM
Status:
Color: ■
Layer:
Space:


Pavement section detail calls for 6" of asphalt but pavement section lift detail only adds up to 5". Please revise so details show same information.

8/14/2023 9:27:14 AM (1)

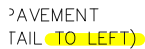

Subject: Highlight
Page Label: [1] Layout1
Author: CDurham
Date: 8/14/2023 9:27:14 AM
Status:
Color: ■
Layer:
Space:


8/14/2023 9:27:39 AM (1)

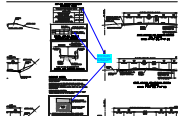

Subject: Callout
Page Label: [1] Layout1
Author: CDurham
Date: 8/14/2023 9:27:39 AM
Status:
Color: ■
Layer:
Space:

Pavement section detail calls for 6" of asphalt but pavement section lift detail only adds up to 5". Please revise so details show same information.

8/14/2023 9:29:31 AM (1)

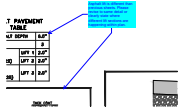

Subject: Callout
Page Label: [1] Layout1
Author: CDurham
Date: 8/14/2023 9:29:31 AM
Status:
Color: ■
Layer:
Space:

Asphalt lift is different than previous sheets. Please revise to same detail or clearly state where different lift sections are happening within plan.


8/14/2023 9:29:50 AM (1)



Subject: Callout
Page Label: [1] Layout1
Author: CDurham
Date: 8/14/2023 9:29:50 AM
Status:
Color: ■
Layer:
Space:

Asphalt lift is different than previous sheets. Please revise to same detail or clearly state where different lift sections are happening within plan.


8/14/2023 9:32:29 AM (1)

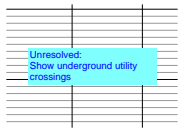

Subject: Text Box
Page Label: [1] SI-01
Author: CDurham
Date: 8/14/2023 9:32:29 AM
Status:
Color: ■
Layer:
Space:

Unresolved:
Show underground utility crossings

8/14/2023 9:39:09 AM (1)

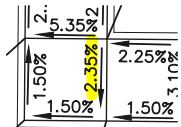

Subject: Highlight
Page Label: [1] Layout1
Author: CDurham
Date: 8/14/2023 9:39:09 AM
Status:
Color: ■
Layer:
Space:

Unresolved:
Show underground utility crossings


8/14/2023 9:40:17 AM (1)



Subject: Callout
Page Label: [1] Layout1
Author: CDurham
Date: 8/14/2023 9:40:17 AM
Status:
Color: ■
Layer:
Space:

Per Std Dtl SD_2-41 in the ECM, landing area of a pedestrian ramp shall not exceed 2% in any direction. Please revise


8/14/2023 9:41:38 AM (1)

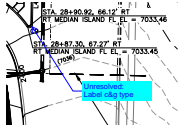

Subject: Callout
Page Label: [1] SI-04
Author: CDurham
Date: 8/14/2023 9:41:38 AM
Status:
Color: ■
Layer:
Space:

Unresolved:
Label c&g type


8/14/2023 9:58:30 AM (1)

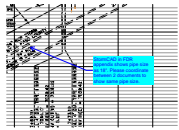

Subject: Callout
Page Label: [1] STORM-1
Author: CDurham
Date: 8/14/2023 9:58:30 AM
Status:
Color: ■
Layer:
Space:

StormCAD in FDR appendix shows pipe size as 18". Please coordinate between 2 documents to show same pipe size.


8/14/2023 9:59:29 AM (1)

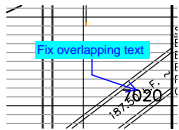

Subject: Callout
Page Label: [1] STORM-1
Author: CDurham
Date: 8/14/2023 9:59:29 AM
Status:
Color: ■
Layer:
Space:

Fix overlapping text

8/14/2023 9:59:46 AM (1)

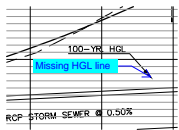

Subject: Callout
Page Label: [1] STORM-1
Author: CDurham
Date: 8/14/2023 9:59:46 AM
Status:
Color: ■
Layer:
Space:

Missing HGL line


8/14/2023 10:56:31 AM (1)



Subject: Callout
Page Label: 62
Author: CDurham
Date: 8/14/2023 10:56:31 AM
Status:
Color: ■
Layer:
Space:

Unresolved:
Per road profiles in CD set, street slope is approximately 5.5%

8/14/2023 11:01:42 AM (1)

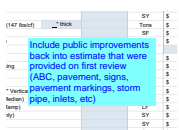

Subject: Text Box
Page Label: 1
Author: CDurham
Date: 8/14/2023 11:01:42 AM
Status:
Color: ■
Layer:
Space:

Include public improvements back into estimate that were provided on first review (ABC, pavement, signs, pavement markings, storm pipe, inlets, etc)