

BE IT KNOWN BY THESE PRESENTS:

DANIEL S. ABEYTA AND JENNIFER A. ABEYTA ARE THE OWNERS OF THE FOLLOWING DESCRIBED TRACT OF LAND, TO WIT:

THE NORTHWEST QUARTER OF THE SOUTHWEST QUARTER OF THE NORTHWEST QUARTER, TOGETHER WITH THE NORTHWEST QUARTER OF THE NORTHWEST QUARTER EXCEPT THE SOUTHEAST QUARTER OF THE NORTHWEST QUARTER OF THE NORTHWEST QUARTER, ALL IN SECTION 10, TOWNSHIP 12 SOUTH, RANGE 65 WEST OF THE 6TH P.M., COUNTY OF EL PASO, STATE OF COLORADO, EXCEPT THE NORTHERLY AND WESTERLY 30 FEET FOR PUBLIC ROAD RIGHT-OF-WAY AS RECORDED JUNE 20, 1917 AT BOOK 571 AT PAGE 55 OF THE RECORDS OF EL PASO COUNTY, STATE OF COLORADO.

CONTAINING 37.70 ACRES, MORE OR LESS.

DEDICATION:

THE UNDERSIGNED, BEING ALL THE OWNERS, MORTGAGES, BENEFICIARIES OF DEEDS OF TRUST AND HOLDERS OF OTHER INTERESTS IN THE LAND DESCRIBED HEREIN, HAVE LAID OUT, SUBDIVIDED, AND PLATTED SAID LANDS INTO LOTS AND EASEMENTS AS SHOWN HEREON UNDER THE NAME AND SUBDIVISION OF "SEDONA SUN ACRES FILING NO. 1". ALL PUBLIC IMPROVEMENTS SO PLATTED ARE HEREBY DEDICATED TO PUBLIC USE AND SAID OWNER DOES HEREBY COVENANT AND AGREE THAT THE PUBLIC IMPROVEMENTS WILL BE CONSTRUCTED TO EL PASO COUNTY STANDARDS AND THAT PROPER DRAINAGE AND EROSION CONTROL FOR SAME WILL BE PROVIDED AT SAID OWNER'S EXPENSE, ALL TO THE SATISFACTION OF THE BOARD OF COUNTY COMMISSIONERS OF EL PASO COUNTY, COLORADO. UPON ACCEPTANCE BY RESOLUTION, ALL PUBLIC IMPROVEMENTS SO DEDICATED WILL BECOME MATTERS OF MAINTENANCE BY EL PASO COUNTY, COLORADO. THE UTILITY EASEMENTS SHOWN HEREON ARE HEREBY DEDICATED FOR PUBLIC UTILITIES AND COMMUNICATION SYSTEMS AND OTHER PURPOSES AS SHOWN HEREON. THE ENTITIES RESPONSIBLE FOR PROVIDING THE SERVICES FOR WHICH THE EASEMENTS ARE ESTABLISHED ARE HEREBY GRANTED THE PERPETUAL RIGHT OF INGRESS AND EGRESS FROM AND TO ADJACENT PROPERTIES FOR INSTALLATION, MAINTENANCE, AND REPLACEMENT OF UTILITY LINES AND RELATED FACILITIES.

IN WITNESS WHEREOF:

THE AFOREMENTIONED DANIEL S. ABEYTA AND JENNIFER A. ABEYTA, HAS EXECUTED THIS INSTRUMENT THIS _____ DAY OF _____, 2020 A.D.

DANIEL S. ABEYTA _____ JENNIFER A. ABEYTA _____

NOTARIAL:

STATE OF COLORADO) SS
COUNTY OF EL PASO)

THE FOREGOING INSTRUMENT WAS ACKNOWLEDGED BEFORE ME THIS _____ DAY OF _____, 2020 A.D. BY DANIEL S. ABEYTA AND JENNIFER A. ABEYTA

WITNESS MY HAND AND SEAL _____

ADDRESS _____


MY COMMISSION EXPIRES _____

SURVEYOR'S CERTIFICATION:

I, TIM SLOAN, A DULY REGISTERED PROFESSIONAL LAND SURVEYOR IN THE STATE OF COLORADO, DO HEREBY CERTIFY THAT THIS INSTRUMENT ACCURATELY REPRESENTS THE RESULTS OF A SURVEY MADE ON THE DATE OF THE SURVEY, BY ME OR UNDER MY DIRECT SUPERVISION AND THAT ALL MONUMENTS EXISTING HEREON THAT MATHEMATICAL CLOSURE ERRORS ARE LESS THAN 1:10,000; AND THAT SAID PLAT HAS BEEN PREPARED IN FULL COMPLIANCE WITH ALL APPLICABLE LAWS OF THE STATE OF COLORADO DEALING WITH MONUMENTS, SUBDIVISION, OR SURVEYING OF LAND AND ALL APPLICABLE PROVISIONS OF THE EL PASO COUNTY LAND DEVELOPMENT CODE.

I ATTEST THE ABOVE ON THIS _____ DAY OF _____, 2020

TIM SLOAN _____ DATE _____
COLORADO REGISTERED PLS #38374
FOR AND ON BEHALF OF SMH CONSULTANTS, PA.

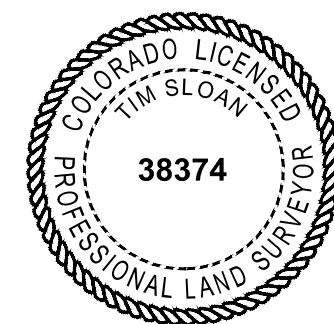

BOARD OF COUNTY COMMISSIONERS CERTIFICATE:

THIS PLAT FOR SEDONA SUN ACRES FILING NO. 1 WAS APPROVED FOR FILING BY THE EL PASO COUNTY, COLORADO BOARD OF COUNTY COMMISSIONERS ON _____ DAY OF _____, 2020, SUBJECT TO ANY NOTES SPECIFIED HEREON AND ANY CONDITIONS INCLUDED IN THE RESOLUTION OF APPROVAL. THE DEDICATIONS OF LAND TO THE PUBLIC, STREETS, TRACTS, AND EASEMENTS ARE ACCEPTED, BUT PUBLIC IMPROVEMENTS THEREON WILL NOT BECOME THE MAINTENANCE RESPONSIBILITY OF EL PASO COUNTY UNTIL PRELIMINARY ACCEPTANCE OF THE PUBLIC IMPROVEMENTS IN ACCORDANCE WITH THE REQUIREMENTS OF THE LAND DEVELOPMENT CODE AND ENGINEERING CRITERIA MANUAL, AND THE SUBDIVISION IMPROVEMENTS AGREEMENT.

CHAIR, BOARD OF COUNTY COMMISSIONERS _____ DATE _____
Planning and Community Development Director Certification: This plat for (name of subdivision or plat) was approved for filing by the El Paso County, Colorado Planning and Community Development Department Director on the _____ day of _____, 20____, subject to any notes or conditions specified hereon.

RECORDINGS:

STATE OF COLORADO) SS
COUNTY OF EL PASO)

I HEREBY CERTIFY THAT THIS INSTRUMENT WAS FILED FOR RECORD IN MY OFFICE AT _____ O'CLOCK _____ M. THIS _____ DAY OF _____, 2020 A.D., AND IS DULY RECORDED AT RECEPTION NO. _____ OF THE RECORDS OF EL PASO COUNTY, COLORADO.

CHUCK BROERMAN _____ FEE: _____

BY: _____ SURCHARGE: _____
COUNTY CLERK AND RECORDER

Owner's dedication block does not include streets and it does not appear that any public streets are to be constructed as part of this subdivision.

Soils and Geology report notes geologic constraints, including potential shallow groundwater. These areas should be denoted on the plan and designated as no-build areas in a plat note.

This plat is missing a title block. See LDC Sec. 7.2.5 for plat naming conventions and regulations. Title block should include proposed name of subdivision, quarter-section, section/township/range, County, and State.

Remove this note and show locations of all existing structures. Recommended to change these notes to a property information table. Specifically state what the required setbacks are.

Add note regarding Addresses: The addresses exhibited on this plat are for informational purposes only. They are not the legal description and are subject to change.

Include MVEA easement - 10 ft along lot lines, 20 ft around perimeter

Show all existing easements on the property. Several are referenced in the title commitment and are not depicted.

See comment on letter of intent regarding lot acreages. Lots must be a minimum of 5 acres each.

THE BASIS OF BEARINGS FOR THIS SURVEY IS THE WEST LINE OF THE PROPERTY, N00°23'27"E - 1954.13'. THE DIRECTION IS BASED ON THE LAND SURVEY PLAT BY RAMPART SURVEYS, LLC, 10/17/2016, AND THE LINE IS MONUMENTED AS SHOWN.

UNITS OF MEASURE ARE U.S. SURVEY FEET

△ FOUND SECTION CORNER AS NOTED

○ FOUND MONUMENT AS NOTED

● FOUND/SET 1/2" DIAMETER REBAR, 24" IN LENGTH, WITH CAP "PLS38374"

TITLE NOTES:


RESEARCH FOR RECORDED RIGHTS OF WAY AND EASEMENTS WAS DONE BY WFG NATIONAL TITLE INSURANCE COMPANY, FILE NO. 20-206795, EFFECTIVE DATE JUNE 5, 2020.

THIS SURVEY DOES NOT CONSTITUTE A TITLE SEARCH BY SMH CONSULTANTS OR TIM SLOAN.

EXCEPTIONS:

- 1. THROUGH 7: NOT EXAMINED AS PART OF THIS SURVEY.
- 8. ANY INTEREST WHICH MAY HAVE BEEN ACQUIRED BY THE PUBLIC BY REASON OF THE RESOLUTION OF THE BOARD OF COUNTY COMMISSIONERS DATED JUNE 20, 1917 AND RECORDED THE SAME DAY IN BOOK 571 AT PAGE 55, PROVIDING THAT ALL SECTION LINES, TOWNSHIP LINES, AND RANGE LINES ON THE PUBLIC DOMAIN IN EL PASO COUNTY ARE DECLARED PUBLIC HIGHWAYS OF THE WIDTH OF 80 FEET, BEING 30 FEET ON EACH SIDE OF SAID SECTION LINES, TOWNSHIP LINES, AND RANGE LINES, PROVIDED HOWEVER THAT THE BOARD MAY, FROM TIME TO TIME AS THE OCCASION ARISES, BY RESOLUTION DECLARE IT NECESSARY TO DEVELOP AND IMPROVE SAID HIGHWAYS WHEN IN THEIR JUDGMENT IT SHALL BE NECESSARY AND EXPEDIENT.
- 9. THE RIGHT OR PROPRIETOR OR A VEIN OR LODGE TO EXTRACT OR REMOVE HIS ORE SHOULD THE SAME BE FOUND TO PENETRATE OR INTERSECT THE PREMISES THEREBY GRANTED AS RESERVED IN UNITED STATES PATENT RECORDED APRIL 17, 1909 IN BOOK 25 AT PAGE 412 AND AUGUST 3, 1891 IN BOOK 36 AT PAGE 170, AND ANY AND ALL ASSIGNMENTS THEREOF OR INTEREST THEREIN.
- 10. RIGHT OF WAY FOR DITCHES AND CANALS CONSTRUCTED BY THE AUTHORITY OF THE UNITED STATES AS RESERVED IN PATENT RECORDED APRIL 17, 1909 IN BOOK 25 AT PAGE 412.
- 11. AN EASEMENT FOR TELEPHONE AND TELEGRAPH LINES AND INCIDENTAL PURPOSES GRANTED TO MOUNTAIN STATES TELEPHONE AND TELEGRAPH COMPANY BY THE INSTRUMENT RECORDED MAY 20, 1927 IN BOOK 103 AT PAGE 363 AND DECEMBER 11, 1937 IN BOOK 122 AT PAGE 573.
- 12. AN UNDIVIDED ONE-HALF INTEREST IN ALL OIL, GAS AND OTHER MINERALS AS RESERVED BY FRANK W. HARRINGTON IN INSTRUMENT RECORDED MARCH 4, 1953 IN BOOK 147 AT PAGE 14, AND ANY AND ALL ASSIGNMENTS THEREOF OR INTERESTS THEREIN.
- 13. RIGHT OF WAY ACROSS SUBJECT PROPERTY AS RESERVED IN DEED RECORDED JANUARY 14, 1966 IN BOOK 2113 AT PAGE 745.
- 14. RIGHTS TO ENTER UPON SUBJECT PROPERTY FOR THE REPAIR AND MAINTENANCE OF DITCHES AND HEADGATES AS RESERVED IN INSTRUMENT RECORDED JANUARY 24, 1968 IN BOOK 199 AT PAGE 178.
- 15. COVENANTS, CONDITIONS, RESTRICTIONS AND EASEMENTS CONTAINED IN INSTRUMENT RECORDED AUGUST 15, 1973 AT BOOK 2613 AT PAGE 749.
- NOTE: VARIANCE UNDER PROTECTIVE COVENANTS RECORDED JANUARY 14, 1977 IN BOOK 2889 AT PAGE 43.
- 16. THE EFFECT, IF ANY OF THE INCLUSION OF THE SUBJECT PROPERTY INTO THE BLACK FOREST VOLUNTEER FIRE PROTECTION DISTRICT AS DISCLOSED BY DEED RECORDED AUGUST 21, 1975 IN BOOK 2172 AT PAGE 121.
- 17. TERMS, CONDITIONS AND PROVISIONS OF THAT CERTAIN NOTICE PURSUANT TO COLORADO STATUTES CONCERNING UNDERGROUND FACILITIES FOR MOUNTAIN VIEW ELECTRIC ASSOCIATION INC. RECORDED MAY 9, 1983 IN BOOK 3718 AT PAGE 812.
- 18. COVENANTS, CONDITIONS AND RESTRICTIONS, WHICH DO NOT INCLUDE A FORFEITURE OR REVERTER CLAUSE, SET FORTH IN THE INSTRUMENT RECORDED NOVEMBER 14, 1985 IN BOOK 5089 AT PAGE 132. PROVISIONS REGARDING RACE, COLOR, CREED, AND NATIONAL ORIGIN, IF ANY, ARE DELETED.
- 19. AN EASEMENT FOR ELECTRICAL, TELEPHONE, AND/OR TELEGRAPH LINES AND INCIDENTAL PURPOSES GRANTED TO MOUNTAIN VIEW ELECTRIC ASSOCIATION, INC. BY THE INSTRUMENT RECORDED AUGUST 6, 1999 AT RECEPTION NO. 9912660.
- 20. PERMANENT, NON-EXCLUSIVE EASEMENT FOR INGRESS AND EGRESS OVER THE NORTHWEST QUARTER OF THE SOUTHWEST QUARTER OF THE NORTHWEST QUARTER AS RESERVED BY ARKANSAS-PLATTE AND GULF PARTNERSHIP IN DEED RECORDED OCTOBER 10, 2000 AT RECEPTION NO. 200027263.
- 21. TERMS, CONDITIONS AND PROVISIONS OF THAT CERTAIN COLORADO GROUND WATER COMMISSION FINDINGS AND ORDER IN THE UPPER BLACK SQUIRREL CREEK RECORDED MARCH 8, 2007 AS RECEPTION NO. 208032050 AND AT RECEPTION NO. 208032051 AND AT RECEPTION NO. 208032052 AND AT RECEPTION NO. 208032053 AND RECORDED APRIL 13, 2020 AT RECEPTION NO. 220049996.
- 22. TERMS, CONDITIONS AND RESTRICTIONS CONTAINED IN ACCESS AND MAINTENANCE AGREEMENT TO BE RECORDED.

NOTICE: ACCORDING TO COLORADO LAW YOU MUST COMMENCE ANY LEGAL ACTION BASED UPON ANY DEFECT IN THIS SURVEY WITHIN THREE YEARS AFTER YOU FIRST DISCOVER SUCH DEFECT. IN NO EVENT MAY ANY ACTION BE TAKEN AFTER THE EXPIRATION OF THE THREE YEAR PERIOD.

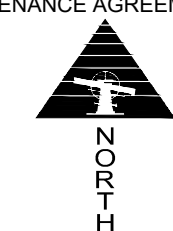

SCALE: 1" = 100'


Remove this note and depict ALL existing and proposed easements on the plat.

- NOTE: 1. NO EASEMENTS, RESTRICTIONS, RESERVATIONS, SETBACKS, OR OTHER MATTER OF RECORD, IF ANY, AFFECTING THE TITLE OF THIS PROPERTY ARE SHOWN, EXCEPT AS PLATTED, AS PER AGREEMENT WITH THE LANDOWNER.
- 2. NO GAPS OR OVERLAPS EXIST.
- 3. THERE ARE NO LINES OF POSSESSION THAT AFFECT THIS SURVEY.
- 4. PARENT TRACT IS RECORDED IN BOOK DIST. PAGE 5210NW4, REGISTER OF DEEDS OFFICE, EL PASO COUNTY, KANSAS.
- 5. NO EXISTING BUILDINGS ARE SHOWN, AS PER AGREEMENT WITH THE OWNERS.
- 6. ALL BUILDING SETBACK REQUIREMENTS SHALL BE DETERMINED BY THE ZONING DISTRICT, UNLESS OTHERWISE NOTED.
- 7. ZONING: "RR-5"
- 8. THE OWNER, HIS SUCCESSORS AND ASSIGNS SHALL ADVISE THE FUTURE OWNERS OF THESE LOTS OF ALL LEGAL REQUIREMENTS OF THE DETERMINATION OF WATER RIGHT 1068-BD RECORDED AT RECEPTION NO. 220049996.
- 9. SEWAGE TREATMENT IS THE RESPONSIBILITY OF EACH INDIVIDUAL PROPERTY OWNER. THE EL PASO COUNTY HEALTH DEPARTMENT AND ENVIRONMENT MUST APPROVE EACH SYSTEM AND, IN SOME CASES THE DEPARTMENT MAY REQUIRE AN ENGINEER DESIGNED SYSTEM PRIOR TO PERMIT APPROVAL.
- 10. INDIVIDUAL WELLS ARE THE RESPONSIBILITY OF EACH PROPERTY OWNER. PERMITS FOR INDIVIDUAL WELLS MUST BE OBTAINED FROM THE STATE ENGINEER WHO HAS THE AUTHORITY TO SET CONDITIONS FOR THE ISSUANCE OF THESE PERMITS.
- 11. WATER IN THE DAWSON AQUIFER IS ALLOCATED BASED ON A 100-YEAR AQUIFER-BASED ALLOCATION PLAN FOR AGRICULTURAL PURPOSES. WATER IN THE DAWSON AQUIFER IS ELEVATED BASED ON A 300-YEAR AQUIFER LIFE. APPLICANTS, THE HOME OWNERS ASSOCIATION, AND ALL FUTURE OWNERS IN THE SUBDIVISION SHOULD BE AWARE THAT THE ECONOMIC LIFE OF A WATER SUPPLY BASED ON WELLS IN A GIVEN DAWSON BASIN AQUIFER MAY BE LESS THAN EITHER THE 100 YEARS OR 300 YEARS INDICATED DUE TO ANTICIPATED WATER LEVEL DECLINES. FURTHERMORE, THE WATER SUPPLY PLAN SHOULD NOT RELY SOLELY UPON NON-RENEWABLE AQUIFERS AND ALTERNATIVE RENEWABLE WATER RESOURCES SHOULD BE ACQUIRED AND INCORPORATED IN A PERMANENT WATER SUPPLY PLAN THAT PROVIDES FUTURE GENERATIONS WITH A WATER SUPPLY.
- 12. NO DRIVEWAY SHALL BE ESTABLISHED UNLESS AN ACCESS PERMIT HAS BEEN GRANTED BY EL PASO COUNTY PLANNING AND COMMUNITY DEVELOPMENT. INDIVIDUAL LOT PURCHASERS ARE RESPONSIBLE FOR CONSTRUCTING DRIVEWAYS, INCLUDING NECESSARY DRAINAGE CULVERTS FROM VOLLMER ROAD PER LAND DEVELOPMENT CODE SECTION 6.3.3.C.2 AND 6.3.3.C.3. DUE TO THEIR LENGTH, SOME OF THE DRIVEWAYS WILL NEED TO BE SPECIFICALLY APPROVED BY THE BLACK FOREST FIRE PROTECTION DISTRICT.
- 13. ALL PROPERTY OWNERS ARE RESPONSIBLE FOR MAINTAINING PROPER STORM DRAINAGE IN AND THROUGH THEIR PROPERTY. PUBLIC DRAINAGE EASEMENTS AS SPECIFICALLY NOTED ON THE PLAT SHALL BE MAINTAINED BY THE INDIVIDUAL LOT OWNERS UNLESS OTHERWISE INDICATED. STRUCTURES, FENCES, MATERIALS OR LANDSCAPING THAT COULD IMPEDE THE FLOW OF RUNOFF SHALL NOT BE PLACED IN DRAINAGE EASEMENTS.
- 14. MAILBOXES SHALL BE INSTALLED IN ACCORDANCE WITH ALL EL PASO COUNTY DEPARTMENT OF TRANSPORTATION AND UNITED STATES POSTAL SERVICE REGULATIONS.
- 15. DEVELOPER SHALL COMPLY WITH FEDERAL AND STATE LAWS, REGULATIONS, ORDINANCES, REVIEW AND PERMIT REQUIREMENTS, AND OTHER AGENCY REQUIREMENTS, IF ANY, OF APPLICABLE AGENCIES INCLUDING, BUT NOT LIMITED TO, THE COLORADO DEPARTMENT OF WILDLIFE, COLORADO DEPARTMENT OF TRANSPORTATION, U.S. ARMY CORPS OF ENGINEERS, THE U.S. FISH & WILDLIFE SERVICE REGARDING THE ENDANGERED SPECIES ACT.
- 16. THE FOLLOWING REPORTS HAVE BEEN SUBMITTED IN ASSOCIATION WITH THE FINAL PLAT FOR THIS SUBDIVISION AND ARE ON FILE AT THE COUNTY DEVELOPMENT SERVICES DEPARTMENT: DRAINAGE REPORT, WATER RESOURCES REPORT, WASTEWATER DISPOSAL REPORT, GEOLOGY AND SOILS REPORT, FIRE PROTECTION REPORT.
- 17. STRUCTURAL FOUNDATIONS ON THE LOTS IN THIS SUBDIVISION SHALL BE DESIGNED BY A COLORADO REGISTERED PROFESSIONAL ENGINEER.
- 18. DRAINAGE EASEMENTS: NO PERMANENT DWELLING UNIT, TEMPORARY STRUCTURES, INCLUDING SHEDS AND OUT BUILDINGS, WATER WELL OR WASTEWATER TREATMENT SYSTEM MAY BE CONSTRUCTED IN THE DRAINAGE EASEMENTS SHOWN ON THIS PLAT. DRAINAGE CULVERTS AND FENCES THAT DO NOT BLOCK OR IMPEDE STORM WATER RUNOFF ARE ALLOWED IN AND ACROSS DRAINAGE EASEMENTS.
- 19. THE ADDRESSES EXHIBITED ON THIS PLAT ARE FOR INFORMATIONAL PURPOSES ONLY. THEY ARE NOT THE LEGAL DESCRIPTION AND ARE SUBJECT TO CHANGE.
- 20. PROPERTY WITHIN THIS SUBDIVISION IS SUBJECT TO THE TERMS AND PROVISIONS OF THE EL PASO COUNTY TRANSPORTATION IMPROVEMENT FEE RESOLUTION (RESOLUTION 18-471) AS AMENDED. FEES FOR EACH LOT WITHIN THIS SUBDIVISION SHALL BE PAID IN FULL AT THE TIME OF BUILDING PERMIT ISSUANCE.
- 21. THIS PROPERTY IS LOCATED WITHIN AND SERVICED BY THE MOUNTAIN VIEW ELECTRIC ASSOCIATION SERVICE DISTRICT, THE BLACK FOREST FIRE PROTECTION DISTRICT, EL PASO COUNTY SCHOOL DISTRICT NO. 20 AND THE BLACK HILLS ENERGY CORPORATION SERVICE DISTRICT.
- 22. SOILS, GEOLOGY, GEOLOGIC HAZARD, AND WASTEWATER STUDY FOR THIS SUBDIVISION DATED MARCH 4, 2020, PREPARED BY ENTECH ENGINEERING, INC.

FLOODPLAIN NOTE: FLOODPLAIN INSURANCE RATE MAP, MAP NUMBER 08041C03200 EFFECTIVE DATE DECEMBER 7, 2016, INDICATES THAT THE AREA WITHIN THE SURVEYED PROPERTY TO BE LOCATED IN ZONE X (AREAS DETERMINED TO BE OUTSIDE THE 500-YEAR FLOOD PLAIN).

Easements: Unless otherwise indicated, all side, front, and rear lot lines are hereby platted on either side with a 10 foot (use 5 feet for lots smaller than 2.5 acres) public utility and drainage easement unless otherwise indicated. All exterior subdivision boundaries are hereby platted with a 20 foot (use 7 feet for lots smaller than 2.5 acres) public utility and drainage easement. The sole responsibility for maintenance of these easements is hereby vested with the individual property owners.

UTILITY NOTES: ANY UTILITY COMPANY THAT LOCATES FACILITIES IN ANY EASEMENT SHALL HAVE THE RIGHT TO PRUNE, REMOVE, ERADICATE, CUT AND CLEAR AWAY ANY TREES, LIMBS, VINES AND BRUSH ON THE UTILITY EASEMENT NOW OR AT ANY FUTURE TIME AND PRUNE AND CLEAR AWAY ANY TREE LIMBS, VINES, AND BRUSH ON LANDS ADJACENT TO THE UTILITY EASEMENT WHENEVER, IN THE UTILITY COMPANIES JUDGMENT, SUCH MAY INTERFERE WITH OR ENDANGER THE CONSTRUCTION, OPERATION, OR MAINTENANCE OF ITS FACILITIES, TOGETHER WITH THE RIGHT OF INGRESS TO AND EGRESS FROM THE UTILITY EASEMENT AND CONTIGUOUS LAND SUBJECT TO THIS PLAT FOR THE PURPOSE OF SURVEYING, ERECTING, CONSTRUCTING, MAINTAINING, INSPECTING, REPAIRING, REPLACING, AND WITH OR ENDANGERING THE CONSTRUCTION, OPERATION OR MAINTENANCE OF SAID FACILITIES.

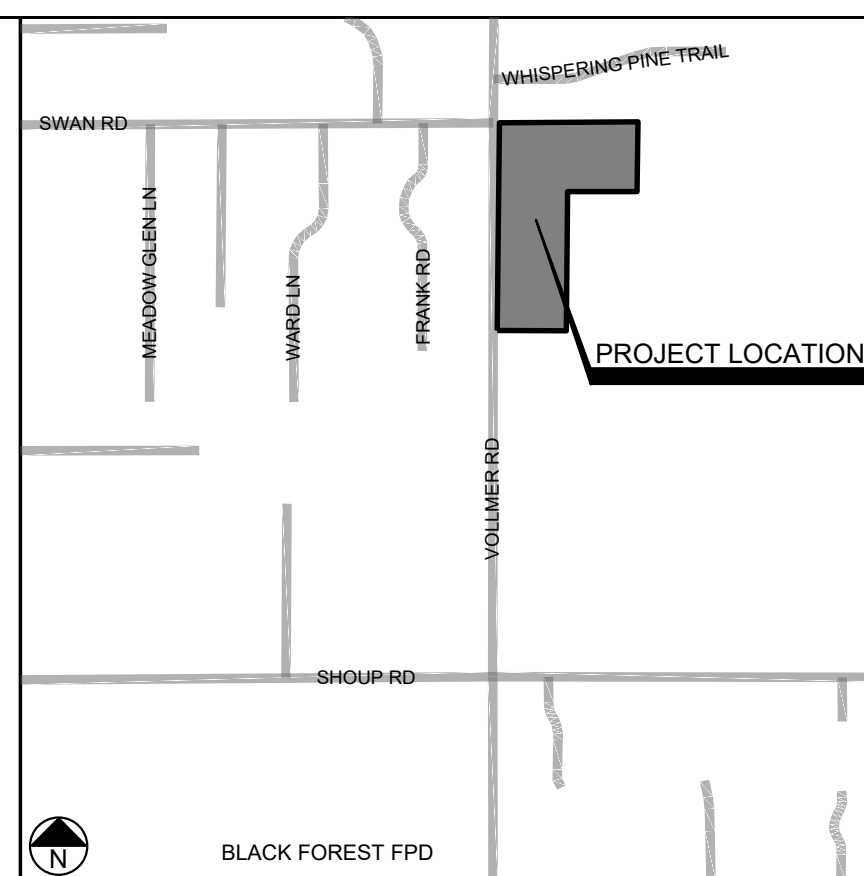

VICINITY MAP (NOT TO SCALE)


TOTAL ACREAGE:
LOT 1 = 19.31 ACRES
LOT 2 = 8.99 ACRES
LOT 3 = 4.75 ACRES
LOT 4 = 4.75 ACRES
DEDICATION = 0.80 ACRES
TOTAL = 37.70 ACRES

SERVICE PROVIDERS:
BLACK FOREST FIRE PROTECTION DISTRICT
MOUNTAIN VIEW ELECTRIC ASSOC.
BLACK HILLS ENERGY
EL PASO CO. TELEPHONE
INDIVIDUAL SEWAGE DISPOSAL SYSTEMS
DOMESTIC WELLS

FEES:
PARK FEE: _____
SCHOOL FEE: _____
BRIDGE FEE: _____
DRAINAGE FEE: _____

OWNER:
DANIEL S. ABEYTA AND JENNIFER A. ABEYTA
13251 VOLLMER ROAD
COLORADO SPRINGS, CO 80908
719-531-5000

Add to the end of this note: "particularly as it relates to the listed species (e.g. Preble's meadow jumping mouse)"

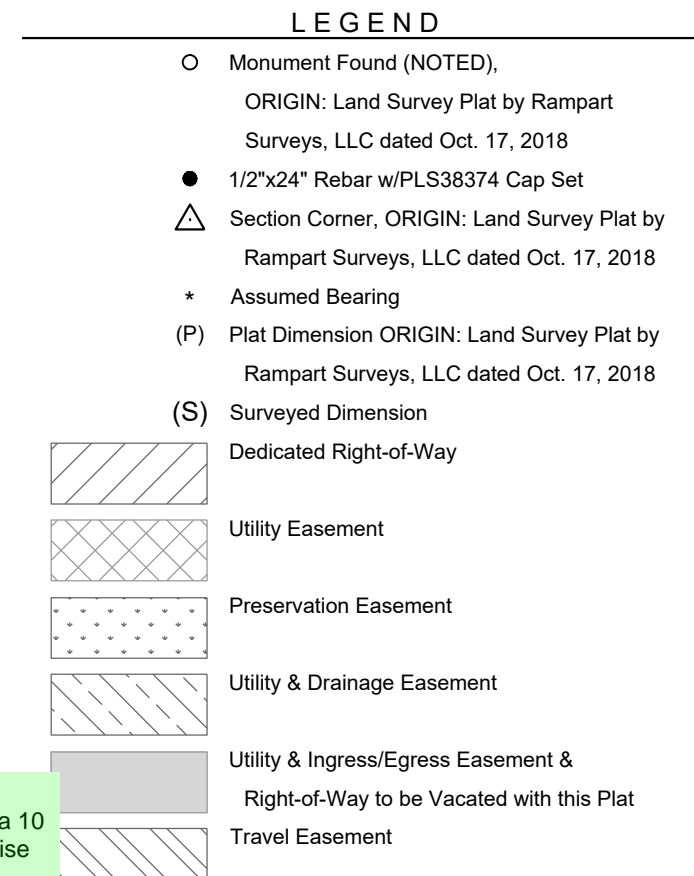

SEDONA SUN ACRES FILING NO. 1 IN THE NORTHWEST QUARTER OF SECTION 10, T12S, R65W, 6TH P.M. El Paso County, Colorado



Civil Engineering • Land Surveying • Landscape Architecture
www.smhconsultants.com

an, KS - HQ P: (785) 776-0541 • Dodge City, KS P: (620) 255-1552
ark, KS P: (613) 444-9615 • Colorado Springs, CO P: (719) 465-2145

Drawn by: ASJ Project #1908CS4030 DD #TDS78

APRIL 2020

Add PCD File # MS203