

WOODBURY HULL BOUNDARY ADJUSTMENT

BEING A PART OF THE NORTHEAST QUARTER OF SECTION 28,
TOWNSHIP 11 SOUTH, RANGE 66 WEST OF THE 6TH PRINCIPAL MERIDIAN,
COUNTY OF EL PASO, STATE OF COLORADO.

REVISE: Title on all sheets - MCLEAN SUBDIVISION FILING NO. 1A

REVISE: This should say, "A REPLAT OF LOTS 1 AND 2 OF MCLEAN SUBDIVISION", then section, township, range, county, state on all sheets.

All Plat Notes from 15442 need to be carried over to this document.
Title should say "PLAT NOTES"

PARCEL DETAILS

Address: 2815 Hodgen Road, Colorado Springs, Colorado, 80921
APN/Parcel ID: 6128101005
Owner of Record: Donald James Hull Living Trust and Linda Marie Larriva Hull Living Trust.

Address: 2458 Hodgen Road, Colorado Springs, Colorado, 80921
APN/Parcel ID: 6128101006
Owner of Record: Woodbury Family Trust.

LAND OWNER CERTIFICATION

IN WITNESS WHEREOF:

Donald James Hull Living Trust and Linda Marie Larriva Hull Living Trust, has executed these presents this _____ day of _____, 20____

Donald James Hull, Owner
Marie Larriva Hull, Owner

UPDATE BOTH:

DONALD JAMES HULL LIVING TRUST

LINDA MARIE LARRIVA HULL LIVING TRUST

State of Colorado }
County of El Paso } ss

Signed before me on _____, 20____, by
Donald James Hull and Marie Larriva Hull, owners.

, Trustee.

Notary Public

Commision Expiration: _____

LAND OWNER CERTIFICATION

IN WITNESS WHEREOF:

Woodbury Family Trust, has executed these presents this _____ day of _____, 20____

Doug Woodbury, Owner

UPDATE:

WOODBURY FAMILY TRUST

State of Colorado }
County of El Paso } ss

Signed before me on _____, 20____, by
Doug Woodbury, owner.

, Trustee.


Notary Public

Commision Expiration: _____

AREAS OF CONCERN

(AOC#1): Portion of rock landscaping encroaches westerly onto subject parcel, as graphically depicted on this Subdivision Plat, causing an area of concern.

(AOC#2): Portion of westerly adjacent monuments falls westerly of subject parcel boundary, as graphically depicted on this Subdivision Plat, and falling short of projected graphically depicted location of said 30 foot right-of-way for access and utility purposes lying Easterly and Southerly and adjoining the Easterly and Southerly lines of said recorded tract, recorded in Book 1121 at Page 163, causing an area of concern.

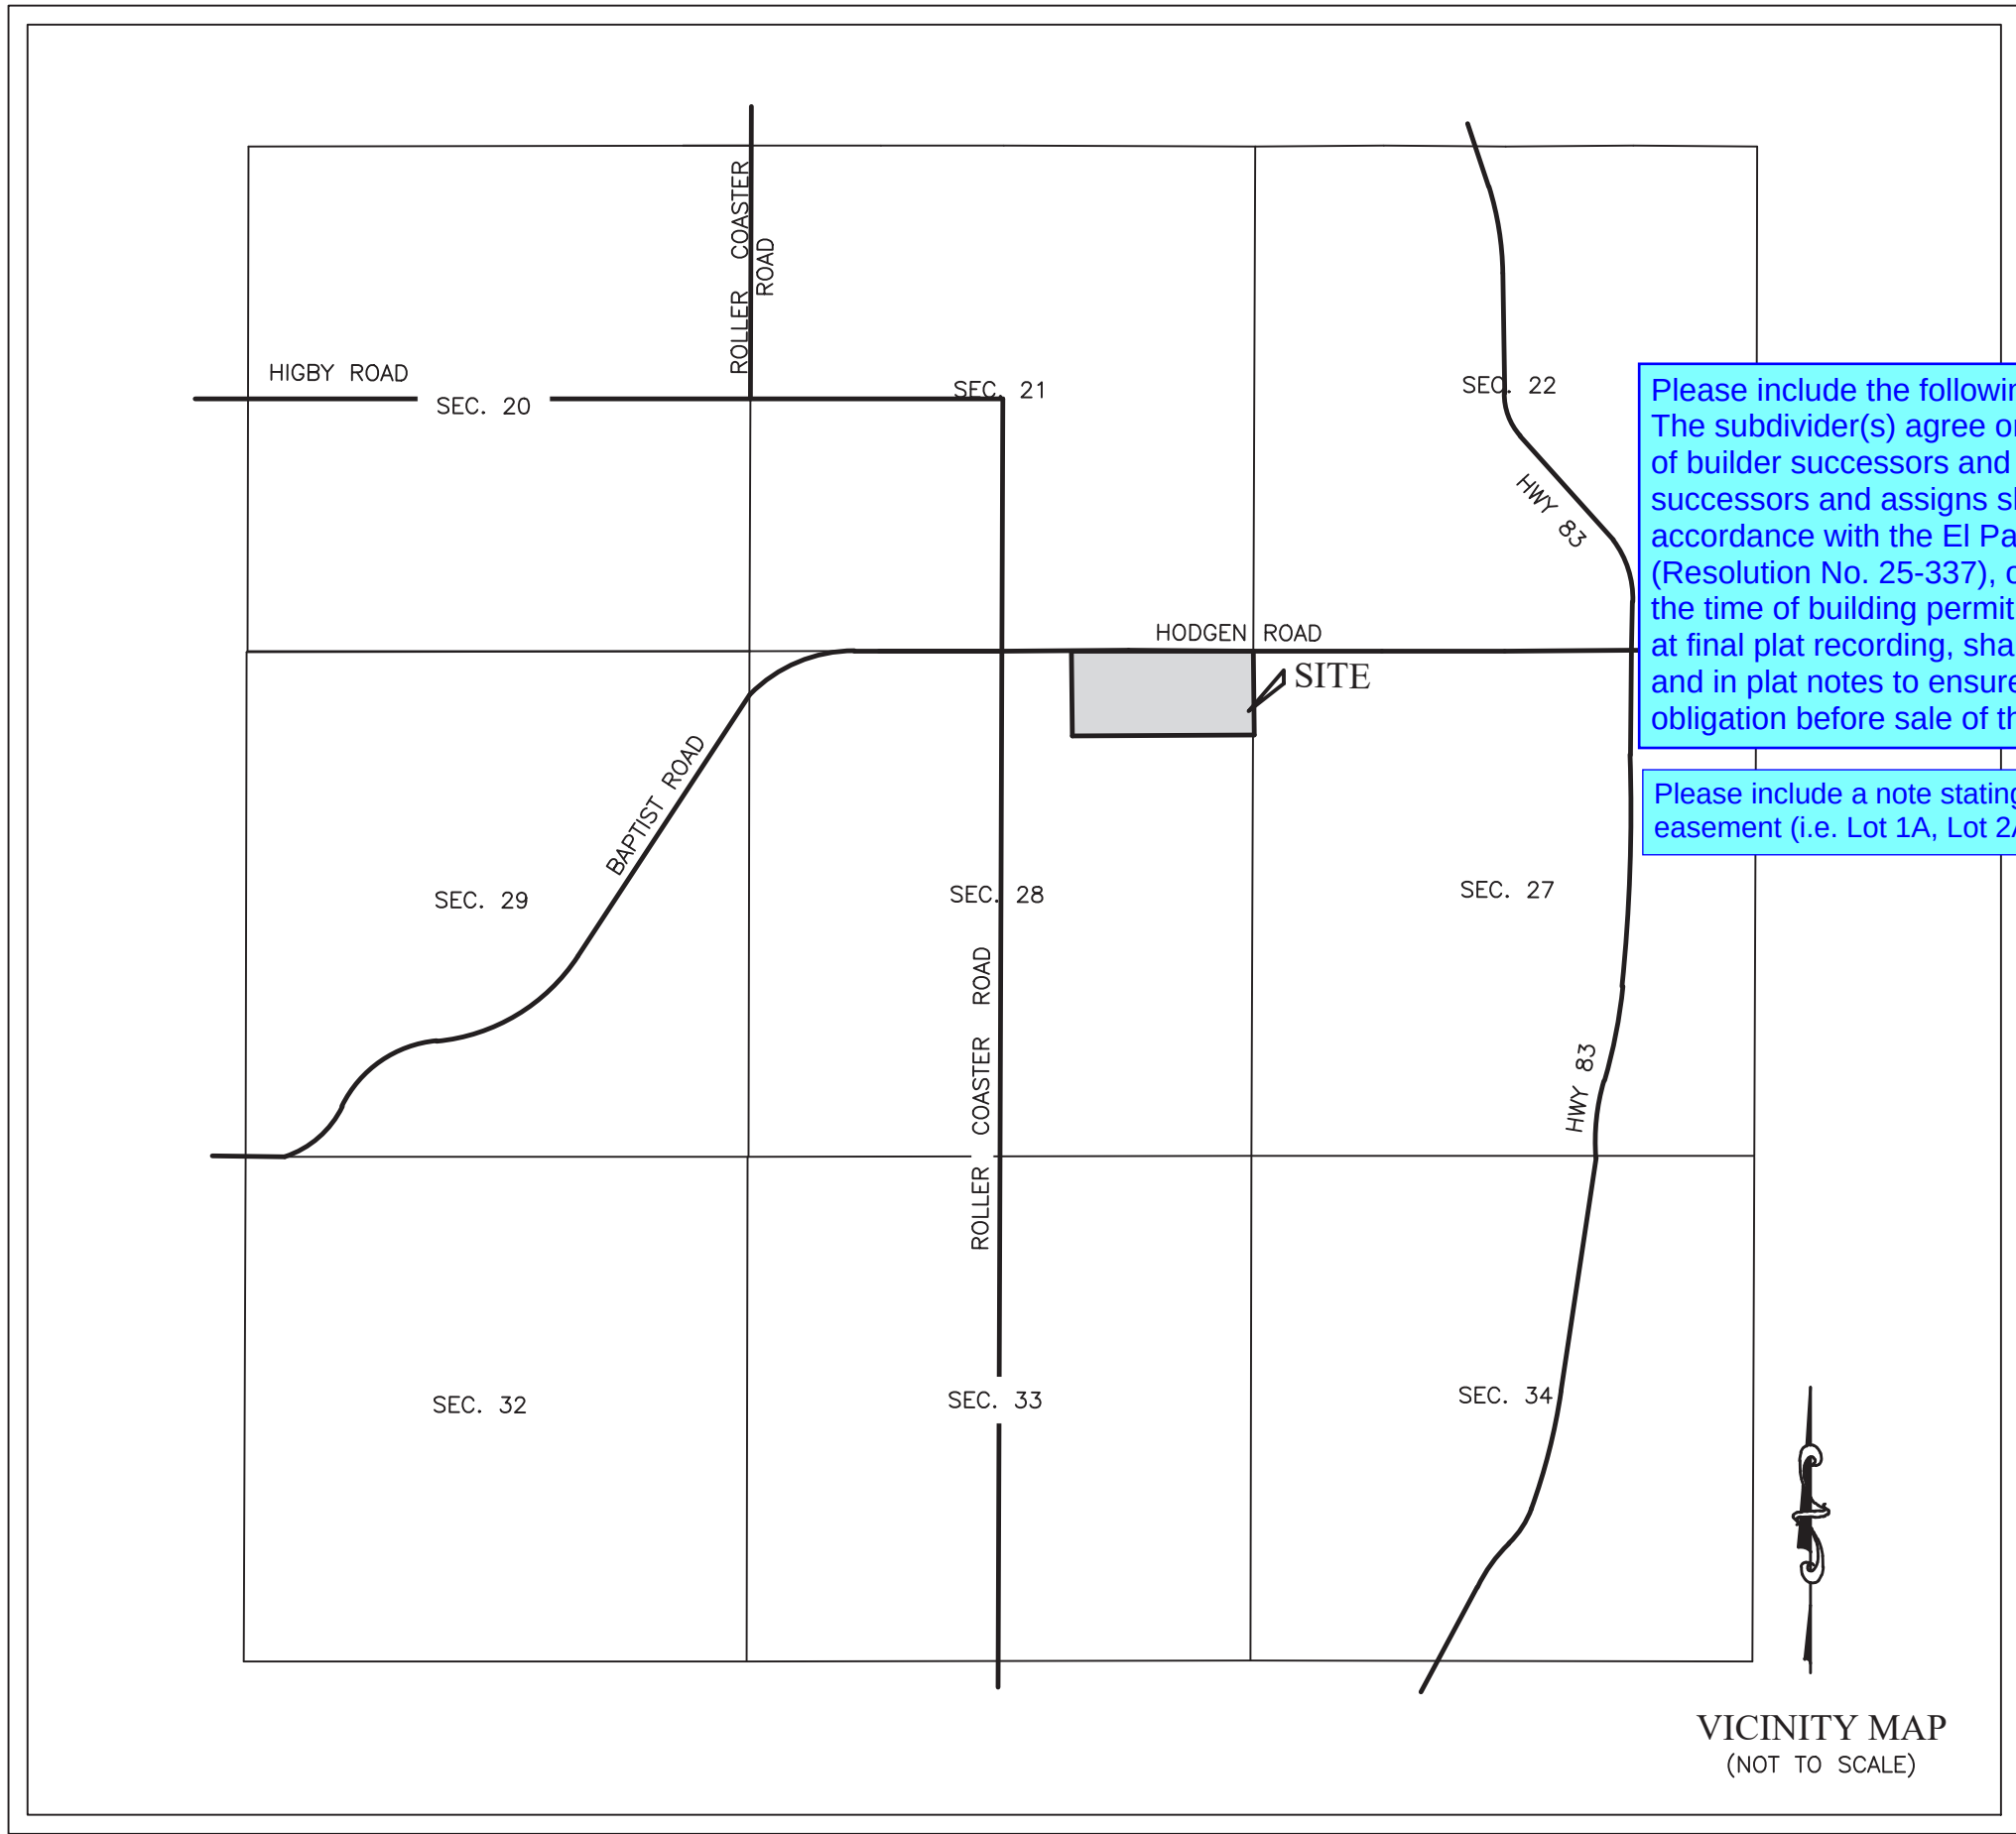

Please include the following standard notes for engineering, note numbers are referenced to original plat no. 15442.

- Driveway access permit, Note 3.
- Access restriction, Note 7.
- Floodplain, Note 8.
- Stormwater drainage, Note 11.
- Driveway construction, Note 13.

Please include the following note:
The subdivider(s) agree on behalf of him/herself and any developer of builder successors and assignees that subdivider and/or said successors and assigns shall be required to pay traffic impact fees in accordance with the El Paso County Road Impact Fee Program (Resolution No. 25-337), or any amendments thereto, at or prior to the time of building permit submittals. The fee obligation, if not paid at final plat recording, shall be documents on all sales documents and in plat notes to ensure that a title search would find the fee obligation before sale of the property.

Please include a note stating the maintenance responsibility of the access easement (i.e. Lot 1A, Lot 2A or both).

SURVEYOR'S NOTES

- NOTICE: According to Colorado law you must commence any legal action based upon any defect in this survey within three years after you first discover such defect. In no event may any action based upon any defect in this survey be commenced more than ten years from the date of the certification shown hereon.
- Any person who knowingly removes, alters or defaces any public land survey monument or land boundary monument or accessory commits a class 2 misdemeanor pursuant to the Colorado Revised Statute 18-4-508.
- The lineal units used in this drawing are U.S. Survey Feet.
- The overall subject parcel contains a calculated area of 1,684,120 square feet (38.66 acres) of land, more or less. Subject parcel to be divided into two lots as shown hereon.
- This survey does not constitute a title search by Apex Land Surveying and Mapping, LLC, to determine ownership or easements of record. A current title commitment was not provided at the time of survey. Easements shown are per McClean Subdivision by Reception Number 224715442.
- Bearings are based on a portion of the East line of the Northeast quarter of Section 28, T11S, R66W of the 6th Principal Meridian, monumented on the South end with a found No. 4 rebar with a 1-1/4" plastic cap, PLS 2372, 0.2' below grade, and on the North end with a found 3-1/2" aluminum cap, PLS 17496, 0.6' below grade in range box, and is to bear N.00°16'45"E., a measured distance of 911.54' feet.
- Any underground or above ground utilities shown hereon have been located from field survey information. Apex Land Surveying and Mapping, LLC, does not guarantee said underground utilities to be shown in their exact location and that said underground utilities are shown in their entirety. Apex Land Surveying and Mapping, LLC, did not physically enter any manholes or inlets to verify size and material. Where additional or more detailed information is required, the client is advised that excavation may be necessary.
- Reception No. 200121614 calls for Grant of Right Of Way being an easement of ten 10 feet either side of power line and guy wires on NE 1/4 Section 28, County of El Paso, State of Colorado, which lot is on Hodgen Road. Surveyor did not observe any Guy wires or above ground power lines on Subject parcel. Surveyor observed Power poles and above ground lines East of Subject parcel travelening North/South in direction, and did not observe any on subject parcel.
- 30 foot right-of-way for access and utility purposes lying Easterly and Southerly and adjoining the Easterly and Southerly lines of said recorded tract, recorded in Book 1121 at Page 163. This is graphically depicted on this survey per a previous Monumented Land Survey Plat by Vernon P. Taylor, PLS 25966, deposited on the 18th day of October, 2001 under Deposit No. 201900415, Page No. 61280 as shown on this Land Survey Plat. Due to the ambiguity of the legal description and monumented evidence found (AOC#2) for the 30 foot right-of-way for access and utility purposes lying Easterly and Southerly and adjoining the Easterly and Southerly lines of said recorded tract, recorded in Book 1121 at Page 163, and based on monumented evidence found, surveyor interprets it to be Westerly of Westerly boundary line as graphically depicted on this plat. (See Note #11).
- Surveyor has discovered monumented evidence Westerly of subject parcel that surveyor graphically depicts the intended location of said 30 foot right-of-way for access and utility purposes lying Easterly and Southerly and adjoining the Easterly and Southerly lines of said recorded tract, recorded in Book 1121 at Page 163. See (AOC#2) note.

SURVEYOR'S CERTIFICATE

I, Danny Rodic, a duly registered Professional Land Surveyor in the State of Colorado, do hereby certify that this plat truly and correctly represents the results of a survey made on date of survey, by me or under my direct supervision and that all monuments exist as shown hereon; that mathematical closure errors are less than 1:10,000 ; and that said plat has been prepared in full compliance with all applicable laws of the State of Colorado dealing with monuments, subdivision, or surveying of land and all applicable provisions of the El Paso County Land Development Code.

I attest the above on this _____ day of _____, 20____.

DRAFT

ADD THIS SIGNATURE BLOCK:

This plat for MCLEAN SUBDIVISION FILING NO. 1A was approved for filing by the El Paso County, Colorado Planning and Community Development Department Director on the _____ day of _____, 20____, subject to any notes or conditions specified hereon.

Surveyor's Name, (Sign _____)

Colorado Registered PLS _____

Previous plat name in entirety is amended for the areas described by this Lot Line Adjustment subject to all covenants, conditions, and restrictions recorded against and appurtenant to the original plat recorded in the Office of the El Paso County Clerk and Recorder, Reception # 224715442.

Planning and Community Development Director

CLERK AND RECORDER:

State of Colorado }
County of El Paso } ss

I certify that this instrument was filed for record in my office at _____ O'Clock _____, this _____ day of _____, 20____, A.D.
and is duly recorded in plat book _____, at page number _____,
under Reception No. _____, of the records of El Paso County,
Colorado.


Fee: _____

By: _____
El Paso County Clerk and Recorder

VR269

PDC File No: XX XX

DATE: August 3, 2026		REVISIONS	
No.	Remarks	Date	By
Field: TJM/DDR	Drawn: DDR	Checked: DDR	

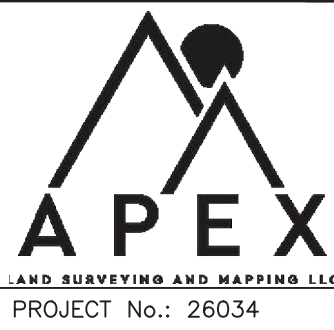

APEX Land Surveying and Mapping LLC.

6130 Spurwood Drive
Colorado Springs, CO 80918
Phone: 719-318-0377
E-mail: info@apexsurveyor.com
Website: www.apexsurveyor.com


PROJECT No.: 26034

SHEET 1 OF 3


Many engineering comments apply to both this sheet and the next one.

WOODBURY HULL BOUNDARY ADJUSTMENT

BEING A PART OF THE NORTHEAST QUARTER OF SECTION 28,
TOWNSHIP 11 SOUTH, RANGE 66 WEST OF THE 6TH PRINCIPAL MERIDIAN,
COUNTY OF EL PASO, STATE OF COLORADO.

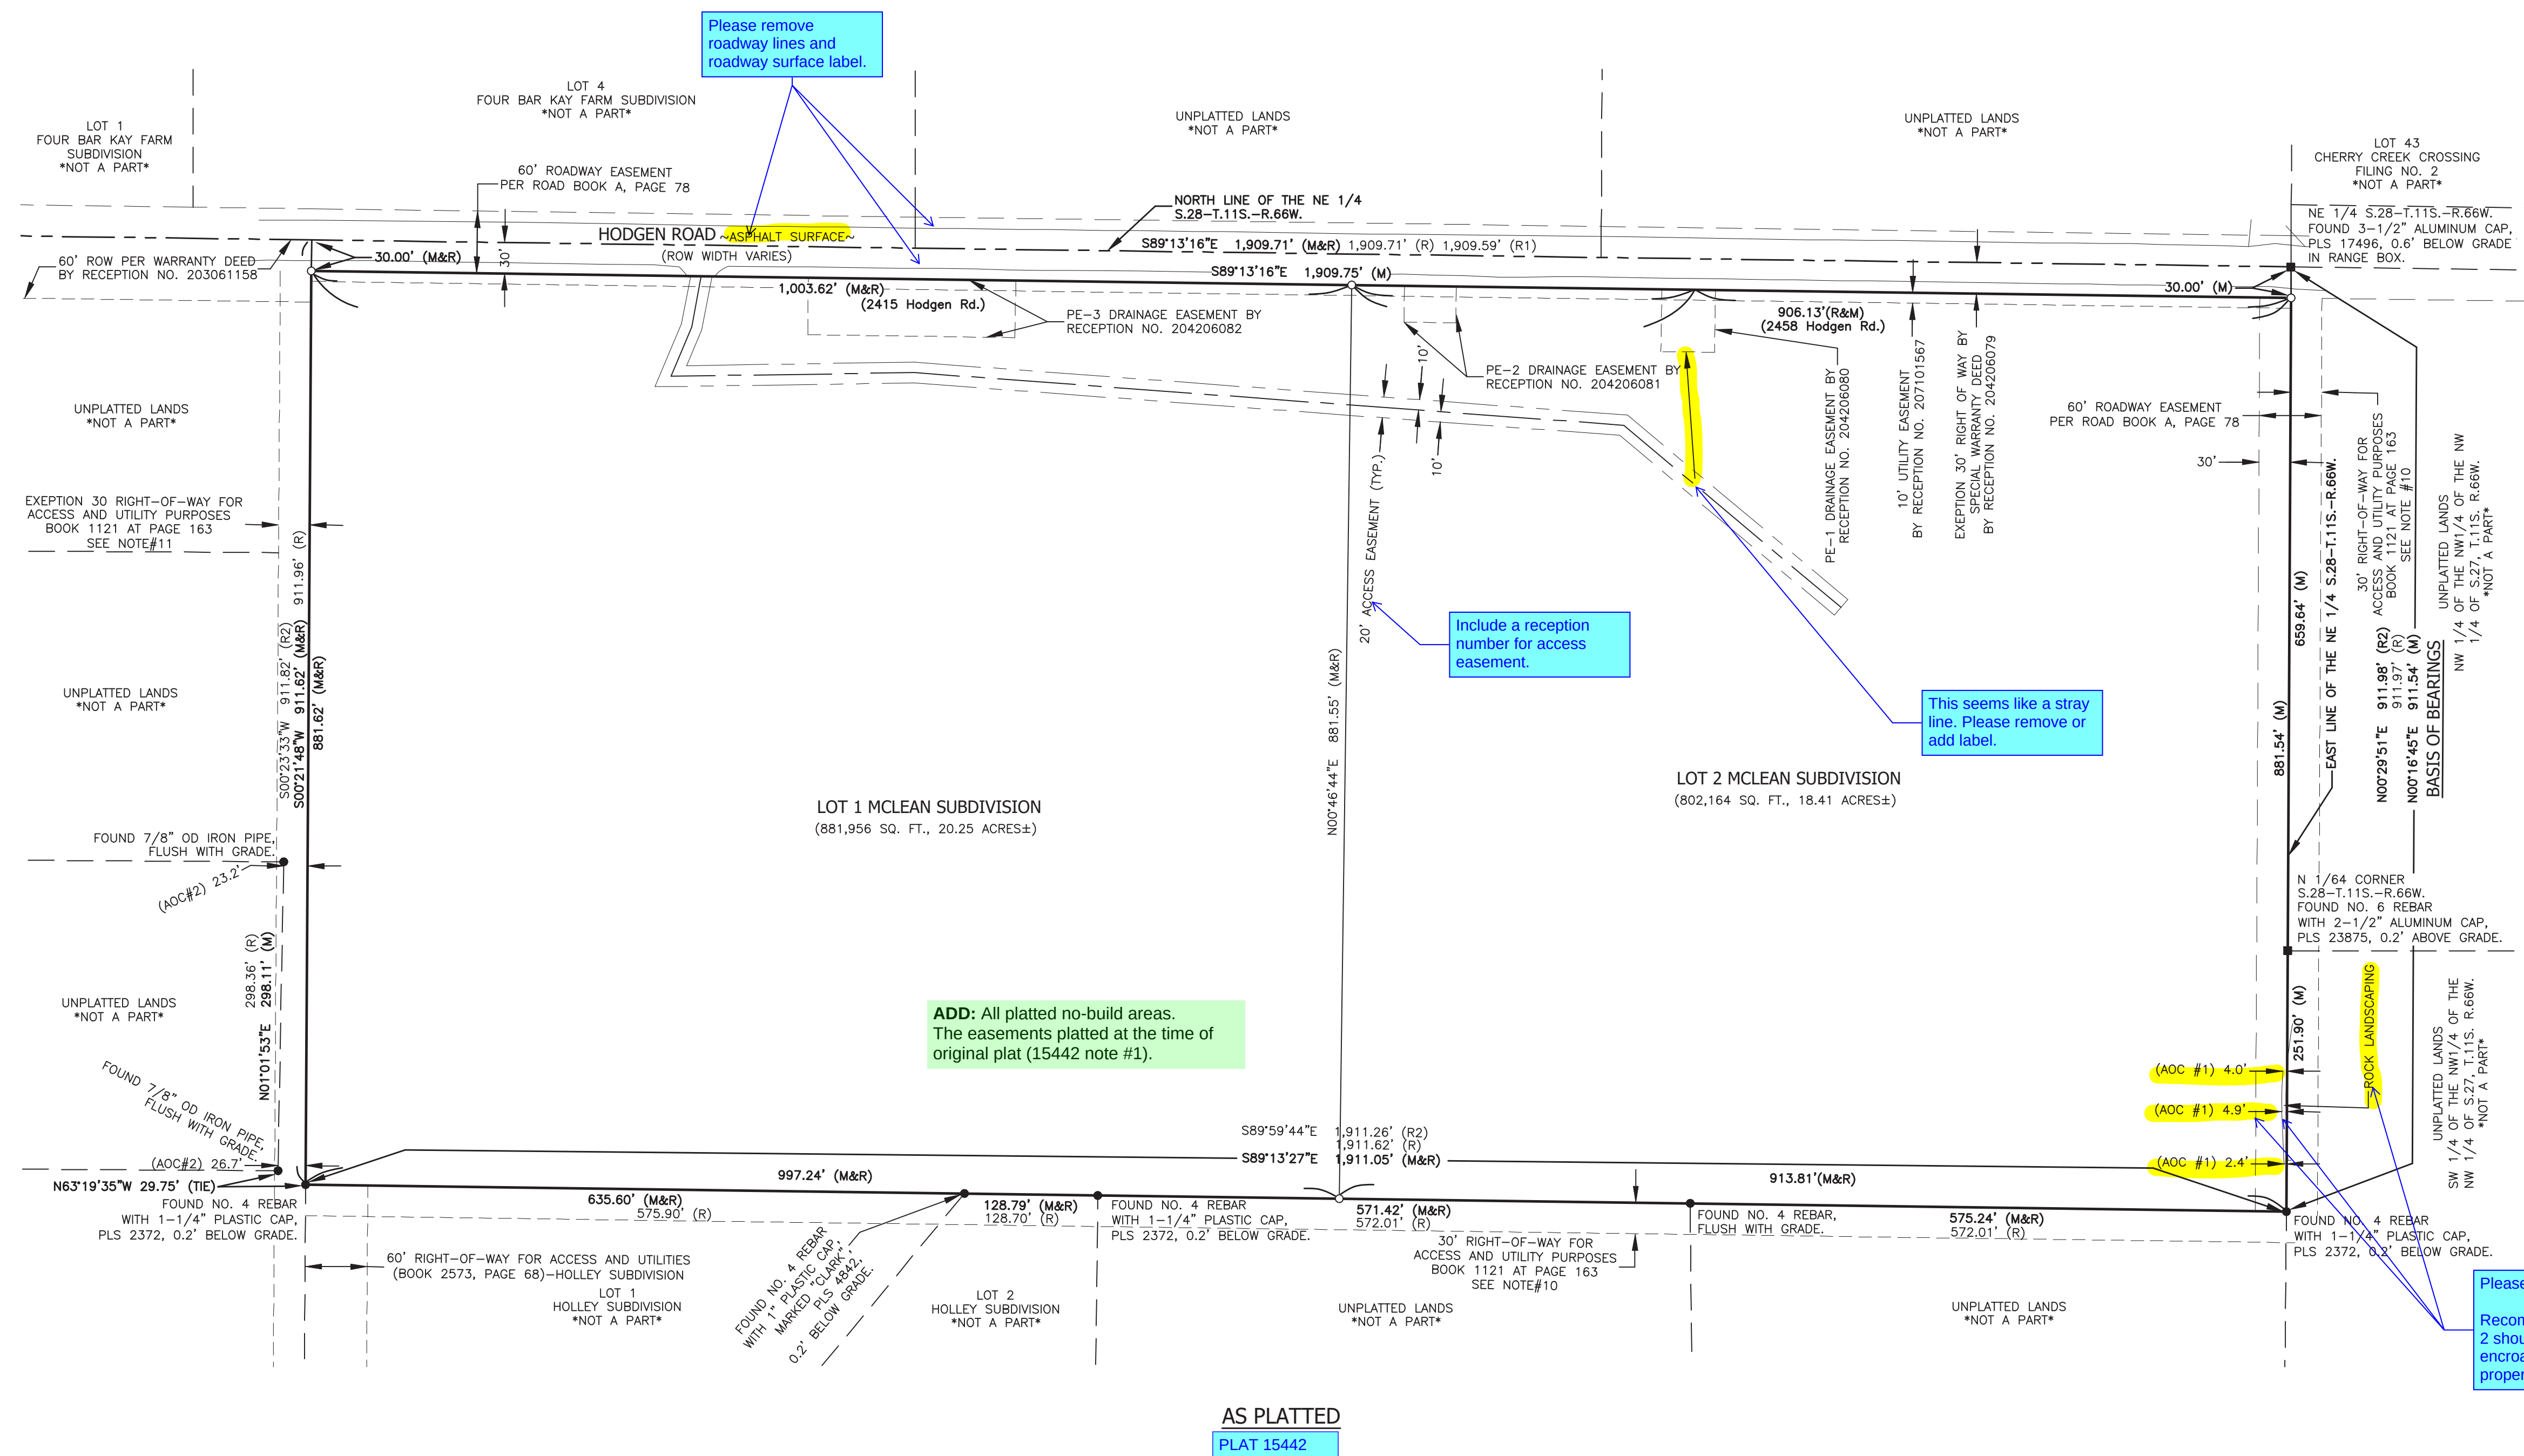

DRAFT

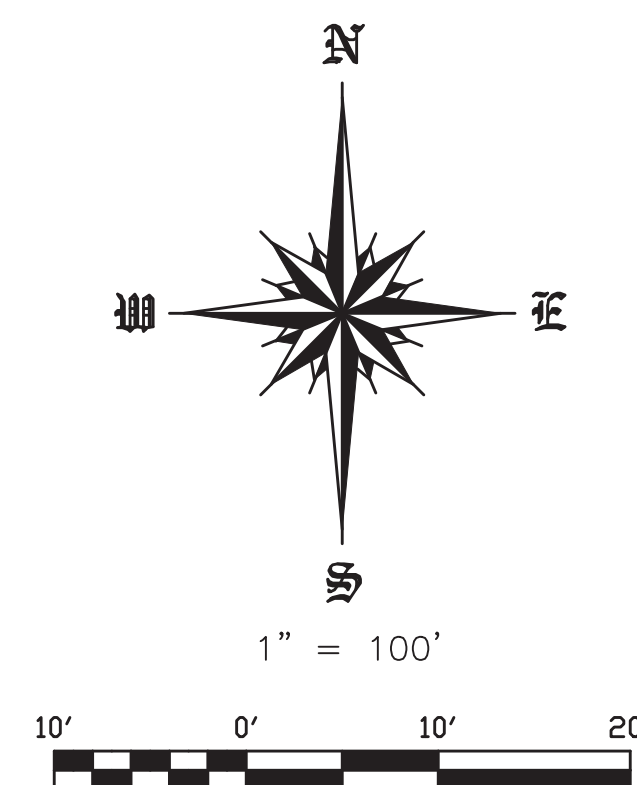

LEGEND

- PLSS MONUMENT FOUND AS NOTED
 - MONUMENT FOUND AS NOTED
 - FOUND NO. 5 REBAR WITH 1-1/4" PLASTIC CAP, PLS 38759, FLUSH WITH GRADE.
- (R) RECORD VALUE
- (M) MEASURED VALUE
- (AOC#-) AREA OF CONCERN

DATE: August 3, 2026		REVISIONS	
No.	Remarks	Date	By
Field: TJM/DDR	Drawn: DDR	Checked: DDR	



APEX Land Surveying and Mapping LLC.
6130 Spurwood Drive
Colorado Springs, CO 80918
Phone: 719-318-0377
E-mail: info@apexsurveyor.com
Website: www.apexsurveyor.com

R269

PDC File No: XX XX

PAGE 2 OF 3

WOODBURY HULL BOUNDARY ADJUSTMENT EXHIBIT

BEING A PART OF THE NORTHEAST QUARTER OF SECTION 28, TOWNSHIP 11 SOUTH, RANGE 66 WEST OF THE 6TH PRINCIPAL MERIDIAN, COUNTY OF EL PASO, STATE OF COLORADO.

See comment on Page 1.

The El Paso County 2045 Major Transportation Corridors Plan depicts the Hodgen Road classification as a minor arterial roadway with planned improvements. EPC is requesting an additional 20' of Right of Way preservation (reserving the land for the County to purchase from property owners in the future) to accommodate planned improvements. If the applicant wishes to preserve 20' of Right of Way in response to this request, please depict on this drawing.

It isn't very clear what some of the dimensions are referring to (2 examples highlighted). Please revise for clarity.

ADD: All platted no-build areas. The easements platted at the time of original plat (15442 note #1).


AS ADJUSTED

LEGEND

- PLSS MONUMENT FOUND AS NOTED
- MONUMENT FOUND AS NOTED
- FOUND NO. 5 REBAR WITH 1-1/4" PLASTIC CAP, PLS 38759, FLUSH WITH GRADE.
- (R) RECORD VALUE
- (M) MEASURED VALUE
- (AOC#_) AREA OF CONCERN

DRAFT

Remember to remove "DRAFT" for next submittal.

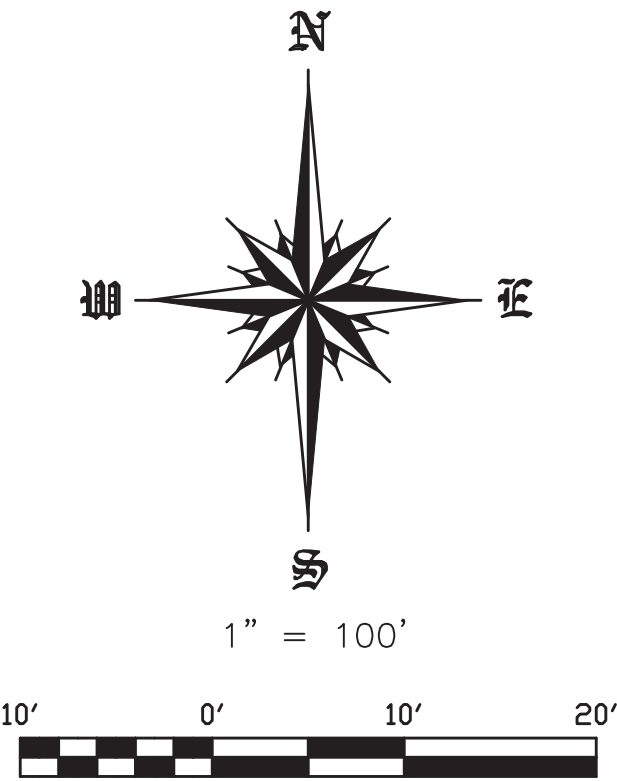

DATE: August 3, 2026		REVISIONS	
No.	Remarks	Date	By
Field: TJM/DDR	Drawn: DDR	Checked: DDR	



APEX Land Surveying and Mapping LLC.
6130 Spurwood Drive
Colorado Springs, CO 80918
Phone: 719-318-0377
E-mail: info@apexsurveyor.com
Website: www.apexsurveyor.com

PROJECT No.: 26034

VR269

PDC File No: XX XX

SHEET 3 OF 3

V1_Final Plat Drawings_COMMENTS.pdf Markup Summary

Joseph Sandstrom (20)

Please include the following standard notes for engineering. Note numbers are referenced to original plat no. 15442.

- Driveway access permit, Note 3.
- Access restriction, Note 7.
- Floodplain, Note 8.
- Stormwater drainage, Note 11.
- Driveway construction, Note 13.

Subject: Text Box
Page Label: 1
Author: Joseph Sandstrom
Date: 9/28/2026 11:55:54 AM
Status:
Color: ■
Layer:
Space:

Please include the following standard notes for engineering, note numbers are referenced to original plat no. 15442.

- Driveway access permit, Note 3.
- Access restriction, Note 7.
- Floodplain, Note 8.
- Stormwater drainage, Note 11.
- Driveway construction, Note 13.

Please include the following note:
The subdividers agree on behalf of him/herself and any developer of builder successors and assignees that subdivider and/or said successors and assignees shall be required to pay traffic impact fees in accordance with the El Paso County Road Impact Fee Program (Resolution No. 25-337), or any amendments thereto, at or prior to the time of building permit submittals. The fee obligation, if not paid at final plat recording, shall be documents on all sales documents and in plat notes to ensure that a title search would find the fee obligation before sale of the property.

Subject: Road Impact Fees:
Page Label: 1
Author: Joseph Sandstrom
Date: 9/28/2026 11:56:39 AM
Status:
Color: ■
Layer:
Space:

Please include the following note:
The subdivider(s) agree on behalf of him/herself and any developer of builder successors and assignees that subdivider and/or said successors and assignees shall be required to pay traffic impact fees in accordance with the El Paso County Road Impact Fee Program (Resolution No. 25-337), or any amendments thereto, at or prior to the time of building permit submittals. The fee obligation, if not paid at final plat recording, shall be documents on all sales documents and in plat notes to ensure that a title search would find the fee obligation before sale of the property.

Please include a note stating the maintenance responsibility of the access easement (i.e. Lot 1A, Lot 2A or both).

Subject: Text Box
Page Label: 1
Author: Joseph Sandstrom
Date: 9/28/2026 3:46:37 PM
Status:
Color: ■
Layer:
Space:

Please include a note stating the maintenance responsibility of the access easement (i.e. Lot 1A, Lot 2A or both).

AS PLATTED
PLAT 15442


Subject: Text Box
Page Label: 2
Author: Joseph Sandstrom
Date: 9/24/2026 5:18:26 PM
Status:
Color: ■
Layer:
Space:

PLAT 15442

20' ACCESS EASE
Include a reception number for access easement.


Subject: Callout
Page Label: 2
Author: Joseph Sandstrom
Date: 9/29/2026 9:09:35 AM
Status:
Color: ■
Layer:
Space:

Include a reception number for access easement.

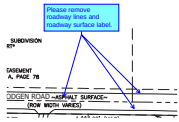


Subject: Callout
Page Label: 2
Author: Joseph Sandstrom
Date: 9/29/2026 9:01:23 AM
Status:
Color: ■
Layer:
Space:


Please remove roadway lines and roadway surface label.

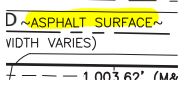


Subject: Highlight
Page Label: 2
Author: Joseph Sandstrom
Date: 9/24/2026 5:21:31 PM
Status:
Color: ■
Layer:
Space:

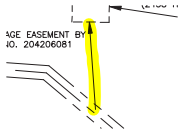


Subject: Highlight
Page Label: 2
Author: Joseph Sandstrom
Date: 9/24/2026 5:25:53 PM
Status:
Color: ■
Layer:
Space:

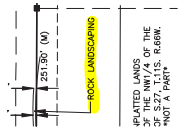


Subject: Highlight
Page Label: 2
Author: Joseph Sandstrom
Date: 9/24/2026 5:28:04 PM
Status:
Color: ■
Layer:
Space:

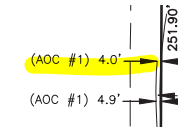


Subject: Highlight
Page Label: 2
Author: Joseph Sandstrom
Date: 9/28/2026 9:34:09 AM
Status:
Color: ■
Layer:
Space:

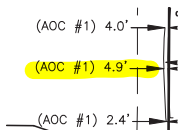

Subject: Highlight
Page Label: 2
Author: Joseph Sandstrom
Date: 9/28/2026 9:34:11 AM
Status:
Color: ■
Layer:
Space:

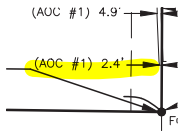


Subject: Highlight
Page Label: 2
Author: Joseph Sandstrom
Date: 9/28/2026 9:34:12 AM
Status:
Color: 
Layer:
Space:

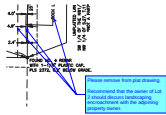

Subject: Callout
Page Label: 2
Author: Joseph Sandstrom
Date: 9/29/2026 9:00:43 AM
Status:
Color: 
Layer:
Space:


Please remove from plat drawing.

Recommend that the owner of Lot 2 should discuss landscaping encroachment with the adjoining property owner.

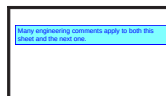


Subject: Text Box
Page Label: 2
Author: Joseph Sandstrom
Date: 9/29/2026 7:49:30 AM
Status:
Color: 
Layer:
Space:

Many engineering comments apply to both this sheet and the next one.

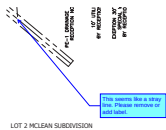


Subject: Callout
Page Label: 2
Author: Joseph Sandstrom
Date: 9/28/2026 3:45:11 PM
Status:
Color: 
Layer:
Space:

This seems like a stray line. Please remove or add label.

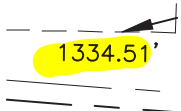

Subject: Highlight
Page Label: 3
Author: Joseph Sandstrom
Date: 9/28/2026 3:37:31 PM
Status:
Color: 
Layer:
Space:

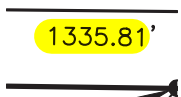

Subject: Highlight
Page Label: 3
Author: Joseph Sandstrom
Date: 9/28/2026 3:37:40 PM
Status:
Color: 
Layer:
Space:




Subject: Callout
Page Label: 3
Author: Joseph Sandstrom
Date: 9/28/2026 3:41:58 PM
Status:
Color: ■
Layer:
Space:

It isn't very clear what some of the dimensions are referring to (2 examples highlighted). Please revise for clarity.



Subject: Callout
Page Label: 3
Author: Joseph Sandstrom
Date: 9/29/2026 8:59:34 AM
Status:
Color: ■
Layer:
Space:

The El Paso County 2045 Major Transportation Corridors Plan depicts the Hodgen Road classification as a minor arterial roadway with planned improvements. EPC is requesting an additional 20' of Right of Way preservation (reserving the land for the County to purchase from property owners in the future) to accommodate planned improvements. If the applicant wishes to preserve 20' of Right of Way in response to this request, please depict on this drawing.

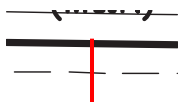

Subject: Line
Page Label: 3
Author: Joseph Sandstrom
Date: 9/29/2026 8:59:42 AM
Status:
Color: ■
Layer:
Space:

MirandaBenson2 (27)



Subject: Planner
Page Label: 1
Author: MirandaBenson2
Date: 9/9/2026 12:16:30 PM
Status:
Color: ■
Layer:
Space:

UPDATE BOTH:



Subject: Planner
Page Label: 1
Author: MirandaBenson2
Date: 9/9/2026 12:13:49 PM
Status:
Color: ■
Layer:
Space:

REVISE: Title on all sheets - MCLEAN SUBDIVISION FILING NO. 1A



Subject: Planner
Page Label: 1
Author: MirandaBenson2
Date: 10/2/2026 11:15:22 AM
Status:
Color: ■
Layer:
Space:

REVISE: This should say, "A REPLAT OF LOTS 1 AND 2 OF MCLEAN SUBDIVISION", then section, township, range, county, state on all sheets.

DONALD JAMES HULL LIVING TRUST
LINDA MARIE LARRIVA HULL LIVING TRUST

Subject: Planner
Page Label: 1
Author: MirandaBenson2
Date: 9/9/2026 12:16:54 PM
Status:
Color: 
Layer:
Space:

Subject: Image
Page Label: 1
Author: MirandaBenson2
Date: 9/9/2026 12:16:48 PM
Status:
Color: 
Layer:
Space:

— WOODBURY FAMILY TRUST

Subject: Architect
Page Label: 1
Author: MirandaBenson2
Date: 9/9/2026 12:17:07 PM
Status:
Color: 
Layer:
Space:

Marie Larriva Hull, Owner
State of Colorado }
County of El Paso } ss

Signed before me on _____ 20____
Constance James Hull and Marie Larriva Hull, canera.

Notary Public

Subject: Architect
Page Label: 1
Author: MirandaBenson2
Date: 9/9/2026 12:17:15 PM
Status:
Color: 
Layer:
Space:

Doug Woodbury, owner.

Subject: Planner
Page Label: 1
Author: MirandaBenson2
Date: 9/9/2026 12:18:13 PM
Status:
Color: 
Layer:
Space:

CORRECT: (AS PLATTED)

Paso, State of Colorado.
- 225027277.)

Paso, State of Colorado,
r 225027277.)

CORRECT: (AS PLATTED)

E,
Paso, State of Colorado,
r 224094090.)

Subject: Planner
Page Label: 1
Author: MirandaBenson2
Date: 9/9/2026 12:18:25 PM
Status:
Color: ■
Layer:
Space:

CORRECT: (AS PLATTED)

VR269
XX XX

Subject: Planner
Page Label: 1
Author: MirandaBenson2
Date: 9/9/2026 12:25:32 PM
Status:
Color: ■
Layer:
Space:

VR269

STED)
) **ADJUSTED LOT 1A**
Clean Subdivision by Reception
Number 224715442 as follows

Subject: Planner
Page Label: 1
Author: MirandaBenson2
Date: 9/30/2026 2:11:08 PM
Status:
Color: ■
Layer:
Space:

ADJUSTED LOT 1A

t (27.02 Acres) of land, is
) **ADJUSTED LOT 2A**
by Reception Number 224715442 as follows:

Subject: Planner
Page Label: 1
Author: MirandaBenson2
Date: 9/30/2026 2:11:16 PM
Status:
Color: ■
Layer:
Space:

ADJUSTED LOT 2A


This document is a copy of a document filed with the El Paso County Clerk and Recorder, Reception # 224715442. It is not a certified copy. The original document is the only one that should be used for any legal purposes. This document is a copy of a document filed with the El Paso County Clerk and Recorder, Reception # 224715442. It is not a certified copy. The original document is the only one that should be used for any legal purposes.

Subject: Admin Replat
Page Label: 1
Author: MirandaBenson2
Date: 9/30/2026 3:08:49 PM
Status:
Color: ■
Layer:
Space:

ADD THIS SIGNATURE BLOCK:
This plat for MCLEAN SUBDIVISION FILING NO. 1A was approved for filing by the El Paso County, Colorado Planning and Community Development Department Director on the _____ day of _____, 20__, subject to any notes or conditions specified hereon.

Previous plat name in entirety is amended for the areas described by this Lot Line Adjustment subject to all covenants, conditions, and restrictions recorded against and appurtenant to the original plat recorded in the Office of the El Paso County Clerk and Recorder, Reception # 224715442.

Planning and Community Development Director

20____, by
, Trustee.

Subject: Planner
Page Label: 1
Author: MirandaBenson2
Date: 9/30/2026 3:09:55 PM
Status:
Color: 
Layer:
Space:

, Trustee.

, Trustee.

Subject: Planner
Page Label: 1
Author: MirandaBenson2
Date: 9/30/2026 3:10:06 PM
Status:
Color: 
Layer:
Space:

, Trustee.



Subject: Planner
Page Label: 1
Author: MirandaBenson2
Date: 9/30/2026 3:45:08 PM
Status:
Color: 
Layer:
Space:

All Plat Notes from 15442 need to be carried over to this document.
Title should say "PLAT NOTES"

MENT

See comment on Page 1.

IDIAN,

Subject: Planner
Page Label: 2
Author: MirandaBenson2
Date: 9/30/2026 1:18:05 PM
Status:
Color: 
Layer:
Space:

See comment on Page 1.

VR269

XX XX

Subject: Planner
Page Label: 2
Author: MirandaBenson2
Date: 9/30/2026 2:55:51 PM
Status:
Color: 
Layer:
Space:

VR269

ADD: All platted no-build areas.
The easements platted at the time of original plat (15442 note #1).

Subject: Planner
Page Label: 2
Author: MirandaBenson2
Date: 9/30/2026 3:55:14 PM
Status:
Color: 
Layer:
Space:

ADD: All platted no-build areas.
The easements platted at the time of original plat (15442 note #1).

1
ACRES±)

CORRECT: LOT 1A

Subject: Planner
Page Label: 3
Author: MirandaBenson2
Date: 9/9/2026 12:19:07 PM
Status:
Color: 
Layer:
Space:

CORRECT: LOT 1A

2
ACRES±)

CORRECT: LOT 2A

Subject: Planner
Page Label: 3
Author: MirandaBenson2
Date: 9/9/2026 12:19:22 PM
Status:
Color: 
Layer:
Space:

CORRECT: LOT 2A

ADD: All platted no-build areas.
The easements platted at the time of
original plat (15442 note #1).

100°19'14"N 1,011.20' (02)
100°13'27"E 1,011.62' (02)
100°13'27"E 1,011.69' (0400)

Subject: Planner
Page Label: 3
Author: MirandaBenson2
Date: 9/30/2026 3:55:00 PM
Status:
Color: 
Layer:
Space:

ADD: All platted no-build areas.
The easements platted at the time of original plat
(15442 note #1).

NT EXHIBIT
See comment on Page 1.
IDIAN,


Subject: Planner
Page Label: 3
Author: MirandaBenson2
Date: 9/30/2026 1:18:19 PM
Status:
Color: 
Layer:
Space:

See comment on Page 1.

VR269
XX XX

Subject: Planner
Page Label: 3
Author: MirandaBenson2
Date: 9/30/2026 2:55:55 PM
Status:
Color: 
Layer:
Space:

VR269

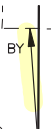EMENT BY
4206081


Subject: Planner
Page Label: 3
Author: MirandaBenson2
Date: 9/30/2026 3:49:24 PM
Status:
Color: 
Layer:
Space:



Remember to remove "DRAFT"
for next submittal.

Subject: Planner
Page Label: 3
Author: MirandaBenson2
Date: 10/2/2026 8:45:59 AM
Status:
Color: ■
Layer:
Space:

Remember to remove "DRAFT" for next submittal.