

RISING MOON


A REPLAT TRACT B OF MORNING SUN I

EAST 1/2 OF SEC. 3, TOWNSHIP 15S, RANGE 65 WEST, COUNTY OF EL PASO, STATE OF COLORADO

PRELIMINARY PLAN

GENERAL NOTES:

- ALL SIDEWALKS SHOWN ON PRELIMINARY PLAN ARE TO BE 5' CONCRETE UNLESS OTHERWISE SPECIFIED.
 - DEVELOPER SHALL ANALYZE THE NEED TO PROVIDE ALL NECESSARY OFFSITE ROAD IMPROVEMENTS, WHICH MAY INCLUDE IMPROVEMENTS IN THE CITY OF COLORADO SPRINGS, TO PROVIDE AN APPROPRIATE LEVEL OF SERVICE TO THIS DEVELOPMENT. IF OFFSITE ROAD IMPROVEMENTS ARE NECESSARY, THEY WILL BE SPECIFICALLY OUTLINED PER A SUBDIVISION IMPROVEMENTS AGREEMENT OR DEVELOPMENT AGREEMENT BETWEEN DEVELOPER AND EL PASO COUNTY.
 - ALL STREETS SHALL BE NAMED AND CONSTRUCTED TO EL PASO COUNTY STANDARDS AND ANY APPROVED DEVIATION. UPON ACCEPTANCE EL PASO COUNTY, PUBLIC STREETS SHALL BE MAINTAINED BY THE COUNTY.
 - NOTWITHSTANDING ANYTHING DEPICTED IN THIS PLAN IN WORDS OR GRAPHIC REPRESENTATION, ALL DESIGN AND CONSTRUCTION RELATED TO ROADS, STORM DRAINAGE AND EROSION CONTROL SHALL CONFORM TO THE STANDARDS AND REQUIREMENTS OF THE MOST RECENT VERSION OF THE RELEVANT ADOPTED EL PASO COUNTY STANDARDS, INCLUDING THE LAND DEVELOPMENT CODE (LDC), THE ECM, THE DRAINAGE CRITERIA MANUAL (DCM), AND THE DCM VOLUME 2. ANY DEVIATIONS FROM THESE STANDARDS MUST BE SPECIFICALLY REQUESTED AND APPROVED IN WRITING TO BE ACCEPTABLE. THE APPROVAL OF THIS PRELIMINARY PLAN DOES NOT IMPLICITLY ALLOW ANY DEVIATIONS OR WAIVERS THAT HAVE NOT BEEN OTHERWISE APPROVED THROUGH THE DEVIATION APPROVAL PROCESS.
 - THE SUBDIVIDER(S) AGREE ON BEHALF OF HIM/HERSELF AND ANY DEVELOPER OR BUILDER SUCCESSORS AND ASSIGNEES THAT SUBDIVIDER AND/OR SAID SUCCESSORS AND ASSIGNS SHALL BE REQUIRED TO PAY TRAFFIC IMPACT FEES IN ACCORDANCE WITH THE EL PASO COUNTY ROAD IMPACT FEE PROGRAM RESOLUTIONS (RESOLUTION NO.19-47), OR ANY AMENDMENTS THERETO, AT OR PRIOR TO THE TIME OF BUILDING PERMIT SUBMITTALS. THE FEE OBLIGATION, IF NOT PAID AT FINAL PLAT RECORDING, SHALL BE DOCUMENTED ON ALL SALES DOCUMENTS AND ON PLAT NOTES TO ENSURE THAT A TITLE SEARCH WOULD FIND THE FEE OBLIGATION BEFORE SALE OF THE PROPERTY.
 - THE FOLLOWING UTILITY PROVIDERS WILL SERVE THE RISING MOON FILING NO. 1 PRELIMINARY PLAN AREA INSTALLED BY THE DEVELOPER:
 WATER: PIKES PEAK HABITAT FOR HUMANITY, INC.
 WASTEWATER: COLORADO CENTRE METROPOLITAN DISTRICT
 GAS: COLORADO SPRINGS UTILITIES GAS
 ELECTRIC: MOUNTAIN VIEW ELECTRIC ASSOCIATION, INC.
 - THE FOLLOWING REPORTS HAVE BEEN SUBMITTED IN ASSOCIATION WITH THE PRELIMINARY PLAN FOR THIS SUBDIVISION AND ARE ON FILE AT THE COUNTY PLANNING AND COMMUNITY DEVELOPMENT DEPARTMENT: TRANSPORTATION IMPACT STUDY; DRAINAGE REPORT; WATER RESOURCES REPORT; WASTEWATER DISPOSAL REPORT; GEOLOGY AND SOILS REPORT; FIRE PROTECTION REPORT.
 - DEVELOPER SHALL COMPLY WITH FEDERAL AND STATE LAWS, REGULATION, ORDINANCES, REVIEW AND PERMIT REQUIREMENTS, AND OTHER AGENCY REQUIREMENTS, IF ANY, OF APPLICABLE AGENCIES INCLUDING, BUT NOT LIMITED TO, THE COLORADO PARKS AND WILDLIFE, COLORADO DEPARTMENT OF TRANSPORTATION, U.S. ARMY CORPS OF ENGINEERS AND THE U.S. FISH AND WILDLIFE SERVICE REGARDING THE ENDANGERED SPECIES ACT, PARTICULARLY AS IT RELATES TO THE LISTED SPECIES (E.G., PREBLE'S MEADOW JUMPING MOUSE).
 - THE PARTIES RESPONSIBLE FOR THIS PLAN HAVE FAMILIARIZED THEMSELVES WITH ALL CURRENT ACCESSIBILITY CRITERIA AND SPECIFICATIONS AND THE PROPOSED PLAN REFLECTS ALL SITE ELEMENTS REQUIRED BY THE APPLICABLE ADA DESIGN STANDARDS AND GUIDELINES AS PUBLISHED BY THE UNITED STATES DEPARTMENT OF JUSTICE. APPROVAL OF THIS PLAN BY EL PASO COUNTY DOES NOT ASSURE COMPLIANCE WITH THE ADA OR ANY REGULATIONS OR GUIDELINES ENACTED OR PROMULGATED UNDER OR WITH RESPECT TO SUCH LAWS.
 - UNLESS OTHERWISE INDICATED, ALL LOTS HAVE THE FOLLOWING EASEMENTS, 7' REAR PUBLIC UTILITY AND DRAINAGE EASEMENT, 5' SIDE PUBLIC EASEMENTS, 5' FRONT PUBLIC UTILITY AND PUBLIC IMPROVEMENT EASEMENT, AND ADDITIONAL EXCLUSIVE 10' FRONT PUBLIC UTILITY EASEMENT, THE SOLE RESPONSIBILITY FOR MAINTENANCE OF THESE EASEMENTS IS HEREBY VESTED WITH THE INDIVIDUAL PROPERTY OWNERS.
 - THERE SHALL BE NO DIRECT LOT ACCESS TO PEACEFUL MEADOW STREET FOR ANY RESIDENTIAL LOTS.
 - ANY LANDSCAPING IN THE PUBLIC RIGHT-OF-WAY WILL REQUIRE A LICENSE AGREEMENT WITH THE HOMEOWNERS ASSOCIATION AT TIME OF FINAL PLAT.
 - SOIL AND GEOLOGY CONDITIONS:
 GEOLOGIC HAZARD NOTE--PRELIMINARY PLAN:
 THE FOLLOWING LOTS HAVE BEEN FOUND TO BE IMPACTED BY GEOLOGIC HAZARDS. MITIGATION MEASURES AND A MAP OF THE HAZARD AREA CAN BE FOUND IN THE REPORT "SOILS AND GEOLOGY STUDY RISING MOON - HABITAT FOR HUMANITY" BY ENTECH ENGINEERING INC. DATED MARCH 27, 2024 IN FILE (SP243) AVAILABLE AT THE EL PASO COUNTY PLANNING AND COMMUNITY DEVELOPMENT DEPARTMENT:
 • EXPANDABLE SOILS: (ALL LOTS)
 • LOOSE/COLLAPSIBLE SOILS: (ALL LOTS)
- IN AREAS OF HIGH GROUNDWATER:
 DUE TO THE POTENTIAL FOR GROUNDWATER IN THE AREA, ALL FOUNDATIONS SHALL INCORPORATE AN UNDERGROUND DRAINAGE SYSTEM FOR ANY HOMES WITH USABLE BELOW GRADE SPACE.
- GEOLOGIC HAZARD NOTE: THE GEOLOGIC HAZARD IDENTIFIED IN THE ENTECH REPORT INCLUDE THE POTENTIAL FOR RADON. A MAP OF THE AREA CAN BE FOUND IN THE REPORT "SOILS AND GEOLOGY STUDY RISING MOON - HABITAT FOR HUMANITY" PREPARED BY ENTECH ENGINEERING, INC., DATED MARCH 27, 2024 AVAILABLE AT THE EL PASO COUNTY PLANNING AND COMMUNITY DEVELOPMENT DEPARTMENT.
- INVESTIGATION ON EACH LOT IS RECOMMENDED PRIOR TO CONSTRUCTION PER THE ENTECH REPORT. RECOMMENDATIONS FROM THE GEOTECHNICAL ENGINEER SHOULD BE CAREFULLY FOLLOWED ESPECIALLY REGARDING SITE GRADING FOR SURFACE RUNOFF AND PERIMETER DRAINS WHERE SHALLOW GROUNDWATER IS ENCOUNTERED OR EXPECTED. SITE SPECIFIC SOIL AND FOUNDATION INVESTIGATIONS SHOULD SPECIFICALLY EVALUATE FOR THE PRESENCE OF GROUNDWATER AND POTENTIALLY EXPANSIVE AND/OR COLLAPSIBLE SOILS AND FILL PRIOR TO FOUNDATION DESIGN. ALL RECOMMENDATIONS IN THE ENTECH REPORT SHOULD BE ADHERED TO.

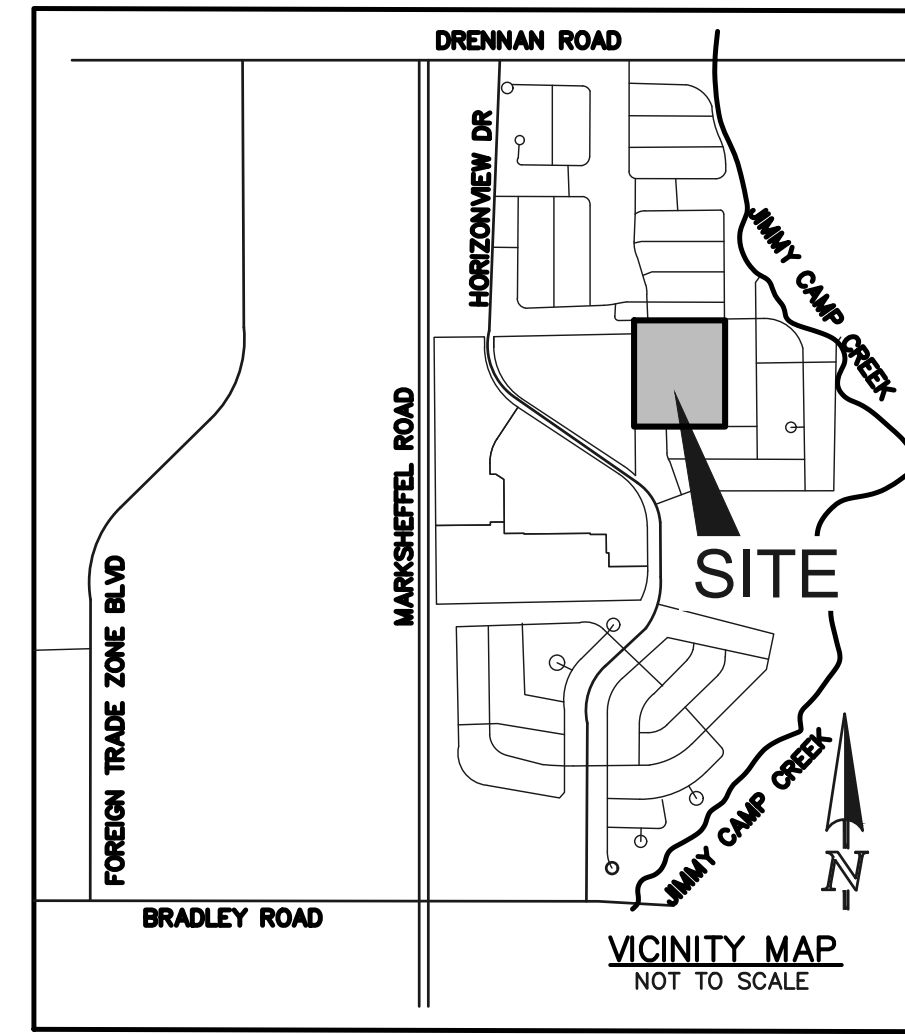

SITE DATA

| | |
|-------------------------|------------------------------------|
| TAX ID NUMBER: | 5503101010 |
| TOTAL AREA: | 9.00 ACRES |
| DEVELOPMENT SCHEDULE: | FALL 2024 |
| CURRENT ZONING: | RS-5000 CAD-0 |
| CURRENT USE: | VACANT |
| PROPOSED USE: | SINGLE FAMILY RESIDENTIAL SUBURBAN |
| PROPOSED GROSS DENSITY: | 4.5 DU/AC (41 LOTS/9.00 AC) |
| PROPOSED NET DENSITY: | 7.0 DU/AC (41 LOTS/5.80 AC) |
| LANDSCAPE SETBACKS: | N/A |

TRACT TABLE

| TRACT | AREA (SF) | AREA (AC.) | USE | OWNERSHIP/MAINTENANCE |
|-------------------------------|-----------|------------|---|------------------------|
| A | 46,871 | 1.08 | PARK, LANDSCAPE, OPEN SPACE, DRAINAGE, DETENTION, UTILITIES | HOMEOWNERS ASSOCIATION |
| B | 1,748 | 0.04 | DRAINAGE, LANDSCAPE, UTILITIES | HOMEOWNERS ASSOCIATION |
| C | 809 | 0.02 | DRAINAGE, LANDSCAPE, UTILITIES | HOMEOWNERS ASSOCIATION |
| TOTAL TRACT AREA = 1.14 ACRES | | | | |

ZONE DIMENSIONAL STANDARDS

| ZONE | MIN. LOT SIZE | MAX. BUILDING HEIGHT | MAX. LOT COVERAGE | MIN. LOT WIDTH AT FRONT SETBACK LINE | FRONT BUILDING SETBACK | SIDE BUILDING SETBACK | REAR BUILDING SETBACK |
|---------------|---------------|----------------------|-------------------|--------------------------------------|------------------------|-----------------------|-----------------------|
| RS-5000/CAD-0 | 5,000 SF | 30' | 40%/45% | 50' | 25' | 5' | 25' |

LAND USE DATA TABLE

| LAND USE | ACRES | % OF LAND |
|---|-------|-----------|
| SINGLE FAMILY | 5.80 | 64.4% |
| ROAD ROW | 2.07 | 23.0% |
| DRAINAGE, LANDSCAPE, UTILITIES | 0.05 | 0.6% |
| PARK, LANDSCAPE, UTILITIES, OPEN SPACE, DETENTION | 1.08 | 12.0% |
| TOTAL | 9.00 | 100% |

PROJECT TEAM

| | |
|-----------------------------|--|
| OWNER: | PIKES PEAK HABITAT FOR HUMANITY INC. 2802 N. PROSPECT ST. COLORADO SPRINGS, CO 80907 (719)661-5527 BINGELS@NORWOOD.DEV |
| APPLICANT/CIVIL CONSULTANT: | CLASSIC CONSULTING ENGINEERS & SURVEYORS, LLC 619 N. CASCADE AVENUE, SUITE 200 COLORADO SPRINGS, CO 80903 MR. KYLE CAMPBELL, P.E. (719) 785-0790 |

SHEET INDEX:

| | |
|---|--------------|
| TITLE SHEET | SHEET 1 OF 4 |
| LEGAL BOUNDARY & ADJACENT PROPERTY OWNERS EXHIBIT | SHEET 2 OF 4 |
| PRELIMINARY SITE PLAN | SHEET 3 OF 4 |
| PRELIMINARY GRADING & UTILITY PLAN | SHEET 4 OF 4 |



EL PASO COUNTY FILE NO.: SP243



RISING MOON
PRELIMINARY PLAN
TITLE SHEET

| | | | | |
|-------------|--------------|---------------|---------|------------|
| DESIGNED BY | MES | SCALE | DATE | 05/15/2024 |
| DRAWN BY | KES | (H) 1" = 100' | SHEET | 1 OF 4 |
| CHECKED BY | (V) 1" = N/A | JOB NO. | 2506.03 | |

619 N. Cascade Avenue, Suite 200
Colorado Springs, Colorado 80903
(719)785-0790

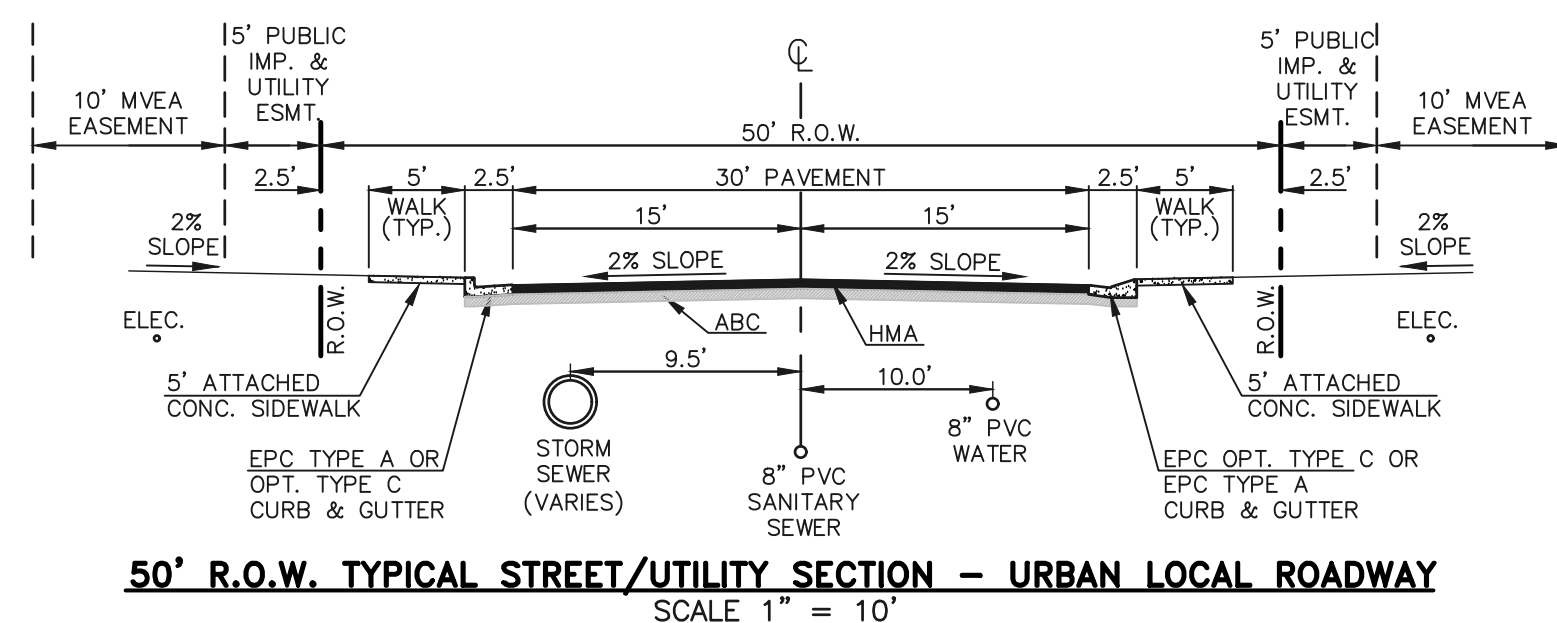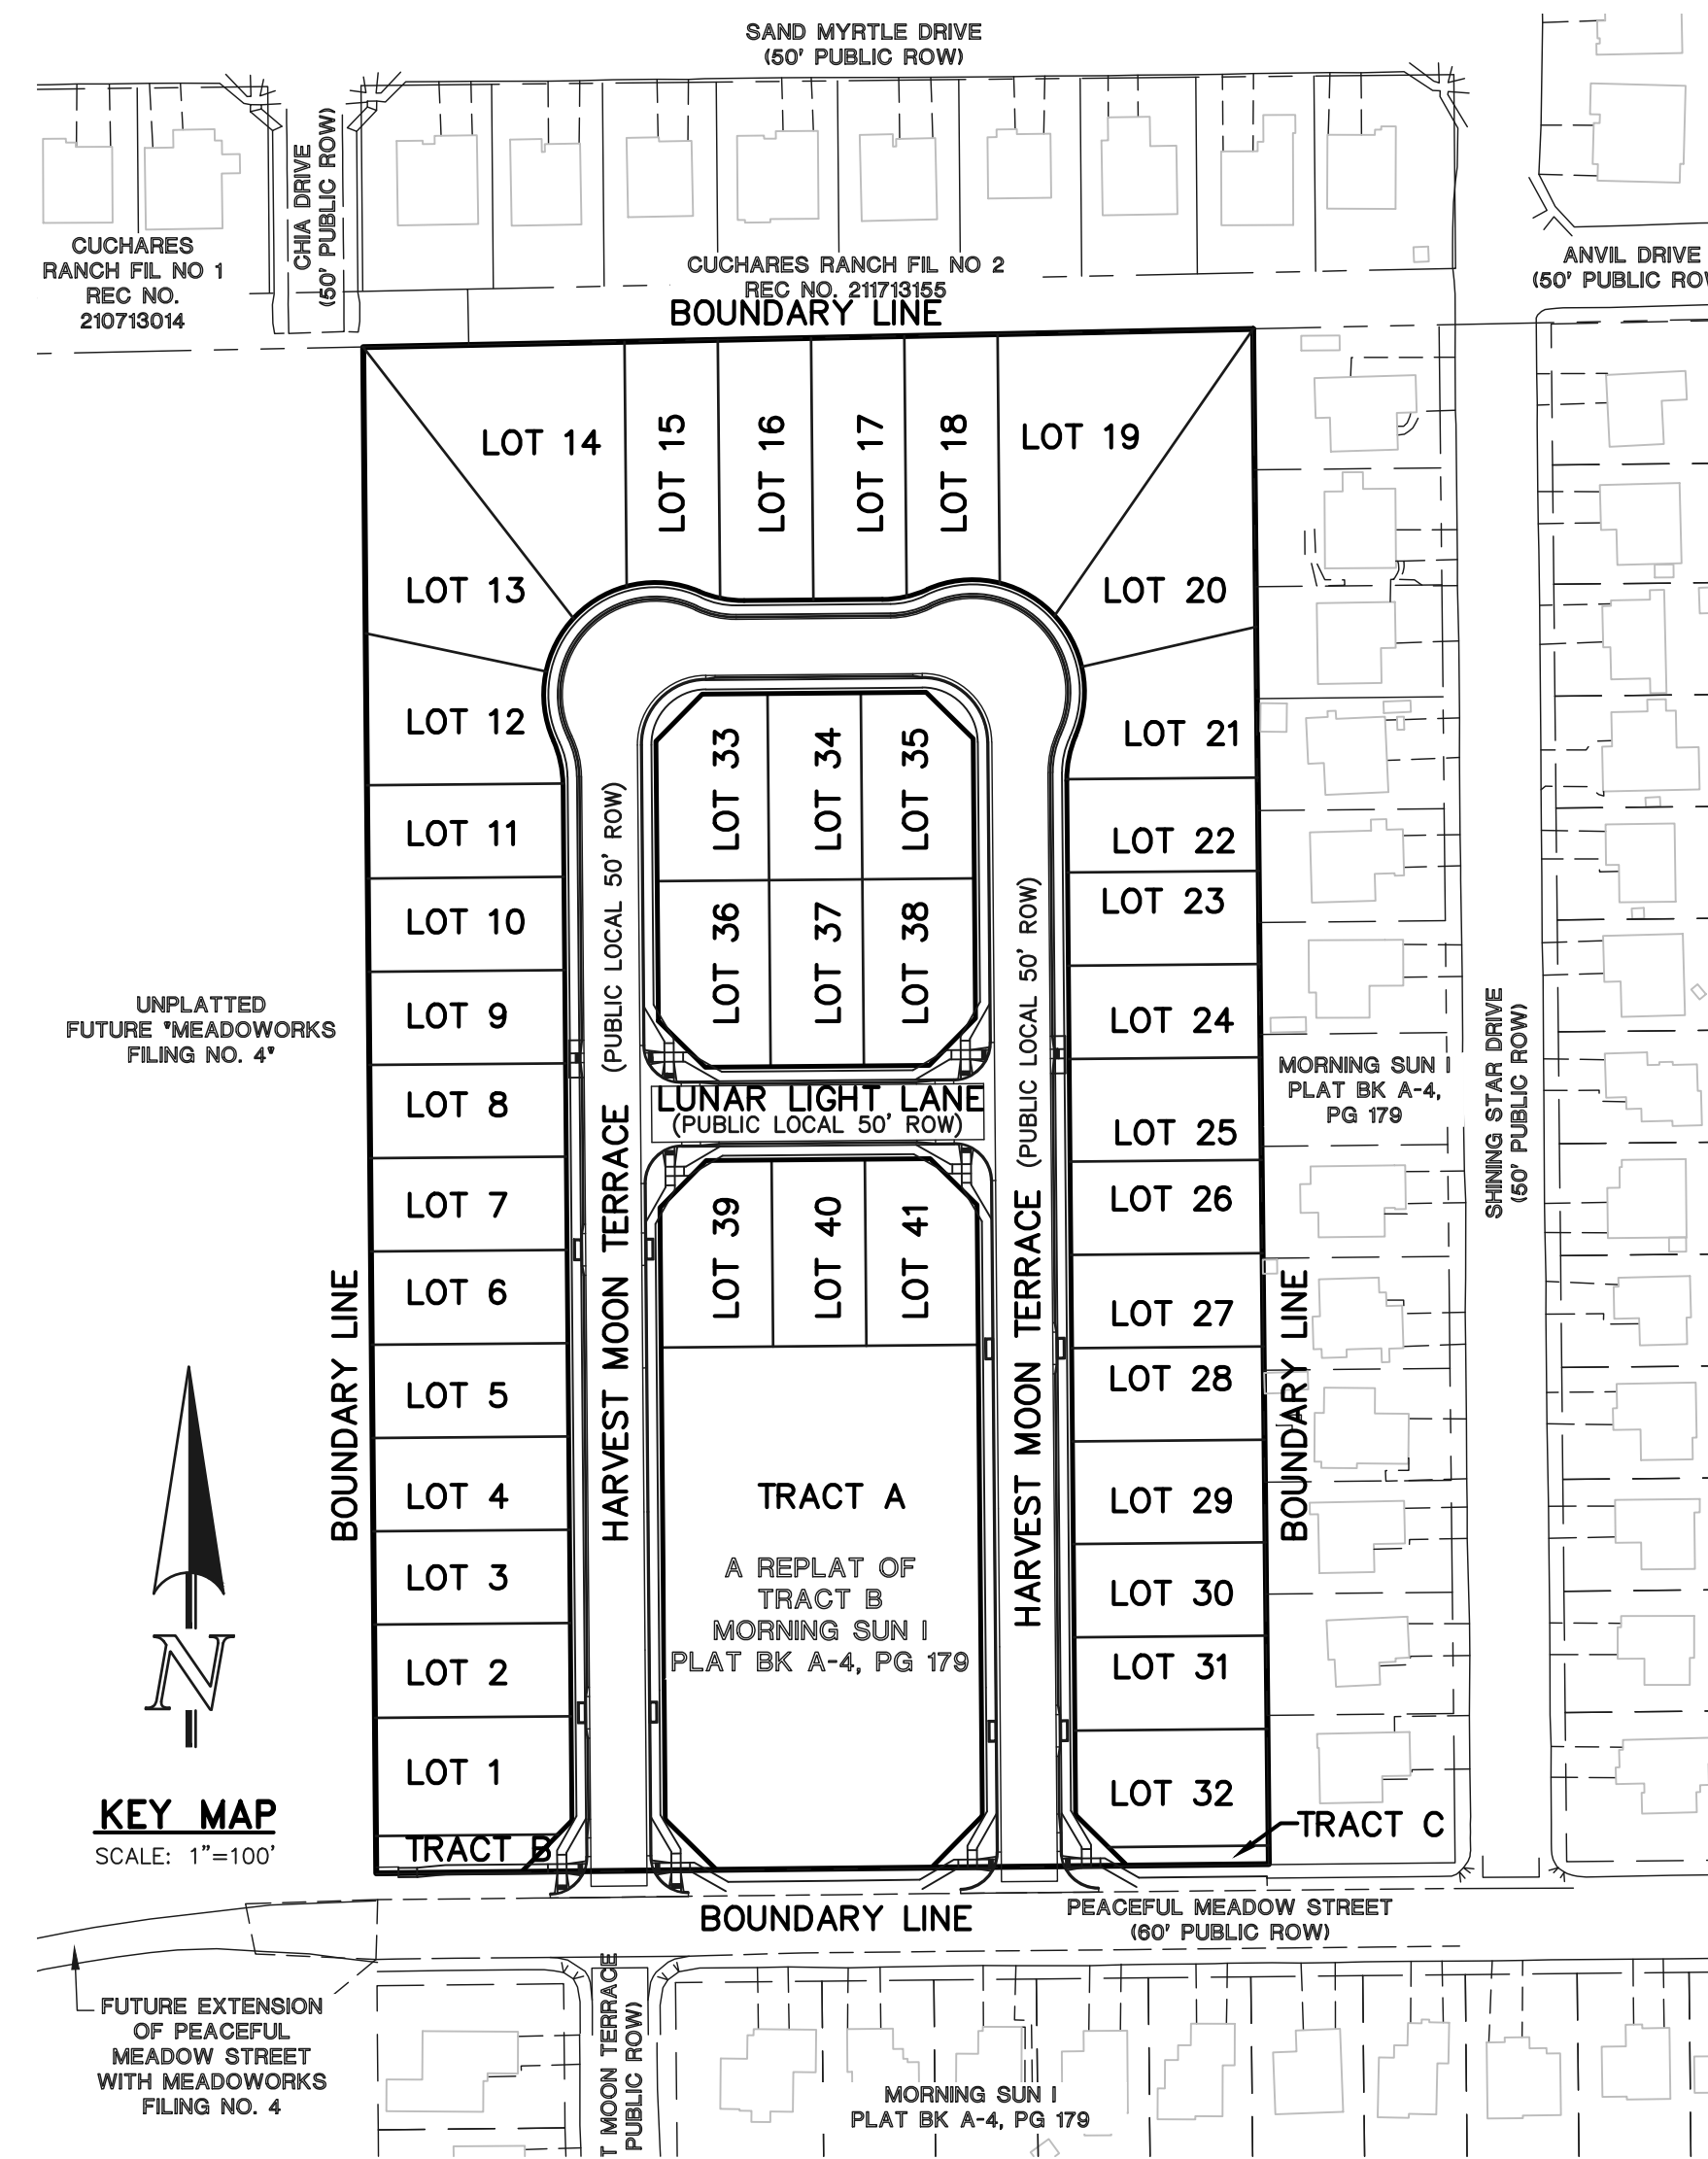

NOTE: THIS COMMUNITY WILL NOT REQUIRE GAS FACILITIES (HOMES ARE ALL ELECTRIC).

KEY MAP
SCALE: 1" = 100'


FUTURE EXTENSION OF PEACEFUL MEADOW STREET WITH MEADOWWORKS FILING NO. 4

RISING MOON

REPLAT TRACT B OF MORNING SUN I

EAST 1/2 OF SEC. 3, TOWNSHIP 15S, RANGE 65 WEST, COUNTY OF EL PASO, STATE OF COLORADO

PRELIMINARY PLAN

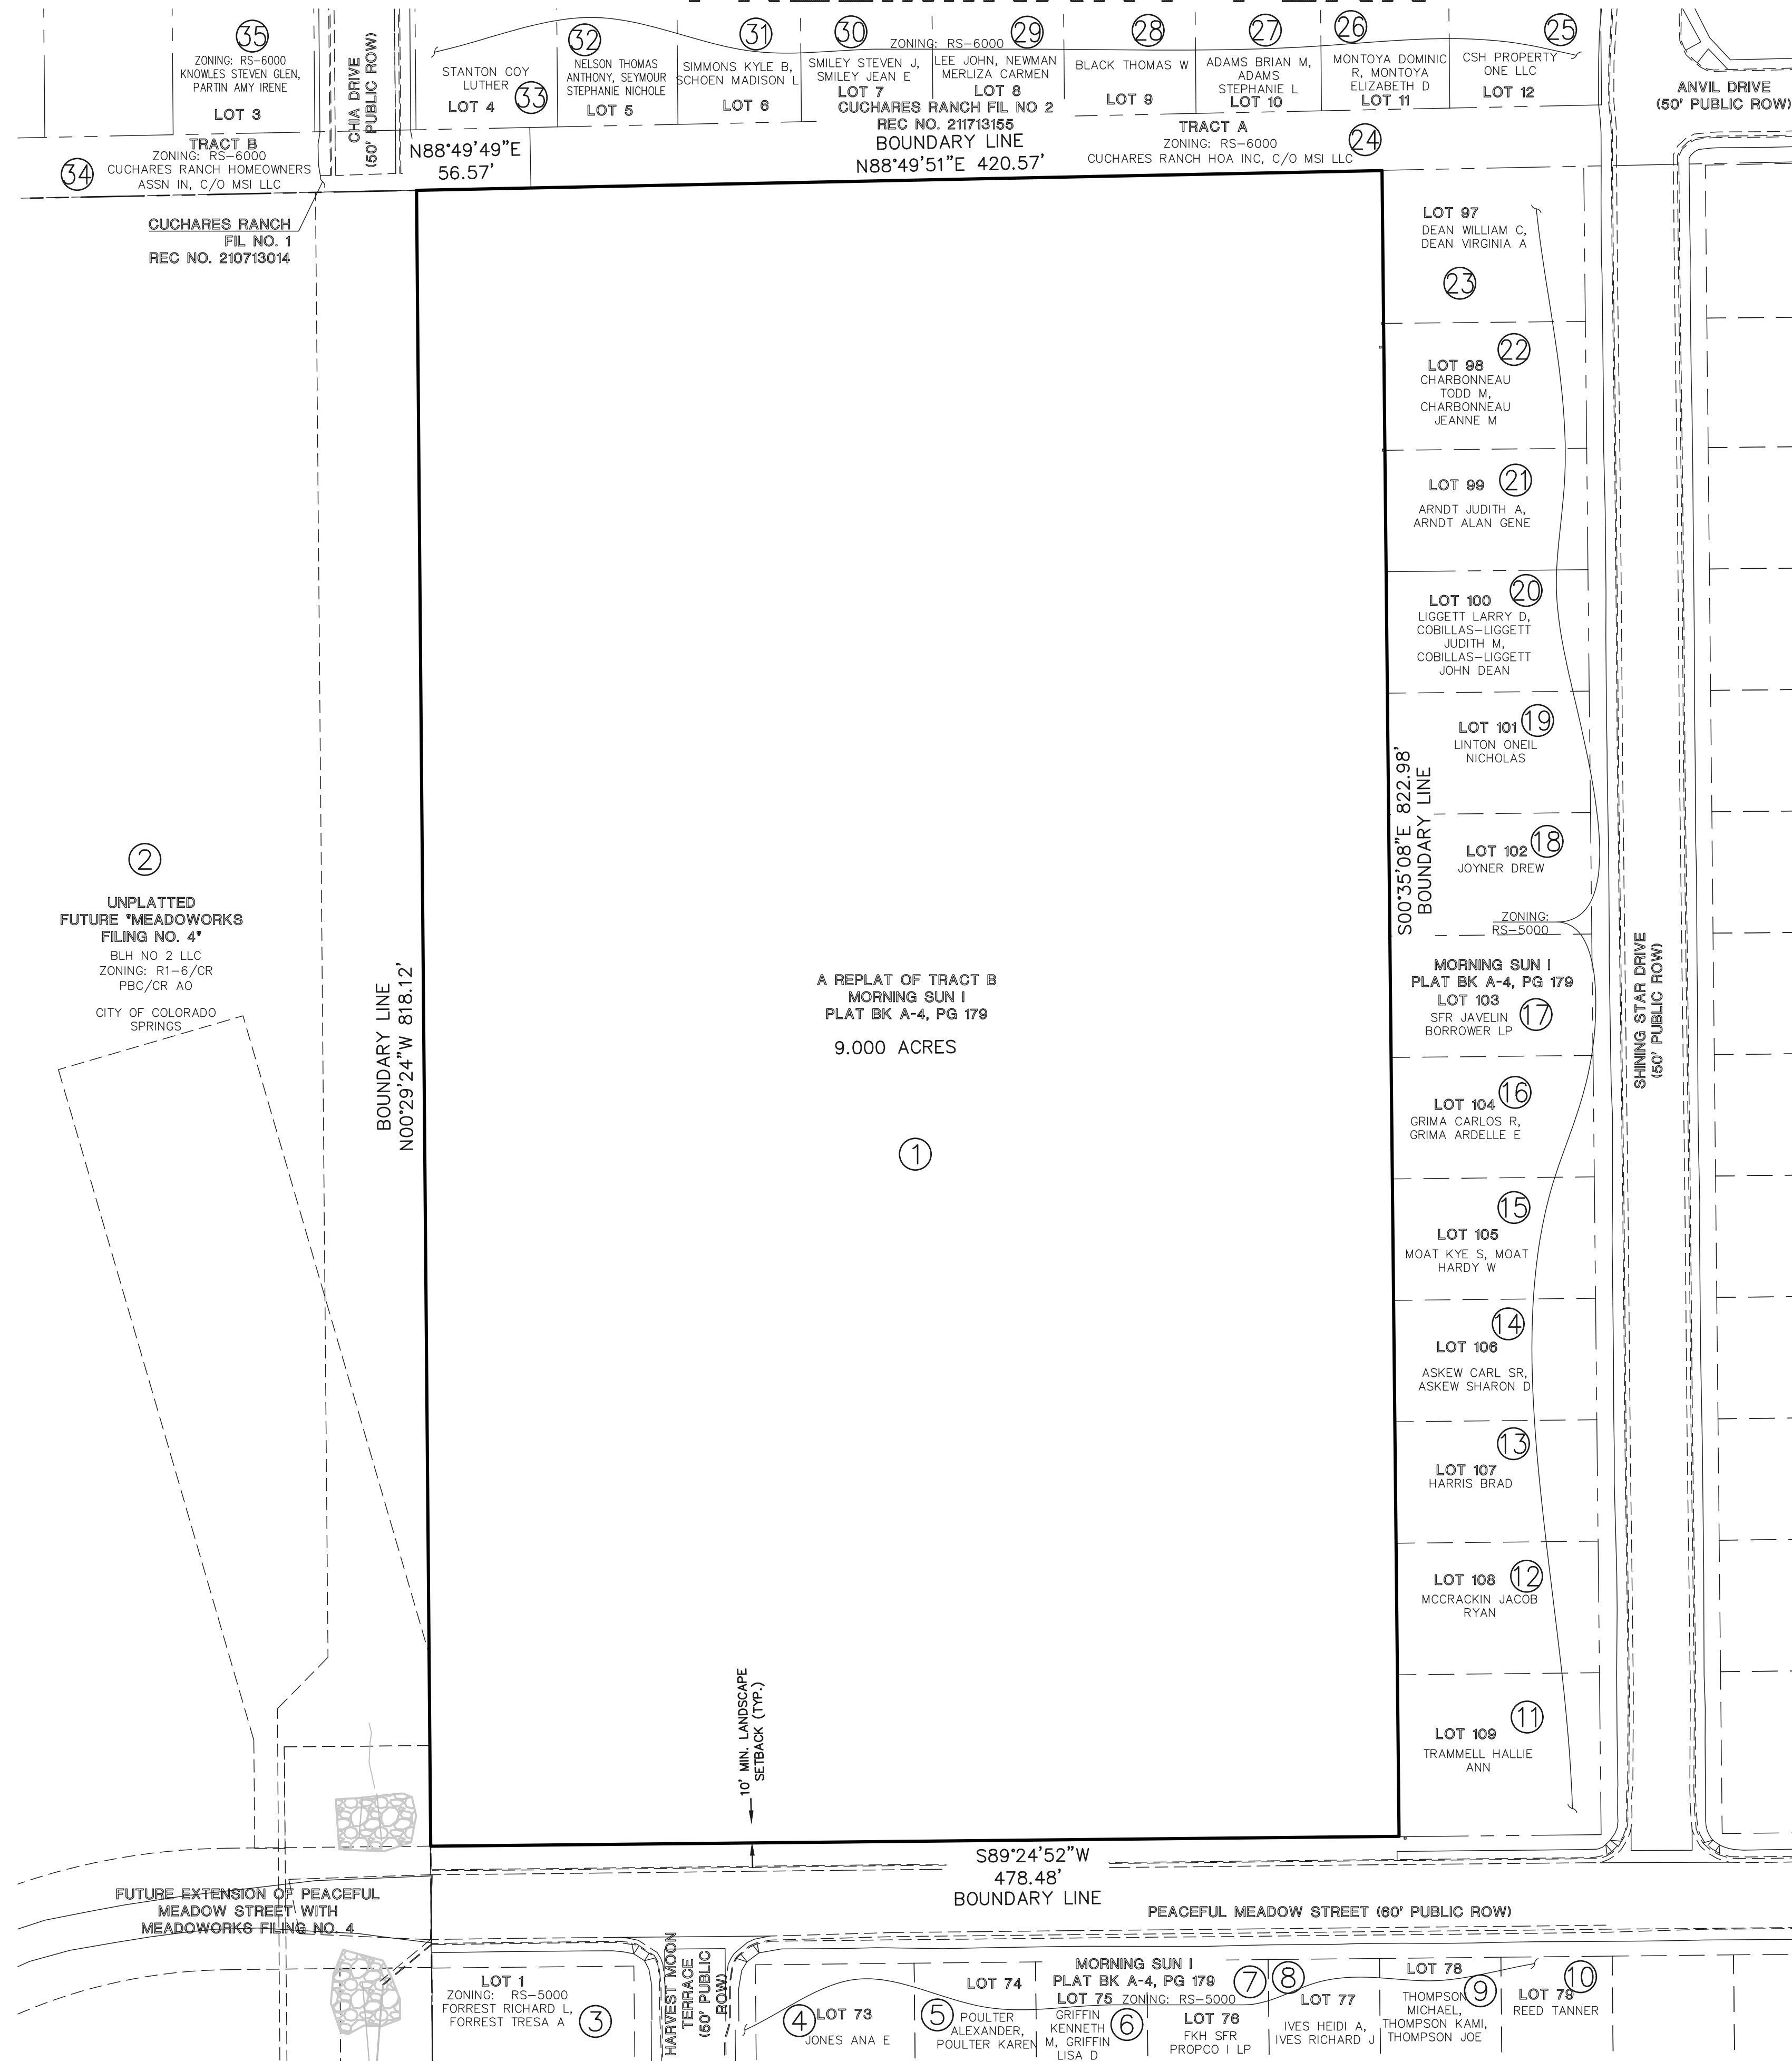


LEGAL DESCRIPTION

LEGAL DESCRIPTION: RISING MOON FILING NO. 1 PRELIMINARY PLAN.
 A REPLAT TRACT B OF MORNING SUN I RECORDED IN PLAT BOOK A-4 AT PAGE 179 BEING LOCATED IN THE EAST 1/2 OF SECTION 3, TOWNSHIP 15 SOUTH, RANGE 65 WEST OF THE SIXTH PRINCIPAL MERIDIAN, COUNTY OF EL PASO, STATE OF COLORADO.
 CONTAINING A CALCULATED AREA OF 9.000 ACRES.


BASIS OF BEARINGS

ALL BEARINGS ARE RELATIVE TO THE NORTH LINE OF SECTION 3, TOWNSHIP 15 SOUTH, RANGE 65 WEST OF THE 6TH PRINCIPAL MERIDIAN, EL PASO COUNTY, COLORADO, IS ASSUMED TO BEAR S89°53'55\"/>

| ADJACENT OWNER | NAME | MAILING ADDRESS | CITY, STATE, ZIP CODE |
|----------------|---------------------------------------|-------------------------|--------------------------------|
| 1 | PIKES PEAK HABITAT FOR HUMANITY, INC. | 2802 N PROSPECT ST | COLORADO SPRINGS CO 80907-6325 |
| 2 | BLH NO 2 LLC | 111 S TEJON ST STE 222 | COLORADO SPRINGS CO 80903-2246 |
| 3 | FORREST RICHARD L | 4052 HARVEST MOON TER | COLORADO SPRINGS CO 80925-1110 |
| 4 | JONES ANA E | 9303 PEACEFUL MEADOW ST | COLORADO SPRINGS CO 80925-1120 |
| 5 | POULTER ALEXANDER | 9311 PEACEFUL MEADOW ST | COLORADO SPRINGS CO 80925-1120 |
| 6 | GRIFFIN KENNETH M | 9319 PEACEFUL MEADOW ST | COLORADO SPRINGS CO 80925-1120 |
| 7 | FKH SFR PROPCO I LP | 31 W 27TH ST 4TH FLOOR | NEW YORK NY 10001 |
| 8 | IVES HEIDI A | 9335 PEACEFUL MEADOW ST | COLORADO SPRINGS CO 80925-1120 |
| 9 | THOMPSON MICHAEL | 9343 PEACEFUL MEADOW ST | COLORADO SPRINGS CO 80925-1120 |
| 10 | REED TANNER | 9351 PEACEFUL MEADOW ST | COLORADO SPRINGS CO 80925-1120 |
| 11 | TRAMMELL HALLIE ANN | 4036 SHINING STAR DR | COLORADO SPRINGS CO 80925-1103 |
| 12 | MCCRACKIN JACOB RYAN | 4028 SHINING STAR DR | COLORADO SPRINGS CO 80925 |
| 13 | HARRIS BRAD | 4020 SHINING STAR DR | COLORADO SPRINGS CO 80925-1103 |
| 14 | ASKEW CARL SR | 4012 SHINING STAR DR | COLORADO SPRINGS CO 80925-1103 |
| 15 | MOAT KYE S | 7049 TAFT COURT | COLORADO SPRINGS CO 80911 |
| 16 | GRIMA CARLOS R | 3960 SHINING STAR DR | COLORADO SPRINGS CO 80925-1133 |
| 17 | SFR JAVELIN BORROWER LP | 1717 MAIN ST SUITE 2000 | DALLAS TX 75201 |
| 18 | JOYNER DREW | 3944 SHINING STAR DR | COLORADO SPRINGS CO 80925-1133 |
| 19 | LINTON ONEIL NICHOLAS | 3355 CALAVERAS WAY | COLORADO SPRINGS CO 80910-1409 |
| 20 | LIGGETT LARRY D | 3928 SHINING STAR DR | COLORADO SPRINGS CO 80925 |
| 21 | ARNDT JUDITH A | 3920 SHINING STAR DR | COLORADO SPRINGS CO 80925-1101 |
| 22 | CHARBONNEAU TODD M | 3912 SHINING STAR DR | COLORADO SPRINGS CO 80925-1101 |
| 23 | DEAN WILLIAM C | 3904 SHINING STAR DR | COLORADO SPRINGS CO 80925-1101 |
| 24 | CUCHARS RANCH HOMEOWNERS ASSN INC | 11002 BENTON ST | BROOMFIELD CO 80020-3286 |
| 25 | CSH PROPERTY ONE LLC | 1717 MAIN ST STE#2000 | DALLAS TX 75201 |
| 26 | MONTOYA DOMINIC R | 9575 SAND MYRTLE DR | COLORADO SPRINGS CO 80925-1113 |
| 27 | ADAMS BRIAN M | 9565 SAND MYRTLE DR | PUEBLO CO 81003 |
| 28 | BLACK THOMAS W | 10445 CHEETAH WINDS | LONE TREE CO 80124 |
| 29 | LEE JOHN | 9545 SAND MYRTLE DR | COLORADO SPRINGS CO 80925-1113 |
| 30 | SMILEY STEVEN J | 9535 SAND MYRTLE DR | COLORADO SPRINGS CO 80925-1113 |
| 31 | SIMMONS KYLE B | 9525 SAND MYRTLE DR | COLORADO SPRINGS CO 80925 |
| 32 | NELSON THOMAS ANTHONY | 9515 SAND MYRTLE DR | COLORADO SPRINGS CO 80925-1113 |
| 33 | STANTON COY LUTHER | 638 E WILLAMETTE AVE | COLORADO SPRINGS CO 80903 |
| 34 | CUCHARS RANCH HOMEOWNERS ASSN INC | 11002 BENTON ST | BROOMFIELD CO 80020-3286 |
| 35 | KNOWLES STEVEN GLEN | 9485 SAND MYRTLE DR | COLORADO SPRINGS CO 80925-1165 |

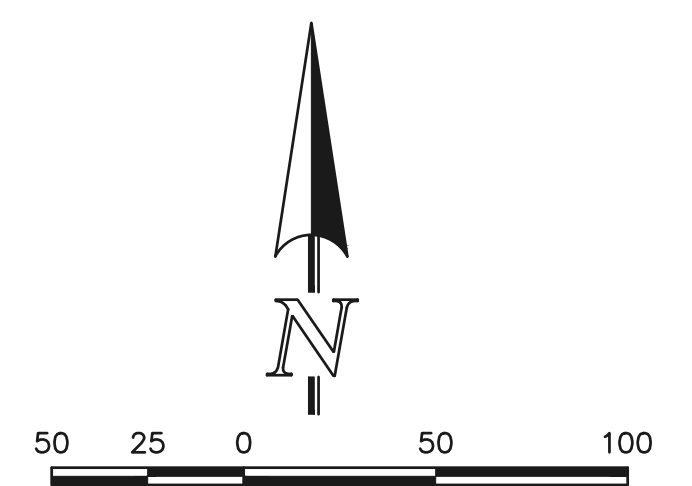


EL PASO COUNTY FILE NO.: SP243



619 N. Cascade Avenue, Suite 200
Colorado Springs, Colorado 80903

RISING MOON
PRELIMINARY PLAN
 LEGAL BOUNDARY & ADJACENT PROPERTY OWNERS EXHIBIT



| | | | | |
|-------------|-----|--------------|---------|------------|
| DESIGNED BY | MES | SCALE | DATE | 05/15/2024 |
| DRAWN BY | KES | (H) 1" = 50' | SHEET | 2 OF 4 |
| CHECKED BY | | (V) 1" = N/A | JOB NO. | 2506.03 |


N:\250603\DRAWINGS\DEVELOPMENT\PRELIM\PLAN\02-250603\ADJ PROP.dwg 8/14/2024 11:20:34 AM 1:1

RISING MOON

REPLAT TRACT B OF MORNING SUN I


EAST 1/2 OF SEC. 3, TOWNSHIP 15S, RANGE 65 WEST, COUNTY OF EL PASO, STATE OF COLORADO

PRELIMINARY PLAN

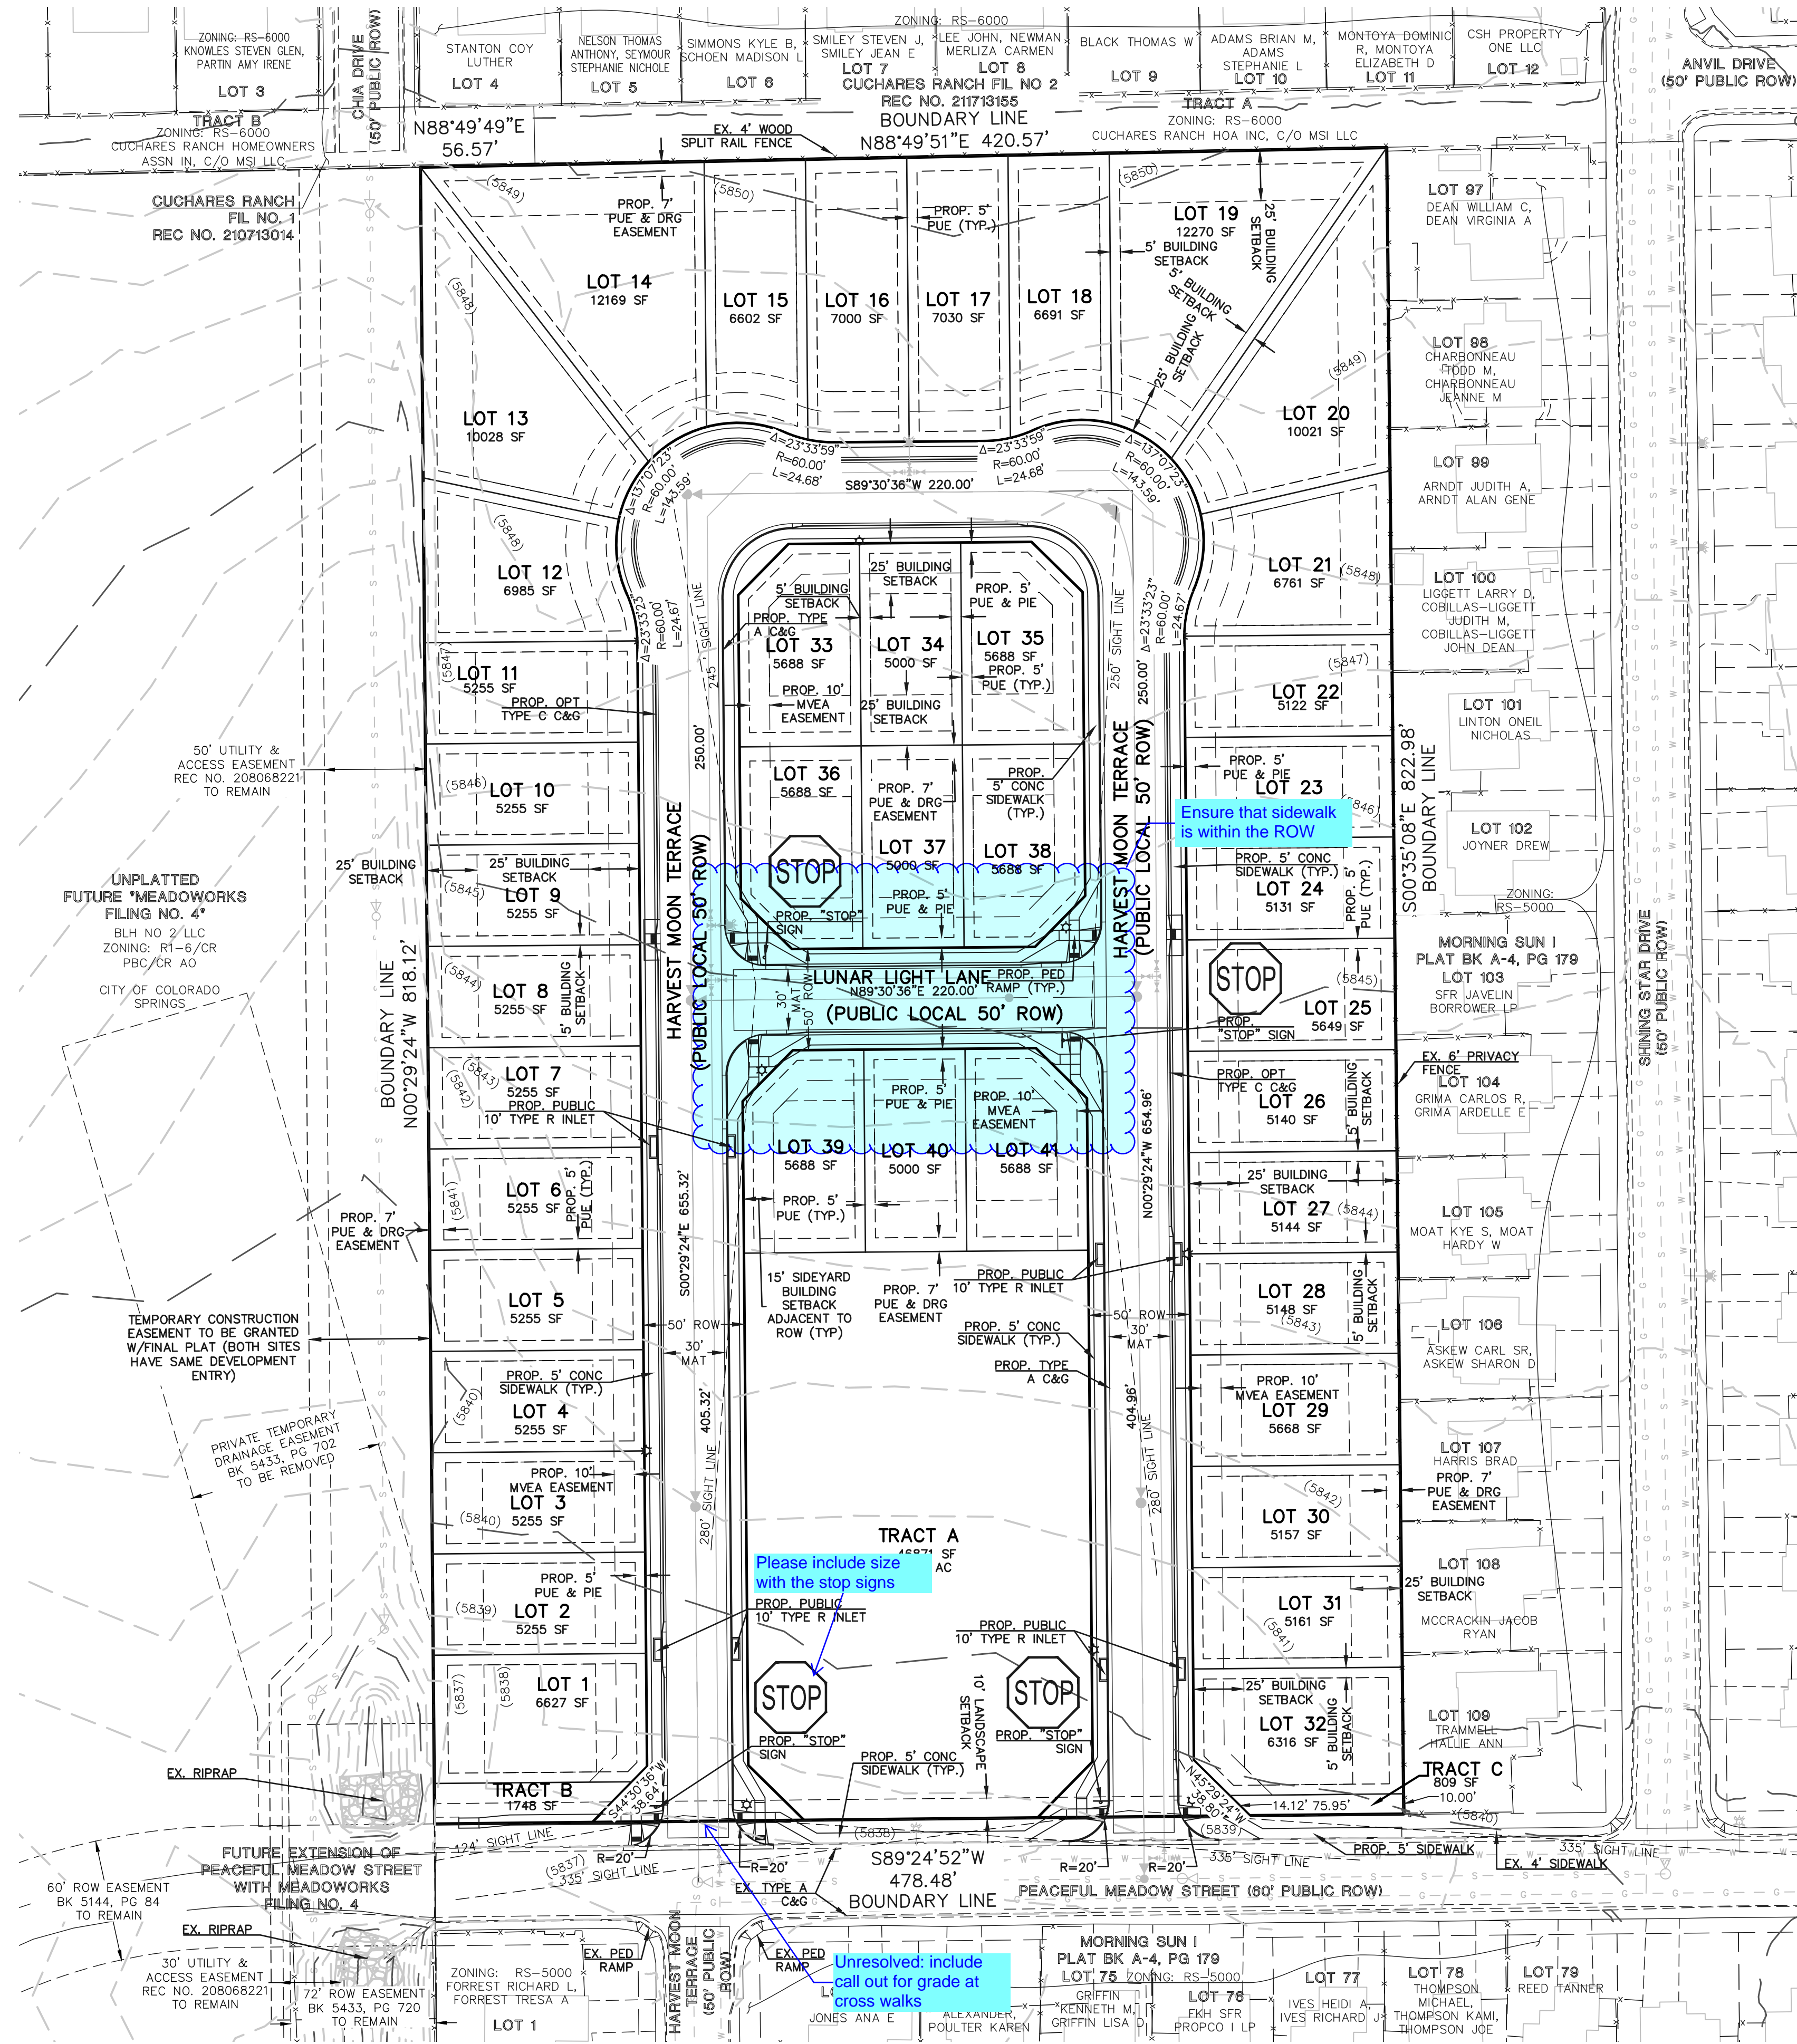

LEGEND

| | |
|---|--|
| EXISTING FIRE HYDRANT | |
| EXISTING WATER MAIN | |
| EXISTING SANITARY SEWER MAIN W/ MANHOLE | |
| PROPOSED STORM INLET | |
| EXISTING GAS MAIN | |
| EXISTING FENCE | |
| SETBACK | |
| MVEA EASEMENT | |
| LOT EASEMENT | |

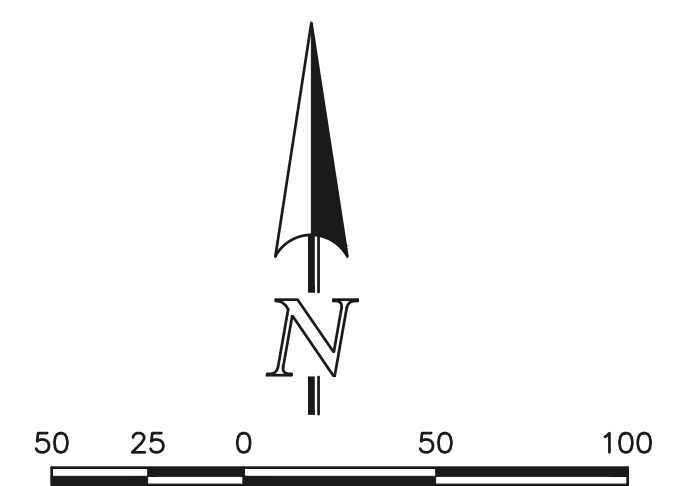

EL PASO COUNTY FILE NO.: SP243

CLASSIC CONSULTING

619 N. Cascade Avenue, Suite 200
Colorado Springs, Colorado 80903

RISING MOON
PRELIMINARY PLAN
PRELIMINARY SITE PLAN
4

| | | | | |
|-------------|-----|--------------|---------|------------|
| DESIGNED BY | MES | SCALE | DATE | 05/15/2024 |
| DRAWN BY | KES | (H) 1" = 50' | SHEET | 3 OF 4 |
| CHECKED BY | | (V) 1" = N/A | JOB NO. | 2506.03 |

CLASSIC CONSULTING


N:\250603\DRAWINGS\DEVELOPMENT\PRELIM\PLAN\03-250603-SP.dwg, 8/14/2024 11:26:52 AM, 1:1, KS

RISING MOON

REPLAT TRACT B OF MORNING SUN I


EAST 1/2 OF SEC. 3, TOWNSHIP 15S, RANGE 65 WEST, COUNTY OF EL PASO, STATE OF COLORADO

PRELIMINARY PLAN

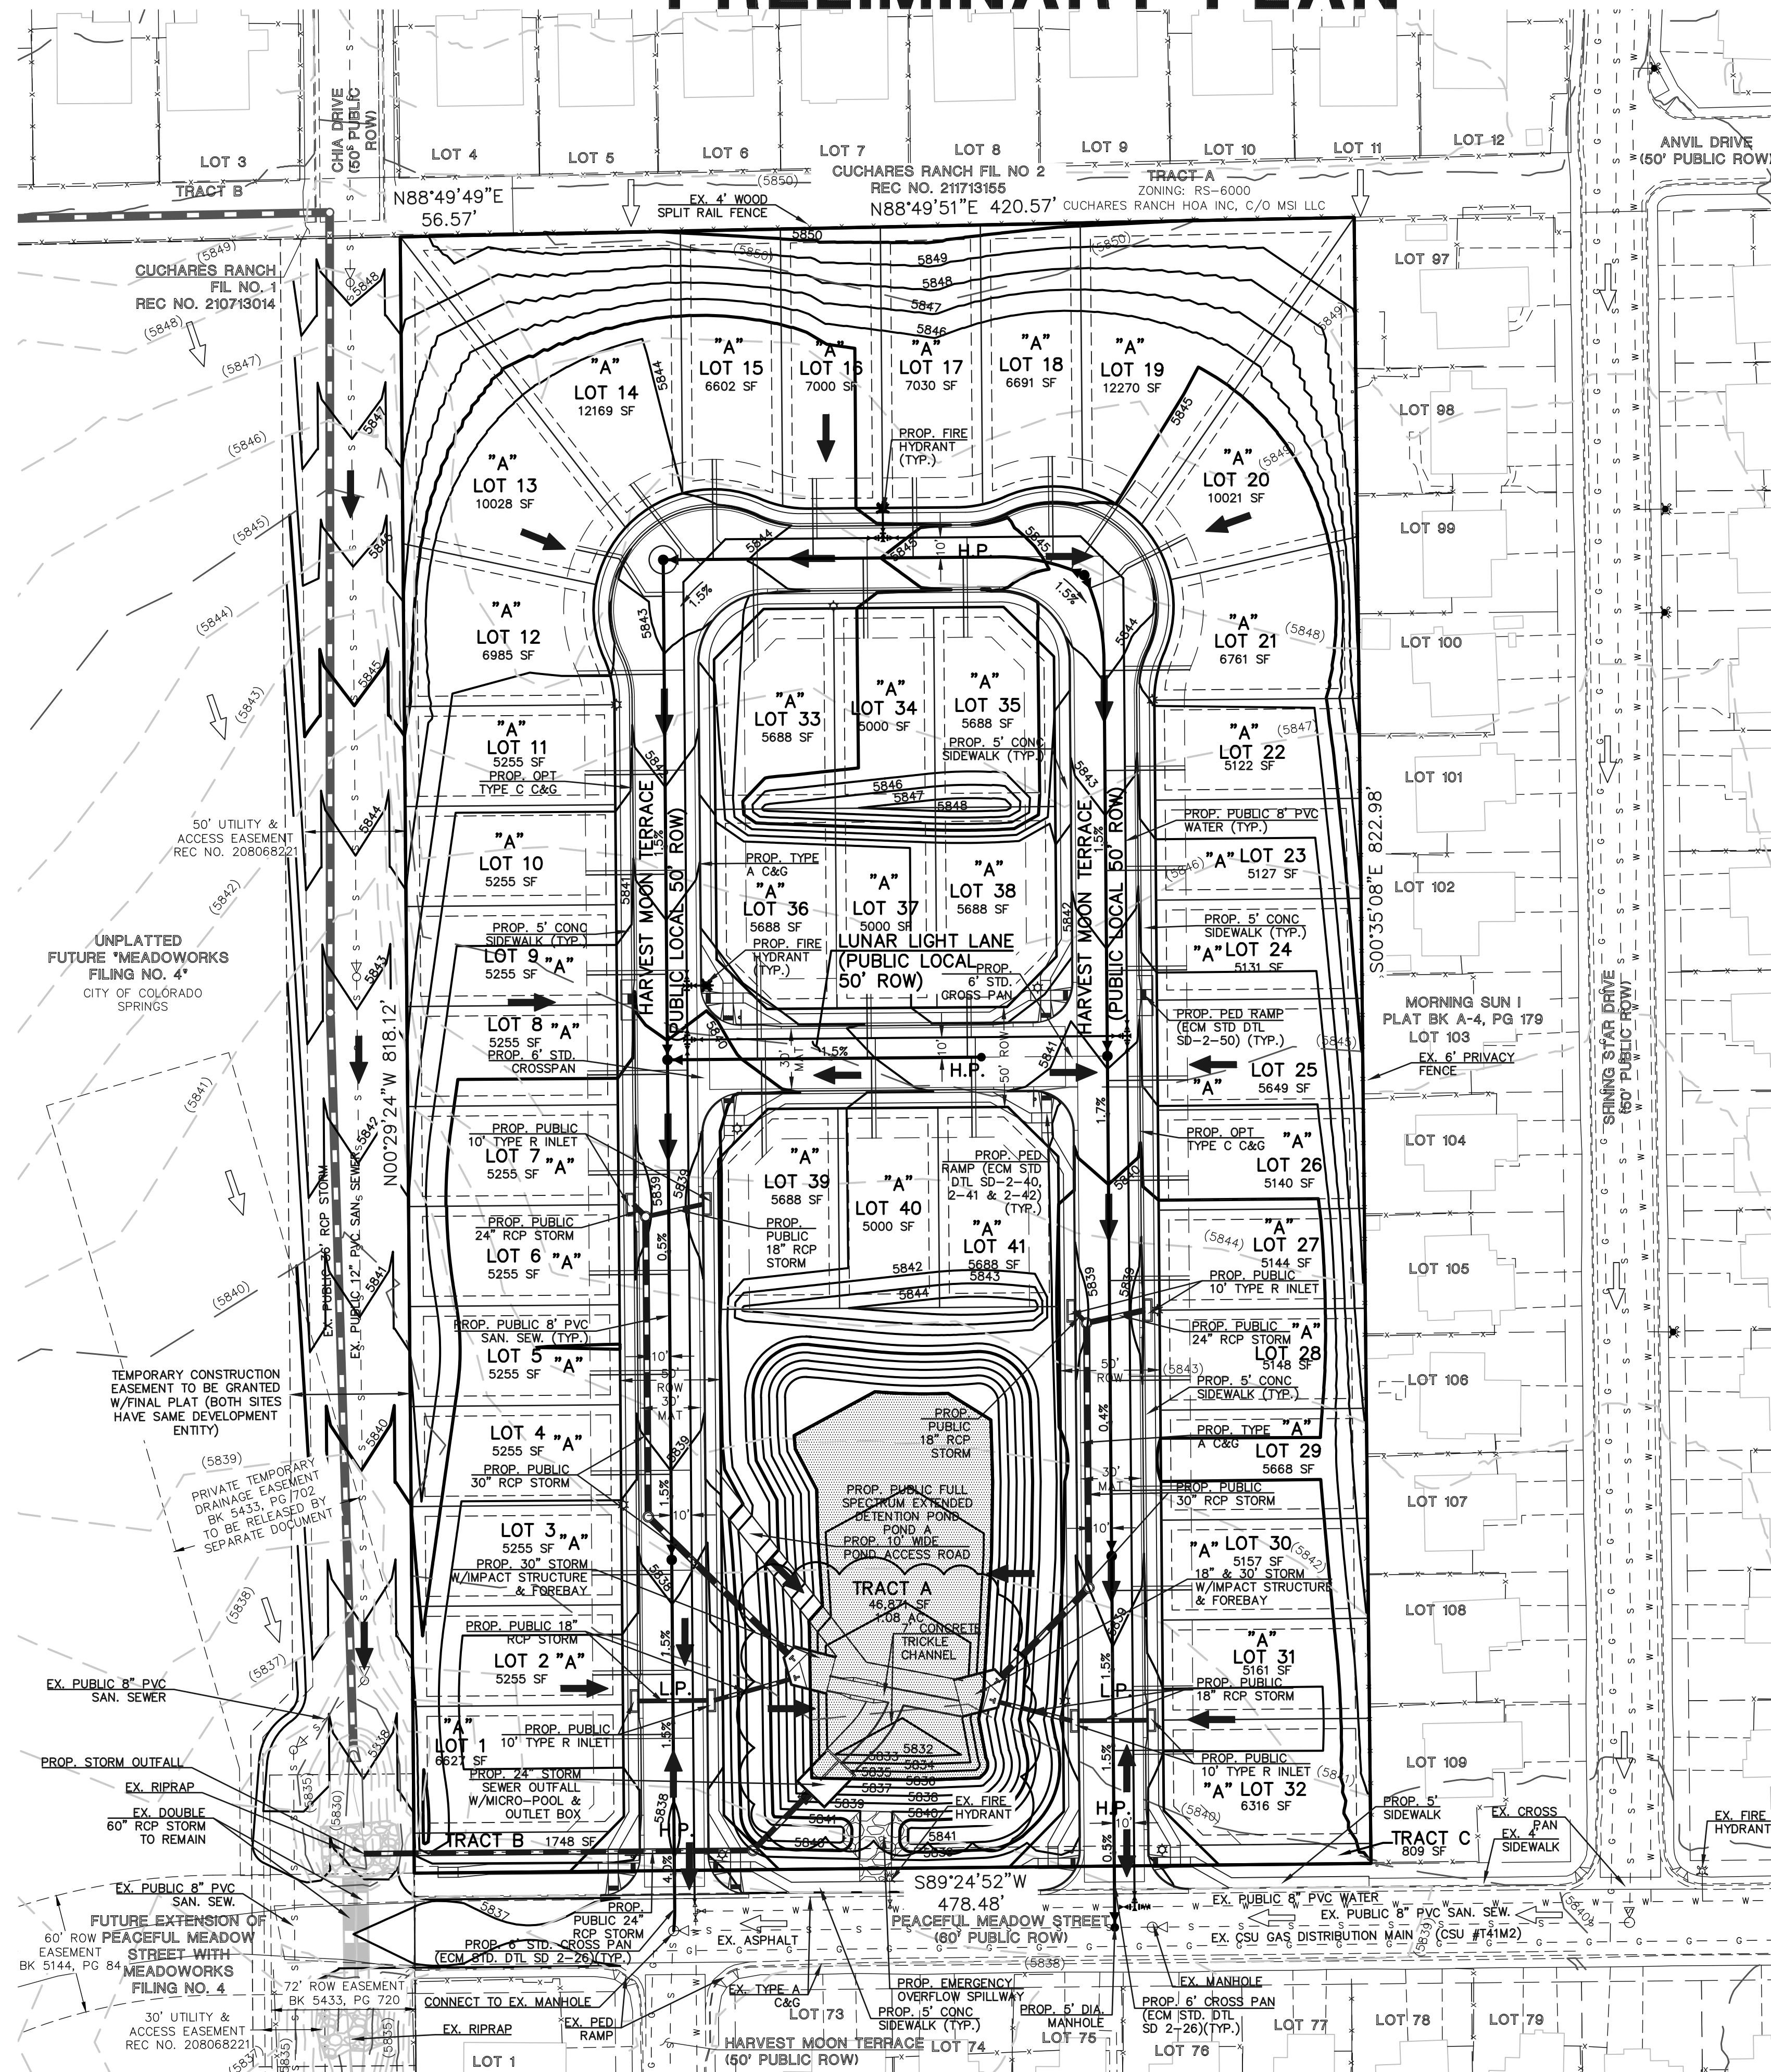


LEGEND

- PROPOSED CONTOUR-5
- PROPOSED CONTOUR-1
- EXISTING CONTOUR-5
- EXISTING CONTOUR-1
- EXISTING DIRECTION OF FLOW
- PROPOSED DIRECTION OF FLOW
- PROPOSED HIGH POINT **H.P.**
- PROPOSED LOW POINT **L.P.**
- EXISTING FIRE HYDRANT
- EXISTING WATER MAIN
- EXISTING SANITARY SEWER MAIN W/ MANHOLE
- PROPOSED WATER MAIN
- PROPOSED FIRE HYDRANT
- PROPOSED STORM INLET
- PROPOSED STORM SEWER
- EXISTING STORM INLET
- EXISTING STORM SEWER
- PROPOSED SANITARY SEWER MAIN W/ MANHOLE
- EXISTING GAS MAIN
- EXISTING FENCE
- SETBACK
- MVEA EASEMENT
- LOT EASEMENT

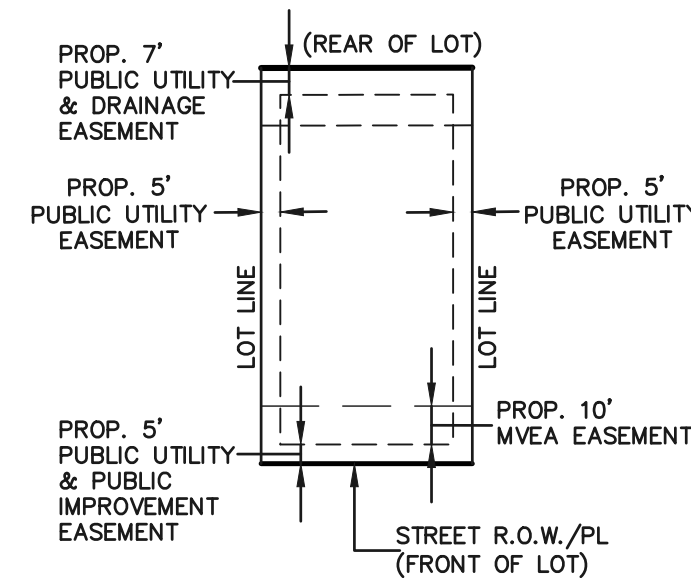

DETAIL: TYPICAL LOT EASEMENTS


N.T.S.

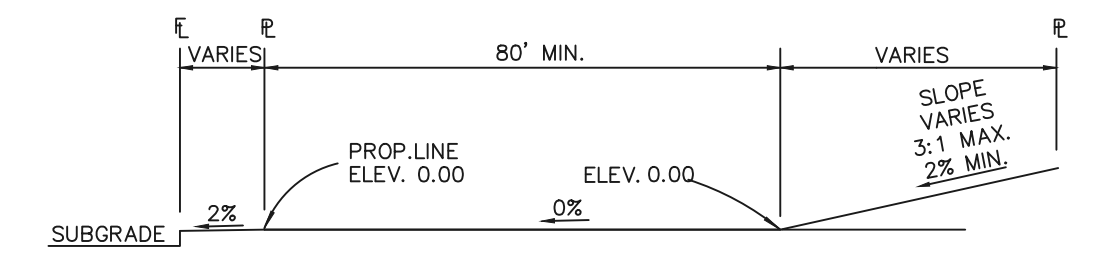

TYPICAL (A) LOT

N.T.S.


- NOTES:
- ALL TYPE C CURB & GUTTER IS THE OPTIONAL TYPE C CURB & GUTTER PER EPC STANDARDS
 - ALL PROPOSED STORM ALIGNMENT AND INLET SIZING IS PRELIMINARY. FINAL DESIGN TO BE PROVIDED WITH CD'S AND FINAL DRAINAGE REPORT

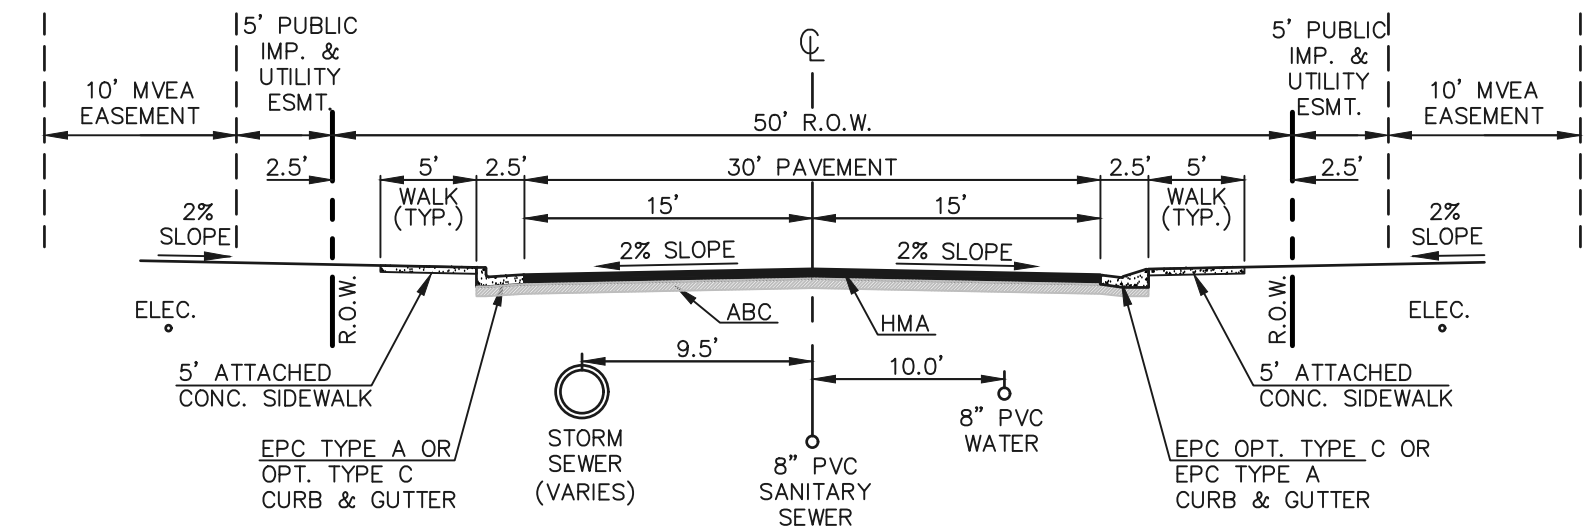

50' R.O.W. TYPICAL STREET/UTILITY SECTION - URBAN LOCAL ROADWAY

SCALE 1" = 10'

NOTE: THIS COMMUNITY WILL NOT REQUIRE GAS FACILITIES (HOMES ARE ALL ELECTRIC).

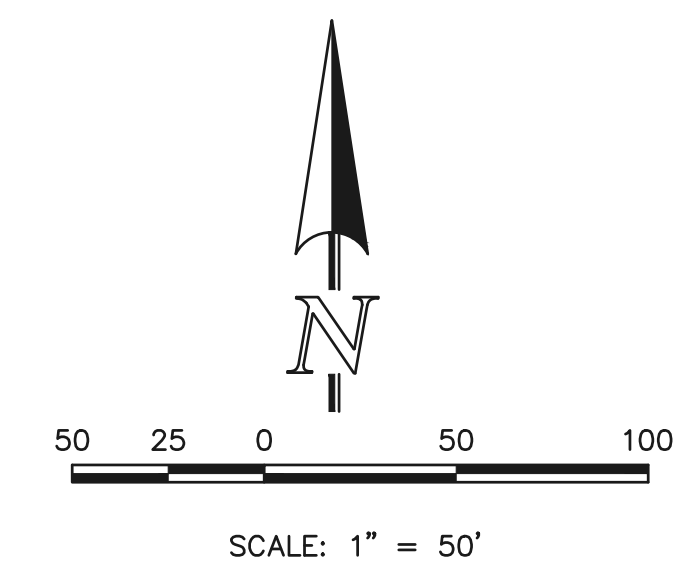

NOTE: ALL PEDESTRIAN RAMPS/PATHS TO BE CONSTRUCTED IN ACCORDANCE WITH ECM CHAPTER 6. SEE ECM STANDARD DRAWINGS SD_2-40, 2-41, 2-42 AND 2-50.

EL PASO COUNTY FILE NO.: SP243



RISING MOON
PRELIMINARY PLAN
PRELIMINARY GRADING & UTILITY PLAN

| | | | | |
|-------------|--------------|--------------|---------|------------|
| DESIGNED BY | MES | SCALE | DATE | 05/15/2024 |
| DRAWN BY | KES | (H) 1" = 50' | SHEET | 4 OF 4 |
| CHECKED BY | (V) 1" = N/A | JOB NO. | 2506.03 | |


619 N. Cascade Avenue, Suite 200
Colorado Springs, Colorado 80903

(719)785-0790

N:\250603\DRAWINGS\DEVELOPMENT\PRELIM\PLAN\04-250603P-G-PU.dwg, 8/14/2024 11:21:17 AM, 1:1

V2_Preliminary Plan Drawings.pdf Markup Summary

Bret (3)

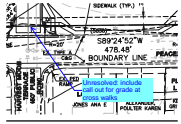


Subject: Engineer
Page Label: [3] 03-250603PSP - Layout1
Author: Bret
Date: 10/7/2024 11:51:52 AM
Status:
Color: ■
Layer:
Space:

Unresolved: include call out for grade at crosswalks



Subject: Engineer
Page Label: [3] 03-250603PSP - Layout1
Author: Bret
Date: 10/8/2024 4:38:11 PM
Status:
Color: ■
Layer:
Space:

Please include size with the stop signs

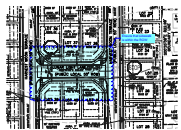

Subject: Engineer
Page Label: [3] 03-250603PSP - Layout1
Author: Bret
Date: 10/8/2024 4:37:00 PM
Status:
Color: ■
Layer:
Space:

Ensure that sidewalk is within the ROW