# BENT GRASS EAST COMMERCIAL FILING NO. 4

A REPLAT OF LOT 1A "BENT GRASS EAST COMMERCIAL FILING NO. 2A", RECORDED UNDER RECEPTION NO. 214713554 IN THE EL PASO COUNTY, COLORADO RECORDS, BEING A PORTION OF THE NORTHEAST QUARTER OF SECTION 1, T13S, R65W, OF THE 6TH P.M., EL PASO COUNTY, COLORADO

#### BE IT KNOWN BY THESE PRESENTS:

THAT CD MERIDIAN & BENT GRASS, LLC, AN ARIZONA LIMITED LIABILITY COMPANY. BEING THE OWNERS OF THE FOLLOWING DESCRIBED TRACT OF LAND:

#### LEGAL DESCRIPTION:

LOT 1A, "BENT GRASS EAST COMMERCIAL FILING NO. 2A" AS RECORDED UNDER RECEPTION NO. 214713554 OF THE RECORDS OF EL PASO COUNTY, COLORADO, BEING A PORTION OF THE NORTHEAST QUARTER OF SECTION 1, T13S, R65W OF THE 6th P.M., EL PASO COUNTY,

SAID PARCEL CONTAINS A CALCULATED AREA OF 63,462 SQUARE FEET (1.457 ACRES MORE OR LESS).

THOSE EASEMENT RIGHTS CREATED BY RECIPROCAL ACCESS EASEMENT AND TEMPORARY CONSTRUCTION AND MAINTENANCE EASEMENT AGREEMENT RECORDED JUNE 04, 2013 UNDER RECEPTION NO. 213072561 AND FIRST AMENDMENT TO RECIPROCAL ACCESS EASEMENT AND TEMPORARY CONSTRUCTION AND MAINTENANCE EASEMENT AGREEMENT RECORDED JULY 07, 2013 UNDER RECEPTION NO. 213098588.

SEE GENERAL PLAT NOTE 1 FOR BASIS OF BEARING.

#### **DEDICATION:**

THE UNDERSIGNED, BEING ALL THE OWNERS, MORTGAGEES, BENEFICIARIES OF DEEDS OF TRUST AND HOLDERS OF OTHER INTERESTS IN THE LAND DESCRIBED HEREIN, HAVE LAID OUT, SUBDIVIDED, AND PLATTED SAID LANDS INTO LOTS AND EASEMENTS AS SHOWN HEREON UNDER THE NAME AND SUBDIVISION OF "BENT GRASS EAST COMMERCIAL FILING NO. 4". ALL PUBLIC IMPROVEMENTS SO PLATTED ARE HEREBY DEDICATED TO PUBLIC USE AND SAID OWNER DOES HEREBY COVENANT AND AGREE THAT THE PUBLIC IMPROVEMENTS WILL BE CONSTRUCTED TO EL PASO COUNTY STANDARDS AND THAT PROPER DRAINAGE AND EROSION CONTROL FOR SAME WILL BE PROVIDED AT SAID OWNER'S EXPENSE, ALL TO THE SATISFACTION OF THE BOARD OF COUNTY COMMISSIONERS OF EL PASO COUNTY, COLORADO. UPON ACCEPTANCE BY RESOLUTION, ALL PUBLIC IMPROVEMENTS SO DEDICATED WILL BECOME MATTERS OF MAINTENANCE BY EL PASO COUNTY, COLORADO THE UTILITY EASEMENTS SHOWN HEREON ARE HEREBY DEDICATED FOR PUBLIC UTILITIES AND COMMUNICATION SYSTEMS AND OTHER PURPOSES AS SHOWN HEREON. THE ENTITIES RESPONSIBLE FOR PROVIDING THE SERVICES FOR WHICH THE EASEMENTS ARE ESTABLISHED ARE HEREBY GRANTED THE PERPETUAL RIGHT OF INGRESS AND EGRESS FROM AND TO ADJACENT PROPERTIES FOR INSTALLATION, MAINTENANCE, AND REPLACEMENT OF UTILITY LINES AND RELATED FACILITIES.


BY: ALEXANDER APODACA, MANAGER,

CD MERIDIAN & BENT GRASS, LLC, AN ARIZONA LIMITED LIABILITY COMPANY

## NOTARIAL:

NOTARY PUBLIC: \_\_\_\_\_

STATE OF COLORADO COUNTY OF EL PASO ACKNOWLEDGED BEFORE ME THIS \_\_\_\_\_ DAY OF \_\_\_\_\_, 2023 BY ALEXANDER APODACA, AS MANAGER, CD MERIDIAN & BENT GRASS, LLC, AN ARIZONA LIMITED LIABILITY COMPANY WITNESS MY HAND AND OFFICIAL SEAL: MY COMMISSION EXPIRES:

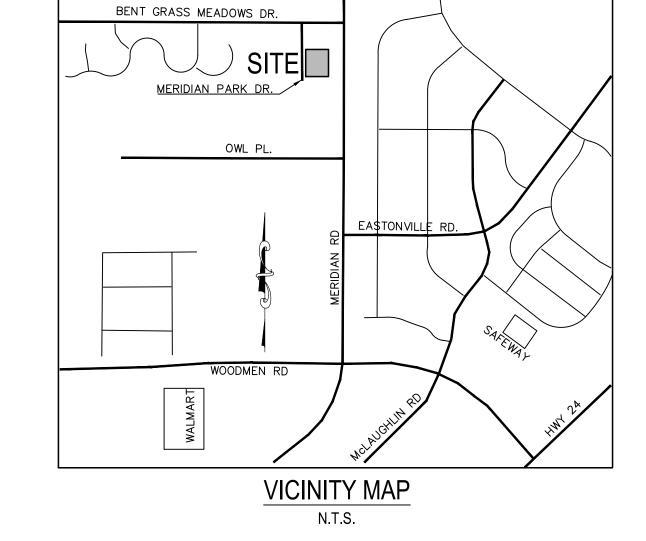

#### GENERAL PLAT NOTES:

- 1. BASIS OF BEARINGS: BEARINGS ARE DERIVED FROM STATE PLANE COORDINATES ON THE WEST LINE OF LOT 1A "BENT GRASS EAST COMMERCIAL FILING NO. 2A" RECORDED UNDER RECEPTION NO. 214713554 IN THE RECORDS OF EL PASO COUNTY, COLORADO, BEING MONUMENTED AT EACH END WITH A FOUND NO. 5 REBAR WITH 1.25" ALUMINUM CAP STAMPED "CCES PLS 30118", SAID LINE BEARS NO0°29'16"W (NO0°00'00"E RECORD) A DISTANCE OF 282.10 (282.16 RECORD) FEET. THE UNIT OF MEASUREMENT FOR THIS PLAT IS THE U.S. SURVEY FOOT.
- 2. THE FLOOD INSURANCE RATE MAP (FIRM) PANEL NO. 08041C0553G WITH AN EFFECTIVE DATE OF DECEMBER 7, 2018 HAS BEEN EXAMINED AS IT RELATES TO THE PROPERTY BEING PLATTED. SUBJECT PROPERTY LIES WITHIN ZONE X (AREA OF MINIMAL FLOOD HAZARD).
- 3. THIS PLAT DOES NOT CONSTITUTE A TITLE SEARCH BY M&S CIVIL CONSULTANTS, INC. TO DETERMINE OWNERSHIP OR EASEMENTS OF RECORD. FOR ALL INFORMATION REGARDING TITLE OF RECORD, EASEMENTS, AND RIGHTS-OF-WAY, M&S CIVIL CONSULTANTS RELIED ON A COMMITMENT FOR TITLE INSURANCE ISSUED JUNE 6, 2023 BY LAND TITLE GUARANTEE COMPANY AS AGENT FOR OLD REPUBLIC NATIONAL TITLE INSURANCE COMPANY, WITH AN EFFECTIVE DATE OF MAY 27, 2023 AT 5:00 P.M., ORDER NO. SC55101622-8, WHICH HAS BEEN EXAMINED AS IT RELATES TO THE PROPERTY BEING PLATTED. ADDITIONAL REAL ESTATE RECORD RESEARCH WAS NOT CONDUCTED BY M&S CIVIL CONSULTANTS.
- 4. WATER AND WASTEWATER SERVICES FOR THIS SUBDIVISION ARE PROVIDED BY THE WOODMEN HILLS METROPOLITAN DISTRICT SUBJECT TO THE DISTRICTS RULES REGULATIONS AND
- 5. ALL STRUCTURAL FOUNDATIONS SHALL BE LOCATED AND DESIGNED BY A PROFESSIONAL ENGINEER, CURRENTLY REGISTERED IN THE STATE OF COLORADO.
- 6. THE ADDRESSES EXHIBITED ON THIS PLAT ARE FOR INFORMATIONAL PURPOSES ONLY. THEY ARE NOT THE LEGAL DESCRIPTION AND ARE SUBJECT TO CHANGE.
- MERIDIAN PARK DRIVE VIA BENT GRASS MEADOWS DRIVE. 8. NO DRIVEWAY SHALL BE ESTABLISHED UNLESS AN ACCESS PERMIT HAS BEEN GRANTED BY

7. THERE SHALL BE NO DIRECT ACCESS TO MERIDIAN ROAD ALLOWED. ACCESS IS BY

STATES POSTAL SERVICES REGULATIONS.

- 9. MAILBOXES SHALL BE INSTALLED IN ACCORDANCE WITH ALL EL PASO COUNTY AND UNITED
- 10. ALL PROPERTY OWNERS ARE RESPONSIBLE FOR MAINTAINING PROPER STORM WATER DRAINAGE IN AND THROUGH THEIR PROPERTY. PUBLIC DRAINAGE EASEMENTS AS SPECIFICALLY NOTED ON THE PLAT SHALL BE MAINTAINED BY THE INDIVIDUAL LOT OWNERS UNLESS OTHERWISE INDICTED. STRUCTURES, FENCES, MATERIALS, OR LANDSCAPING THAT COULD IMPEDE THE FLOW OF RUNOFF SHALL NOT BE PLACED IN DRAINAGE EASEMENT.
- 11. THE PROPERTY IS SUBJECT TO THE DECLARATION OF COVENANTS, CONDITIONS, AND RESTRICTIONS AND GRANT OF EASEMENTS AS RECORDED AT RECEPTION NO. 21309866 AND USE RESTRICTION AGREEMENT UNDER RECEPTION NO. 214085629 OF THE RECORDS OF EL
- 12. THE FOLLOWING REPORTS HAVE BEEN SUBMITTED IN ASSOCIATION WITH THE FINAL PLAT FOR THIS SUBDIVISION AND ARE ON FILE AT THE COUNTY PLANNING AND COMMUNITY DEVELOPMENT DEPARTMENT: TRANSPORTATION IMPACT STUDY; DRAINAGE REPORT; WATER RESOURCES REPORT; WASTEWATER DISPOSAL REPORT; GEOLOGY AND SOILS REPORT; FIRE
- 13. PUBLIC AND COMMON SUBDIVISION IMPROVEMENTS: NO LOT OR INTEREST THEREIN, SHALL BE SOLD, CONVEYED, OR TRANSFERRED WHETHER BY DEED OR BY CONTRACT, NOR SHALL BUILDING PERMITS BE ISSUED, UNTIL AND UNLESS EITHER THE REQUIRED PUBLIC AND COMMON DEVELOPMENT IMPROVEMENTS HAVE BEEN CONSTRUCTED AND COMPLETED AND PRELIMINARILY ACCEPTED IN ACCORDANCE WITH THE SUBDIVISION IMPROVEMENTS AGREEMENT BETWEEN THE APPLICANT/OWNER AND EL PASO COUNTY AS RECORDED UNDER RECEPTION NO. 214092268 IN THE OFFICE OF THE CLERK AND RECORDER OF EL PASO COUNTY, COLORADO OR, IN THE ALTERNATIVE, OTHER COLLATERAL IS PROVIDED TO MAKE PROVISION FOR THE COMPLETION OF SAID IMPROVEMENTS IN ACCORDANCE WITH THE EL PASO COUNTY LAND DEVELOPMENT CODE AND ENGINEERING CRITERIA MANUAL. ANY SUCH ALTERNATIVE COLLATERAL MUST BE APPROVED BY THE BOARD OF COUNTY COMMISSIONERS OR, IF PERMITTED BY THE SUBDIVISION IMPROVEMENTS AGREEMENT, BY THE PLANNING AND COMMUNITY DEVELOPMENT DEPARTMENT DIRECTOR AND MEET THE POLICY AND PROCEDURE REQUIREMENTS OF EL PASO COUNTY PRIOR TO THE RELEASE BY THE COUNTY OF ANY LOTS FOR SALE, CONVEYANCE OR TRANSFER.THIS PLAT RESTRICTION MAY BE REMOVED OR RESCINDED BY THE BOARD OF COUNTY COMMISSIONERS OR, IF PERMITTED BY THE SUBDIVISION IMPROVEMENTS AGREEMENT, BY THE PLANNING AND COMMUNITY DEVELOPMENT DEPARTMENT DIRECTOR UPON EITHER APPROVAL OF AN ALTERNATIVE FORM OF COLLATERAL OR COMPLETION AND PRELIMINARY ACCEPTANCE BY THE EL PASO BOARD OF COUNTY COMMISSIONERS OF ALL IMPROVEMENTS REQUIRED TO BE CONSTRUCTED AND COMPLETED IN ACCORDANCE WITH SAID SUBDIVISION IMPROVEMENTS AGREEMENT. THE PARTIAL RELEASE OF LOTS FOR SALE, CONVEYANCE OR TRANSFER MAY ONLY BE GRANTED IN ACCORDANCE WITH ANY PLANNED PARTIAL RELEASE OF LOTS AUTHORIZED BY THE SUBDIVISION IMPROVEMENTS AGREEMENT.

#### GENERAL PLAT NOTES: (CONT.)

- 14. DEVELOPER SHALL COMPLY WITH FEDERAL AND STATE LAWS, REGULATIONS, ORDINANCES, REVIEW AND PERMIT REQUIREMENTS, AND OTHER AGENCY REQUIREMENTS, IF ANY, OF APPLICABLE AGENCIES INCLUDING, BUT NOT LIMITED TO, THE COLORADO DIVISION OF WILDLIFE, COLORADO DEPARTMENT OF TRANSPORTATION, U.S. ARMY CORPS OF ENGINEERS AND THE U.S. FISH AND WILDLIFE SERVICE REGARDING THE ENDANGERED SPECIES ACT, PARTICULARLY AS IT RELATES TO THE LISTED SPECIES.
- 15. THE SUBDIVIDER(S) AGREES ON BEHALF OF HIM/HERSELF AND ANY DEVELOPER OR BUILDER SUCCESSORS AND ASSIGNS THAT SUBDIVIDER AND/OR SAID SUCCESSORS AND ASSIGNS SHALL BE REQUIRED TO PAY TRAFFIC IMPACT FEES IN ACCORDANCE WITH THE COUNTYWIDE TRANSPORTATION IMPROVEMENT FEE RESOLUTION (RESOLUTION 19-471), AS AMENDED, AT OR PRIOR TO THE TIME OF BUILDING PERMIT SUBMITTALS. THE FULL FEE OBLIGATION FOR LOT 1 SHALL BE PAID UP FRONT. THE METHOD OF PAYMENT FOR THE REMAINING PORTIONS OF THE OBLIGATED FEES SHALL BE DOCUMENTED ON ALL SALES DOCUMENTS AND ON PLAT NOTES TO ENSURE THAT A TITLE SEARCH WOULD FIND THE FEE OBLIGATION BEFORE THE SALE OF THE PROPERTY.
- 16. WOODMEN ROAD DISTRICT NOTE: ALL PROPERTY WITHIN THIS SUBDIVISION IS WITHIN THE BOUNDARIES OF THE WOODMEN ROAD METROPOLITAN DISTRICT AND, AS SUCH, IS SUBJECT TO A MILL LEVY, PLATTING FEES AND BUILDING PERMIT FEES FOR THE PURPOSE OF FINANCING CONSTRUCTION OF SPECIFIED IMPROVEMENTS TO WOODMEN ROAD.
- 17. SOIL AND GEOLOGY CONDITIONS: GEOLOGIC HAZARDS: THE FOLLOWING LOTS HAVE BEEN FOUND TO BE IMPACTED BY GEOLOGIC HAZARDS. MITIGATION MEASURES AND A MAP OF THE HAZARD AREA CAN BE FOUND IN THE REPORT "SUBSURFACE SOIL INVESTIGATION DUNKIN DONUTS MERIDIAN ROAD AND BENT GRASS MEADOWS DRIVE EL PASO COUNTY, COLORADO"BY ENTECH ENGINEERING, INC. SEPTEMBER 23, 2022 IN FILE ENTECH JOB NO. 221761 AVAILABLE AT THE EL PASO COUNTY PLANNING AND COMMUNITY DEVELOPMENT DEPARTMENT:
- ARTIFICIAL FILL: LOTS 1 AND 2 FILL ASSOCIATED WITH CONTROLLED FILL PLACED ON THE SITE, AND MINOR FILL PILES OBSERVED ON THE SITE. AREAS OF FILL OTHER THAN THOSE MAPPED MAY BE ENCOUNTERED. THE FILL AT THE SITE WAS PERIODICALLY OBSERVED AND TESTED BY PERSONNEL OF ENTECH ENGINEERING INC. ANY UNCONTROLLED FILL ENCOUNTERED BENEATH FOUNDATIONS WILL REQUIRE COMPLETE PENETRATION AND REMOVAL AND RECOMPACTION UNDER CONTROLLED CONDITIONS. MITIGATION: IT IS ANTICIPATED THAT THE FILL PILES WILL BE REMOVED DURING SITE
- GRADING. AREAS OF FILL OTHER THAN THOSE ENCOUNTERED MAY BE ENCOUNTERED. THE FILL PILES ARE CONSIDERED UNCONTROLLED. ANY UNCONTROLLED FILL ENCOUNTERED BENEATH FOUNDATIONS SHOULD BE REMOVED AND RECOMPACTED AT A MINIMUM OF 95% OF ITS MAXIMUM MODIFIED PROCTOR DRY DENSITY, ASTM D-1557.
- 18.LOTS 1 AND 2 OF THIS PLAT SHALL BE SUBJECT TO THE DECLARATION OF CROSS ACCESS EASEMENT RECORDED UNDER RECEPTION NO. \_\_\_\_\_
- 19. ANY PERSON WHO KNOWINGLY REMOVES, ALTERS OR DEFACES ANY PUBLIC LAND SURVEY MONUMENT OR LAND BOUNDARY MONUMENT OR ACCESSORY COMMITS A CLASS TWO (2) MISDEMEANOR PURSUANT TO C.R.S. § 18-4-508.
- 20.THE APPROVAL OF THIS REPLAT VACATES ALL PRIOR PLATS FOR THE AREA DESCRIBED BY THIS REPLAT.

### **EASEMENTS:**

- UNLESS OTHERWISE INDICATED, SIDE LOT LINES ARE HEREBY PLATTED ON EITHER SIDE WITH A FIVE (5) FOOT PUBLIC UTILITY AND DRAINAGE EASEMENT UNLESS OTHERWISE INDICATED. ALL OTHER EASEMENTS ARE AS SHOWN ON THIS PLAT.
- THE SOLE RESPONSIBILITY FOR MAINTENANCE OF EASEMENTS IS HEREBY VESTED WITH THE INDIVIDUAL PROPERTY OWNERS.

Please add this note; Gas and Electric: The subdivider/developer is responsible for extending utilities to each lot, tract or building

Gas and electric service for this subdivision is provided by \_\_\_\_ \_\_\_\_\_(Provider name(s)) subject to the District's (Providers) rules, regulations and specifications. (Combined note, which can be broken into separate notes for gas or electric in the case of different

#### SURVEYORS CERTIFICATE

I VERNON P. TAYLOR, A DULY REGISTERED PROFESSIONAL LAND SURVEYOR IN THE STATE OF COLORADO, DO HEREBY CERTIFY THAT THIS PLAT TRULY AND CORRECTLY REPRESENTS THE RESULTS OF A SURVEY MADE APRIL 2021, BY ME OR UNDER MY DIRECT SUPERVISION AND THAT ALL MONUMENTS EXIST AS SHOWN HEREON; THAT MATHEMATICAL CLOSURE ERRORS ARE LESS THAN 1:10,000; AND THAT SAID PLAT HAS BEEN PREPARED IN FULL COMPLIANCE WITH ALL APPLICABLE LAWS OF THE STATE OF COLORADO DEALING WITH MONUMENTS, SUBDIVISION, OR SURVEYING OF LAND AND ALL APPLICABLE PROVISIONS OF THE EL PASO COUNTY LAND DEVELOPMENT CODE.

I ATTEST THE ABOVE ON THIS \_\_\_\_\_ DAY OF \_\_\_\_\_, 2023.

VERNON P. TAYLOR COLORADO PLS NO. 25966, FOR AND ON BEHALF OF M&S CIVIL CONSULTANTS, INC

CHAID DOADD OF COUNTY COMMISSIONEDS



ACCORDING TO COLORADO LAW, YOU MUST COMMENCE ANY LEGAL ACTION BASED UPON ANY DEFECT IN THIS SURVEY WITHIN THREE YEARS AFTER YOU FIRST DISCOVER SUCH DEFECT. IN NO EVENT, MAY ANY ACTION BASED UPON ANY DEFECT IN THIS SURVEY BE COMMENCED MORE THAN TEN YEARS FROM THE DATE OF THE CERTIFICATION SHOWN HEREON.

### BOARD OF COUNTY COMMISSIONERS CERTIFICATE:

THIS PLAT FOR "BENT GRASS EAST COMMERCIAL FILING NO. 4" WAS APPROVED FOR FILING BY THE EL PASO COUNTY, COLORADO BOARD OF COUNTY COMMISSIONERS ON THE \_\_\_\_\_ DAY OF \_\_\_\_\_, 2023, SUBJECT TO ANY NOTES SPECIFIED HEREON AND ANY CONDITIONS INCLUDED IN THE RESOLUTION OF APPROVAL. THE DEDICATIONS OF LAND TO THE PUBLIC EASEMENTS ARE ACCEPTED, BUT PUBLIC IMPROVEMENTS THEREON WILL NOT BECOME THE MAINTENANCE RESPONSIBILITY OF EL PASO COUNTY UNTIL PRELIMINARY ACCEPTANCE OF THE PUBLIC IMPROVEMENTS IN ACCORDANCE WITH THE REQUIREMENTS OF THE LAND DEVELOPMENT CODE AND ENGINEERING CRITERIA MANUAL, AND THE SUBDIVISION IMPROVEMENTS AGREEMENT.

	- · · · · <del>-</del>		plat was for one lot, this is creating 2 lots	
2 LOTS	1.457 ACRES TOTAL	100.00% 100.00%	 Please remove. Prior	
SUMMARY:	-			
REGIONAL I AM		The strain of th		
REGIONAL PARK	>	PAID BY PRIOR PL	)	
URBAN PARK F	(	PAID BY PRIOR PL	7	
SCHOOL FEE:	7	\$ N/A PAID BY PRIOR PLAT		
BRIDGE FEE:	<b>&gt;</b>	PAID BY PRIOR PL	<u> </u>	
DRAINAGE FEE:	$\left\langle \begin{array}{c} X & Y & Y & Y \\ & & \$ & N/A \end{array} \right\rangle$	PAID BY PRIOR PL	' '	
FEES:	00000			
		<i>ו</i> רו₁ מו	•	
SURCHARGE: _		BY:	<u>-</u>	
FEE:		STEVE SCHLE	EIKER, RECORDER	
OF EL PASO CO	DUNTY, COLORADO.	N NO	OF THE RECOR	
C	CLOCK, THIS _	DAY OF	R RECORD IN MY OFFICE AT  2023, A.D.,	
COUNTY OF EL	PASO )			
STATE OF COLO	) SS			
<u>CLERK AN</u>	D RECORDER:			
DIRECTOR OF PL. DEVELOPMENT DE	ANNING AND COMMUNITY PARTMENT		DATE	

FINAL PLAT BENT GRASS EAST COMMERCIAL FILING NO. 4 JOB NO. 70-110

DATE PREPARED: 05/31/2023 DATE REVISED: 06/21/2023 DATE REVISED: 09/06/2023

SHEET 1 OF 2 CIVIL CONSULTANTS, INC.


and associated fees

will apply

PCD FIL. NO. <u>VR2316</u>

# BENT GRASS EAST COMMERCIAL FILING NO. 4

A REPLAT OF LOT 1A "BENT GRASS EAST COMMERCIAL FILING NO. 2A", RECORDED UNDER RECEPTION NO. 214713554 IN THE EL PASO COUNTY, COLORADO RECORDS, BEING A PORTION OF THE NORTHEAST QUARTER OF SECTION 1, T13S, R65W, OF THE 6TH P.M., EL PASO COUNTY, COLORADO

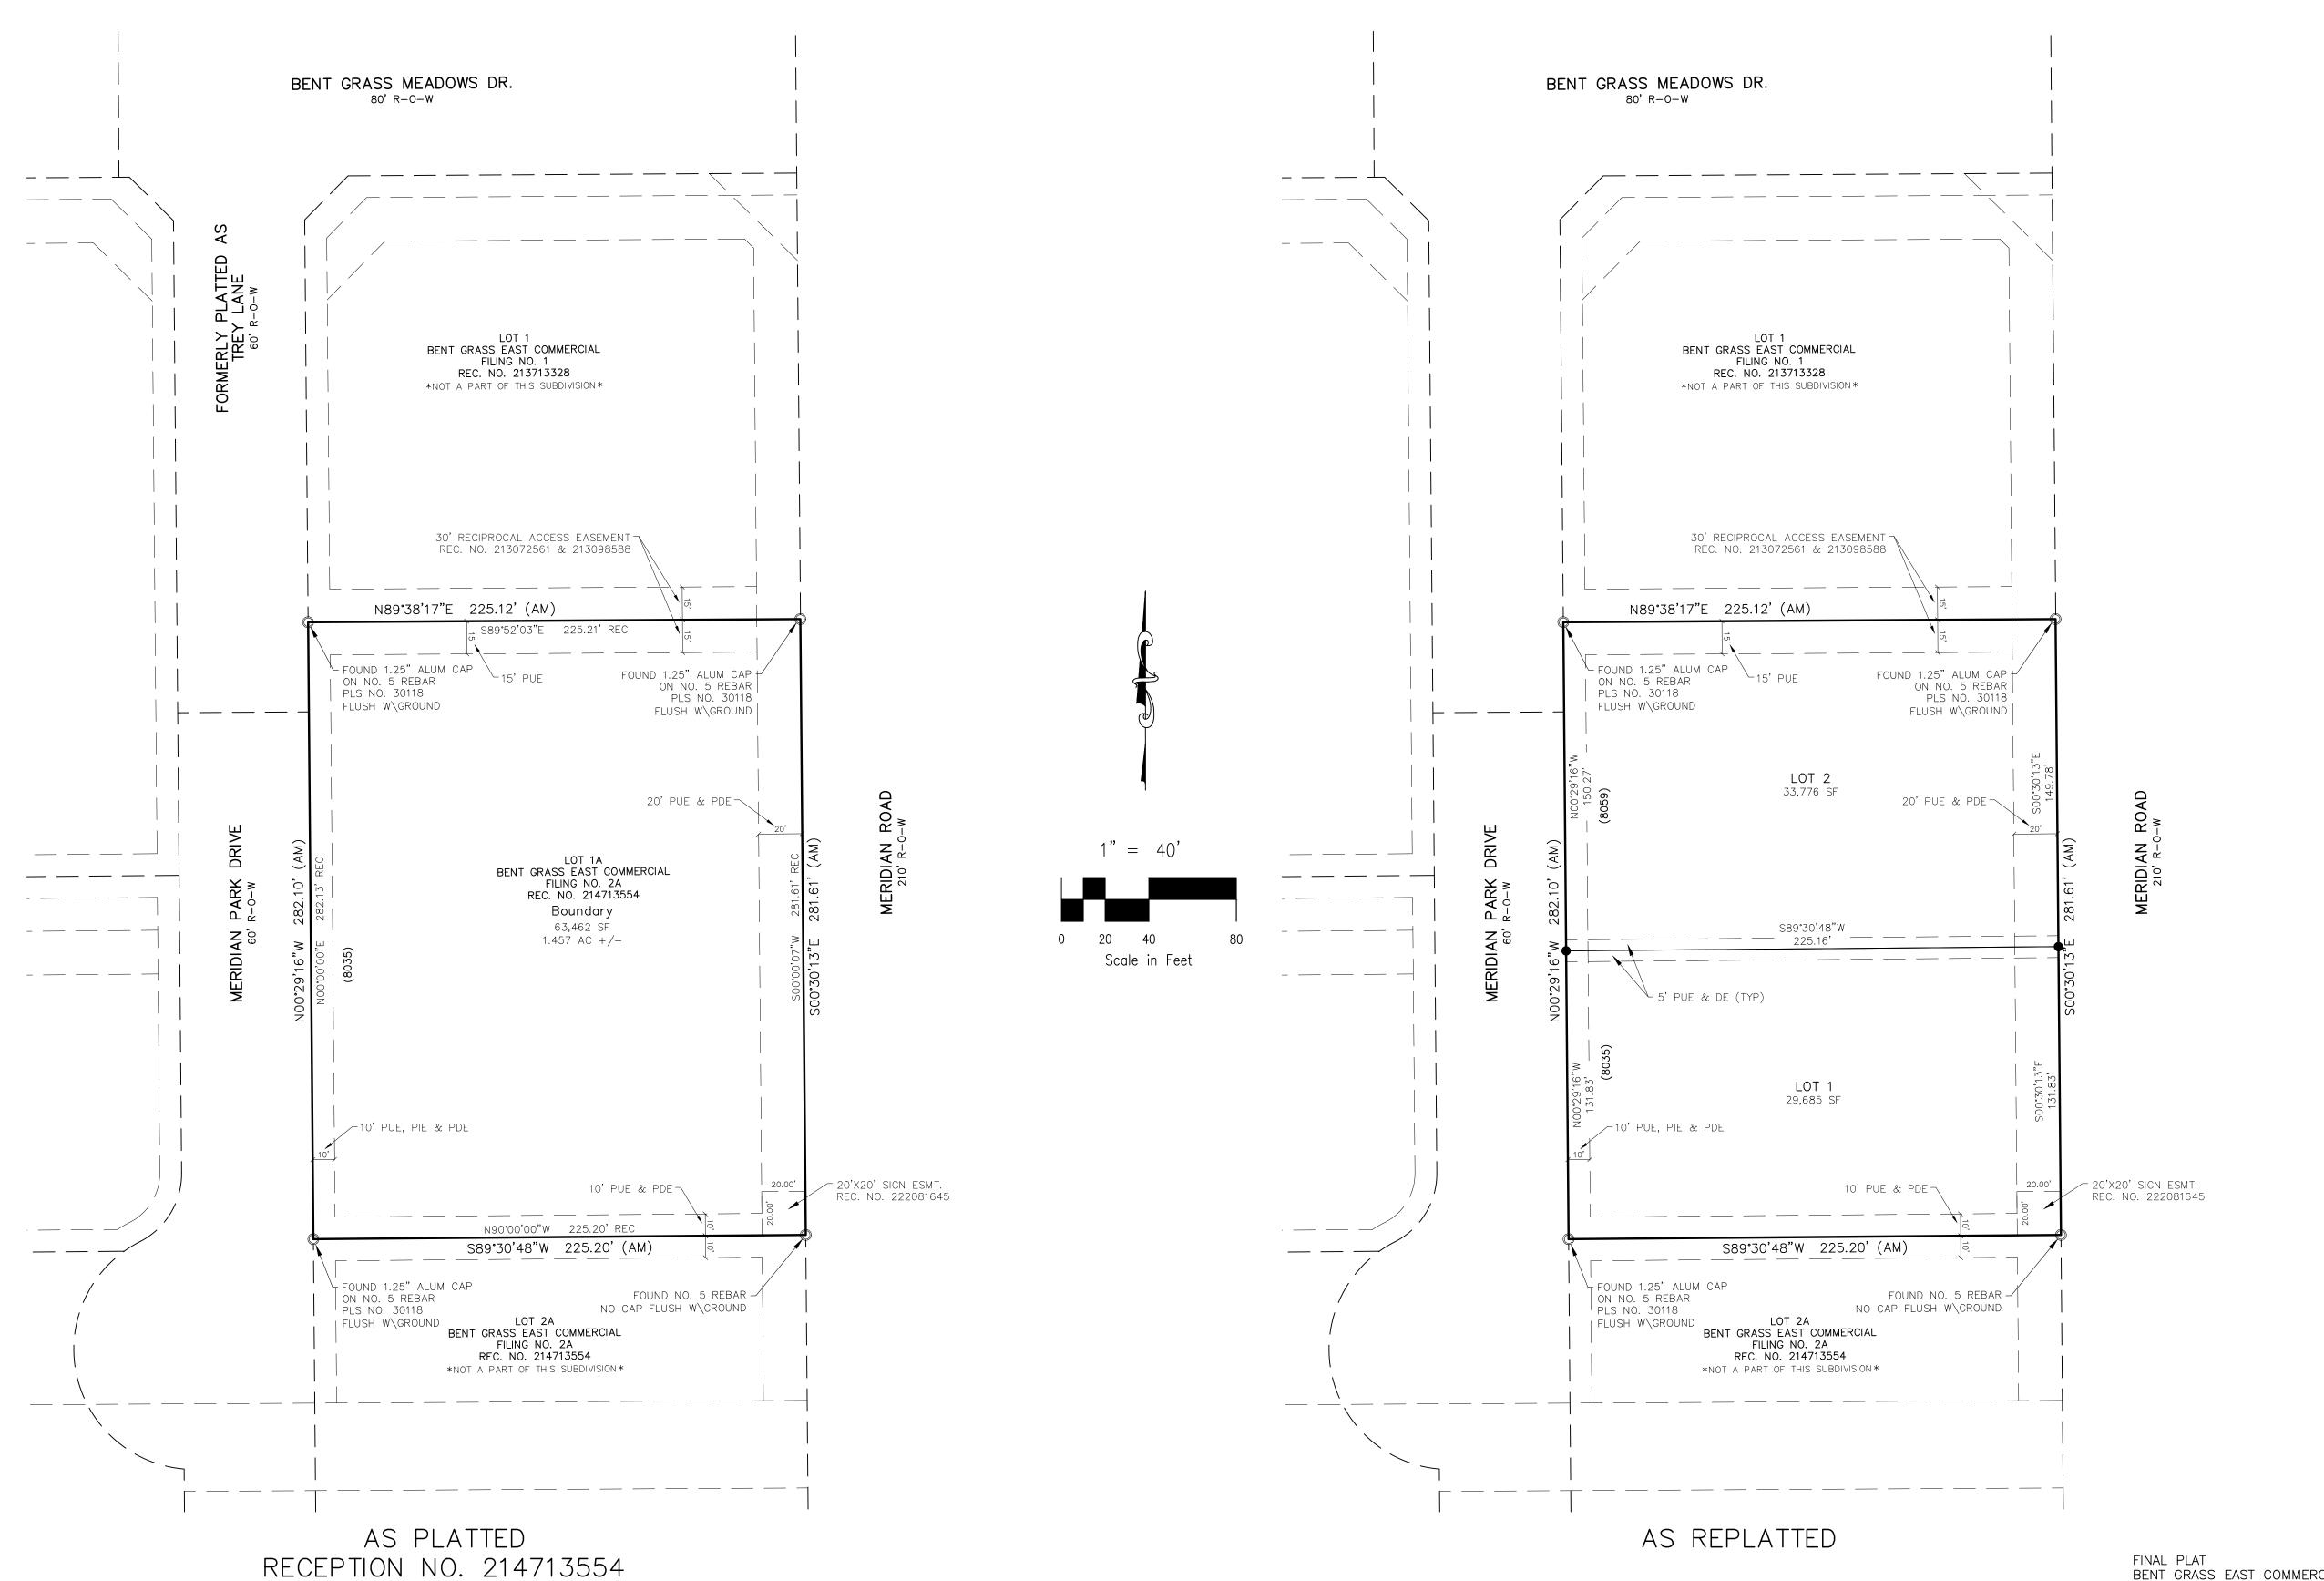

LEGEND

FOUND PROPERTY CORNER AS DESCRIBED

SET NO. 5 REBAR AND ORANGE PLASTIC CAP COLO. PLS NO. 25966 FLUSH W/GRADE

R-O-W RIGHT OF WAY

DRAINAGE EASEMENT

PUBLIC DRAINAGE EASEMENT

PUBLIC IMPROVEMENT EASEMENT

PUBLIC UTILITY EASEMENT

BENT GRASS EAST COMMERCIAL FILING NO. 4 JOB NO. 70-110 DATE PREPARED: 05/31/2023 DATE REVISED: 06/21/2023

PHONE: 719.955.5485 CIVIL CONSULTANTS, INC.

PCD FIL. NO. VR2316

DATE REVISED: 09/06/2023