

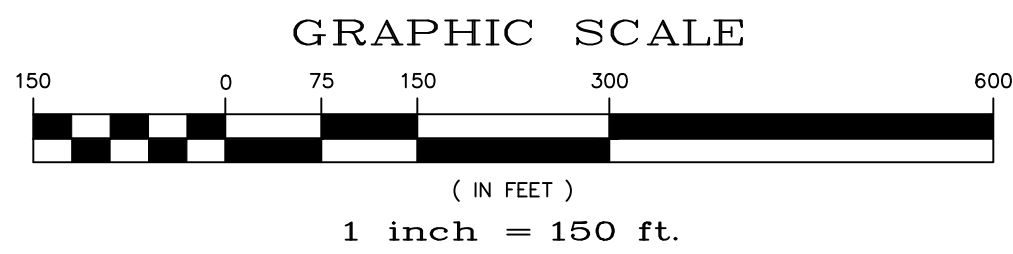


Erosion control blanket is not proposed with this plan set. No change to the plans.

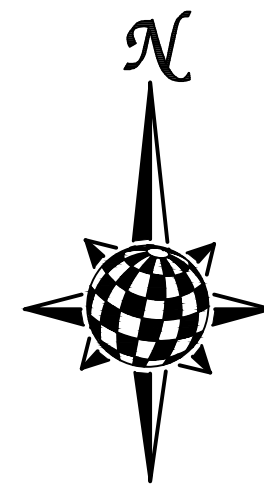

AREAS OF CUT

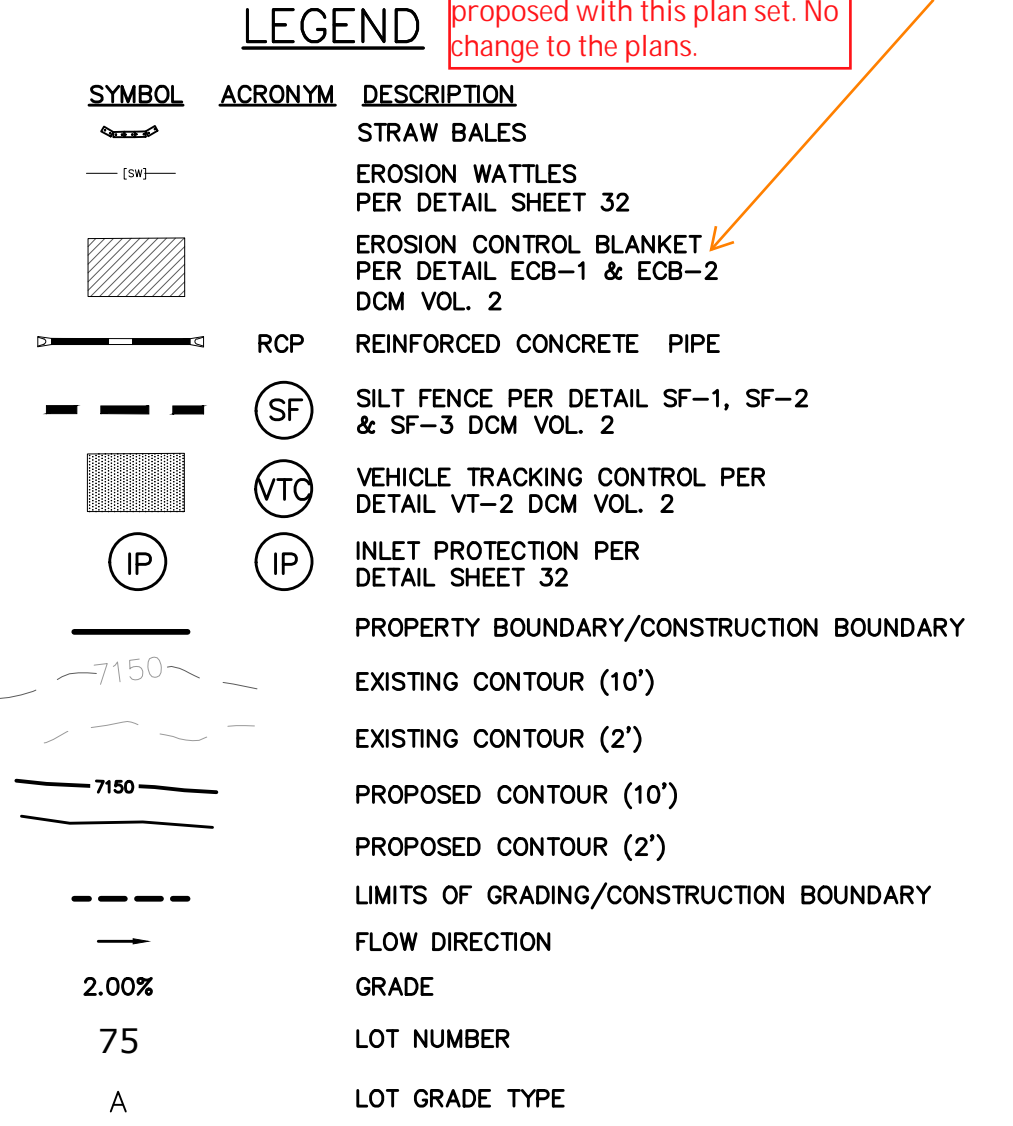

AREAS OF FILL




NOTE:
ALL CONTOURS SHOWN WITHIN THE PLAN SET
ARE TO FINISHED SURFACE. ALL STREET
SECTIONS ARE TO BE GRADED TO ROUGH
SUB-GRADE AS SHOWN IN THEIR RESPECTIVE
TYPICAL STREET SECTION SHOWN ON SHEET 31.


CONTRACTOR SHALL PROTECT ALL EXISTING
UTILITIES.

EX. UTILITIES SEE CONSTRUCTION DRAWINGS FOR:

- 1) ROLLING HILLS RANCH ROUGH GRADING
- 2) ROLLING HILLS RANCH FILING 1
- 3) ESTATES AT ROLLING HILLS RANCH FILING 2
- 4) ROLLING HILLS RANCH FILING 2

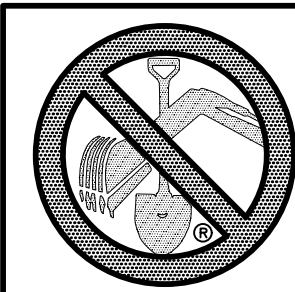


**TWO WORKING DAYS
BEFORE YOU DIG
CALL 811**
OR
UTILITY NOTIFICATION CENTER OF COLORADO
1-800-922-1987
(SEE COVER FOR LIST OF UTILITY CONTACTS)

| | | | | | | | | | | | | |
|---|----------|----------|----------|--|---|---|---|---|---|---|-----|-----------|
|  | Scale | AS SHOWN | Drawn by | ROLLING HILLS RANCH FILING 3 AT MERIDIAN RANCH GRADING-EROSION CONTROL PLAN GRADING CUT-FILL LAYOUT |  MERIDIAN RANCH | TECH CONTRACTORS 11886 STAPLETON DRIVE FALCON, CO 80831 TELEPHONE: 719.495.7444 FAX: 719.495.2457 | 1 | - | - | - | | |
| | | | | | | | | | 2 | - | - | - |
| | | | | | | | | 3 | - | - | - | |
| | | | | | | | | 4 | - | - | - | |
| | 30 of 32 | Date | MAY 2021 | | | | | | | | No. | Revisions |

Construction Drawings_V2_Comments.pdf Markup Summary

Contractor (1)

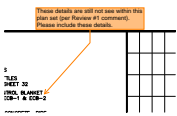

Subject: Contractor
Page Label: 30
Author: EPC Stormwater - Glenn Reese
Date: 6/18/2021 12:02:43 PM
Status:
Color: ■
Layer:
Space:

These details are still not see within this plan set (per Review #1 comment). Please include these details.