


Please resubmit the site plan drawing. The drawing appears cut off.

Please provide a scale, title, and north arrow for these figures.

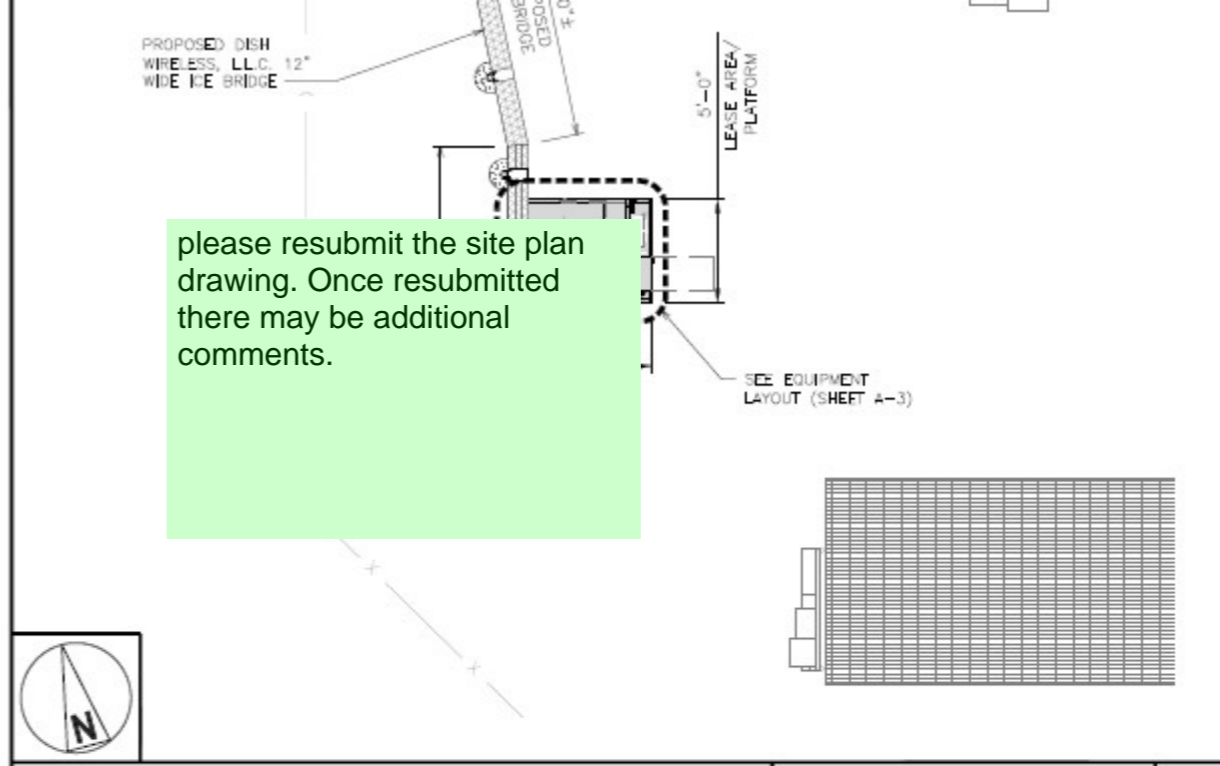


please resubmit the site plan drawing. Once resubmitted there may be additional comments.

ENLARGED SITE PLAN

6' 4' 2' 0' 5' 10'

3/16"=1'-0"

2

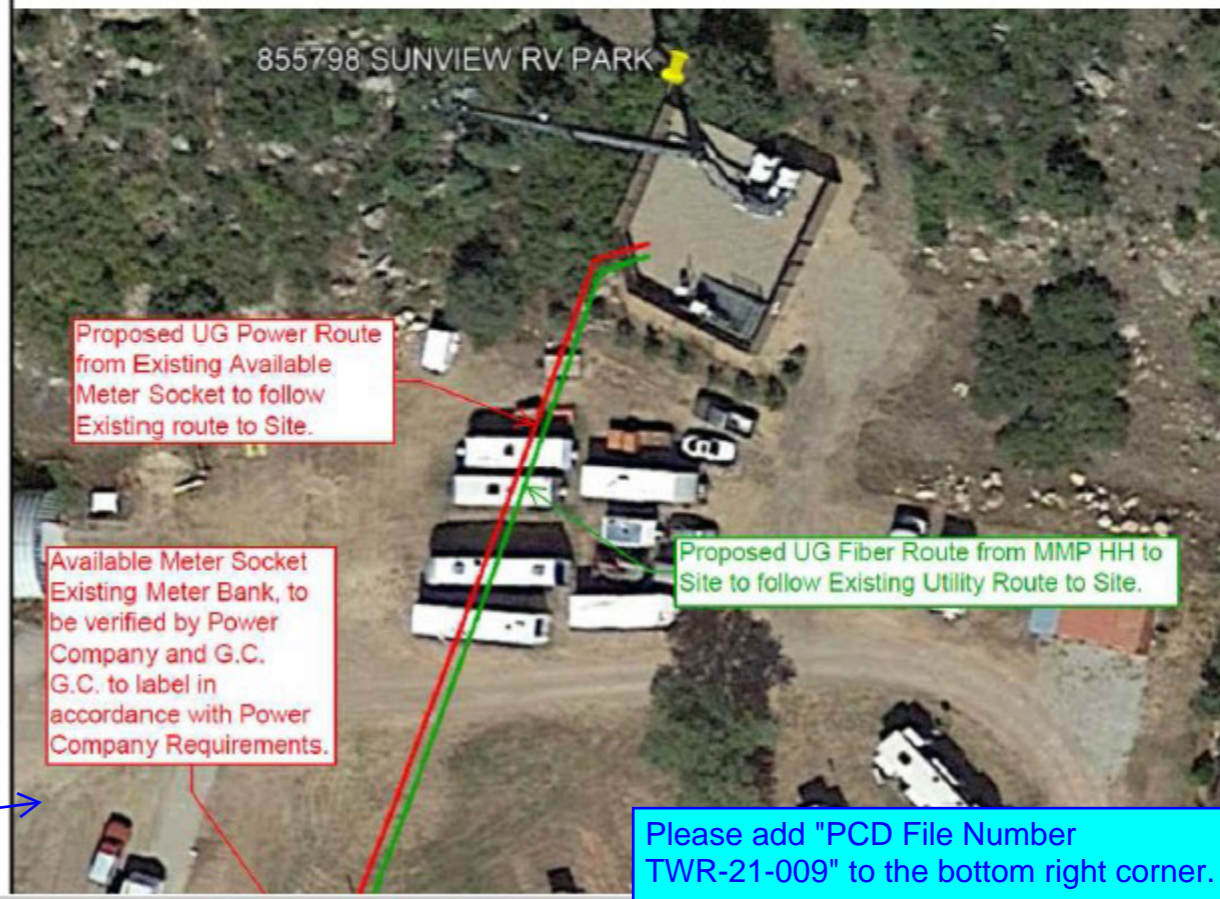

Proposed UG Power Route from Existing Available Meter Socket to follow Existing route to Site.

Available Meter Socket Existing Meter Bank, to be verified by Power Company and G.C. G.C. to label in accordance with Power Company Requirements.

Proposed UG Fiber Route from MMP HH to Site to follow Existing Utility Route to Site.

Please add "PCD File Number TWR-21-009" to the bottom right corner.