



YOW Architects PC

Architecture & Planning

115 S. Weber St. Colorado Springs, CO 80903 719-475-8133

1865 Woodmoor Drive - As Built
Existing Retaining Wall Heights

Sunshine Behavioral Health
1865 Woodmoor Drive
Monument, CO 80132


As-Built
Not For Construction

Drawn By: SP
Checked By: YOW
Issued: 9.19.18
Revised:

As-Built Exg
Retaining Wall Plan

SD1.0

18.195

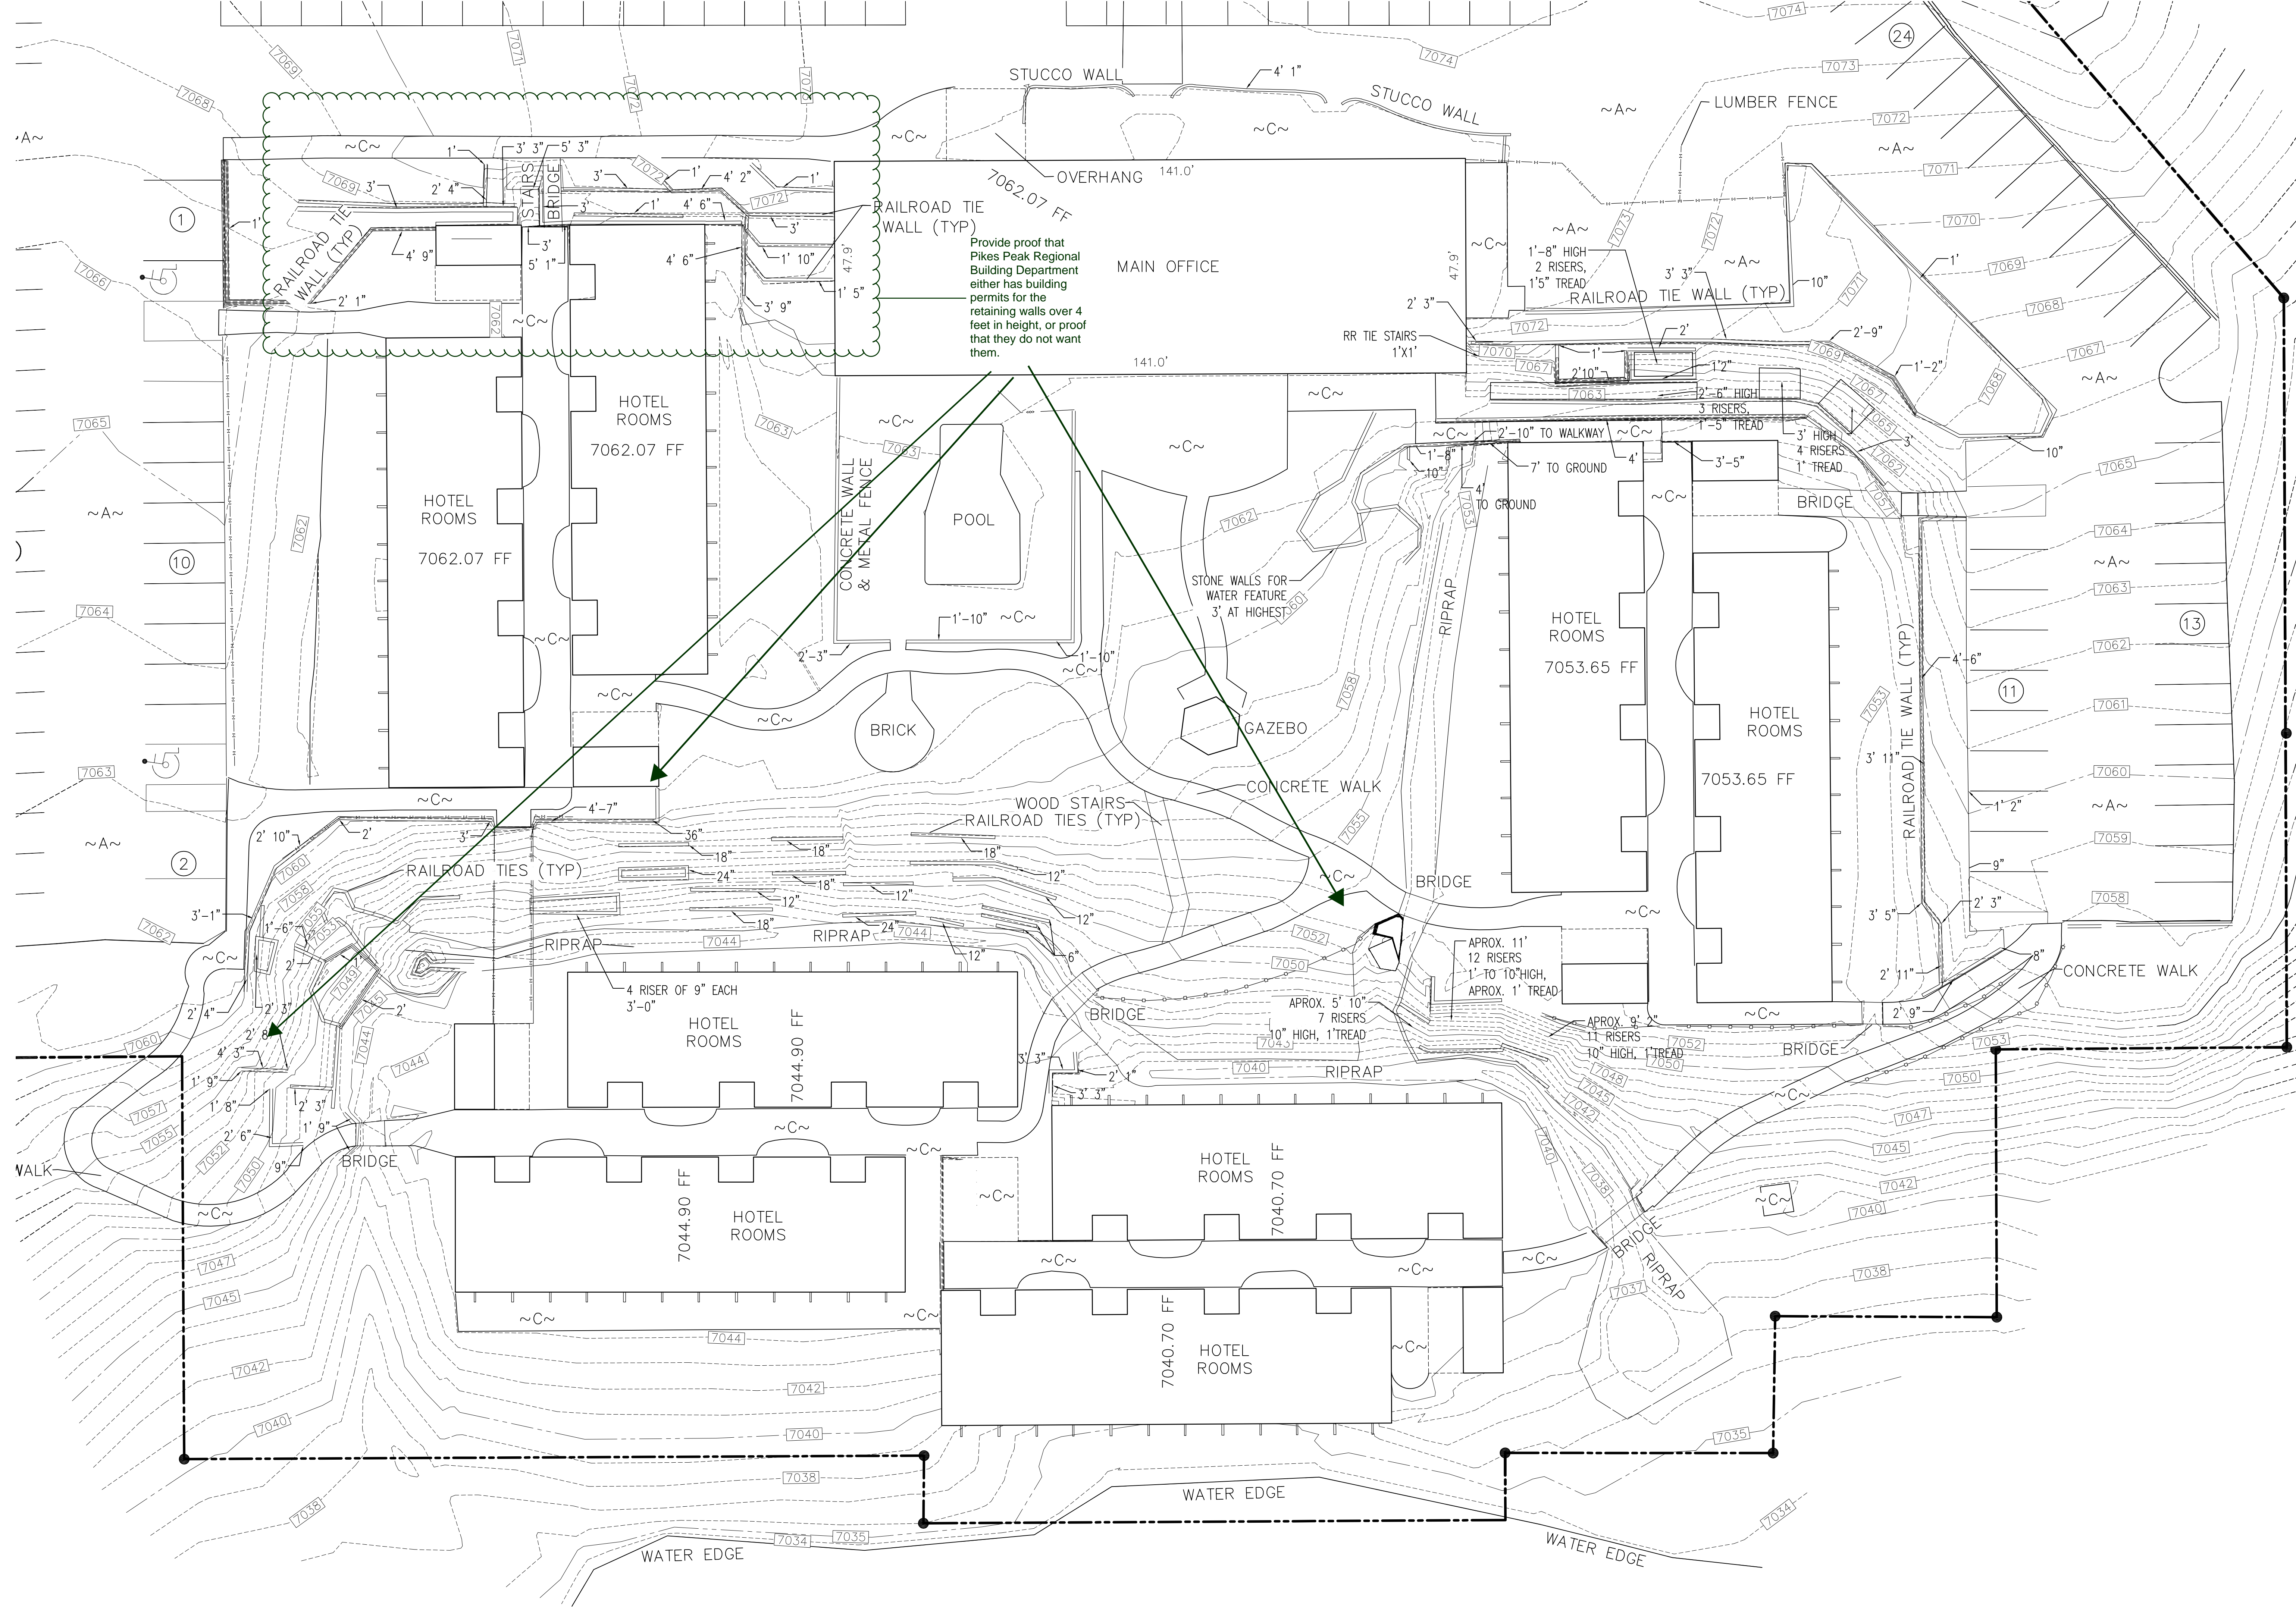


Provide proof that Pikes Peak Regional Building Department either has building permits for the retaining walls over 4 feet in height, or proof that they do not want them.

As Built Existing Retaining Wall Site Plan
Scale: 1/16" = 1'-0"


Markup Summary

dsdkendall (4)

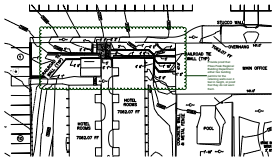


Subject: Cloud+
Page Label: 1
Lock: Unlocked
Author: dsdkendall
Date: 10/17/2018 10:55:55 AM
Color: ■


Provide proof that Pikes Peak Regional Building Department either has building permits for the retaining walls over 4 feet in height, or proof that they do not want them.

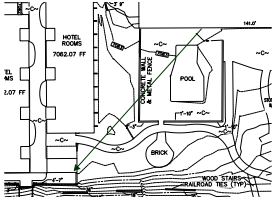

Subject: Arrow
Page Label: 1
Lock: Unlocked
Author: dsdkendall
Date: 10/17/2018 10:59:18 AM
Color: ■

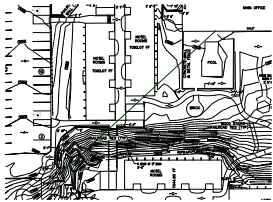

Subject: Arrow
Page Label: 1
Lock: Unlocked
Author: dsdkendall
Date: 10/17/2018 10:59:29 AM
Color: ■

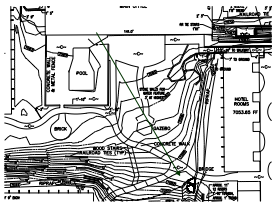

Subject: Arrow
Page Label: 1
Lock: Unlocked
Author: dsdkendall
Date: 10/17/2018 10:59:51 AM
Color: ■