


1865 WOODMOOR DRIVE

TOWN OF MONUMENT, COLORADO

SITE DEVELOPMENT PLAN

Not within the town limits.

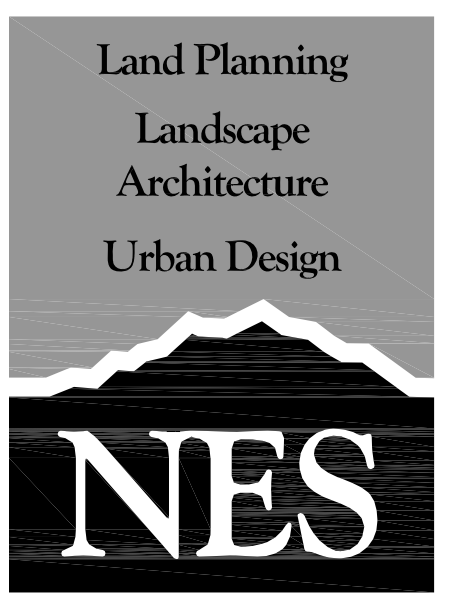

N.E.S. Inc.
619 N. Cascade Avenue, Suite 200
Colorado Springs, CO 80903

Tel. 719.471.0073
Fax 719.471.0267

www.nescolorado.com

© 2012. All Rights Reserved.

OWNER/ APPLICANT

FHAM LLC
30950 RANCHO VIEJO ROAD, SUITE 225
SAN JUAN CAPISTRANO, CA 92675

CONSULTANT

NES INC.
619 N. CASCADE AVENUE, SUITE 200
COLORADO SPRINGS, CO 80903


LEGAL DESCRIPTION

THAT PORTION OF THE NORTHWEST ONE-QUARTER IN SECTION 14, TOWNSHIP 11 SOUTH, RANGE 67 WEST OF THE 6TH PRINCIPAL MERIDIAN, COUNTY OF EL PASO, STATE OF COLORADO, MORE PARTICULARLY DESCRIBED AS FOLLOWS:
BEGINNING AT A POINT FROM WHICH THE NORTHEAST CORNER OF THE NORTHWEST QUARTER OF SAID SECTION 14 BEARS NORTH 21 DEGREES 17 MINUTES 56 SECONDS EAST, A DISTANCE OF 1,161.84 FEET; (ALL BEARINGS IN THIS DESCRIPTION ARE RELATIVE TO THE EAST LINE OF THE NORTHWEST ON-QUARTER OF SECTION 14, WHICH LINE WAS ASSUMED NORTH 00 DEGREES 14 MINUTES 49 SECONDS WEST); THENCE SOUTH 22 DEGREES 29 MINUTES 22 SECONDS EAST 75.00 FEET; THENCE SOUTH 40 DEGREES 29 MINUTES 22 SECONDS EAST 137.61 FEET; THENCE SOUTH 00 DEGREES 11 MINUTES 03 SECONDS EAST 167.25 FEET; THENCE SOUTH 89 DEGREES 48 MINUTES 57 SECONDS WEST 65.00 FEET; THENCE SOUTH 00 DEGREES 11 MINUTES 03 SECONDS EAST 60.00 FEET; THENCE SOUTH 89 DEGREES 48 MINUTES 57 SECONDS WEST 50.00 FEET; THENCE SOUTH 00 DEGREES 11 MINUTES 03 SECONDS EAST 30.00 FEET; THENCE SOUTH 89 DEGREES 48 MINUTES 57 SECONDS WEST 60.00 FEET; THENCE SOUTH 00 DEGREES 11 MINUTES 03 SECONDS EAST 15.00 FEET; THENCE SOUTH 89 DEGREES 48 MINUTES 57 SECONDS WEST 130.00 FEET; THENCE NORTH 00 DEGREES 11 MINUTES 03 SECONDS WEST 15.00 FEET; THENCE SOUTH 89 DEGREES 48 MINUTES 57 SECONDS WEST 165.00 FEET; THENCE NORTH 00 DEGREES 11 MINUTES 03 SECONDS WEST, 90.00 FEET; THENCE SOUTH 89 DEGREES 48 MINUTES 57 SECONDS WEST 50.00 FEET; THENCE NORTH 00 DEGREES 11 MINUTES 03 SECONDS WEST 180.00 FEET; THENCE SOUTH 89 DEGREES 48 MINUTES 57 SECONDS WEST 45.00 FEET TO A POINT OF CURVATURE; THENCE ALONG THE ARC OF A CIRCULAR CURVE TO THE LEFT, HAVING A RADIUS OF 40.00 FEET, A CENTRAL ANGLE OF 90 DEGREES 00 MINUTES 00 SECONDS AND AN ARC DISTANCE OF 62.83 FEET; THENCE SOUTH 00 DEGREES 11 MINUTES 03 SECONDS EAST 40.00 FEET TO A POINT OF CURVATURE; THENCE ALONG THE ARC OF A CIRCULAR CURVE TO THE RIGHT, HAVING A RADIUS OF 70.92 FEET, A CENTRAL ANGLE OF 95 DEGREES 27 MINUTES 16 SECONDS AND AN ARC DISTANCE OF 118.70 FEET TO A POINT OF TANGENCY; THENCE NORTH 84 DEGREES 43 MINUTES 47 SECONDS WEST 57.60 FEET TO INTERSECT THE EASTERLY RIGHT OF WAY LINE OF WOODMOOR DRIVE AS PLATTED IN PLAT BOOK M-2, AT PAGE 26 OF THE RECORDS OF THE EL PASO COUNTY, COLORADO; THENCE NORTHERLY ON THE EASTERLY RIGHT OF WAY LINE OF SAID WOODMOOR DRIVE ALONG THE ARC OF A CIRCULAR CURVE TO THE RIGHT HAVING A RADIUS OF 1000 FEET, A CENTRAL ANGLE OF 2 DEGREES 17 MINUTES 30 SECONDS AND AN ARC DISTANCE OF 40.00 FEET; THENCE SOUTH 84 DEGREES 43 MINUTES 47 SECONDS EAST 57.60 FEET, TO A POINT OF CURVATURE; THENCE ALONG THE ARC OF A CIRCULAR CURVE TO THE LEFT, HAVING A RADIUS OF 30.92 FEET, A CENTRAL ANGLE OF 95 DEGREES 27 MINUTES 16 SECONDS AND AN ARC DISTANCE OF 51.75 FEET, TO A POINT OF TANGENCY; THENCE NORTH 00 DEGREES 11 MINUTES 03 SECONDS WEST 40.00 FEET TO A POINT OF CURVATURE; THENCE ALONG THE ARC OF A CIRCULAR CURVE TO THE RIGHT, HAVING A RADIUS OF 80.00 FEET, A CENTRAL ANGLE OF 90 DEGREES 00 MINUTES 00 SECONDS AND AN ARC DISTANCE OF 125.66 FEET TO A POINT OF TANGENCY; THENCE NORTH 89 DEGREES 48 MINUTES 57 SECONDS EAST 45.00 FEET; THENCE NORTH 00 DEGREES 11 MINUTES 03 SECONDS WEST 140.00 FEET; THENCE NORTH 89 DEGREES 48 MINUTES 57 SECONDS EAST 394.97 FEET; THENCE SOUTH 22 DEGREES 29 MINUTES 22 SECONDS EAST 19.91 FEET TO THE POINT OF BEGINNING, IN EL PASO COUNTY, COLORADO.

(Per Title Commitment File No. 35100-18-10210, with an effective date of June 4, 2018 at 7:30 a.m. as provided by North American Title Insurance Company of Colorado.)

Address of Record: 1865 S. Woomoor Drive, Monument, CO 80132

VICINITY MAP

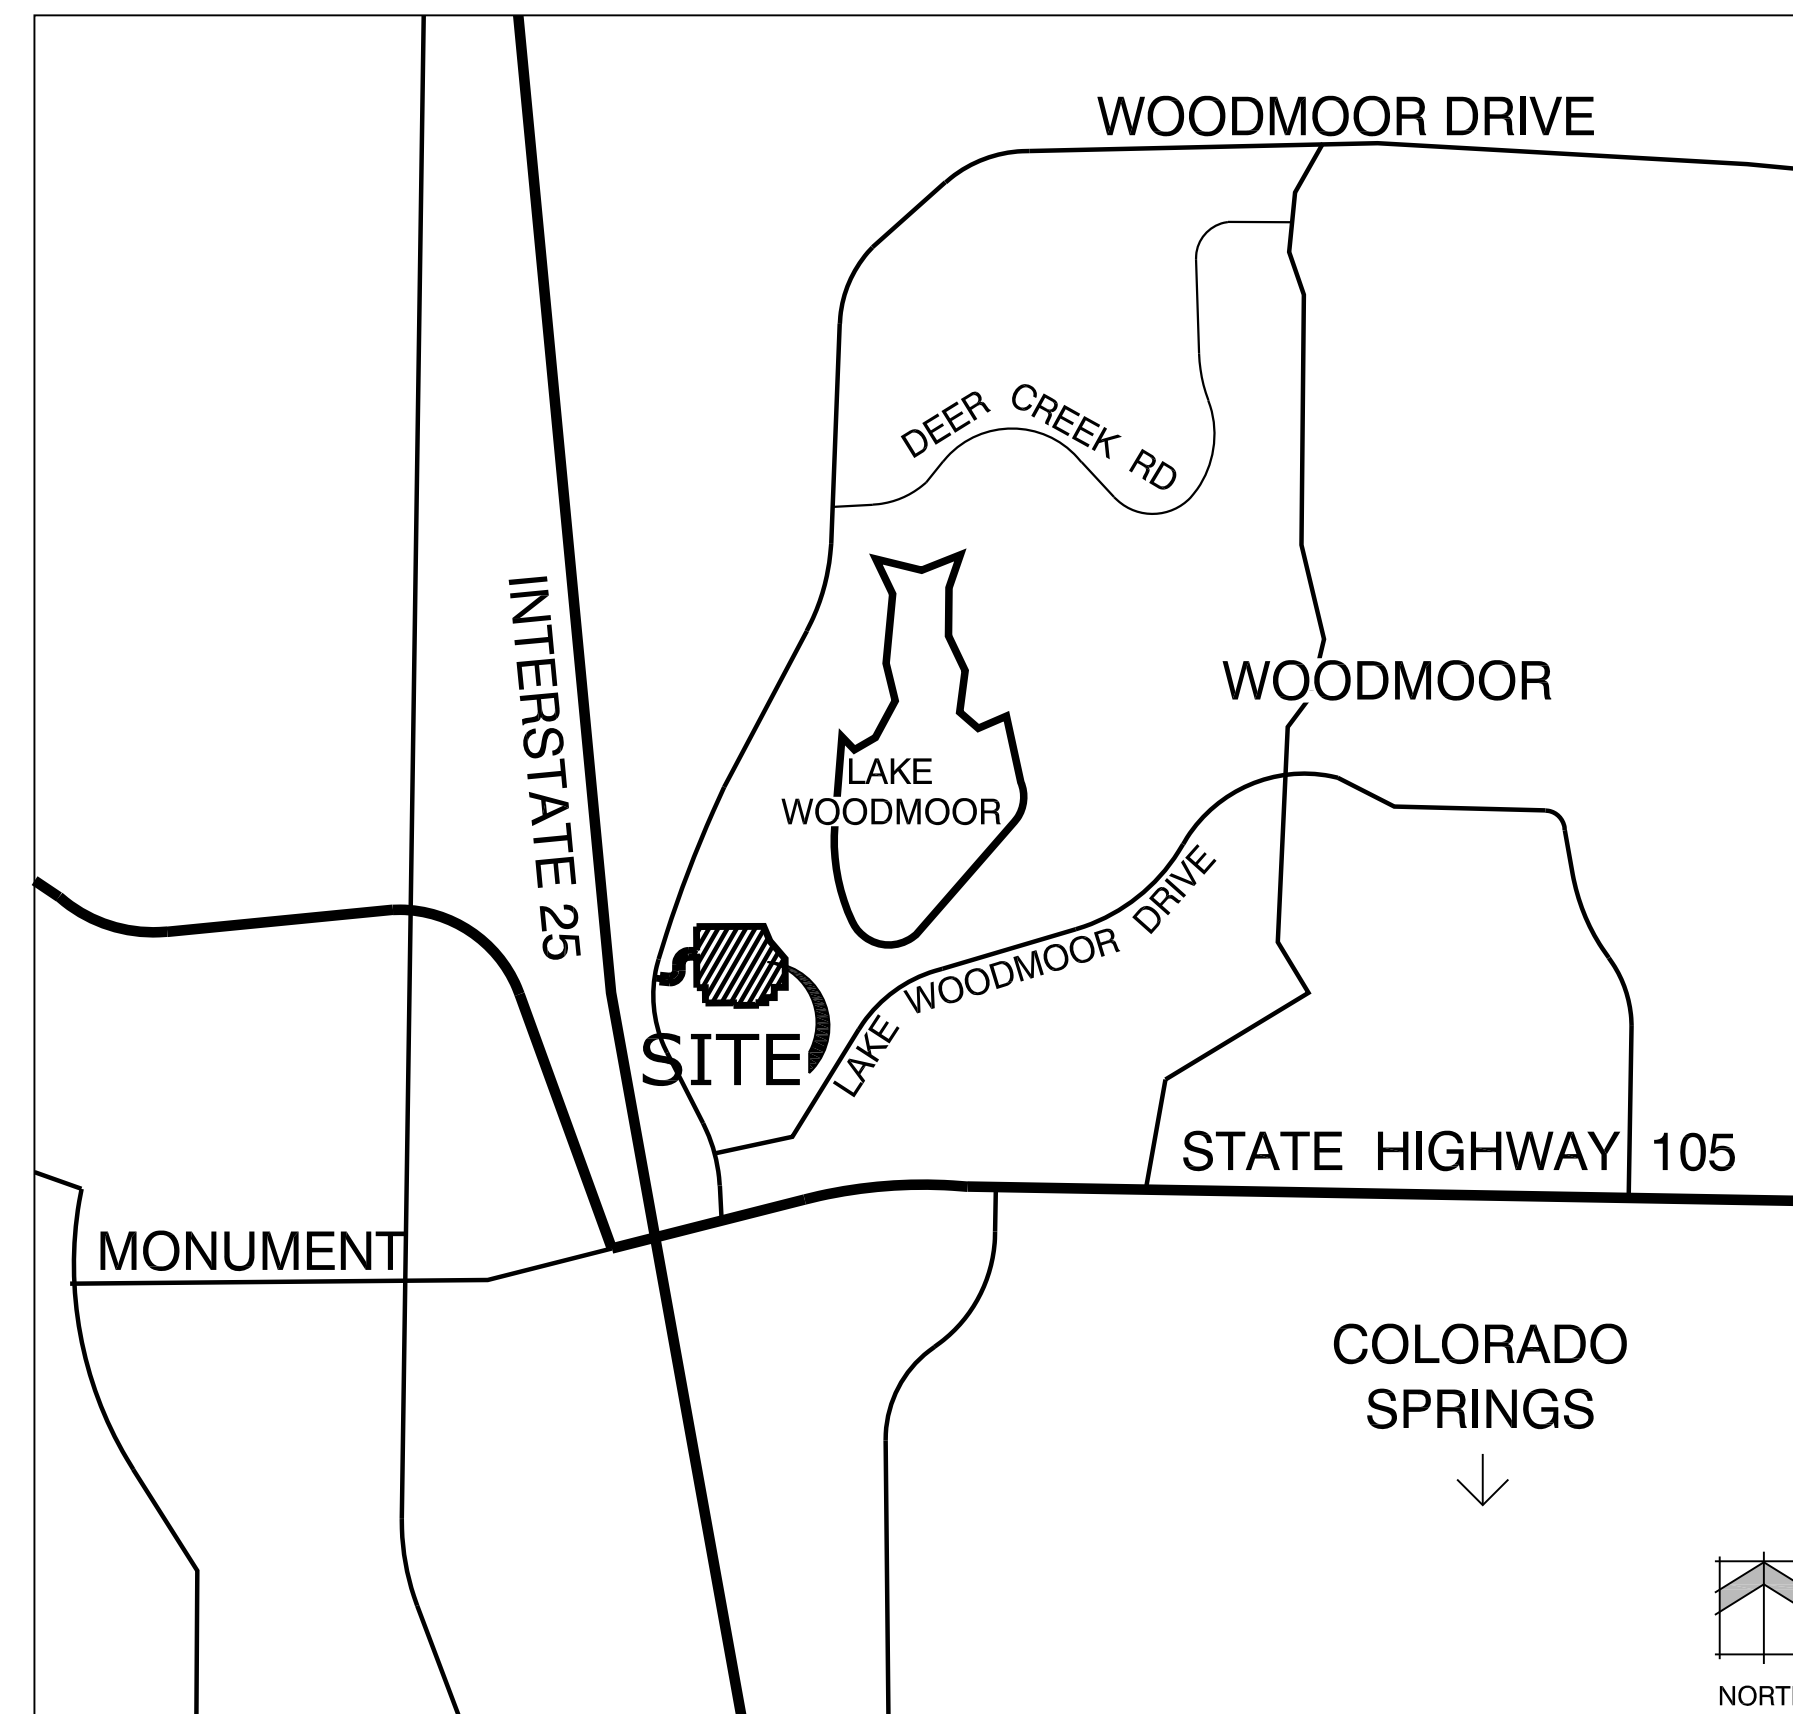

SITE DATA

Tax ID Number:	7114200020
Total Site Area:	5.12 Acres (222,838 Square Feet)
Current Zoning:	C-2
Development Schedule:	Fall 2018
Existing Building Use:	Hotel
Proposed Building Use:	Rehabilitation Facility
Maximum Building Height:	50 FT
Existing Building Height:	33 FT
Building Setbacks:	
-Front (Woodmoor Drive):	15 FT
-Rear (East Boundary):	20 FT
-Side (North & South Boundary):	5 FT
Lot Coverage:	
-Building:	30,782 SF (14%)
-Impervious:	121,518 SF (54%)
-Landscape:	70,538 SF (32%)
Required Parking:	Nursing Home*: 1 Space/ 5 Beds 150 Total Beds 30 Required Parking Spaces *Per Section 6.2.5.D.ii
Existing Parking:	220 Parking Spaces 6 ADA Accessible Parking Spaces 226 Total
Proposed Parking:	193 Parking Spaces 7 ADA Accessible Parking Spaces 200 Total

GENERAL NOTES

- The Federal Emergency Management Agency, Flood Insurance Rate Map No. 08041C002767F, effective date March 17, 1997, indicates this parcel of land to be located in Zone X (Areas determined outside the 500-year floodplain).
- The parties responsible for this plan have familiarized themselves with all current accessibility criteria and specifications and the proposed plan reflects all site elements required by the applicable ADA design standards and guidelines as published by the United States Department of Justice. Approval of this plan by El Paso County does not assure compliance with the ADA or any regulations or guidelines enacted or promulgated under or with respect to such laws.
- The existing ADA accessible parking spaces are to be restriped for compliance with the ADA design standards.
- The existing hotel sign located near Woodmoor Drive is to be removed.
- Site survey completed by Barron Land on June 20, 2018.
- The parking lot is asphalt. All walkways are concrete, except where noted on plan.

SHEET INDEX

Sheet 1 of 6:	Cover Sheet
Sheet 2 of 6:	Site Development Plan
Sheet 3 of 6:	Landscape Plan
Sheet 4 of 6:	Landscape Notes & Details
Sheet 5 of 6:	Photometric Plan
Sheet 6 of 6:	Photometric Plan

1865 WOODMOOR DRIVE

MONUMENT COLORADO

DATE: 7-6-2018
PROJECT MGR: KW
PREPARED BY: KW

DATE:	BY:	DESCRIPTION:
9-12-18	KW	Revised Per County Comments

SITE DEVELOPMENT PLAN COVER SHEET

1


1 OF 6

PPR1830

1865 WOODMOOR DRIVE


TOWN OF MONUMENT, COLORADO

SITE DEVELOPMENT PLAN

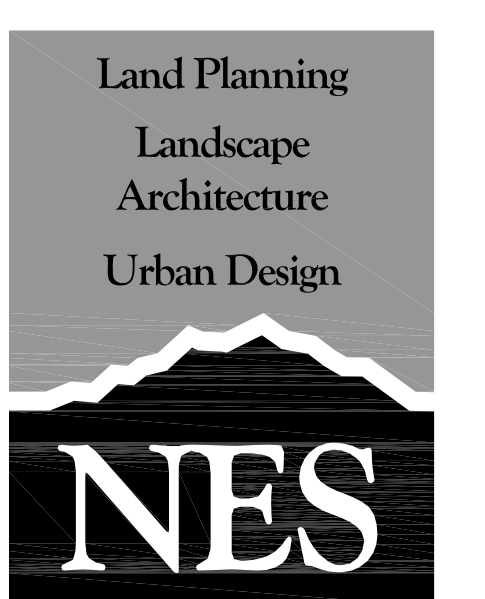

N.E.S. Inc.
619 N. Cascade Avenue, Suite 200
Colorado Springs, CO 80903
Tel. 719.471.0073
Fax 719.471.0267
www.nescolorado.com
© 2012. All Rights Reserved.

P:\Sunshine Behavioral Health\1865 Woodmoor Drive\Drawings\Planning\Develop\1865WoodmoorDrive_SiteDevelopmentPlan_2-22-18.dwg [Site Development Plan] 10/17/2018 3:42:17 PM kwhitford

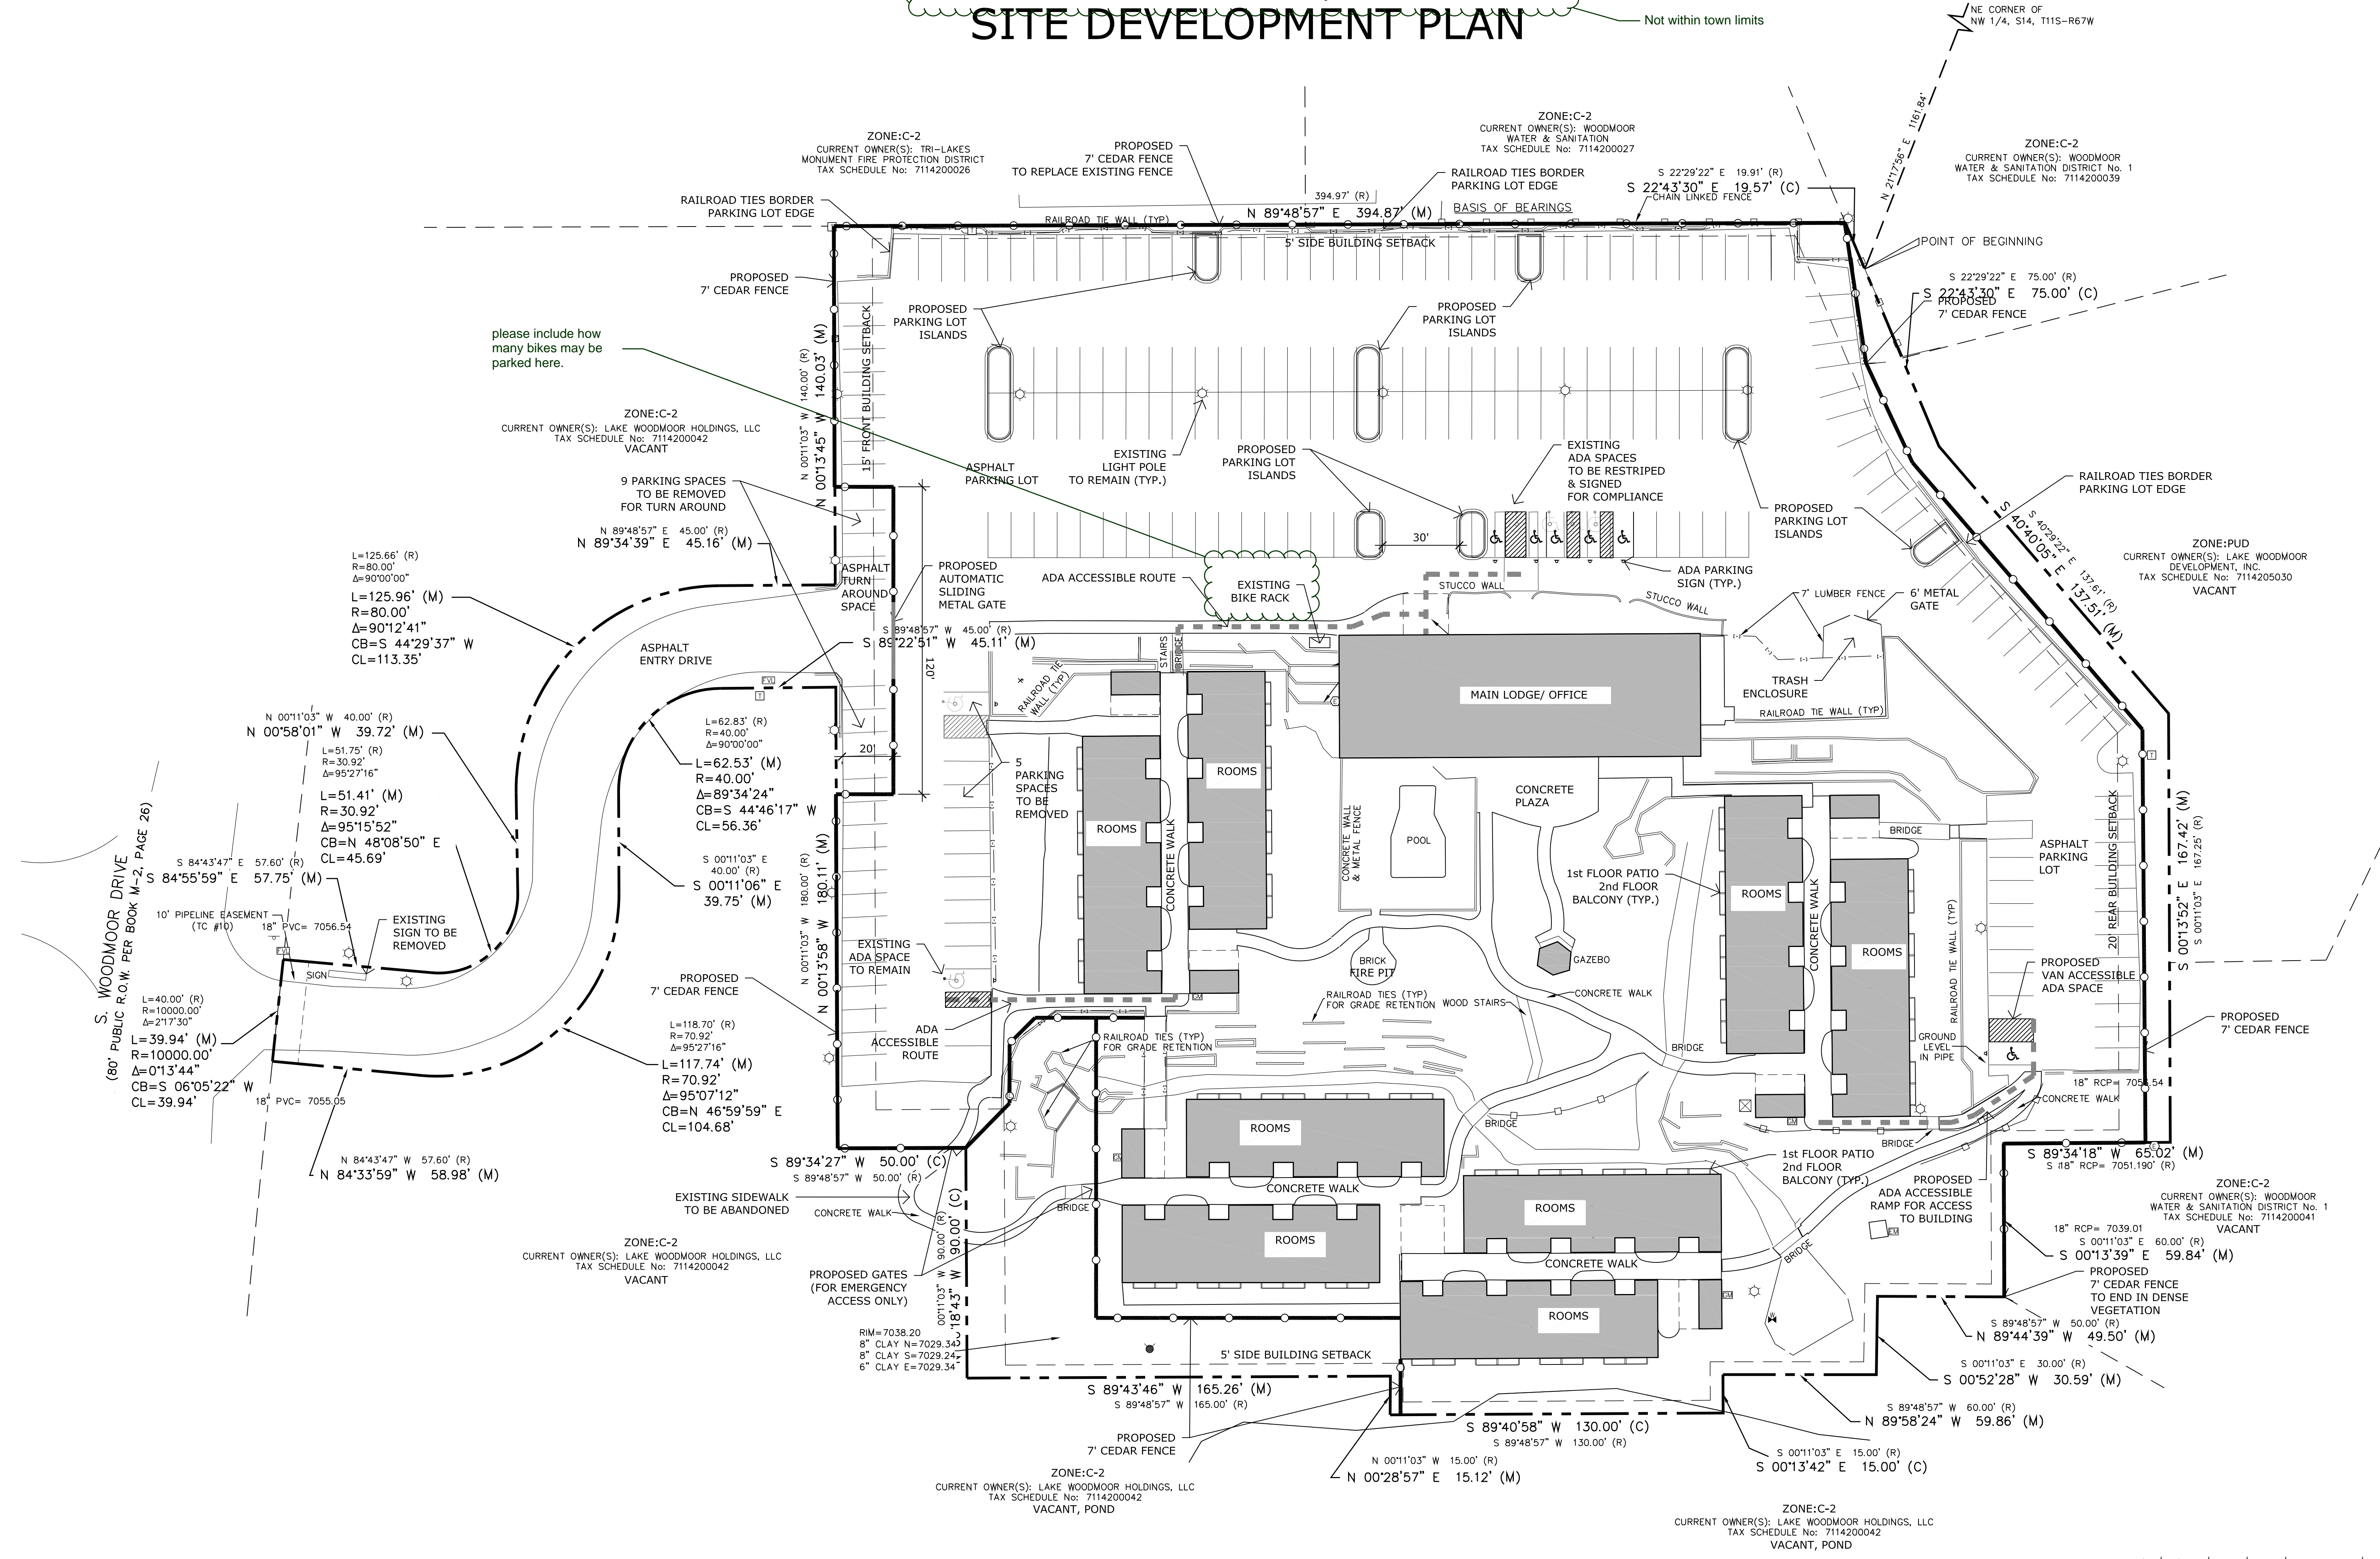

1865 WOODMOOR DRIVE

MONUMENT COLORADO

DATE: 7-6-2018
PROJECT MGR: KW
PREPARED BY: KW


DATE:	BY:	DESCRIPTION:
9-12-18	KW	Revised Per County Comments

SITE DEVELOPMENT PLAN

2


2 OF 6

PPR1830

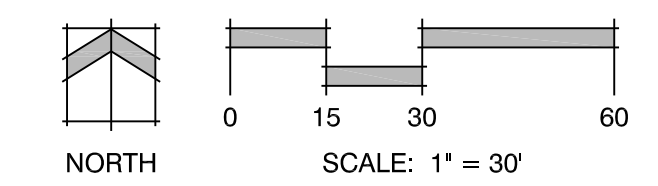


Markup Summary

dsdruiz (3)

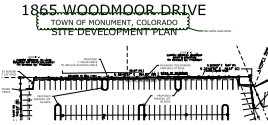

Subject: Cloud+
Page Label: 2
Lock: Unlocked
Author: dsdruiz
Date: 10/16/2018 4:16:44 PM
Color: ■

Not within town limits

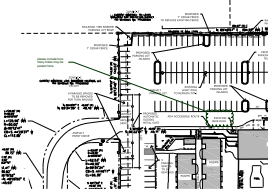

Subject: Cloud+
Page Label: 2
Lock: Unlocked
Author: dsdruiz
Date: 10/16/2018 4:18:22 PM
Color: ■

please include how many bikes may be parked here.

1865 WOODMOOR DRIVE
TOWN OF MONUMENT, COLORADO
SITE DEVELOPMENT PLAN



Subject: Cloud+
Page Label: 1
Lock: Unlocked
Author: dsdruiz
Date: 10/16/2018 4:19:34 PM
Color: ■

Not within the town limits.