



YOW Architects PC

Architecture & Planning

115 S. Weber St. Colorado Springs, CO 80903 719-475-8133

1865 Woodmoor Drive - As Built
Existing Retaining Wall Heights

Sunshine Behavioral Health
1865 Woodmoor Drive
Monument, CO 80132


As-Built
Not For Construction

Drawn By: SP
Checked By: YOW
Issued: 9.19.18
Revised:

As-Built Exg
Retaining Wall Plan

SD1.0

18.195

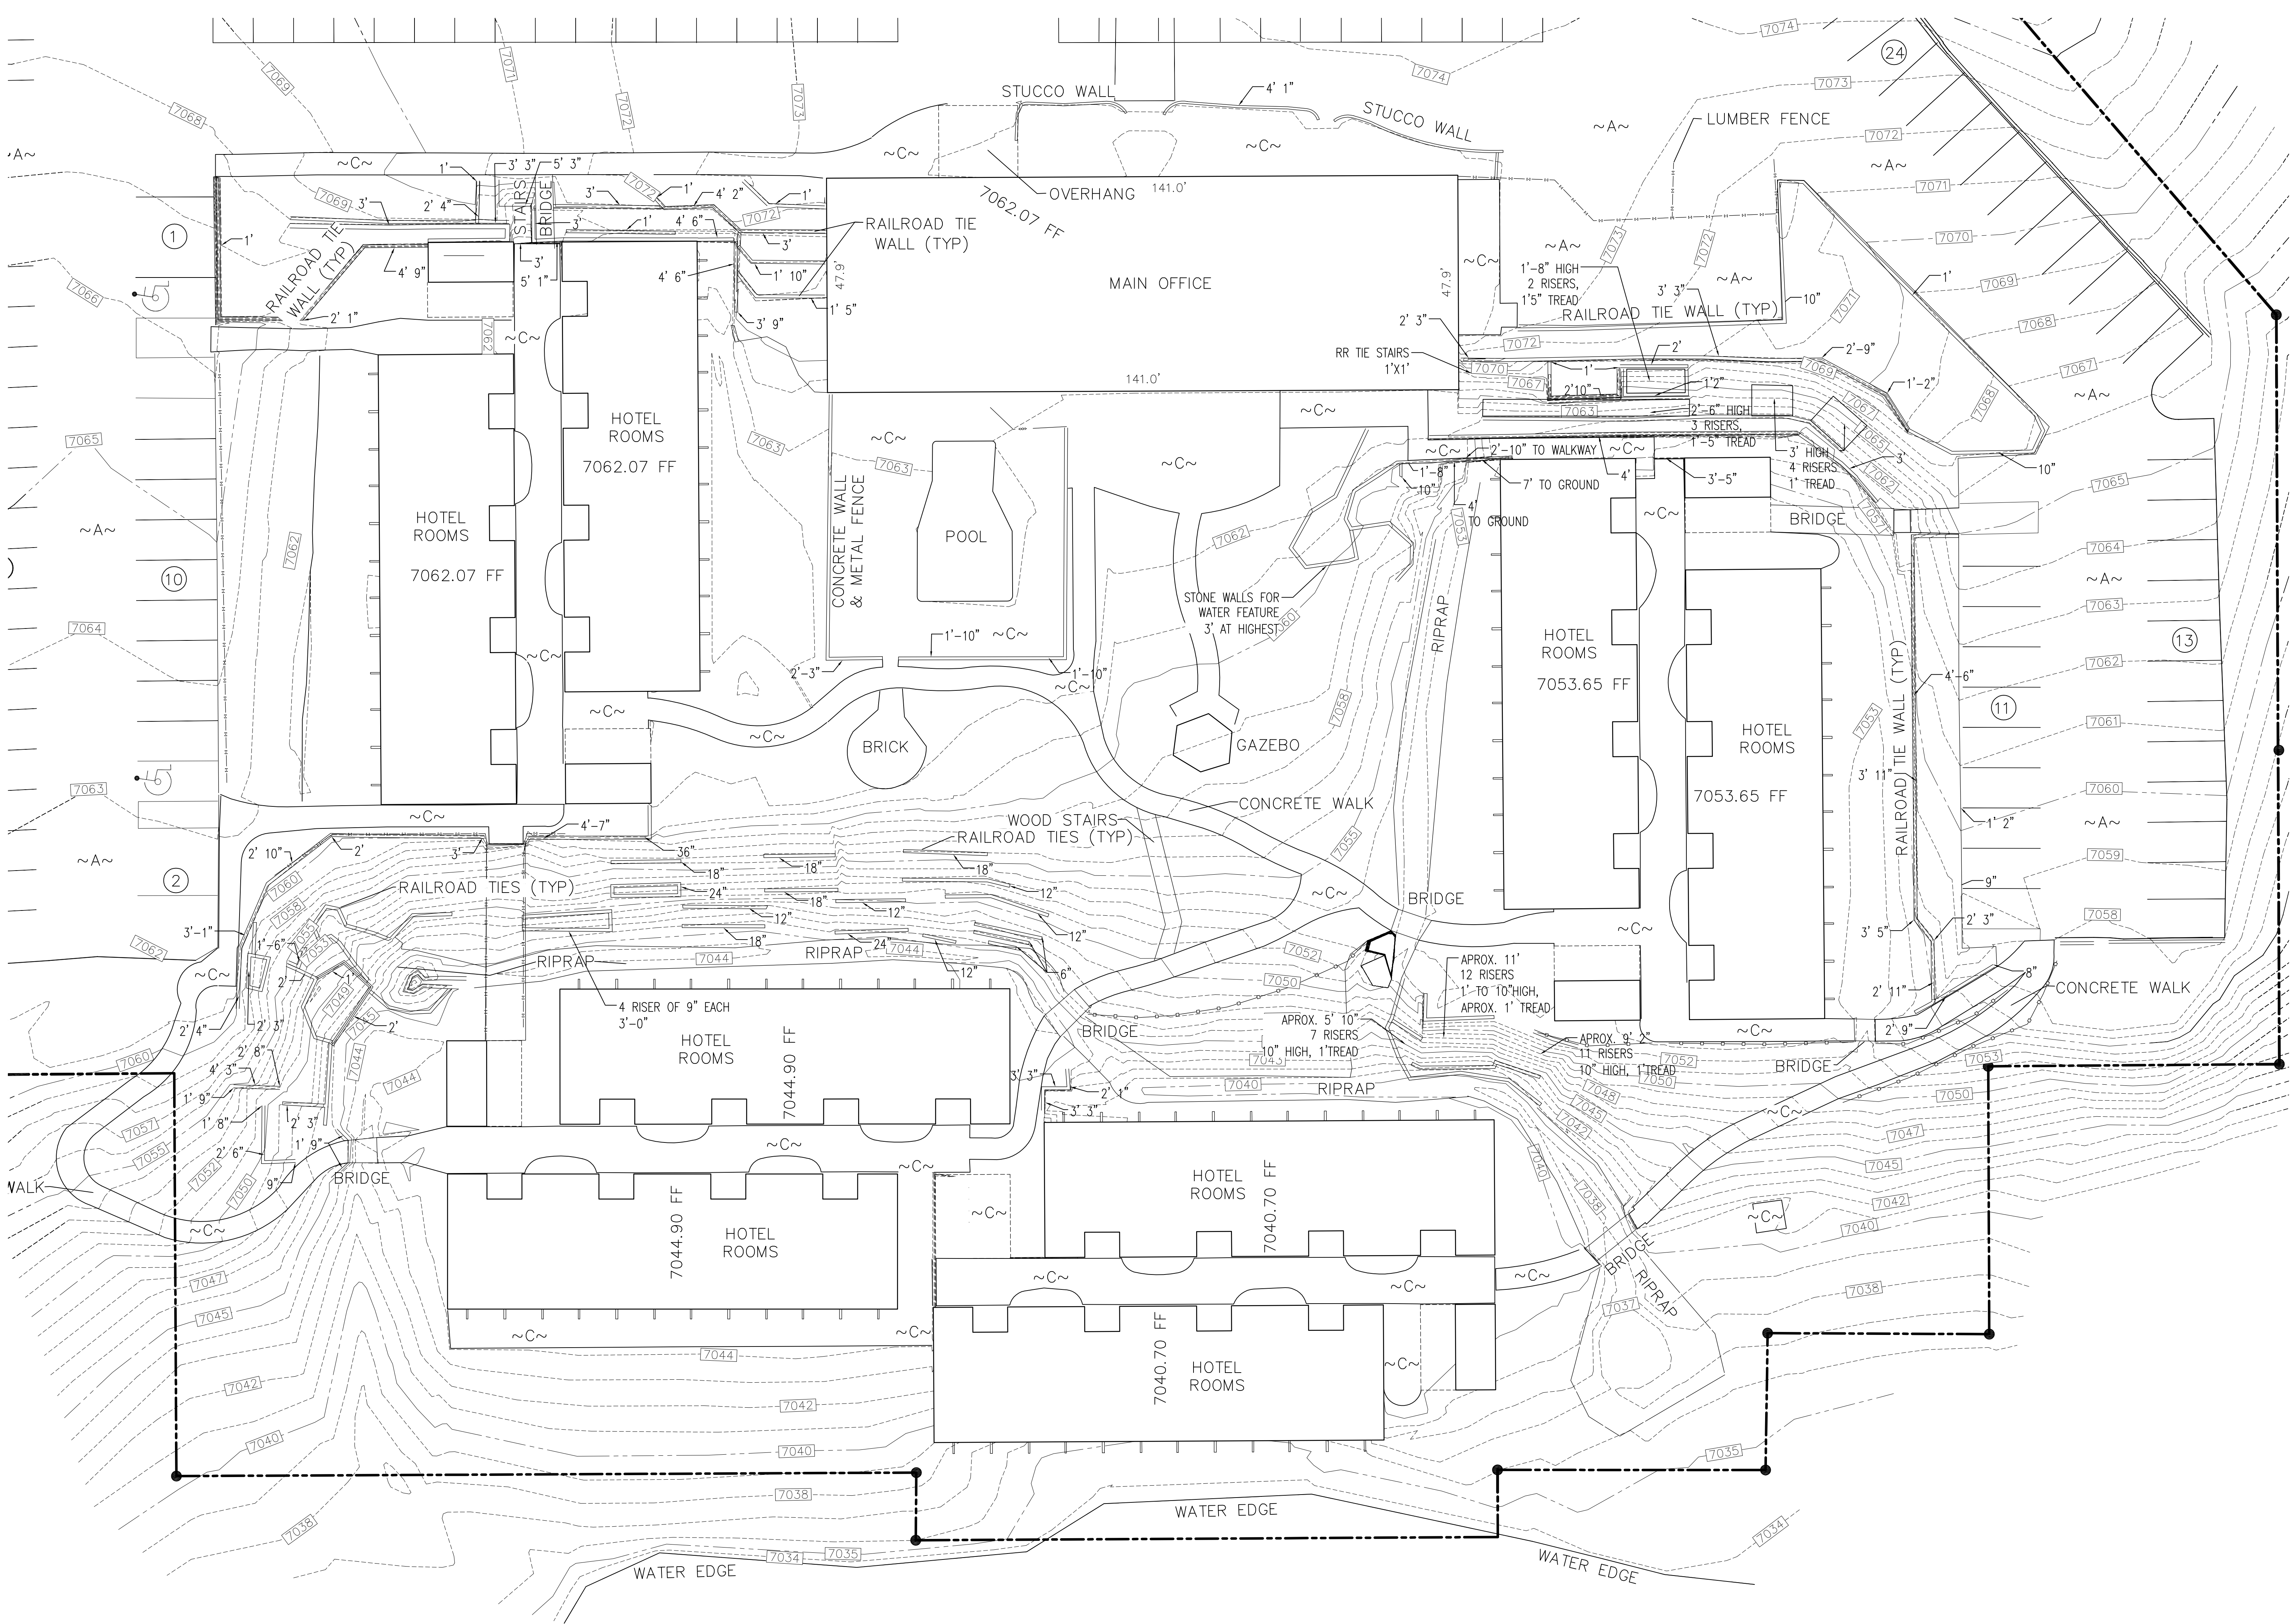

As Built Existing Retaining Wall Site Plan

Scale: 1/16" = 1'-0"

1