



**1865  
WOODMOOR  
DRIVE  
MONUMENT  
COLORADO**

DATE: 7-6-2018  
PROJECT MGR: TM  
PREPARED BY: TM


SEAL

DATE: BY: DESCRIPTION:  
9-12-18 TM Revised Per County Comments

ISSUE REVISION


SITE TITLE

**E-1**  
5 OF 6

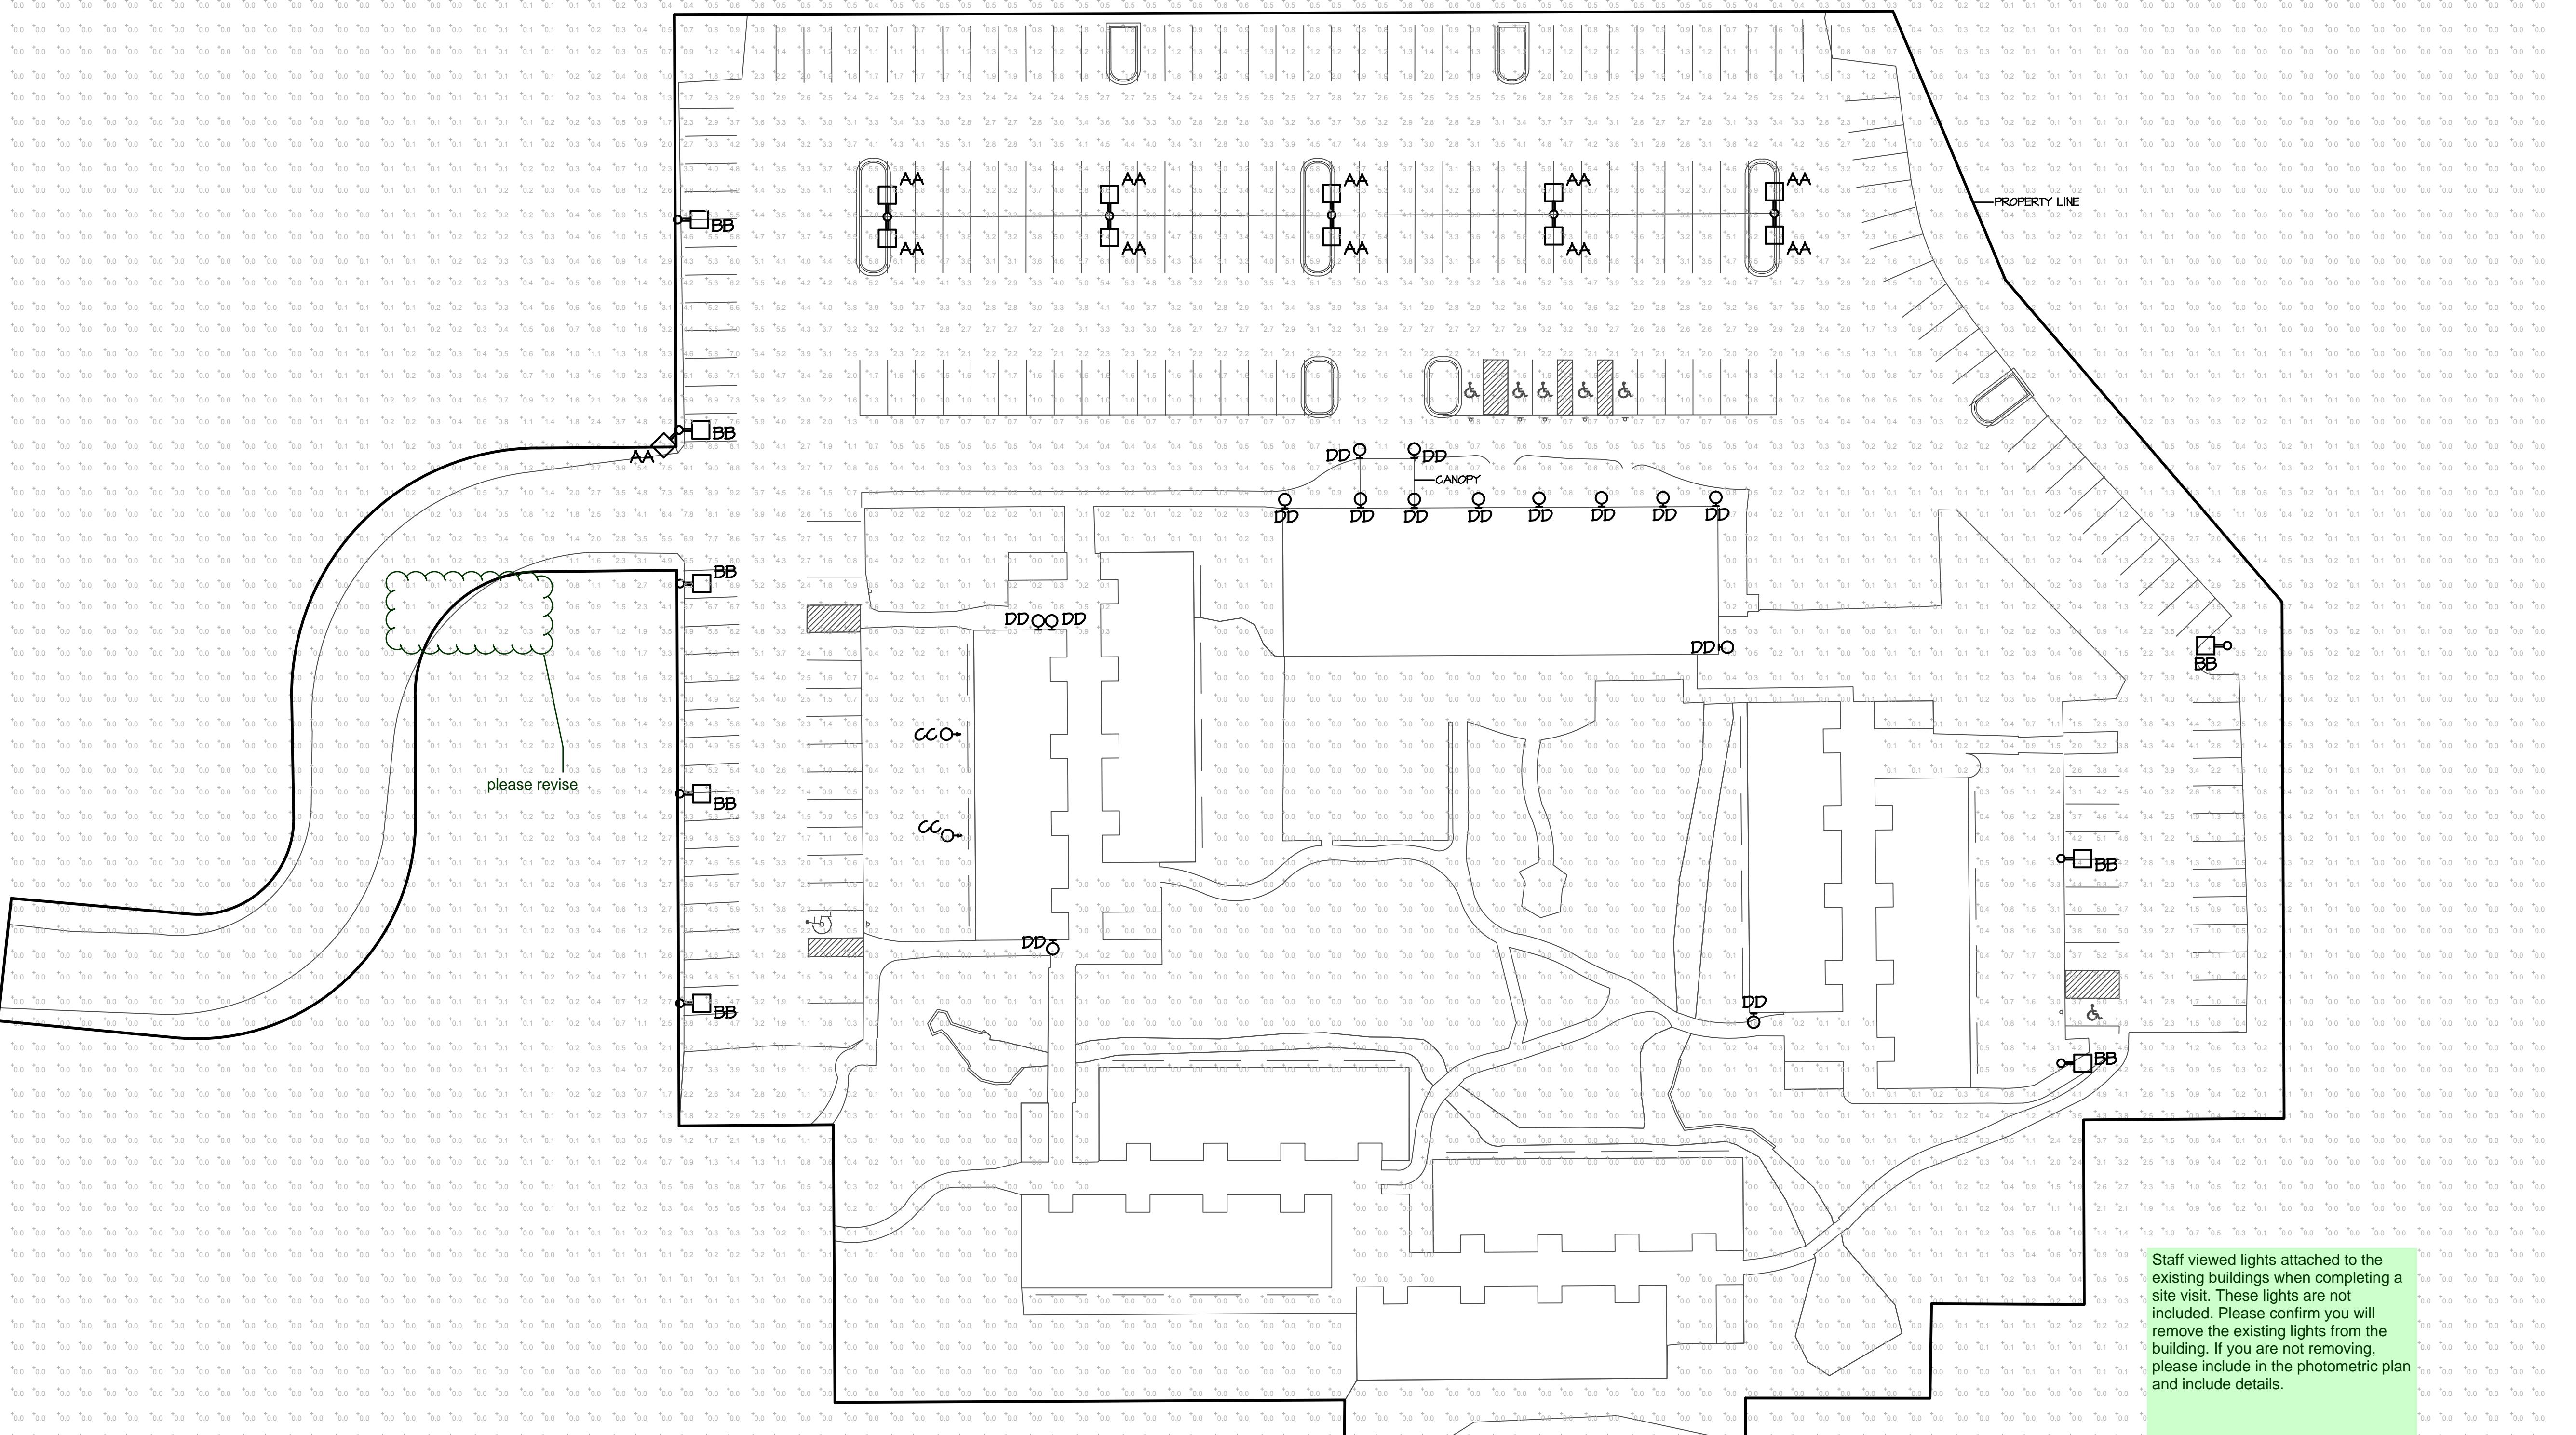

PROJECT INFO	DATE: 7-6-2018 PROJECT MGR: TM PREPARED BY: TM
ISSUE INFO	DATE: BY: DESCRIPTION: 9-12-18 TM Revised Per County Comments
ISSUE REVISION	
SHEET NUMBER	<b>E-1</b> 5 OF 6
FILE #	PPR1830


LIGHTING FIXTURE SCHEDULE												
ID	MANUFACTURER	MODEL	CATALOG NUMBER	LUMINAIRE				LAMPS				
				DESCRIPTION	VOLTAGE	DIMMING	MOUNTING	QTY.	TYPE	WATTS	LUMENS	COLOR TEMP/CRI
AA	ILP	AREA LIGHT	AL-140LED-UNIV-40-T4-BDSOPC	PARKING LOT AREA LIGHTING FIXTURE, UNIVERSAL VOLTAGE (120-277V) DRIVER, TYPE 4 DISTRIBUTION, INTEGRAL 50% STEP DIMMING PHOTOCELL FOR LIGHT REDUCTION CONTROL	120-277	Y	POLE (25'-0" AF6)	1	LED	140	16042	4000/10
BB	ILP	AREA LIGHT	AL-140LED-UNIV-40-T3-BDSOPC	SIMILAR TO TYPE "AA" EXCEPT TYPE 3 DISTRIBUTION	120-277	Y	POLE (25'-0" AF6)	1	LED	140	16123	4000/10
CC	ILP	LARGE FLOOD	FLL-85WLED-UNIV-40	GRADE MOUNTED DIRECTIONAL FLOOD LIGHT, UNIVERSAL VOLTAGE (120-277V) DRIVER	120-277	N	GRADE MOUNT	1	LED	85	10240	4000/80
DD	--	--	--	EXISTING WALL MOUNTED DECORATIVE ARCHITECTURAL SCONE WITH MEDIUM BASE INCANDESCENT LAMP	120	N	WALL MOUNT	1	INCAND	20	--	--

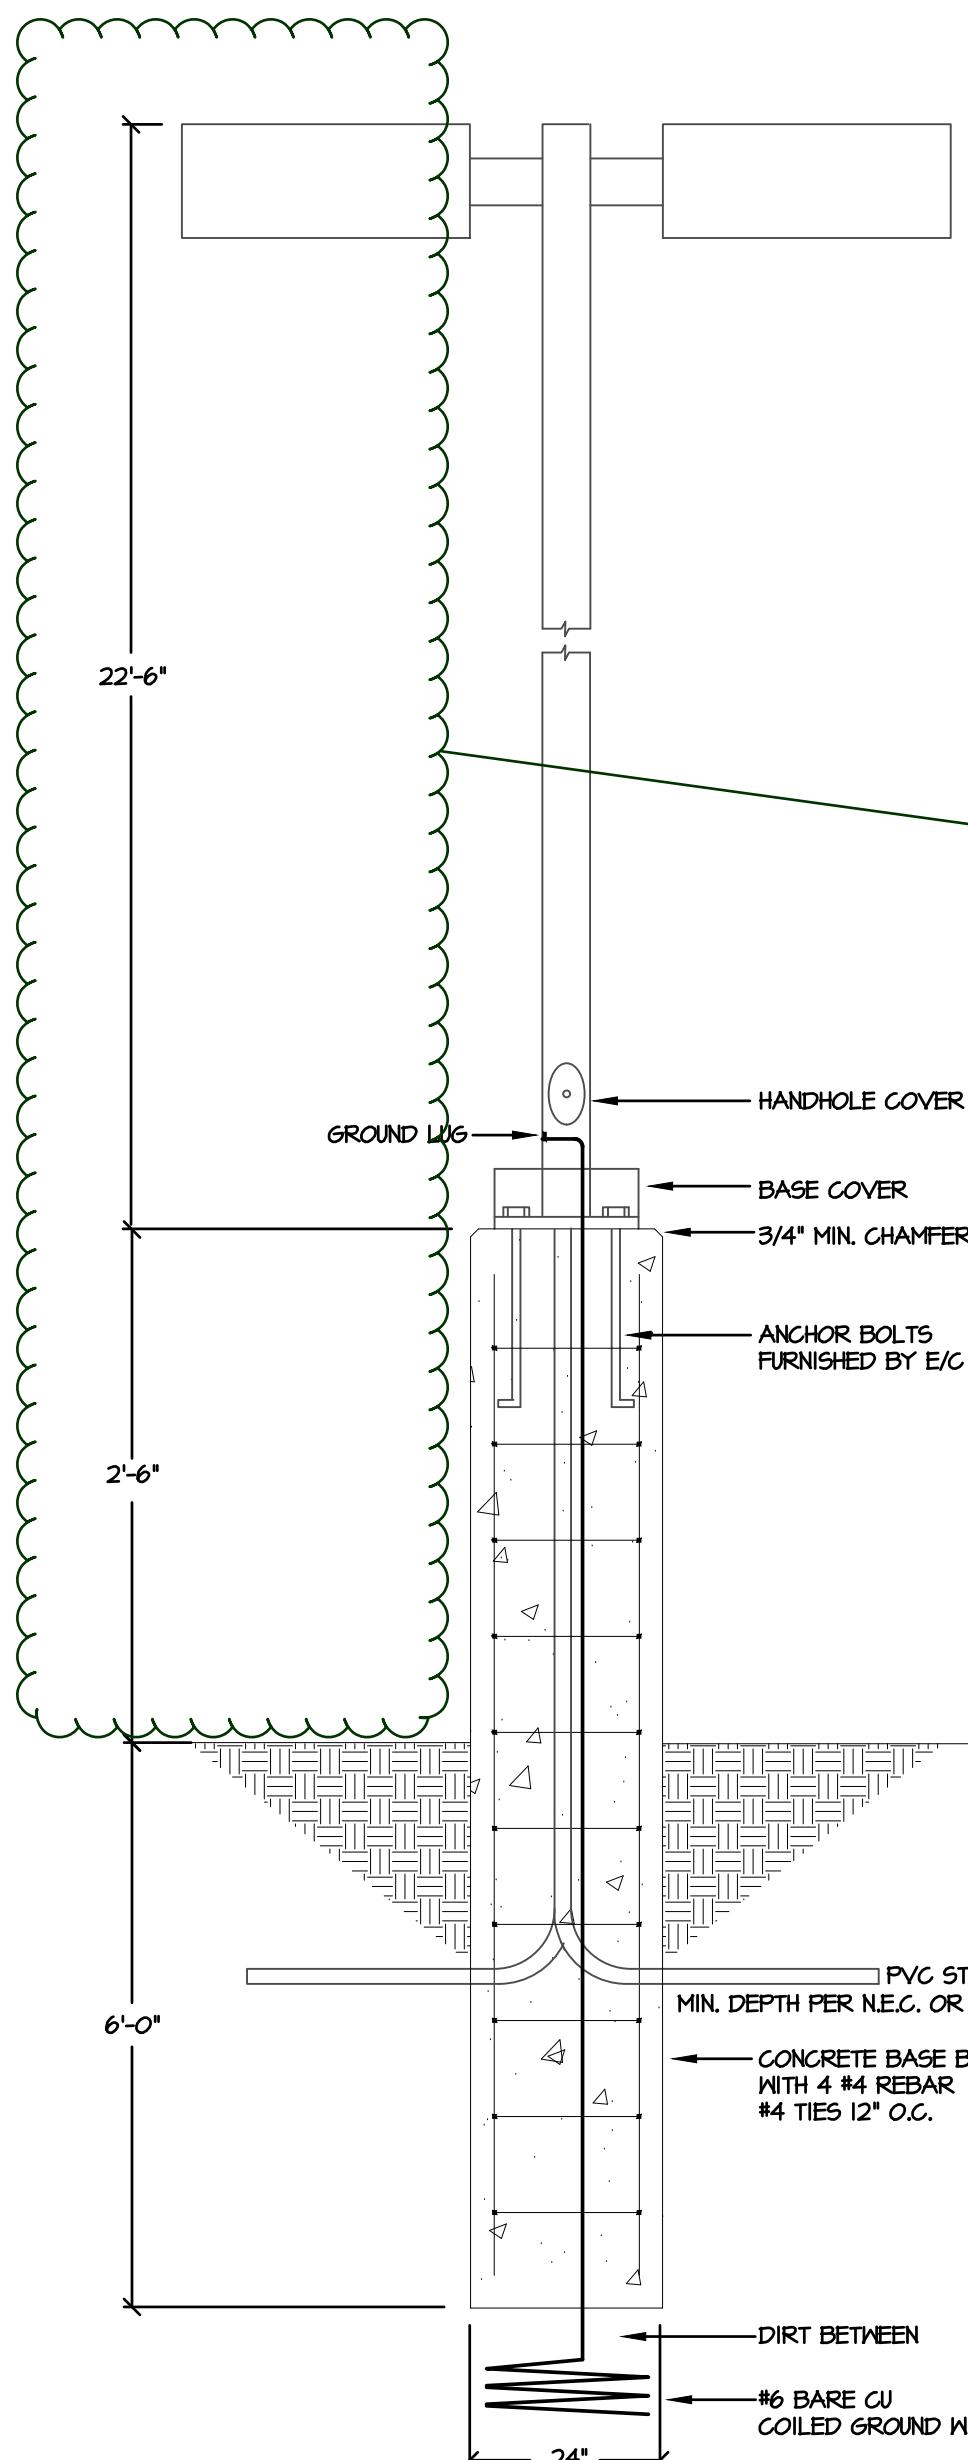

**POLE BASE DIAGRAM**  
NOT TO SCALE



**Fixture Type DD (existing)**  
SCALE: NONE

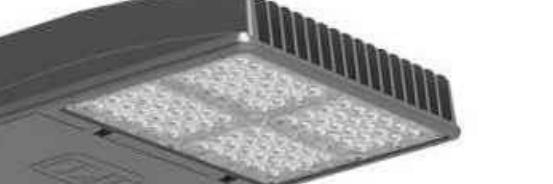Project Name:	Part Number:	Type:																																																																																										
<b>AREA LIGHT - 140W LED</b>																																																																																												
OUTDOOR																																																																																												
<b>FEATURES</b> <ul style="list-style-type: none"> <li>Steek low profile die cast aluminum bronze housing (std. &amp; in stock)</li> <li>Multiple housing color options (see third page)</li> <li>Custom color options available (call factory for pricing)</li> <li>Type II, III, IV, &amp; V optics available</li> <li>Tool less access drop down driver access</li> <li>Universal Pole Mounting Bracket available (UPMB)</li> <li>Swappable driver cover</li> <li>IP66 Rated</li> <li>3000K, 4000K, &amp; 5000K color options</li> <li>0-10V Dimmable Driver</li> <li>Dark Sky Compliant<sup>1,2</sup></li> <li>5 year warranty</li> <li>DesignLights Consortium® Qualified Luminaire</li> <li><sup>1</sup>Must select 3000K to qualify</li> <li><sup>2</sup>Must select UPMB, ARMS, or HTMA mounting options to qualify</li> </ul>																																																																																												
 407-478-3759 <a href="http://www.ilp-inc.com">www.ilp-inc.com</a>																																																																																												
																																																																																												
<b>SUITABLE APPLICATIONS</b> <ul style="list-style-type: none"> <li>Parking Lots</li> <li>Car Dealerships</li> <li>Roadways</li> <li>Shopping Centers</li> </ul>																																																																																												
<b>LED SYSTEMS INFO</b> <table border="1"> <tr> <td>Calculated L<sub>70</sub> (TM-21)</td> <td>T2</td> <td>T3</td> <td>T4</td> <td>T55</td> <td>T2</td> <td>T3</td> <td>T4</td> <td>T55</td> </tr> <tr> <td><b>4000K</b></td> <td>&gt;100K</td> <td>&gt;100K</td> <td>&gt;100K</td> <td>&gt;100K</td> <td>&gt;100K</td> <td>&gt;100K</td> <td>&gt;100K</td> <td>&gt;100K</td> </tr> <tr> <td>Total Input Watts</td> <td>15,122 lm</td> <td>16,123 lm</td> <td>16,042 lm</td> <td>16,607 lm</td> <td>15,510 lm</td> <td>16,537 lm</td> <td>16,453 lm</td> <td>17,033 lm</td> </tr> <tr> <td>Luminare Efficacy Rating (LER)</td> <td>138 W</td> </tr> <tr> <td>Correlated Color Temperature (CCT)</td> <td>110 lm/W</td> <td>117 lm/W</td> <td>117 lm/W</td> <td>121 lm/W</td> <td>113 lm/W</td> <td>120 lm/W</td> <td>120 lm/W</td> <td>124 lm/W</td> </tr> <tr> <td>Color Rendering Index (CRI)</td> <td>4000K</td> <td>4000K</td> <td>4000K</td> <td>4000K</td> <td>5000K</td> <td>5000K</td> <td>5000K</td> <td>5000K</td> </tr> <tr> <td>BUG Rating</td> <td>&gt;70</td> <td>&gt;70</td> <td>&gt;70</td> <td>&gt;70</td> <td>&gt;70</td> <td>&gt;70</td> <td>&gt;70</td> <td>&gt;70</td> </tr> <tr> <td>Ambient Temperature Range</td> <td>B3-U0-G3</td> <td>B3-U0-G3</td> <td>B3-U0-G3</td> <td>B4-U0-G2</td> <td>B3-U0-G3</td> <td>B3-U0-G3</td> <td>B3-U0-G3</td> <td>B4-U0-G2</td> </tr> <tr> <td>Universal Driver</td> <td>-40 F - 115 F</td> </tr> <tr> <td></td> <td>120-277 V</td> </tr> </table>			Calculated L <sub>70</sub> (TM-21)	T2	T3	T4	T55	T2	T3	T4	T55	<b>4000K</b>	>100K	Total Input Watts	15,122 lm	16,123 lm	16,042 lm	16,607 lm	15,510 lm	16,537 lm	16,453 lm	17,033 lm	Luminare Efficacy Rating (LER)	138 W	Correlated Color Temperature (CCT)	110 lm/W	117 lm/W	117 lm/W	121 lm/W	113 lm/W	120 lm/W	120 lm/W	124 lm/W	Color Rendering Index (CRI)	4000K	4000K	4000K	4000K	5000K	5000K	5000K	5000K	BUG Rating	>70	>70	>70	>70	>70	>70	>70	>70	Ambient Temperature Range	B3-U0-G3	B3-U0-G3	B3-U0-G3	B4-U0-G2	B3-U0-G3	B3-U0-G3	B3-U0-G3	B4-U0-G2	Universal Driver	-40 F - 115 F		120-277 V																												
Calculated L <sub>70</sub> (TM-21)	T2	T3	T4	T55	T2	T3	T4	T55																																																																																				
<b>4000K</b>	>100K	>100K	>100K	>100K	>100K	>100K	>100K	>100K																																																																																				
Total Input Watts	15,122 lm	16,123 lm	16,042 lm	16,607 lm	15,510 lm	16,537 lm	16,453 lm	17,033 lm																																																																																				
Luminare Efficacy Rating (LER)	138 W	138 W	138 W	138 W	138 W	138 W	138 W	138 W																																																																																				
Correlated Color Temperature (CCT)	110 lm/W	117 lm/W	117 lm/W	121 lm/W	113 lm/W	120 lm/W	120 lm/W	124 lm/W																																																																																				
Color Rendering Index (CRI)	4000K	4000K	4000K	4000K	5000K	5000K	5000K	5000K																																																																																				
BUG Rating	>70	>70	>70	>70	>70	>70	>70	>70																																																																																				
Ambient Temperature Range	B3-U0-G3	B3-U0-G3	B3-U0-G3	B4-U0-G2	B3-U0-G3	B3-U0-G3	B3-U0-G3	B4-U0-G2																																																																																				
Universal Driver	-40 F - 115 F	-40 F - 115 F	-40 F - 115 F	-40 F - 115 F	-40 F - 115 F	-40 F - 115 F	-40 F - 115 F	-40 F - 115 F																																																																																				
	120-277 V	120-277 V	120-277 V	120-277 V	120-277 V	120-277 V	120-277 V	120-277 V																																																																																				
<small>LED System data above based on AL-140WLED-UNIV-40 and AL-140WLED-UNIV-50 LED Lumen maintenance estimates based on TM-21 projections for the light source at 25°C ambient.</small>																																																																																												

Project Name:	Part Number:	Type:																								
<b>LARGE FLOOD - 85W LED</b>																										
FLOODS 2.0																										
<b>FEATURES</b> <ul style="list-style-type: none"> <li>Die-cast aluminum housing</li> <li>Diffused tempered glass lens</li> <li>Hinged front frame w/ removable back cover also available (3' cord &amp; watertight bushing included)</li> <li>Watertight end grip installed</li> <li>Standard yoke included</li> <li>4000K &amp; 5000K color options</li> <li>0-10V Dimmable Driver</li> <li>IP65 Rating</li> <li>ETL Listed</li> <li>5 Year Warranty</li> <li>DesignLights Consortium® Premium Qualified Luminaire</li> </ul>																										
 407-478-3759 <a href="http://www.ilp-inc.com">www.ilp-inc.com</a>																										
																										
<b>SUITABLE APPLICATIONS</b> <ul style="list-style-type: none"> <li>Parking Lots</li> <li>Buildings</li> <li>General Area Lighting</li> </ul>																										
<b>LED SYSTEMS INFO</b> <table border="1"> <tr> <td>Calculated L<sub>70</sub> (TM-21)</td> <td>&gt;100K</td> <td>&gt;100K</td> </tr> <tr> <td>Delivered Lumens</td> <td>10,240 lm</td> <td>9,684 lm</td> </tr> <tr> <td>Total Input Watts</td> <td>83 W</td> <td>81 W</td> </tr> <tr> <td>Luminare Efficacy Rating (LER)</td> <td>123 lm/W</td> <td>119 lm/W</td> </tr> <tr> <td>Correlated Color Temperature (CCT)</td> <td>4000K</td> <td>5000K</td> </tr> <tr> <td>Color Rendering Index (CRI)</td> <td>&gt;80</td> <td>&gt;80</td> </tr> <tr> <td>Ambient Temperature Range</td> <td>-20 F - 115 F</td> <td>-20 F - 115 F</td> </tr> <tr> <td>Universal Driver</td> <td>120-277 V</td> <td>120-277 V</td> </tr> </table>			Calculated L <sub>70</sub> (TM-21)	>100K	>100K	Delivered Lumens	10,240 lm	9,684 lm	Total Input Watts	83 W	81 W	Luminare Efficacy Rating (LER)	123 lm/W	119 lm/W	Correlated Color Temperature (CCT)	4000K	5000K	Color Rendering Index (CRI)	>80	>80	Ambient Temperature Range	-20 F - 115 F	-20 F - 115 F	Universal Driver	120-277 V	120-277 V
Calculated L <sub>70</sub> (TM-21)	>100K	>100K																								
Delivered Lumens	10,240 lm	9,684 lm																								
Total Input Watts	83 W	81 W																								
Luminare Efficacy Rating (LER)	123 lm/W	119 lm/W																								
Correlated Color Temperature (CCT)	4000K	5000K																								
Color Rendering Index (CRI)	>80	>80																								
Ambient Temperature Range	-20 F - 115 F	-20 F - 115 F																								
Universal Driver	120-277 V	120-277 V																								
<small>LED System data above based on FLL-85WLED-UNIV-40 &amp; FLL-85WLED-UNIV-50 LED Lumen Maintenance Estimates based on TM-21 projections for the light source at 25°C ambient.</small>																										

Project Name:	Part Number:	Type:		
<b>ORDERING GUIDE:</b>				
Series	Watts	Driver	Color	Description
FLL Large Flood	85WLED	UNIV 120-277V Driver	50	CORDx: 50' CORDx PCox: Photocell (xx = Voltage) GS: Glare Shield WG: Wire Guard PMB: Pole Mount Bracket (3' cord & bushing incl.) TMB: Tenon Mount Bracket (3' cord & bushing incl.) SP1: 10kA Max Univolt Surge Protector SD480V: 480V Step Down Transformer SD347V: 347V Step Down Transformer

Project Name:	Part Number:	Type:		
<b>ORDERING GUIDE:</b>				
Series	Watts	Driver	Color	Description
AL Area Light	140WLED	UNIV 120-277V Driver	50	CORDx: 50' CORDx PCox: Photocell (xx = Voltage) GS: Glare Shield WG: Wire Guard PMB: Pole Mount Bracket (3' cord & bushing incl.) TMB: Tenon Mount Bracket (3' cord & bushing incl.) SP1: 10kA Max Univolt Surge Protector SD480V: 480V Step Down Transformer SD347V: 347V Step Down Transformer


**Fixture Type AA & BB**  
SCALE: NONE

**Fixture Type CC**  
SCALE: NONE




# Markup Summary

dsdruiz (3)

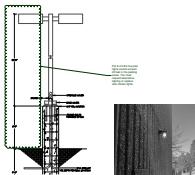


**Subject:** Cloud+  
**Page Label:** [2] 18288 Site Photometric Plan-SITE  
PHOTOMETRIC DETAILS  
**Lock:** Unlocked  
**Author:** dsdruiz  
**Date:** 10/16/2018 4:03:33 PM  
**Color:** ■

Per 6.2.3.B.2 the pole lights cannot exceed 20 feet in the parking areas. You must request alternative lighting or replace with shorter lights.

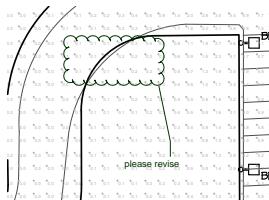

**Subject:** Cloud+  
**Page Label:** [1] 18288 Site Photometric Plan-SITE  
PHOTOMETRICS  
**Lock:** Unlocked  
**Author:** dsdruiz  
**Date:** 10/16/2018 4:05:43 PM  
**Color:** ■

please revise

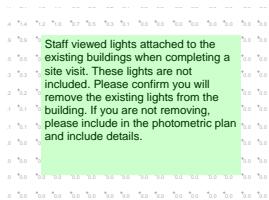

**Subject:** Text Box  
**Page Label:** [1] 18288 Site Photometric Plan-SITE  
PHOTOMETRICS  
**Lock:** Unlocked  
**Author:** dsdruiz  
**Date:** 10/17/2018 10:45:00 AM  
**Color:** ■

Staff viewed lights attached to the existing buildings when completing a site visit. These lights are not included. Please confirm you will remove the existing lights from the building. If you are not removing, please include in the photometric plan and include details.