
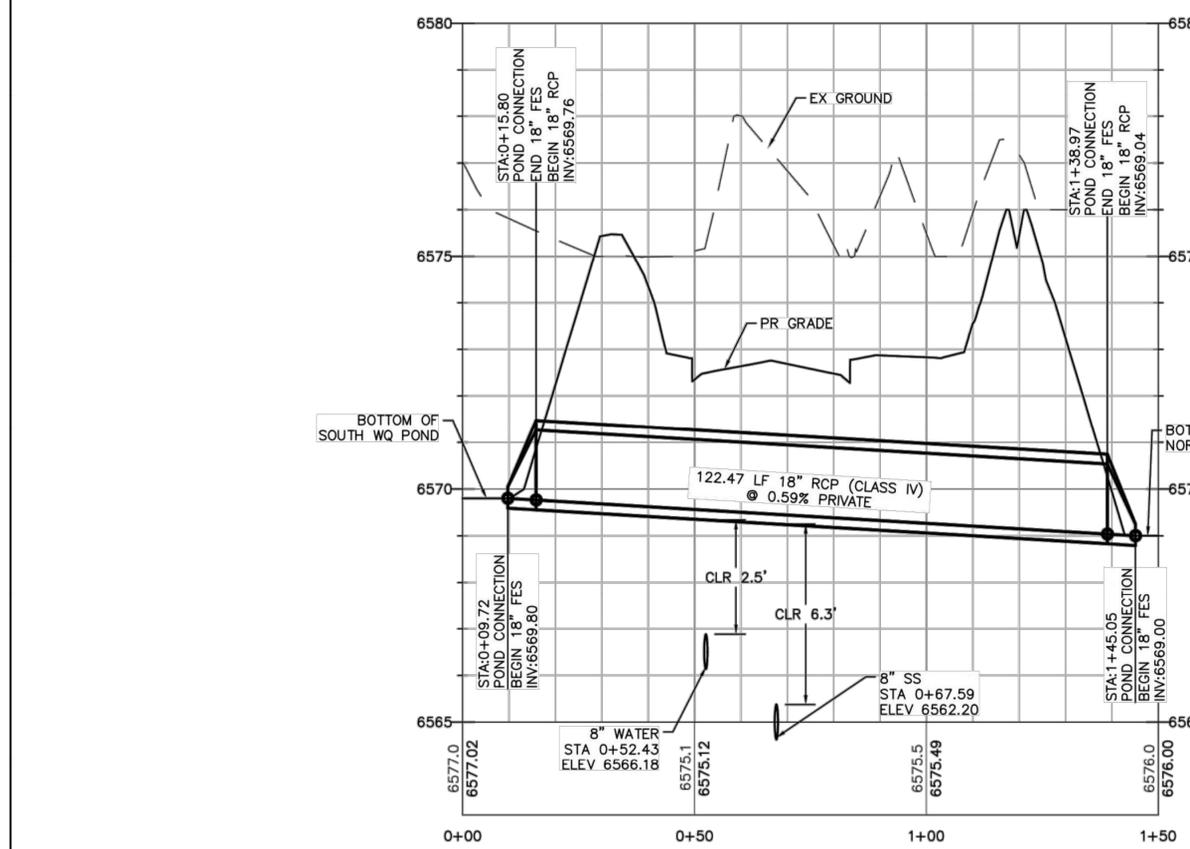


LINE TABLE: ALIGNMENTS

LINE #	LENGTH	START STA	END STA	DIRECTION	START POINT (EAST, NORTH)	END POINT (EAST, NORTH)
L100	150.00	0+00.00	1+50.00	N3° 59' 09.43\"/>		

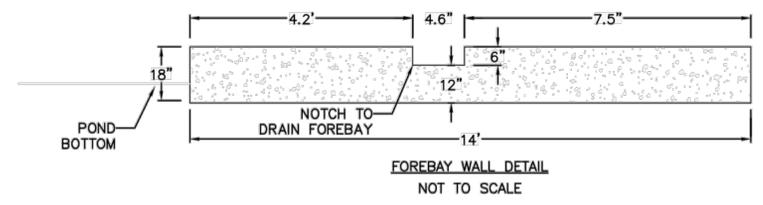

**THE GARDENS AT NORTH CAREFREE
POND ASBUILTS**
FIELD DATA COLLECTED 11-06-2020, 11-11-2020 AND 1-7-2022



ENGINEERING STATEMENT

THE DETENTION POND SHOWN ON THIS EXHIBIT, CONSTRUCTED AS PART OF THE GARDENS AT NORTH CAREFREE HAS BEEN CONSTRUCTED TO MEET OR EXCEED ITS RESPECTIVE DESIGN PARAMETERS. CHARLES K. COTHERN, PE, COLORADO COLORADO REGISTRATION NO. 24997

SIGNATURE: _____ DATE: _____
PRINTED NAME: CHARLES K. COTHERN

AS-BUILT POND PROPERTIES

AS-BUILT POND VOLUME = 58632.903 CF = 1.346 Ac.Ft.
DESIGN POND VOLUME = 53,056 CF = 1.216 Ac.Ft.

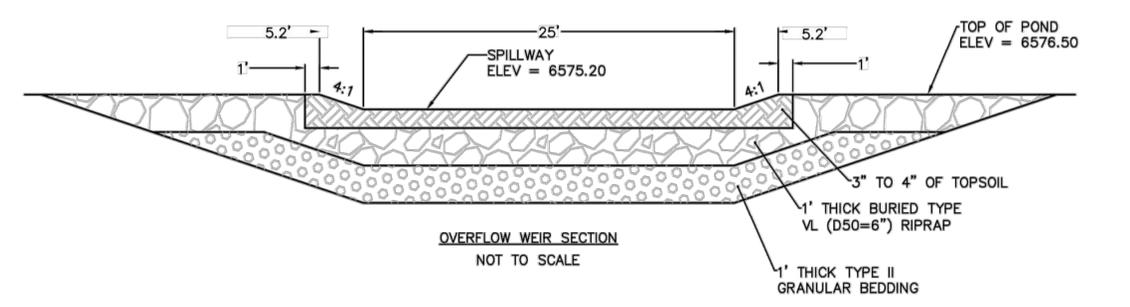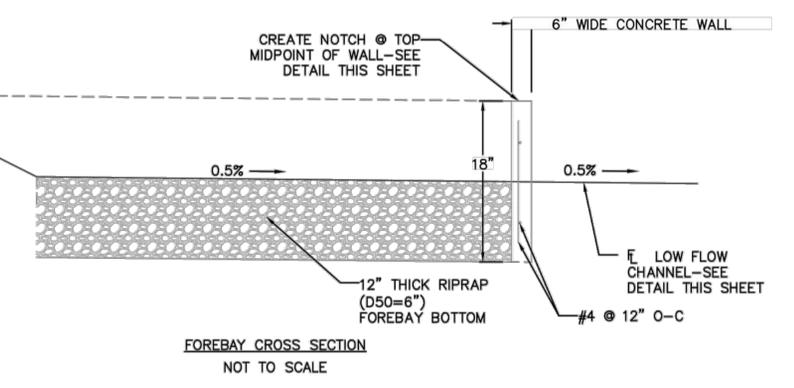

Computer File Information

Creation Date: 4-25-17	Initials: CMD
Last Modification Date:	Initials:
Full Path & Drawing File Name:	
Acad Ver. 2014	Scale: Units: Feet

Index of Revisions

No.	Description

Stantec
Stantec Consulting Inc.
5725 MARK DABLING BLVD
Suite 190
Colorado Springs, CO 80919
Tel. (719) 594-4535
Fax.
www.stantec.com

**GARDENS AT NORTH CAREFREE
SOUTH WQ POND**

Designer: CD	Structure Numbers
Detailer: MB	
Sheet Subset:	

Project No./Code
187608744

SHEET 26 OF 34