
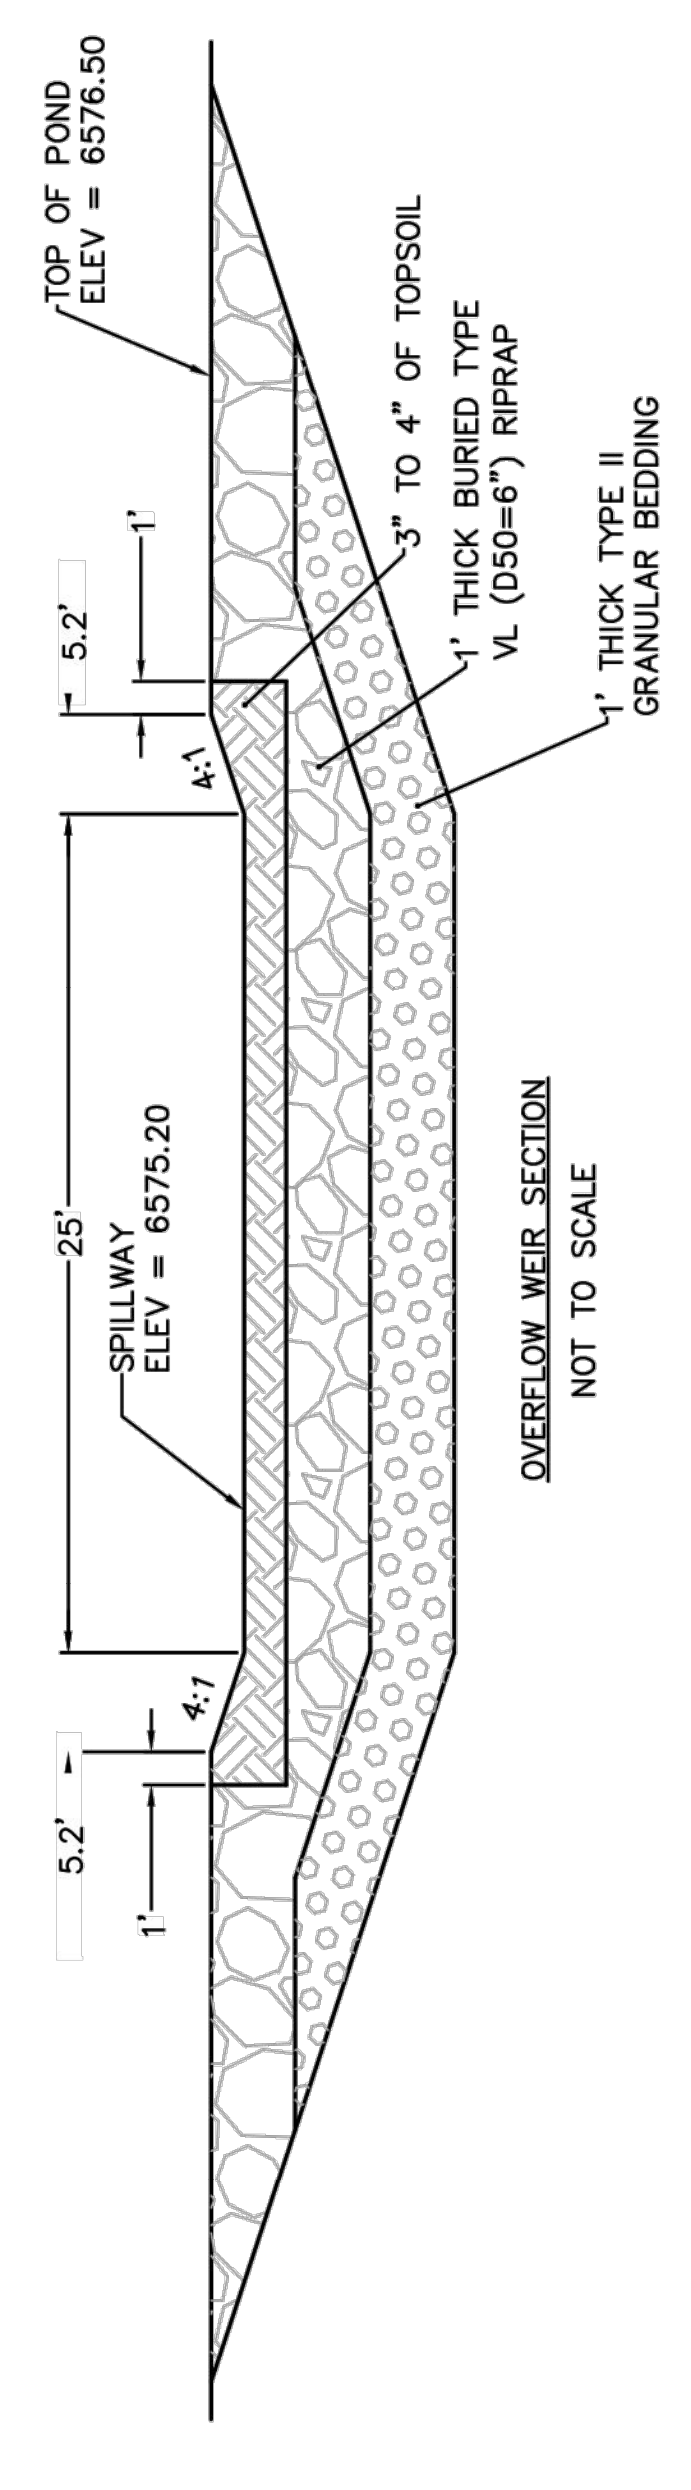
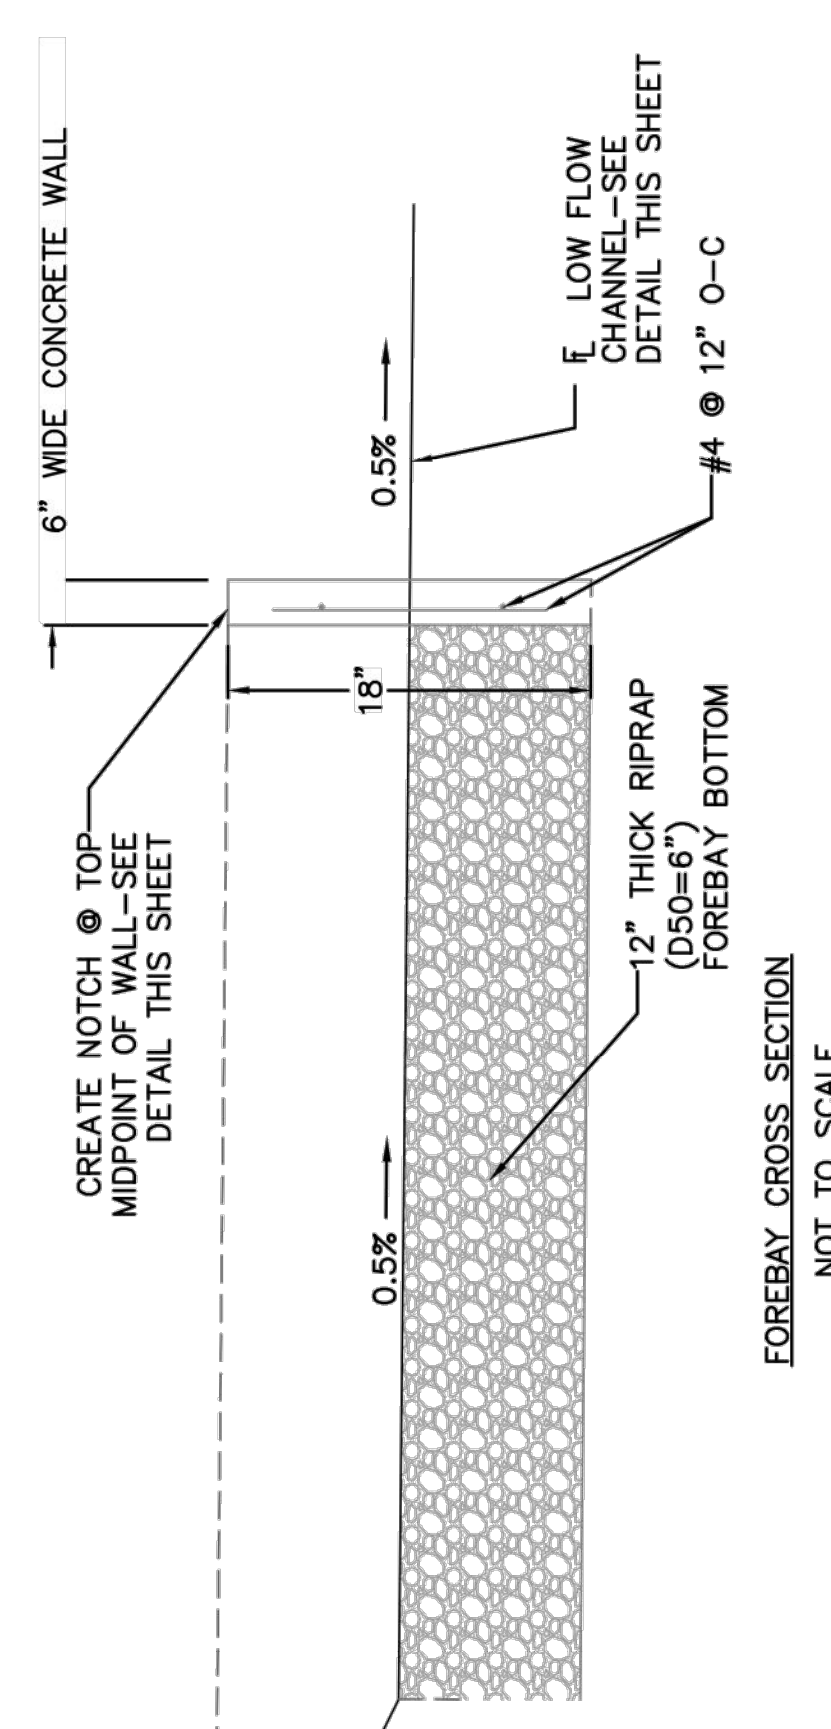


LINE TABLE: ALIGNMENTS

LINE #	LENGTH	START STA	END STA	DIRECTION	START POINT (EAST, NORTH)	END POINT (EAST, NORTH)
L100	150.00	0+00.00	1+50.00	N3° 59' 09.43"W	(3322.97, 5625.79)	(3312.54, 5775.42)

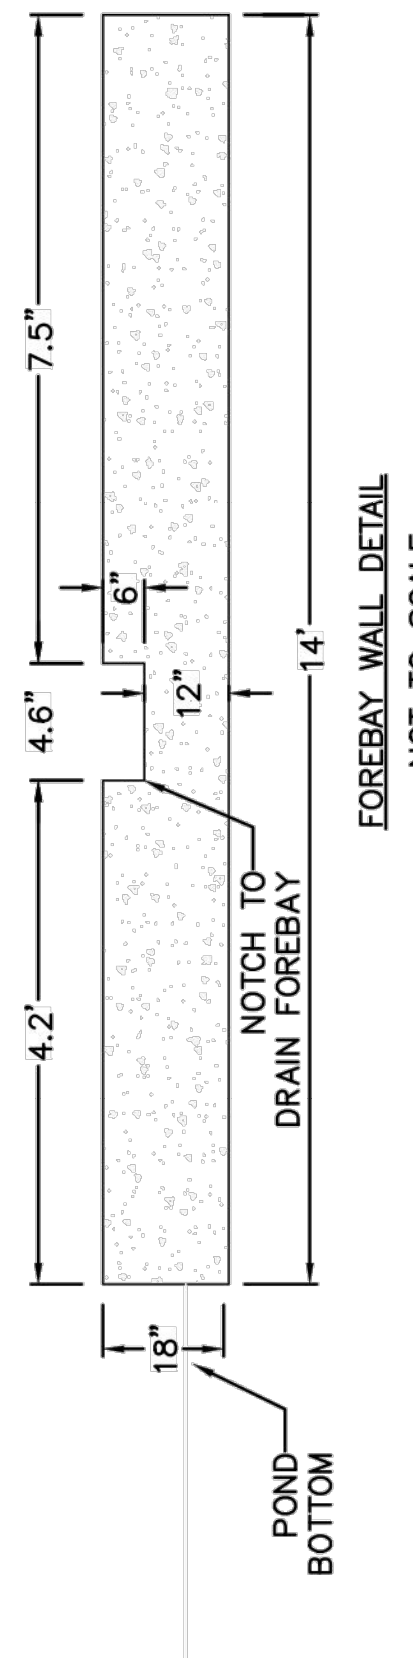

THE GARDENS AT NORTH CAREFREE  
POND AS BUILTS  
FIELD DATA COLLECTED 11-06-2020, 11-11-2020 AND 1-7-2022


**ENGINEERING STATEMENT**

THE DETENTION POND SHOWN ON THIS EXHIBIT, CONSTRUCTED AS PART OF THE GARDENS AT NORTH CAREFREE HAS BEEN CONSTRUCTED TO MEET OR EXCEED ITS RESPECTIVE DESIGN PARAMETERS.

CHARLES K. COTHERN, P.E. COLORADO COLORADO REGISTRATION NO. 24997  
SIGNATURE: \_\_\_\_\_ DATE: \_\_\_\_\_  
PRINTED NAME: CHARLES K. COTHERN P.E.

**AS-BUILT POND PROPERTIES**

AS-BUILT POND VOLUME = 58632.903 CF = 1.346 Ac.Ft.  
DESIGN POND VOLUME = 53,056 CF = 1.216 Ac.Ft.

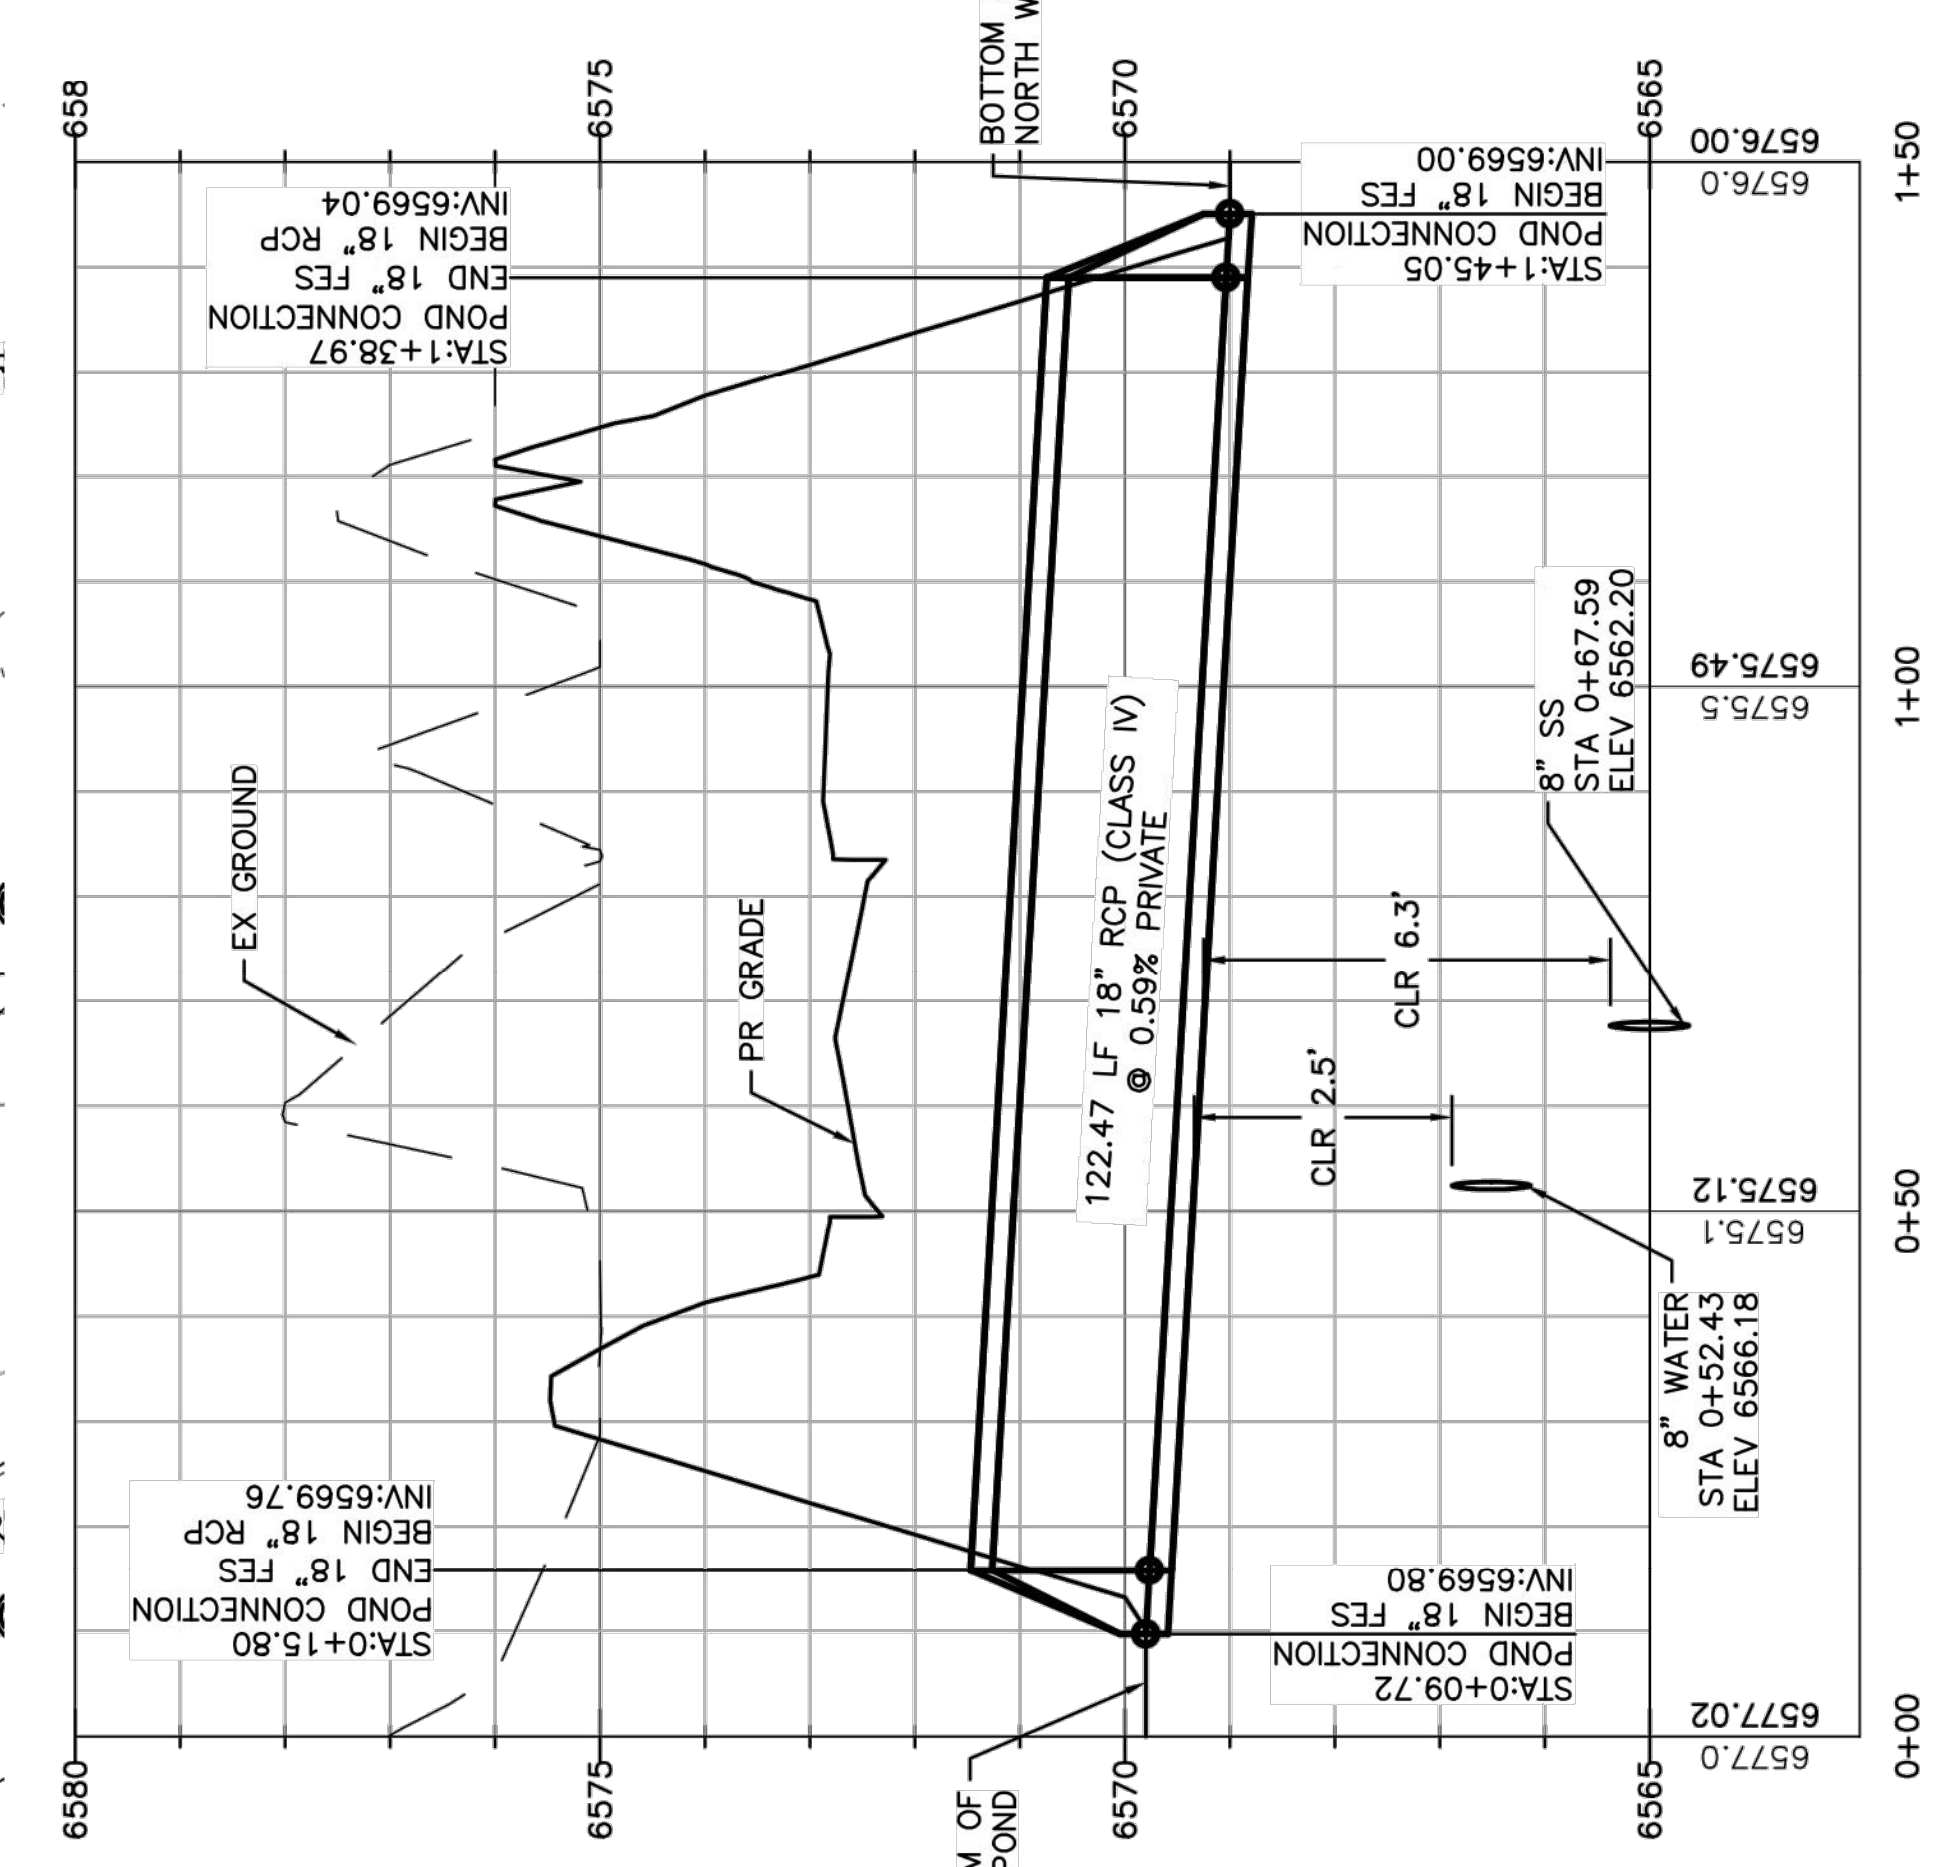

**Computer File Information**

Creation Date: 4-25-17 Initials: CMD  
Last Modification Date: Initials:  
Full Path & Drawing File Name:  
Acad Ver. 2014 Scale: Units: Feet

**Index of Revisions**

NO.	DESCRIPTION
0000	
0000	
0000	
0000	

**Stantec**  
Stantec Consulting Inc.  
3725 MARK DABLING BLDG  
Suite 190  
Colorado Springs, CO 80919  
Tel. (719) 594-4335  
Fax. \_\_\_\_\_  
www.stantec.com

**GARDENS AT NORTH CAREFREE  
SOUTH WQ POND**

Project No./Code: 187608744

Designer: CD Structure Numbers  
Detailer: MB MB  
Sheet Subset: SHEET 26 OF 34