
ALL LIGHTING FIXTURES SHALL BE FULL CUT-OFF OR HAVE SHIELDING TO REDUCE OFF-SITE LIGHTING IMPACTS ONTO ADJACENT PROPERTIES AND ROADWAYS. ALL EXTERIOR LIGHTING SHALL BE ARRANGED TO MITIGATE LIGHT DIRECTED AWAY FROM ADJACENT PROPERTIES AND ANY PUBLIC RIGHT-OF-WAY. AN AMENDMENT TO THIS PLAN MAY BE REQUIRED IF THE LIGHTING TYPE IS CHANGED.

LIGHT FIXTURE SCHEDULE										
	\\\\\\\\\\\\\\\\\\\\\\\\\\\\\\\\\\\\\\	~~~~~~		-PAMB	<b>√</b>	<	~~~~	<b>~~~</b>	<u>√₹</u> @₹ <b>A</b> L∕	$\sim$
MARK	MANUFACTURER	MODEL	QTY.	WATT	TYPE	MOUNTING	DESCRIPTION	VOLTAGE	WATTS	NOTES
AA	LSI INDUSTRIES, INC	SLM-LED-18L-SIL-4-40-70CRI	1	135	LED	POLE @ 15' & 20'	AREA LUMINAIRE	120/277	135	1 - 2
WP1	LITHONIA	DSXW1 LED 10C 350 30K T4M MVOLT	1	13.3	LED	WALL SURFACE @ 15'	WALLPACK	120/277	13.3	1 - 2

1) LIGHTING FIXTURE TO BE CONTROLLED VIA LIGHTING CONTROL PANEL WITH TIME CLOCK AND PHOTOCELL. 2) CONFIRM ALL LIGHT FIXTURE SELECTIONS WITH TENANT PRIOR TO ORDERING. THIS INCLUDES COLORS, COLOR TEMPERATURES, MANUFACTURER, ETC.

> CShea onsulting, LLC MECHANICAL + ELECTRICAL + PLUMBING 4445 Northpark Dr. Suite 200 Colorado Springs, CO 80907 mcsheaconsulting.com Project #: 24-7334

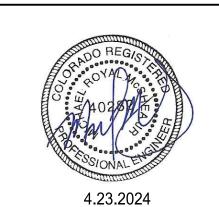

OWNERSHIP OF INSTRUMENTS OF

<u>SERVICE</u> All Drawings, Reports, Plans, Specifications, Computer Files (including CAD files), field information, notes, sketches, and othe design materials prepared by the Engineer and his/her consultants as instruments of service shall remain the property of the Engineer. The Engineer shall retain all common law, statutory and other reserved rights, including the Copyright thereto.

> 80930 JCKING-is Road, olorado Curti Is, Co -CITY LINK TI 225 North Cu rado Springs,

Colorado


	FULL SET ISSUE HIS	STORY:						
1	- PERMIT SET	4.23.2024						
△ SHEET REVISION:								
1	- FIELD CHANGES	4.23.2024						

PROJECT #: 24-7334 DRAWN BY: SH CHECKED BY: MRM

FILE NUMBER: PPR2339


SHEET


ES0.1

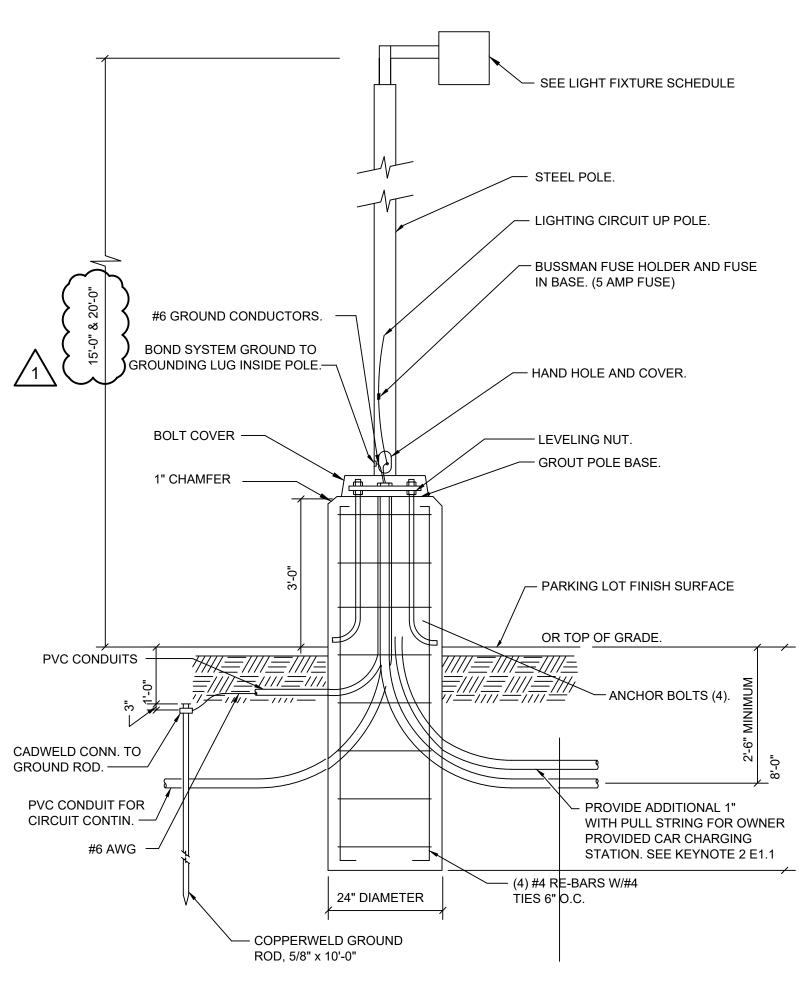


TYPICAL POLE BASE DETAIL ES0.1 SCALE: NONE



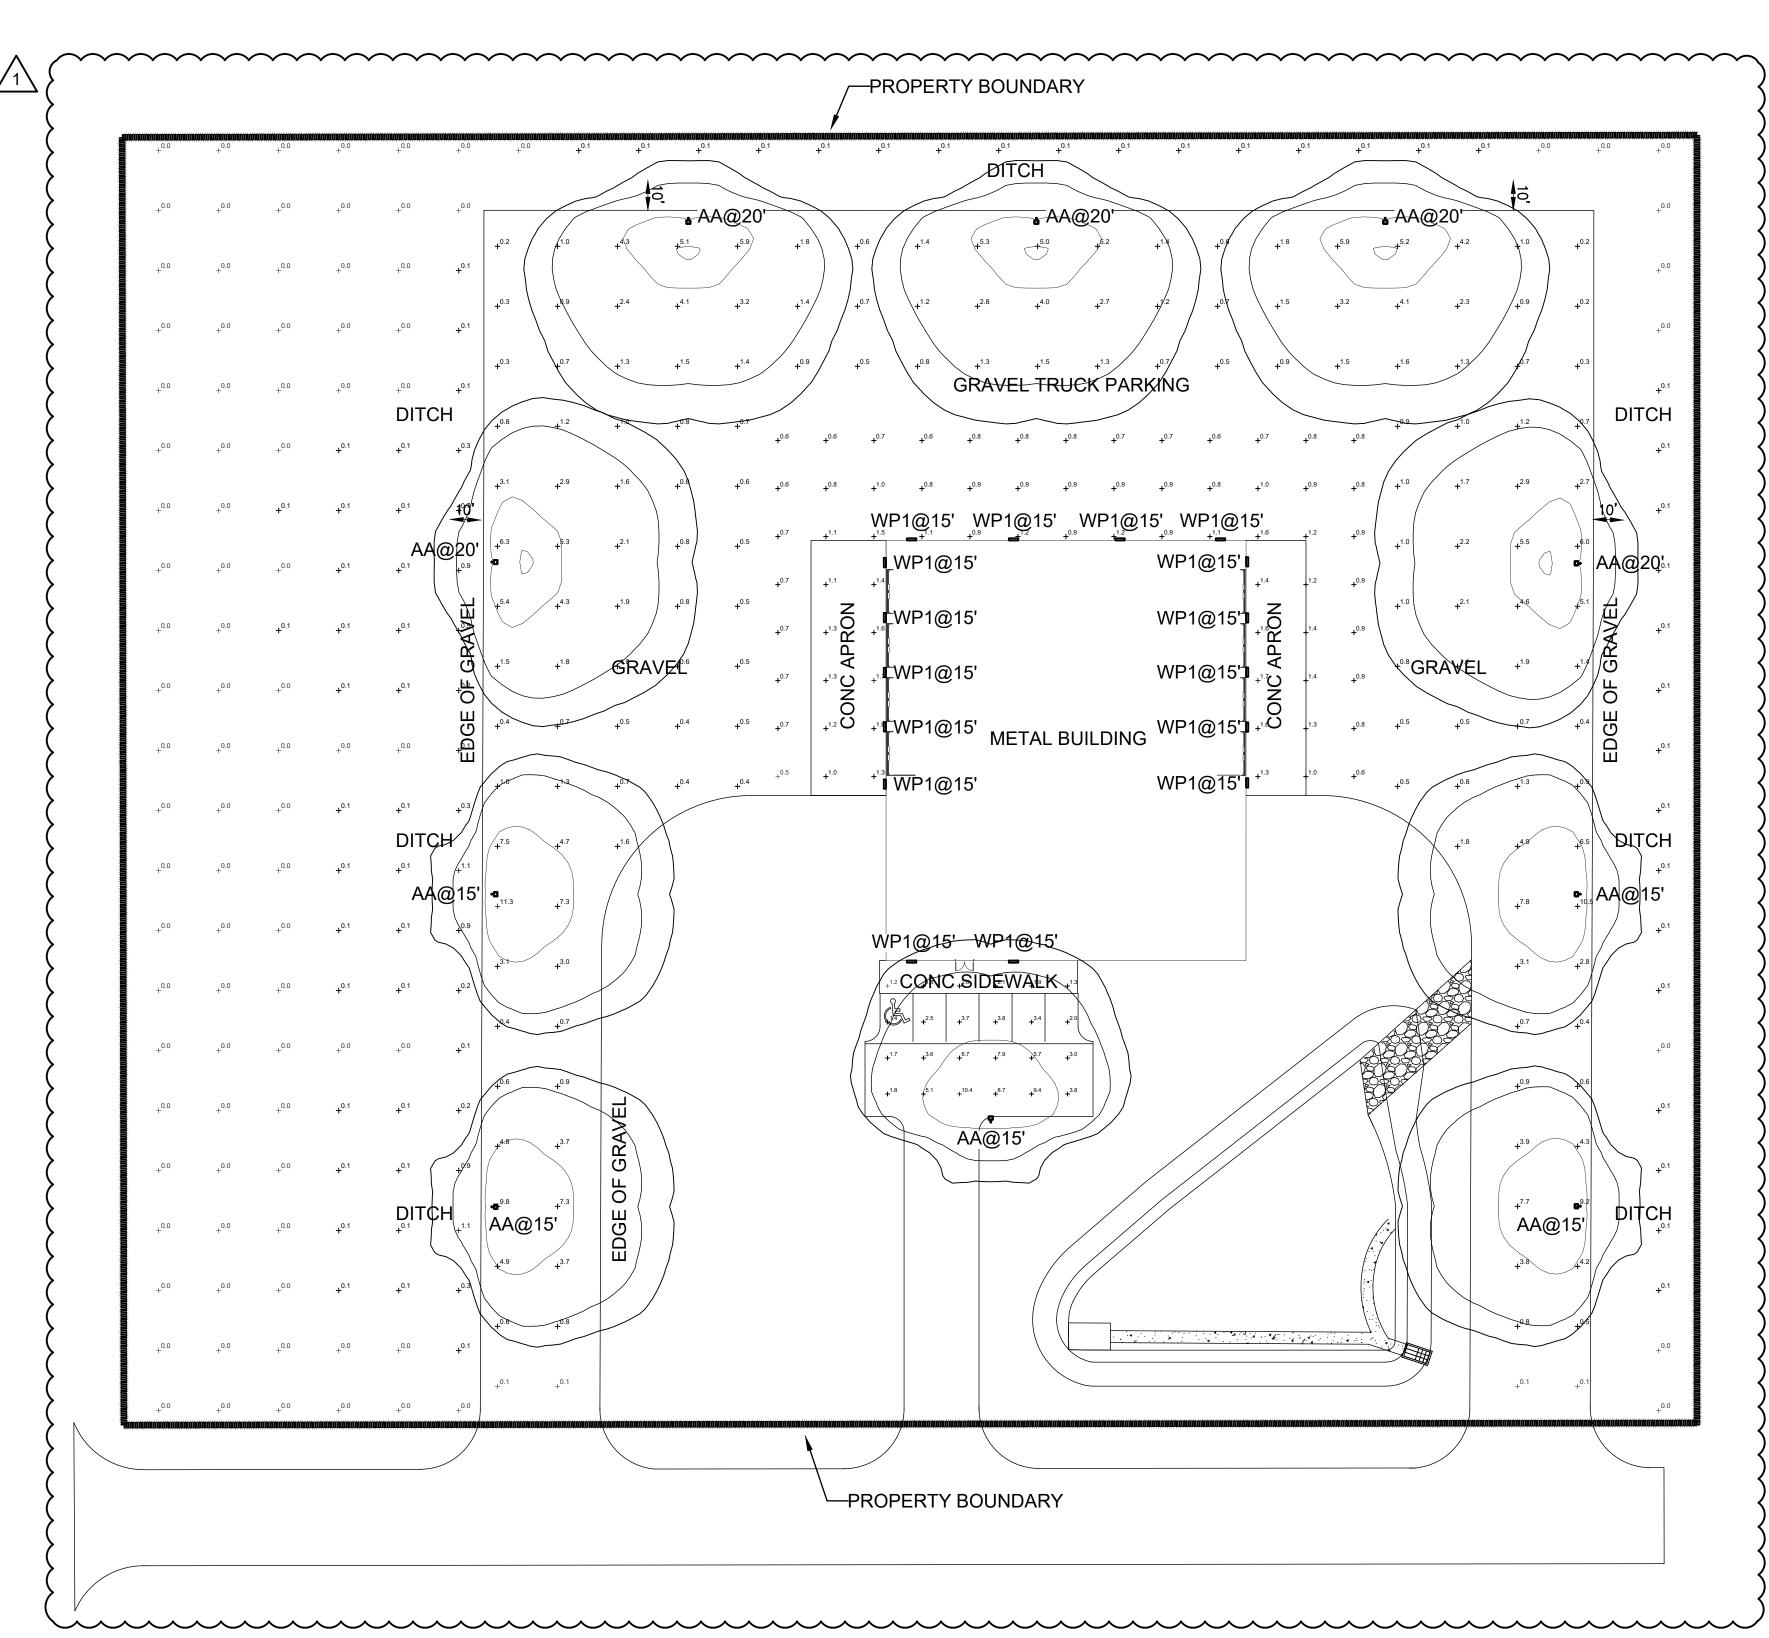

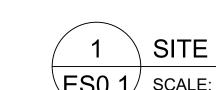



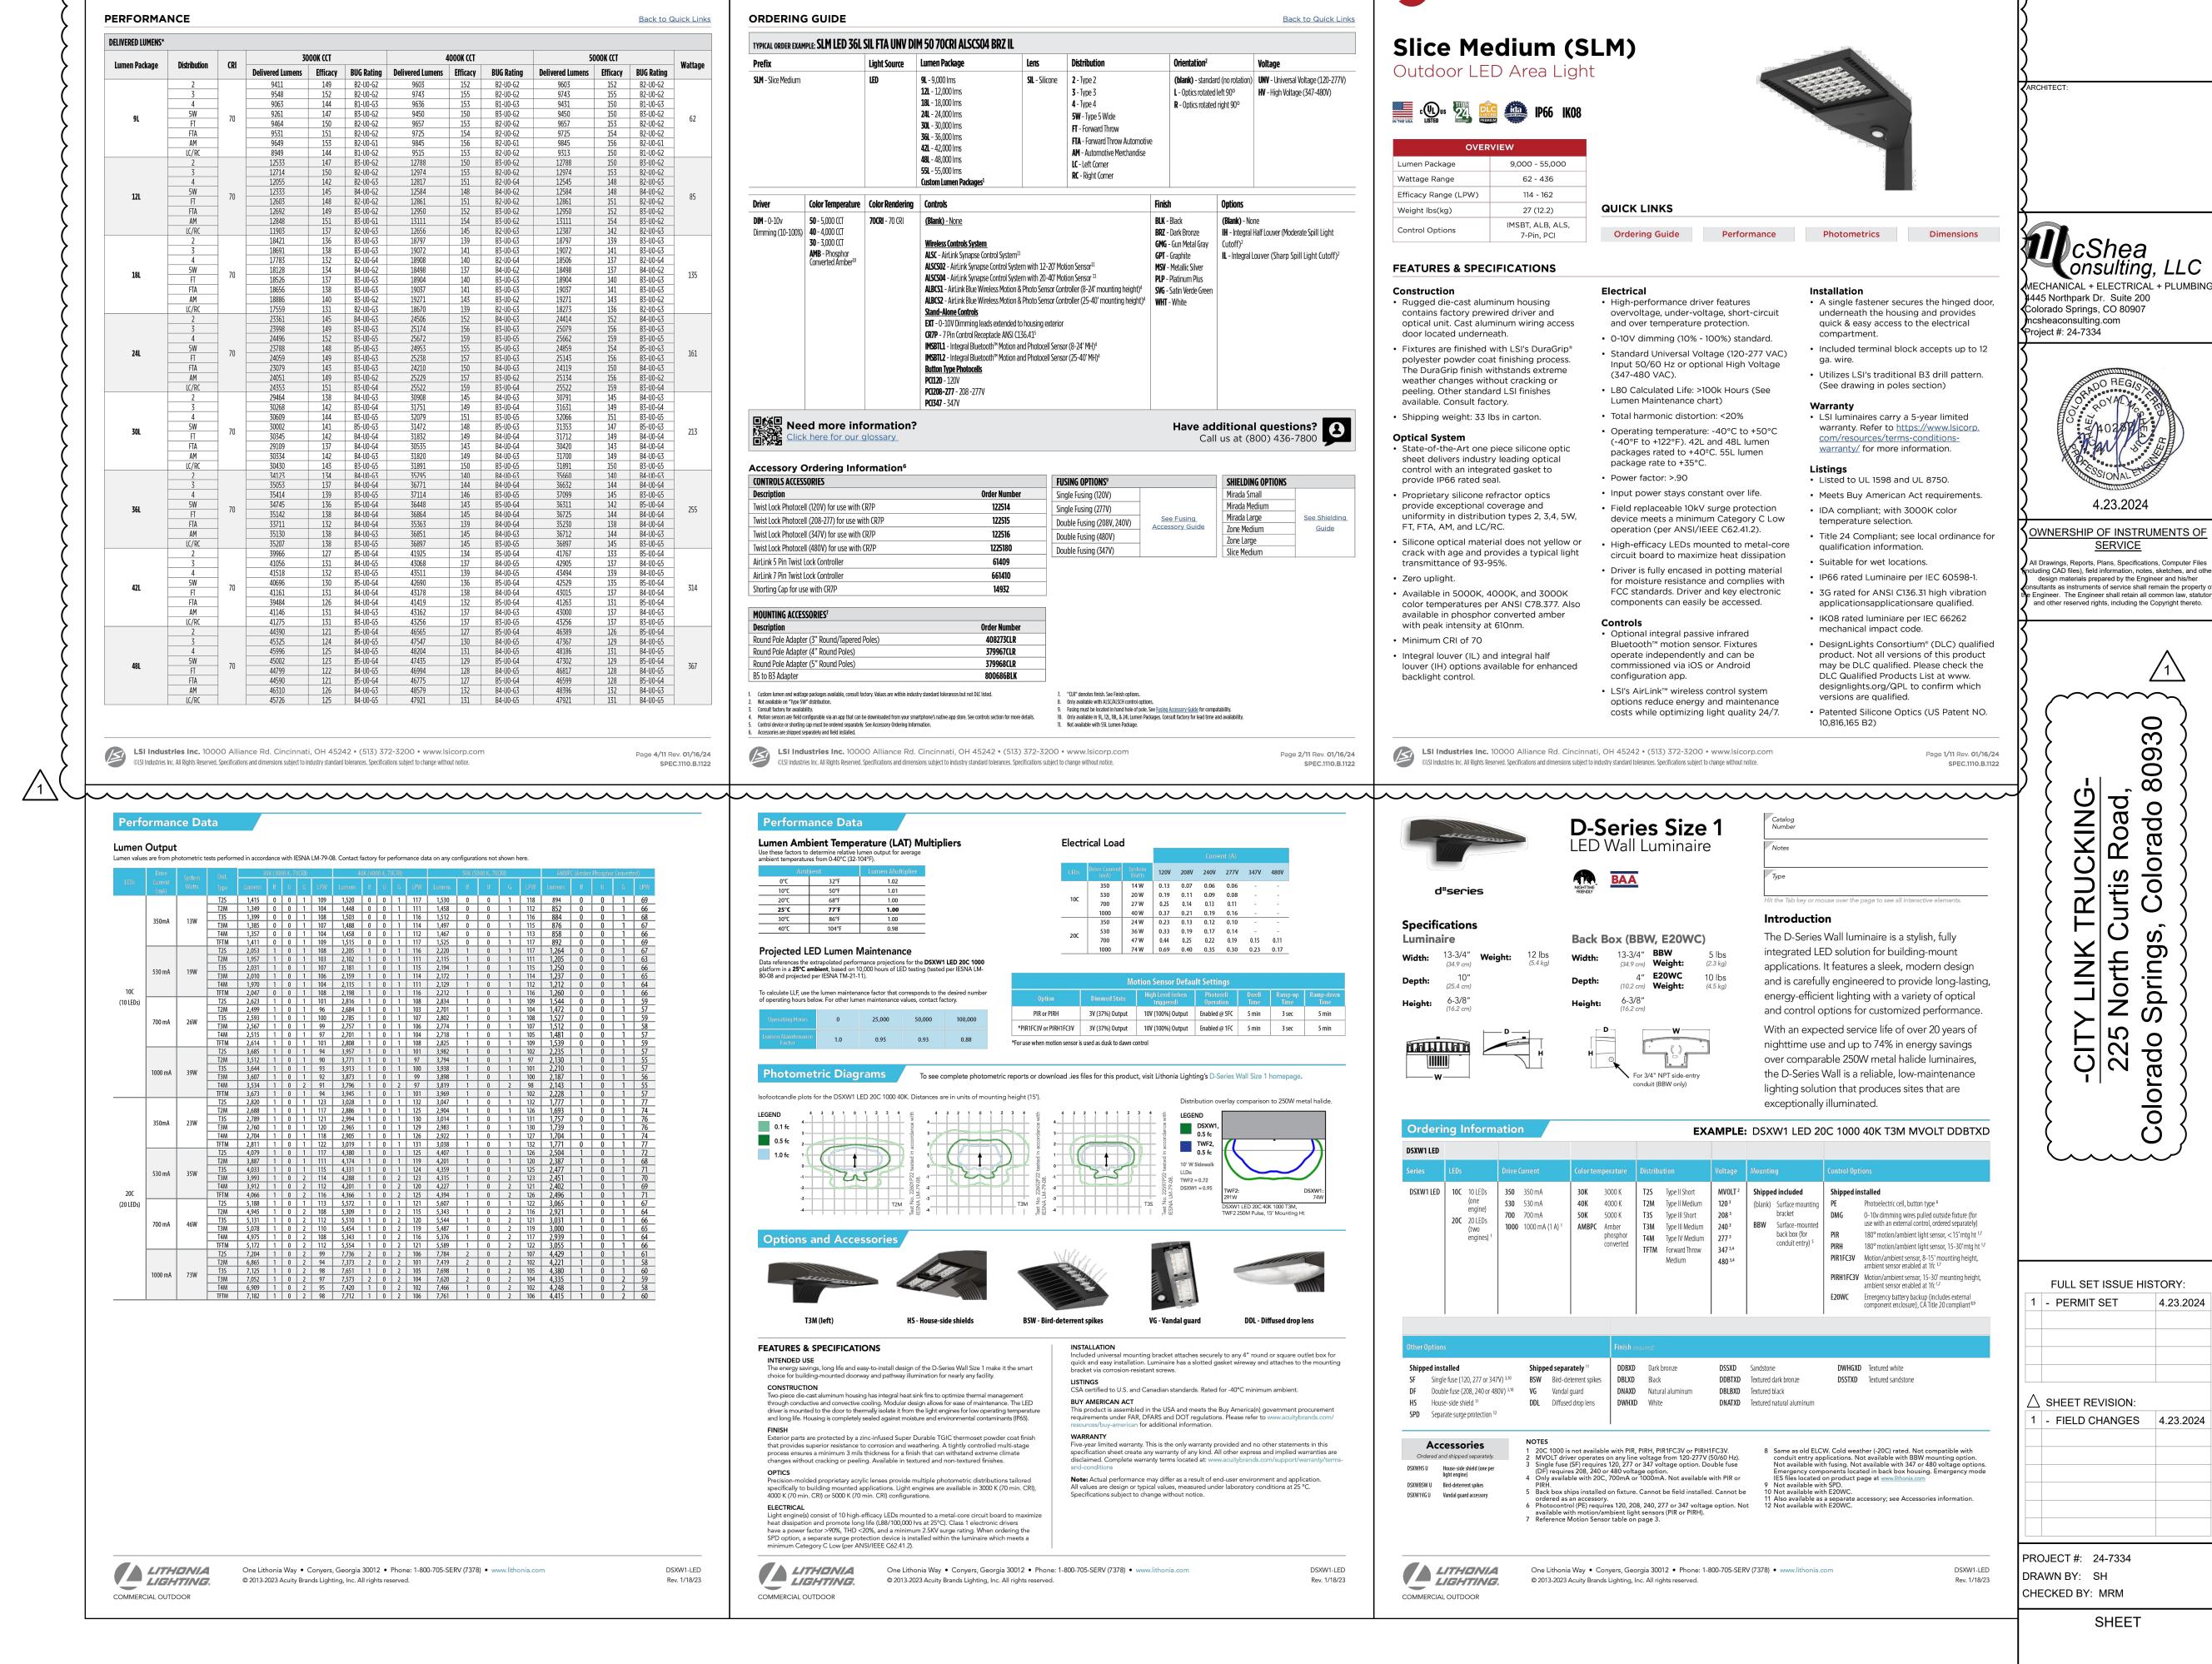

Slice Medium Outdoor LED Area Light

■ Have questions? Call us at (800) 436-7800

Slice Medium Outdoor LED Area Light

**A Have questions?** Call us at (800) 436-7800

ES0.2