

Please include title:  
"Alternative Landscape Plan"

Please include:  
-applicants POC info  
-existing or proposed easements

SITE PLAN KEY NOTES:

- ① ASPHALT PARKING LOT AND PARKING STRIPING
- ② EDGE OF PAVING
- ③ ADA PARKING SPACE AND SIGNAGE




8' PANEL FENCE AND SCREENING SYSTEM


Symbol	Qty	Common Name
	4	Chrysothamnus
	6	Russian Sage

Any fencing over 7 ft will require a building permit from PPRBD

**Please include:**  
 -plant table that includes provided vs required  
 -Legend that goes over:  
 .height  
 .ball/burlap size  
 .size  
 .caliper  
 -sight distance triangle  
 -zoning of property and surrounding zoning of each adjoining property  
 -please provide information or another page where we can see the adjoining lots in relation to the landscaping, especially for the two lots closest to this use (South and West)  
 -staff does recommend more landscaping, however we are welcome to more items of:  
 -xeriscape and decorative rock

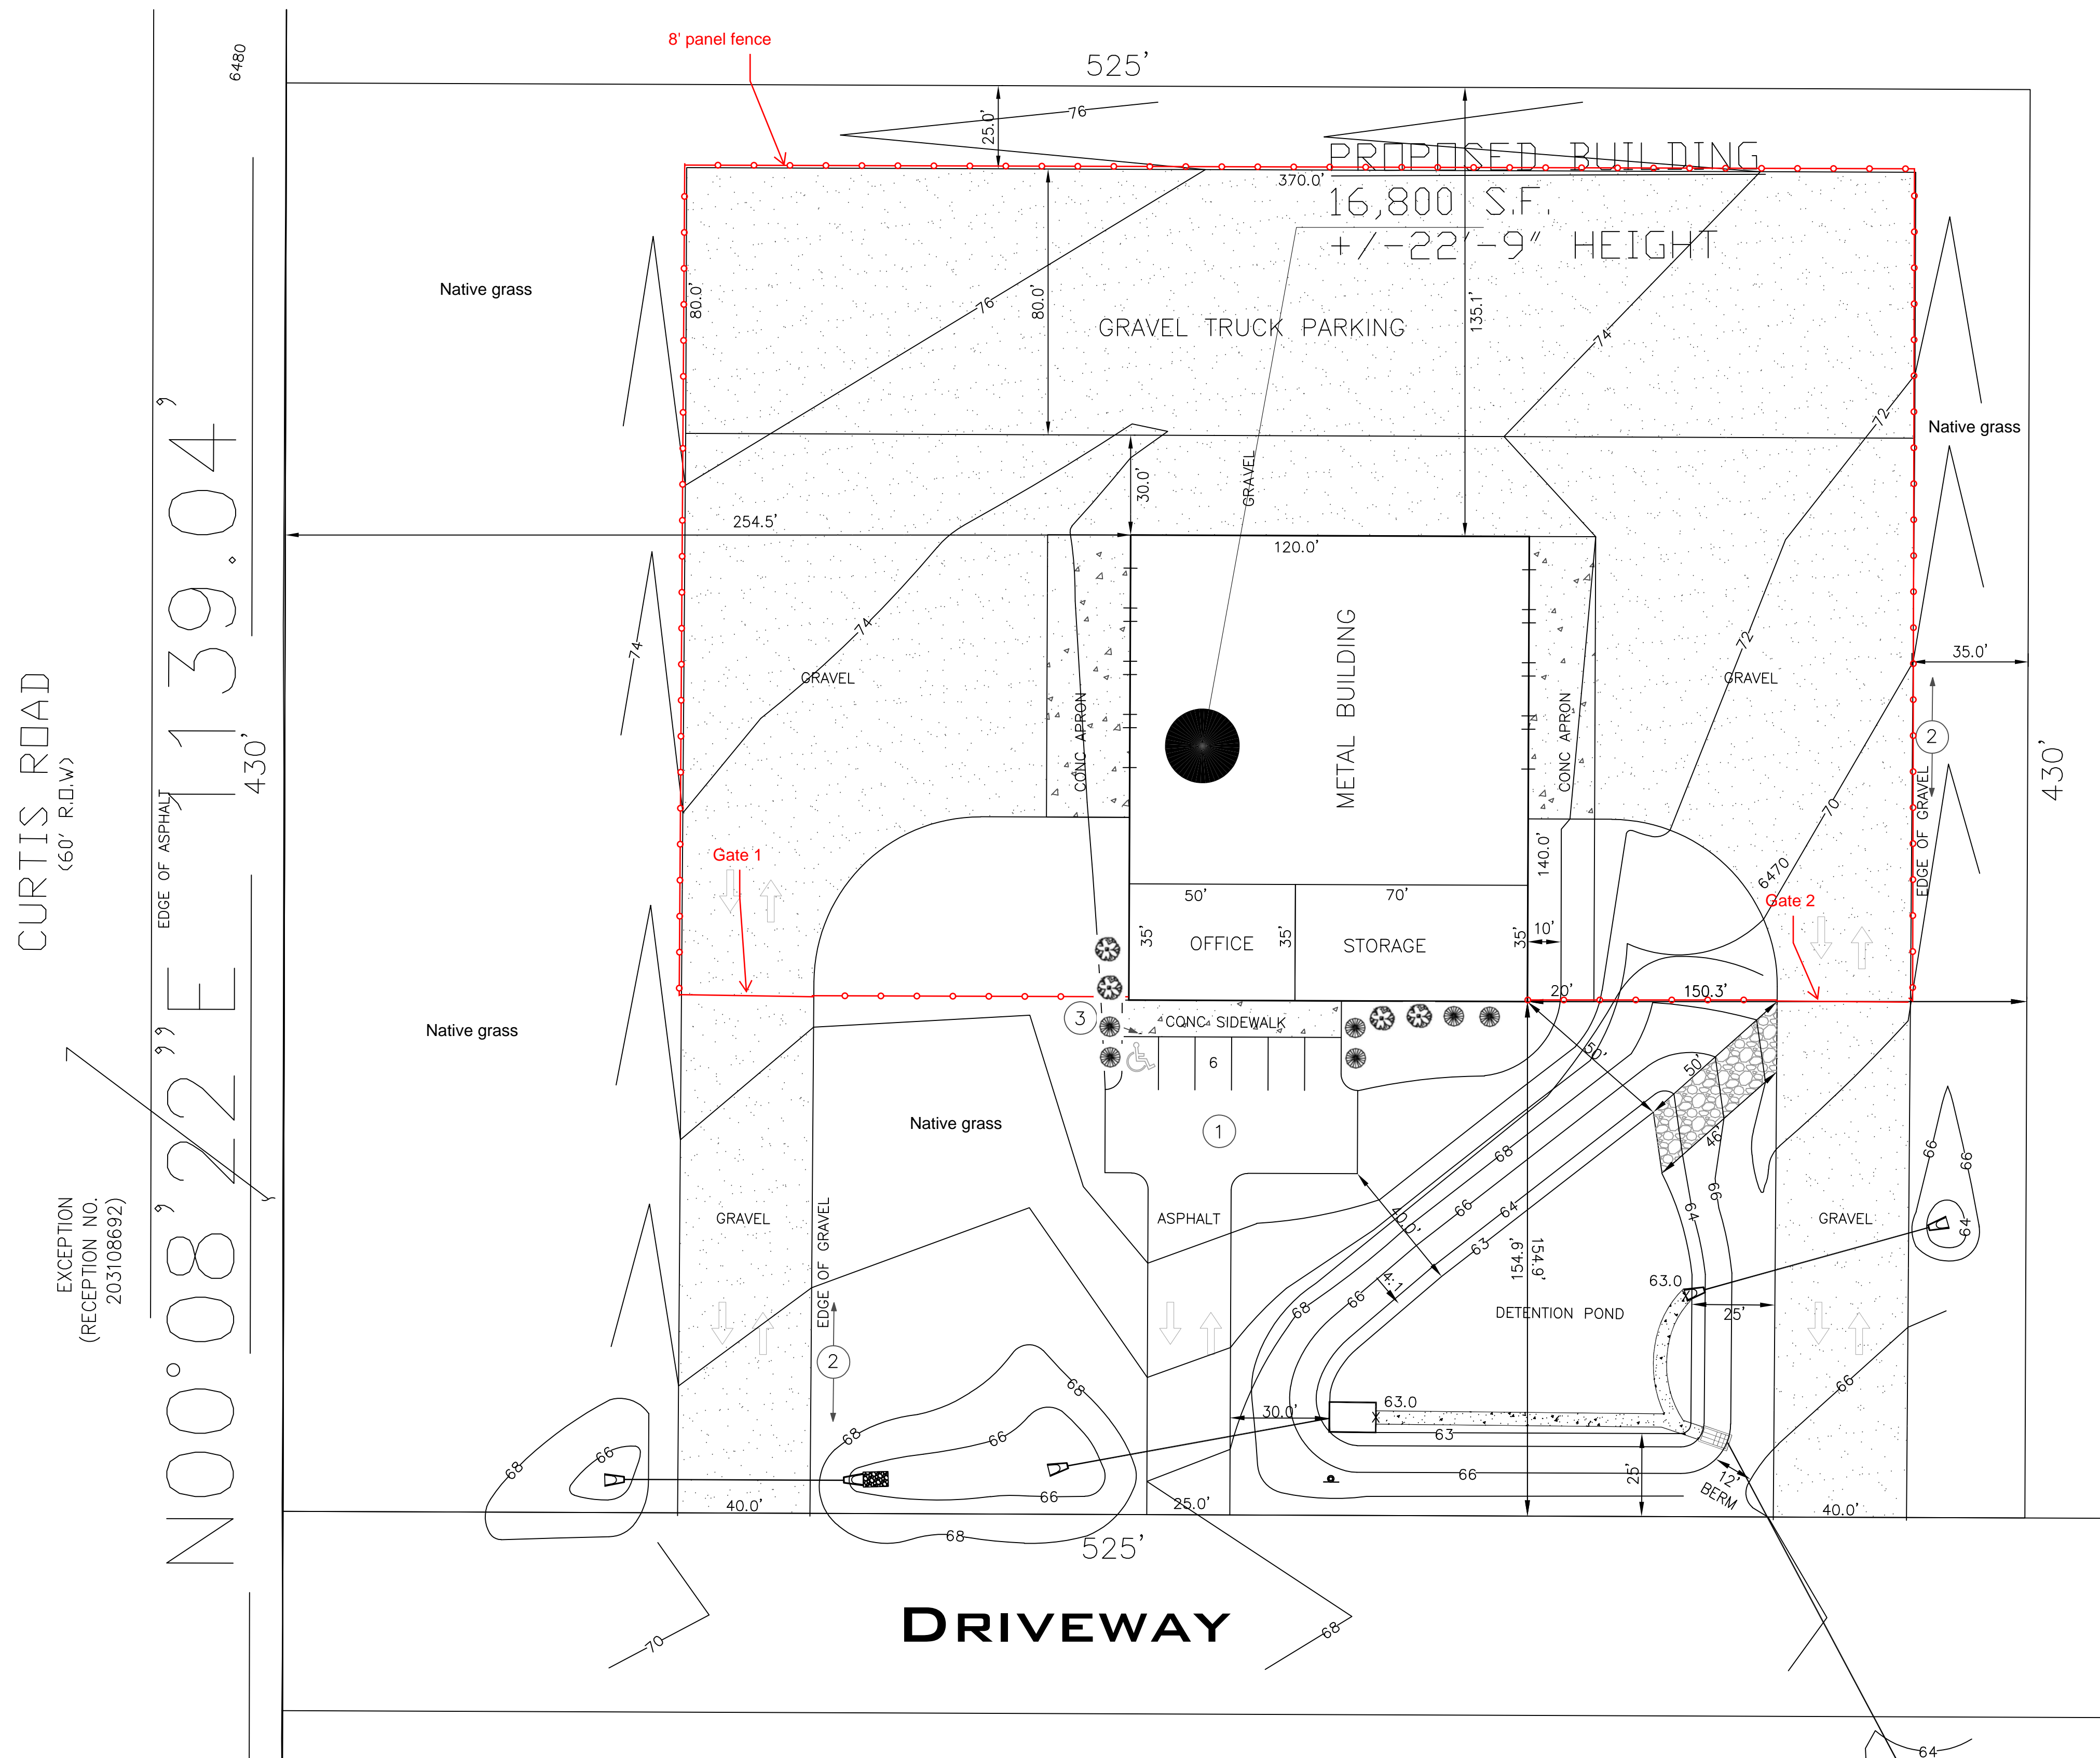

1 ENLARGED SITE PLAN  
1" = 30'-0"

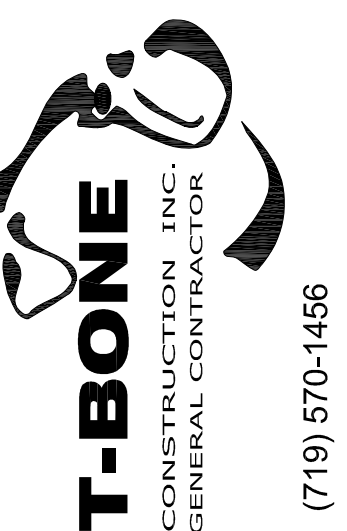

Design Development Consultants @  
1310 FORD STREET  
COLORADO SPRINGS, CO 80915  
(719) 570-1456  
(C) ALL RIGHTS RESERVED

Revisions	DATE
#	DESCRIPTION

D2-1109

CITY LINK TRUCKING  
225 N. CURTIS ROAD,  
COLORADO SPRINGS, CO

DATE	08-25-2023
CHECKED	-
DRAWN BY	-

ENLARGED SITE PLAN

DP-2