


verify legal with LOI,
Application and Legal
in word

HANNAH RIDGE AT FEATHERGRASS FILING NO. 7

A REPLAT OF TRACT KK AND LL OF HANNAH RIDGE AT FEATHERGRASS FILING NO. 1,
RECEPTION NO. 214713468, RECORDS OF EL PASO COUNTY, COLORADO,
SECTION 32, TOWNSHIP 13 SOUTH, RANGE 65
WEST OF THE SIXTH PRINCIPAL MERIDIAN, EL PASO COUNTY, COLORADO

Can you add the line
work for whats been
platted so we can see
the overall
connectivity to the is
map?

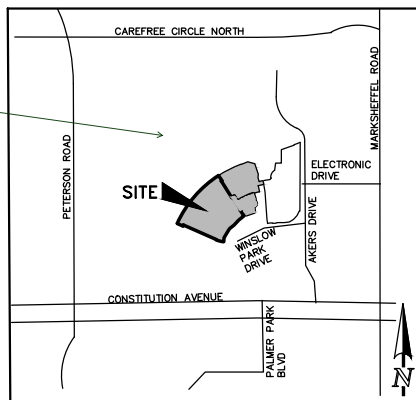

VICINITY MAP
N.T.S.

SUMMARY TABLE:

LOTS	SQUARE FEET	PERCENTAGE	OWNER	MAINTENANCE
TRACT A (PARKS, OPEN SPACE, PUBLIC UTILITIES, DRAINAGE)	320,329	33.96%	HOA	HOA
TRACT B (FUTURE DEVELOPMENT)	2,058	0.22%	OWNER OF RECORD	
LOTS (81 TOTAL)	468,567	49.67%	INDIVIDUAL LOT OWNERS	
R.O.W.	152,345	16.15%	COUNTY	COUNTY
TOTAL	943,290	100%		

SURVEYOR'S STATEMENT:

I, DOUGLAS P. REINELT, A DULY LICENSED PROFESSIONAL LAND SURVEYOR IN THE STATE OF COLORADO, DO HEREBY CERTIFY THIS PLAT TRULY AND CORRECTLY REPRESENTS THE RESULTS OF A SURVEY MADE ON DATE OF SURVEY, BY ME OR UNDER MY DIRECT SUPERVISION AND THAT ALL MONUMENTS EXIST AS SHOWN HEREON; THAT MATHEMATICAL CLOSURE ERRORS ARE LESS THAN 1:10,000; AND THAT SAID PLAT HAS BEEN PREPARED IN FULL COMPLIANCE WITH ALL APPLICABLE LAWS OF THE STATE OF COLORADO DEALING WITH MONUMENTS, SUBDIVISION, OR SURVEYING OF LAND AND ALL APPLICABLE PROVISION OF THE EL PASO COUNTY LAND DEVELOPMENT CODED.

I ATTEST THE ABOVE ON THIS _____ DAY OF _____, 20__

DOUGLAS P. REINELT, PROFESSIONAL LAND SURVEYOR DATE
P.L.S. NO. 30118
FOR AND ON BEHALF OF CLASSIC CONSULTING,
ENGINEERS AND SURVEYORS, LLC.

NOTICE:

ACCORDING TO COLORADO LAW YOU MUST COMMENCE ANY LEGAL ACTION BASED UPON ANY DEFECT IN THIS SURVEY WITHIN THREE YEARS AFTER YOU FIRST DISCOVER SUCH DEFECT. IN NO EVENT, MAY ANY ACTION BASED UPON ANY DEFECT IN THIS SURVEY BE COMMENCED MORE THAN TEN YEARS FROM THE DATE OF THE CERTIFICATION SHOWN HEREON.

BOARD OF COUNTY COMMISSIONERS CERTIFICATE

THIS PLAT FOR HANNAH RIDGE AT FEATHERGRASS FILING NO. 7 WAS APPROVED FOR FILING BY THE EL PASO COUNTY, COLORADO BOARD OF COUNTY COMMISSIONERS ON THIS _____ DAY OF _____, 20__ SUBJECT TO ANY NOTES SPECIFIED HEREON AND ANY CONDITIONS INCLUDED IN THE RESOLUTION OF APPROVAL. THE DEDICATIONS OF LAND TO THE PUBLIC (STREETS AND EASEMENTS) ARE ACCEPTED, BUT PUBLIC IMPROVEMENTS THEREON WILL NOT BECOME MAINTENANCE RESPONSIBILITY OF EL PASO COUNTY UNTIL PRELIMINARY ACCEPTANCE OF THE PUBLIC IMPROVEMENTS IN ACCORDANCE WITH THE REQUIREMENTS OF THE LAND DEVELOPMENT CODE AND ENGINEERING CRITERIA MANUAL, AND THE SUBDIVISION IMPROVEMENTS AGREEMENT.

CHAIR, BOARD OF COUNTY COMMISSIONERS DATE

DIRECTOR OF PLANNING AND COMMUNITY DEVELOPMENT DEPARTMENT DATE

COUNTY ASSESSOR DATE

CLERK AND RECORDER:

STATE OF COLORADO)
COUNTY OF EL PASO)
I HEREBY CERTIFY THAT THIS INSTRUMENT WAS FILED FOR RECORD IN MY OFFICE AT O'CLOCK __M. THIS _____ DAY OF _____, 20__, A.D., AND IS DULY RECORDED AT RECEPTION NO. _____ OF THE RECORDS OF EL PASO COUNTY, COLORADO.

CHUCK BROERMAN, RECORDER

BY: _____
DEPUTY

DRAINAGE: SANDCREEK BASIN

BRIDGE FEES: SANDCREEK BASIN

URBAN PARK: _____

REGIONAL PARK: _____

SCHOOL FEE: DISTRICT 11

PRELIMINARY
THIS DOCUMENT HAS NOT BEEN
PLAT CHECKED

HANNAH RIDGE AT FEATHERGRASS
FILING NO. 7
JOB NO. 1116.07
OCTOBER 4, 2018
SHEET 1 OF 3

OWNER:
FEATHERGRASS INVESTMENTS, LLC
4715 NORTH CHESTNUT STREET,
SUITE 200
COLORADO SPRINGS, CO 80907



619 N. Cascade Avenue, Suite 200 (719)785-0790
Colorado Springs, Colorado 80903 (719)785-0799 (Fax)

NO.	REVISION	DATE
1	COUNTY COMMENTS	12-17-18
2	BOUNDARY REVISIONS	12-17-18

KNOW ALL MEN BY THESE PRESENTS:
THAT FEATHERGRASS INVESTMENTS, LLC A COLORADO LIMITED LIABILITY COMPANY
BEING THE OWNER OF THE FOLLOWING DESCRIBED TRACT OF LAND TO WIT:

LEGAL DESCRIPTION:
TRACT KK AND LL AS PLATTED IN HANNAH RIDGE AT FEATHERGRASS FILING NO. 1 RECORDED UNDER RECEPTION NO. 214713468, RECORDS OF EL PASO COUNTY, COLORADO, AS CORRECTED BY AFFIDAVIT OF CORRECTION RECORDED AT RECEPTION NO. 214061663 AND CLARIFIED BY AFFIDAVIT OF CLARIFICATION RECORDED AT RECEPTION NO. 214081923 AND AFFIDAVIT OF CORRECTION RECORDED UNDER RECEPTION NO. 21805396 AND AFFIDAVIT OF CORRECTION RECORDED UNDER RECEPTION NO. 218091255 BEING A PORTION OF SECTION 32, TOWNSHIP 13 SOUTH, RANGE 65 WEST OF THE SIXTH PRINCIPAL MERIDIAN, EL PASO COUNTY, COLORADO.

CONTAINING A CALCULATED AREA OF 21.655 ACRES.

OWNERS CERTIFICATE:
THE UNDERSIGNED, BEING ALL THE OWNERS, MORTGAGEES, BENEFICIARIES OF DEEDS OF TRUST AND HOLDERS OF OTHER INTERESTS IN THE LAND DESCRIBED HEREIN, HAVE LAID OUT, SUBDIVIDED, AND PLATTED SAID LANDS INTO LOTS, TRACTS, STREETS, AND EASEMENTS AS SHOWN HEREON UNDER THE NAME AND SUBDIVISION OF HANNAH RIDGE AT FEATHERGRASS FILING NO. 7. ALL PUBLIC IMPROVEMENTS SO PLATTED ARE HEREBY DEDICATED TO PUBLIC USE AND SAID OWNER DOES HEREBY COVENANT AND AGREE THAT THE PUBLIC IMPROVEMENTS WILL BE CONSTRUCTED TO EL PASO COUNTY STANDARDS AND THAT PROPER DRAINAGE AND EROSION CONTROL FOR SAME WILL BE PROVIDED AT SAID OWNER'S EXPENSE, ALL TO THE SATISFACTION OF THE BOARD OF COUNTY COMMISSIONERS OF EL PASO COUNTY, COLORADO. UPON ACCEPTANCE BY RESOLUTION, ALL PUBLIC IMPROVEMENTS SO DEDICATED WILL BECOME MATTERS OF MAINTENANCE BY EL PASO COUNTY, COLORADO. THE UTILITY EASEMENTS SHOWN HEREON ARE HEREBY DEDICATED FOR PUBLIC UTILITIES AND COMMUNICATION SYSTEMS AND OTHER PURPOSES AS SHOWN HEREON. THE ENTITIES RESPONSIBLE FOR PROVIDING THE SERVICES FOR WHICH THE EASEMENTS ARE ESTABLISHED ARE HEREBY GRANTED THE PERPETUAL RIGHT OF INGRESS AND EGRESS FROM AND TO ADJACENT PROPERTIES FOR INSTALLATION, MAINTENANCE, AND REPLACEMENT OF UTILITY LINES AND RELATED FACILITIES.

OWNER:
THE AFOREMENTIONED, FEATHERGRASS INVESTMENTS, LLC A COLORADO LIMITED LIABILITY COMPANY HAS EXECUTED THIS INSTRUMENT THIS ___ DAY OF _____, 20__
WITNESS MY HAND AND OFFICIAL SEAL.

AS _____
OF FEATHERGRASS INVESTMENTS, LLC A COLORADO LIMITED LIABILITY COMPANY
STATE OF COLORADO)
COUNTY OF EL PASO)
THE FOREGOING INSTRUMENT WAS ACKNOWLEDGED BEFORE ME THIS _____ DAY OF _____, 20__, A.D. BY _____
OF FEATHERGRASS INVESTMENTS, LLC A COLORADO LIMITED LIABILITY COMPANY
WITNESS MY HAND AND OFFICIAL SEAL.
MY COMMISSION EXPIRES: _____ NOTARY PUBLIC

ACCEPTANCE CERTIFICATE FOR TRACTS
THE DEDICATION OF TRACTS, PER TRACT TABLE, ARE HEREBY ACCEPTED FOR OWNERSHIP AND MAINTENANCE BY THE HANNAH RIDGE HOMEOWNER'S ASSOCIATION, INC.

BY: _____
AS _____
OF HANNAH RIDGE HOMEOWNER'S ASSOCIATION, INC.
STATE OF COLORADO)
COUNTY OF EL PASO)
THE FOREGOING INSTRUMENT WAS ACKNOWLEDGED BEFORE ME THIS _____ DAY OF _____, 20__, A.D. BY _____
OF HANNAH RIDGE HOMEOWNERS ASSOCIATION, INC.
WITNESS MY HAND AND OFFICIAL SEAL.
MY COMMISSION EXPIRES: _____ NOTARY PUBLIC

GENERAL NOTES (CONT.):

- THIS PLAT IS REGULATED BY A P.U.D. DEVELOPMENT PLAN AS RECORDED UNDER RECEPTION NO. 208091457 AND P.U.D. DEVELOPMENT GUIDELINES AS RECORDED UNDER RECEPTION NO. 208091456 OF THE RECORDS OF EL PASO COUNTY AND AS AMENDED.
- MAILBOXES SHALL BE INSTALLED IN ACCORDANCE WITH ALL EL PASO COUNTY DEPARTMENT OF TRANSPORTATION AND UNITED STATES POSTAL SERVICE REGULATIONS.
- FIRE PROTECTION IS BY FALCON FIRE PROTECTION DISTRICT AND CIMARRON HILLS FIRE PROTECTION DISTRICT.
- THE HANNAH RIDGE HOMEOWNER'S ASSOCIATION, INC. SHALL MAINTAIN ALL IMPROVEMENTS LYING WITHIN MEDIANS, ISLANDS AND SIMILAR AREAS LYING WITHIN THE PLATTED RIGHT OF WAY.
- ANY PERSON WHO KNOWINGLY REMOVES, ALTERS OR DEFACES ANY PUBLIC LAND SURVEY MONUMENT OR LAND BOUNDARY MONUMENT OR ACCESSORY, COMMITS A CLASS TWO (2) MISDEMEANOR PURSUANT TO STATE STATUE 18-4-508, C.R.S.
- THIS PLAT DOES NOT CONSTITUTE A TITLE SEARCH TO DETERMINE OWNERSHIP OR EASEMENTS OF RECORD. FOR ALL INFORMATION REGARDING EASEMENTS, RIGHT-OF-WAY AND TITLE OF RECORD, CLASSIC CONSULTING ENGINEERS AND SURVEYORS AND THE SURVEYOR OF RECORD RELIED UPON THE TITLE COMMITMENT ORDER NUMBER 181499-AMENDMENT NO. 1 PREPARED BY CAPSTONE TITLE AS AGENT FOR STEWART TITLE GUARANTY, WITH AN EFFECTIVE DATE OF AUGUST 20, 2018 AT 8:00 A.M.
- PURSUANT TO RESOLUTION _____, APPROVED BY THE BOARD OF DIRECTORS, EL PASO COUNTY PUBLIC IMPROVEMENT DISTRICT AND RECORDED IN THE RECORDS OF THE EL PASO COUNTY CLERK AND RECORDER AT RECEPTION NO. _____ THE PARCELS WITHIN THE PLATTED BOUNDARIES OF HANNAH RIDGE AT FEATHERGRASS FILING NO. 7 ARE INCLUDED WITHIN THE BOUNDARIES OF THE EL PASO COUNTY PUBLIC IMPROVEMENT DISTRICT NO. 2 AND AS SUCH ARE SUBJECT TO APPLICABLE ROAD IMPACT FEES AND MILL LEVY.
- A DRIVEWAY PERMIT IS REQUIRED TO BE APPLIED FOR AND APPROVED BY EL PASO COUNTY DEVELOPMENT SERVICES DEPARTMENT PRIOR TO THE ESTABLISHMENT OF ANY DRIVEWAY.
- ALL PROPERTY OWNERS ARE RESPONSIBLE FOR MAINTAINING PROPER STORM WATER DRAINAGE IN AND THROUGH THEIR PROPERTY. PUBLIC DRAINAGE EASEMENTS AS SPECIFICALLY NOTED ON THE PLAT SHALL BE MAINTAINED BY THE INDIVIDUAL LOT OWNERS UNLESS OTHERWISE INDICATED. STRUCTURES, FENCES, MATERIALS OR LANDSCAPING THAT COULD IMPEDE THE FLOW OF RUNOFF SHALL NOT BE PLACED IN DRAINAGE EASEMENTS.
- INDIVIDUAL LOT PURCHASERS ARE RESPONSIBLE FOR CONSTRUCTING DRIVEWAYS, INCLUDING NECESSARY DRAINAGE CULVERTS PER LAND DEVELOPMENT CODE SECTION 6.3.3.C.2 AND 6.3.3.C.3.
- BASIS OF BEARINGS: A PORTION OF THE EASTERLY BOUNDARY OF HANNAH RIDGE AT FEATHERGRASS FILING NO. 1 BEING MONUMENTED AT THE BOTH ENDS BY A 1-1/2" ALUMINUM CAP STAMPED "PLS 27605", IS ASSUMED TO BEAR S00°21'33"W, A DISTANCE OF 1997.45 FEET.
- TRACT A IS FOR PARKS, OPEN SPACE, DRAINAGE AND PUBLIC UTILITIES AND WILL BE OWNED AND MAINTAINED BY THE HANNAH RIDGE HOMEOWNERS ASSOCIATION INC. OWNERSHIP OF SAID TRACT TO BE CONVEYED BY SEPARATE DOCUMENT.
- TRACT B IS FUTURE DEVELOPMENT AND WILL BE OWNED AND MAINTAINED BY THE OWNER OF RECORD.
- ALL EASEMENTS SHOWN OR DEDICATED HEREON FOR PUBLIC UTILITY PURPOSES SHALL BE SUBJECT TO THOSE TERMS AND CONDITIONS AS SPECIFIED IN THE INSTRUMENT RECORDED AT RECEPTION NO. 212112548 OF THE RECORDS OF EL PASO COUNTY, COLORADO. ALL OTHER EASEMENTS OR INTERESTS OF RECORD AFFECTING ANY OF THE PLATTED PROPERTY DEPICTED HEREON SHALL NOT BE AFFECTED AND SHALL REMAIN IN FULL FORCE AND EFFECT.
- ALL LOTS WITHIN THIS SUBDIVISION ARE SUBJECT TO AN AVIGATION EASEMENT TO THE UNITED STATES AIR FORCE ACADEMY AS RECORDED UNDER RECEPTION NO. 214022684 IN THE OFFICE OF THE CLERK AND RECORDER OF EL PASO COUNTY, COLORADO.
- UTILITY PROVIDERS:
SANITARY SEWER: CHEROKEE METROPOLITAN DISTRICT
WATER: CHEROKEE METROPOLITAN DISTRICT
ELECTRIC: MOUNTAIN VIEW ELECTRIC ASSOCIATION
- ALL PROPERTY WITHIN THIS SUBDIVISION IS INCLUDED IN THE CONSTITUTION HEIGHTS METROPOLITAN DISTRICT AS EVIDENCED BY INSTRUMENT RECORDED UNDER RECEPTION NO. 209112366.

Acceptance
Certificate for
Tracts (accepting
entity in
existence)

The dedication of
Tracts (list tracts
and use) are
hereby accepted
for ownership
and maintenance
by the (Name)
District/Homeow
ner's
Association.
(Name district or
homeowner's
association)

BY: (notarized
signature)

President
STATE OF
COLORADO)
SS.
COUNTY OF
()

Acknowledged
before me this
____ day of _____,
20__ by _____

____ as

My commission
expires:


Witness my hand
and official seal

Notary Public


HANNAH RIDGE AT FEATHERGRASS FILING NO. 7

A REPLAT OF TRACT KK AND TRACT LL OF HANNAH RIDGE AT FEATHERGRASS FILING NO. 1,
RECEPTION NO. 214713468, RECORDS OF EL PASO COUNTY, COLORADO
SECTION 32, TOWNSHIP 13 SOUTH, RANGE 65
WEST OF THE SIXTH PRINCIPAL MERIDIAN, EL PASO COUNTY, COLORADO

AS PLATTED

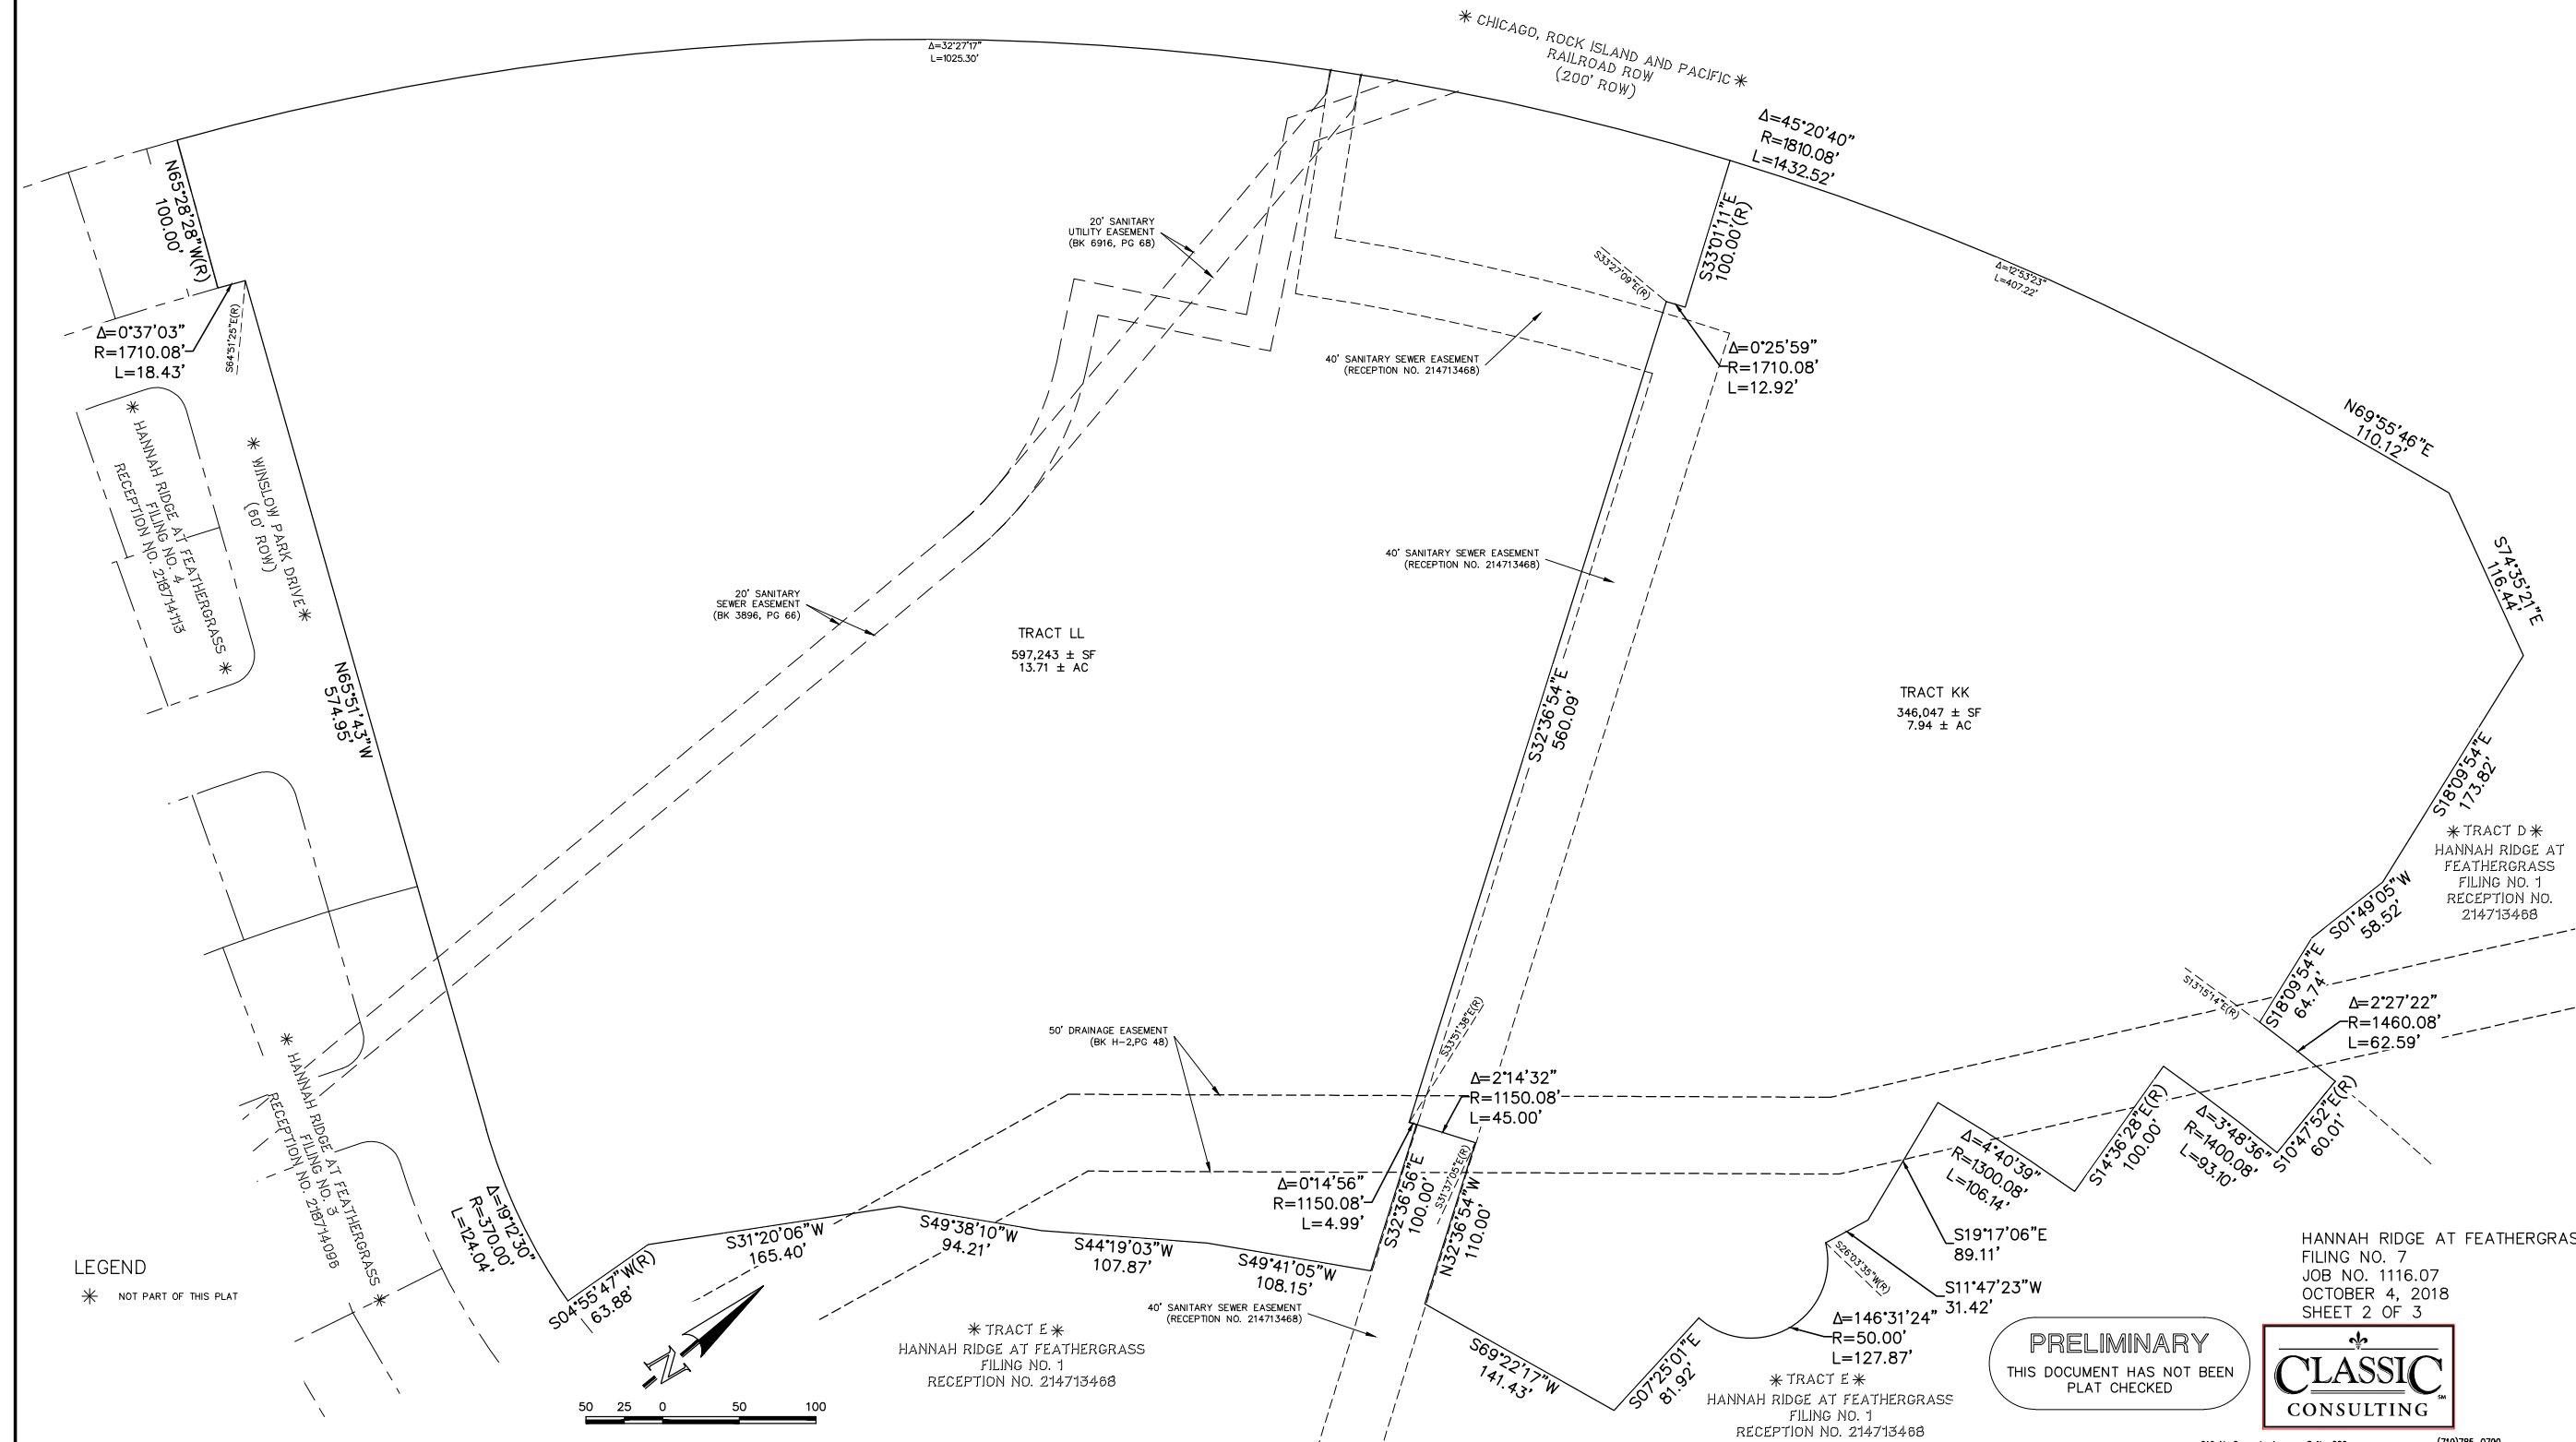

LEGEND
* NOT PART OF THIS PLAT

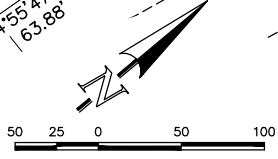

* TRACT E *
HANNAH RIDGE AT FEATHERGRASS
FILING NO. 1
RECEPTION NO. 214713468

* TRACT E *
HANNAH RIDGE AT FEATHERGRASS
FILING NO. 1
RECEPTION NO. 214713468

PRELIMINARY
THIS DOCUMENT HAS NOT BEEN
PLAT CHECKED





HANNAH RIDGE AT FEATHERGRASS
FILING NO. 7
JOB NO. 1116.07
OCTOBER 4, 2018
SHEET 2 OF 3

HANNAH RIDGE AT FEATHERGRASS FILING NO. 7

A REPLAT OF TRACT KK AND LL OF HANNAH RIDGE AT FEATHERGRASS FILING NO. 1, RECEPTION NO. 214713468, RECORDS OF EL PASO COUNTY, COLORADO SECTION 32, TOWNSHIP 13 SOUTH, RANGE 65 WEST OF THE SIXTH PRINCIPAL MERIDIAN, EL PASO COUNTY, COLORADO

AS REPLATTED

* CHICAGO, ROCK ISLAND AND PACIFIC *
RAILROAD ROW
(200' ROW)

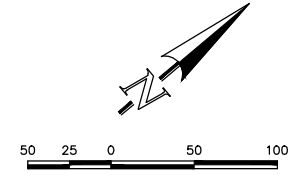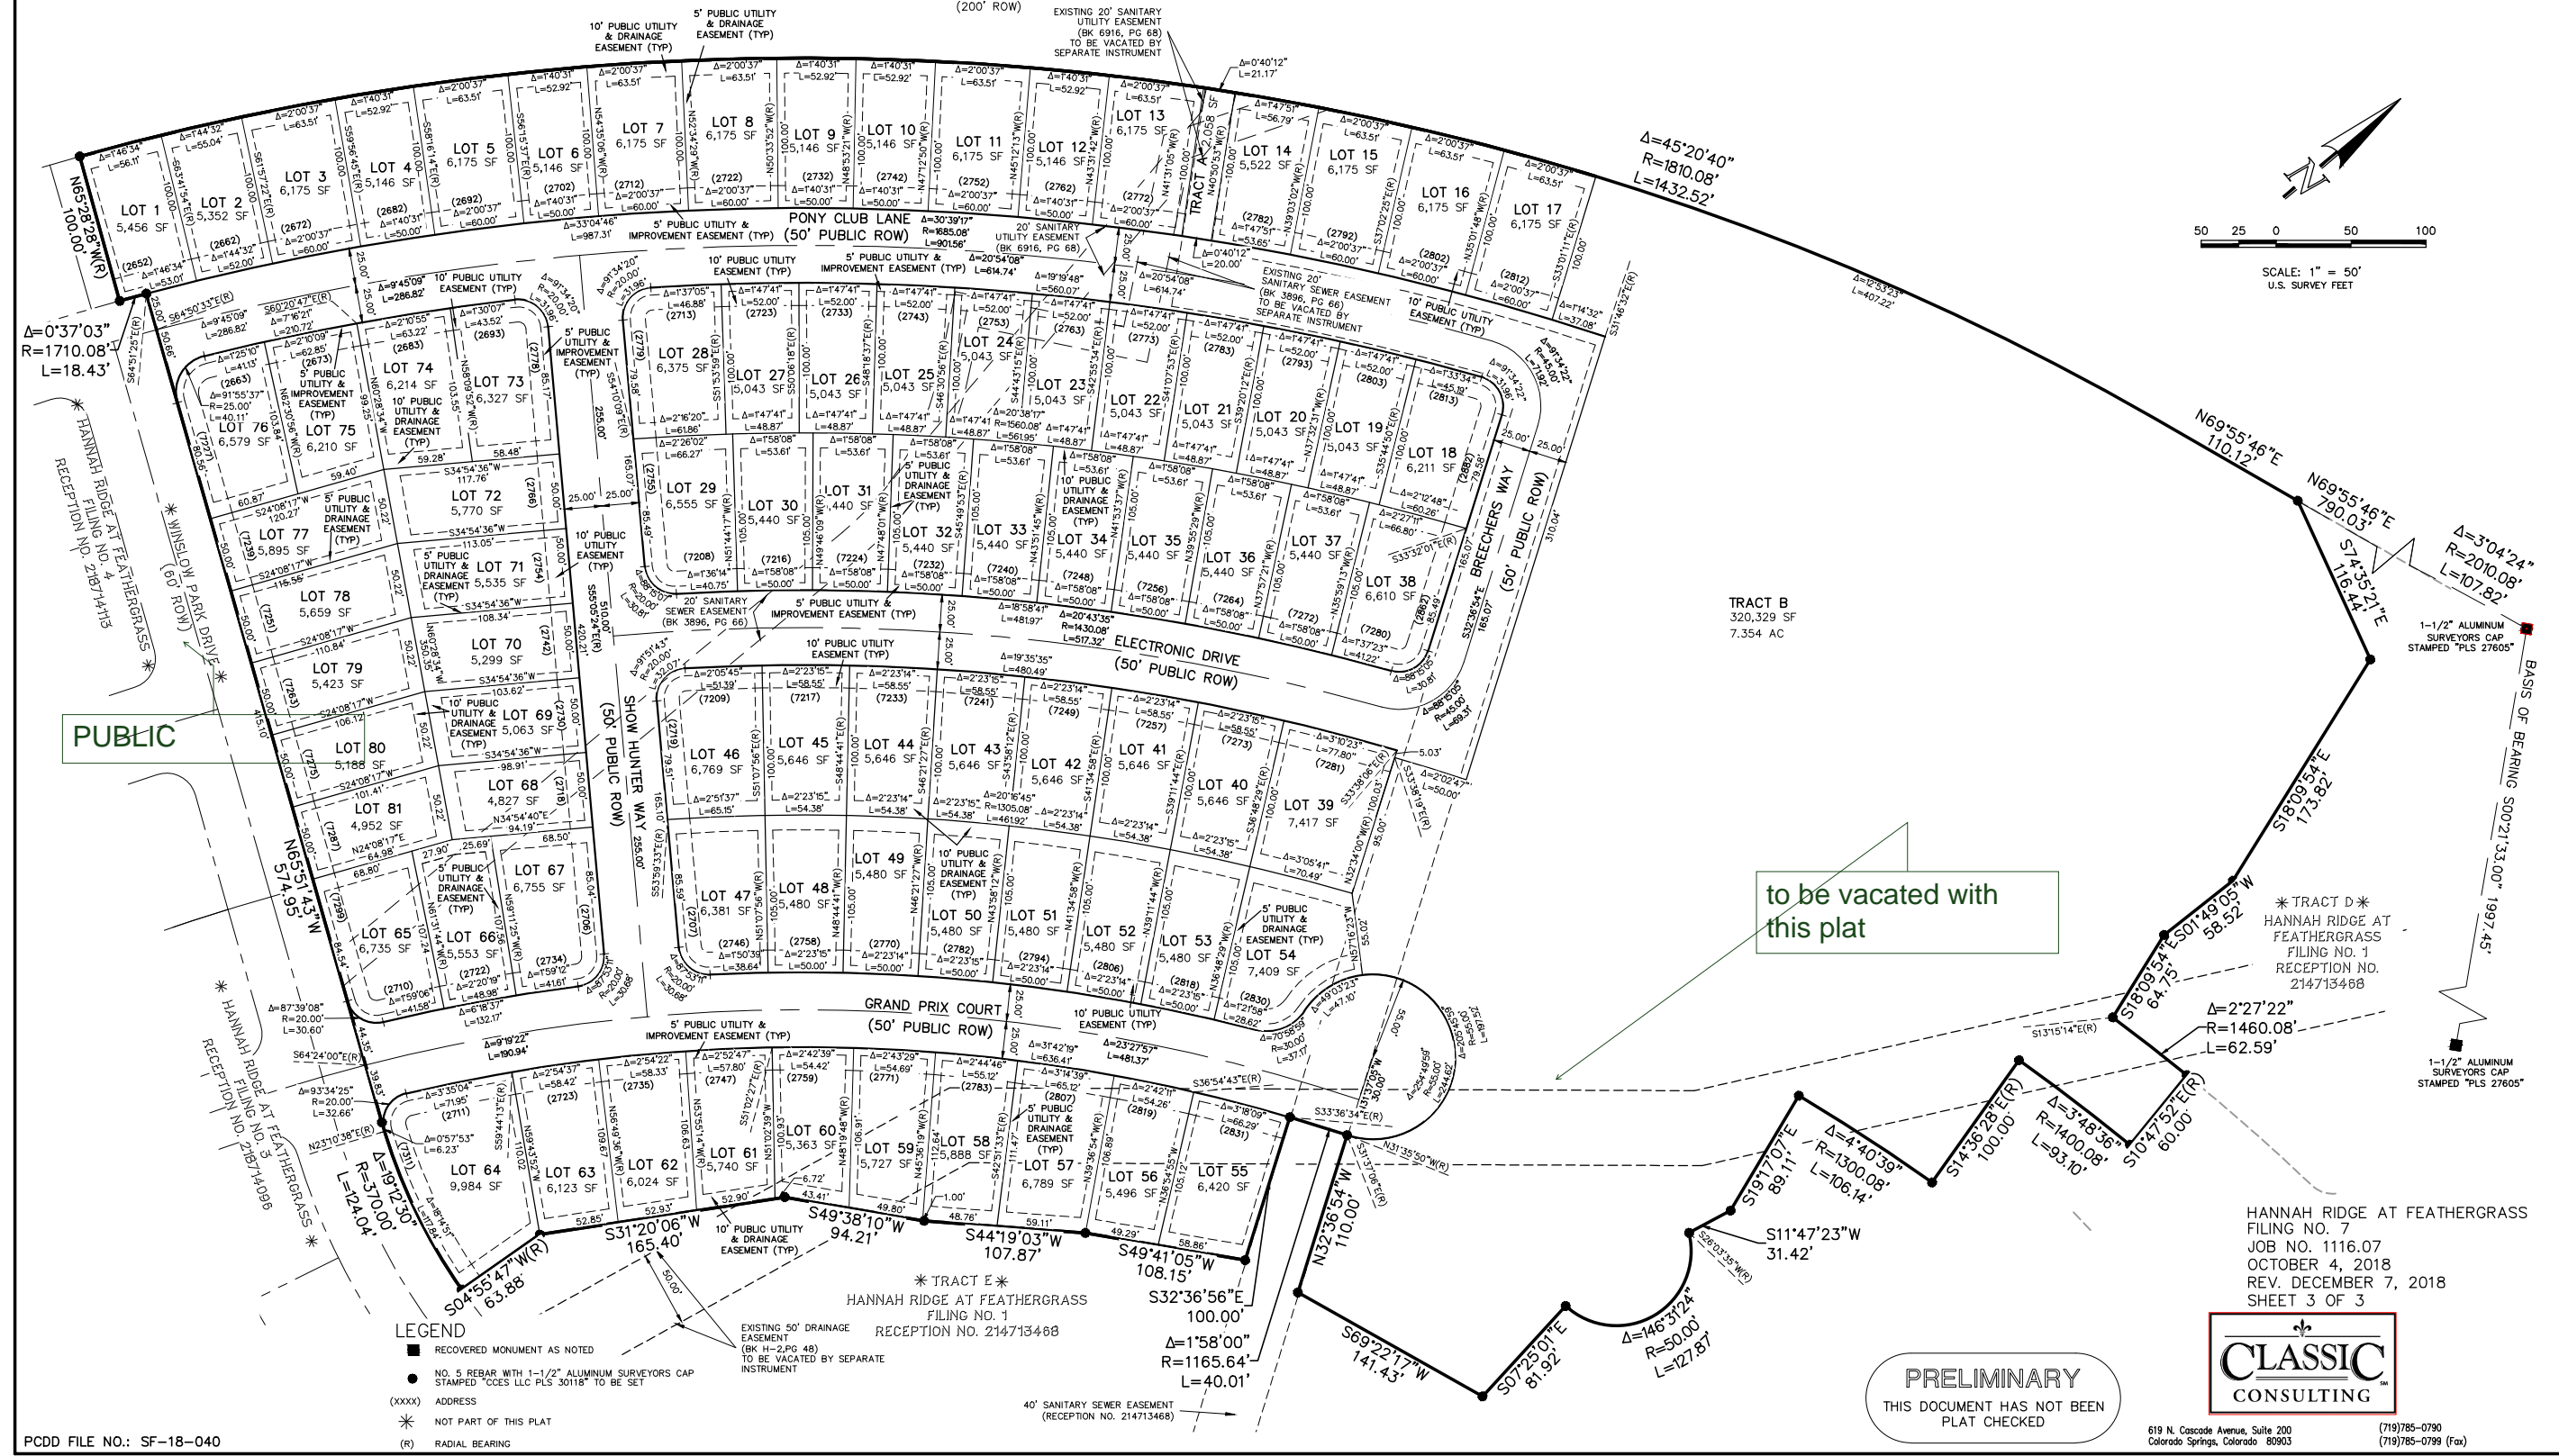

to be vacated with this plat

* TRACT D *
HANNAH RIDGE AT FEATHERGRASS FILING NO. 1 RECEPTION NO. 214713468

HANNAH RIDGE AT FEATHERGRASS FILING NO. 7
JOB NO. 1116.07
OCTOBER 4, 2018
REV. DECEMBER 7, 2018
SHEET 3 OF 3

- LEGEND**
- RECOVERED MONUMENT AS NOTED
 - NO. 5 REBAR WITH 1-1/2" ALUMINUM SURVEYORS CAP STAMPED "CCES LLC PLS 30118" TO BE SET
 - (XXXX) ADDRESS
 - * NOT PART OF THIS PLAT
 - (R) RADIAL BEARING
 - EXISTING 50' DRAINAGE EASEMENT (BK 11-2190 48) TO BE VACATED BY SEPARATE INSTRUMENT
 - 40' SANITARY SEWER EASEMENT (RECEPTION NO. 214713468)

PRELIMINARY
THIS DOCUMENT HAS NOT BEEN PLAT CHECKED



619 N. Cascade Avenue, Suite 200
Colorado Springs, Colorado 80903 (719)785-0790
(719)785-0799 (Fax)


Markup Summary

dsdparsons (6)




Subject: Callout
Page Label: 3
Author: dsdparsons
Date: 1/16/2019 12:34:13 PM
Color: ■

PUBLIC

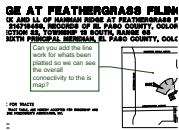

Subject: Callout
Page Label: 1
Author: dsdparsons
Date: 1/16/2019 12:35:24 PM
Color: ■

Can you add the line work for whats been platted so we can see the overall connectivity to the is map?

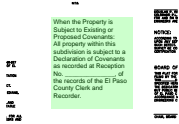

Subject: Covenants
Page Label: 1
Author: dsdparsons
Date: 1/16/2019 5:12:43 PM
Color: ■

When the Property is Subject to Existing or Proposed Covenants:
All property within this subdivision is subject to a Declaration of Covenants as recorded at Reception No. _____, of the records of the El Paso County Clerk and Recorder.



Subject: Tract Acceptance
Page Label: 1
Author: dsdparsons
Date: 1/16/2019 5:13:02 PM
Color: ■

Acceptance Certificate for Tracts (accepting entity in existence)

The dedication of Tracts (list tracts and use) are hereby accepted for ownership and maintenance by the (Name) District/Homeowner's Association. (Name district or homeowner's association)

BY: (notarized signature)

President
STATE OF COLORADO)
ss.
COUNTY OF _____)

Acknowledged before me this ____ day of _____, 20__ by _____ as _____.

My commission expires: _____
Witness my hand and official seal

Notary Public



Subject: Callout
Page Label: 3
Author: dsdparsons
Date: 1/16/2019 5:13:48 PM
Color: ■

to be vacated with this plat



Subject: Callout
Page Label: 1
Author: dsdparsons
Date: 1/16/2019 5:14:28 PM
Color: ■

verify legal with LOI, Application and Legal in word