


SCALE - 1" = 20'

4576 HENNINGS DR
65112-12-032
LOT 4 BLK 2
BRADLEY RANCH
FIL NO 2
SECURITY
PLAT 7506
RS-5000
CAD-0


23x17 carpor
8' high

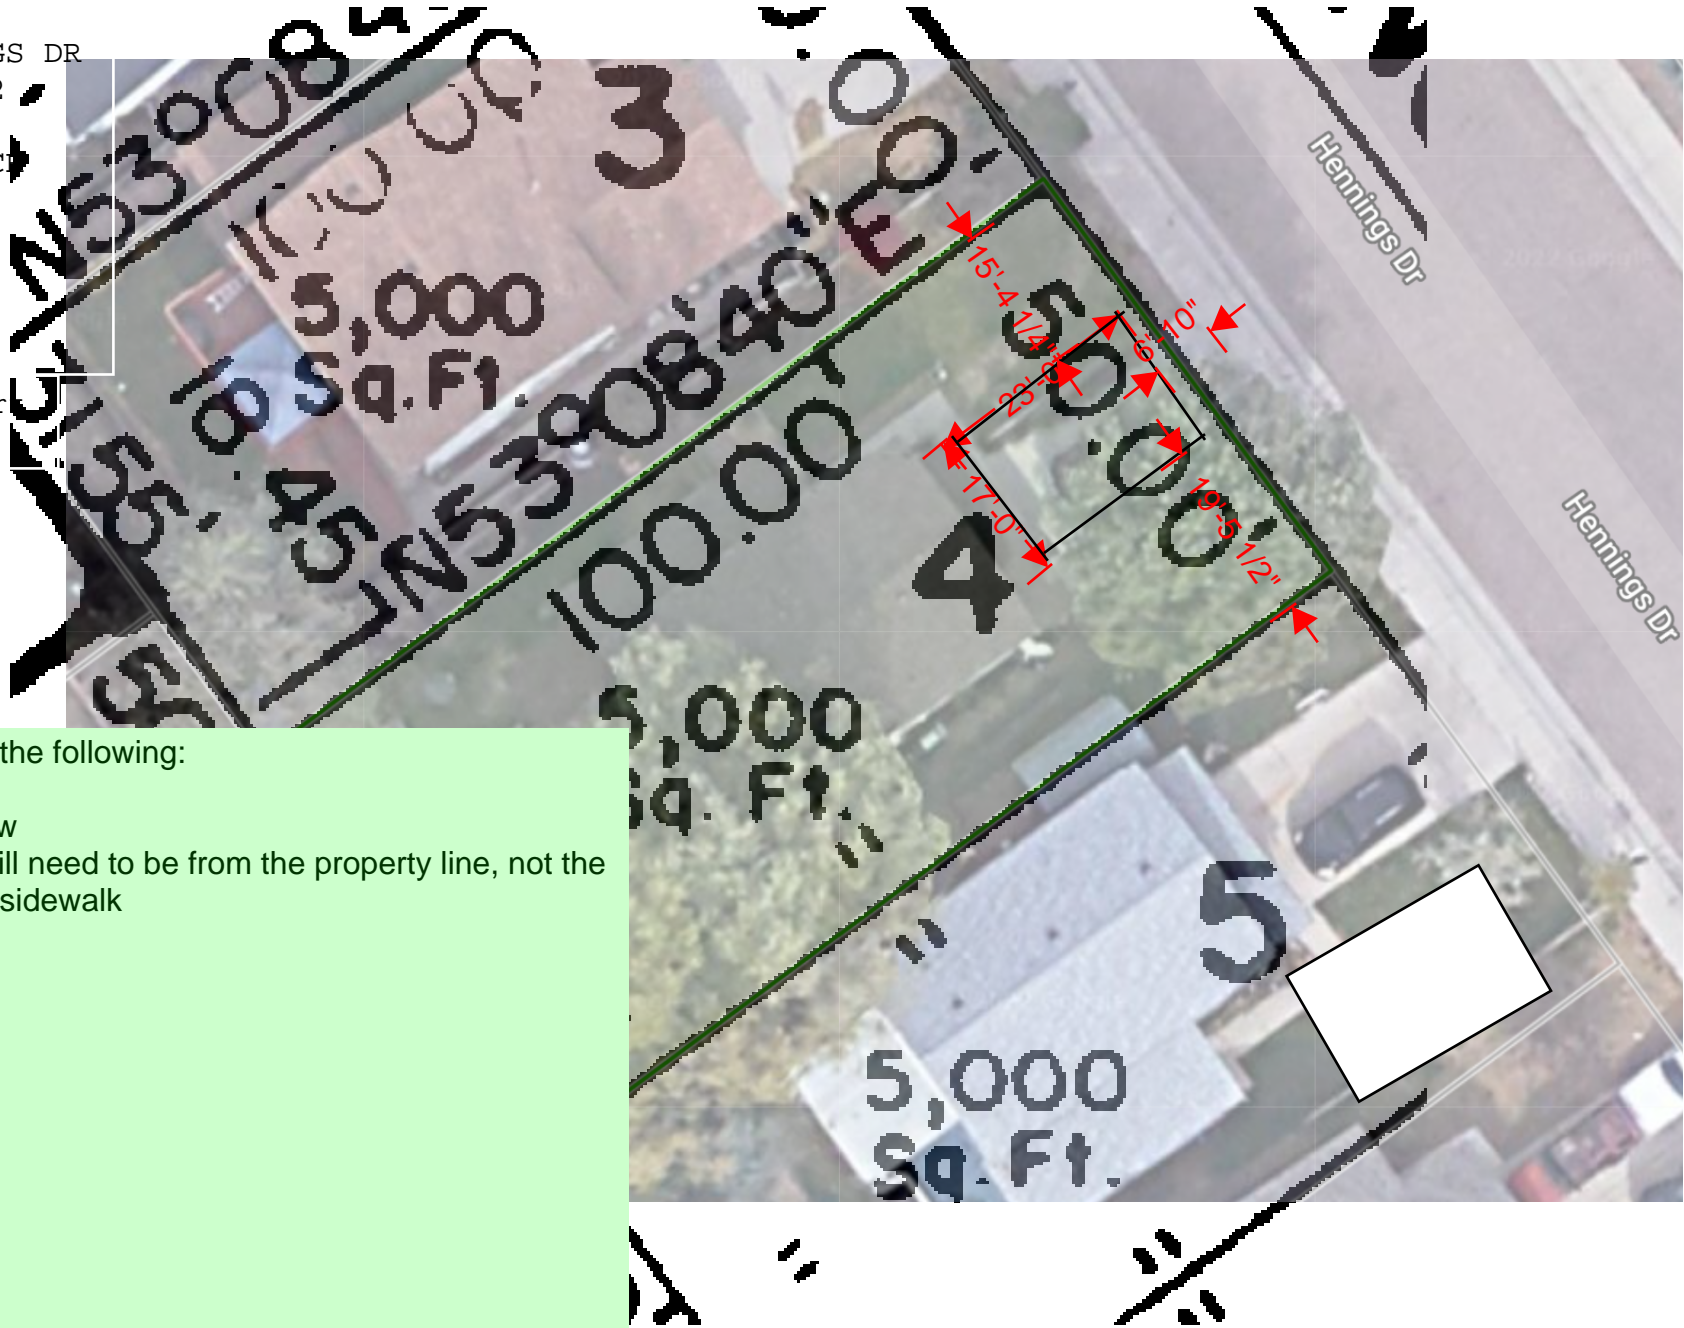

Please add the following:


- North arrow
- Setback will need to be from the property line, not the edge of the sidewalk

Site Plan

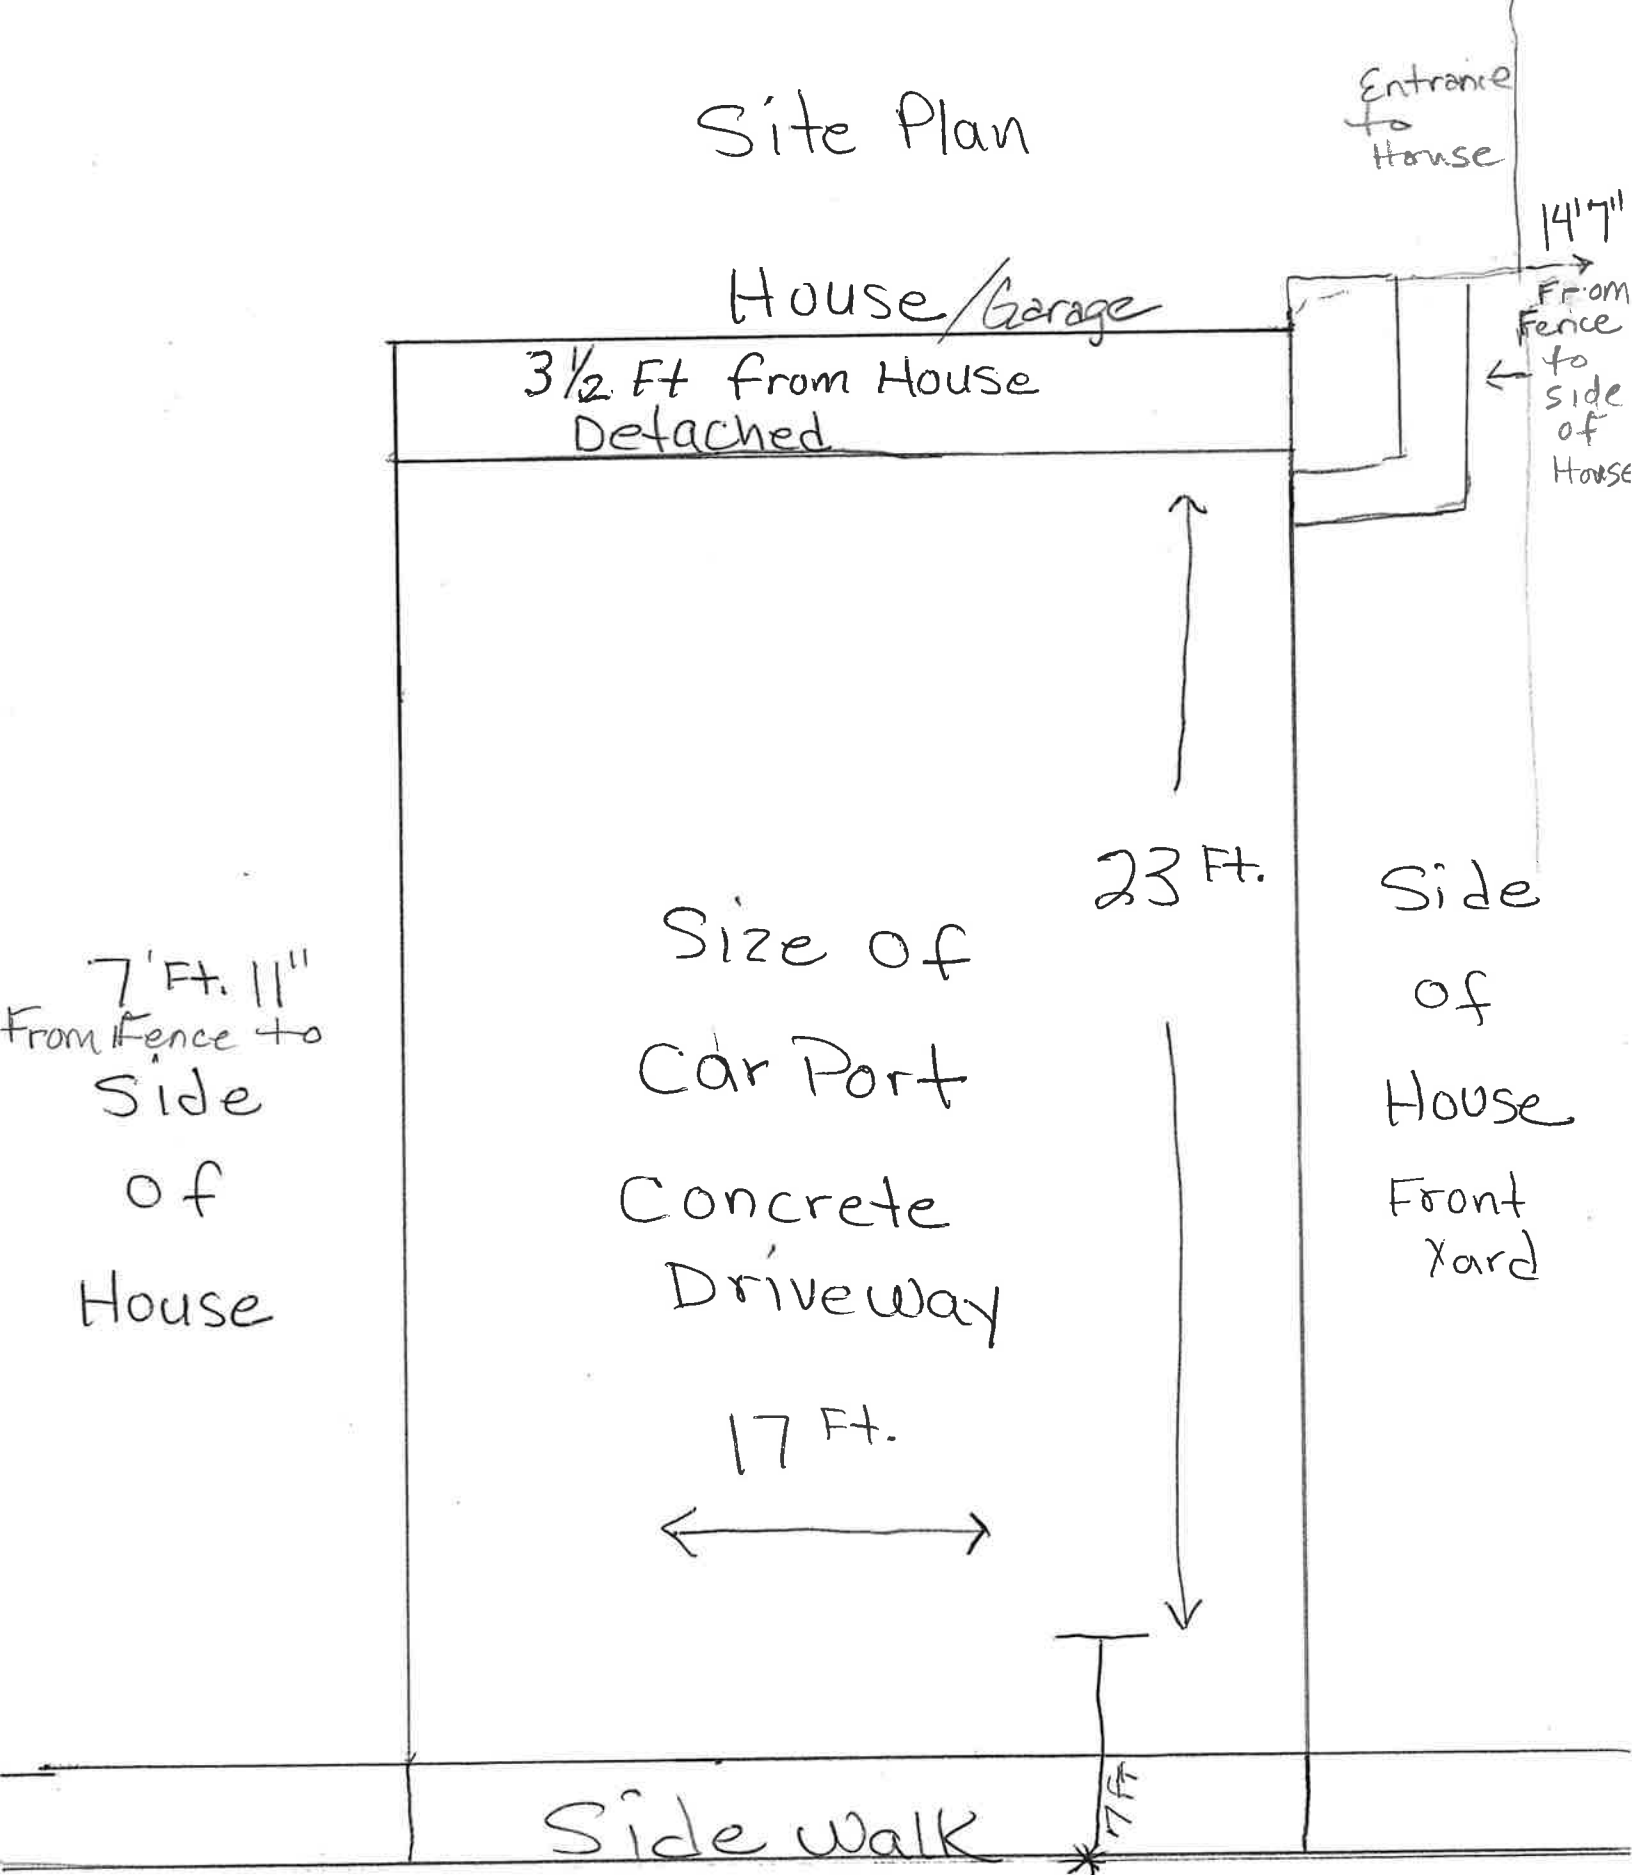


4576

Hennings DR. 80911

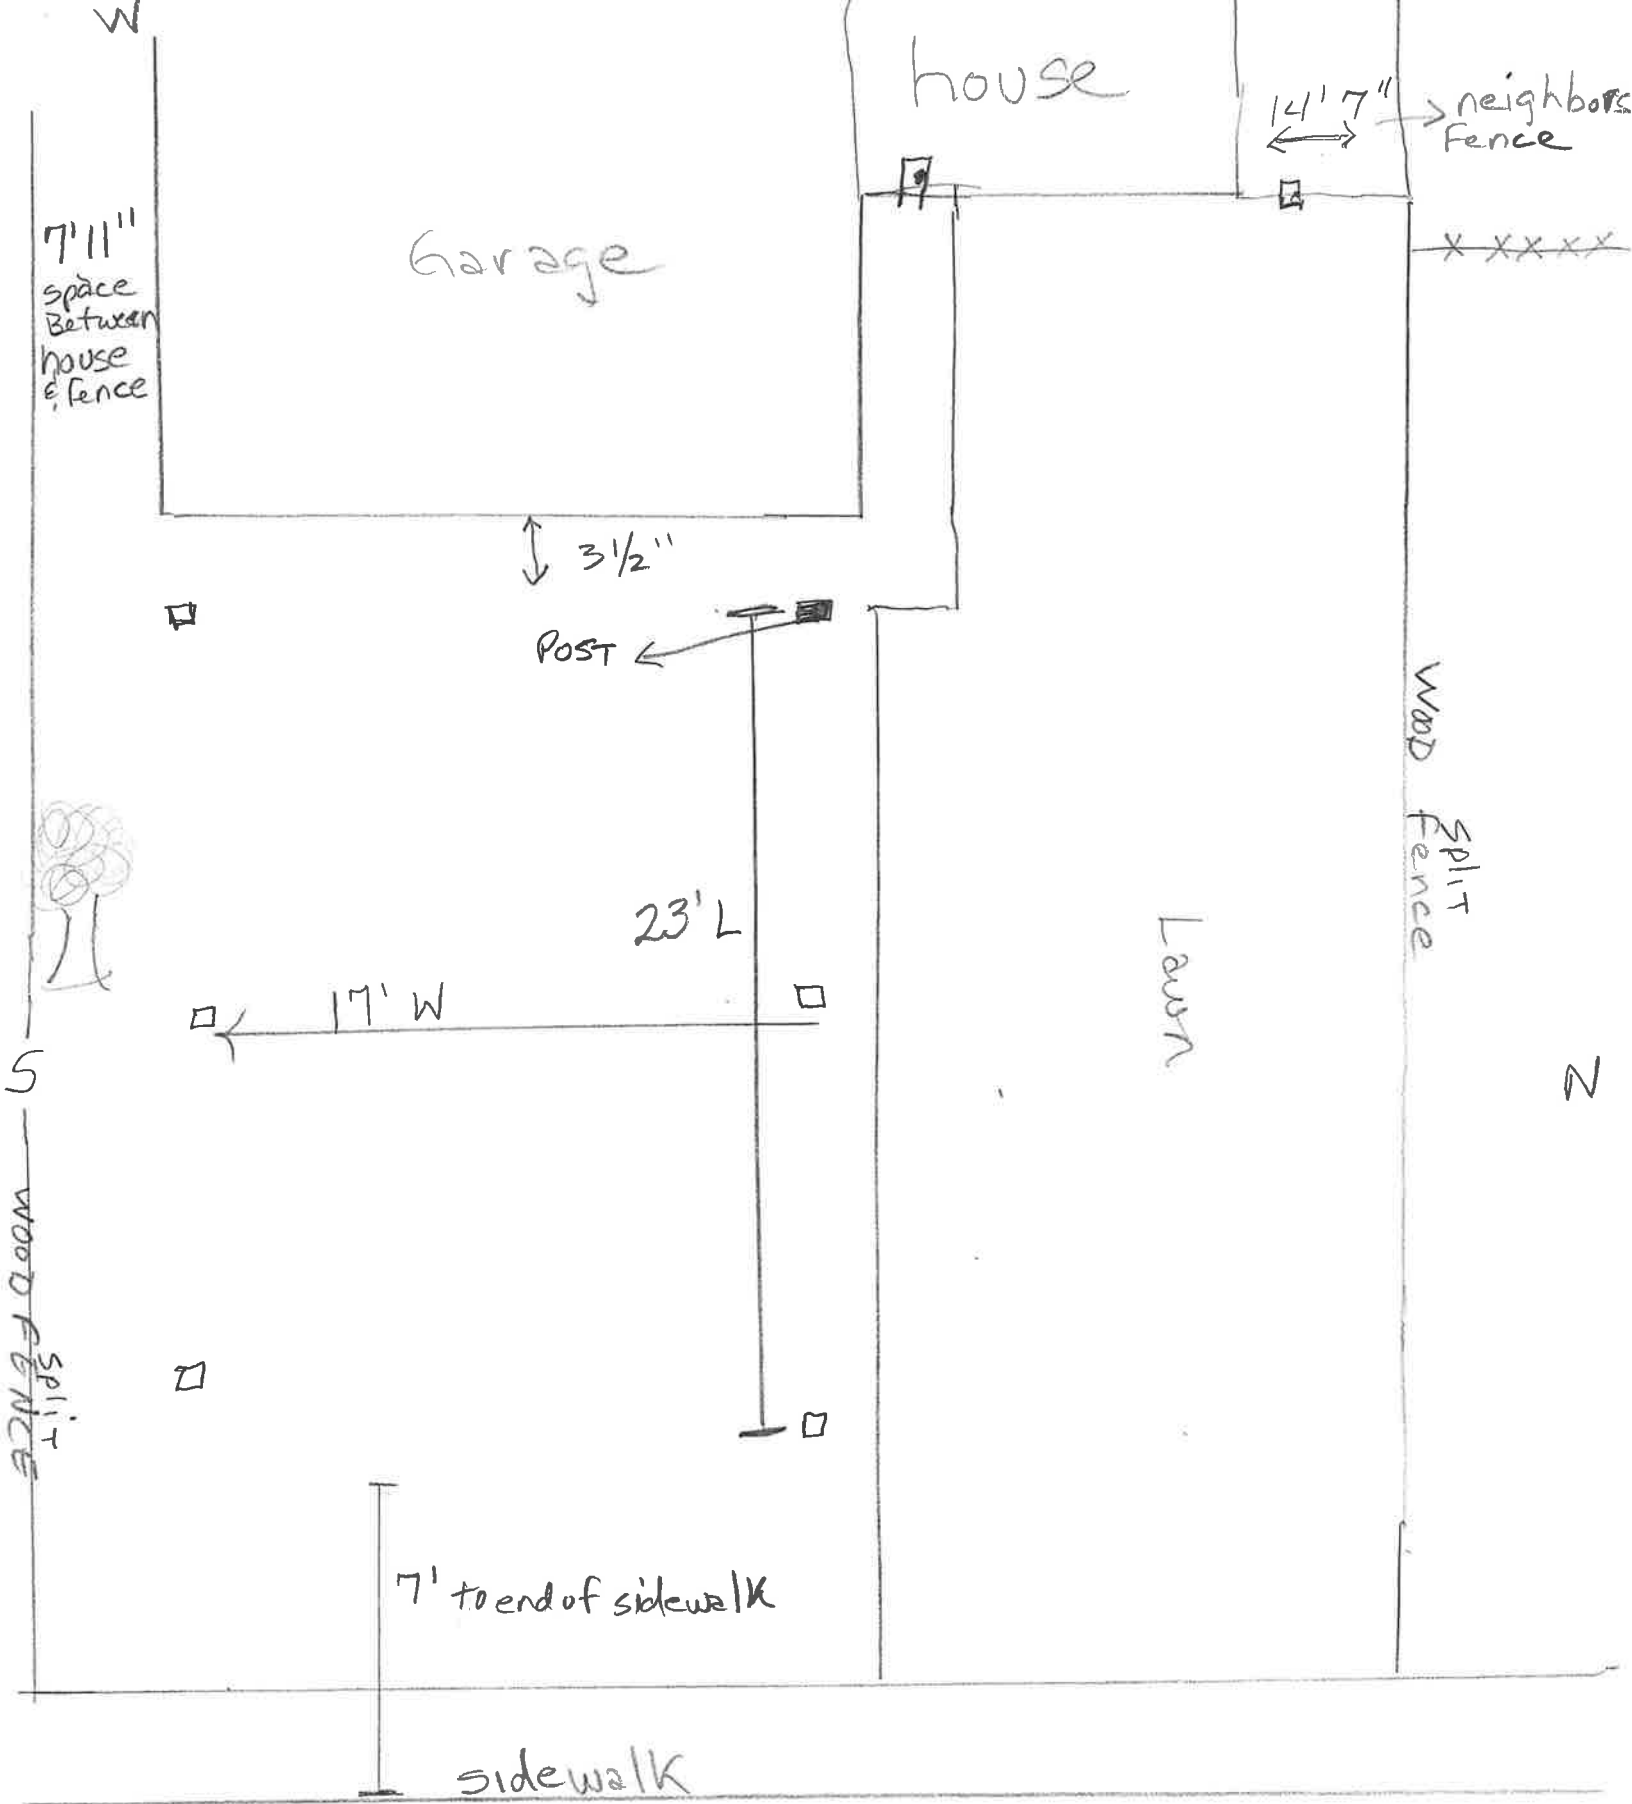

4576 Hennings Dr

E

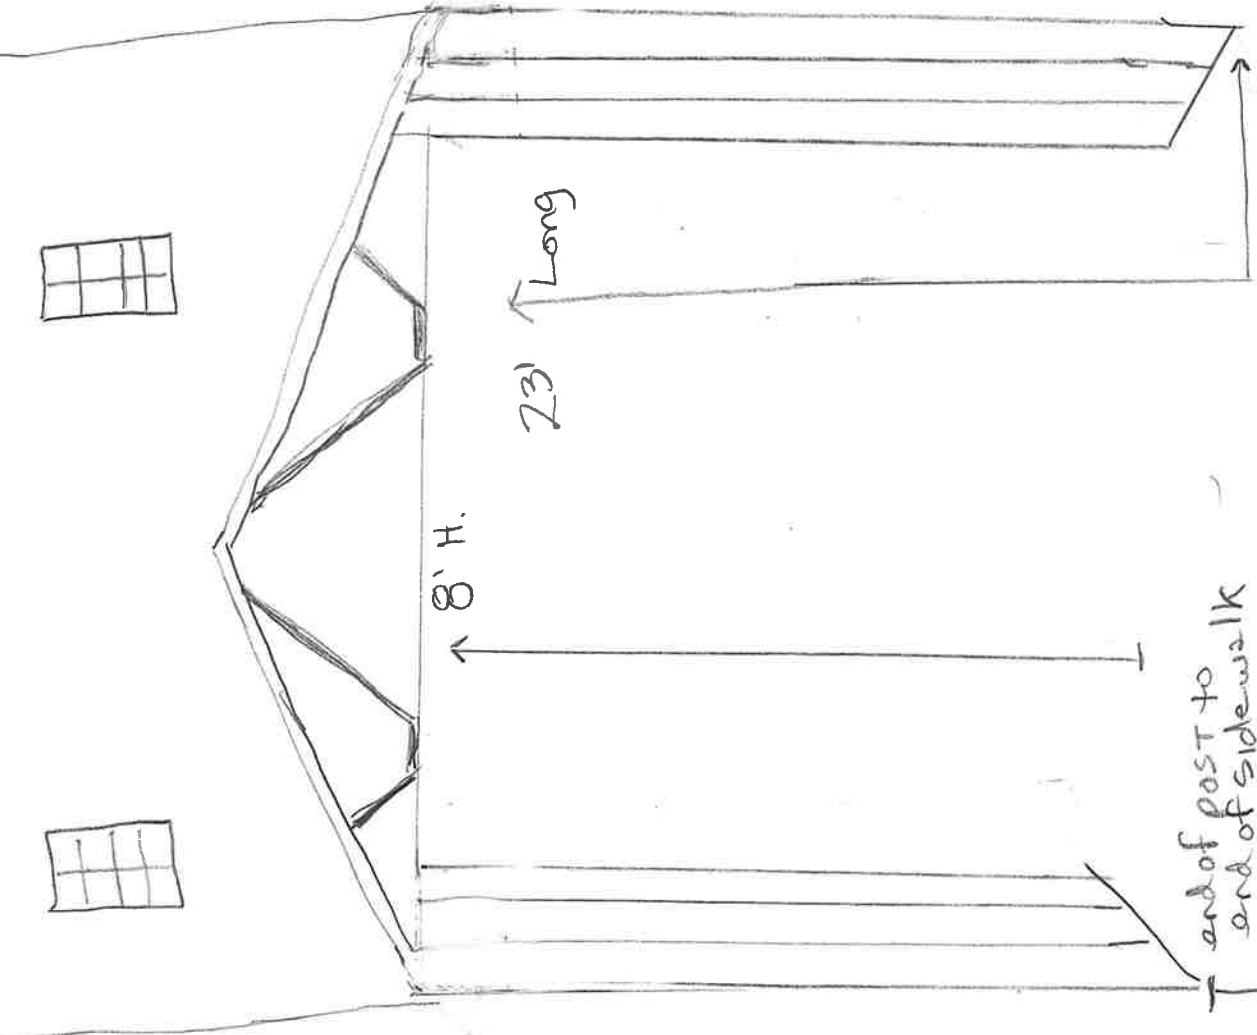

17' W x 23' L x 8' H

Proposed
Car port

sidewalk

4576 Hennings Dr.