

Hudnall Custom Builders, LLC

rick@hudnallhomes.com (719) 331-0286
3226 Hearthridge Circle Colo Spgs, CO 80918

Drawn by: Rick Hudnall
Date: 10/02/200

Moon Residence Carport


David & Margaret Moon
1663 Woodstone Way ✓
Monument, CO 80132

Lot 31, Woodmoor Oaks ✓
Tax Schedule #7111107034 ✓
Zoning: RR-0.5 PLAT 2523 ✓
Lot Area: 46,000 Square Feet ✓


ADD20893

Not Required
BESQCP
11/20/2020 10:11:53 AM
dsdyounger
EPC Planning & Community
Development Department



APPROVED
Plan Review
11/20/2020 10:12:02 AM
dsdyounger
EPC Planning & Community
Development Department

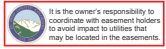

ANY APPROVAL GIVEN BY
EL PASO COUNTY
DOES NOT RELIEVE THE NEED
TO COMPLY WITH APPLICABLE
FEDERAL, STATE OR LOCAL
LAWS AND/OR REGULATION
Planning & Community Development Department
approval is contingent upon compliance with all
applicable rules on the record plan.
An access permit must be granted by the
Planning & Community Development Department
prior to the establishment of any driveway onto a
County road.
Division of disposal of any drainage way
is not permitted without approval of the
Planning & Community Development Department.

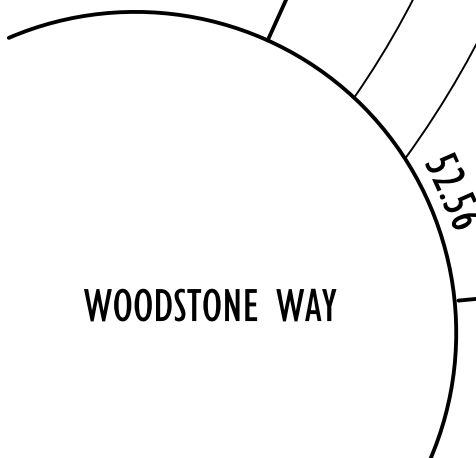

WOODSTONE WAY

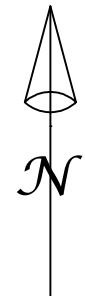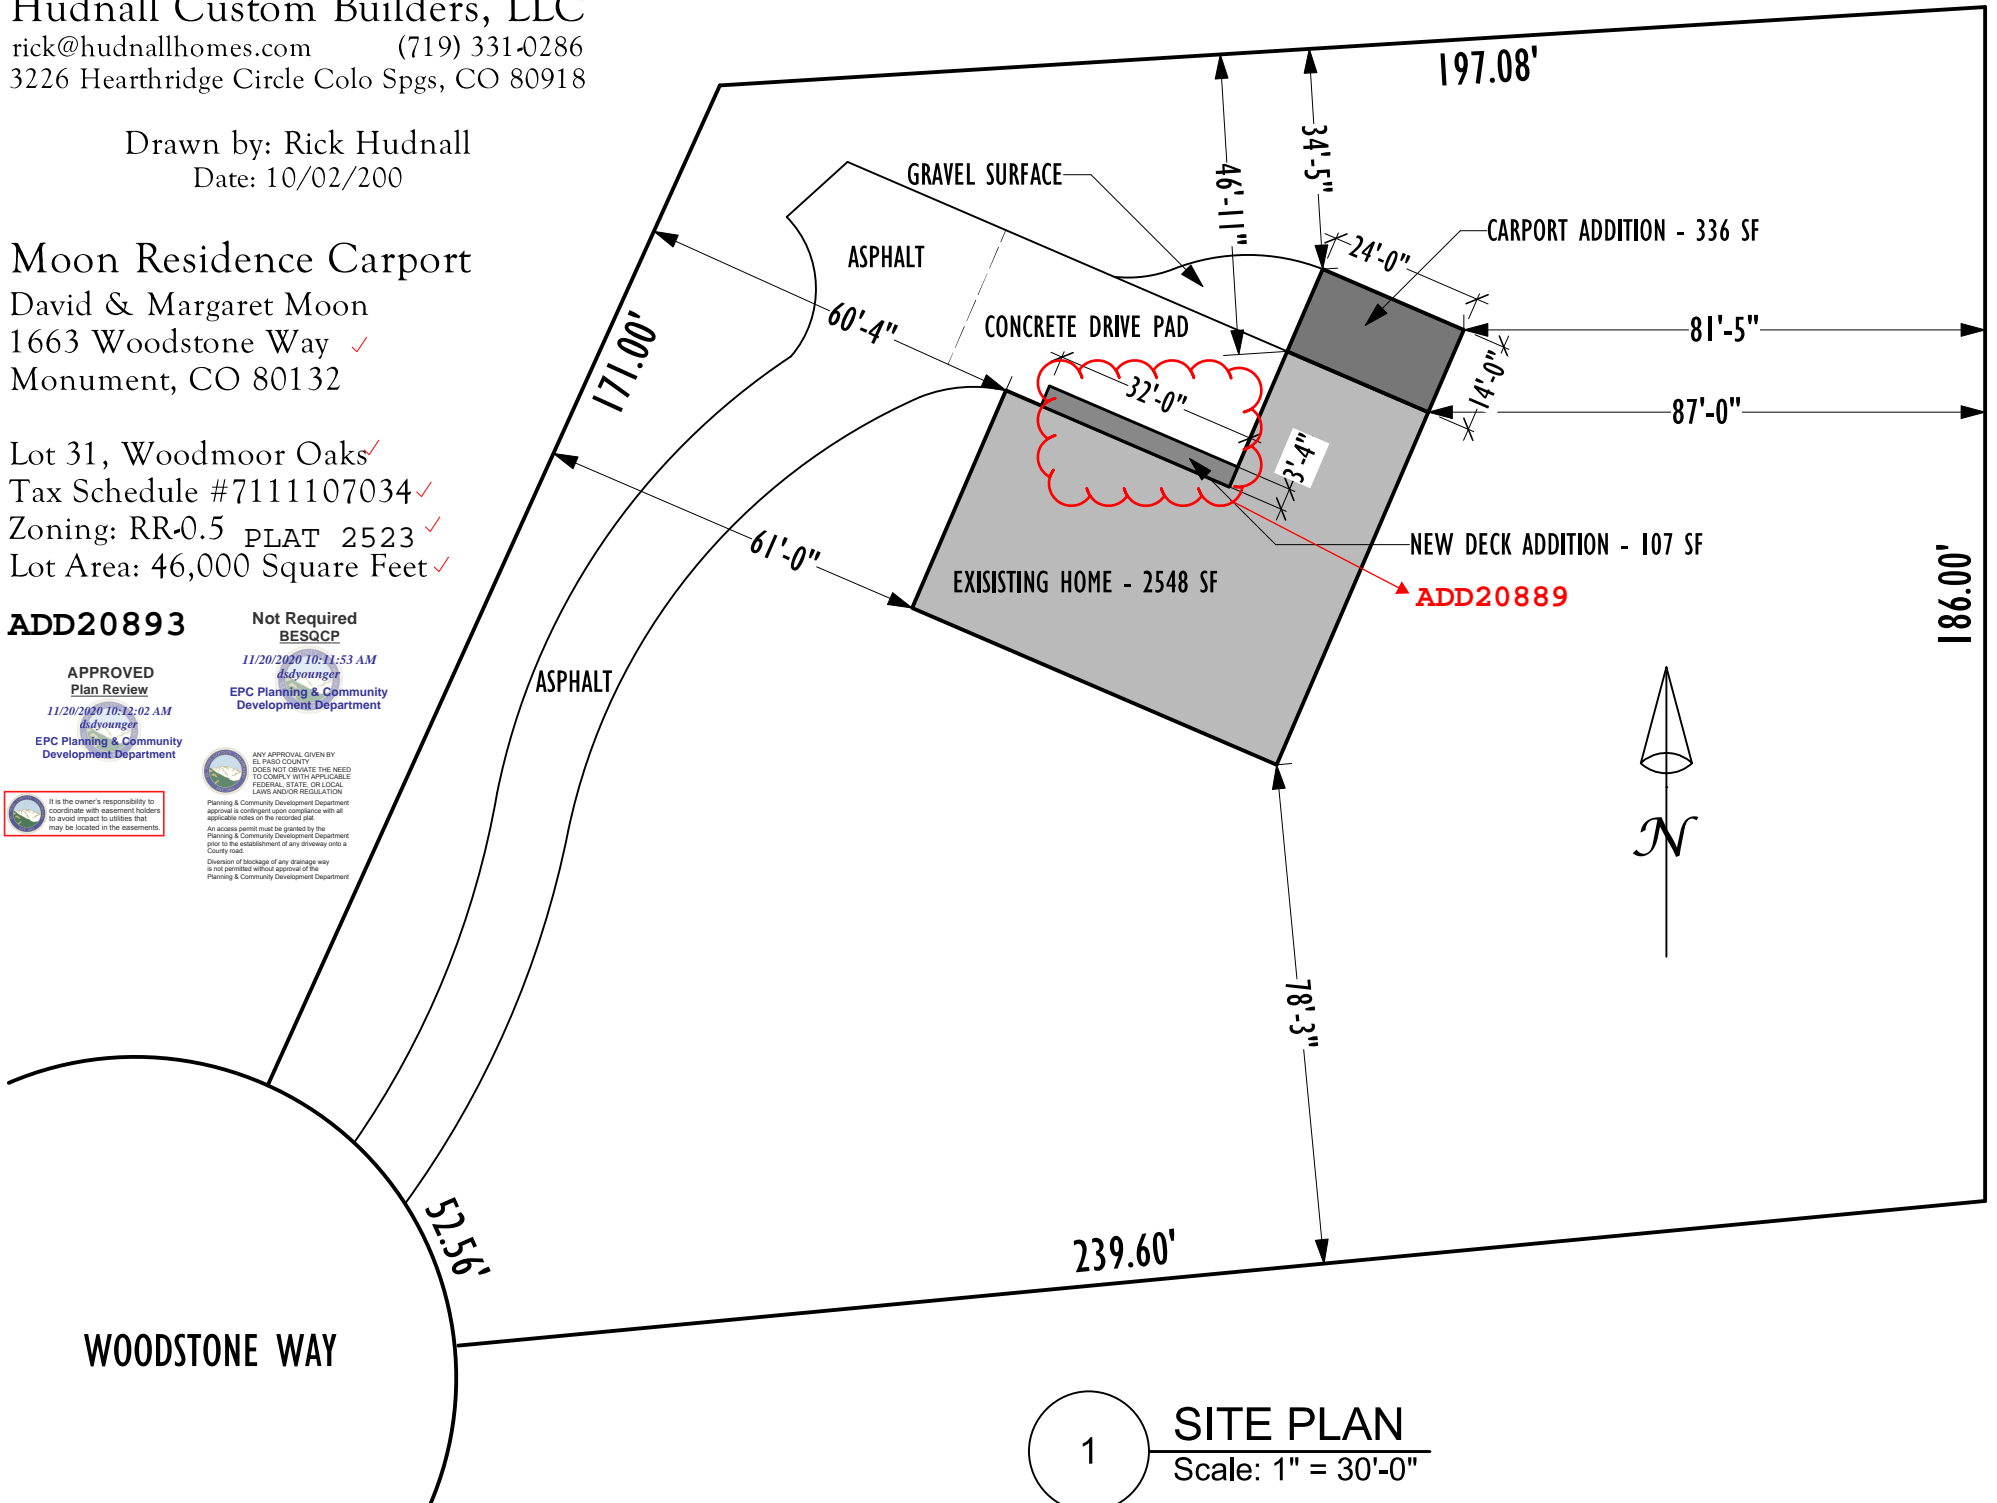

1 SITE PLAN
Scale: 1" = 30'-0"

RESIDENTIAL



2017 PPRBC

Address: 1663 WOODSTONE WAY, MONUMENT

Parcel: 7111107034

Plan Track #: 137290 

Received: 17-Nov-2020 (JANE)

Description:

CARPORT

Contractor: HUDNALL CUSTOM BUILDERS

Type of Unit:

Required PPRBD Departments (2)


Floodplain	Construction
(N/A) RBD GIS	

Required Outside Departments (1)

**County Zoning
APPROVED
Plan Review**

*11/20/2020 10:12:43 AM
dsdyounger*

**EPC Planning & Community
Development Department**



Release of this plan does not preclude compliance with all applicable codes, ordinances and other pertinent regulations. This plan set must be present on the job site for every inspection.