
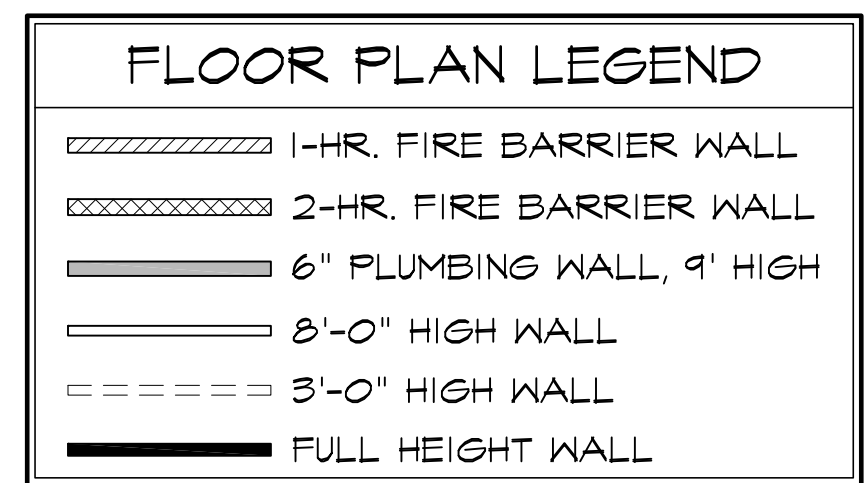


Show square footage per use.

1st FLOOR PLAN
SCALE: 1/8"=1'-0"

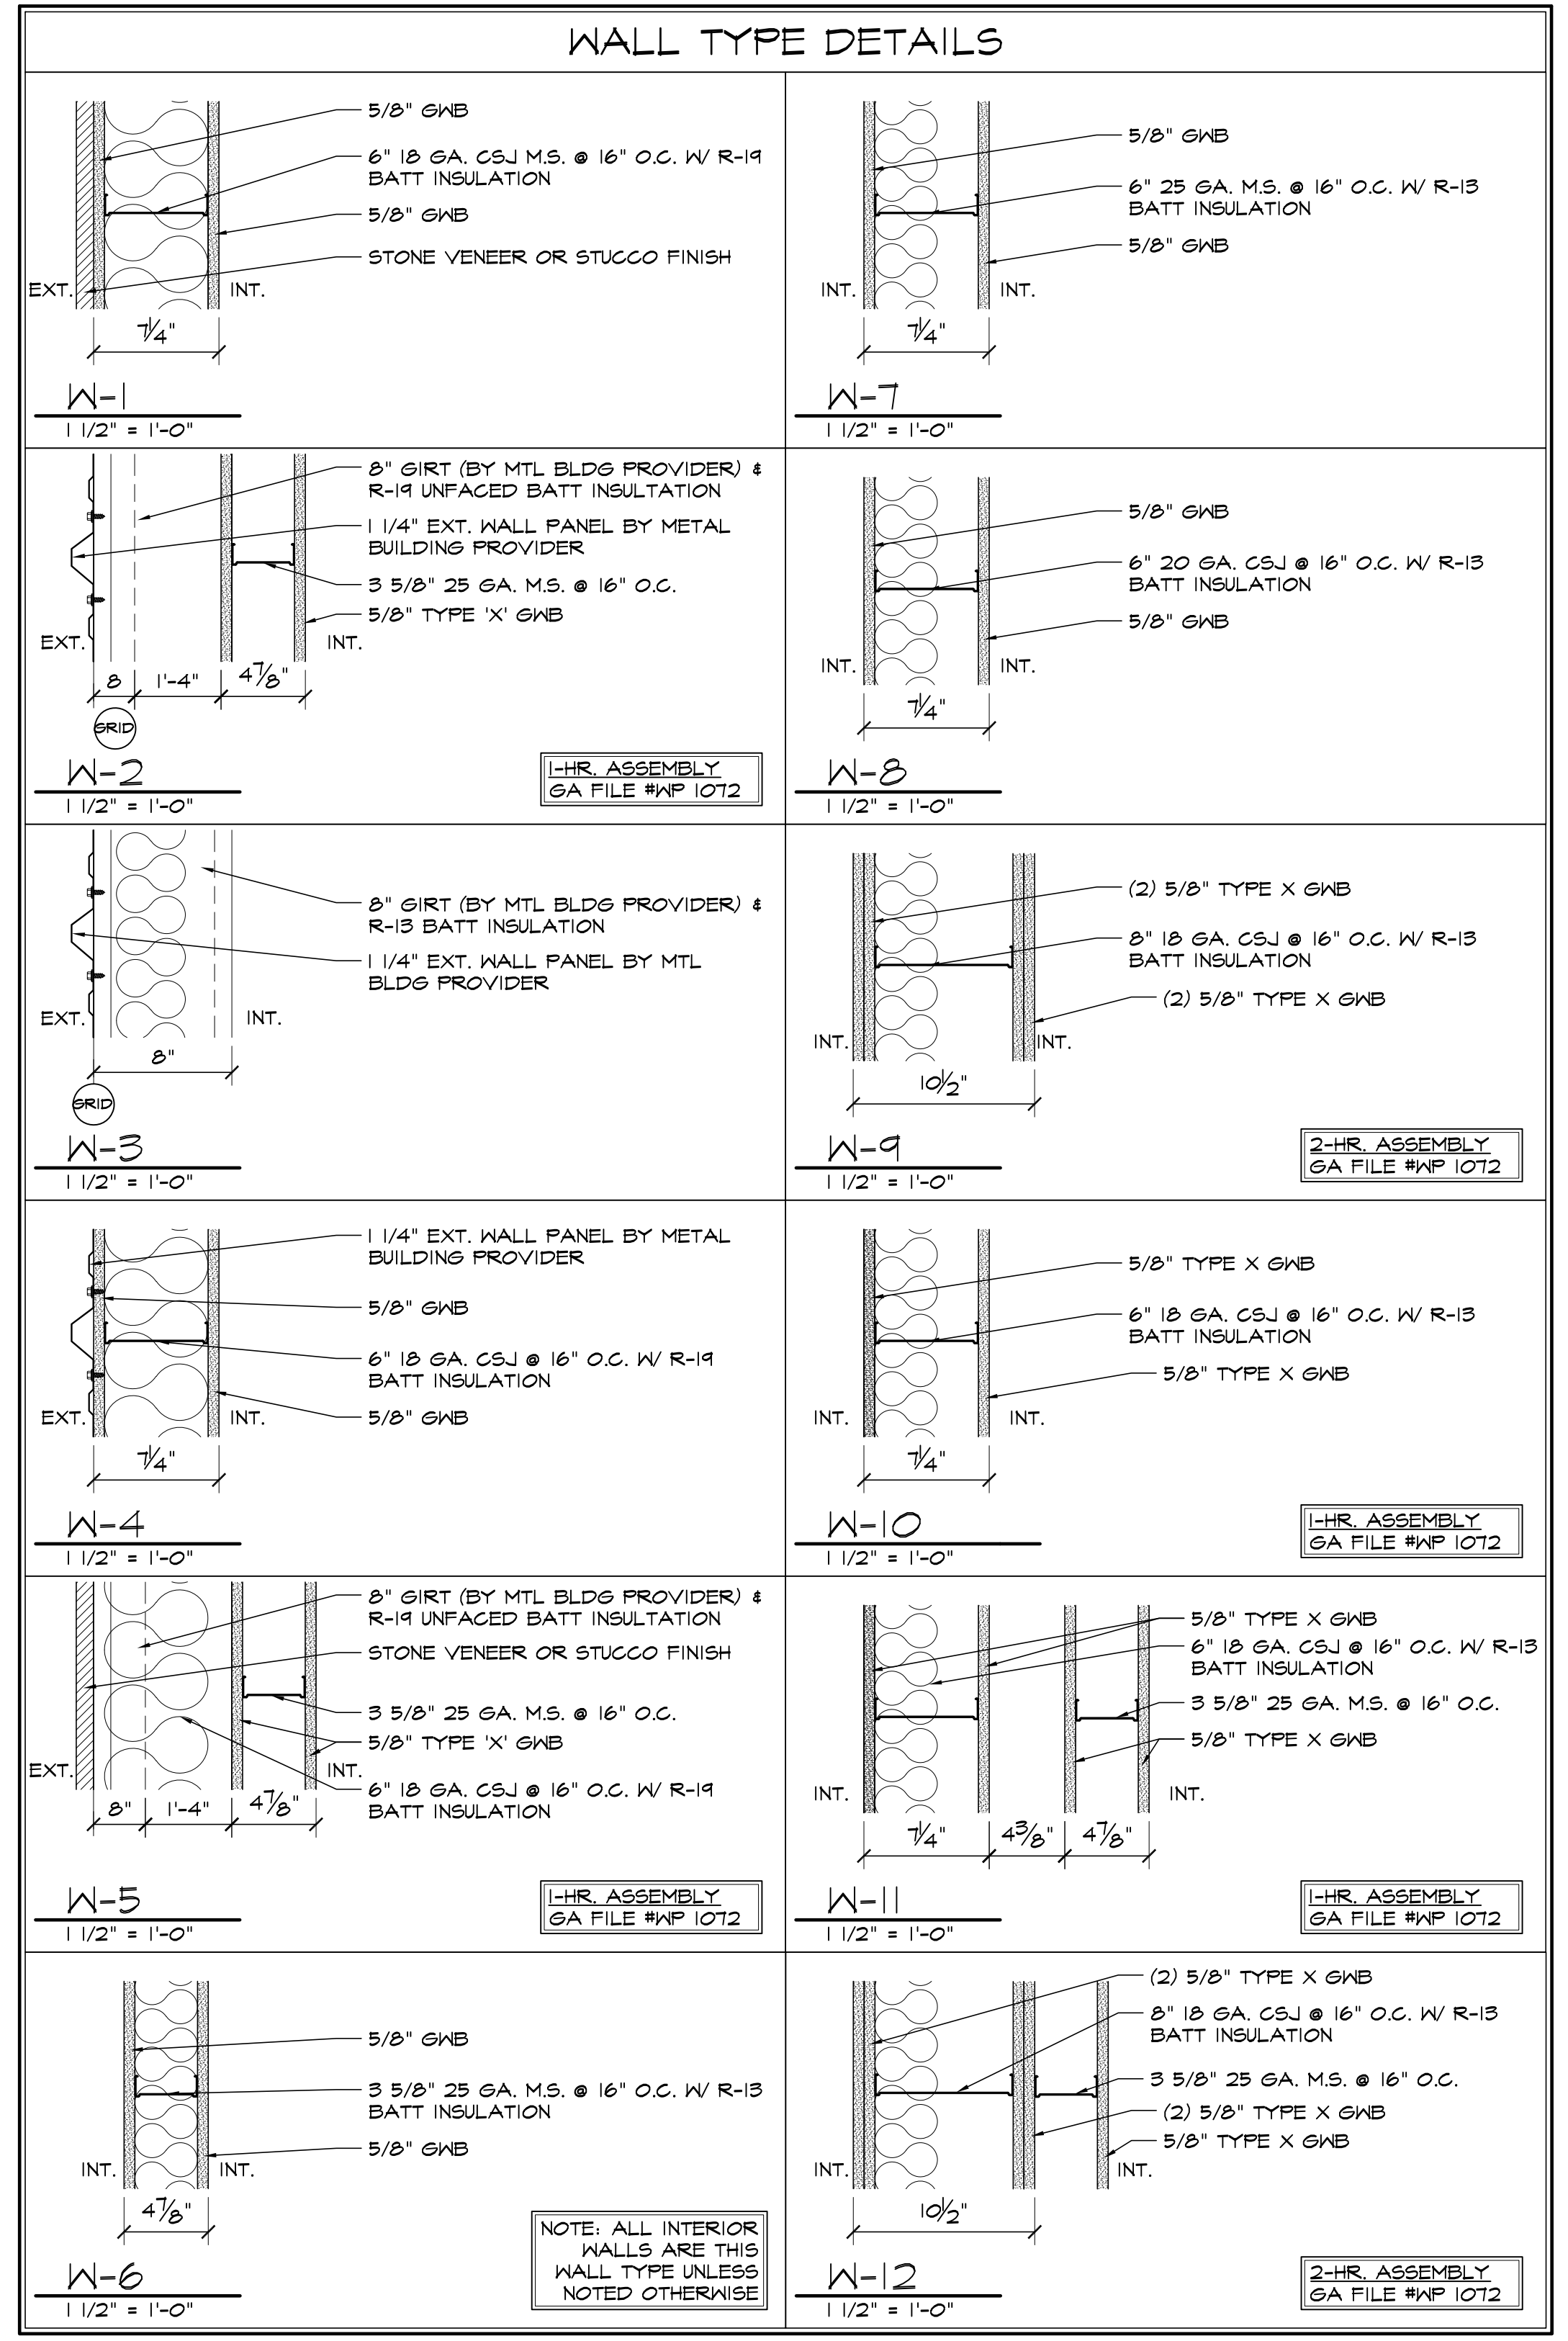



HAMMERS CONSTRUCTION INC.
COMMERCIAL GENERAL CONTRACTORS SPECIALIZING IN DESIGN/BUILD
PRESIDENT: STEVE R. HAMMERS
VICE PRES. DAVID J. HAMMERS
1411 WOOLSEY HEIGHTS
COLORADO SPRINGS, CO 80915
(719) 570-1589 FAX (719) 570-7008
www.hammersconstruction.com

THIS DRAWING CONTAINS MATERIAL & INFORMATION WHICH MAY NOT BE REPRODUCED WITHOUT WRITTEN CONSENT OF HAMMERS CONSTRUCTION INC. THESE DRAWINGS ARE INTENDED TO BE USED ONLY BY HAMMERS CONSTRUCTION & ITS REPRESENTATIVES. THESE DRAWINGS HAVE NOT BEEN PREPARED FOR ANY OTHER PURPOSE THAN TO INDICATE THE GENERAL FEATURES AND PLACEMENT OF THE PROPOSED PROJECT. COPYRIGHT © 2014 HAMMERS CONSTRUCTION

FATHER & SONS
CLAREMONT BUSINESS PARK LOT 4-2
1405 SELIX GROVE
COLORADO SPRINGS, CO 80915
EL PASO COUNTY, COLORADO

DATE: MAR. 11, 2019
DRAWN BY: A. MCKENZIE
PROJ. MGR: R. GREEN
SCALE: SEE PLAN
APPROVED BY:
JOB NO: 1065

REVISIONS:

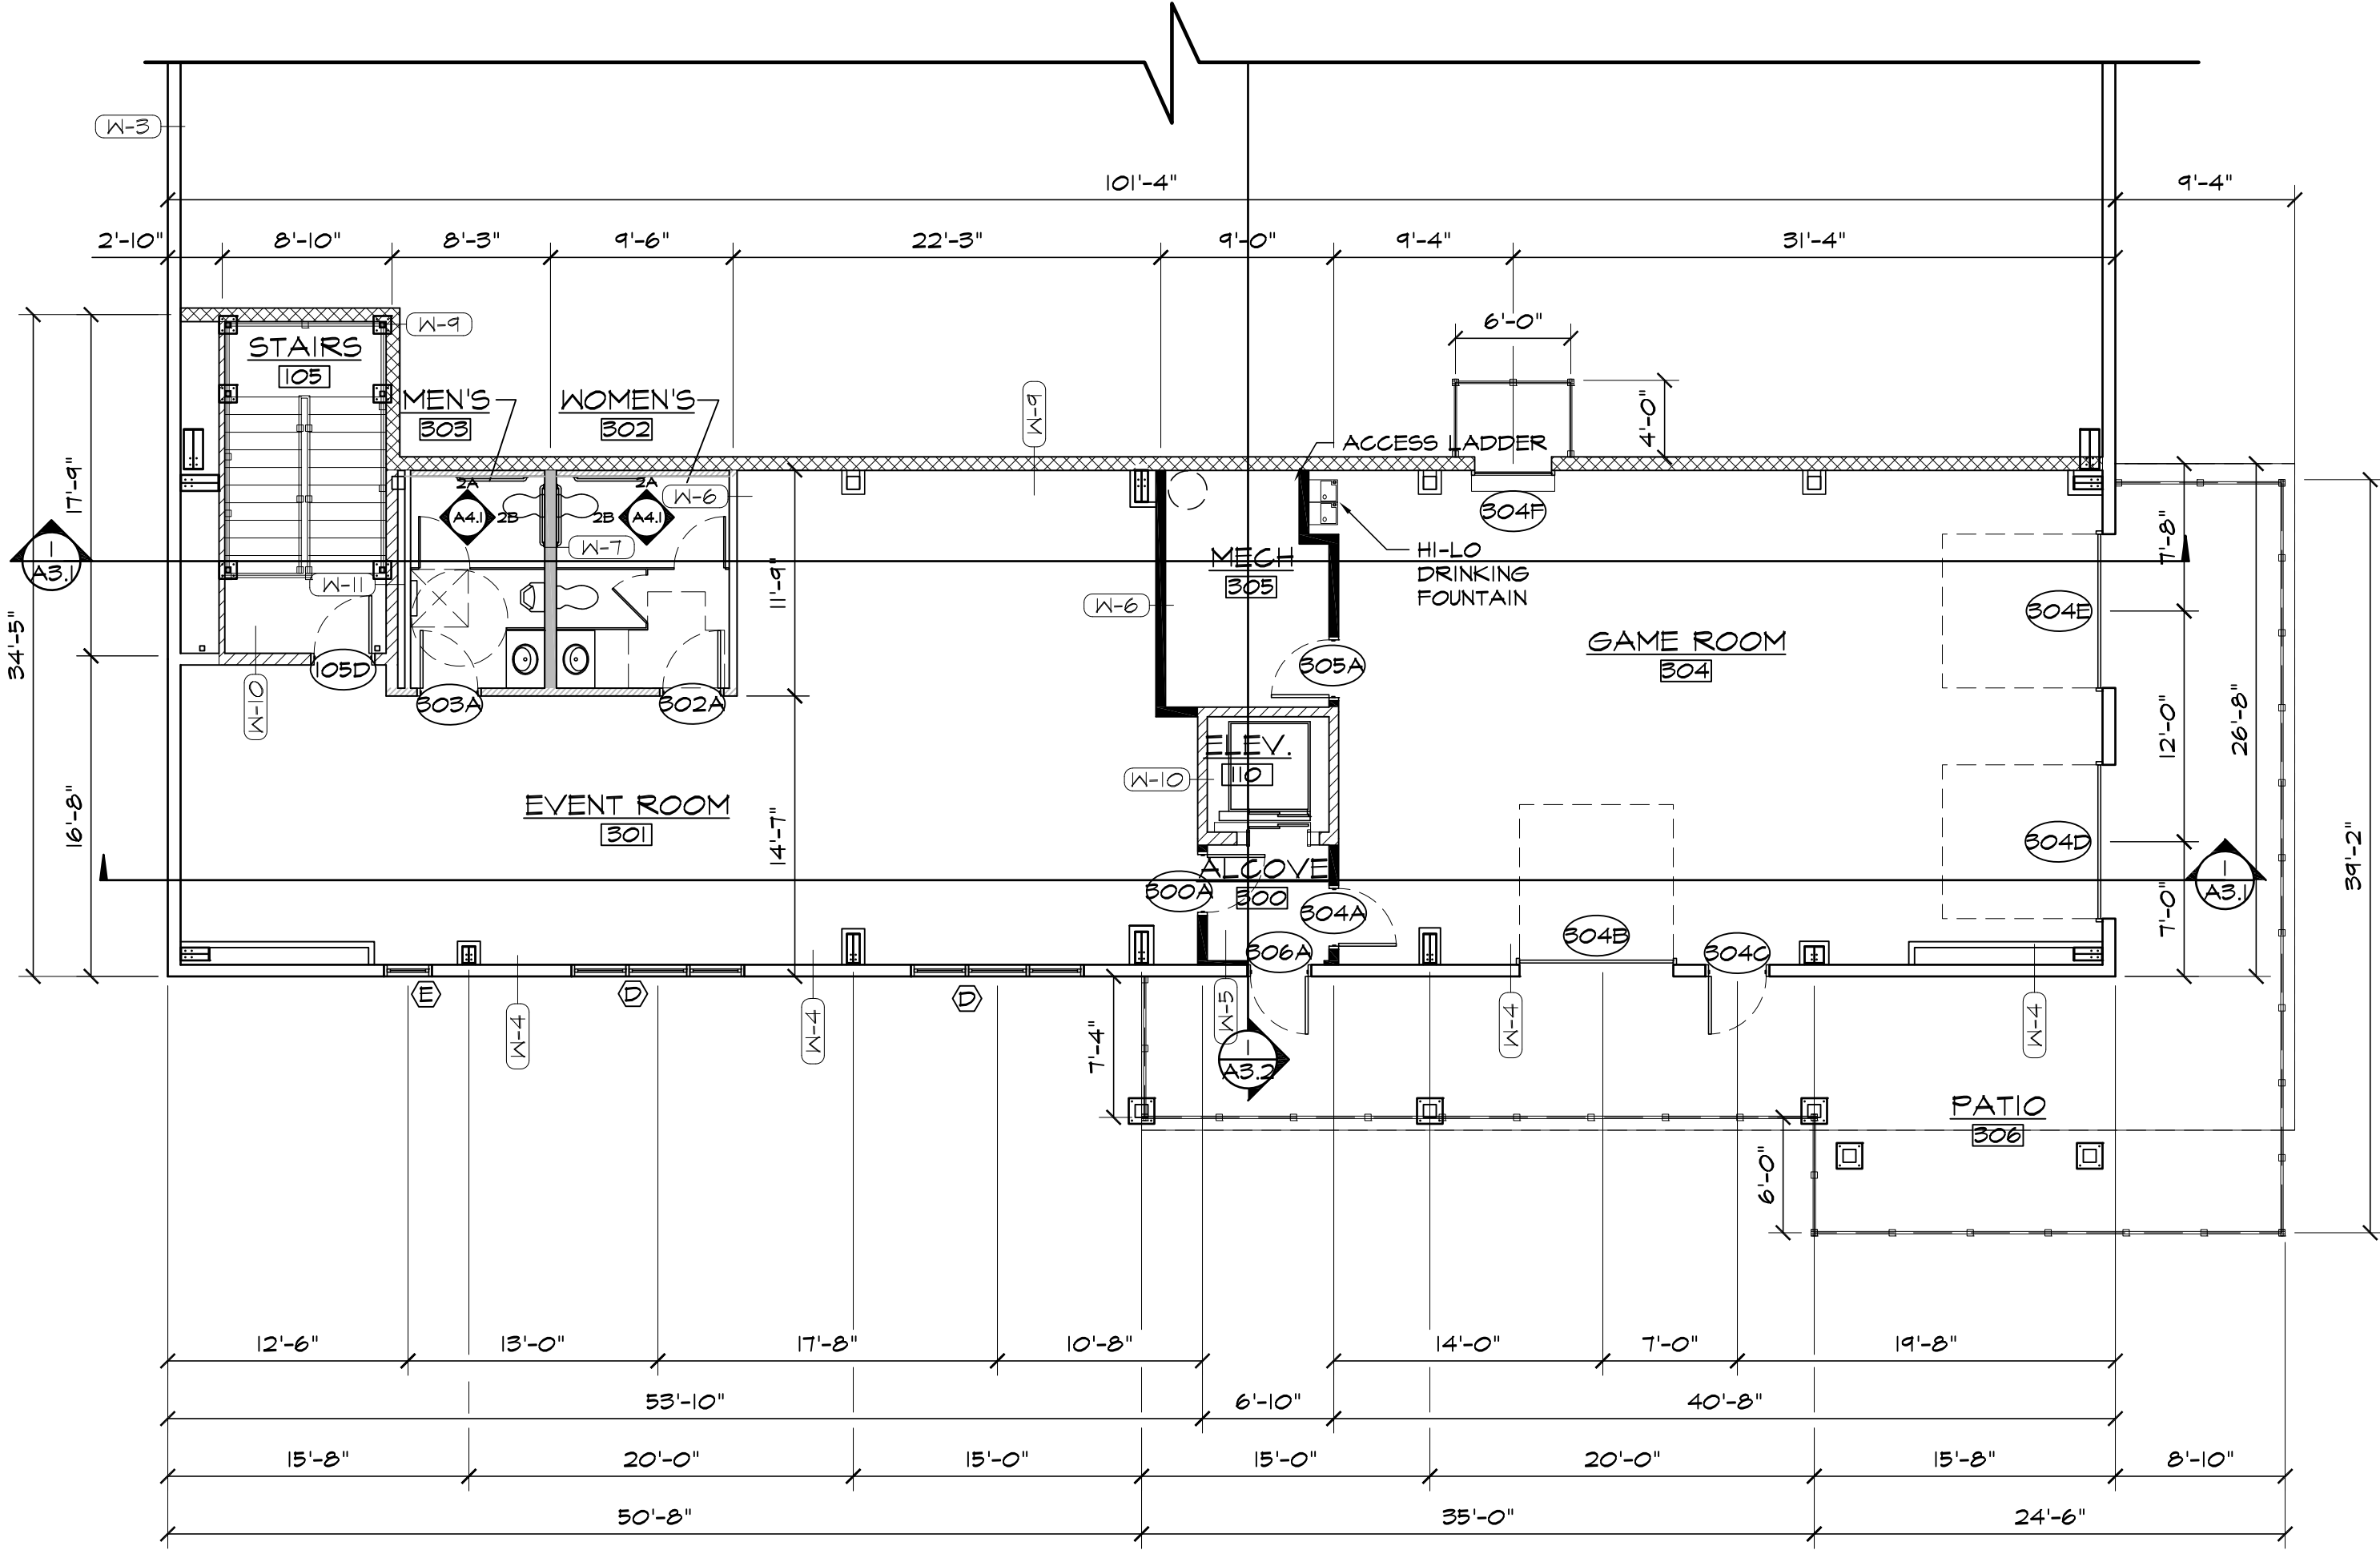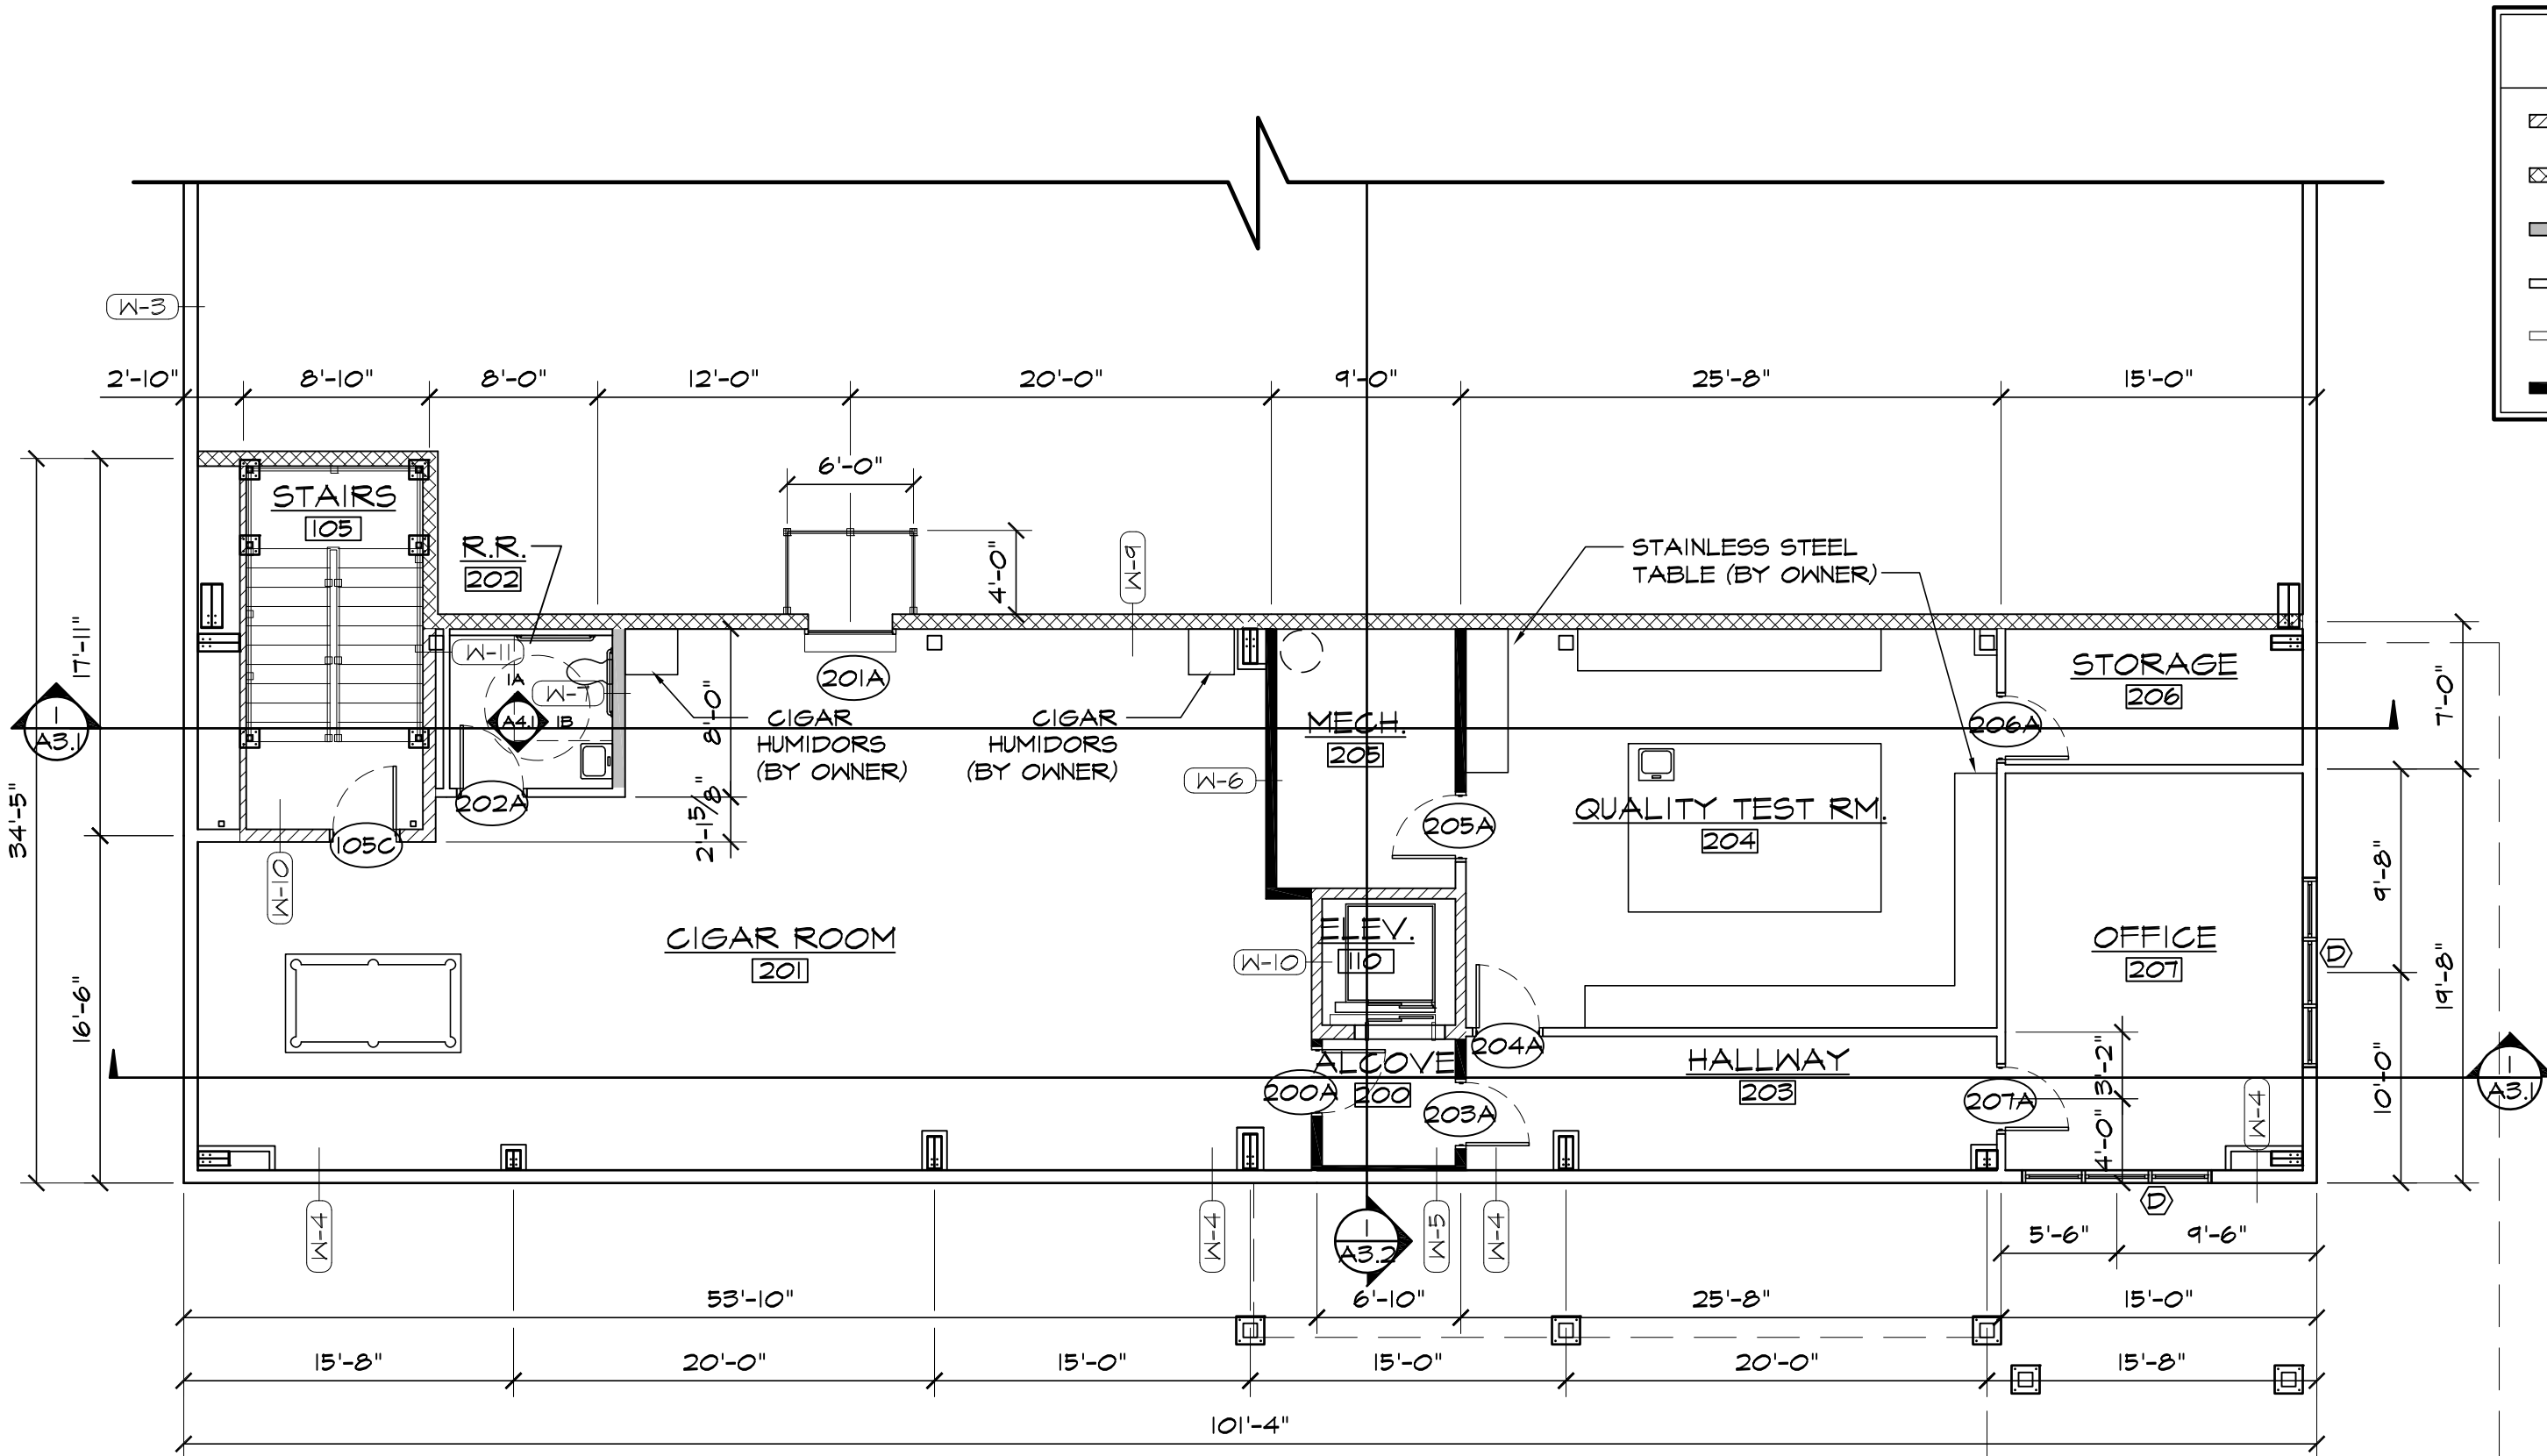

FLOOR PLAN LEGEND

- 1-HR. FIRE BARRIER WALL
- 2-HR. FIRE BARRIER WALL
- 6" PLUMBING WALL, 9' HIGH
- 3'-0" HIGH WALL
- 3'-0" HIGH WALL
- FULL HEIGHT WALL

WALL TYPE DETAILS

<p>W-1 1 1/2" = 1'-0"</p>	<p>W-7 1 1/2" = 1'-0"</p>
<p>W-2 1 1/2" = 1'-0"</p> <p>1-HR. ASSEMBLY GA FILE #WP 1072</p>	<p>W-8 1 1/2" = 1'-0"</p>
<p>W-3 1 1/2" = 1'-0"</p>	<p>W-9 1 1/2" = 1'-0"</p> <p>2-HR. ASSEMBLY GA FILE #WP 1072</p>
<p>W-4 1 1/2" = 1'-0"</p>	<p>W-10 1 1/2" = 1'-0"</p> <p>1-HR. ASSEMBLY GA FILE #WP 1072</p>
<p>W-5 1 1/2" = 1'-0"</p>	<p>W-11 1 1/2" = 1'-0"</p> <p>1-HR. ASSEMBLY GA FILE #WP 1072</p>
<p>W-6 1 1/2" = 1'-0"</p> <p>NOTE: ALL INTERIOR WALLS ARE THIS WALL TYPE UNLESS NOTED OTHERWISE</p>	<p>W-12 1 1/2" = 1'-0"</p> <p>2-HR. ASSEMBLY GA FILE #WP 1072</p>

HAMMERS CONSTRUCTION INC.
COMMERCIAL GENERAL CONTRACTORS SPECIALIZING IN DESIGN/BUILD
PRESIDENT: STEVE R. HAMMERS
VICE PRES. DAVID J. HAMMERS
1411 WOODLEY HEIGHTS
COLORADO SPRINGS, CO 80915
(719) 570-1589 FAX (719) 570-7008
www.hammersconstruction.com

THIS DRAWING CONTAINS MATERIAL & INFORMATION WHICH MAY NOT BE REPRODUCED WITHOUT WRITTEN CONSENT OF HAMMERS CONSTRUCTION INC. THESE DRAWINGS ARE INTENDED TO BE USED ONLY BY HAMMERS CONSTRUCTION & ITS REPRESENTATIVES. THESE DRAWINGS HAVE NOT BEEN PREPARED FOR ANY OTHER PURPOSE THAN TO INDICATE THE GENERAL FEATURES AND PLACEMENT OF THE PROPOSED PROJECT. COPYRIGHT © 2014 HAMMERS CONSTRUCTION

FATHER & SONS
CLAREMONT BUSINESS PARK LOT 4-2
1405 SELIX GROVE
COLORADO SPRINGS, CO 80915
EL PASO COUNTY, COLORADO

DATE: MAR. 11, 2019
DRAWN BY: A. MCKENZIE
PROJ. MGR: R. GREEN
SCALE: SEE PLAN
APPROVED BY:
JOB NO: 1065

REVISIONS:

DATE: MAR. 11, 2019
DRAWN BY: A. MCKENZIE
PROJ. MGR: R. GREEN
SCALE: SEE PLAN
APPROVED BY:
JOB NO: 1065

REVISIONS:

Floor Plans-redline.pdf Markup Summary

Show square footage per use. (1)

Show square footage
per use.

Subject: Text Box
Page Label: 1
Lock: Unlocked
Author: dsdkendall
Date: 6/12/2019 2:16:19 PM
Status:
Color: ■
Layer:
Space:

Show square footage per use.