

EPC STORMWATER REVIEW COMMENTS
IN ORANGE BOXES WITH BLACK TEXT


STORMWATER MANAGEMENT PLAN (SWMP)

FOR
FLYING HORSE NORTH FILING NO. 4
SE OF SANDBAGGER DR & OLD STAGECOACH RD
UNINCORPORATED EL PASO COUNTY, CO 80908

LOCATED IN A PORTION OF SECTION 31, TOWNSHIP 11 SOUTH, RANGE 65W WEST OF THE 6TH P.M.
LATITUDE: 39.053219°, LONGITUDE: -104.712769°

NOTE: SCALES SHOWN
ARE FOR 11"x17"
SHEETS, ADJUST
ACCORDINGLY FOR
OTHER SIZES.

0 700 1400
1 INCH = 700 FEET

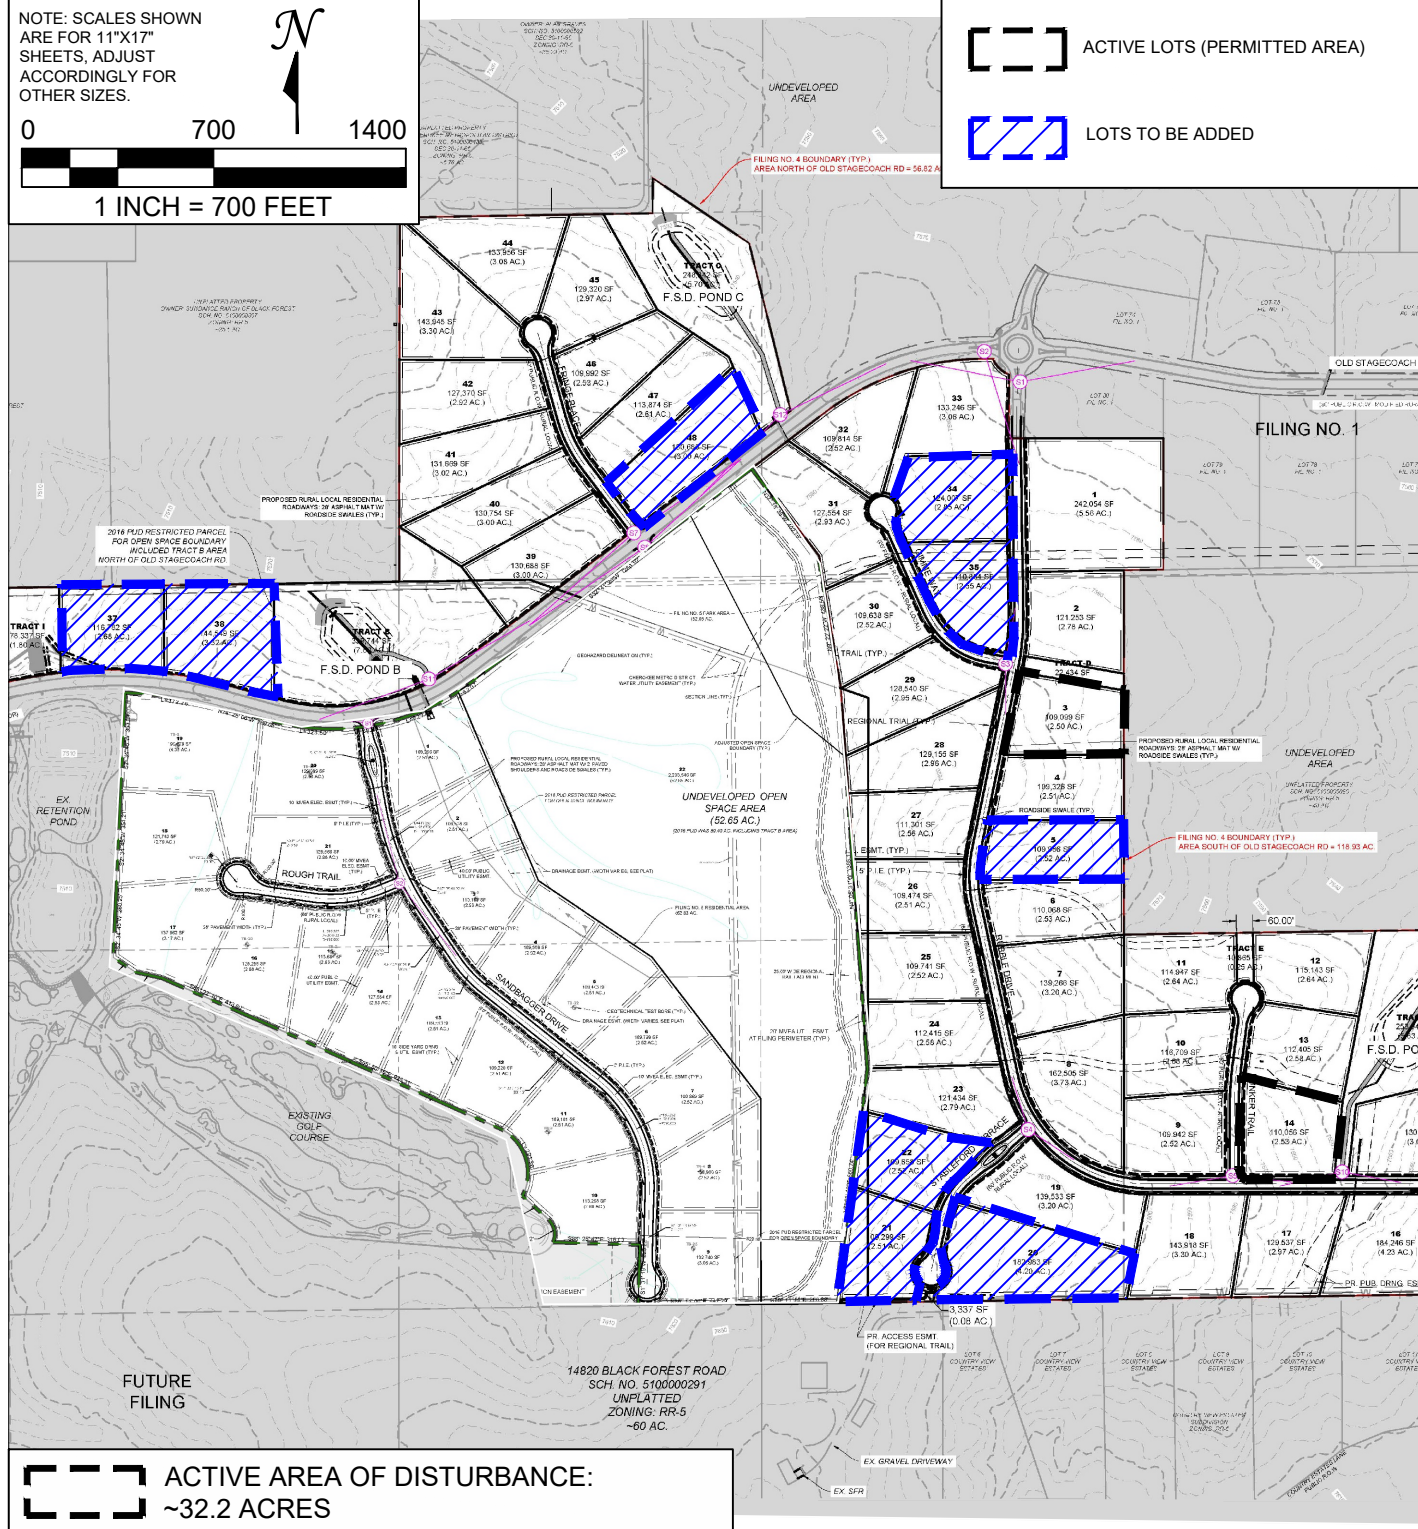


ACTIVE AREA OF DISTURBANCE:
~32.2 ACRES

SITE MAP

NOTE: SCALES SHOWN
ARE FOR 11"x17"
SHEETS, ADJUST
ACCORDINGLY FOR
OTHER SIZES.

0 2,000 4,000
1 INCH = 2,000 FEET

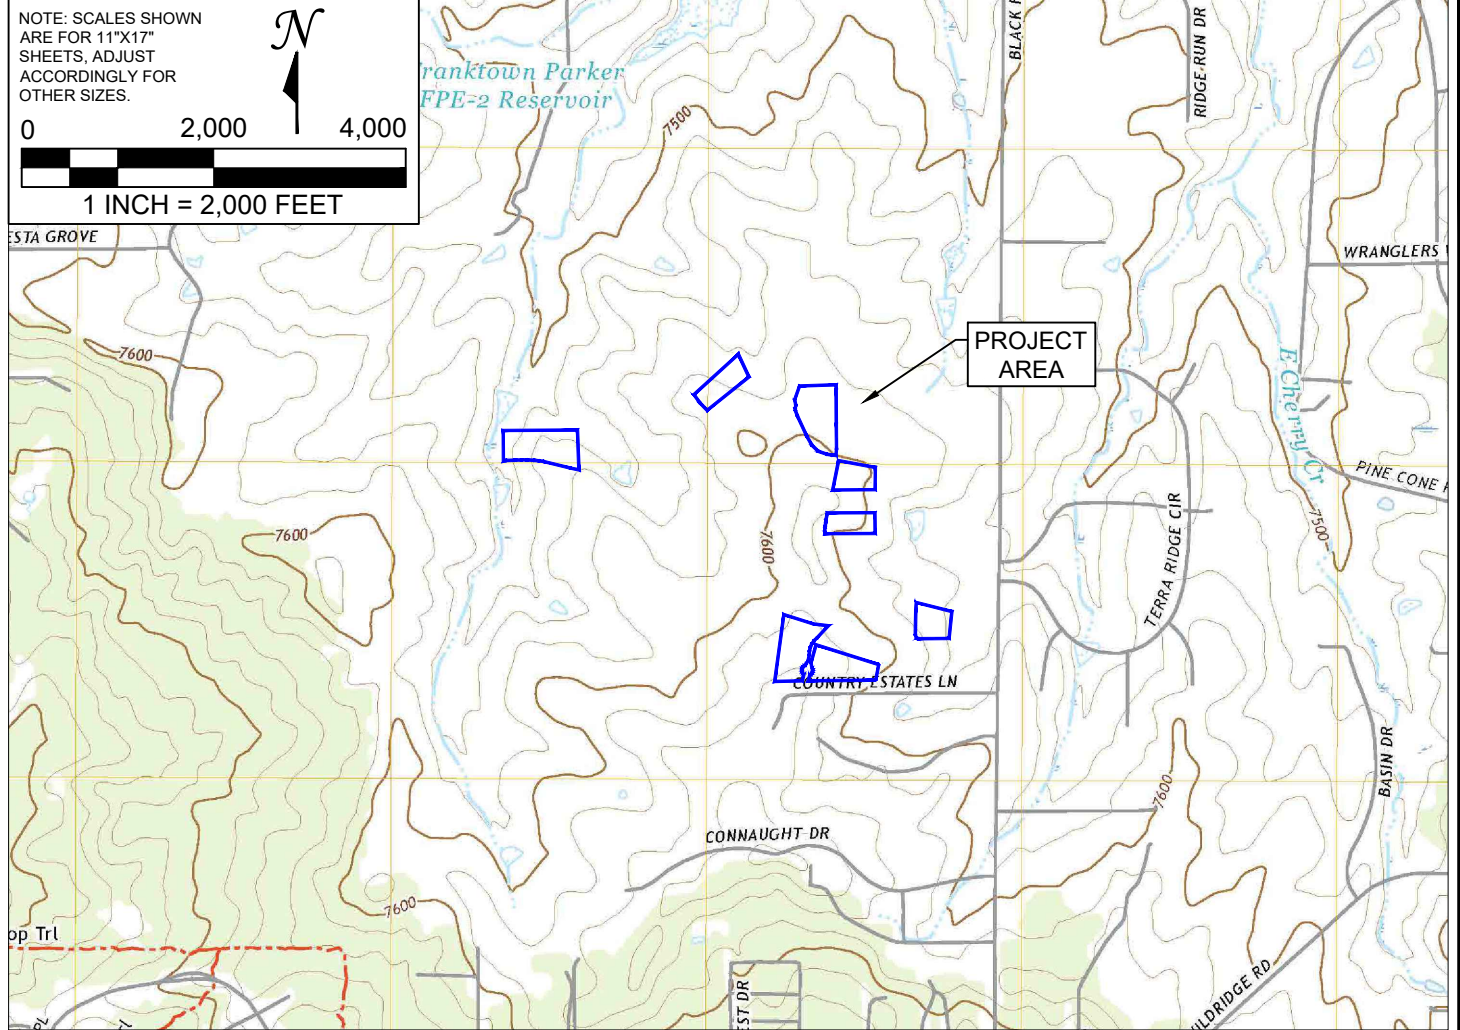

VICINITY MAP

SHEET INDEX

EC-1	COVER PAGE
EC-2 - EC-12	PLANNED EROSION AND SEDIMENT CONTROL - VERTICAL CONSTRUCTION

OWNER/OPERATOR:
WEEKLEY HOMES LLC
CRAIG SMITH, PROJECT MANAGER
7150 CAMPUS DR, SUITE 320
COLORADO SPRINGS, CO 80920
PHONE: (719) 431-0349
EMAIL: CSMITH@DWHOMES.COM



P.E. CERTIFICATION (SEAL)

NO.	DATE	REVISIONS		ENG	CAD
		ORIGINAL			
0	10/06/2026			SR	TR
PROJECT: FLYING HORSE NORTH FILING NO. 4					
SHEET TITLE: COVER PAGE					
PERMITTEE: WEEKLEY HOMES LLC					
7150 CAMPUS DR, SUITE 320, COLORADO SPRINGS, CO 80920 (719) 431-0349					
PROJ #: 06-2025					
DATE: 10/07/2026					
DESIGN ENG: TR					
CHECKED BY: SR					
EC-1					


VERTICAL CONSTRUCTION NOTES:

1. LAND DEVELOPMENT BMPS WILL BE RELIED UPON UNTIL ACTIVE VERTICAL CONSTRUCTION BEGINS AT A LOT OR LOTS WHEREIN THE INDIVIDUAL LOT CONTROLS WILL BE APPLIED.
2. REFER TO CONSTRUCTION PLANS FOR FULL CONSTRUCTION DETAILS INCLUDING BENCHMARK.
3. SEQUENCING OF THE PROJECT WILL BE DETERMINED DURING CONSTRUCTION AND UPDATES CAN BE OBTAINED FROM SITE SUPERINTENDENT. REFER TO THE SITE MAP IN SECTION 2.1 OF THE SWMP FOR FURTHER SCHEDULING INFORMATION.
4. CONSTRUCTION AND DISTURBANCE OF THE GROUND WILL BE CONFINED TO THE LIMITS OF CONSTRUCTION AND THE LOTS WITHIN THE PERMITTED AREA. ANY UNEXPECTED DISTURBANCE OUTSIDE THE PERMITTED AREA WILL REQUIRE STABILIZATION AND POSSIBLE MODIFICATION OF THE PERMIT.
5. SOILS FROM FOUNDATION EXCAVATION WILL BE STOCKPILED ON EACH LOT OR THE ADJACENT LOT IF POSSIBLE. ENSURE PROPER LOADING OPERATIONS TAKE PLACE. REFER TO SWMP SECTION 3 FOR ADDITIONAL INFORMATION.
6. CWA LOCATION(S) WILL BE DETERMINED IN FIELD. THE CONCRETE WASHOUTS NEED TO BE INSTALLED PRIOR TO PLACING ANY CONCRETE ON THE SITE. ADEQUATE SIGNAGE SHALL BE PLACED AROUND THE PROJECT TO IDENTIFY THE LOCATION OF THE CONCRETE WASHOUT.
7. WORKERS WILL BE INSTRUCTED TO PARK ON PAVED ROADWAYS OR ADJACENT PARKING LOTS. IF AN ADDITIONAL STAGING AREA IS REQUIRED AT THIS POINT OF CONSTRUCTION IT WILL BE REFLECTED IN ACTIVE SITE MAP.
8. LOCATIONS OF VEHICLE TRACKING CONTROLS (VTC) ARE TO BE DETERMINED IN FIELD. MUD MATS OR MODIFIED VTC'S DO NOT NEED TO BE INSTALLED UNTIL DISTURBANCE OF AN AREA COMMENCES.
9. THE CONTRACTOR SHALL BE RESPONSIBLE FOR SWEEPING AND CLEAN UP OF ALL PAVED AREAS SURROUNDING THE PROJECT ON A DAILY BASIS, AS NEEDED DURING THE DAY WHEN SEDIMENT AND OTHER MATERIALS ARE TRACKED OR DISCHARGED ONTO THEM OR PRIOR TO ANY STORM EVENT. ADDITIONAL GOOD HOUSEKEEPING PRACTICES (PORTABLE TOILETS, DUMPSTERS) WILL BE IMPLEMENTED THROUGHOUT CONSTRUCTION AND WILL BE REFLECTED ON THE ACTIVE SITE MAP.
10. DEPLOYMENT AND/OR REMOVAL OF THE ABOVE BMP'S ARE DEPENDENT OF WORK SEQUENCING AND PROXIMITY TO EACH DISTURBANCE AREA. ADDITIONAL BMPS MAY BE REQUIRED PER THE DETAILS OR NARRATIVE.
11. IT IS THE PERMITTEE'S RESPONSIBILITY TO ADJUST OR REMOVE INLET PROTECTIONS AS NECESSARY PRIOR TO LARGE RAIN EVENTS THAT MAY EXCEED THE NORMAL CAPACITY OF THE INLET PROTECTION TO PREVENT FLOODING AND POTENTIAL PROPERTY DAMAGE.
12. ACTUAL LOCATIONS OF PERIMETER CONTROLS SHALL BE DETERMINED IN THE FIELD AND ADJUSTED AS NECESSARY TO PROVIDE EFFECTIVE SEDIMENT AND EROSION CONTROL THROUGHOUT CONSTRUCTION.

PLANNED CONTROL MEASURE LEGEND


	(CWA)	CONCRETE WASHOUT AREA
	(IP)	INLET PROTECTION
	(OP)	OUTLET PROTECTION
	(RS)	ROCK SOCK OR COMPARABLE BMP
	(LOC)	LIMITS OF CONSTRUCTION
	(PC)	PERIMETER CONTROL (SILT FENCE STRAW WATTLE, OR COMPARABLE BMP)
	(TL)	TREE LAWN CONTROLS (ECB, HEAVY WEIGHT WATTLE, SEDIMENT CONTROL LOG, ETC.)
	(SA)	STAGING AREA
	(VTC)	VEHICLE TRACKING CONTROL

NOTE: SCALES SHOWN ARE FOR 11"x17" SHEETS, ADJUST ACCORDINGLY FOR OTHER SIZES.

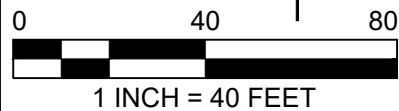

SITE DATA
LOT SF = 109226
HOUSE SQ. FT = 44268
COVERAGE = 4.0%
BLDG. HEIGHT =31.1
IMPERVIOUS SF. = 8443
IMP COVERAGE = 7.7%

FLYING HORSE NORTH FILING NO. 4
15253 RUBBLE DR
LOT 3

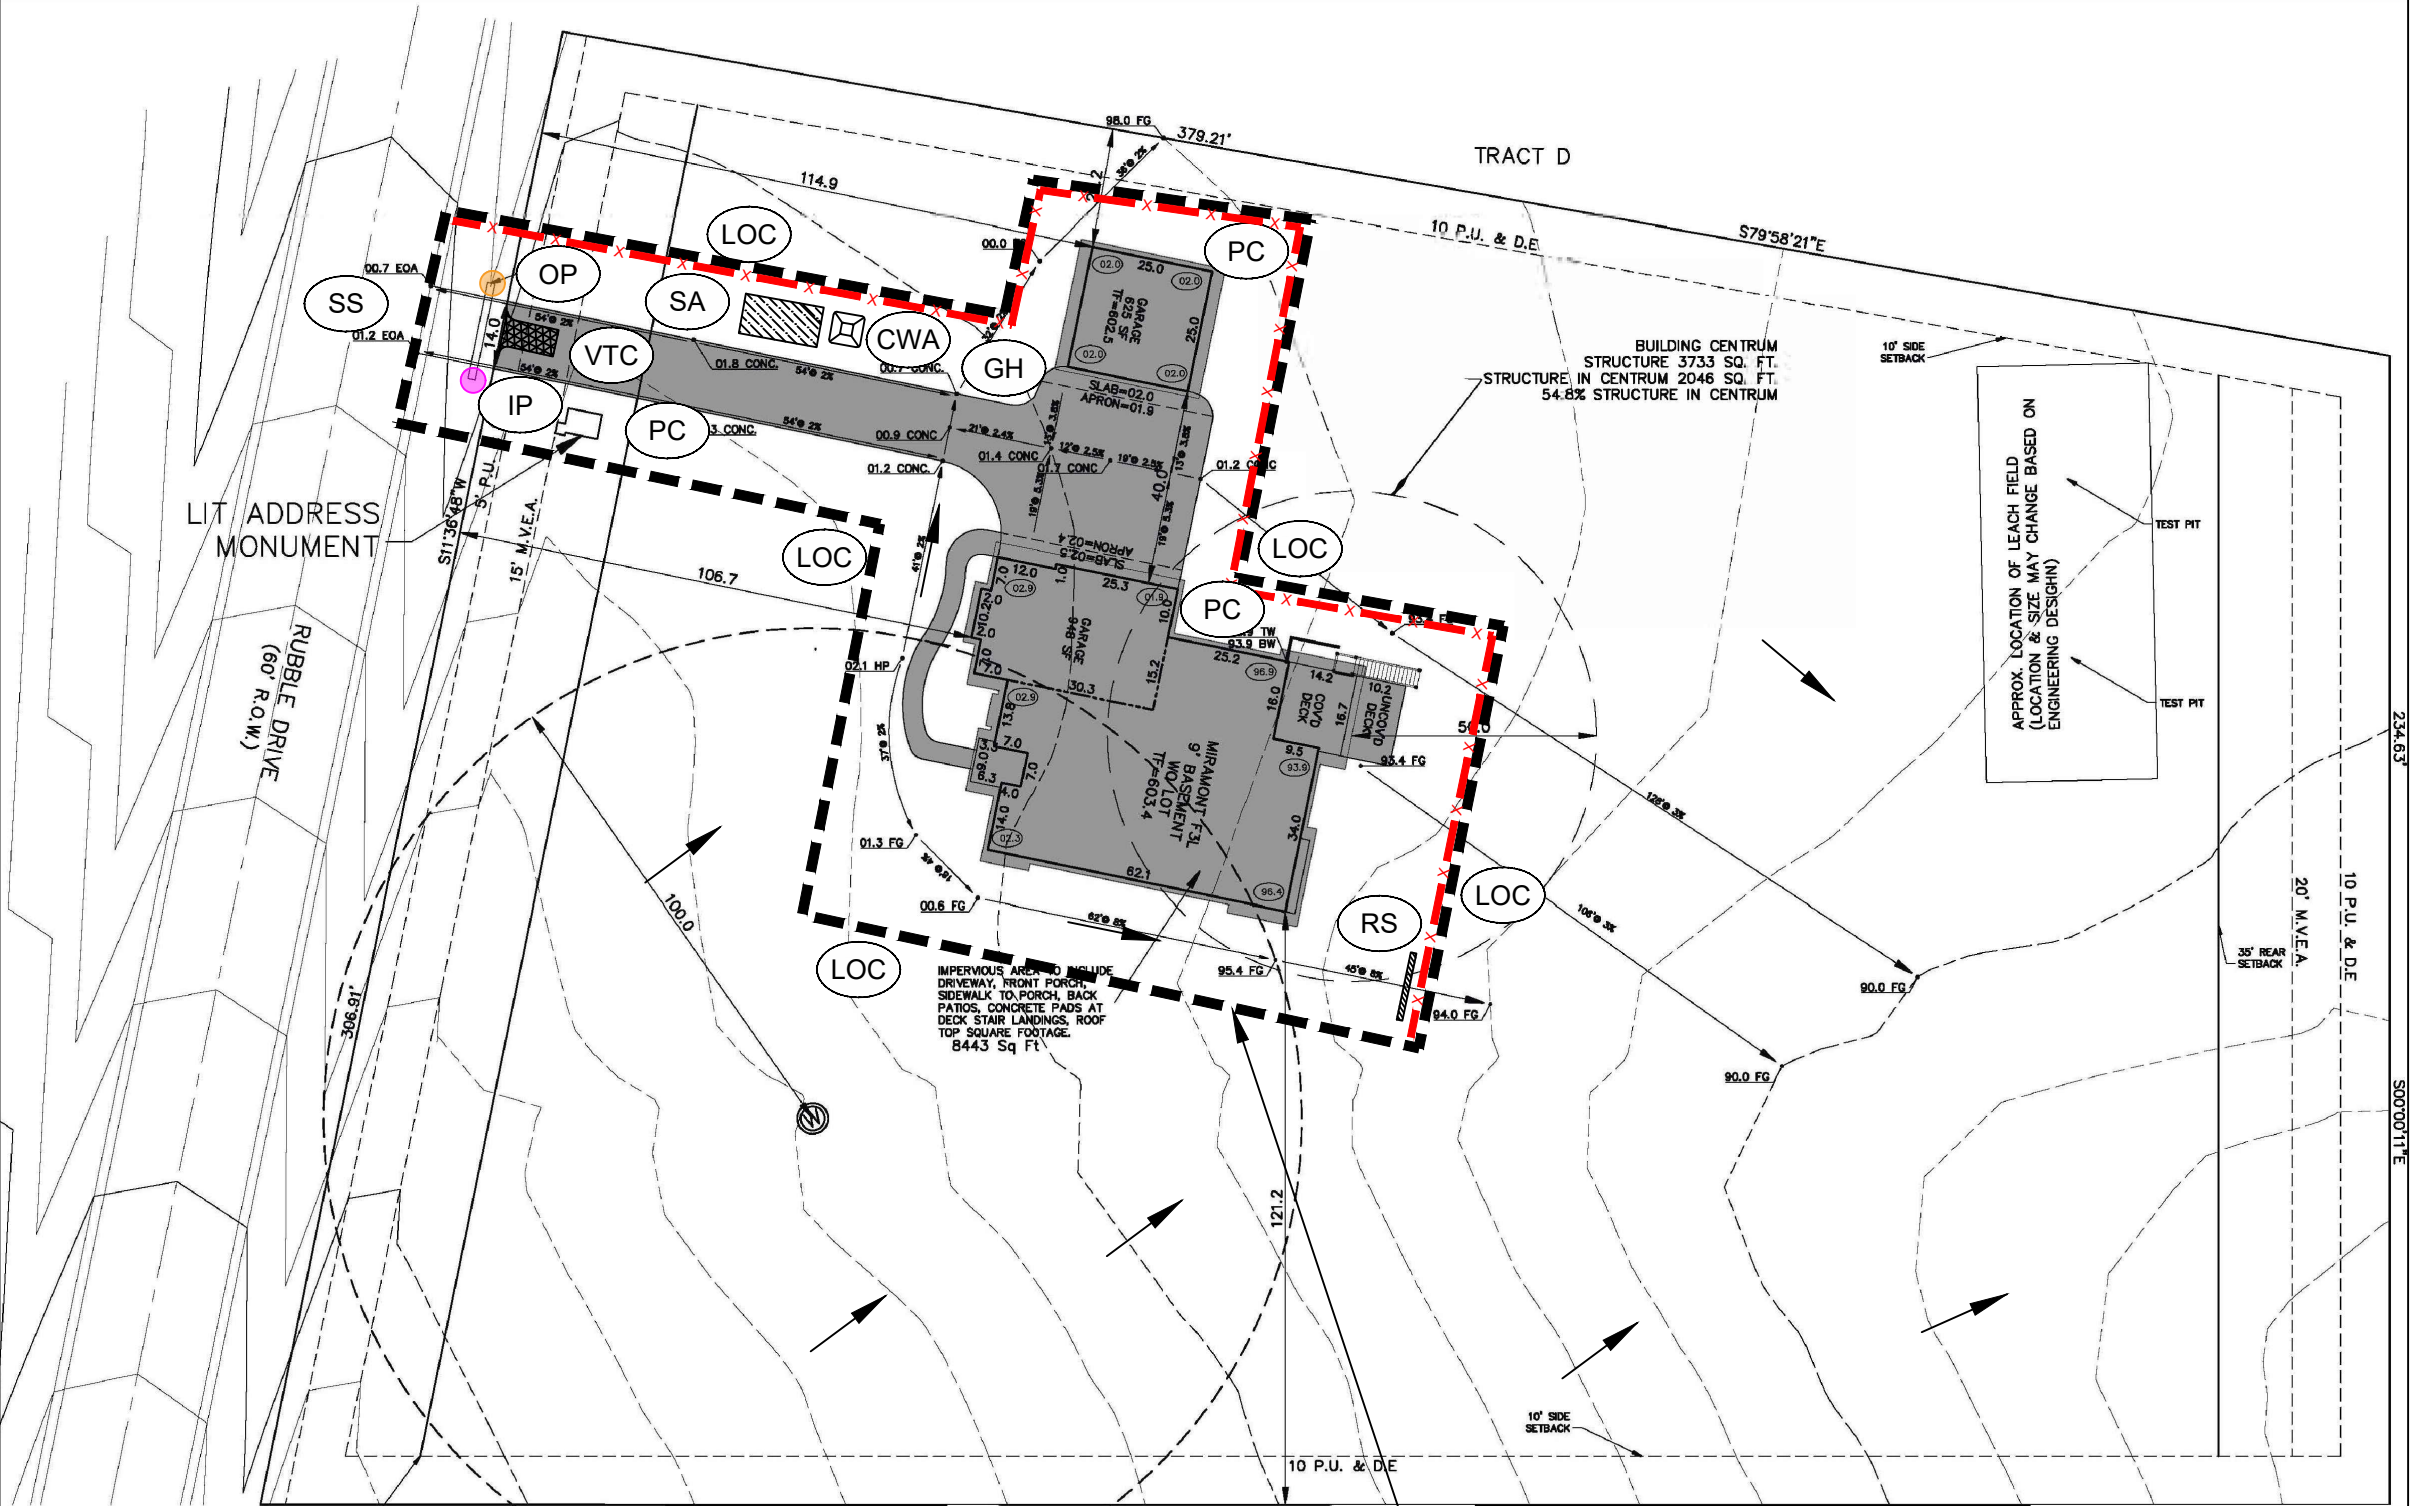


VERTICAL CONSTRUCTION NOTES:

1. LAND DEVELOPMENT BMPS WILL BE RELIED UPON UNTIL ACTIVE VERTICAL CONSTRUCTION BEGINS AT A LOT OR LOTS WHEREIN THE INDIVIDUAL LOT CONTROLS WILL BE APPLIED.
2. REFER TO CONSTRUCTION PLANS FOR FULL CONSTRUCTION DETAILS INCLUDING BENCHMARK.
3. SEQUENCING OF THE PROJECT WILL BE DETERMINED DURING CONSTRUCTION AND UPDATES CAN BE OBTAINED FROM SITE SUPERINTENDENT. REFER TO THE SITE MAP IN SECTION 2.1 OF THE SWMP FOR FURTHER SCHEDULING INFORMATION.
4. CONSTRUCTION AND DISTURBANCE OF THE GROUND WILL BE CONFINED TO THE LIMITS OF CONSTRUCTION AND THE LOTS WITHIN THE PERMITTED AREA. ANY UNEXPECTED DISTURBANCE OUTSIDE THE PERMITTED AREA WILL REQUIRE STABILIZATION AND POSSIBLE MODIFICATION OF THE PERMIT.
5. SOILS FROM FOUNDATION EXCAVATION WILL BE STOCKPILED ON EACH LOT OR THE ADJACENT LOT IF POSSIBLE. ENSURE PROPER LOADING OPERATIONS TAKE PLACE. REFER TO SWMP SECTION 3 FOR ADDITIONAL INFORMATION.
6. CWA LOCATION(S) WILL BE DETERMINED IN FIELD. THE CONCRETE WASHOUTS NEED TO BE INSTALLED PRIOR TO PLACING ANY CONCRETE ON THE SITE. ADEQUATE SIGNAGE SHALL BE PLACED AROUND THE PROJECT TO IDENTIFY THE LOCATION OF THE CONCRETE WASHOUT.
7. WORKERS WILL BE INSTRUCTED TO PARK ON PAVED ROADWAYS OR ADJACENT PARKING LOTS. IF AN ADDITIONAL STAGING AREA IS REQUIRED AT THIS POINT OF CONSTRUCTION IT WILL BE REFLECTED IN ACTIVE SITE MAP.
8. LOCATIONS OF VEHICLE TRACKING CONTROLS (VTC) ARE TO BE DETERMINED IN FIELD. MUD MATS OR MODIFIED VTC'S DO NOT NEED TO BE INSTALLED UNTIL DISTURBANCE OF AN AREA COMMENCES.
9. THE CONTRACTOR SHALL BE RESPONSIBLE FOR SWEEPING AND CLEAN UP OF ALL PAVED AREAS SURROUNDING THE PROJECT ON A DAILY BASIS, AS NEEDED DURING THE DAY WHEN SEDIMENT AND OTHER MATERIALS ARE TRACKED OR DISCHARGED ONTO THEM OR PRIOR TO ANY STORM EVENT. ADDITIONAL GOOD HOUSEKEEPING PRACTICES (PORTABLE TOILETS, DUMPSTERS) WILL BE IMPLEMENTED THROUGHOUT CONSTRUCTION AND WILL BE REFLECTED ON THE ACTIVE SITE MAP.
10. DEPLOYMENT AND/OR REMOVAL OF THE ABOVE BMP'S ARE DEPENDENT OF WORK SEQUENCING AND PROXIMITY TO EACH DISTURBANCE AREA. ADDITIONAL BMPS MAY BE REQUIRED PER THE DETAILS OR NARRATIVE.
11. IT IS THE PERMITTEE'S RESPONSIBILITY TO ADJUST OR REMOVE INLET PROTECTIONS AS NECESSARY PRIOR TO LARGE RAIN EVENTS THAT MAY EXCEED THE NORMAL CAPACITY OF THE INLET PROTECTION TO PREVENT FLOODING AND POTENTIAL PROPERTY DAMAGE.
12. ACTUAL LOCATIONS OF PERIMETER CONTROLS SHALL BE DETERMINED IN THE FIELD AND ADJUSTED AS NECESSARY TO PROVIDE EFFECTIVE SEDIMENT AND EROSION CONTROL THROUGHOUT CONSTRUCTION.

PLANNED CONTROL MEASURE LEGEND

- | | | |
|--|-------|---|
| | (CWA) | CONCRETE WASHOUT AREA |
| | (IP) | INLET PROTECTION |
| | (OP) | OUTLET PROTECTION |
| | (RS) | ROCK SOCK OR COMPARABLE BMP |
| | (LOC) | LIMITS OF CONSTRUCTION |
| | (PC) | PERIMETER CONTROL (SILT FENCE STRAW WATTLE, OR COMPARABLE BMP) |
| | (TL) | TREE LAWN CONTROLS (ECB, HEAVY WEIGHT WATTLE, SEDIMENT CONTROL LOG, ETC.) |
| | (SA) | STAGING AREA |
| | (VTC) | VEHICLE TRACKING CONTROL |

NOTE: SCALES SHOWN ARE FOR 11"x17" SHEETS, ADJUST ACCORDINGLY FOR OTHER SIZES.

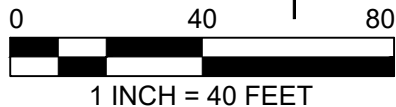


SITE DATA

LOT SQ. FT = 545807
HOUSE SQ. FT = 5090
COVERAGE = 4.6%
BLDG. HEIGHT = 27.6
IMPERVIOUS SF. = 7922
IMP COVERAGE = 7.2%

FLYING HORSE NORTH FILING NO. 4

14939 Bunker Trail
LOT 14

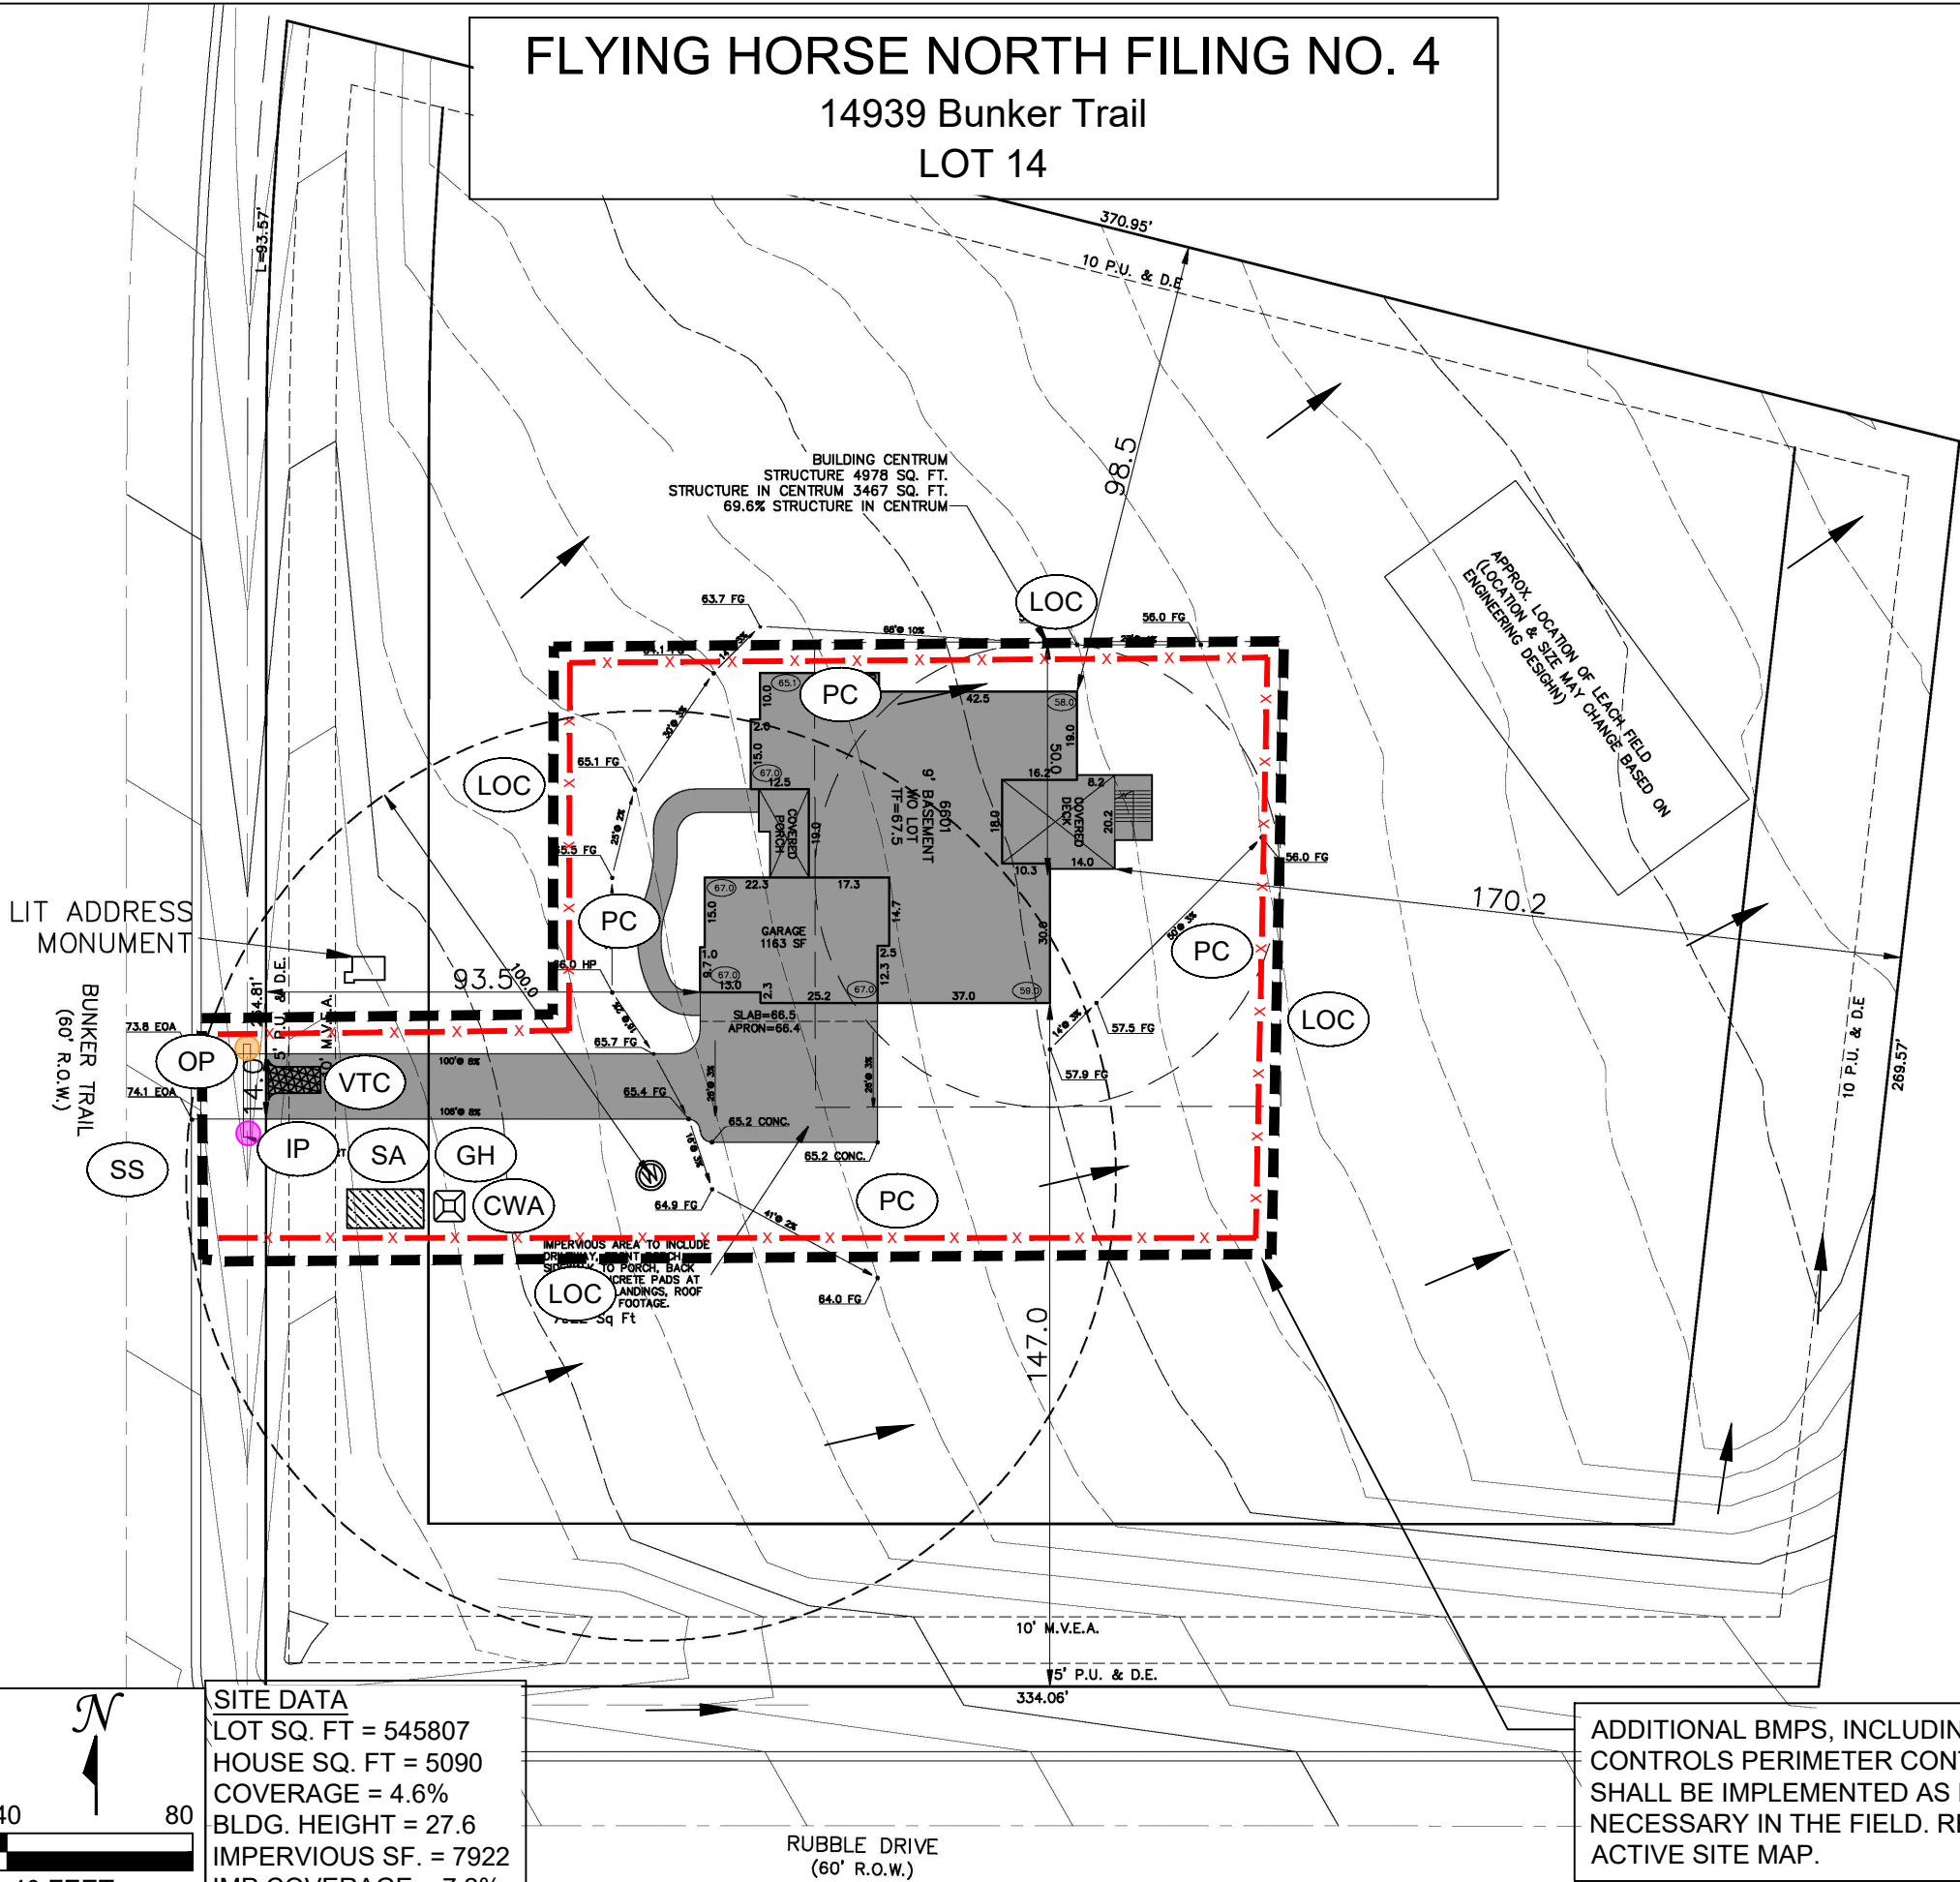


ADDITIONAL BMPS, INCLUDING RUN-ON CONTROLS PERIMETER CONTROLS, SHALL BE IMPLEMENTED AS DEEMED NECESSARY IN THE FIELD. REFER TO ACTIVE SITE MAP.

PROJECT:		FLYING HORSE NORTH FILING NO. 4		 CMS ENVIRONMENTAL SOLUTIONS		5231 SOUTH QUEBEC STREET GREENWOOD VILLAGE, CO 80111 P: (303) 593-2107 F: (303) 923-3416 WWW.CMSENVIRO.COM		NO.		DATE		REVISIONS		ENG		CAD	
PROJ #:		06-2025						0		08/18/2026		ORIGINAL		TB		TR	
DATE:		08/18/2026															
DESIGN ENG:		TR															
CHECKED BY:		SR															
SHEET TITLE:				PLANNED EROSION AND SEDIMENT CONTROL - VERTICAL CONSTRUCTION													
PERMITTEE:				WEEKLEY HOMES LLC													
				7150 CAMPUS DR, SUITE 320, COLORADO SPRINGS, CO 80920; (719) 431-0349													
EC-3																	

1. LAND DEVELOPMENT BMPs WILL BE RELIED UPON UNTIL ACTIVE VERTICAL CONSTRUCTION BEGINS AT A LOT OR LOTS WHEREIN THE INDIVIDUAL LOT CONTROLS WILL BE APPLIED.
2. REFER TO CONSTRUCTION PLANS FOR FULL CONSTRUCTION DETAILS INCLUDING BENCHMARK.
3. SEQUENCING OF THE PROJECT WILL BE DETERMINED DURING CONSTRUCTION AND UPDATES CAN BE OBTAINED FROM SITE SUPERINTENDENT. REFER TO THE SITE MAP IN SECTION 2.1 OF THE SWMP FOR FURTHER SCHEDULING INFORMATION.
4. CONSTRUCTION AND DISTURBANCE OF THE GROUND WILL BE CONFINED TO THE LIMITS OF CONSTRUCTION AND THE LOTS WITHIN THE PERMITTED AREA. ANY UNEXPECTED DISTURBANCE OUTSIDE THE PERMITTED AREA WILL REQUIRE STABILIZATION AND POSSIBLE MODIFICATION OF THE PERMIT.
5. SOILS FROM FOUNDATION EXCAVATION WILL BE STOCKPILED ON EACH LOT OR THE ADJACENT LOT IF POSSIBLE. ENSURE PROPER LOADING OPERATIONS TAKE PLACE. REFER TO SWMP SECTION 3 FOR ADDITIONAL INFORMATION.
6. CWA LOCATION(S) WILL BE DETERMINED IN FIELD. THE CONCRETE WASHOUTS NEED TO BE INSTALLED PRIOR TO PLACING ANY CONCRETE ON THE SITE. ADEQUATE SIGNAGE SHALL BE PLACED AROUND THE PROJECT TO IDENTIFY THE LOCATION OF THE CONCRETE WASHOUT.
7. WORKERS WILL BE INSTRUCTED TO PARK ON PAVED ROADWAYS OR ADJACENT PARKING LOTS. IF AN ADDITIONAL STAGING AREA IS REQUIRED AT THIS POINT OF CONSTRUCTION IT WILL BE REFLECTED IN ACTIVE SITE MAP.
8. LOCATIONS OF VEHICLE TRACKING CONTROLS (VTC) ARE TO BE DETERMINED IN FIELD. MUD MATS OR MODIFIED VTC'S DO NOT NEED TO BE INSTALLED UNTIL DISTURBANCE OF AN AREA COMMENCES.
9. THE CONTRACTOR SHALL BE RESPONSIBLE FOR SWEEPING AND CLEAN UP OF ALL PAVED AREAS SURROUNDING THE PROJECT ON A DAILY BASIS, AS NEEDED DURING THE DAY WHEN SEDIMENT AND OTHER MATERIALS ARE TRACKED OR DISCHARGED ONTO THEM OR PRIOR TO ANY STORM EVENT. ADDITIONAL GOOD HOUSEKEEPING PRACTICES (PORTABLE TOILETS, DUMPSTERS) WILL BE IMPLEMENTED THROUGHOUT CONSTRUCTION AND WILL BE REFLECTED ON THE ACTIVE SITE MAP.
10. DEPLOYMENT AND/OR REMOVAL OF THE ABOVE BMP'S ARE DEPENDENT OF WORK SEQUENCING AND PROXIMITY TO EACH DISTURBANCE AREA. ADDITIONAL BMPs MAY BE REQUIRED PER THE DETAILS OR NARRATIVE.
11. IT IS THE PERMITTEE'S RESPONSIBILITY TO ADJUST OR REMOVE INLET PROTECTIONS AS NECESSARY PRIOR TO LARGE RAIN EVENTS THAT MAY EXCEED THE NORMAL CAPACITY OF THE INLET PROTECTION TO PREVENT FLOODING AND POTENTIAL PROPERTY DAMAGE.
12. ACTUAL LOCATIONS OF PERIMETER CONTROLS SHALL BE DETERMINED IN THE FIELD AND ADJUSTED AS NECESSARY TO PROVIDE EFFECTIVE SEDIMENT AND EROSION CONTROL THROUGHOUT CONSTRUCTION.

Flying Horse Filings 4 and 5 have lot imperviousness restrictions because the developer chose to utilize the Large Lot Exclusion for water quality which restricts lot imperviousness to 10% or between 10-20% imperviousness with an additional study. Many of these site plans are reporting impervious cover greater than 10% which would trigger the study requirement. I have comments on the reported square footage so please with the next submittal verify all impervious percentages reported. If lots have between 10-20% imperviousness an additional study will be required. Lots cannot be greater than 20% impervious without providing water quality.

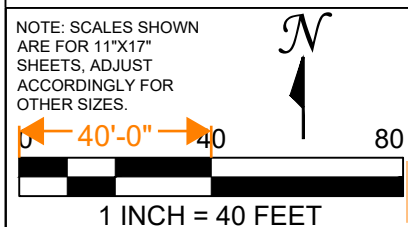


SITE DATA
LOT SQ. FT = 109986
IMPERVIOUS SF. = 15150
IMP COVERAGE = 13.8%

[illegible]

I'm measuring closer to 9 which would be approximately imperviousness. Verify.

 ADDITIONAL BMPS, INCLUDING RUN-ON CONTROLS PERIMETER CONTROLS, SHALL BE IMPLEMENTED AS DEEMED NECESSARY IN THE FIELD. REFER TO ACTIVE SITE MAP.

PROJECT:		FLYING HORSE NORTH FILING NO. 4	
SHEET TITLE:		PLANNED EROSION AND SEDIMENT CONTROL - VERTICAL CONSTRUCTION	
PERMITTEE:		WEEKLEY HOMES LLC 7150 CAMPUS DR, SUITE 320, COLORADO SPRINGS, CO 80920; (719) 431-0349	
PROJ #:	06-2025		
DATE:	10/07/2026		
DESIGN ENG:	TR		
CHECKED BY:	SR		
 CMS ENVIRONMENTAL SOLUTIONS		5231 SOUTH QUEBEC STREET GREENWOOD VILLAGE, CO 80111 P: (303) 593-2107 F: (303) 923-3416 WWW.CMSENVIRO.COM	
NO.	0	DATE	08/18/2026
REVISIONS		ORIGINAL	
CAD		ENG	
TR		SR	

VERTICAL CONSTRUCTION NOTES:

1. LAND DEVELOPMENT BMPS WILL BE RELIED UPON UNTIL ACTIVE VERTICAL CONSTRUCTION BEGINS AT A LOT OR LOTS WHEREIN THE INDIVIDUAL LOT CONTROLS WILL BE APPLIED.
2. REFER TO CONSTRUCTION PLANS FOR FULL CONSTRUCTION DETAILS INCLUDING BENCHMARK.
3. SEQUENCING OF THE PROJECT WILL BE DETERMINED DURING CONSTRUCTION AND UPDATES CAN BE OBTAINED FROM SITE SUPERINTENDENT. REFER TO THE SITE MAP IN SECTION 2.1 OF THE SWMP FOR FURTHER SCHEDULING INFORMATION.
4. CONSTRUCTION AND DISTURBANCE OF THE GROUND WILL BE CONFINED TO THE LIMITS OF CONSTRUCTION AND THE LOTS WITHIN THE PERMITTED AREA. ANY UNEXPECTED DISTURBANCE OUTSIDE THE PERMITTED AREA WILL REQUIRE STABILIZATION AND POSSIBLE MODIFICATION OF THE PERMIT.
5. SOILS FROM FOUNDATION EXCAVATION WILL BE STOCKPILED ON EACH LOT OR THE ADJACENT LOT IF POSSIBLE. ENSURE PROPER LOADING OPERATIONS TAKE PLACE. REFER TO SWMP SECTION 3 FOR ADDITIONAL INFORMATION.
6. CWA LOCATION(S) WILL BE DETERMINED IN FIELD. THE CONCRETE WASHOUTS NEED TO BE INSTALLED PRIOR TO PLACING ANY CONCRETE ON THE SITE. ADEQUATE SIGNAGE SHALL BE PLACED AROUND THE PROJECT TO IDENTIFY THE LOCATION OF THE CONCRETE WASHOUT.
7. WORKERS WILL BE INSTRUCTED TO PARK ON PAVED ROADWAYS OR ADJACENT PARKING LOTS. IF AN ADDITIONAL STAGING AREA IS REQUIRED AT THIS POINT OF CONSTRUCTION IT WILL BE REFLECTED IN ACTIVE SITE MAP.
8. LOCATIONS OF VEHICLE TRACKING CONTROLS (VTC) ARE TO BE DETERMINED IN FIELD. MUD MATS OR MODIFIED VTC'S DO NOT NEED TO BE INSTALLED UNTIL DISTURBANCE OF AN AREA COMMENCES.
9. THE CONTRACTOR SHALL BE RESPONSIBLE FOR SWEEPING AND CLEAN UP OF ALL PAVED AREAS SURROUNDING THE PROJECT ON A DAILY BASIS, AS NEEDED DURING THE DAY WHEN SEDIMENT AND OTHER MATERIALS ARE TRACKED OR DISCHARGED ONTO THEM OR PRIOR TO ANY STORM EVENT. ADDITIONAL GOOD HOUSEKEEPING PRACTICES (PORTABLE TOILETS, DUMPSTERS) WILL BE IMPLEMENTED THROUGHOUT CONSTRUCTION AND WILL BE REFLECTED ON THE ACTIVE SITE MAP.
10. DEPLOYMENT AND/OR REMOVAL OF THE ABOVE BMP'S ARE DEPENDENT OF WORK SEQUENCING AND PROXIMITY TO EACH DISTURBANCE AREA. ADDITIONAL BMPS MAY BE REQUIRED PER THE DETAILS OR NARRATIVE.
11. IT IS THE PERMITTEE'S RESPONSIBILITY TO ADJUST OR REMOVE INLET PROTECTIONS AS NECESSARY PRIOR TO LARGE RAIN EVENTS THAT MAY EXCEED THE NORMAL CAPACITY OF THE INLET PROTECTION TO PREVENT FLOODING AND POTENTIAL PROPERTY DAMAGE.
12. ACTUAL LOCATIONS OF PERIMETER CONTROLS SHALL BE DETERMINED IN THE FIELD AND ADJUSTED AS NECESSARY TO PROVIDE EFFECTIVE SEDIMENT AND EROSION CONTROL THROUGHOUT CONSTRUCTION.

PLANNED CONTROL MEASURE LEGEND



CWA

IP

OP

RS

LOC

PC

TL

SA

VTC

GH

SS

CONCRETE WASHOUT AREA

INLET PROTECTION

OUTLET PROTECTION

ROCK SOCK OR COMPARABLE BMP

LIMITS OF CONSTRUCTION

PERIMETER CONTROL (SILT FENCE, STRAW WATTLE, OR COMPARABLE BMP)

TREE LAWN CONTROLS (SILT FENCE, STRAW WATTLE, SEDIMENT CONTROL, LOG, ETC.)


STAGING AREA

 
VEHICLE TRACKING CONTROL

GOOD HOUSEKEEPING

STREET SWEEPING

SURFACE FLOW DIRECTION

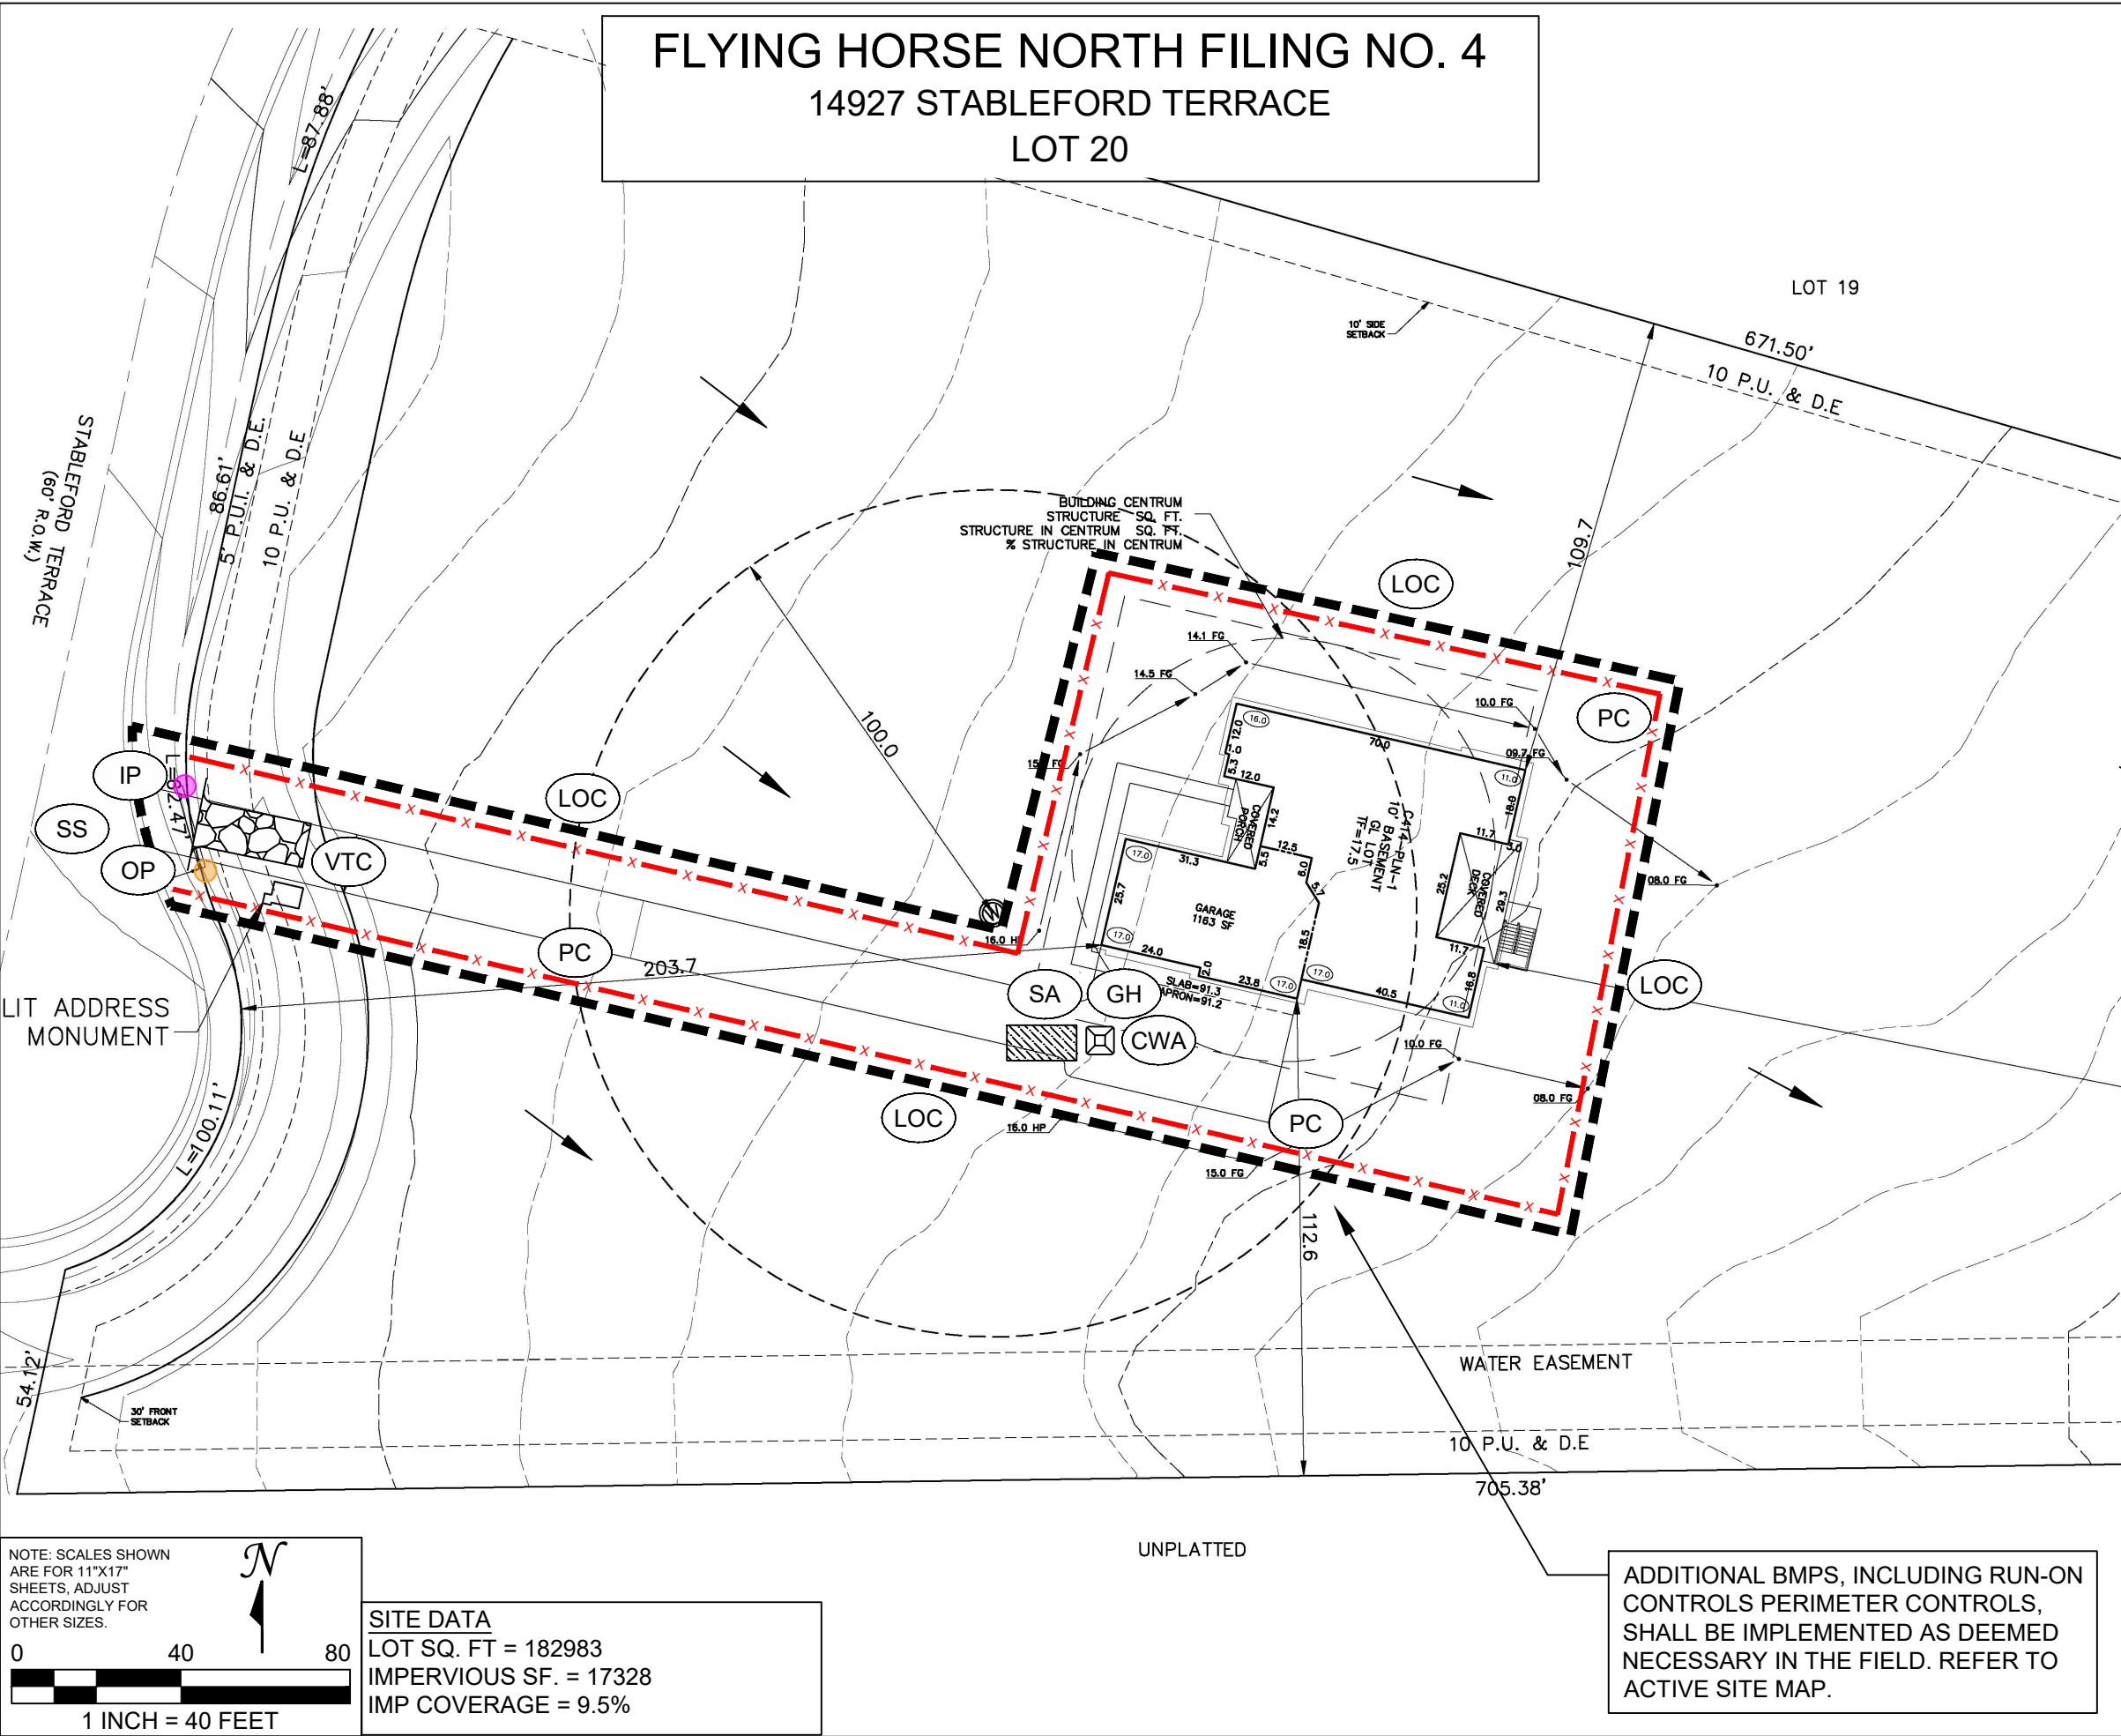


PROJECT:										FLYING HORSE NORTH FILING NO. 4																				5231 SOUTH QUEBEC STREET GREENWOOD VILLAGE, CO 80111 P: (303) 593-2107 F: (303) 923-3416 WWW.CMSENVIRO.COM										NO. DATE										0 08/18/2026										REVISIONS ORIGINAL										ENG CAD										SR TR																																																																																																																																																																																																																																																																																																																																																																																																																																																																																																																																																																																																																																																																																																																																																																																																																																																																																																																																																																																																																																																																																																																																																																																																																																																																																																																																																																																																																																																																																																																																																																																																																																																																																																																																																																																																																																																																																																																																																																																																																																																																																																																																																																																																																																																																																																																																																																																																																																																																																																																																																																																																																																																																																																																																																																																																																																																																																																																																																																																																																																																																																																																																																																																																																																																																																																																																																																																																																																																																																																																																																																																																																																																																																																																																																																																																																																																																																																																																																																																																																																																																																																																																																																																																																																																																																																																																																																																																																																																																																																																																																																																																																																																																																																																																																																																																																																																																																																																																																																																																																																																																																																																																																																																																																																																																																																																																																																																																																																																																																															
SHEET TITLE:										PLANNED EROSION AND SEDIMENT CONTROL - VERTICAL CONSTRUCTION																																																																																																																																																																																																																																																																																																																																																																																																																																																																																																																																																																																																																																																																																																																																																																																																																																																																																																																																																																																																																																																																																																																																																																																																																																																																																																																																																																																																																																																																																																																																																																																																																																																																																																																																																																																																																																																																																																																																																																																																																																																																																																																																																																																																																																																																																																																																																																																																																																																																																																																																																																																																																																																																																																																																																																																																																																																																																																																																																																																																																																																																																																																																																																																																																																																																																																																																																																																																																																																																																																																																																																																																																																																																																																																																																																																																																																																																																																																																																																																																																																																																																																																																																																																																																																																																																																																																																																																																																																																																																																																																																																																																																																																																																																																																																																																																																																																																																																																																																																																																																																																																																																																																																																																																																																																																																																																																																																																																																																																																																																																																																																					

1. LAND DEVELOPMENT BMPs WILL BE RELIED UPON UNTIL ACTIVE VERTICAL CONSTRUCTION BEGINS AT A LOT OR LOTS WHEREIN THE INDIVIDUAL LOT CONTROLS WILL BE APPLIED.
2. REFER TO CONSTRUCTION PLANS FOR FULL CONSTRUCTION DETAILS INCLUDING BENCHMARK.
3. SEQUENCING OF THE PROJECT WILL BE DETERMINED DURING CONSTRUCTION AND UPDATES CAN BE OBTAINED FROM SITE SUPERINTENDENT. REFER TO THE SITE MAP IN SECTION 2.1 OF THE SWMP FOR FURTHER SCHEDULING INFORMATION.
4. CONSTRUCTION AND DISTURBANCE OF THE GROUND WILL BE CONFINED TO THE LIMITS OF CONSTRUCTION AND THE LOTS WITHIN THE PERMITTED AREA. ANY UNEXPECTED DISTURBANCE OUTSIDE THE PERMITTED AREA WILL REQUIRE STABILIZATION AND POSSIBLE MODIFICATION OF THE PERMIT.
5. SOILS FROM FOUNDATION EXCAVATION WILL BE STOCKPILED ON EACH LOT OR THE ADJACENT LOT IF POSSIBLE. ENSURE PROPER LOADING OPERATIONS TAKE PLACE. REFER TO SWMP SECTION 3 FOR ADDITIONAL INFORMATION.
6. CWA LOCATION(S) WILL BE DETERMINED IN FIELD. THE CONCRETE WASHOUTS NEED TO BE INSTALLED PRIOR TO PLACING ANY CONCRETE ON THE SITE. ADEQUATE SIGNAGE SHALL BE PLACED AROUND THE PROJECT TO IDENTIFY THE LOCATION OF THE CONCRETE WASHOUT.
7. WORKERS WILL BE INSTRUCTED TO PARK ON PAVED ROADWAYS OR ADJACENT PARKING LOTS. IF AN ADDITIONAL STAGING AREA IS REQUIRED AT THIS POINT OF CONSTRUCTION IT WILL BE REFLECTED IN ACTIVE SITE MAP.
8. LOCATIONS OF VEHICLE TRACKING CONTROLS (VTC) ARE TO BE DETERMINED IN FIELD. MUD MATS OR MODIFIED VTC'S DO NOT NEED TO BE INSTALLED UNTIL DISTURBANCE OF AN AREA COMMENCES.
9. THE CONTRACTOR SHALL BE RESPONSIBLE FOR SWEEPING AND CLEAN UP OF ALL PAVED AREAS SURROUNDING THE PROJECT ON A DAILY BASIS, AS NEEDED DURING THE DAY WHEN SEDIMENT AND OTHER MATERIALS ARE TRACKED OR DISCHARGED ONTO THEM OR PRIOR TO ANY STORM EVENT. ADDITIONAL GOOD HOUSEKEEPING PRACTICES (PORTABLE TOILETS, DUMPSTERS) WILL BE IMPLEMENTED THROUGHOUT CONSTRUCTION AND WILL BE REFLECTED ON THE ACTIVE SITE MAP.
10. DEPLOYMENT AND/OR REMOVAL OF THE ABOVE BMP'S ARE DEPENDENT OF WORK SEQUENCING AND PROXIMITY TO EACH DISTURBANCE AREA. ADDITIONAL BMPs MAY BE REQUIRED PER THE DETAILS OR NARRATIVE.
11. IT IS THE PERMITTEE'S RESPONSIBILITY TO ADJUST OR REMOVE INLET PROTECTIONS AS NECESSARY PRIOR TO LARGE RAIN EVENTS THAT MAY EXCEED THE NORMAL CAPACITY OF THE INLET PROTECTION TO PREVENT FLOODING AND POTENTIAL PROPERTY DAMAGE.
12. ACTUAL LOCATIONS OF PERIMETER CONTROLS SHALL BE DETERMINED IN THE FIELD AND ADJUSTED AS NECESSARY TO PROVIDE EFFECTIVE SEDIMENT AND EROSION CONTROL THROUGHOUT CONSTRUCTION.


PLANNED CONTROL MEASURE LEGEND

		CWASHOUT AREA
		INLET PROTECTION
		OUTLET PROTECTION
		ROCK SOCK OR COMPARABLE BMP
		LIMITS OF CONSTRUCTION
		PERIMETER CONTROL (SILT FENCE STRAW WATTLE, OR COMPARABLE BMP)
		TREE LAWN CONTROLS (E.G. HEAVY WEIGHT WATTLE, SEDIMENT CONTROL, LOGS, ETC.)
		STAGING AREA
		VEHICLE TRACKING CONTROL
		GOOD HOUSEKEEPING
		STREET SWEEPING
		SURFACE FLOW DIRECTION

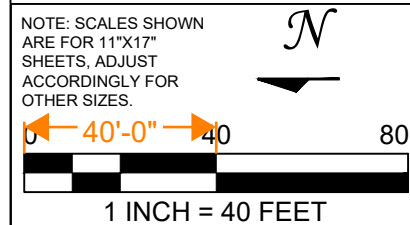

SITE DATA
LOT SQ. FT = 109299
IMPERVIOUS SF = 22180
IMP COVERAGE = 20.3%

I'm measuring closer to 9,500 sqft which would be approximately 9% imperviousness. Verify.

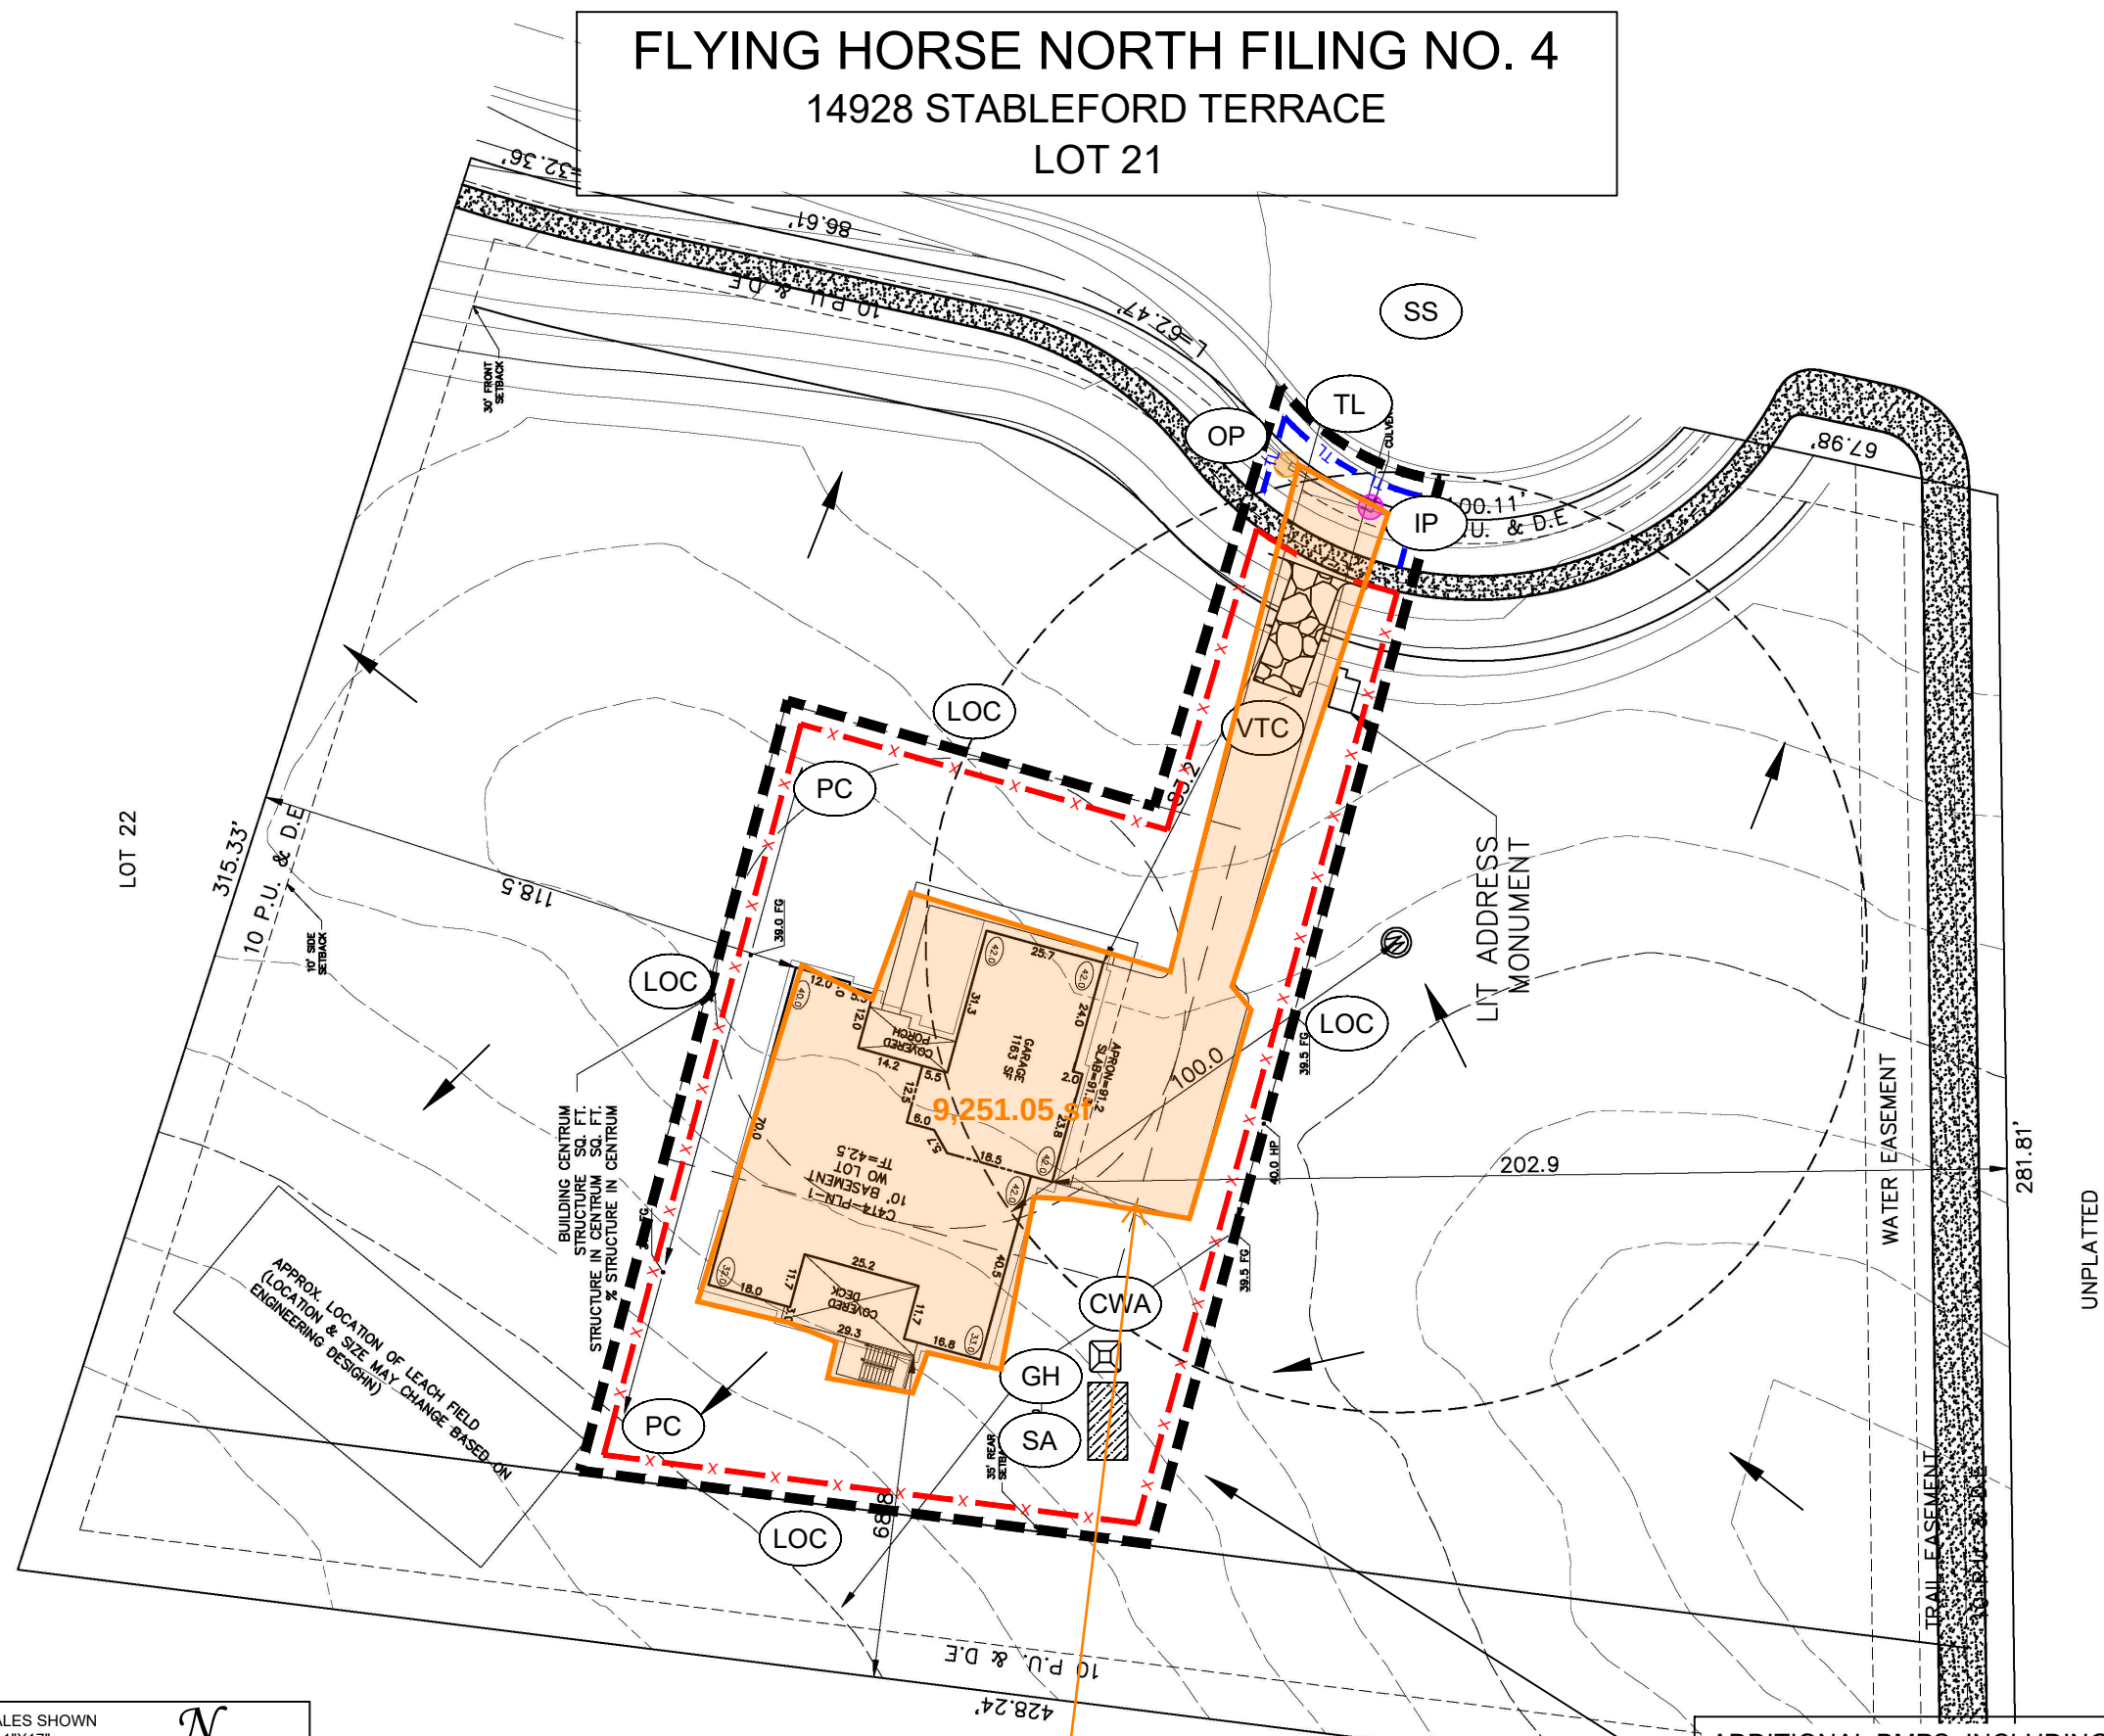

ADDITIONAL BMPs, INCLUDING RUN-ON CONTROLS PERIMETER CONTROLS, SHALL BE IMPLEMENTED AS DEEMED NECESSARY IN THE FIELD. REFER TO ACTIVE SITE MAP.


EC-6					
PROJECT: FLYING HORSE NORTH FILING NO. 4					
PROJECT #:		06-2025			
DATE:		10/07/2026			
DESIGN ENG:		TR			
CHECKED BY:		SR			
SHEET TITLE: PLANNED EROSION AND SEDIMENT CONTROL - VERTICAL CONSTRUCTION					
PERMITTEE: WEEKLEY HOMES LLC 7150 CAMPUS DR., SUITE 320 , COLORADO SPRINGS, CO 80920; (719) 431-0349					
		 CMS ENVIRONMENTAL SOLUTIONS			
		5231 SOUTH QUEBEC STREET GREENWOOD VILLAGE, CO 80111 P: (303) 893-2107 F: (303) 923-3416 WWW.CMSENVIRO.COM			
	NO.	DATE	ENG	SERIAL	REVISIONS
	0	08/18/2026			ORIGINAL

1. LAND DEVELOPMENT BMPs WILL BE RELIED UPON UNTIL ACTIVE VERTICAL CONSTRUCTION BEGINS AT A LOT OR LOTS WHEREIN THE INDIVIDUAL LOT CONTROLS WILL BE APPLIED.
2. REFER TO CONSTRUCTION PLANS FOR FULL CONSTRUCTION DETAILS INCLUDING BENCHMARK.
3. SEQUENCING OF THE PROJECT WILL BE DETERMINED DURING CONSTRUCTION AND UPDATES CAN BE OBTAINED FROM SITE SUPERINTENDENT. REFER TO THE SITE MAP IN SECTION 2.1 OF THE SWMP FOR FURTHER SCHEDULING INFORMATION.
4. CONSTRUCTION AND DISTURBANCE OF THE GROUND WILL BE CONFINED TO THE LIMITS OF CONSTRUCTION AND THE LOTS WITHIN THE PERMITTED AREA. ANY UNEXPECTED DISTURBANCE OUTSIDE THE PERMITTED AREA WILL REQUIRE STABILIZATION AND POSSIBLE MODIFICATION OF THE PERMIT.
5. SOILS FROM FOUNDATION EXCAVATION WILL BE STOCKPILED ON EACH LOT OR THE ADJACENT LOT IF POSSIBLE. ENSURE PROPER LOADING OPERATIONS TAKE PLACE. REFER TO SWMP SECTION 3 FOR ADDITIONAL INFORMATION.
6. CWA LOCATION(S) WILL BE DETERMINED IN FIELD. THE CONCRETE WASHOUTS NEED TO BE INSTALLED PRIOR TO PLACING ANY CONCRETE ON THE SITE. ADEQUATE SIGNAGE SHALL BE PLACED AROUND THE PROJECT TO IDENTIFY THE LOCATION OF THE CONCRETE WASHOUT.
7. WORKERS WILL BE INSTRUCTED TO PARK ON PAVED ROADWAYS OR ADJACENT PARKING LOTS. IF AN ADDITIONAL STAGING AREA IS REQUIRED AT THIS POINT OF CONSTRUCTION IT WILL BE REFLECTED IN ACTIVE SITE MAP.
8. LOCATIONS OF VEHICLE TRACKING CONTROLS (VTC) ARE TO BE DETERMINED IN FIELD. MUD MATS OR MODIFIED VTC'S DO NOT NEED TO BE INSTALLED UNTIL DISTURBANCE OF AN AREA COMMENCES.
9. THE CONTRACTOR SHALL BE RESPONSIBLE FOR SWEEPING AND CLEAN UP OF ALL PAVED AREAS SURROUNDING THE PROJECT ON A DAILY BASIS, AS NEEDED DURING THE DAY WHEN SEDIMENT AND OTHER MATERIALS ARE TRACKED OR DISCHARGED ONTO THEM OR PRIOR TO ANY STORM EVENT. ADDITIONAL GOOD HOUSEKEEPING PRACTICES (PORTABLE TOILETS, DUMPSTERS) WILL BE IMPLEMENTED THROUGHOUT CONSTRUCTION AND WILL BE REFLECTED ON THE ACTIVE SITE MAP.
10. DEPLOYMENT AND/OR REMOVAL OF THE ABOVE BMP'S ARE DEPENDENT OF WORK SEQUENCING AND PROXIMITY TO EACH DISTURBANCE AREA. ADDITIONAL BMPs MAY BE REQUIRED PER THE DETAILS OR NARRATIVE.
11. IT IS THE PERMITTEE'S RESPONSIBILITY TO ADJUST OR REMOVE INLET PROTECTIONS AS NECESSARY PRIOR TO LARGE RAIN EVENTS THAT MAY EXCEED THE NORMAL CAPACITY OF THE INLET PROTECTION TO PREVENT FLOODING AND POTENTIAL PROPERTY DAMAGE.
12. ACTUAL LOCATIONS OF PERIMETER CONTROLS SHALL BE DETERMINED IN THE FIELD AND ADJUSTED AS NECESSARY TO PROVIDE EFFECTIVE SEDIMENT AND EROSION CONTROL THROUGHOUT CONSTRUCTION.

1. LAND DEVELOPMENT BMPs WILL BE RELIED UPON UNTIL ACTIVE VERTICAL CONSTRUCTION BEGINS AT A LOT OR LOTS WHEREIN THE INDIVIDUAL LOT CONTROLS WILL BE APPLIED.
2. REFER TO CONSTRUCTION PLANS FOR FULL CONSTRUCTION DETAILS INCLUDING BENCHMARK.
3. SEQUENCING OF THE PROJECT WILL BE DETERMINED DURING CONSTRUCTION AND UPDATES CAN BE OBTAINED FROM SITE SUPERINTENDENT. REFER TO THE SITE MAP IN SECTION 2.1 OF THE SWMP FOR FURTHER SCHEDULING INFORMATION.
4. CONSTRUCTION AND DISTURBANCE OF THE GROUND WILL BE CONFINED TO THE LIMITS OF CONSTRUCTION AND THE LOTS WITHIN THE PERMITTED AREA. ANY UNEXPECTED DISTURBANCE OUTSIDE THE PERMITTED AREA WILL REQUIRE STABILIZATION AND POSSIBLE MODIFICATION OF THE PERMIT.
5. SOILS FROM FOUNDATION EXCAVATION WILL BE STOCKPILED ON EACH LOT OR THE ADJACENT LOT IF POSSIBLE. ENSURE PROPER LOADING OPERATIONS TAKE PLACE. REFER TO SWMP SECTION 3 FOR ADDITIONAL INFORMATION.
6. CWA LOCATION(S) WILL BE DETERMINED IN FIELD. THE CONCRETE WASHOUTS NEED TO BE INSTALLED PRIOR TO PLACING ANY CONCRETE ON THE SITE. ADEQUATE SIGNAGE SHALL BE PLACED AROUND THE PROJECT TO IDENTIFY THE LOCATION OF THE CONCRETE WASHOUT.
7. WORKERS WILL BE INSTRUCTED TO PARK ON PAVED ROADWAYS OR ADJACENT PARKING LOTS. IF AN ADDITIONAL STAGING AREA IS REQUIRED AT THIS POINT OF CONSTRUCTION IT WILL BE REFLECTED IN ACTIVE SITE MAP.
8. LOCATIONS OF VEHICLE TRACKING CONTROLS (VTC) ARE TO BE DETERMINED IN FIELD. MUD MATS OR MODIFIED VTC'S DO NOT NEED TO BE INSTALLED UNTIL DISTURBANCE OF AN AREA COMMENCES.
9. THE CONTRACTOR SHALL BE RESPONSIBLE FOR SWEEPING AND CLEAN UP OF ALL PAVED AREAS SURROUNDING THE PROJECT ON A DAILY BASIS, AS NEEDED DURING THE DAY WHEN SEDIMENT AND OTHER MATERIALS ARE TRACKED OR DISCHARGED ONTO THEM OR PRIOR TO ANY STORM EVENT. ADDITIONAL GOOD HOUSEKEEPING PRACTICES (PORTABLE TOILETS, DUMPSTERS) WILL BE IMPLEMENTED THROUGHOUT CONSTRUCTION AND WILL BE REFLECTED ON THE ACTIVE SITE MAP.
10. DEPLOYMENT AND/OR REMOVAL OF THE ABOVE BMP'S ARE DEPENDENT OF WORK SEQUENCING AND PROXIMITY TO EACH DISTURBANCE AREA. ADDITIONAL BMPs MAY BE REQUIRED PER THE DETAILS OR NARRATIVE.
11. IT IS THE PERMITTEE'S RESPONSIBILITY TO ADJUST OR REMOVE INLET PROTECTIONS AS NECESSARY PRIOR TO LARGE RAIN EVENTS THAT MAY EXCEED THE NORMAL CAPACITY OF THE INLET PROTECTION TO PREVENT FLOODING AND POTENTIAL PROPERTY DAMAGE.
12. ACTUAL LOCATIONS OF PERIMETER CONTROLS SHALL BE DETERMINED IN THE FIELD AND ADJUSTED AS NECESSARY TO PROVIDE EFFECTIVE SEDIMENT AND EROSION CONTROL THROUGHOUT CONSTRUCTION.

		CONCRETE WASHOUT AREA
		INLET PROTECTION
		OUTLET PROTECTION
		ROCK SOCK OR COMPARABLE BMP
		LIMITS OF CONSTRUCTION
		PERIMETER CONTROL (EG. FENCE, STRAW BATTLE, OR COMPARABLE BMP)
		TREE LAWN CONTROL (EG. HEAVY WEIGHT WAIT-LT. SEDIMENT CONTROL, LOG, ETC.)
		STAGING AREA
		VEHICLE TRACKING CONTROL
		GOOD HOUSEKEEPING
		STREET SWEEPING
		SURFACE FLOW DIRECTION

I'm measuring closer to 9 which would be approximately imperviousness. Verify.

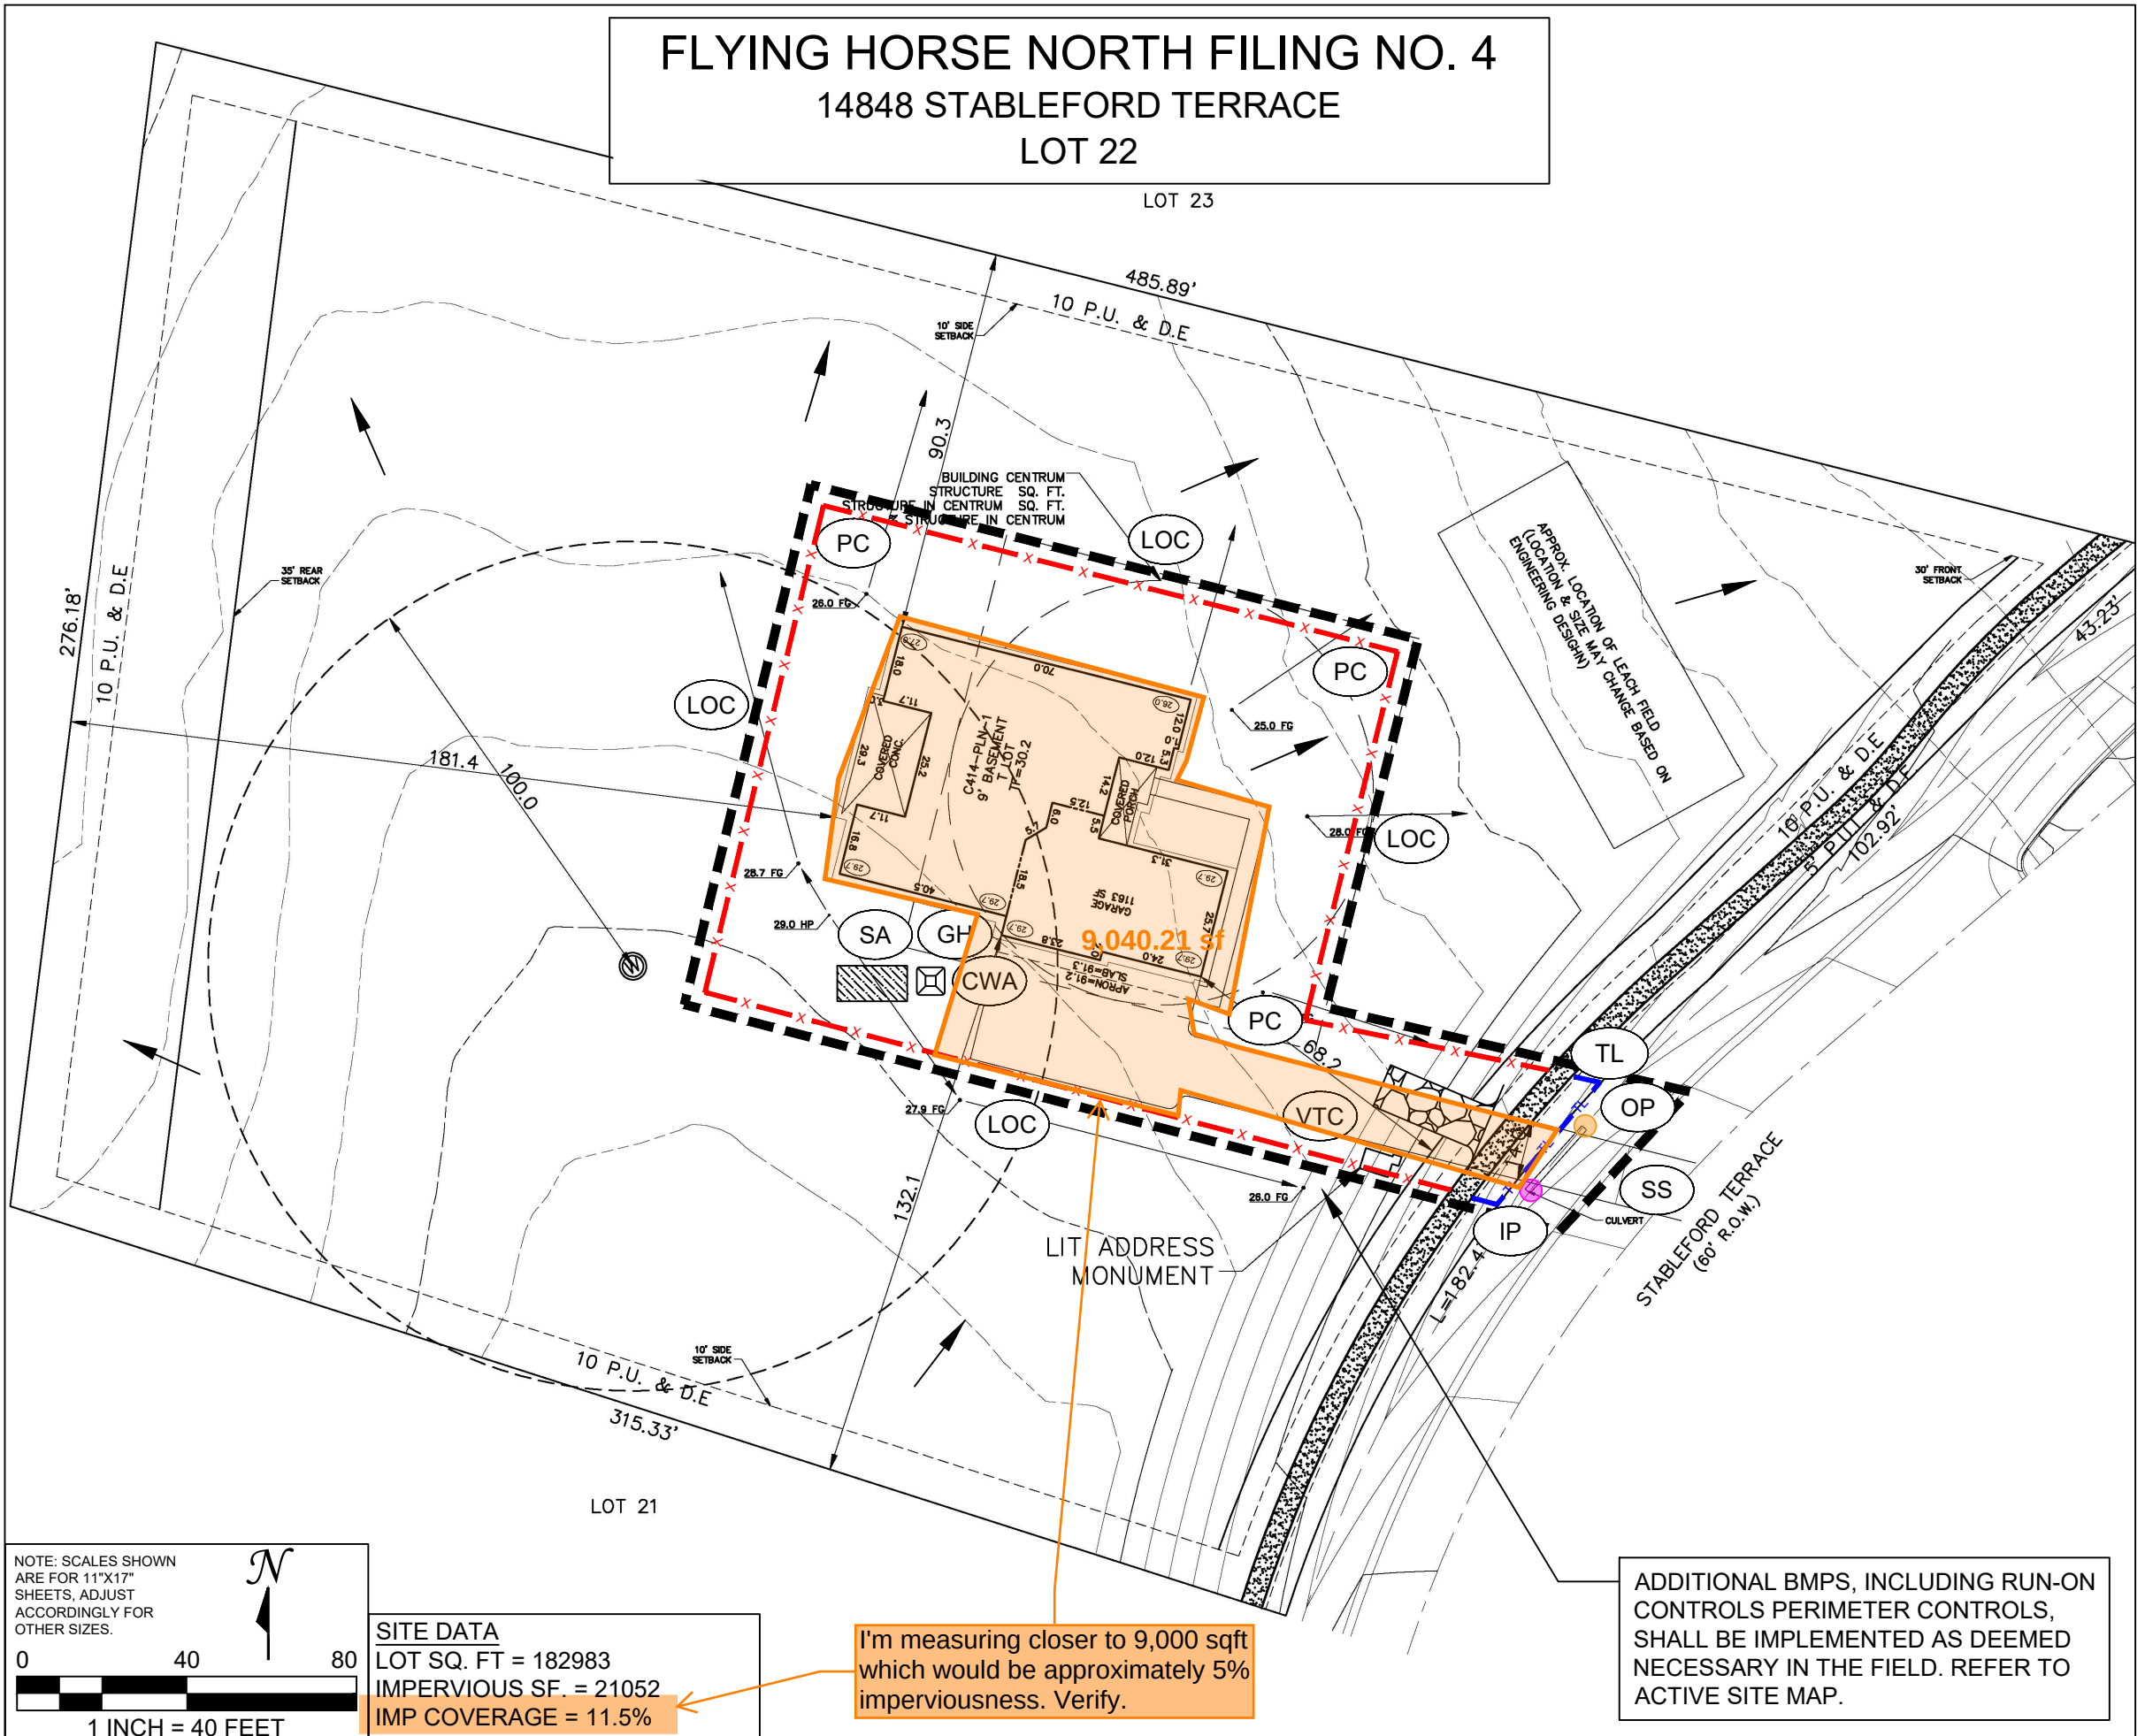

ADDITIONAL BMPS, INCLUDING RUN-ON CONTROLS PERIMETER CONTROLS, SHALL BE IMPLEMENTED AS DEEMED NECESSARY IN THE FIELD. REFER TO ACTIVE SITE MAP.


[illegible]

VERTICAL CONSTRUCTION NOTES:

1. LAND DEVELOPMENT BMPS WILL BE RELIED UPON UNTIL ACTIVE VERTICAL CONSTRUCTION BEGINS AT A LOT OR LOTS WHEREIN THE INDIVIDUAL LOT CONTROLS WILL BE APPLIED.
2. REFER TO CONSTRUCTION PLANS FOR FULL CONSTRUCTION DETAILS INCLUDING BENCHMARK.
3. SEQUENCING OF THE PROJECT WILL BE DETERMINED DURING CONSTRUCTION AND UPDATES CAN BE OBTAINED FROM SITE SUPERINTENDENT. REFER TO THE SITE MAP IN SECTION 2.1 OF THE SWMP FOR FURTHER SCHEDULING INFORMATION.
4. CONSTRUCTION AND DISTURBANCE OF THE GROUND WILL BE CONFINED TO THE LIMITS OF CONSTRUCTION AND THE LOTS WITHIN THE PERMITTED AREA. ANY UNEXPECTED DISTURBANCE OUTSIDE THE PERMITTED AREA WILL REQUIRE STABILIZATION AND POSSIBLE MODIFICATION OF THE PERMIT.
5. SOILS FROM FOUNDATION EXCAVATION WILL BE STOCKPILED ON EACH LOT OR THE ADJACENT LOT IF POSSIBLE. ENSURE PROPER LOADING OPERATIONS TAKE PLACE. REFER TO SWMP SECTION 3 FOR ADDITIONAL INFORMATION.
6. CWA LOCATION(S) WILL BE DETERMINED IN FIELD. THE CONCRETE WASHOUTS NEED TO BE INSTALLED PRIOR TO PLACING ANY CONCRETE ON THE SITE. ADEQUATE SIGNAGE SHALL BE PLACED AROUND THE PROJECT TO IDENTIFY THE LOCATION OF THE CONCRETE WASHOUT.
7. WORKERS WILL BE INSTRUCTED TO PARK ON PAVED ROADWAYS OR ADJACENT PARKING LOTS. IF AN ADDITIONAL STAGING AREA IS REQUIRED AT THIS POINT OF CONSTRUCTION IT WILL BE REFLECTED IN ACTIVE SITE MAP.
8. LOCATIONS OF VEHICLE TRACKING CONTROLS (VTC) ARE TO BE DETERMINED IN FIELD. MUD MATS OR MODIFIED VTC'S DO NOT NEED TO BE INSTALLED UNTIL DISTURBANCE OF AN AREA COMMENCES.
9. THE CONTRACTOR SHALL BE RESPONSIBLE FOR SWEEPING AND CLEAN UP OF ALL PAVED AREAS SURROUNDING THE PROJECT ON A DAILY BASIS, AS NEEDED DURING THE DAY WHEN SEDIMENT AND OTHER MATERIALS ARE TRACKED OR DISCHARGED ONTO THEM OR PRIOR TO ANY STORM EVENT. ADDITIONAL GOOD HOUSEKEEPING PRACTICES (PORTABLE TOILETS, DUMPSTERS) WILL BE IMPLEMENTED THROUGHOUT CONSTRUCTION AND WILL BE REFLECTED ON THE ACTIVE SITE MAP.
10. DEPLOYMENT AND/OR REMOVAL OF THE ABOVE BMP'S ARE DEPENDENT OF WORK SEQUENCING AND PROXIMITY TO EACH DISTURBANCE AREA. ADDITIONAL BMPS MAY BE REQUIRED PER THE DETAILS OR NARRATIVE.
11. IT IS THE PERMITTEE'S RESPONSIBILITY TO ADJUST OR REMOVE INLET PROTECTIONS AS NECESSARY PRIOR TO LARGE RAIN EVENTS THAT MAY EXCEED THE NORMAL CAPACITY OF THE INLET PROTECTION TO PREVENT FLOODING AND POTENTIAL PROPERTY DAMAGE.
12. ACTUAL LOCATIONS OF PERIMETER CONTROLS SHALL BE DETERMINED IN THE FIELD AND ADJUSTED AS NECESSARY TO PROVIDE EFFECTIVE SEDIMENT AND EROSION CONTROL THROUGHOUT CONSTRUCTION.

PLANNED CONTROL MEASURE LEGEND

	CWA	CONCRETE WASHOUT AREA
	IP	INLET PROTECTION
	OP	OUTLET PROTECTION
	RS	ROCK SOCK OR COMPARABLE BMP
	LOC	LIMITS OF CONSTRUCTION
	PC	PERIMETER CONTROL (SILT FENCE STRAW WATTLE OR COMPARABLE BMP)
	TL	TREE LAWN CONTROLS (SILT FENCE STRAW WATTLE, SEDIMENT CONTROL LOG, ETC.)
	SA	STAGING AREA
	VTC	VEHICLE TRACKING CONTROL
	GH	GOOD HOUSEKEEPING
	SS	STREET SWEEPING
		SURFACE FLOW DIRECTION

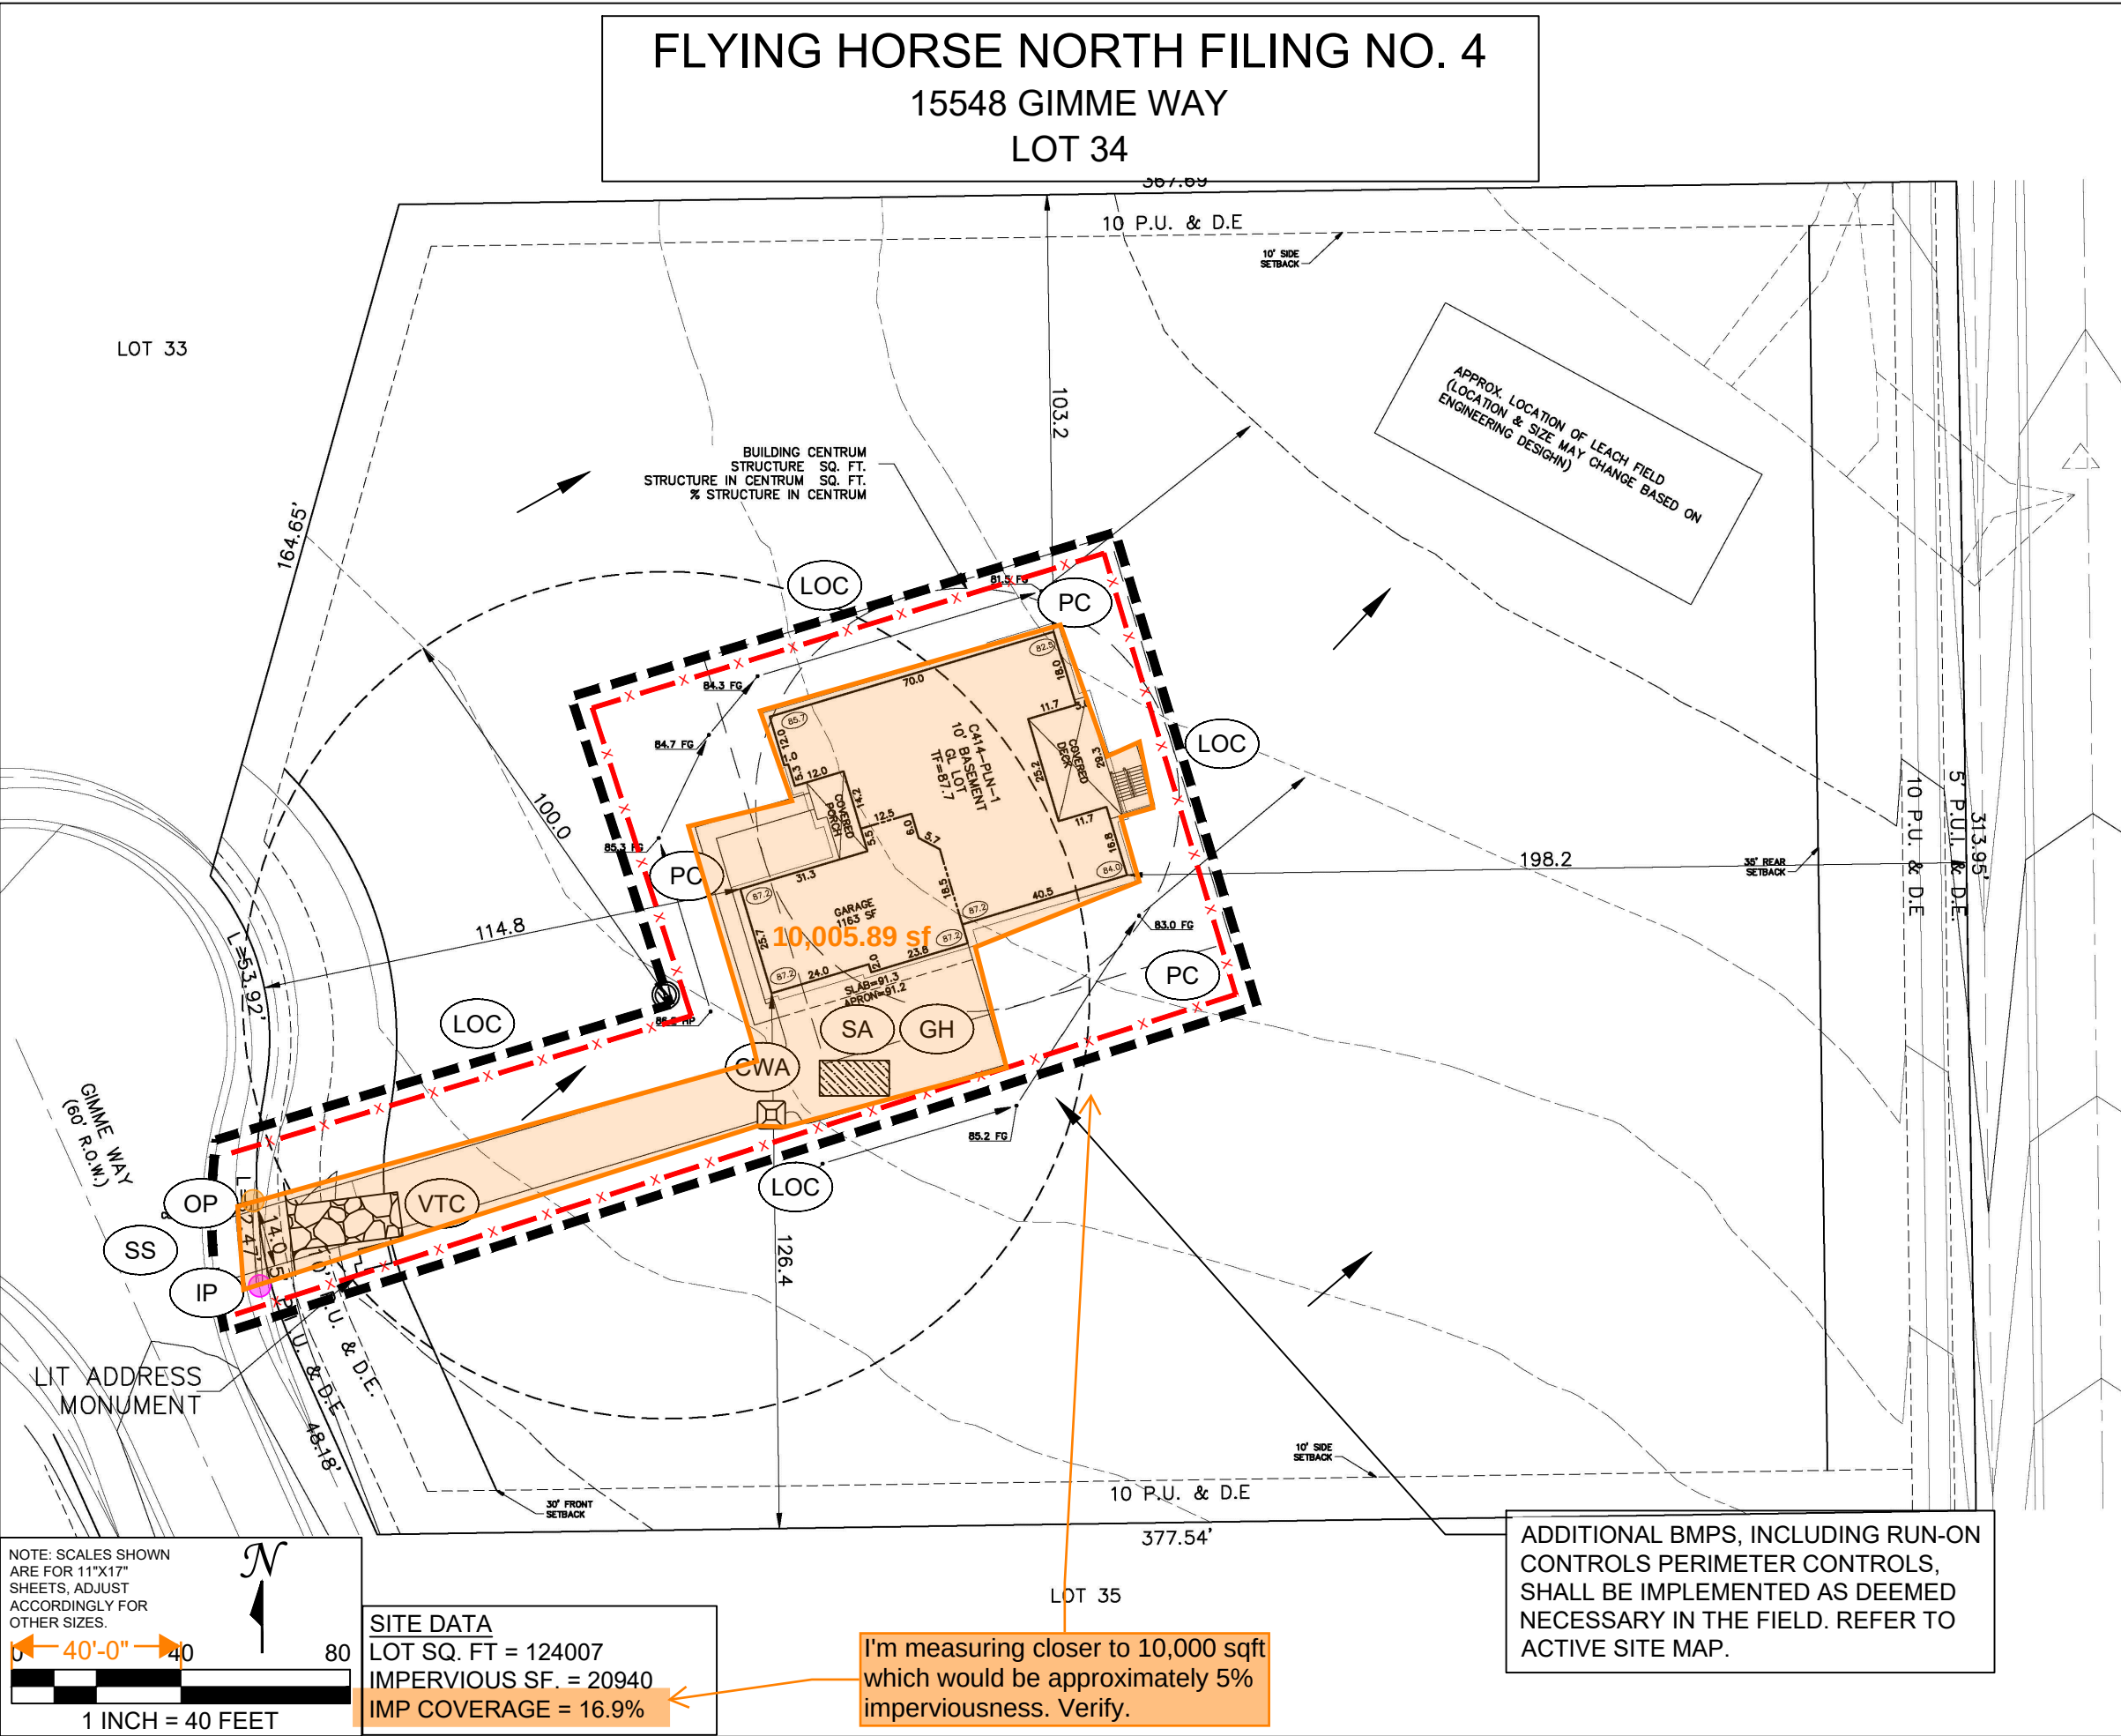


ENG	CAD	SR	TR
REVISIONS	ORIGINAL		
DATE	08/18/2026		
NO.	0		
5231 SOUTH QUEBEC STREET GREENWOOD VILLAGE, CO 80111 P: (303) 593-2107 F: (303) 923-3416 WWW.CMSENVIRO.COM			
PROJECT: FLYING HORSE NORTH FILING NO. 4			
SHEET TITLE: PLANNED EROSION AND SEDIMENT CONTROL - VERTICAL CONSTRUCTION			
PERMITTEE: WEEKLEY HOMES LLC			
7150 CAMPUS DR, SUITE 320, COLORADO SPRINGS, CO 80920; (719) 431-0349			
PROJ #:	06-2025		
DATE:	10/07/2026		
DESIGN ENG:	TR		
CHECKED BY:	SR		
EC-8			

1. LAND DEVELOPMENT BMPs WILL BE RELIED UPON UNTIL ACTIVE VERTICAL CONSTRUCTION BEGINS AT A LOT OR LOTS WHEREIN THE INDIVIDUAL LOT CONTROLS WILL BE APPLIED.
2. REFER TO CONSTRUCTION PLANS FOR FULL CONSTRUCTION DETAILS INCLUDING BENCHMARK.
3. SEQUENCING OF THE PROJECT WILL BE DETERMINED DURING CONSTRUCTION AND UPDATES CAN BE OBTAINED FROM SITE SUPERINTENDENT. REFER TO THE SITE MAP IN SECTION 2.1 OF THE SWMP FOR FURTHER SCHEDULING INFORMATION.
4. CONSTRUCTION AND DISTURBANCE OF THE GROUND WILL BE CONFINED TO THE LIMITS OF CONSTRUCTION AND THE LOTS WITHIN THE PERMITTED AREA. ANY UNEXPECTED DISTURBANCE OUTSIDE THE PERMITTED AREA WILL REQUIRE STABILIZATION AND POSSIBLE MODIFICATION OF THE PERMIT.
5. SOILS FROM FOUNDATION EXCAVATION WILL BE STOCKPILED ON EACH LOT OR THE ADJACENT LOT IF POSSIBLE. ENSURE PROPER LOADING OPERATIONS TAKE PLACE. REFER TO SWMP SECTION 3 FOR ADDITIONAL INFORMATION.
6. CWA LOCATION(S) WILL BE DETERMINED IN FIELD. THE CONCRETE WASHOUTS NEED TO BE INSTALLED PRIOR TO PLACING ANY CONCRETE ON THE SITE. ADEQUATE SIGNAGE SHALL BE PLACED AROUND THE PROJECT TO IDENTIFY THE LOCATION OF THE CONCRETE WASHOUT.
7. WORKERS WILL BE INSTRUCTED TO PARK ON PAVED ROADWAYS OR ADJACENT PARKING LOTS. IF AN ADDITIONAL STAGING AREA IS REQUIRED AT THIS POINT OF CONSTRUCTION IT WILL BE REFLECTED IN ACTIVE SITE MAP.
8. LOCATIONS OF VEHICLE TRACKING CONTROLS (VTC) ARE TO BE DETERMINED IN FIELD. MUD MATS OR MODIFIED VTC'S DO NOT NEED TO BE INSTALLED UNTIL DISTURBANCE OF AN AREA COMMENCES.
9. THE CONTRACTOR SHALL BE RESPONSIBLE FOR SWEEPING AND CLEAN UP OF ALL PAVED AREAS SURROUNDING THE PROJECT ON A DAILY BASIS, AS NEEDED DURING THE DAY WHEN SEDIMENT AND OTHER MATERIALS ARE TRACKED OR DISCHARGED ONTO THEM OR PRIOR TO ANY STORM EVENT. ADDITIONAL GOOD HOUSEKEEPING PRACTICES (PORTABLE TOILETS, DUMPSTERS) WILL BE IMPLEMENTED THROUGHOUT CONSTRUCTION AND WILL BE REFLECTED ON THE ACTIVE SITE MAP.
10. DEPLOYMENT AND/OR REMOVAL OF THE ABOVE BMP'S ARE DEPENDENT OF WORK SEQUENCING AND PROXIMITY TO EACH DISTURBANCE AREA. ADDITIONAL BMPs MAY BE REQUIRED PER THE DETAILS OR NARRATIVE.
11. IT IS THE PERMITTEE'S RESPONSIBILITY TO ADJUST OR REMOVE INLET PROTECTIONS AS NECESSARY PRIOR TO LARGE RAIN EVENTS THAT MAY EXCEED THE NORMAL CAPACITY OF THE INLET PROTECTION TO PREVENT FLOODING AND POTENTIAL PROPERTY DAMAGE.
12. ACTUAL LOCATIONS OF PERIMETER CONTROLS SHALL BE DETERMINED IN THE FIELD AND ADJUSTED AS NECESSARY TO PROVIDE EFFECTIVE SEDIMENT AND EROSION CONTROL THROUGHOUT CONSTRUCTION.

1. LAND DEVELOPMENT BMPs WILL BE RELIED UPON UNTIL ACTIVE VERTICAL CONSTRUCTION BEGINS AT A LOT OR LOTS WHEREIN THE INDIVIDUAL LOT CONTROLS WILL BE APPLIED.
2. REFER TO CONSTRUCTION PLANS FOR FULL CONSTRUCTION DETAILS INCLUDING BENCHMARK.
3. SEQUENCING OF THE PROJECT WILL BE DETERMINED DURING CONSTRUCTION AND UPDATES CAN BE OBTAINED FROM SITE SUPERINTENDENT. REFER TO THE SITE MAP IN SECTION 2.1 OF THE SWMP FOR FURTHER SCHEDULING INFORMATION.
4. CONSTRUCTION AND DISTURBANCE OF THE GROUND WILL BE CONFINED TO THE LIMITS OF CONSTRUCTION AND THE LOTS WITHIN THE PERMITTED AREA. ANY UNEXPECTED DISTURBANCE OUTSIDE THE PERMITTED AREA WILL REQUIRE STABILIZATION AND POSSIBLE MODIFICATION OF THE PERMIT.
5. SOILS FROM FOUNDATION EXCAVATION WILL BE STOCKPILED ON EACH LOT OR THE ADJACENT LOT IF POSSIBLE. ENSURE PROPER LOADING OPERATIONS TAKE PLACE. REFER TO SWMP SECTION 3 FOR ADDITIONAL INFORMATION.
6. CWA LOCATION(S) WILL BE DETERMINED IN FIELD. THE CONCRETE WASHOUTS NEED TO BE INSTALLED PRIOR TO PLACING ANY CONCRETE ON THE SITE. ADEQUATE SIGNAGE SHALL BE PLACED AROUND THE PROJECT TO IDENTIFY THE LOCATION OF THE CONCRETE WASHOUT.
7. WORKERS WILL BE INSTRUCTED TO PARK ON PAVED ROADWAYS OR ADJACENT PARKING LOTS. IF AN ADDITIONAL STAGING AREA IS REQUIRED AT THIS POINT OF CONSTRUCTION IT WILL BE REFLECTED IN ACTIVE SITE MAP.
8. LOCATIONS OF VEHICLE TRACKING CONTROLS (VTC) ARE TO BE DETERMINED IN FIELD. MUD MATS OR MODIFIED VTC'S DO NOT NEED TO BE INSTALLED UNTIL DISTURBANCE OF AN AREA COMMENCES.
9. THE CONTRACTOR SHALL BE RESPONSIBLE FOR SWEEPING AND CLEAN UP OF ALL PAVED AREAS SURROUNDING THE PROJECT ON A DAILY BASIS, AS NEEDED DURING THE DAY WHEN SEDIMENT AND OTHER MATERIALS ARE TRACKED OR DISCHARGED ONTO THEM OR PRIOR TO ANY STORM EVENT. ADDITIONAL GOOD HOUSEKEEPING PRACTICES (PORTABLE TOILETS, DUMPSTERS) WILL BE IMPLEMENTED THROUGHOUT CONSTRUCTION AND WILL BE REFLECTED ON THE ACTIVE SITE MAP.
10. DEPLOYMENT AND/OR REMOVAL OF THE ABOVE BMP'S ARE DEPENDENT OF WORK SEQUENCING AND PROXIMITY TO EACH DISTURBANCE AREA. ADDITIONAL BMPs MAY BE REQUIRED PER THE DETAILS OR NARRATIVE.
11. IT IS THE PERMITTEE'S RESPONSIBILITY TO ADJUST OR REMOVE INLET PROTECTIONS AS NECESSARY PRIOR TO LARGE RAIN EVENTS THAT MAY EXCEED THE NORMAL CAPACITY OF THE INLET PROTECTION TO PREVENT FLOODING AND POTENTIAL PROPERTY DAMAGE.
12. ACTUAL LOCATIONS OF PERIMETER CONTROLS SHALL BE DETERMINED IN THE FIELD AND ADJUSTED AS NECESSARY TO PROVIDE EFFECTIVE SEDIMENT AND EROSION CONTROL THROUGHOUT CONSTRUCTION.


		CONCRETE WASHOUT AREA
		INLET PROTECTION
		OUTLET PROTECTION
		ROCK SOCK OR COMPARABLE BMP
		LIMITS OF CONSTRUCTION
		PERIMETER CONTROL (FENCE, HEAVY WATTLE, OR COMPARABLE BMP)
		THREE LAWN CONTROLS (E.G., HEAVY WATTLE, WATTLE SEDIMENT CONTROL LOG, ETC.)
		STAGING AREA
		VEHICLE TRACKING CONTROL
		GOOD HOUSEKEEPING
		STREET SWEEPING
		SURFACE FLOW DIRECTION

NOTE: SCALES SHOWN
ARE FOR 11"X17"
SHEETS, ADJUST
ACCORDINGLY FOR
OTHER SIZES.

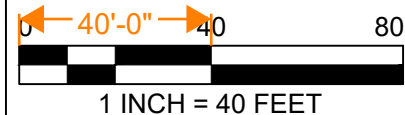

LOT SQ. FT = 110884
IMPERVIOUS SF. = 19493
IMP COVERAGE = 17.6%

I'm measuring closer to 9,500 sqft which would be approximately 9% imperviousness. Verify.

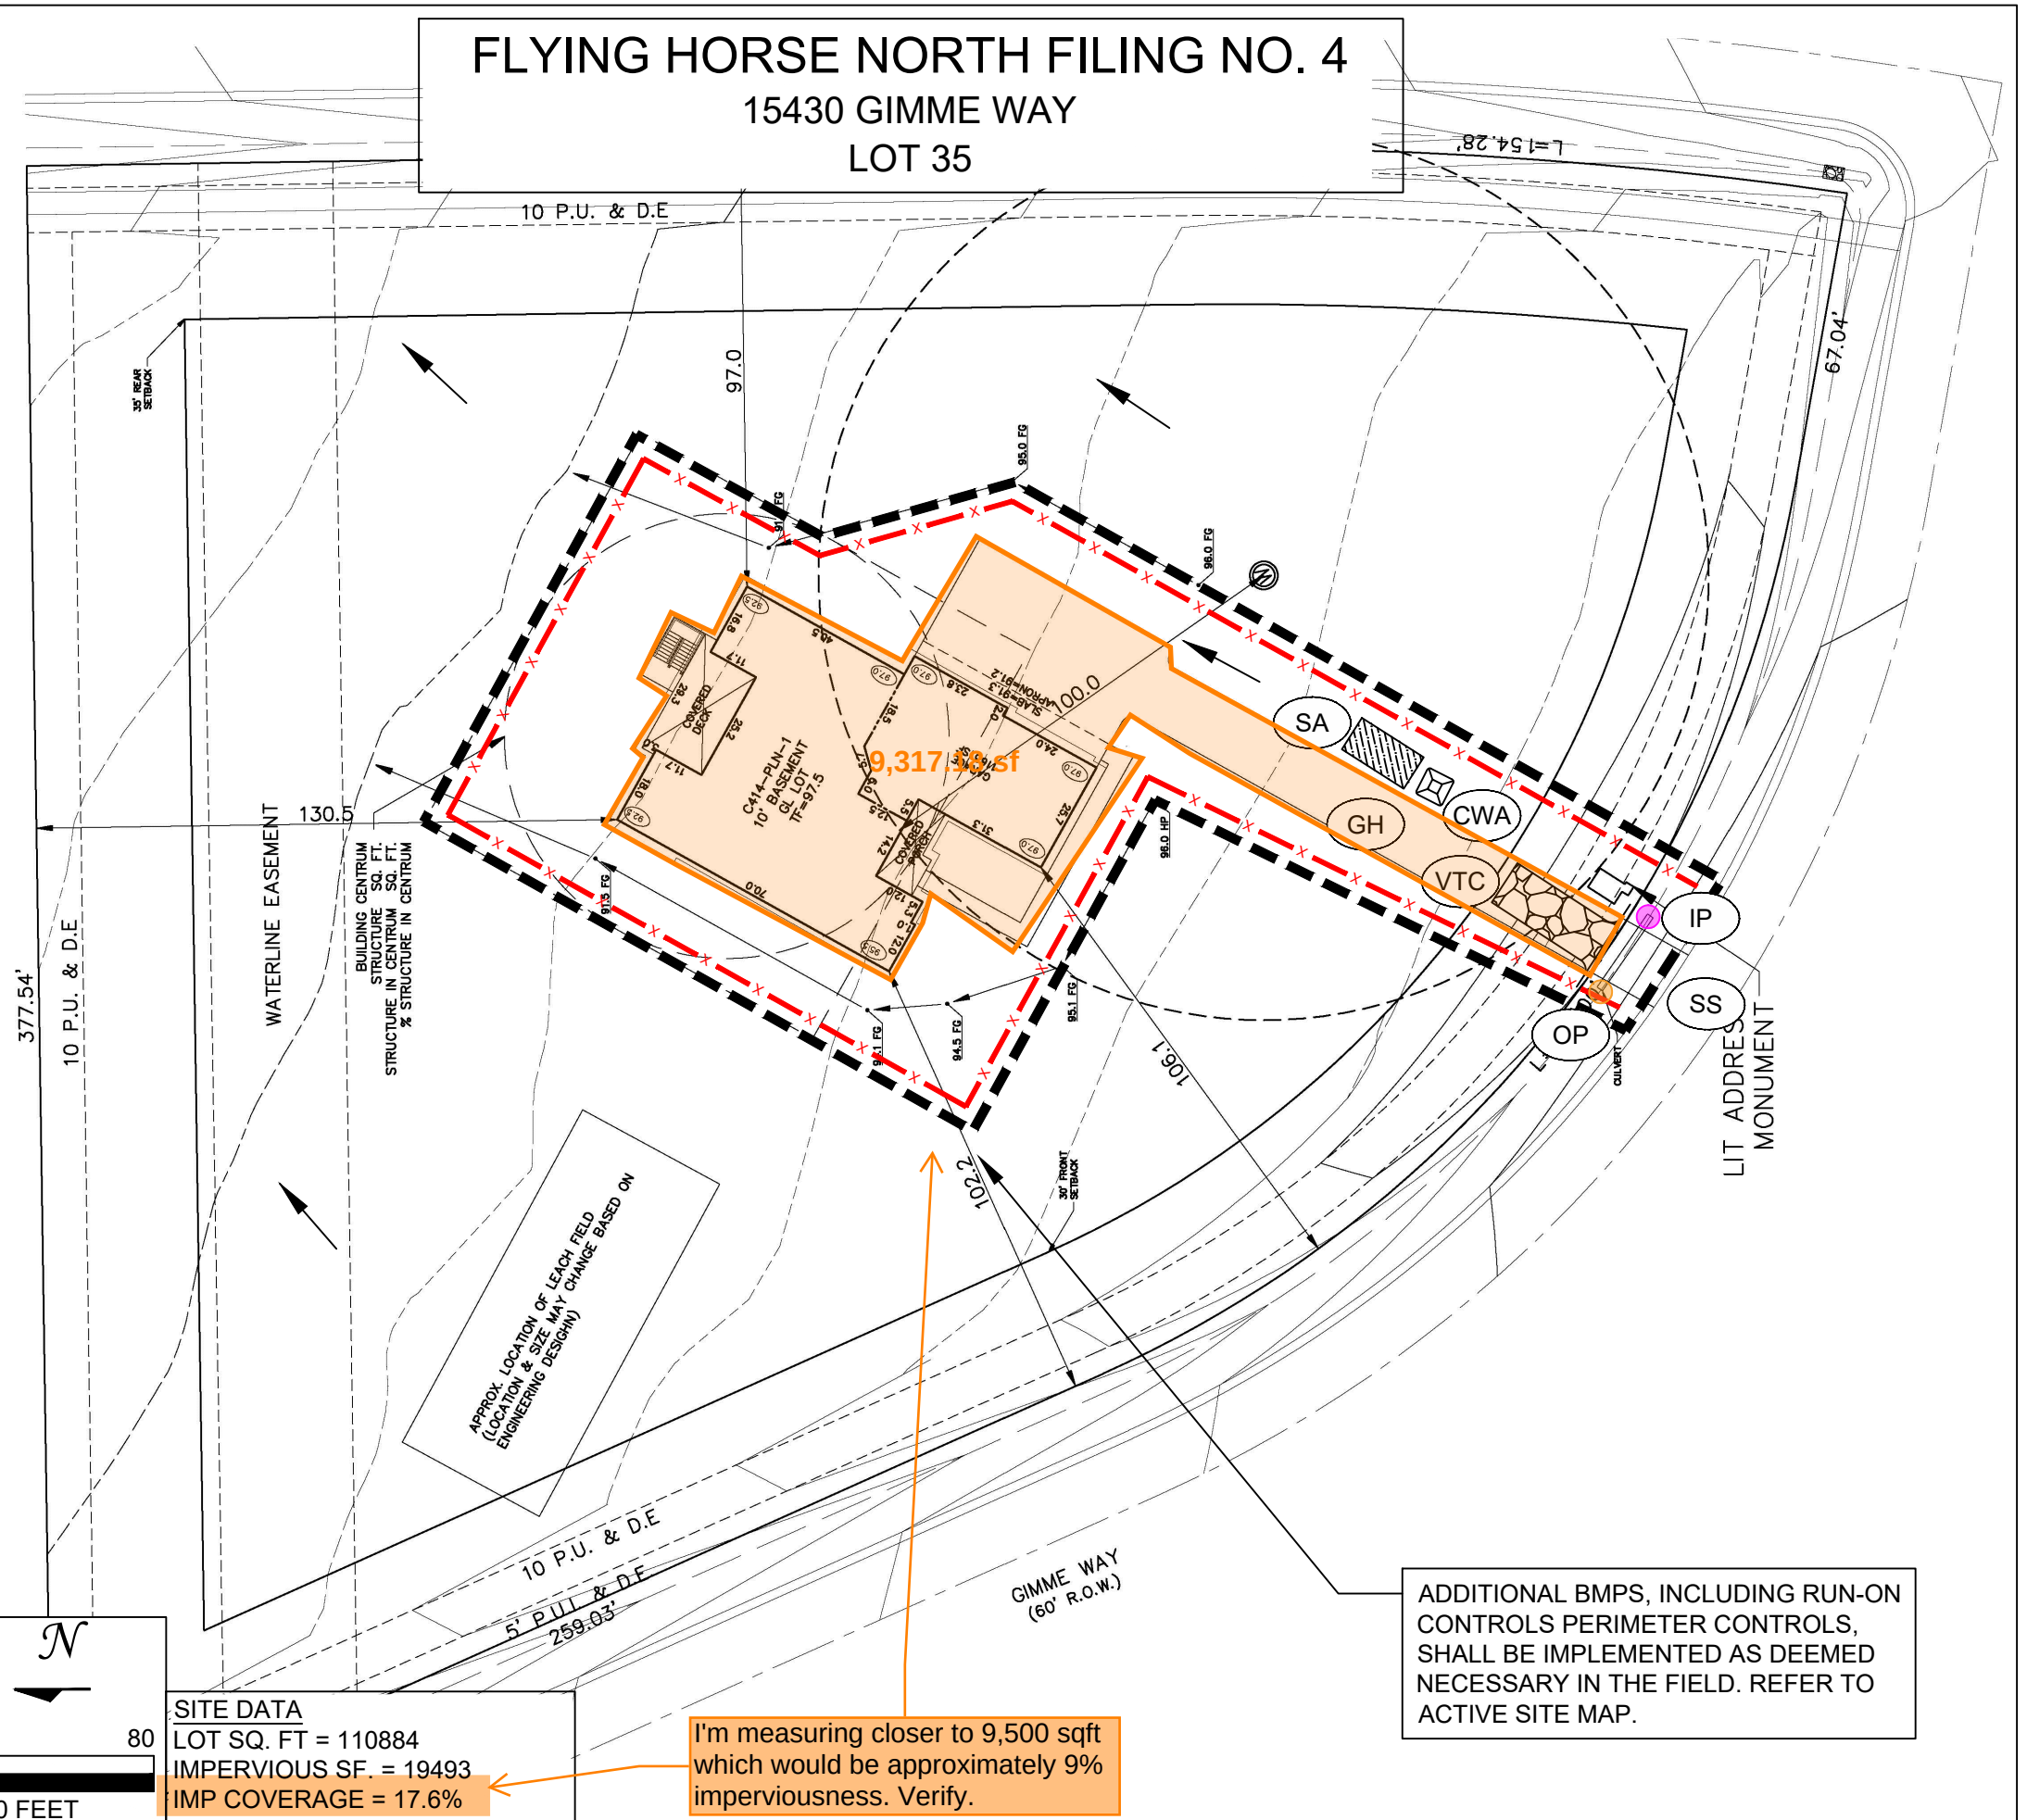


ADDITIONAL BMPs, INCLUDING RUN-ON CONTROLS PERIMETER CONTROLS, SHALL BE IMPLEMENTED AS DEEMED NECESSARY IN THE FIELD. REFER TO ACTIVE SITE MAP.

[illegible]

1. LAND DEVELOPMENT BMPs WILL BE RELIED UPON UNTIL ACTIVE VERTICAL CONSTRUCTION BEGINS AT A LOT OR LOTS WHEREIN THE INDIVIDUAL LOT CONTROLS WILL BE APPLIED.
2. REFER TO CONSTRUCTION PLANS FOR FULL CONSTRUCTION DETAILS INCLUDING BENCHMARK.
3. SEQUENCING OF THE PROJECT WILL BE DETERMINED DURING CONSTRUCTION AND UPDATES CAN BE OBTAINED FROM SITE SUPERINTENDENT. REFER TO THE SITE MAP IN SECTION 2.1 OF THE SWMP FOR FURTHER SCHEDULING INFORMATION.
4. CONSTRUCTION AND DISTURBANCE OF THE GROUND WILL BE CONFINED TO THE LIMITS OF CONSTRUCTION AND THE LOTS WITHIN THE PERMITTED AREA. ANY UNEXPECTED DISTURBANCE OUTSIDE THE PERMITTED AREA WILL REQUIRE STABILIZATION AND POSSIBLE MODIFICATION OF THE PERMIT.
5. SOILS FROM FOUNDATION EXCAVATION WILL BE STOCKPILED ON EACH LOT OR THE ADJACENT LOT IF POSSIBLE. ENSURE PROPER LOADING OPERATIONS TAKE PLACE. REFER TO SWMP SECTION 3 FOR ADDITIONAL INFORMATION.
6. CWA LOCATION(S) WILL BE DETERMINED IN FIELD. THE CONCRETE WASHOUTS NEED TO BE INSTALLED PRIOR TO PLACING ANY CONCRETE ON THE SITE. ADEQUATE SIGNAGE SHALL BE PLACED AROUND THE PROJECT TO IDENTIFY THE LOCATION OF THE CONCRETE WASHOUT.
7. WORKERS WILL BE INSTRUCTED TO PARK ON PAVED ROADWAYS OR ADJACENT PARKING LOTS. IF AN ADDITIONAL STAGING AREA IS REQUIRED AT THIS POINT OF CONSTRUCTION IT WILL BE REFLECTED IN ACTIVE SITE MAP.
8. LOCATIONS OF VEHICLE TRACKING CONTROLS (VTC) ARE TO BE DETERMINED IN FIELD. MUD MATS OR MODIFIED VTC'S DO NOT NEED TO BE INSTALLED UNTIL DISTURBANCE OF AN AREA COMMENCES.
9. THE CONTRACTOR SHALL BE RESPONSIBLE FOR SWEEPING AND CLEAN UP OF ALL PAVED AREAS SURROUNDING THE PROJECT ON A DAILY BASIS, AS NEEDED DURING THE DAY WHEN SEDIMENT AND OTHER MATERIALS ARE TRACKED OR DISCHARGED ONTO THEM OR PRIOR TO ANY STORM EVENT. ADDITIONAL GOOD HOUSEKEEPING PRACTICES (PORTABLE TOILETS, DUMPSTERS) WILL BE IMPLEMENTED THROUGHOUT CONSTRUCTION AND WILL BE REFLECTED ON THE ACTIVE SITE MAP.
10. DEPLOYMENT AND/OR REMOVAL OF THE ABOVE BMP'S ARE DEPENDENT OF WORK SEQUENCING AND PROXIMITY TO EACH DISTURBANCE AREA. ADDITIONAL BMPs MAY BE REQUIRED PER THE DETAILS OR NARRATIVE.
11. IT IS THE PERMITTEE'S RESPONSIBILITY TO ADJUST OR REMOVE INLET PROTECTIONS AS NECESSARY PRIOR TO LARGE RAIN EVENTS THAT MAY EXCEED THE NORMAL CAPACITY OF THE INLET PROTECTION TO PREVENT FLOODING AND POTENTIAL PROPERTY DAMAGE.
12. ACTUAL LOCATIONS OF PERIMETER CONTROLS SHALL BE DETERMINED IN THE FIELD AND ADJUSTED AS NECESSARY TO PROVIDE EFFECTIVE SEDIMENT AND EROSION CONTROL THROUGHOUT CONSTRUCTION.

PLANNED CONTROL MEASURE LEGEND	
	(CWA) CONCRETE WASHOUT AREA
	(IP) INLET PROTECTION
	(OP) OUTLET PROTECTION
	(RS) ROCK SOCK OR COMPARABLE BMP
	(LOC) LIMITS OF CONSTRUCTION
	(PC) PERIMETER CONTROL (SILT FENCE STRAW WATTLE, OR COMPARABLE BMP)
	(TL) TREE LAWN CONTROLS (ECB, HEAVY WEIGHT WATTLE, SEDIMENT CONTROL, LOG ETC.)
	(SA) STAGING AREA
	(VTC) VEHICLE TRACKING CONTROL
	(GH) GOOD HOUSEKEEPING
	(SS) STREET SWEEPING
	SURFACE FLOW DIRECTION

NOTE: SCALES SHOWN ARE FOR 11"X17" SHEETS, ADJUST ACCORDINGLY FOR OTHER SIZES.

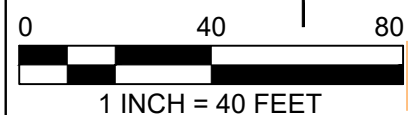

SITE DATA
LOT SQ. FT = 116783
IMPERVIOUS SF. = 32565
IMP COVERAGE = 27.9%

10 P.U. & D.E.

20' M.V.E.A.

35' REAR SETBACK

10' SIDE SETBACK

10' SIDE SETBACK

APPROX. LOCATION OF LEACH FIELD (LOCATION & SIZE MAY CHANGE BASED ON ENGINEERING DESIGN)

BUILDING CENTRUM
STRUCTURE SQ. FT.
STRUCTURE IN CENTRUM SQ. FT.
% STRUCTURE IN CENTRUM

138.6

225.6

10 P.U. & D.E.

311.78'

10 P.U. & D.E.

318.50'

10' BASEMENT GL LOT TF=42.5

5,152.38 sf

100.0

39.0 FG

41.3 P

86.6

SA

GH

CW

VTC

LIT ADDRESS MONUMENT

30' FRONT SETBACK

10' P.U. & D.E.

5' P.U. & D.E.

L=378.40'

OP

IP

7.001

ADDITIONAL BMPS, INCLUDING RUN-ON CONTROLS PERIMETER CONTROLS, SHALL BE IMPLEMENTED AS DEEMED NECESSARY IN THE FIELD. REFER TO ACTIVE SITE MAP.

I'm measuring closer to 5,200 sqft which would be approximately 4% imperviousness. Verify.

PROJECT:		FLYING HORSE NORTH FILING NO. 4		NO.		DATE	REVISONS		CAD
PROJECT #:		06-2025		0		08/18/2026	ORIGINAL		SR
DATE:		10/07/2026							
DESIGN ENG:		TR							
CHECKED BY:		SR							
SHEET TITLE:				5231 SOUTH QUEBEC STREET GREENWOOD VILLAGE, CO 80111					
PERMITTEE:				P: (303) 593-2107 F: (303) 923-3416 WWW.CMSENVIRO.COM					
WEEKLEY HOMES LLC									
7150 CAMPUS DR. SUITE 320, COLORADO SPRINGS, CO 80920; (719) 431-0349									
CMS ENVIRONMENTAL SOLUTIONS									
EC-10									

VERTICAL CONSTRUCTION NOTES:

1. LAND DEVELOPMENT BMPs WILL BE RELIED UPON UNTIL ACTIVE VERTICAL CONSTRUCTION BEGINS AT A LOT OR LOTS WHEREIN THE INDIVIDUAL LOT CONTROLS WILL BE APPLIED.
2. REFER TO CONSTRUCTION PLANS FOR FULL CONSTRUCTION DETAILS INCLUDING BENCHMARK. SEQUENCING OF THE PROJECT WILL BE DETERMINED DURING CONSTRUCTION AND UPDATES CAN BE OBTAINED FROM SITE SUPERINTENDENT. REFER TO THE SITE MAP IN SECTION 2.1 OF THE SWMP FOR FURTHER SCHEDULING INFORMATION.
3. CONSTRUCTION AND DISTURBANCE OF THE GROUND WILL BE CONFINED TO THE LIMITS OF CONSTRUCTION AND THE LOTS WITHIN THE PERMITTED AREA. ANY UNEXPECTED DISTURBANCE OUTSIDE THE PERMITTED AREA WILL REQUIRE STABILIZATION AND POSSIBLE MODIFICATION OF THE PERMIT.
4. SOILS FROM FOUNDATION EXCAVATION WILL BE STOCKPILED ON EACH LOT OR THE ADJACENT LOT IF POSSIBLE. ENSURE PROPER LOADING OPERATIONS TAKE PLACE. REFER TO SWMP SECTION 3 FOR ADDITIONAL INFORMATION.
5. CWA LOCATION(S) WILL BE DETERMINED IN FIELD. THE CONCRETE WASHOUTS NEED TO BE INSTALLED PRIOR TO PLACING ANY CONCRETE ON THE SITE. ADEQUATE SIGNAGE SHALL BE PLACED AROUND THE PROJECT TO IDENTIFY THE LOCATION OF THE CONCRETE WASHOUT.
6. WORKERS WILL BE INSTRUCTED TO PARK ON PAVED ROADWAYS OR ADJACENT PARKING LOTS. IF AN ADDITIONAL STAGING AREA IS REQUIRED AT THIS POINT OF CONSTRUCTION IT WILL BE REFLECTED IN ACTIVE SITE MAP.
7. LOCATIONS OF VEHICLE TRACKING CONTROLS (VTC) ARE TO BE DETERMINED IN FIELD. MUD MATS OR MODIFIED VTC'S DO NOT NEED TO BE INSTALLED UNTIL DISTURBANCE OF AN AREA COMMENCES.
8. THE CONTRACTOR SHALL BE RESPONSIBLE FOR SWEEPING AND CLEAN UP OF ALL PAVED AREAS SURROUNDING THE PROJECT ON A DAILY BASIS, AS NEEDED DURING THE DAY WHEN SEDIMENT AND OTHER MATERIALS ARE TRACKED OR DISCHARGED ONTO THEM OR PRIOR TO ANY STORM EVENT. ADDITIONAL GOOD HOUSEKEEPING PRACTICES (PORTABLE TOILETS, DUMPSTERS) WILL BE IMPLEMENTED THROUGHOUT CONSTRUCTION AND WILL BE REFLECTED ON THE ACTIVE SITE MAP.
9. DEPLOYMENT AND/OR REMOVAL OF THE ABOVE BMP'S ARE DEPENDENT OF WORK SEQUENCING AND PROXIMITY TO EACH DISTURBANCE AREA. ADDITIONAL BMPs MAY BE REQUIRED PER THE DETAILS OR NARRATIVE.
10. IT IS THE PERMITTEE'S RESPONSIBILITY TO ADJUST OR REMOVE INLET PROTECTIONS AS NECESSARY PRIOR TO LARGE RAIN EVENTS THAT MAY EXCEED THE NORMAL CAPACITY OF THE INLET PROTECTION TO PREVENT FLOODING AND POTENTIAL PROPERTY DAMAGE.
11. ACTUAL LOCATIONS OF PERIMETER CONTROLS SHALL BE DETERMINED IN THE FIELD AND ADJUSTED AS NECESSARY TO PROVIDE EFFECTIVE SEDIMENT AND EROSION CONTROL THROUGHOUT CONSTRUCTION.

PLANNED CONTROL MEASURE LEGEND

	CWA	CONCRETE WASHOUT AREA
	IP	INLET PROTECTION
	OP	OUTLET PROTECTION
	RS	ROCK SOCK OR COMPARABLE BMP
	LOC	LIMITS OF CONSTRUCTION
	PC	PERIMETER CONTROL (SILT FENCE, STRAW WATTLE, OR COMPARABLE BMP)
	TL	TREE LAWN CONTROLS (EOL, HEAVY WEIGHT WATTLE, SEDIMENT CONTROL LOG, ETC.)
	SA	STAGING AREA
	VTC	VEHICLE TRACKING CONTROL
	GH	GOOD HOUSEKEEPING
	SS	STREET SWEEPING
		SURFACE FLOW DIRECTION

NOTE: SCALES SHOWN ARE FOR 11"x17" SHEETS, ADJUST ACCORDINGLY FOR OTHER SIZES.

0 40'-0" 40 80


1 INCH = 40 FEET

N

SITE DATA
LOT SQ. FT. = 144543
IMPERVIOUS SF. = 24732
IMP COVERAGE = 17.1%

I'm measuring closer to 6,500 sqft which would be approximately 5% imperviousness. Verify.

ADDITIONAL BMPs, INCLUDING RUN-ON CONTROLS PERIMETER CONTROLS, SHALL BE IMPLEMENTED AS DEEMED NECESSARY IN THE FIELD. REFER TO ACTIVE SITE MAP.

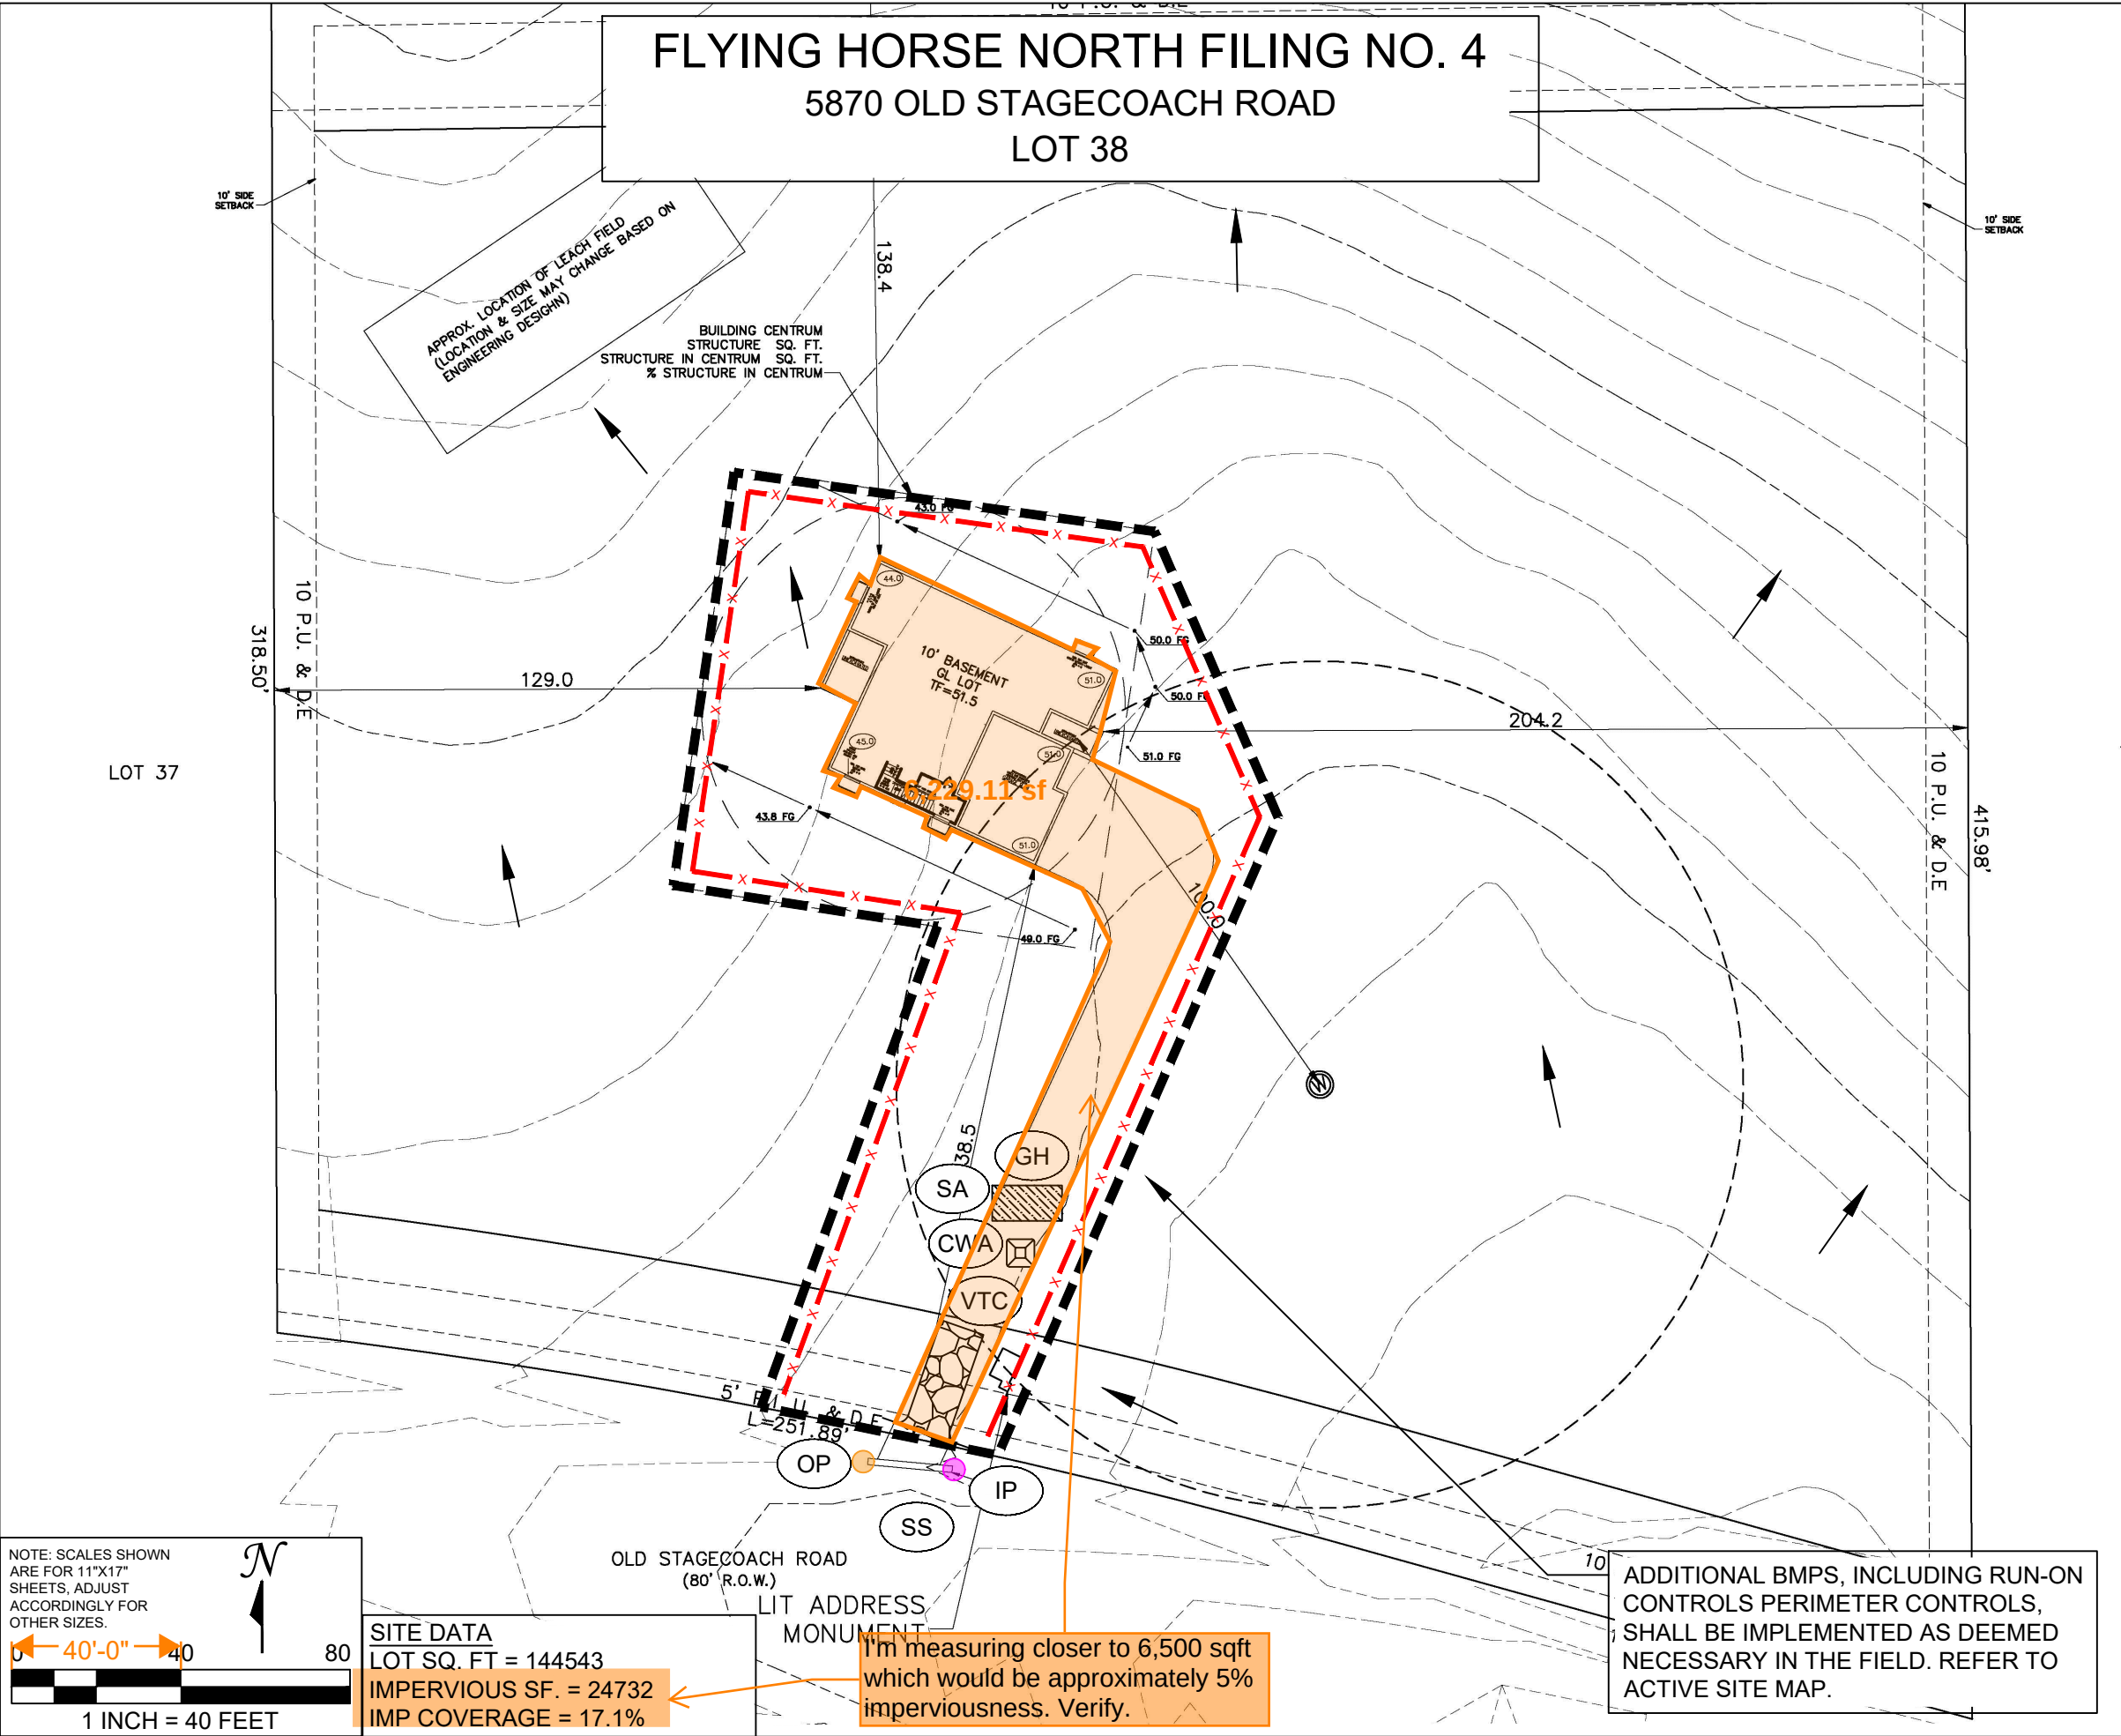

PROJECT:										FLYING HORSE NORTH FILING NO. 4										PROJECT:										NO.										DATE										REVISIONS										ENG										CAD																																																																																																																																																																																																																																																																																																																																																																																																																																																																																																																																																																																																																																																																																																																																																																																																																																																																																																																																																																																																																																																																																																																																																																																																																																																																																																																																																																																																																																																																																																																																																																																																																																																																																																																																																																																																																																																																																																																																																																																																																																																																																																																																																																																																																																																																																																																																																																																																																																																																																																																																																																																																																																																																																																																																																																																																																																																																																																																																																																																																																																																																																																																																																																																																																																																																																																																																																																																																																																																																																																																																																																																																																																																																																																																																																																																																																																																																																																																																																																																																																																																																																																																																																																																																																																																																																																																																																																																																																																																																																																																																																																																																																																																																																																																																																																																																																																																																																																																																																																																																																																																																																																																																																																																																																																																																																																																															
PROJ #:										06-2025										SHEET TITLE:										PLANNED EROSION AND SEDIMENT CONTROL - VERTICAL CONSTRUCTION										DATE:										10/07/2026										DESIGN ENG:										TR										CHECKED BY:										SR										0										08/18/2026										ORIGINAL										SR										TR																																																																																																																																																																																																																																																																																																																																																																																																																																																																																																																																																																																																																																																																																																																																																																																																																																																																																																																																																																																																																																																																																																																																																																																																																																																																																																																																																																																																																																																																																																																																																																																																																																																																																																																																																																																																																																																																																																																																																																																																																																																																																																																																																																																																																																																																																																																																																																																																																																																																																																																																																																																																																																																																																																																																																																																																																																																																																																																																																																																																																																																																																																																																																																																																																																																																																																																																																																																																																																																																																																																																																																																																																																																																																																																																																																																																																																																																																																																																																																																																																																																																																																																																																																																																																																																																																																																																																																																																																																																																																																																																																																																																																																																																																																																																																																																																																																																																																																																																																																																																																																																																																																																																																																																																																																																									
PERMITTEE:										WEEKLEY HOMES LLC										7150 CAMPUS DR, SUITE 320 , COLORADO SPRINGS, CO 80920; (719) 431-0349										5231 SOUTH QUEBEC STREET										GREENWOOD VILLAGE, CO 80111										P: (303) 593-2107										F: (303) 923-3416										WWW.CMSENVIRO.COM																																																																																																																																																																																																																																																																																																																																																																																																																																																																																																																																																																																																																																																																																																																																																																																																																																																																																																																																																																																																																																																																																																																																																																																																																																																																																																																																																																																																																																																																																																																																																																																																																																																																																																																																																																																																																																																																																																																																																																																																																																																																																																																																																																																																																																																																																																																																																																																																																																																																																																																																																																																																																																																																																																																																																																																																																																																																																																																																																																																																																																																																																																																																																																																																																																																																																																																																																																																																																																																																																																																																																																																																																																																																																																																																																																																																																																																																																																																																																																																																																																																																																																																																																																																																																																																																																																																																																																																																																																																																																																																																																																																																																																																																																																																																																																																																																																																																																																																																																																																																																																																																																																																																																																																																																																																																																																																															

VERTICAL CONSTRUCTION NOTES:

1. LAND DEVELOPMENT BMPs WILL BE RELIED UPON UNTIL ACTIVE VERTICAL CONSTRUCTION BEGINS AT A LOT OR LOTS WHEREIN THE INDIVIDUAL LOT CONTROLS WILL BE APPLIED.
2. REFER TO CONSTRUCTION PLANS FOR FULL CONSTRUCTION DETAILS INCLUDING BENCHMARK.
3. SEQUENCING OF THE PROJECT WILL BE DETERMINED DURING CONSTRUCTION AND UPDATES CAN BE OBTAINED FROM SITE SUPERINTENDENT. REFER TO THE SITE MAP IN SECTION 2.1 OF THE SWMP FOR FURTHER SCHEDULING INFORMATION.
4. CONSTRUCTION AND DISTURBANCE OF THE GROUND WILL BE CONFINED TO THE LIMITS OF CONSTRUCTION AND THE LOTS WITHIN THE PERMITTED AREA. ANY UNEXPECTED DISTURBANCE OUTSIDE THE PERMITTED AREA WILL REQUIRE STABILIZATION AND POSSIBLE MODIFICATION OF THE PERMIT.
5. SOILS FROM FOUNDATION EXCAVATION WILL BE STOCKPILED ON EACH LOT OR THE ADJACENT LOT IF POSSIBLE. ENSURE PROPER LOADING OPERATIONS TAKE PLACE. REFER TO SWMP SECTION 3 FOR ADDITIONAL INFORMATION.
6. CWA LOCATION(S) WILL BE DETERMINED IN FIELD. THE CONCRETE WASHOUTS NEED TO BE INSTALLED PRIOR TO PLACING ANY CONCRETE ON THE SITE. ADEQUATE SIGNAGE SHALL BE PLACED AROUND THE PROJECT TO IDENTIFY THE LOCATION OF THE CONCRETE WASHOUT.
7. WORKERS WILL BE INSTRUCTED TO PARK ON PAVED ROADWAYS OR ADJACENT PARKING LOTS. IF AN ADDITIONAL STAGING AREA IS REQUIRED AT THIS POINT OF CONSTRUCTION IT WILL BE REFLECTED IN ACTIVE SITE MAP.
8. LOCATIONS OF VEHICLE TRACKING CONTROLS (VTC) ARE TO BE DETERMINED IN FIELD. MUD MATS OR MODIFIED VTC'S DO NOT NEED TO BE INSTALLED UNTIL DISTURBANCE OF AN AREA COMMENCES.
9. THE CONTRACTOR SHALL BE RESPONSIBLE FOR SWEEPING AND CLEAN UP OF ALL PAVED AREAS SURROUNDING THE PROJECT ON A DAILY BASIS, AS NEEDED DURING THE DAY WHEN SEDIMENT AND OTHER MATERIALS ARE TRACKED OR DISCHARGED ONTO THEM OR PRIOR TO ANY STORM EVENT. ADDITIONAL GOOD HOUSEKEEPING PRACTICES (PORTABLE TOILETS, DUMPSTERS) WILL BE IMPLEMENTED THROUGHOUT CONSTRUCTION AND WILL BE REFLECTED ON THE ACTIVE SITE MAP.
10. DEPLOYMENT AND/OR REMOVAL OF THE ABOVE BMP'S ARE DEPENDENT OF WORK SEQUENCING AND PROXIMITY TO EACH DISTURBANCE AREA. ADDITIONAL BMPs MAY BE REQUIRED PER THE DETAILS OR NARRATIVE.
11. IT IS THE PERMITTEE'S RESPONSIBILITY TO ADJUST OR REMOVE INLET PROTECTIONS AS NECESSARY PRIOR TO LARGE RAIN EVENTS THAT MAY EXCEED THE NORMAL CAPACITY OF THE INLET PROTECTION TO PREVENT FLOODING AND POTENTIAL PROPERTY DAMAGE.
12. ACTUAL LOCATIONS OF PERIMETER CONTROLS SHALL BE DETERMINED IN THE FIELD AND ADJUSTED AS NECESSARY TO PROVIDE EFFECTIVE SEDIMENT AND EROSION CONTROL THROUGHOUT CONSTRUCTION.

PLANNED CONTROL MEASURE LEGEND



CWA

IP

OP

RS

LOC

PC

TL

SA

VTC

GH

SS

CONCRETE WASHOUT AREA

INLET PROTECTION

OUTLET PROTECTION

ROCK SOCK OR COMPARABLE BMP

LIMITS OF CONSTRUCTION

PERIMETER CONTROL (SILT FENCE, STRAW WATTLE, OR COMPARABLE BMP)

TREE LAWN CONTROLS (EOL, HEAVY WEIGHT WATTLE, SEDIMENT CONTROL LOG, ETC.)

STAGING AREA

VEHICLE TRACKING CONTROL

GOOD HOUSEKEEPING

STREET SWEEPING

SURFACE FLOW DIRECTION

NOTE: SCALES SHOWN ARE FOR 11"x17" SHEETS, ADJUST ACCORDINGLY FOR OTHER SIZES.

0

40'-0"

40


80

1 INCH = 40 FEET

N

SITE DATA
LOT SQ. FT = 130680
IMPERVIOUS SF.= 12824
IMP COVERAGE= 9.8%

FLYING HORSE NORTH FILING NO. 4
15509 FRINGE PLACE
LOT 48

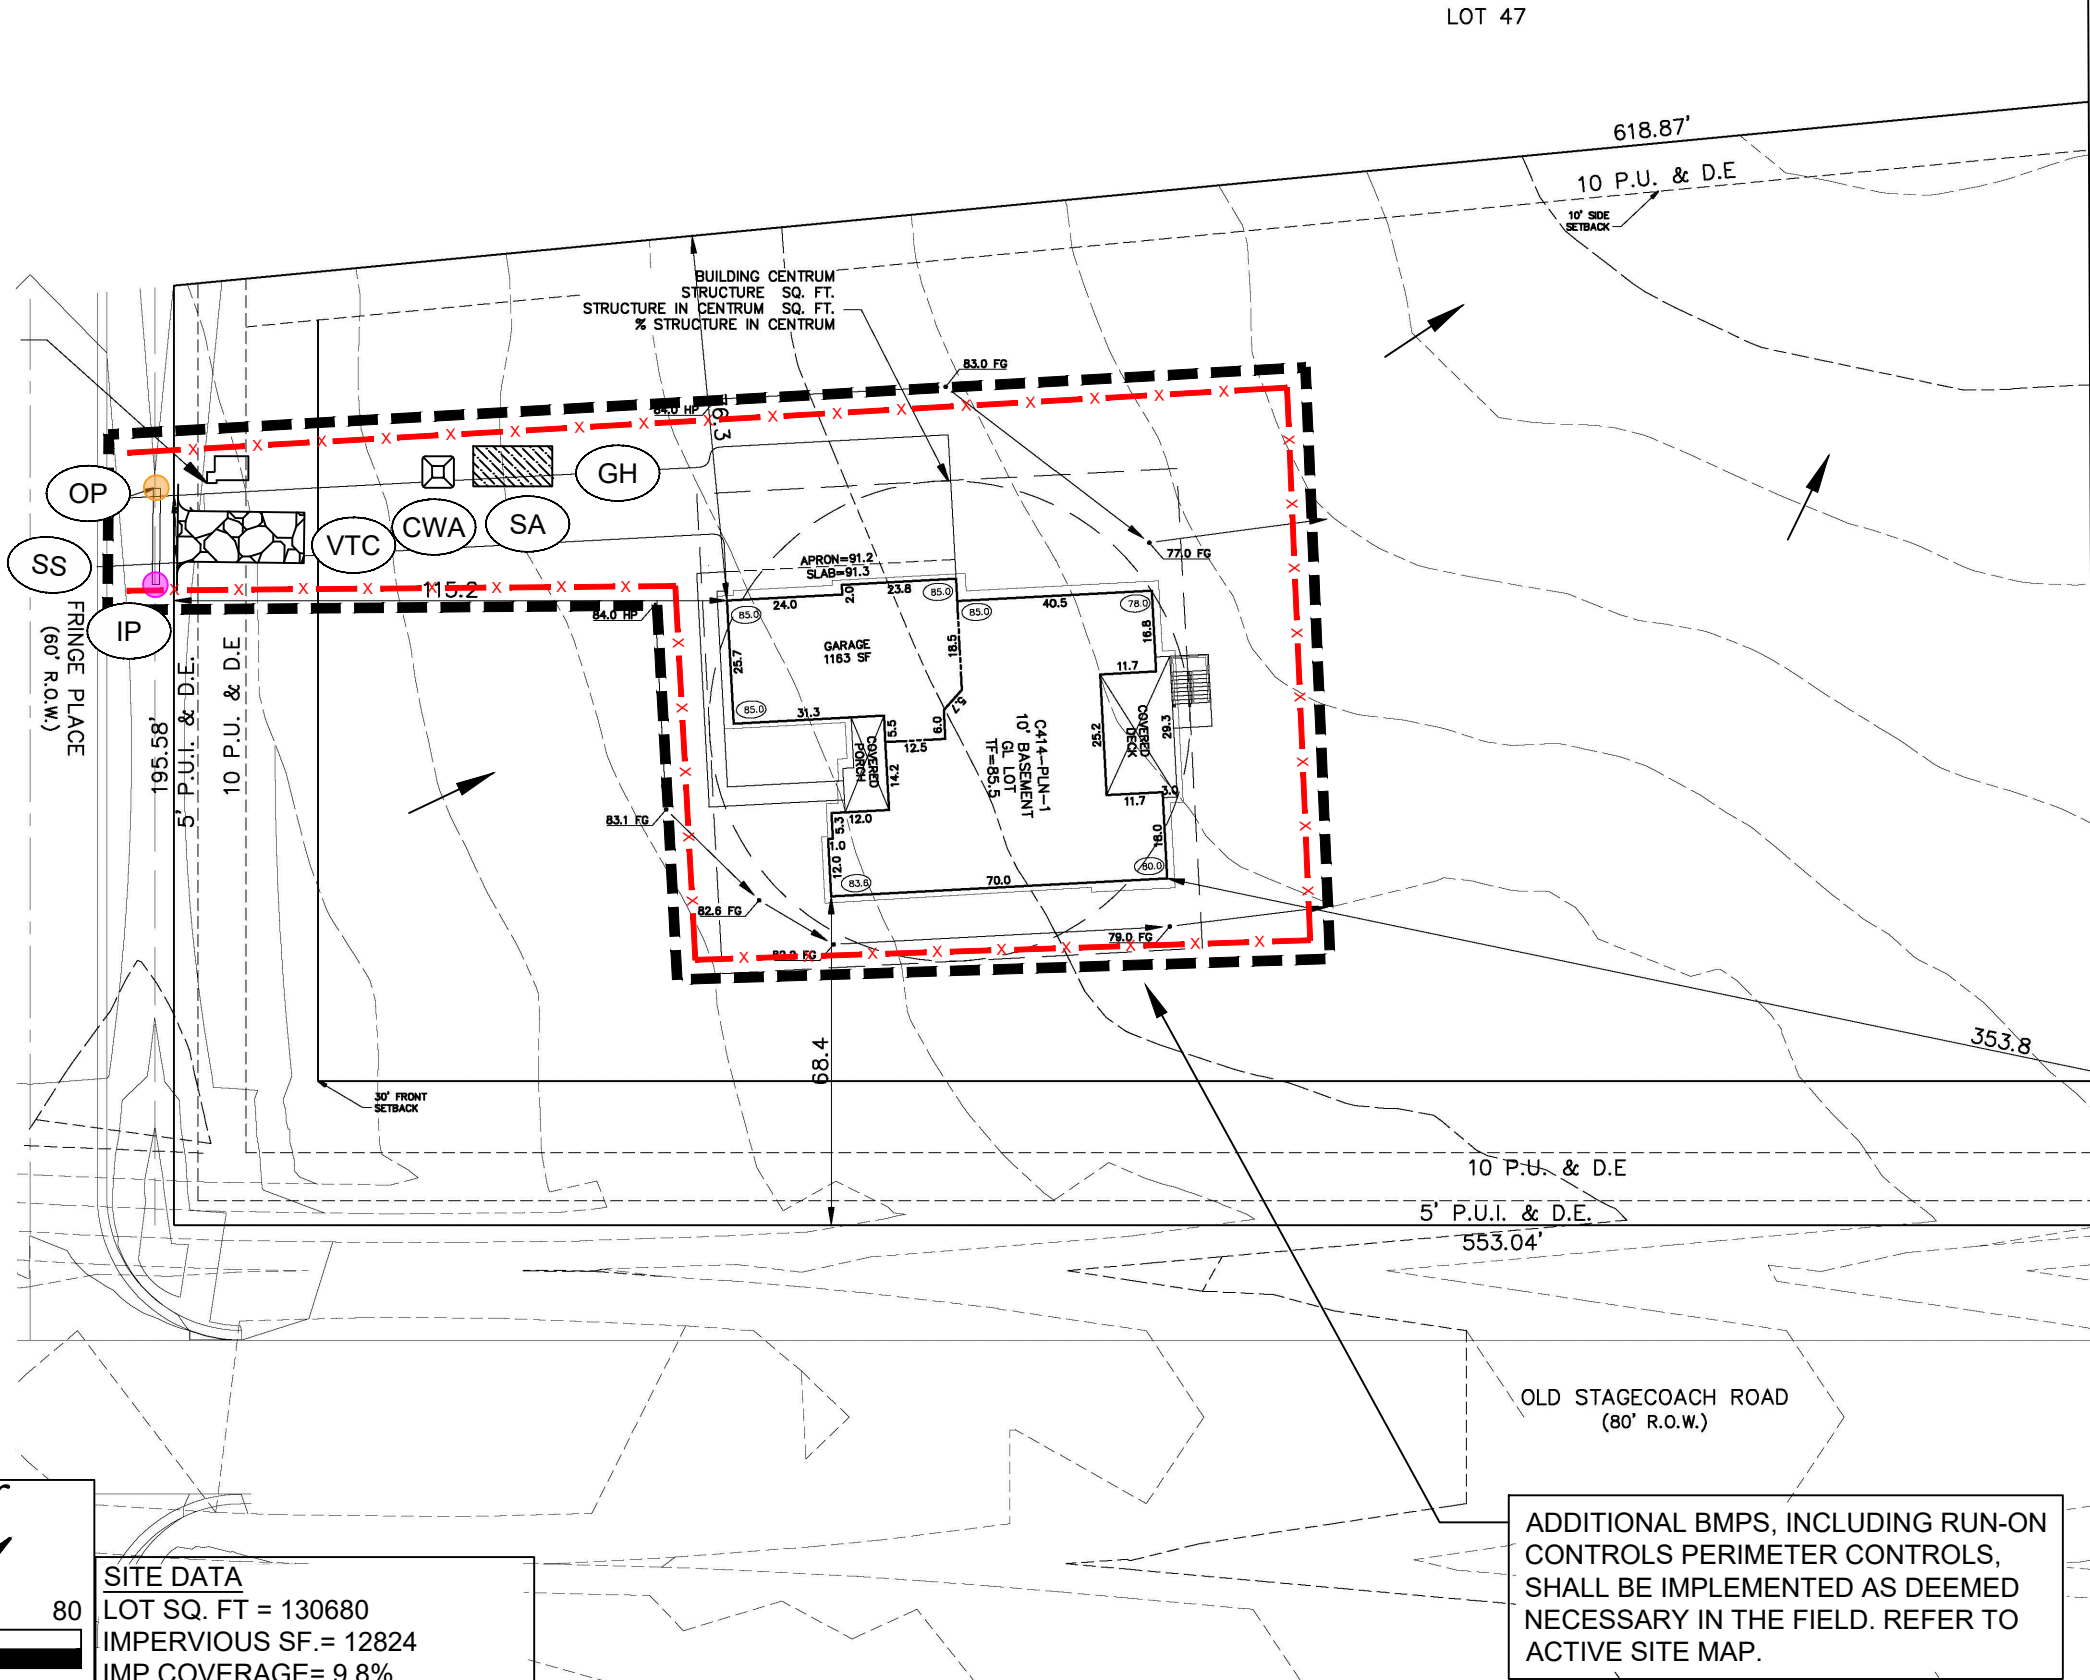

ADDITIONAL BMPs, INCLUDING RUN-ON CONTROLS PERIMETER CONTROLS, SHALL BE IMPLEMENTED AS DEEMED NECESSARY IN THE FIELD. REFER TO ACTIVE SITE MAP.

 CMS ENVIRONMENTAL SOLUTIONS			5231 SOUTH QUEBEC STREET GREENWOOD VILLAGE, CO 80111 P: (303) 593-2107 F: (303) 923-3416 WWW.CMSENVIRO.COM			NO.		DATE		REVISIONS		ENG		CAD	
						0		08/18/2026		ORIGINAL		SR		TR	
PROJECT: FLYING HORSE NORTH FILING NO. 4															
SHEET TITLE: PLANNED EROSION AND SEDIMENT CONTROL - VERTICAL CONSTRUCTION															
PERMITTEE: WEEKLEY HOMES LLC															
7150 CAMPUS DR, SUITE 320, COLORADO SPRINGS, CO 80920; (719) 431-0349															
PROJ #:				06-2025											
DATE:				10/07/2026											
DESIGN ENG:				TR											
CHECKED BY:				SR											
EC-12															