


Please revise to add a North arrow.

## VICINITY MAP

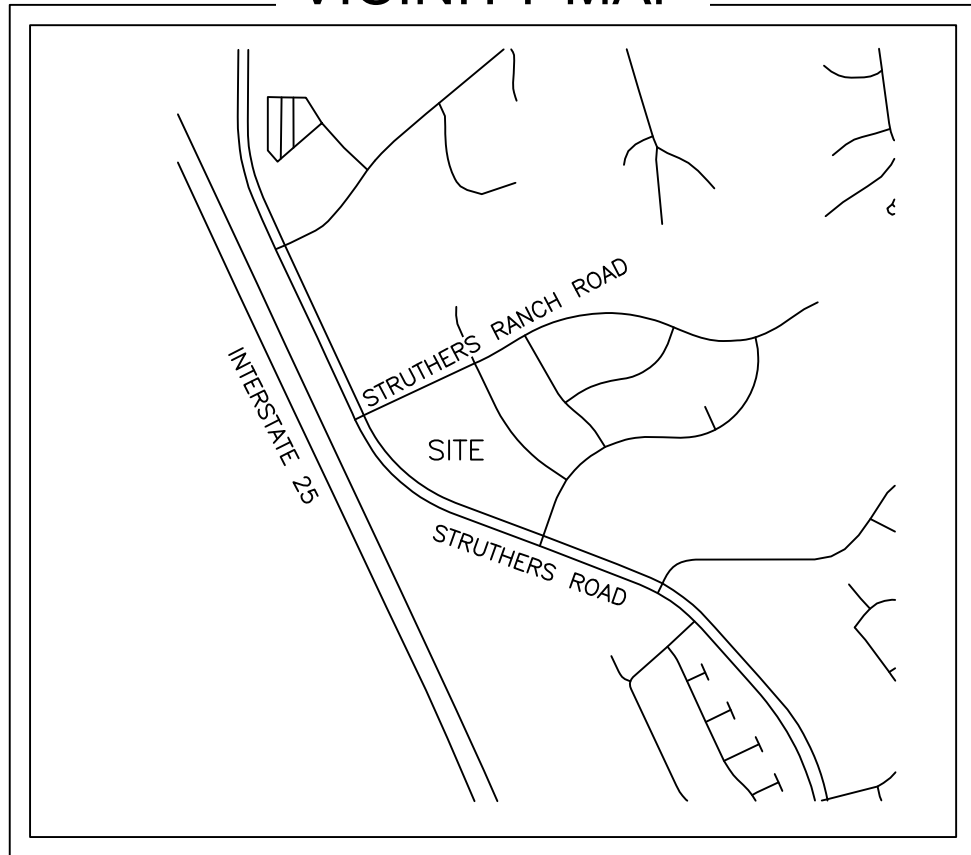

# Vicinity Map\_V1.pdf Markup Summary

---

Kevin.Shell (1)

---



**Subject:** Snapshot  
**Page Label:** 1  
**Author:** Kevin.Shell  
**Date:** 10/9/2020 3:45:41 PM  
**Status:**  
**Color:** ■  
**Layer:**  
**Space:**

---

Sophie Kiepe (1)

---



**Subject:** Cherokee Metro  
**Page Label:** 1  
**Author:** Sophie Kiepe  
**Date:** 3/15/2021 3:49:06 PM  
**Status:**  
**Color:** ■  
**Layer:**  
**Space:**

Please revise to add a North arrow.