



EL PASO COUNTY PLANNING & COMMUNITY DEVELOPMENT SIGN APPLICATION

DATE: _____

Business

Name: John Chapman
Address: 18065 Saddlewood Rd Monument CO 80132

Zone: RR-5
Legal Description: That part of N2 of Sec 17E of Canterbury West, N of Saddlewood Rd + W of Canterbury E section 16-11-66

Type of Sign

Illuminated: _____
Non-Illuminated: x
Valuation: \$200

Storefront Length &/or Width: NA

Proposed Sign Sq. Ft. 80

Existing Sign Sq. Ft. NA

Total Sign Sq. Ft. 80

Contractor Information

Name: NA

Address: _____

Phone: _____

Type of License: _____

Contractor ID# _____


Vicinity Map
Tax Schedule # _____
Please show major intersections.



Elevation Drawing
Indicate storefront length & placement of



Sign Plan
(Please indicate dimensions and sign copy)

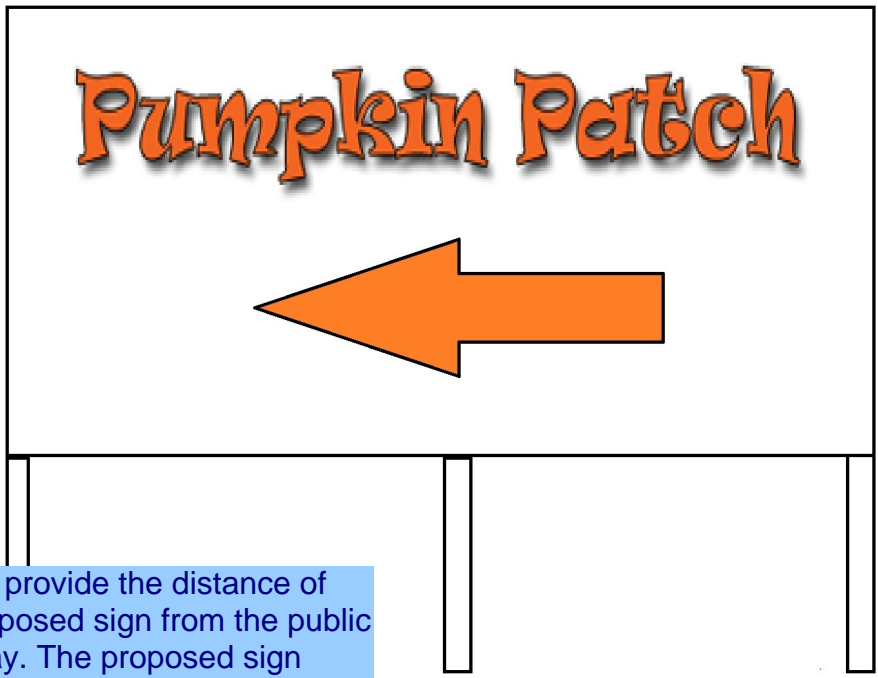


Please provide the distance of the proposed sign from the public roadway. The proposed sign cannot adversely affect the sight distance of the intersection.

For Planning & Community Development Use Only

Approved Date: _____ Resubmittal? Yes _____ No _____
Denied Date: _____
Comments: _____

Markup Summary

dsdgrimm (1)

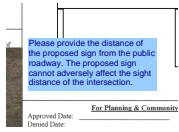

Subject: Engineer
Page Label: 1
Author: dsdgrimm
Date: 7/2/2018 5:07:49 PM
Color: ■

Please provide the distance of the proposed sign from the public roadway. The proposed sign cannot adversely affect the sight distance of the intersection.