


Put a North Arrow on this map.

Please show the floodplain on this site plan as it is shown on the attached document which shows the limits of the 100 year floodplain within your parcel.

Show 25 foot building setback along with the 15 foot landscaping buffer.


Mark that this area is a separate application.

Write "PPR1825" here

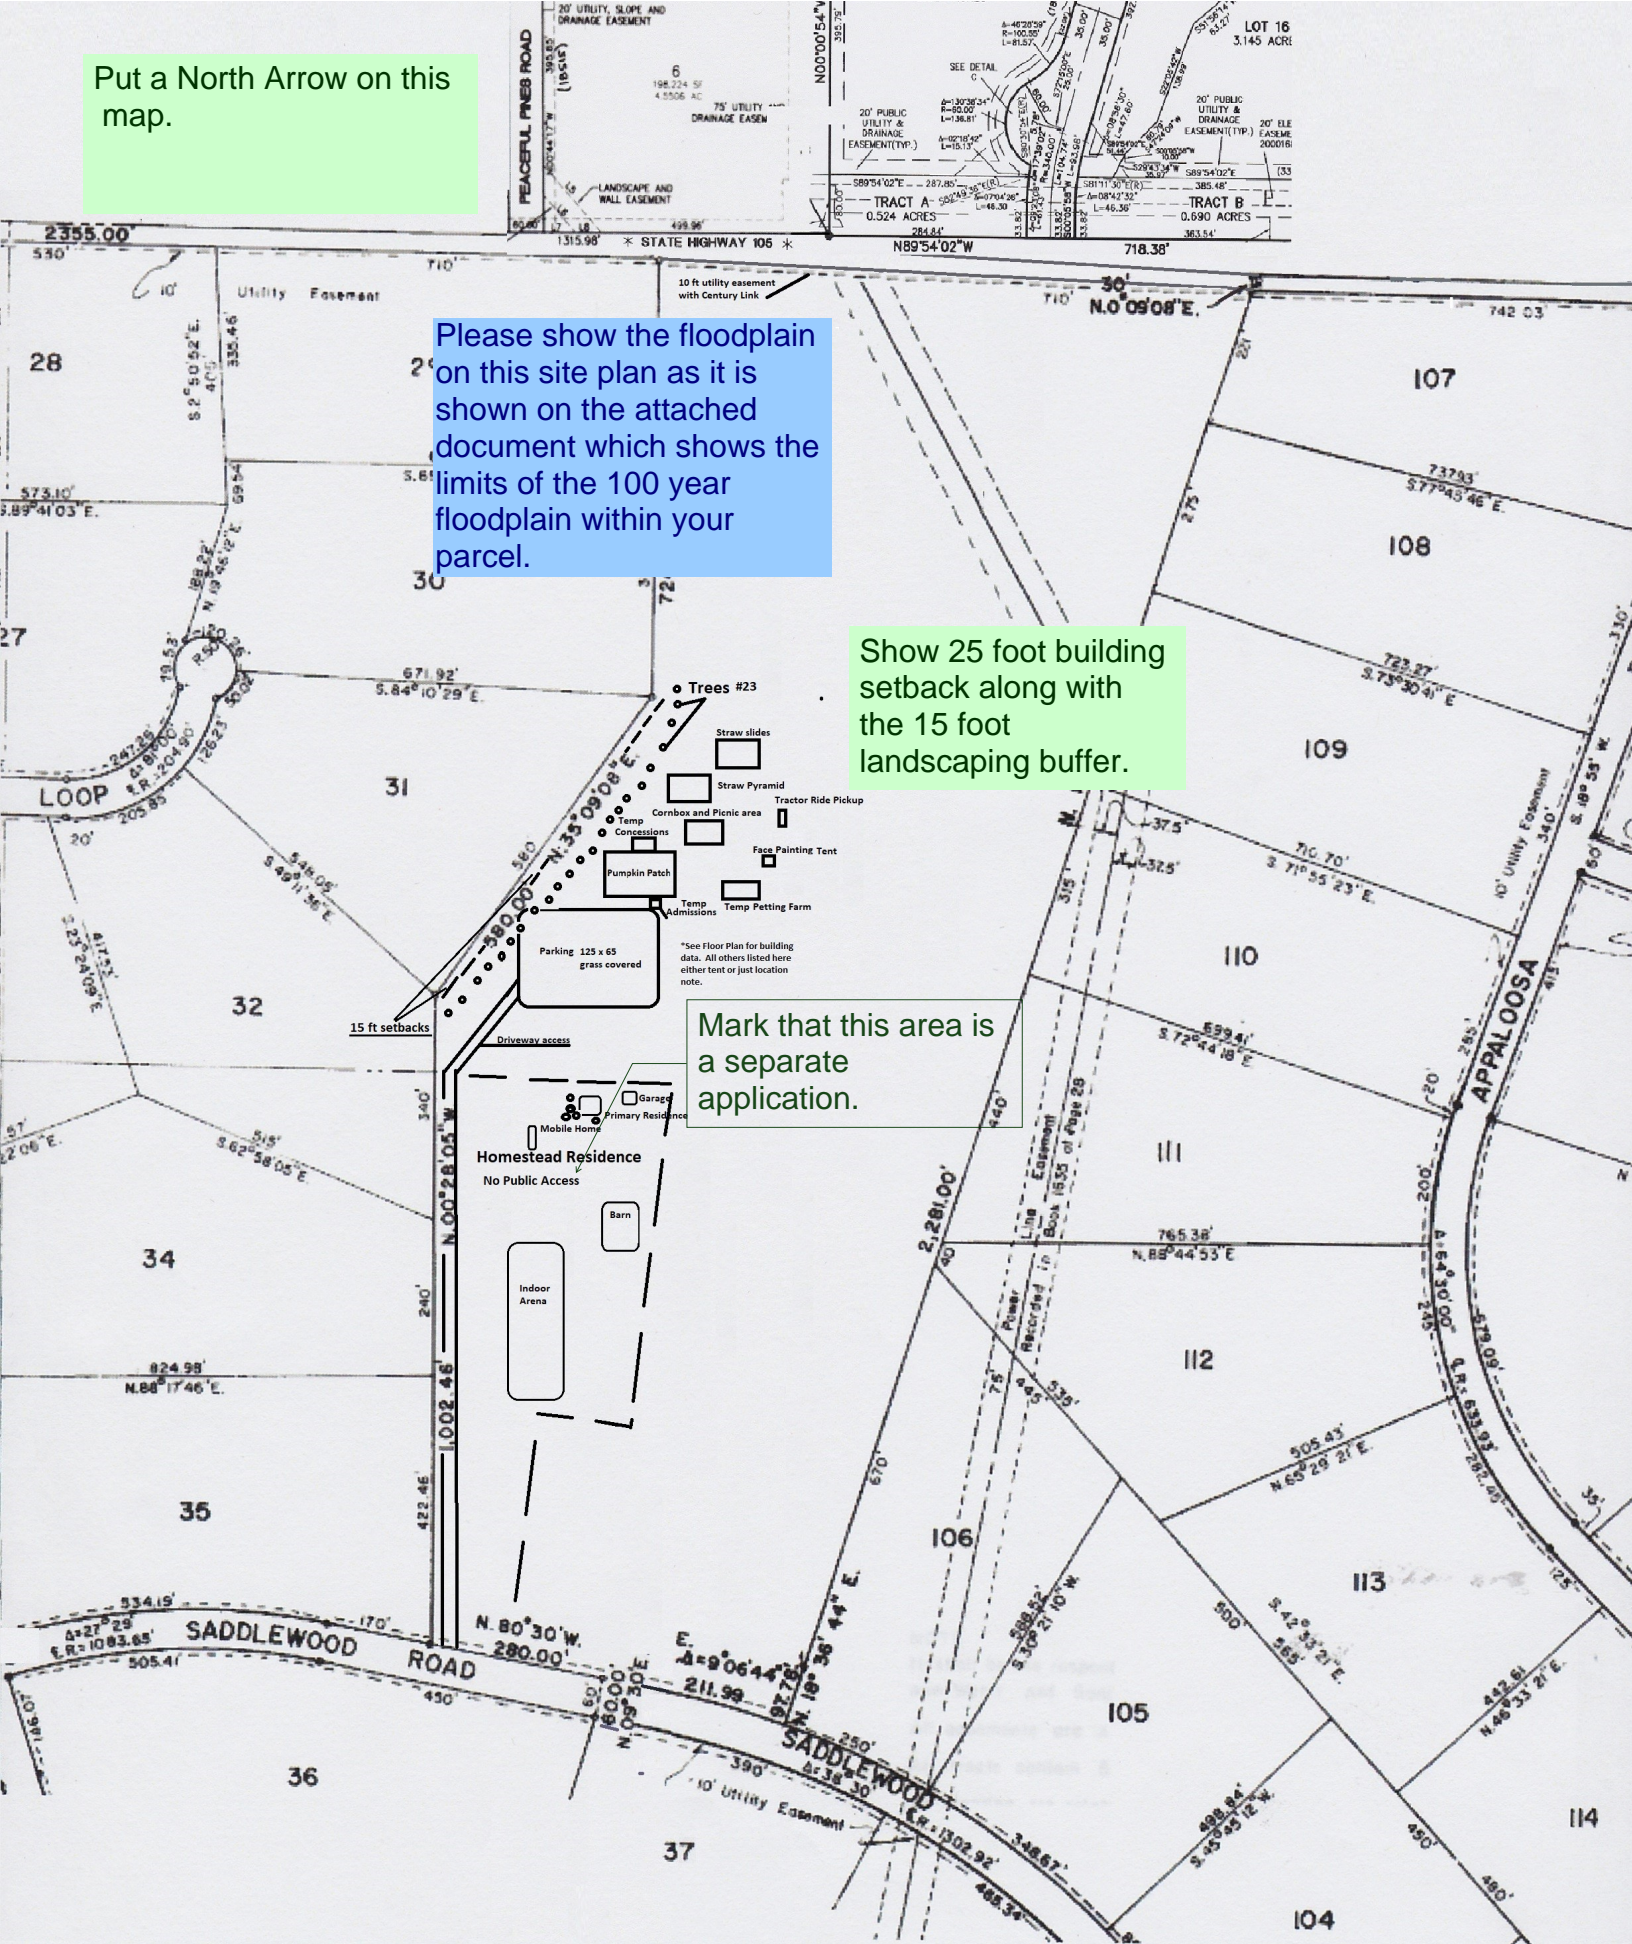

Markup Summary


dsdgrimm (1)

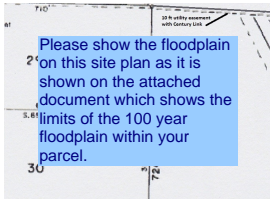

Subject: Engineer
Page Label: 1
Author: dsdgrimm
Date: 8/9/2018 11:50:27 AM
Color: ■


Please show the floodplain on this site plan as it is shown on the attached document which shows the limits of the 100 year floodplain within your parcel.

dsdkendall (4)

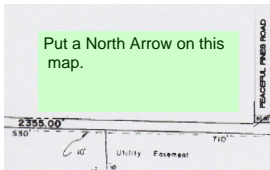


Subject: Text Box
Page Label: 1
Author: dsdkendall
Date: 8/13/2018 1:35:00 PM
Color: ■

Put a North Arrow on this map.

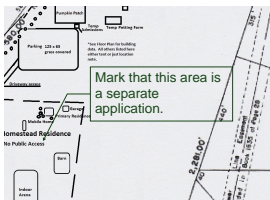

Subject: Callout
Page Label: 1
Author: dsdkendall
Date: 8/13/2018 1:37:14 PM
Color: ■

Mark that this area is a separate application.

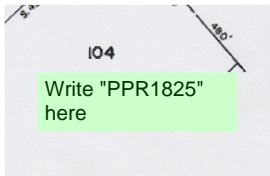

Subject: Text Box
Page Label: 1
Author: dsdkendall
Date: 8/13/2018 1:37:16 PM
Color: ■

Write "PPR1825" here



Subject: Text Box
Page Label: 1
Author: dsdkendall
Date: 8/13/2018 1:37:22 PM
Color: ■

Show 25 foot building setback along with the 15 foot landscaping buffer.