



EXISTING & FUTURE PARKING				
USE	STANDARD/RATIO	FUTURE QUANTITY	FUT. SPACES REQUIRED	FUT. SPACES PROVIDED
CARETAKER'S RESIDENCE	2/UNIT + 1 GUEST SPC	1	3	3
GUEST ROOMS	1 PER 2 GUEST ROOMS	28	14	14
ASSEMBLY SPACES	1 PER 100 SF	2,764 SF	28	35
EMPLOYEES	1 PER EMPLOYEE	8	8	8
REQ. SPACES (SUBTOTAL)			51	60
ADA REQUIREMENTS	1 PER 25 REQ. SPACES		3	4
TOTAL PARKING REQ.			53	64

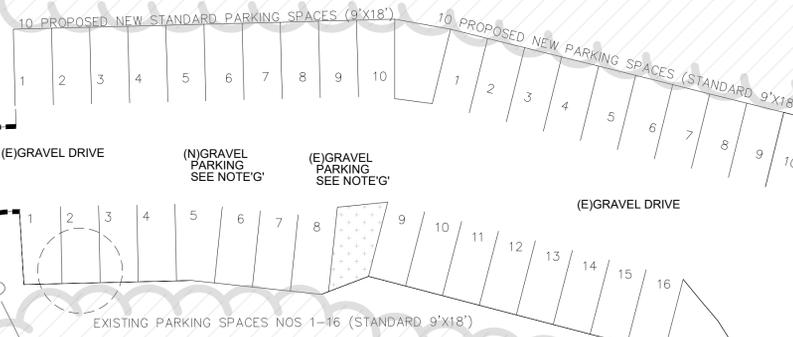

EXISTING BUILDING/USE SQUARE FOOTAGE PER LEVEL				
	MAIN	LOWER	UPPER	TOTAL
RECREATION CAMP	3083	3765	1915	8763
ATTACHED RESIDENCE	2803			2803
BUSINESS AREA(S)	3235	2264	360	5859
ASSEMBLY/MEETING ROOM(S)	1720	648		2368
DINING	468			468
TOTAL FACILITY SF PER LEVEL(S)	11309	6677	2275	20261
BUILDING FOOTPRINT			11,833 SF	

2020 PROPOSED USES/STRUCTURES APPROVED (CURRENT SPECIAL USE REQUEST- AL-20-013)	
ASSEMBLY ROOM EXPANSION	2,172 SF (452 SF EXPANSION)
OUTDOOR POOL ENCLOSURE; NEW OUTDOOR POOL & SPA	2,000 SF
PORTECOCHERE (32' X 32')	1024 SF
2 ADDITIONAL GUEST ROOMS (REDUCES LOWER LEVEL COMMON AREA BY 1100 SF)	1100 SF - NO EXTERNAL EXPANSION
2 ADDITIONAL GUEST ROOMS/REDUCE MAIN LEVEL COMMON AREA BY 600 SF	1200 SF - NO EXTERNAL EXPANSION
TOTAL MAXIMUM FOOTPRINT EXPANSION	5,176 SF

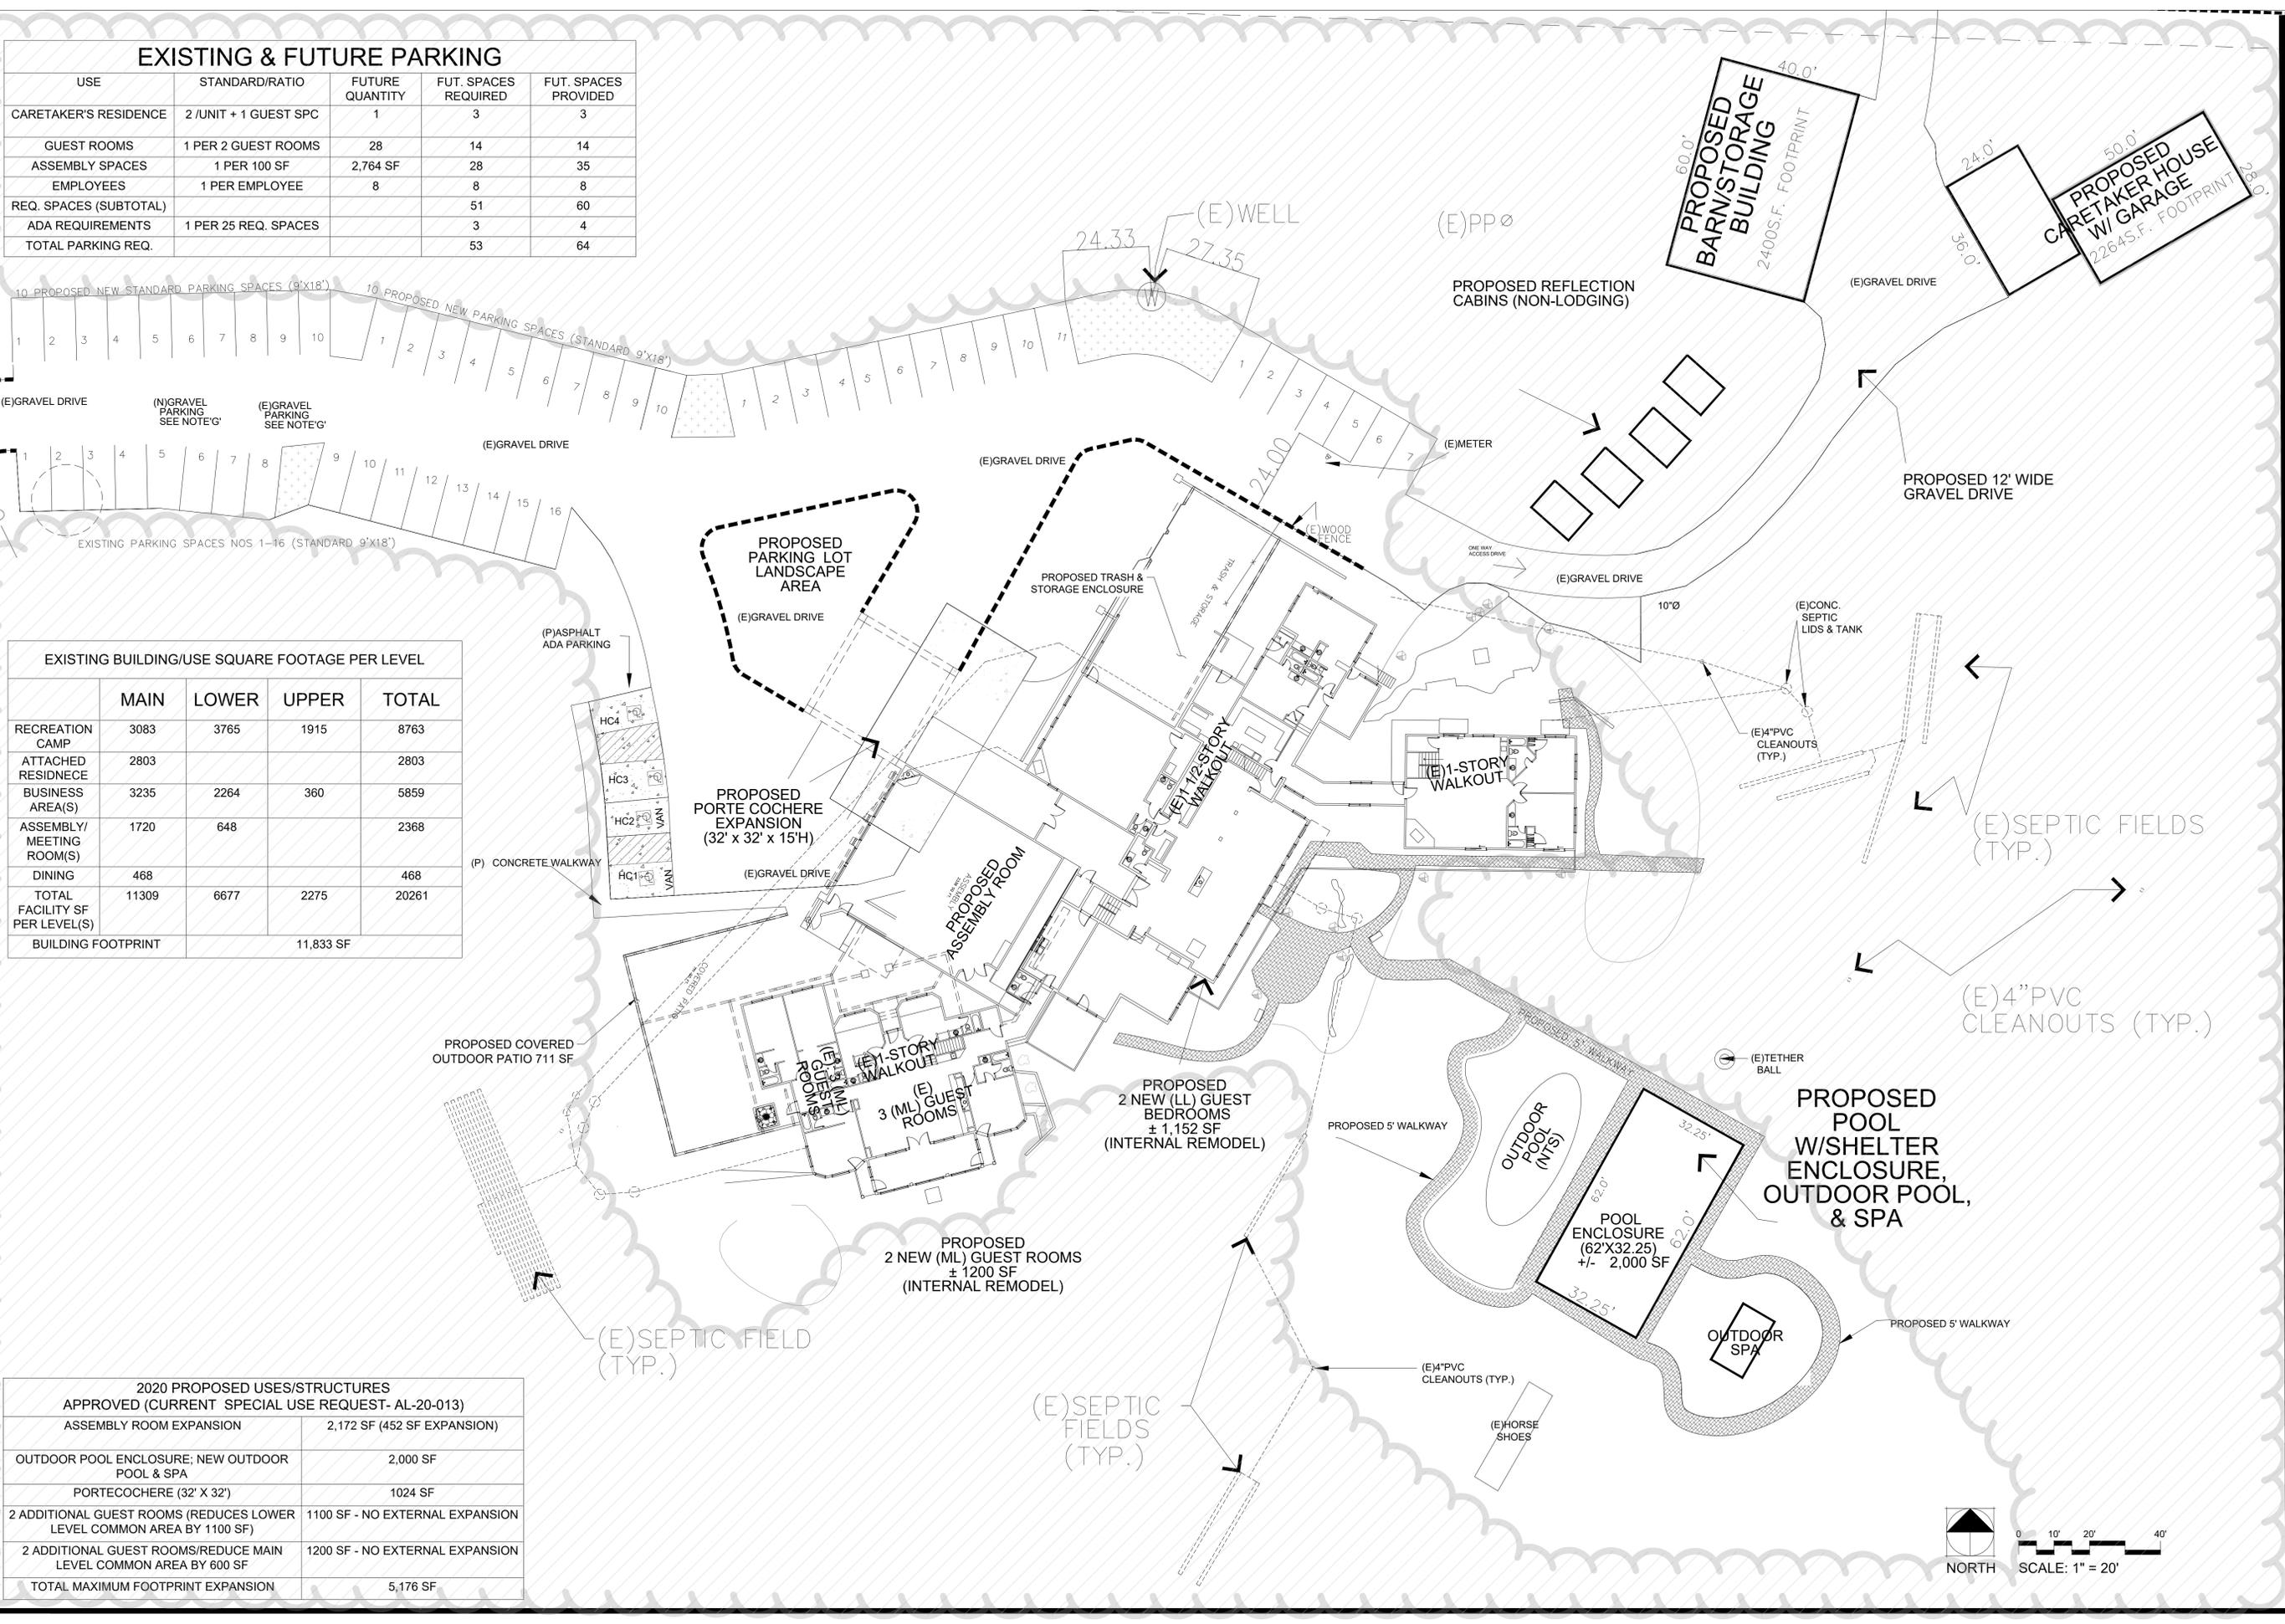


REV #	REVISIONS	DATE
1		
2		
3		
4		
5		
6		


DESIGNED	RSF	04.27.20
DRAWN	RSF	04.27.20
CHECKED	RSF	06.09.20
PROJECT NUMBER	096959000.2	
SCALE:	1:20	AS NOTED




A Proposed Front Elevation
A-9 SCALE: 1/8"=1'-0"

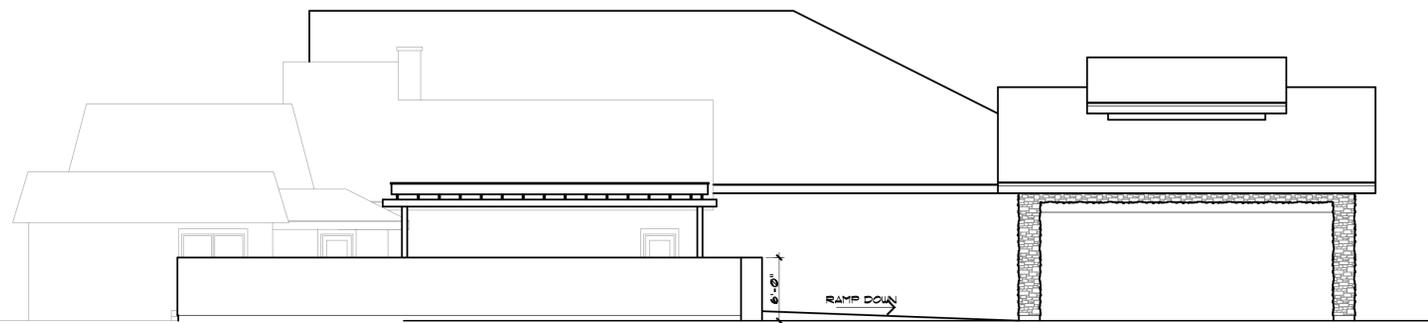

B Proposed Left Side Elevation
A-9 SCALE: 1/8"=1'-0"

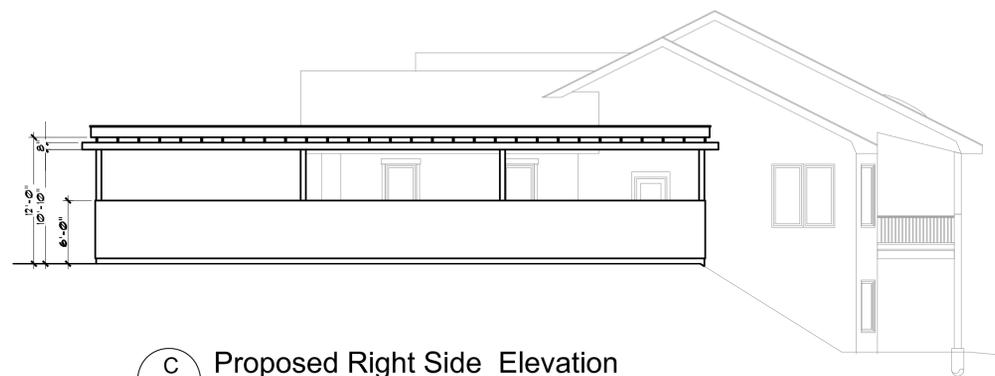

C Proposed Right Side Elevation
A-9 SCALE: 1/8"=1'-0"

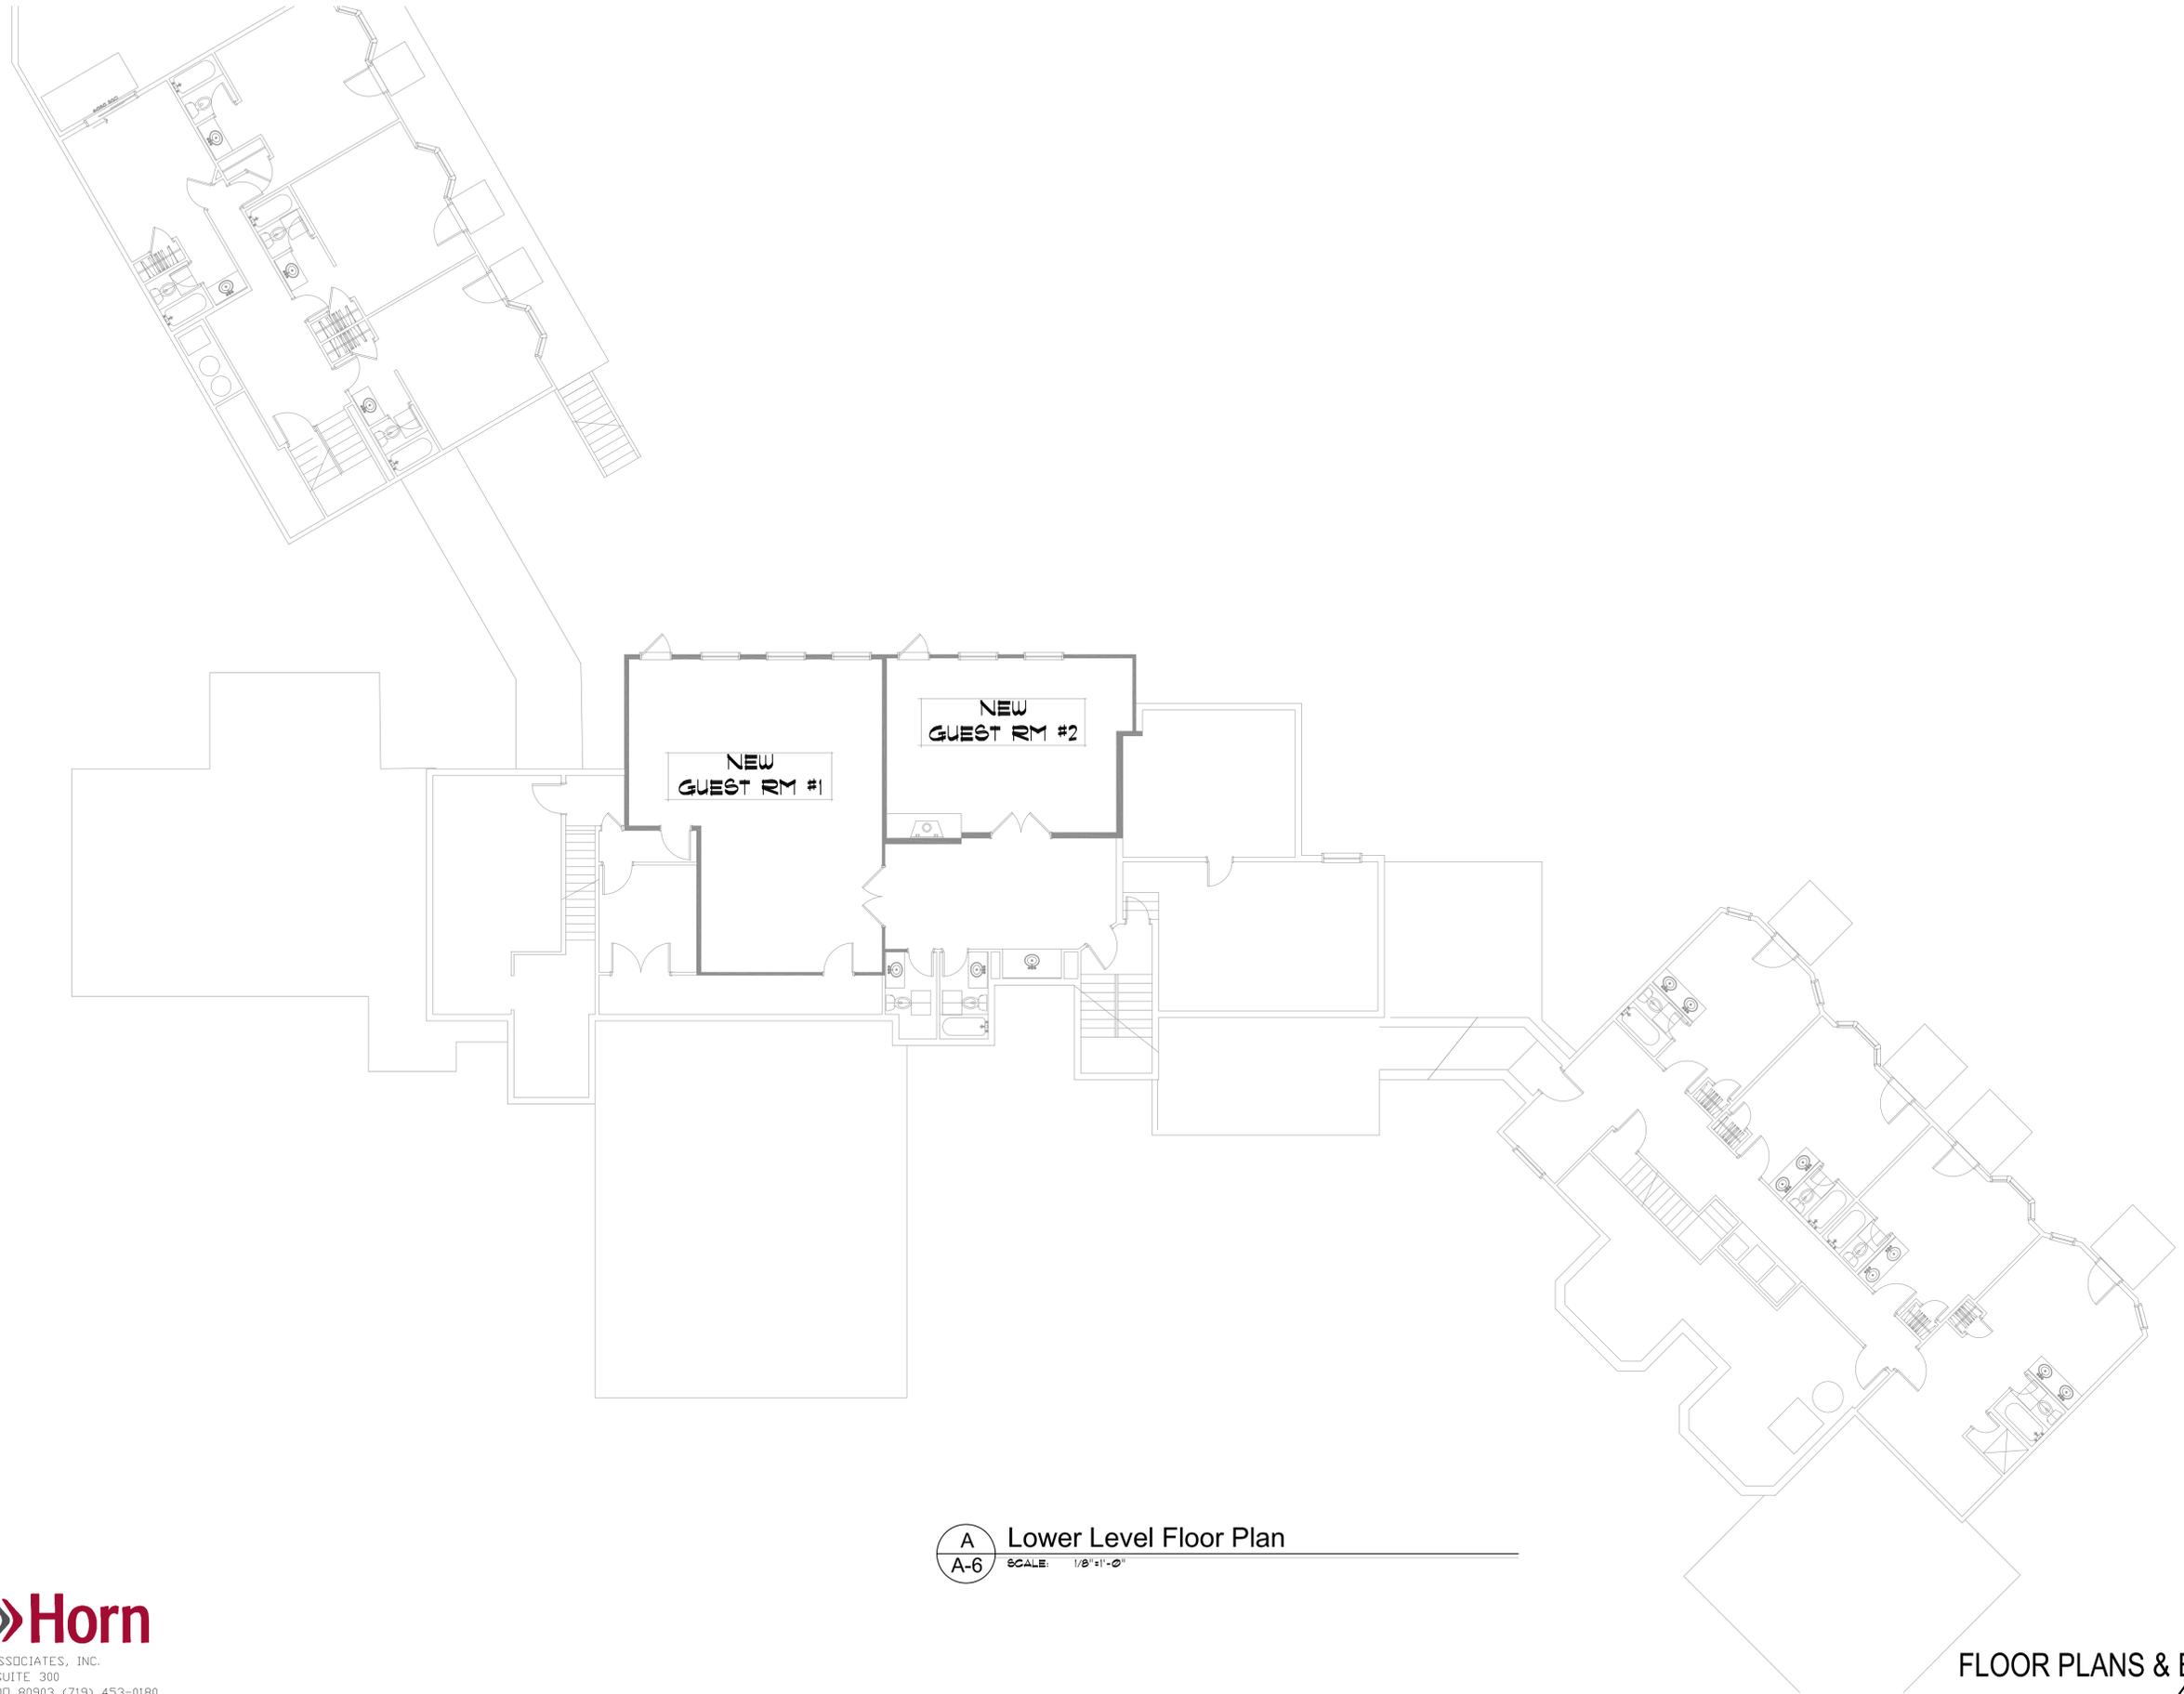


A Lower Level Floor Plan
A-6 SCALE: 1/8"=1'-0"



Site Development Plan_v1.pdf Markup Summary

lpackman (7)

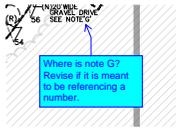

Author: lpackman
Date: 5/10/2022 3:12:09 PM



Author: lpackman
Date: 5/10/2022 3:12:59 PM

SHEET INDEX:




Author: lpackman
Date: 5/10/2022 3:13:40 PM




Author: lpackman
Date: 5/10/2022 4:27:45 PM



Author: lpackman
Date: 5/10/2022 4:44:00 PM

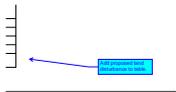


Author: lpackman
Date: 5/10/2022 4:44:36 PM

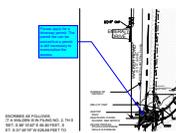

Author: lpackman
Date: 5/11/2022 4:50:28 PM


Raimere.Fitzpatrick (1)

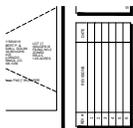

Author: Raimere.Fitzpatrick
Date: 1/19/2022 9:44:37 AM

Site Development Plan_v1.pdf Markup Summary

dsdmathy2 (2)

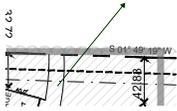

Author: dsdmathy2
Date: 5/12/2022 3:29:27 PM


VELOPMENT PI

Author: dsdmathy2
Date: 5/12/2022 3:31:37 PM

If the adjoining property is owned by the
Indians and the property is to be used by
and for employees, we will want to see a joint
lease agreement.



lpackman (7)

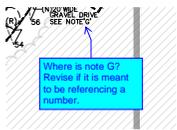

Author: lpackman
Date: 5/10/2022 3:12:09 PM




Author: lpackman
Date: 5/10/2022 3:12:59 PM

Please provide a legend.

SHEET INDEX:



Author: lpackman
Date: 5/10/2022 3:13:40 PM

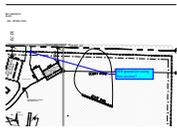


Author: lpackman
Date: 5/10/2022 4:27:45 PM



Author: lpackman
Date: 5/10/2022 4:44:00 PM



Author: lpackman
Date: 5/10/2022 4:44:36 PM

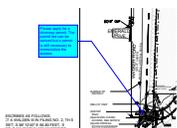

Author: lpackman
Date: 5/11/2022 4:50:28 PM

