
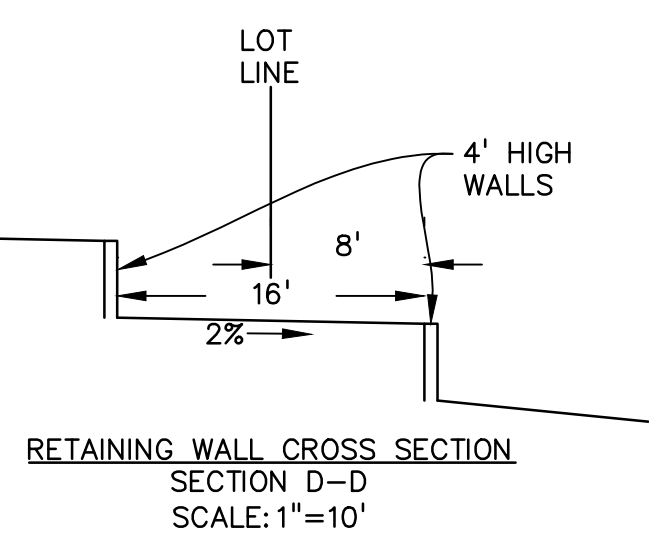


- LEGEND**
- STORM DRAIN
  - CURB FLOWLINE
  - R.O.W.
  - EXIST. FENCE
  - EXIST. STORM SEWER
  - EXIST. MINOR CONTOUR
  - EXIST. MAJOR CONTOUR
  - PROP. MINOR CONTOUR
  - PROP. MAJOR CONTOUR

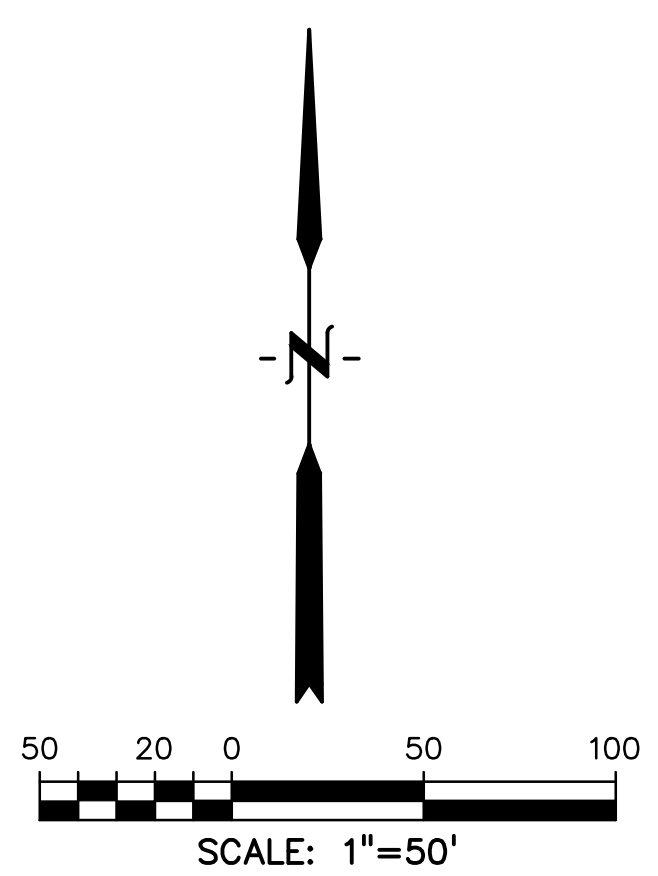

PREPARED BY:

**DREXEL, BARRELL & CO.**  
 Engineers • Surveyors  
 3 SOUTH 7TH STREET  
 COLORADO SPGS, COLORADO 80905  
 CONTACT: TIM D. MCCONNELL, P.E.  
 (719)260-0887  
 BOULDER • COLORADO SPRINGS • GREELEY

CLIENT:

**RICHMOND**  
 AMERICAN HOMES  
 4350 S. MONACO ST.  
 DENVER, CO 80237  
 CONTACT: MATTHEW JENKINS  
 (720) 977-3686

PUD DEVELOPMENT/PRELIMINARY PLAN FOR:

# HAVEN VALLEY

(LETA DR.) BRADLEY RD/ALTURAS DR.  
 SECURITY, EL PASO COUNTY, COLORADO

| ISSUE         | DATE         |
|---------------|--------------|
| INITIAL ISSUE | 4/29/21      |
| LATEST ISSUE  | 4/8/22       |
|               |              |
|               |              |
| DESIGNED BY:  | TDM          |
| DRAWN BY:     | GES          |
| CHECKED BY:   | TDM          |
| FILE NAME:    | 21085-03GP01 |

PREPARED UNDER MY DIRECT SUPERVISION FOR AND ON BEHALF OF DREXEL, BARRELL & CO.

DRAWING SCALE:  
 HORIZONTAL: 1" = 50'  
 VERTICAL: N/A

**PRELIMINARY GRADING PLAN**

PROJECT NO. 21085-03CSCV  
 DRAWING NO.




# GP01

SHEET: 4 OF 9

Please remove the distance shown. The smallest roadway per the PUD and TIS is an urban local low volume roadway which will have a minimum 24' paved width which would not be obtained with these smaller distances. Please also show the paved width dimension.

please revise the distance such that it meets the urban local roadway standards (17.5' to back of curb and 30' min. paved width)

Recommend showing the distance on the cross sections to the back of curb to be consistent with the sections on the PUD plan and for clarity.

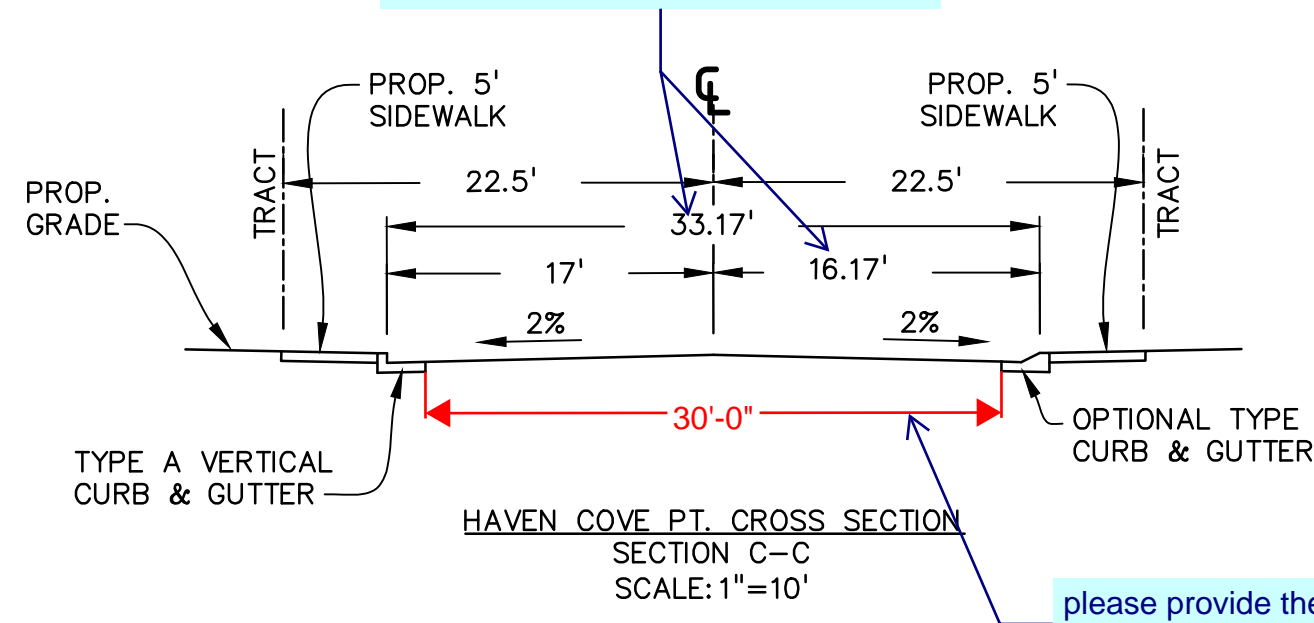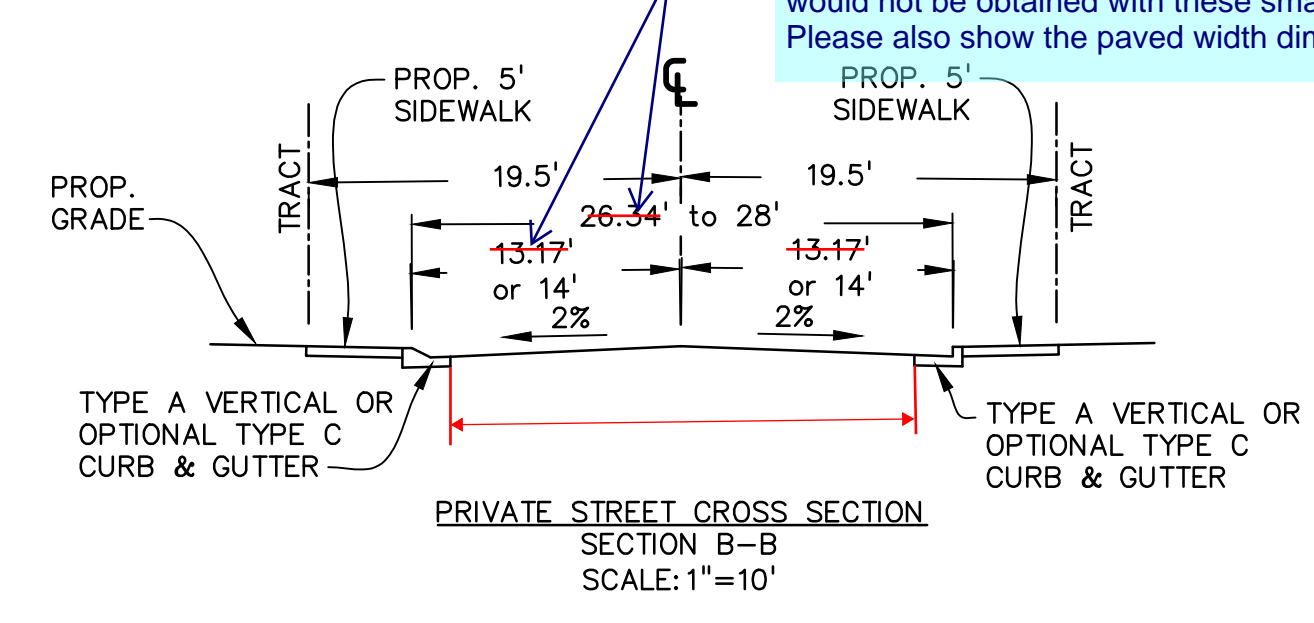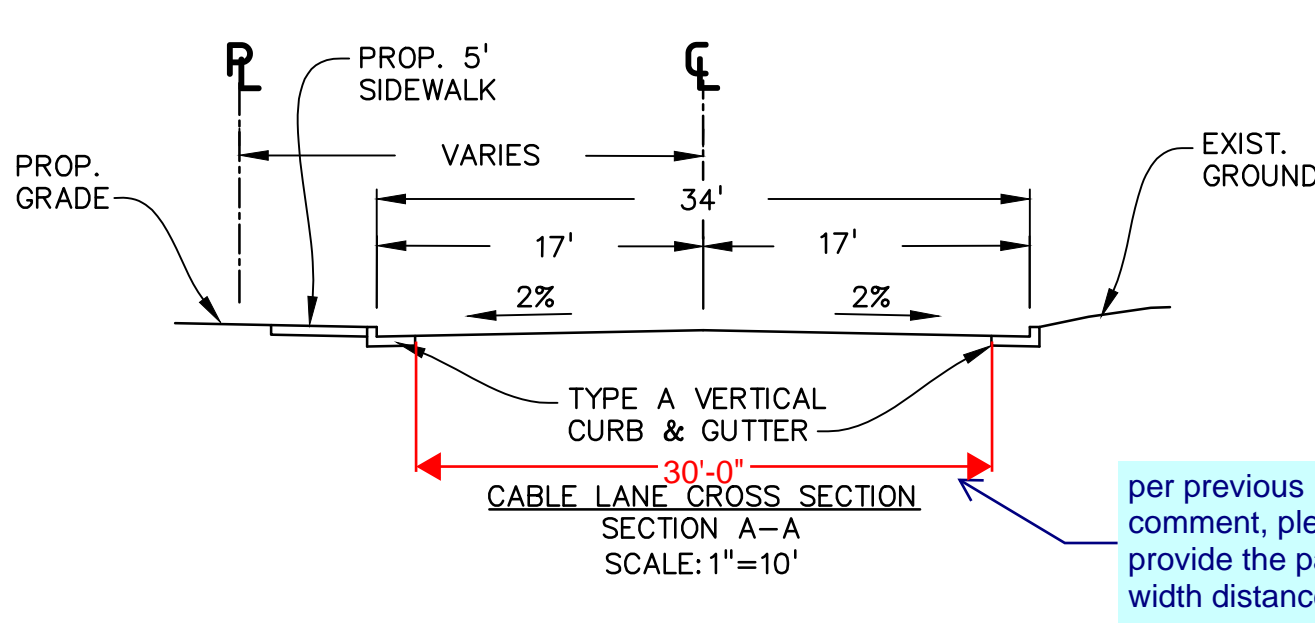


per previous comment, please provide the paved width distance.

please provide the paved width distance

**811** Know what's below. Call before you dig.  
 CALL 3-BUSINESS DAYS IN ADVANCE BEFORE YOU DIG, GRADE, OR EXCAVATE FOR THE MARKING OF UNDERGROUND MEMBER UTILITIES.


# Grading & Erosion Control Plan\_v4.pdf Markup Summary 5-9-2022

Daniel Torres (13)

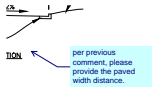


**Subject:** Callout  
**Page Label:** [1] GRADE  
**Author:** Daniel Torres  
**Date:** 5/9/2022 12:58:31 PM  
**Status:**  
**Color:** ■  
**Layer:**  
**Space:**

per previous comment, please provide the paved width distance.

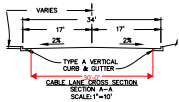


**Subject:** Length Measurement  
**Page Label:** [1] GRADE  
**Author:** Daniel Torres  
**Date:** 5/9/2022 12:59:02 PM  
**Status:**  
**Color:** ■  
**Layer:**  
**Space:**

30'-0"

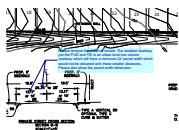


**Subject:** Callout  
**Page Label:** [1] GRADE  
**Author:** Daniel Torres  
**Date:** 5/9/2022 1:00:16 PM  
**Status:**  
**Color:** ■  
**Layer:**  
**Space:**


Please remove the distance shown. The smallest roadway per the PUD and TIS is an urban local low volume roadway which will have a minimum 24' paved width which would not be obtained with these smaller distances. Please also show the paved width dimension.

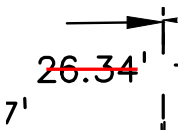


**Subject:** Line  
**Page Label:** [1] GRADE  
**Author:** Daniel Torres  
**Date:** 5/9/2022 12:59:45 PM  
**Status:**  
**Color:** ■  
**Layer:**  
**Space:**

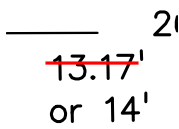


**Subject:** Line  
**Page Label:** [1] GRADE  
**Author:** Daniel Torres  
**Date:** 5/9/2022 12:59:53 PM  
**Status:**  
**Color:** ■  
**Layer:**  
**Space:**

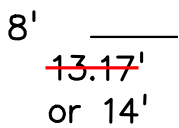


**Subject:** Line  
**Page Label:** [1] GRADE  
**Author:** Daniel Torres  
**Date:** 5/9/2022 1:00:00 PM  
**Status:**  
**Color:** ■  
**Layer:**  
**Space:**

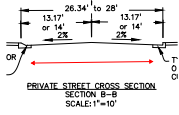


**Subject:** Arrow  
**Page Label:** [1] GRADE  
**Author:** Daniel Torres  
**Date:** 5/9/2022 1:00:54 PM  
**Status:**  
**Color:** ■  
**Layer:**  
**Space:**

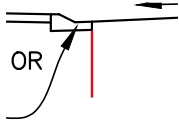

**Subject:** Line  
**Page Label:** [1] GRADE  
**Author:** Daniel Torres  
**Date:** 5/9/2022 1:00:35 PM  
**Status:**  
**Color:** ■  
**Layer:**  
**Space:**

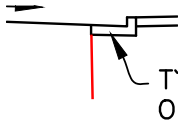


**Subject:** Line  
**Page Label:** [1] GRADE  
**Author:** Daniel Torres  
**Date:** 5/9/2022 1:00:49 PM  
**Status:**  
**Color:** ■  
**Layer:**  
**Space:**

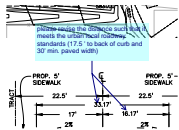


**Subject:** Callout  
**Page Label:** [1] GRADE  
**Author:** Daniel Torres  
**Date:** 5/9/2022 1:01:53 PM  
**Status:**  
**Color:** ■  
**Layer:**  
**Space:**

please revise the distance such that it meets the urban local roadway standards (17.5 ' to back of curb and 30' min. paved width)

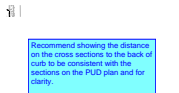


**Subject:** Text Box  
**Page Label:** [1] GRADE  
**Author:** Daniel Torres  
**Date:** 5/9/2022 1:02:23 PM  
**Status:**  
**Color:** ■  
**Layer:**  
**Space:**

Recommend showing the distance on the cross sections to the back of curb to be consistent with the sections on the PUD plan and for clarity.

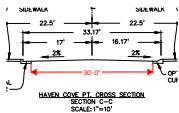

**Subject:** Length Measurement  
**Page Label:** [1] GRADE  
**Author:** Daniel Torres  
**Date:** 5/9/2022 1:02:42 PM  
**Status:**  
**Color:** ■  
**Layer:**  
**Space:**

30'-0"

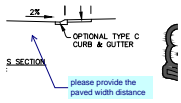

**Subject:** Callout  
**Page Label:** [1] GRADE  
**Author:** Daniel Torres  
**Date:** 5/9/2022 1:03:05 PM  
**Status:**  
**Color:** ■  
**Layer:**  
**Space:**

please provide the paved width distance