



- LEGEND**
- STORM DRAIN
  - CURB FLOWLINE
  - R.O.W.
  - EXIST. FENCE
  - EXIST. STORM SEWER
  - EXIST. MINOR CONTOUR
  - EXIST. MAJOR CONTOUR
  - PROP. MINOR CONTOUR
  - PROP. MAJOR CONTOUR

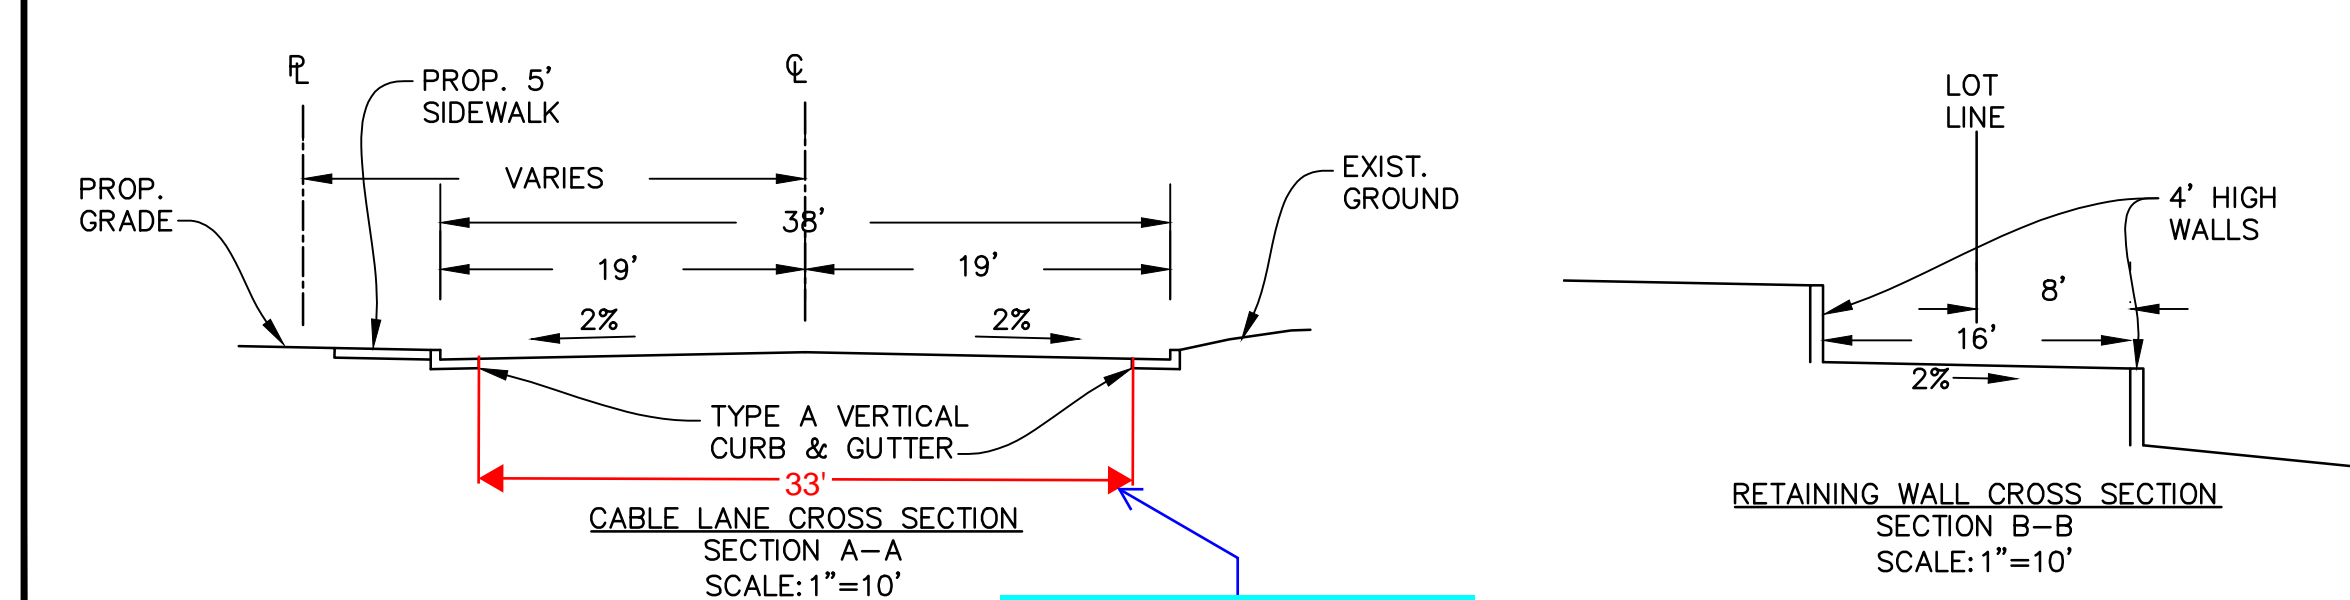

Review 2:  
Please provide a dimension for the travel lane/paved width

PREPARED BY:

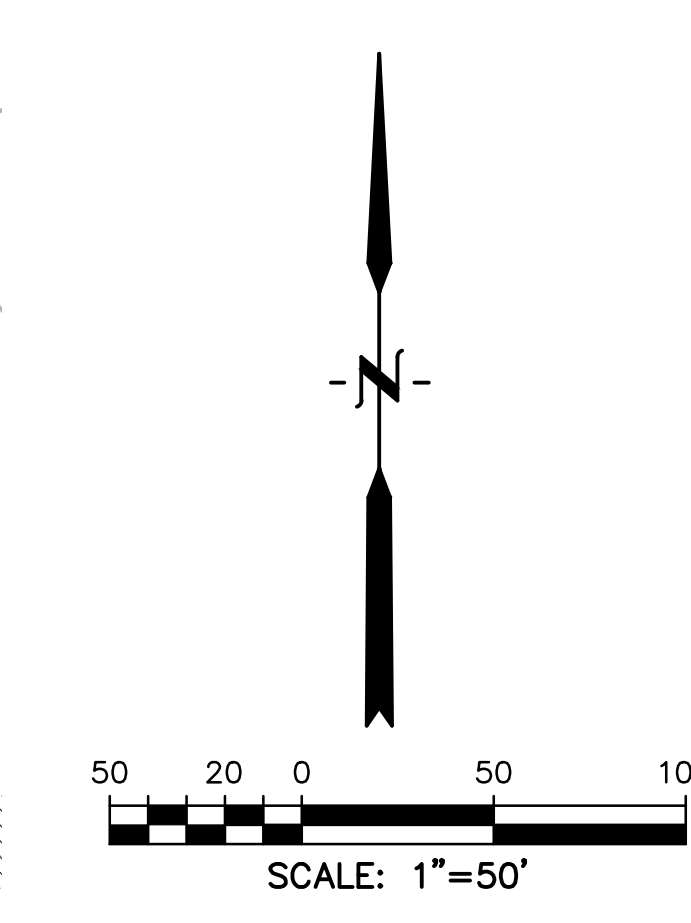

CLIENT:



CONSTRUCTION PLANS FOR:

# HAVEN VALLEY

(LETA DR.) BRADLEY RD/ALTURAS DR.  
SECURITY, EL PASO COUNTY, COLORADO

ISSUE	DATE
INITIAL ISSUE	4/29/21
LATEST ISSUE	2/3/22

DESIGNED BY:	TDM
DRAWN BY:	GES
CHECKED BY:	TDM
FILE NAME:	21085-03GP01

PREPARED UNDER MY DIRECT SUPERVISION FOR AND ON BEHALF OF DREXEL, BARRELL & CO.

DRAWING SCALE:  
HORIZONTAL: 1" = 50'  
VERTICAL: N/A

PRELIMINARY  
GRADING PLAN

PROJECT NO. 21085-03C-SEL  
DRAWING NO.

# GP01

SHEET: 4 OF 9

