


please add a north arrow

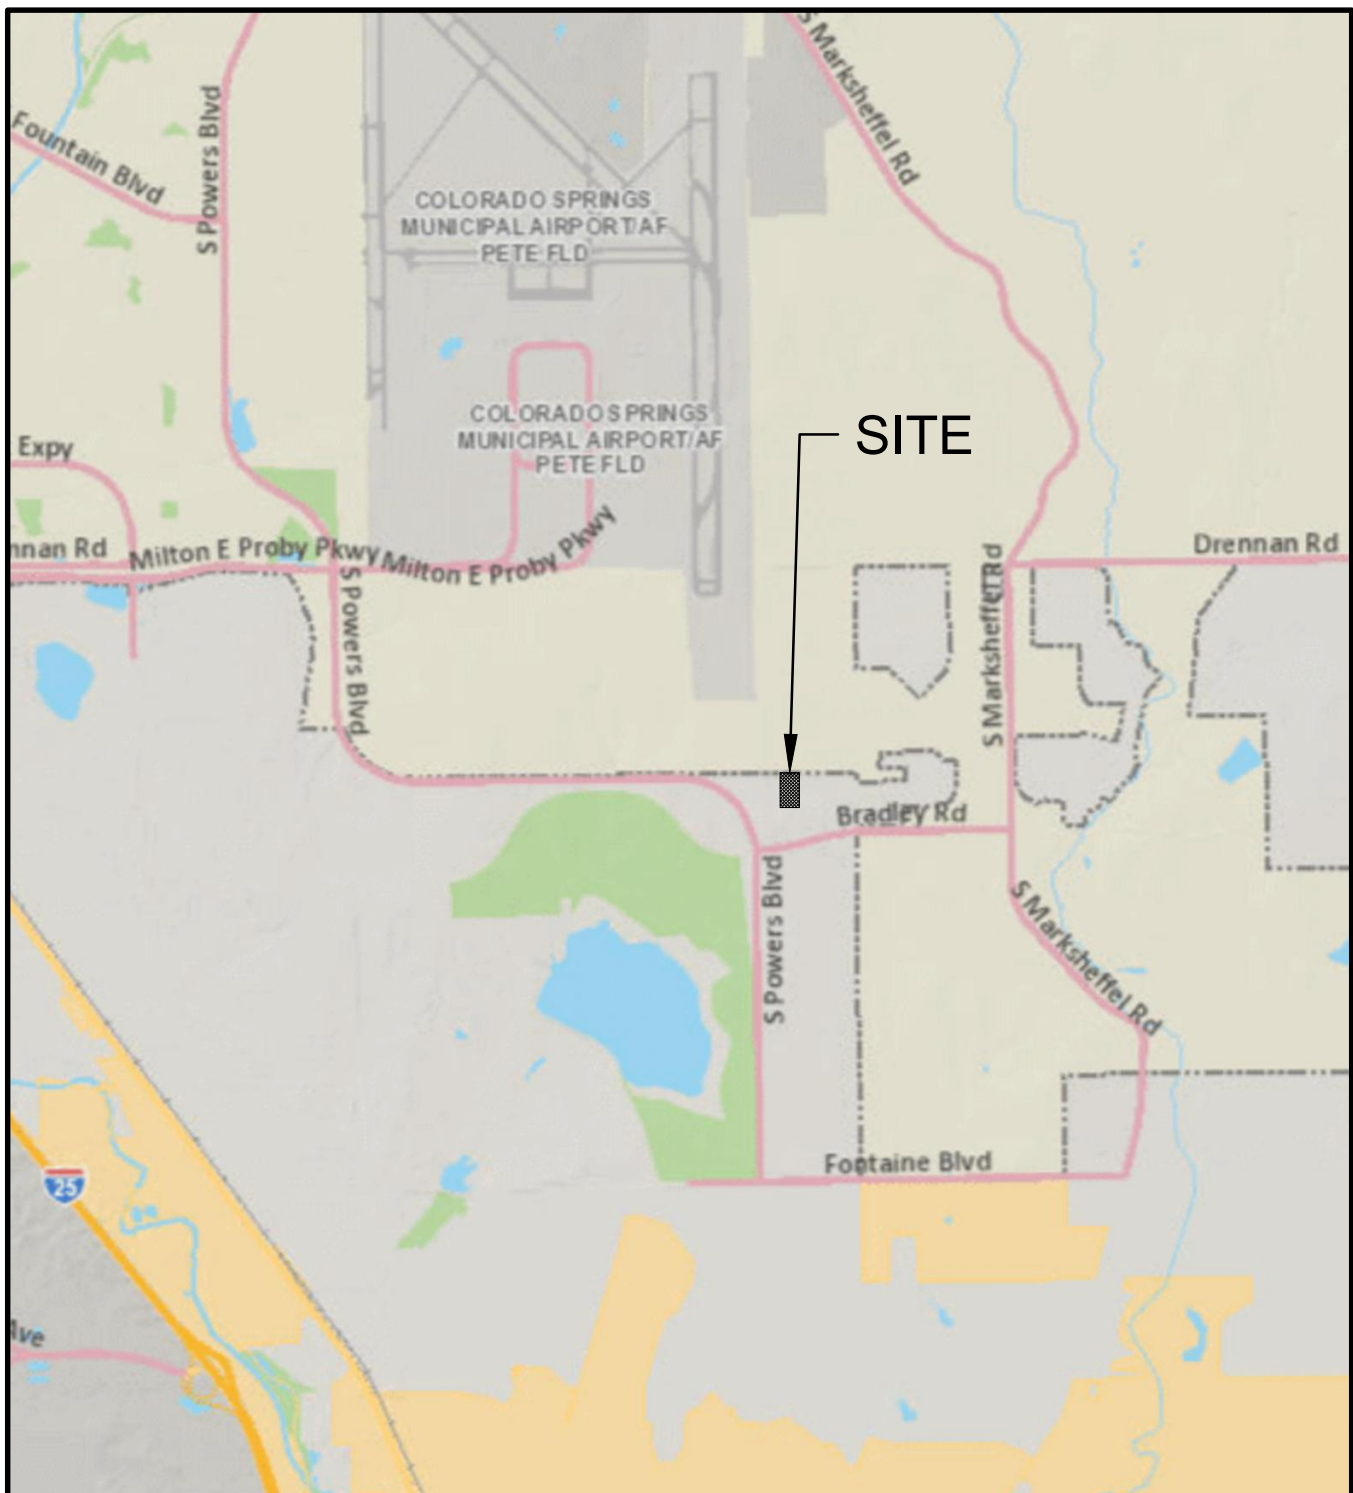

DSE Dakota Springs
Engineering

31 N. TEJON, SUITE 500
COLORADO SPRINGS, CO 80903
P: (719) 227-7388
F: (719) 227-7392

PROJECT WATERVIEW NORTH

SHEET TITLE VICINITY MAP - RM-30

J-CAD
CONSULTING, LLC
719-377-0002

PDF: VICINITY - RM-30.PDF