

ADD26395
PLAT: 14420
ZONE: RS-20000

APPROVED
Plan Review

07/09/2026 11:39:49 AM
dsdchambers

EPC Planning & Community Development Department



It is the owner's responsibility to coordinate with easement holders to avoid impact to utilities that may be located in the easements.




ANY APPROVAL GIVEN BY
EL PASO COUNTY
DOES NOT OBVIATE THE NEED
TO COMPLY WITH APPLICABLE
FEDERAL, STATE, OR LOCAL
LAWS AND/OR REGULATION

Planning & Community Development Department approval is contingent upon compliance with all applicable notes on the recorded plat.

An access permit must be granted by the Planning & Community Development Department prior to the establishment of any driveway onto a County road.

Diversion of blockage of any drainage way
is not permitted without approval of the
Planning & Community Development Department

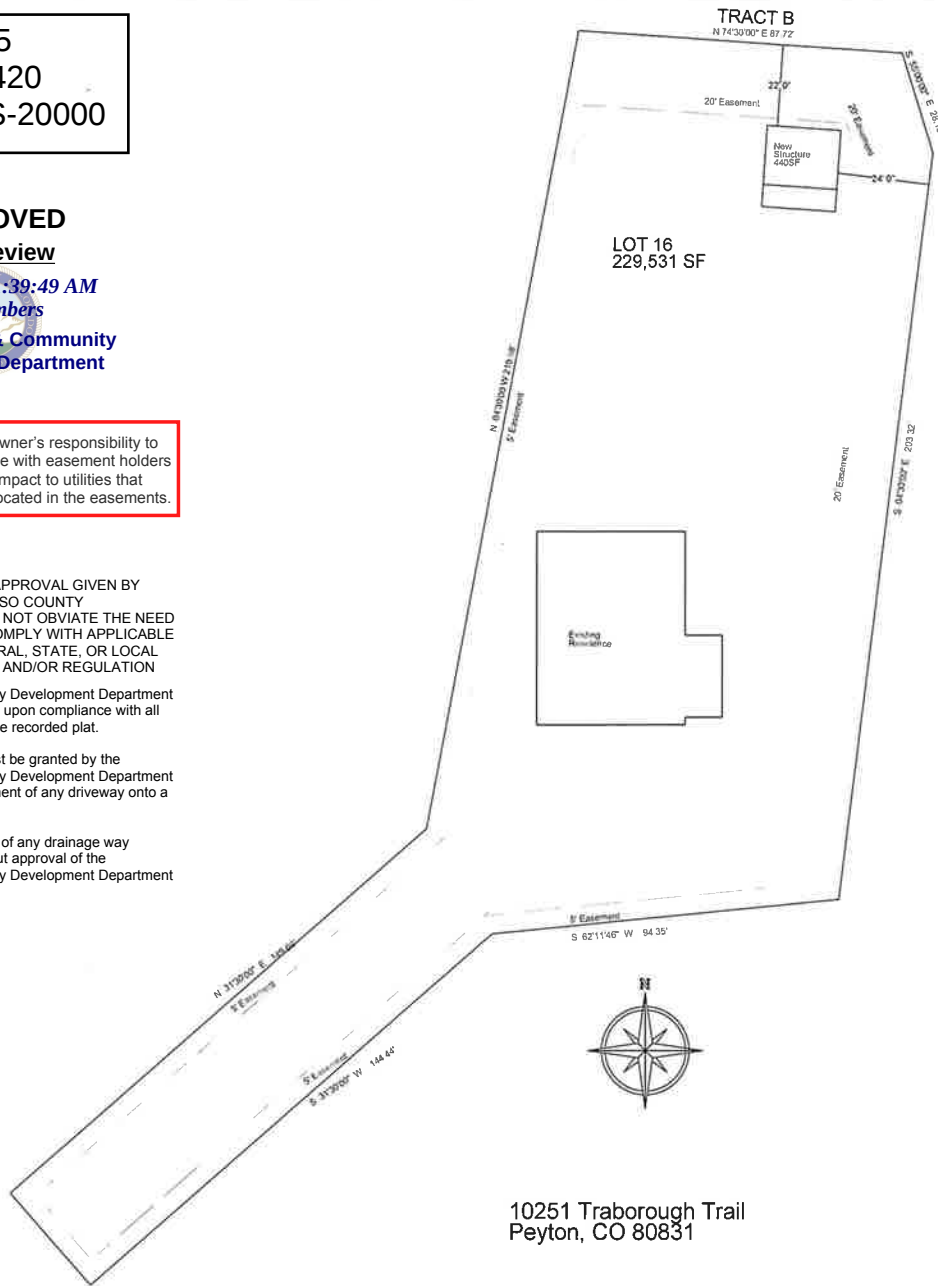

10251 Traborough Trail
Peyton, CO 80831





Job Name.: The She Shed

Drawn: _Doug Smith_

Date: 5/21/26 Scale: 1"= 50"

Plot Plan



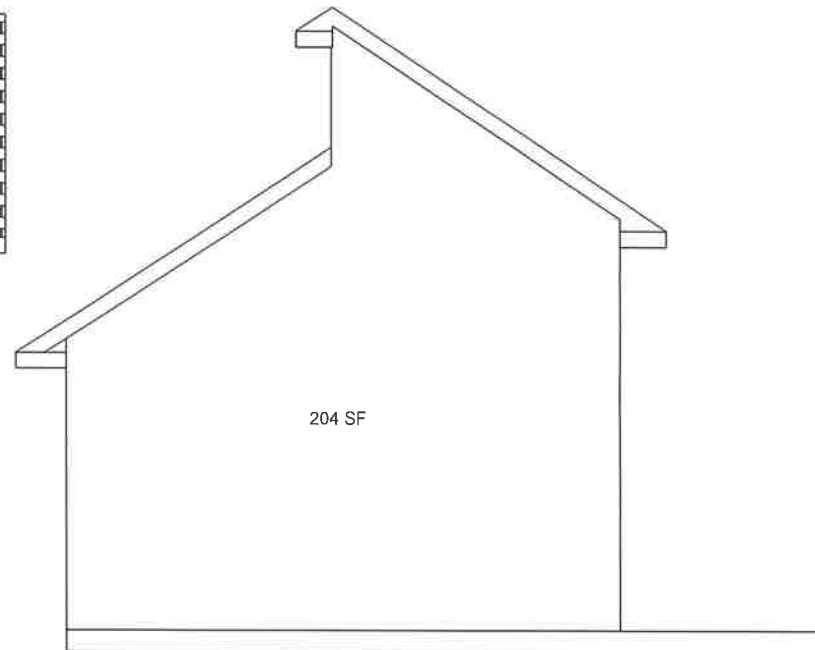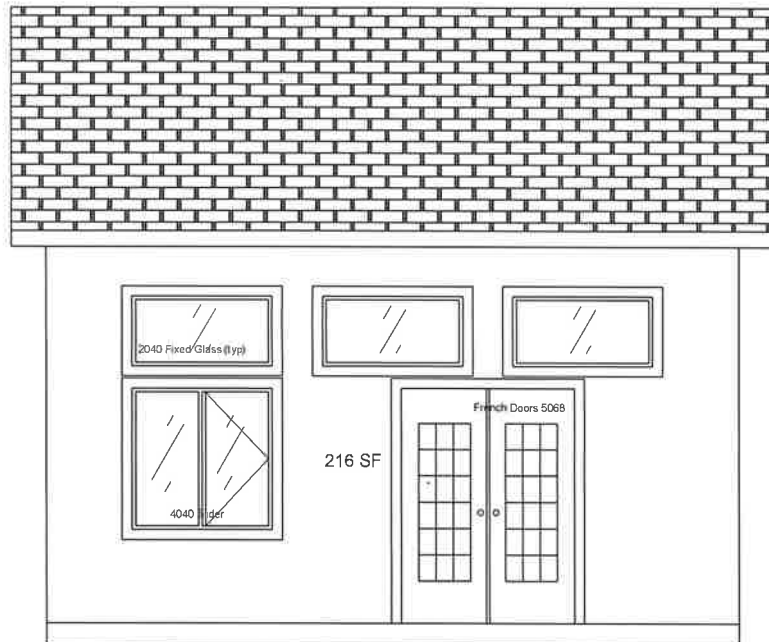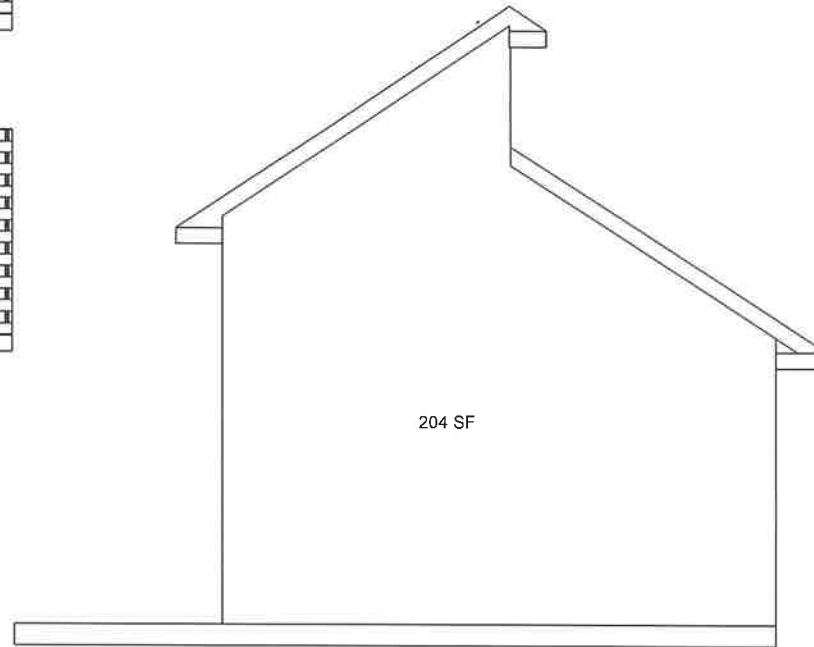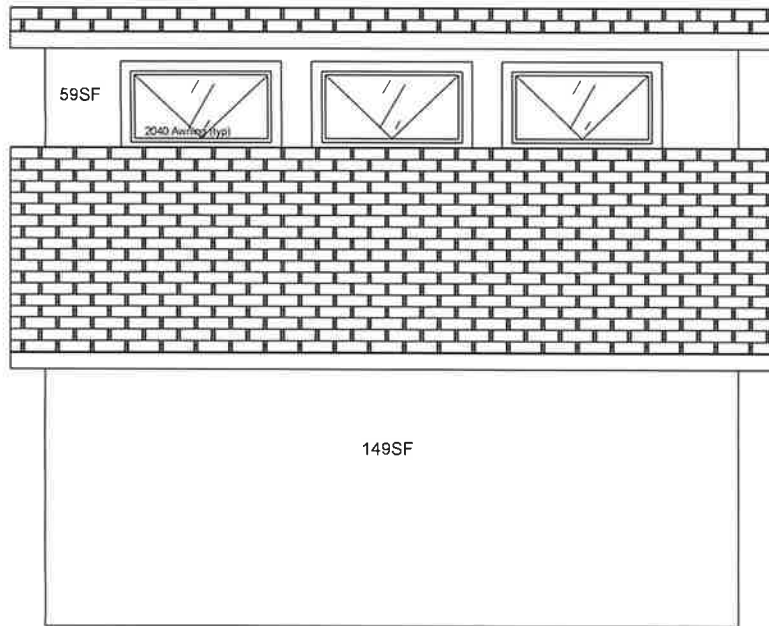

Elevations



Job Name.: The She Shed
 Drawn: _Doug Smith_
 Date: _4/5/26_ Scale: 3/16 = 1'