



THIS DRAWING CONTAINS MATERIAL & REPRODUCED WITHOUT WRITTEN CONSENT OF HAMMERS CONSTRUCTION. NO. THESE DRAWINGS ARE INTENDED O BE USED ONLY BY HAMMERS CONSTRUCTION & ITS REPRESENTATIVES. THESE DRAWINGS HAVE NOT BEEN PREPARED FOR ANY OTHER PURPOSE THAN TO INDICATE THE GENERAL FEATURES AND PLACEMENT OF THE PROPOSED PROJECT. COPYRIGHT 2018 HAMMERS CONSTRUCTION

DATE: JUL. 16, 2018 DRAWN BY: D. AQUINO PROJ. MNGR: Z. CRABTREE SCALE: SEE PLAN APPROVED BY: JOB NO: 1053

RESUBMITTALS: 9-12-18/DP COMMENTS 8-30-18 √3\ 10-4-18/DP COMMENTS 10-01-18

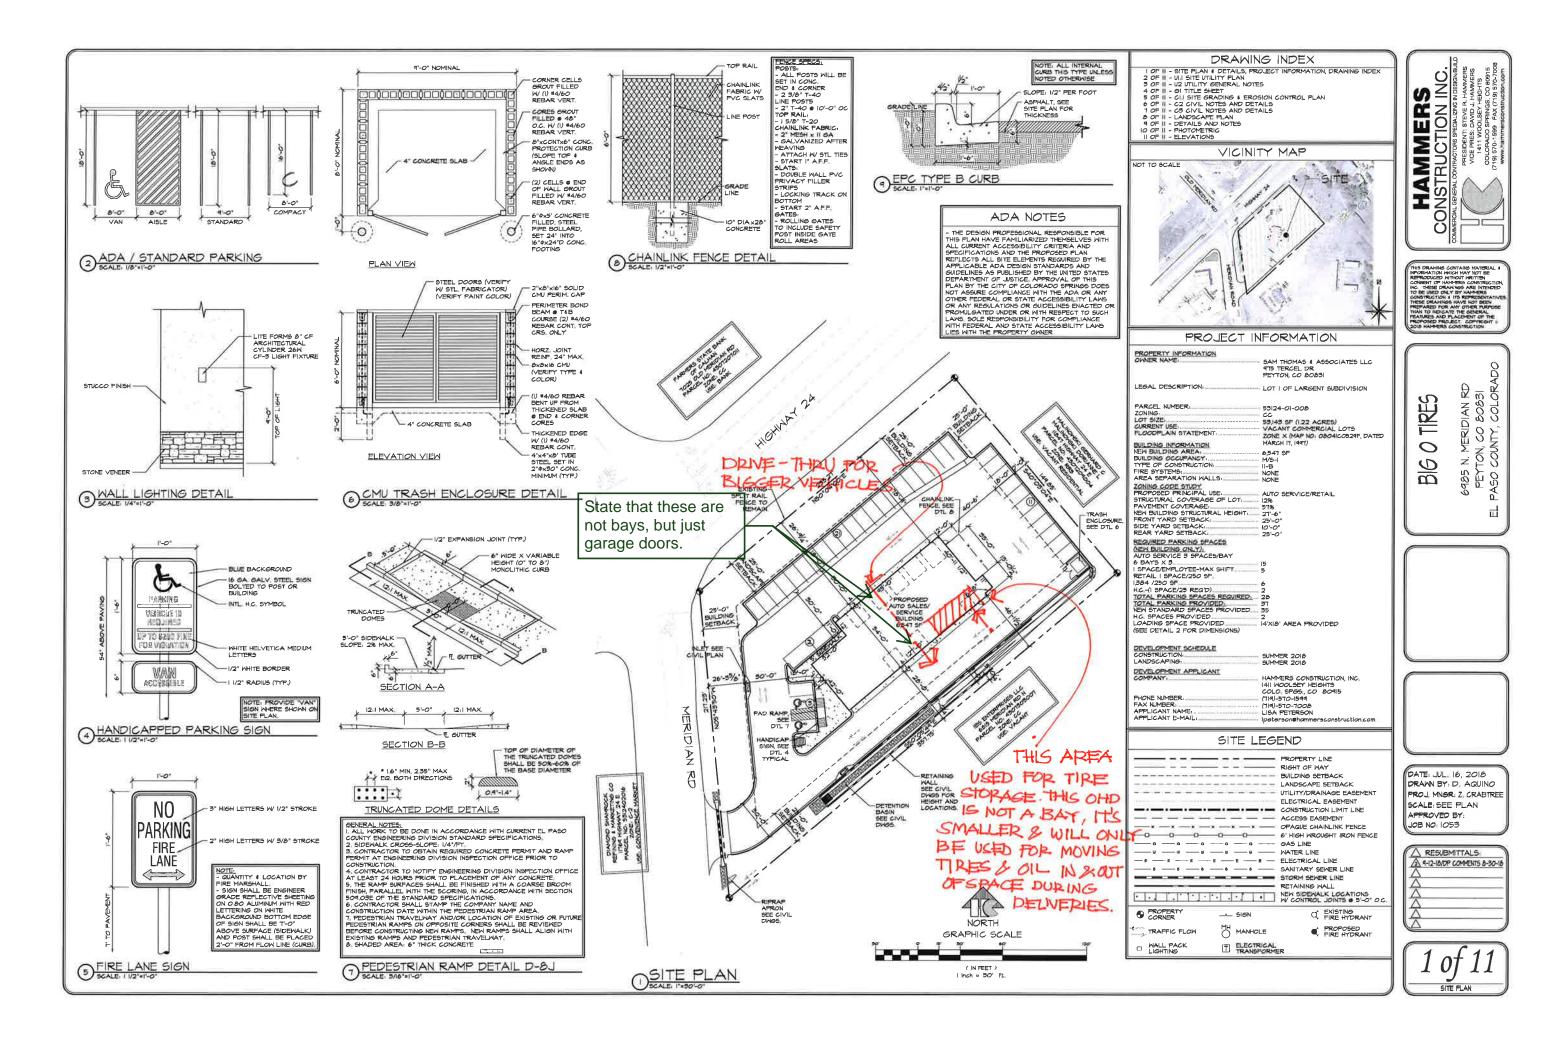

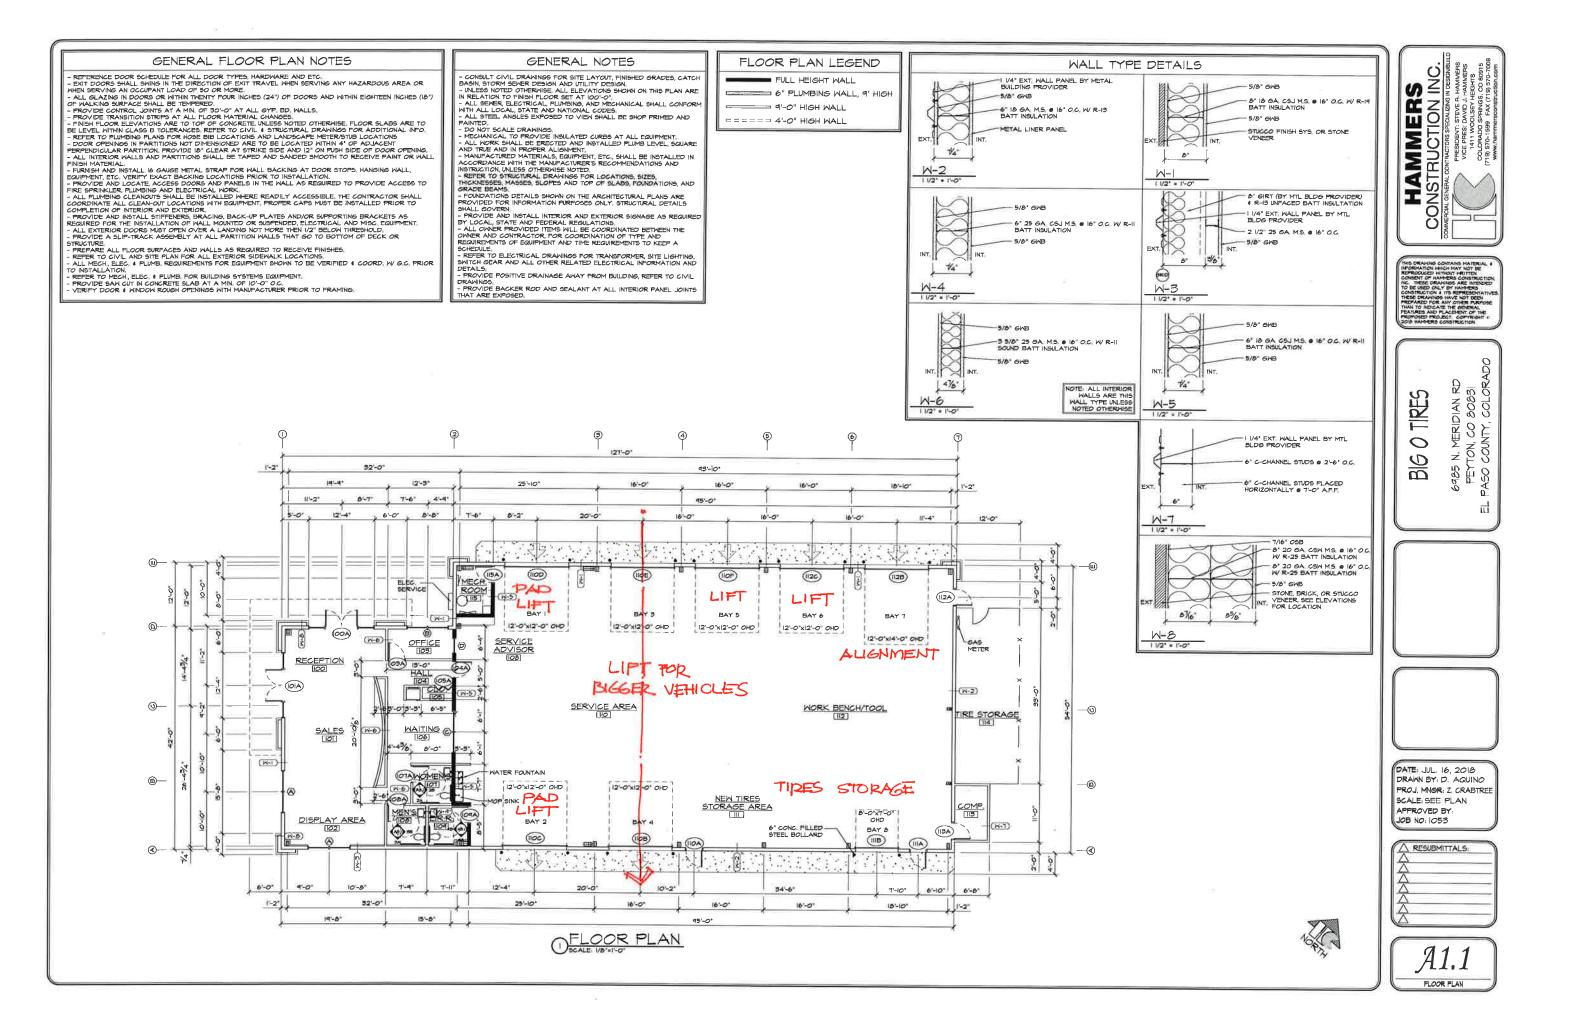

Markup Summary

dsdkendall (1)



Subject: Callout Page Label: 2 Lock: Unlocked Author: dodkendall

Date: 10/22/2018 10:12:18 AM

Color:

State that these are not bays, but just garage doors.